



Kenton C. Ward, CFM
Surveyor of Hamilton County
Phone (317) 776-8495
Fax (317) 776-9628

Suite 188
One Hamilton County Square
Noblesville, Indiana 46060-2230

Map Correction-Field Verification

Drain Number: 238

Drain Length: 13,684

Drain Name: William Baker

Change + / - : 20

Date: 10-26-2012

New Length: 13,704


Verified By: SAB

Notes & Sketch: See attached map & WO-2012-00180

Tile under Dunbar was re-routed around the culvert structure under the road. It was rerouted and replaced with 68 feet 15" RCP and Plastic pipe.



Suzanne L. Mills
GIS Specialist

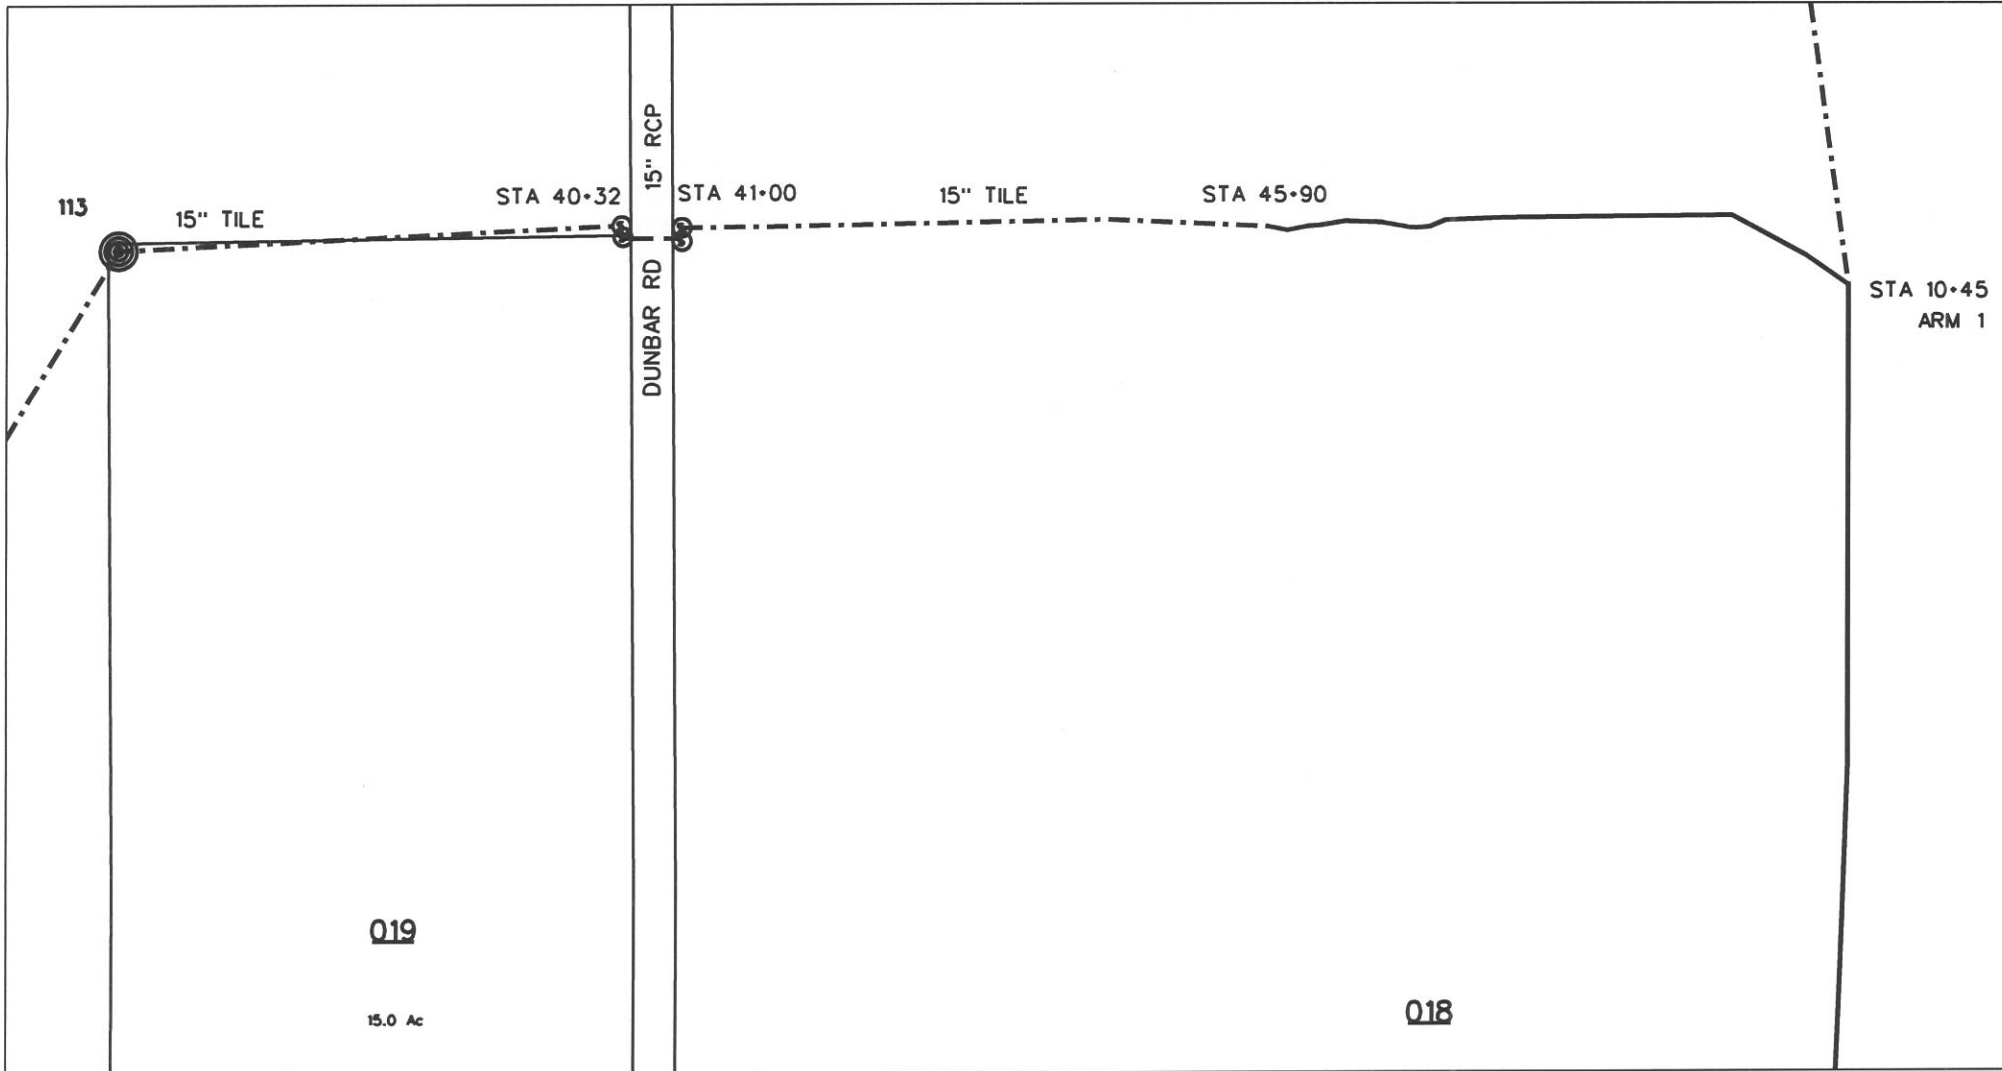

reg_drain_hc.dgn 10/26/2012 11:18:17 AM