

Kenton C. Ward, CFM
Surveyor of Hamilton County
Phone (317) 776-8495
Fax (317) 776-9628

Suite 188
One Hamilton County Square
Noblesville, Indiana 46060-2230

Map Correction-Field Verification

Drain Number: 233

Drain Length: 3200

Drain Name: Beaver & Brooks

Change +/-: +80'

Date: 1-23-08

New Length: 3280'

Verified By: SAB & SLM

DUE TO WD-2005-00043



Notes & Sketch:

SEE ATTACHED MAP. Tile was relocated around the edge of the property. The tile was relocated with 740' of 10" plastic tile.

Suzanne L. Mills
GIS Specialist

	73.51	198	200.0
			125.0

OOH HODSIER RD.

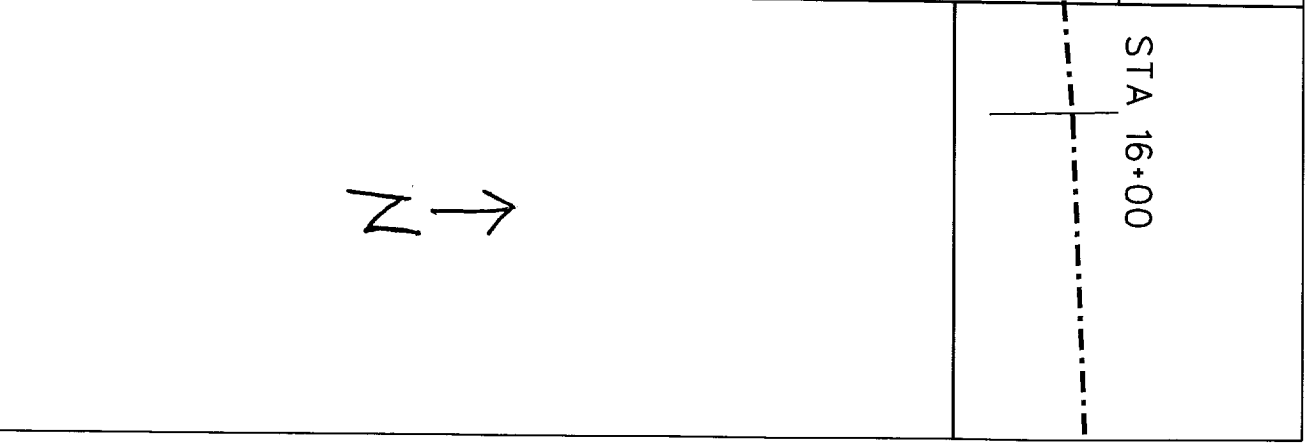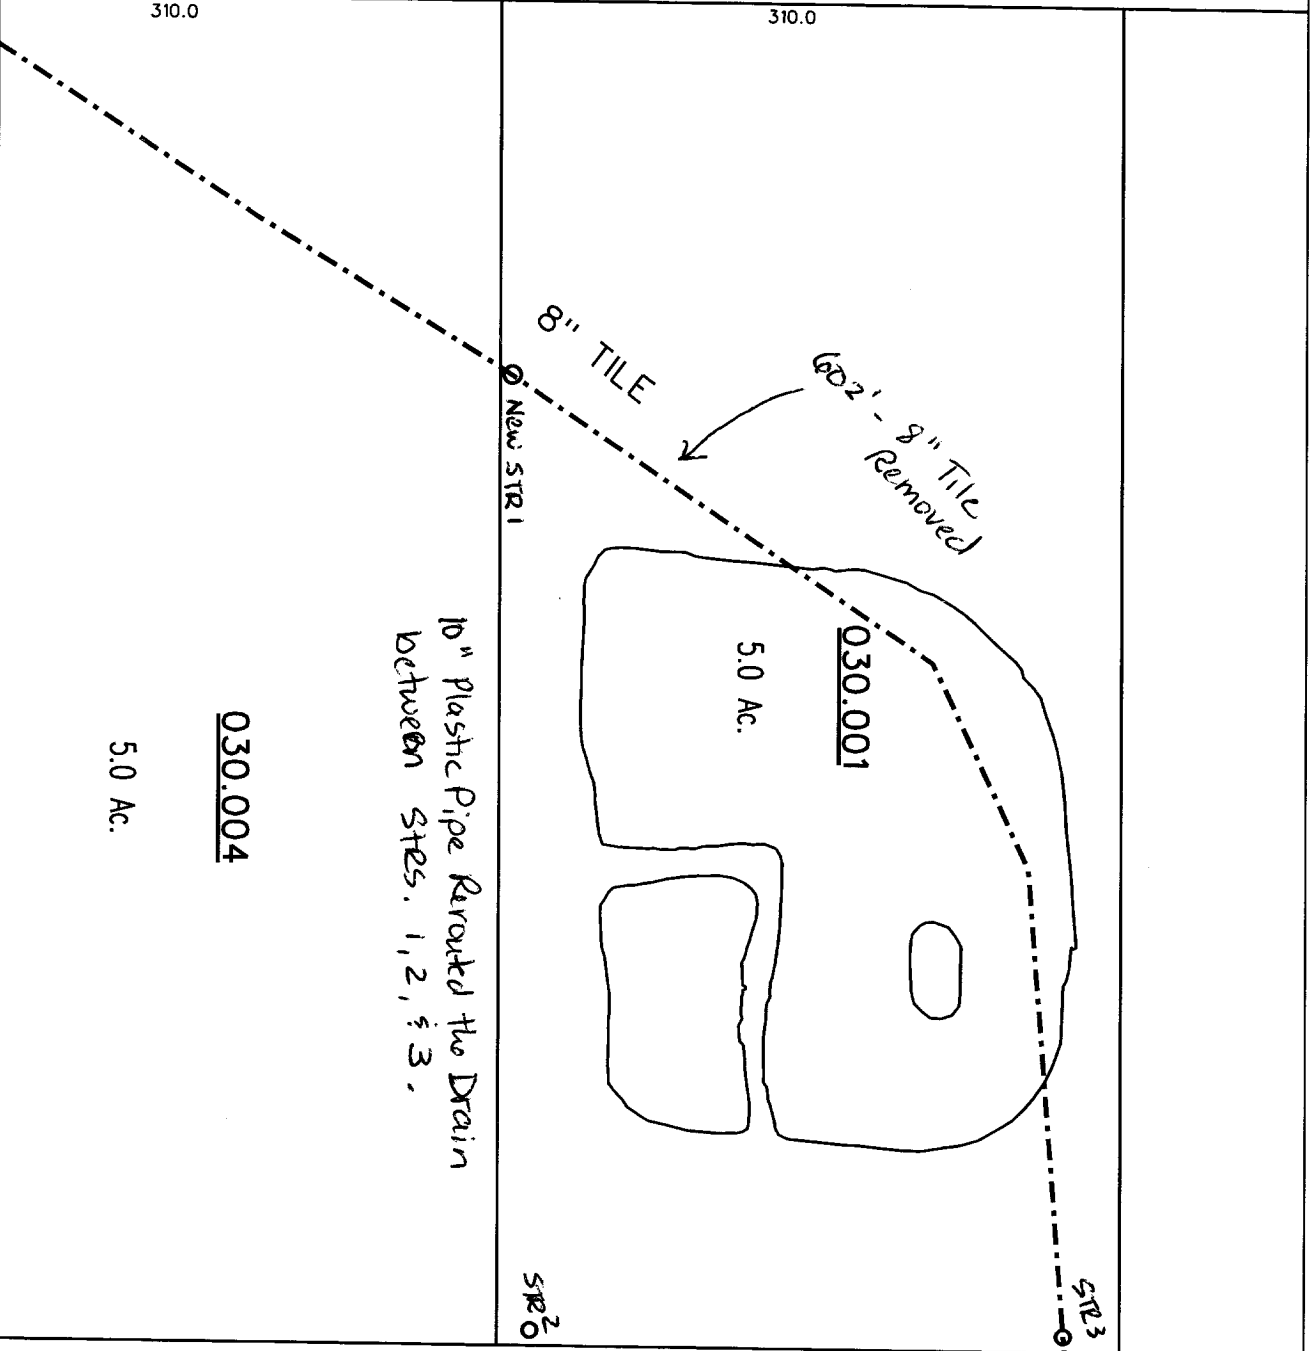

reg_drain_hc.dgn 1/23/2008 11:01:19 AM

↓ 106th ST.

ATES

10" Plastic Pipe Rerouted the Drain between STES. 1, 2, & 3.

New STR 1

STR 2

STR 3

STA 16+00

N ↑