



Kenton C. Ward, Surveyor

Phone (317) 776-8495

Fax (317) 776-9628

Suite 188

One Hamilton County Square

Noblesville, Indiana 46060-2230

Map Correction-Field Verification

Drain Number: 8495

Drain Length: 32+98

Drain Name: Herbert Billingsley

Change +/-: -348

Date: 11-18-05

New Length: 29+50

Verified By: SAB & JPP

Notes & Sketch:

This tile was probed & GPS'd by Steve Baitz & Jeff Powell. The only portion verified at this time is the main drain. The outlet & catch basin were verified as well. Arm 1 & Arm 2 could not be verified unless major excavation was performed. The result of shortened footage - is due to the actual verification of the main drain.

Suzanne L. Mills
GIS Specialist



01:09:00

STA 0
AREA 1

STA 0
AREA 2

3" TEL

3" TEL

AREA 1
STA 5+00
STA 0
HERBERT BELMOSLEY DRAIN

3" TEL

286 TH ST.

30.0 AC

30.0 AC

006
4.5 AC

006.001
4.5 AC

DITCH RD.


STA 9+40 (27.20 per description)

2" TEL

HERBERT BELMOSLEY DRAIN

STA 18+40

3" TEL

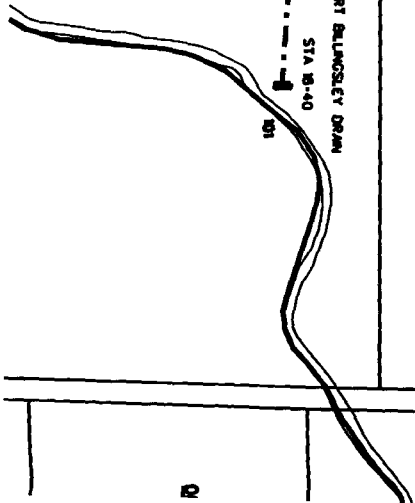

reg_drain_hc.dgn 1/1/8/2005 10:52:11 AM