


Drain: JW BRENDE DRAIN **Drain #:** 77
Improvement/Arm: HAYDEN RUN - SECTION 2
Operator: JDH **Date:** 10-21-03
Drain Classification: Urban/Rural **Year Installed:** 2003

GIS Drain Input Checklist

- Digitize & Attribute Tile Drains _____
- Digitize & Attribute Storm Drains _____
- Digitize & Attribute SSD _____
- Digitize & Attribute Open Ditch _____
- Sum drain lengths & Validate _____
- Enter Improvements into Posse JDH 10-21
- Enter Drain Age into Posse _____
- Sum drain length for Watershed in Posse _____
- Stamp Plans _____
- Pull Source Documents for Scanning JDH 10-21

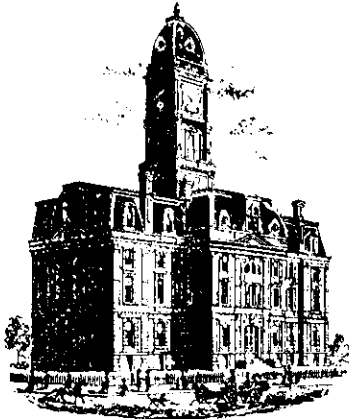

June 26, 2003

SURVEYOR'S OFFICE Hamilton County

Kenton C. Ward, Surveyor

Phone (317) 776-8495

Fax (317) 776-9628

Suite 188

One Hamilton County Square

Noblesville, Indiana 46060-2230

TO: Hamilton County Drainage Board

RE: J.W. Brendle Drain, Hayden Run Section 2 Arm

Attached is a petition filed by Centex Homes along with a non-enforcement request, plans, calculations, quantity summary and assessment roll for the Hayden Run Section 2 Arm, J.W. Brendle Drain to be located in Clay Township. I have reviewed the submittals and petition and have found each to be in proper form.

I have made a personal inspection of the land described in the petition. Upon doing so, I believe that the drain is practicable, will improve the public health, benefit a public highway, and be of public utility and that the costs, damages and expenses of the proposed drain will probably be less than the benefits accruing to the owners of land likely to be benefited. The drain will consist of the following:

6" SSD	2,136 ft.	18" RCP	127 ft.	30" RCP	537 ft.
12" RCP	488 ft.	21" RCP	270 ft.		
12" Plastic tile	90 ft.	27" RCP	144 ft.		

The total length of the drain will be 3,792 feet.

The subsurface drains (SSD) to be part of the regulated drain are those located under the curbs. Only the main SSD lines which are located within the right of way are to be maintained as regulated drain. Laterals for individual lots will not be considered part of the regulated drain.

The 90 feet of 12" plastic tile listed above is that portion of drain across the rear of lot 38. This tile connects the existing private tile which crosses the site to the new drainage facilities.

I have reviewed the plans and believe the drain will benefit each lot equally. Therefore, I recommend each lot be assessed equally. I also believe that no damages will result to landowners by the construction of this drain. I recommend a maintenance assessment of \$ 65.00 per acre for common areas and platted lots, \$ 10.00 per acre for roadways, with a \$ 65.00 minimum. With this assessment the total annual assessment for this drain/this section will be \$ 1,347.00.

The petitioner has/has not submitted surety for the proposed drain at this time. Surety shall be submitted prior to the approval of the Hamilton County Board of Commissioners/commencement of construction. The sureties which are in the form of a Performance Bond/Letter of Credit are as follows:

Agent: Safeco Insurance Co.
Date: March 6, 2003
Number: 6200099
For: Storm Sewer
Amount: \$ 79,891.79


Agent: Safeco Insurance Co.
Date: March 6, 2003
Number: 6200100
For: Erosion Control
Amount: \$ 6,882.34

Parcels assessed for this drain may be assessed for the Long Branch Drain at sometime in the future.

I believe this proposed drain meets the requirements for Urban Drain Classification as set out in IC 36-9-27-67 to 69. Therefore, this drain shall be designated as an Urban Drain.

I recommend that upon approval of the above proposed drain that the Board also approve the attached non-enforcement request. The request is for the reduction of the regulated drain easement to those easement widths as shown on the secondary plat for Hayden Run Section 2 as recorded in the office of the Hamilton County Recorder.

I recommend the Board set a hearing for this proposed drain for July 28, 2003.

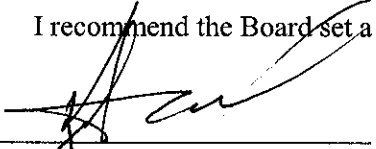

Kenton C. Ward
Hamilton County Surveyor

KCW/pll

STATE OF INDIANA)
)
COUNTY OF HAMILTON)

TO: HAMILTON COUNTY DRAINAGE BOARD
% Hamilton County Surveyor, Courthouse, Noblesville, IN 46060

In the matter of Hayden Run Subdivision, Section Two Drain
Petition.

Petitioner is the owner of all lots in the land affected by the proposed new regulated drain. The drainage will affect various lots in Hayden Run, Sec. 2 a subdivision in Hamilton County, Indiana. The general route of such drainage shall be in existing easements and along public roads as shown in the plans on file in the Surveyor's Office.

Petitioner believes that the cost, damages and expenses of the proposed improvement will be less than the benefits which will result to the owners of the land likely to be benefitted thereby. Petitioner believes the proposed improvements will:

- (a) improve public health
- (b) benefit a public street
- (c) be of public utility

Petitioner agrees to pay the cost of construction of the drainage system and requests periodic maintenance assessments by the Board thereafter.

The Petitioner also agrees to the following:

1. To provide the Drainage Board a Performance Bond for the portion of the drainage system which will be made a regulated drain. The bond will be in the amount of 100% of the Engineers estimate. The bond will be in effect until construction of 100% of the system is completed and so certified by the Engineer.
2. The Petitioner shall retain an Engineer throughout the construction phase. At completion of the project the Petitioner's Engineer shall certify that the drainage system which is to be maintained as a regulated drain has been constructed as per construction plans.

FILED
MAY 29 2002

176

3. The Petitioner agrees to request in writing to the County Surveyor any changes from the approved plan and must receive written authorization from the County Surveyor prior to implementation of the change. All changes shall be documented and given to the Surveyor to be placed in the Drain File.
4. The Petitioner shall instruct his Engineer to provide a reproducible print on a 24" x 36" mylar of the final design of the Drainage System. This shall be submitted to the County Surveyor prior to the release of the Performance Bond.
5. The Petitioner shall comply with the Erosion Control Plan as specified on the construction plans. Failure to comply with the Erosion Control Plan shall be determined by the Board as being an obstruction to the drainage system. The County Surveyor shall immediately install or repair the needed measures at Petitioner cost as per IC 36-9-27-46.

The Petitioner further requests that the Drain be classified as an Urban Drain.

Thomas L. Kutz, LAND DEVELOPMENT MANAGER

Printed Name

Thomas L. Kutz

Signed Centex Homes, A Nevada General Partnership
By: Centex Real Estate Corporation
A Nevada Corporation
Its: Managing General Partner

Printed Name

RECORDED OWNER(S) OF LAND INVOLVED

DATE 5-24-02

HCDB 2003-00007

SUBDIVISION BOND

Bond No. 6200099

KNOW ALL MEN BY THESE PRESENTS, that we CENTEX HOMES, A Nevada General Partnership

as Principal, and SAFECO INSURANCE COMPANY OF AMERICA

authorized to do business in the State of Indiana, as Surety, are held and firmly bound unto Hamilton
County Board of Commissioners, Indianapolis, IN

as Obligee, in the penal sum of Seventy Nine Thousand Eight Hundred Ninety One and 79/100 -----
----- (\$ 79,891.79) DOLLARS, lawful money of
the United States of America, for the payment of which well and truly to be made, we bind ourselves, our heirs, executors,
administrators, successors and assigns, jointly and severally, firmly by these presents.

WHEREAS, CENTEX HOMES, A Nevada General Partnership

has agreed to construct in Hayden Run Section 2

the following improvements: Storm Sewer

NOW, THEREFORE, THE CONDITION OF THIS OBLIGATION IS SUCH, that if the said Principal shall
construct, or have constructed, the improvements herein described and shall save the Obligee harmless from any loss, cost or
damage by reason of its failure to complete said work, then this obligation shall be null and void; otherwise to remain in full
force and effect.

Signed, sealed and dated this 6th day of March, 2003.

CENTEX HOMES, A Nevada General Partnership

Principal

By: *[Signature]*

SAFECO INSURANCE COMPANY OF AMERICA

By: *[Signature]*

ALLYSON DEAN

Attorney-in-Fact

HCDB 2003-00008

SUBDIVISION BOND

Bond No. 6200100

KNOW ALL MEN BY THESE PRESENTS, that we CENTEX HOMES, A Nevada General Partnership

as Principal, and SAFECO INSURANCE COMPANY OF AMERICA

authorized to do business in the State of Indiana, as Surety, are held and firmly bound unto Hamilton
County Board of Commissioners, Indianapolis, IN

as Obligee, in the penal sum of Six Thousand Eight Hundred Eighty Two and 34/100 -----
----- (\$ 6,882.34) DOLLARS, lawful money of
the United States of America, for the payment of which well and truly to be made, we bind ourselves, our heirs, executors,
administrators, successors and assigns, jointly and severally, firmly by these presents.

WHEREAS, CENTEX HOMES, A Nevada General Partnership
has agreed to construct in Hayden Run Section 2

the following improvements: Erosion Control

NOW, THEREFORE, THE CONDITION OF THIS OBLIGATION IS SUCH, that if the said Principal shall
construct, or have constructed, the improvements herein described and shall save the Obligee harmless from any loss, cost or
damage by reason of its failure to complete said work, then this obligation shall be null and void; otherwise to remain in full
force and effect.

Signed, sealed and dated this 6th day of March, 2003.

CENTEX HOMES, A Nevada General Partnership
Principal

By: *[Signature]*

SAFECO INSURANCE COMPANY OF AMERICA

By: *[Signature]*
ALLYSON DEAN Attorney-in-Fact

SUBDIVISION BOND

HCPB-2003-0009

Bond No. 6200101

KNOW ALL MEN BY THESE PRESENTS, that we CENTEX HOMES, A Nevada General Partnership

as Principal, and SAFECO INSURANCE COMPANY OF AMERICA

authorized to do business in the State of Indiana, as Surety, are held and firmly bound unto Hamilton County Board of Commissioners, Indianapolis, IN

as Obligee, in the penal sum of One Thousand Two Hundred and 00/100 -----
----- (\$ 1,200.00) DOLLARS, lawful money of
the United States of America, for the payment of which well and truly to be made, we bind ourselves, our heirs, executors, administrators, successors and assigns, jointly and severally, firmly by these presents.

WHEREAS, CENTEX HOMES, A Nevada General Partnership
has agreed to construct in Hayden Run Section 2

the following improvements: Monuments and Markers

NOW, THEREFORE, THE CONDITION OF THIS OBLIGATION IS SUCH, that if the said Principal shall construct, or have constructed, the improvements herein described and shall save the Obligee harmless from any loss, cost or damage by reason of its failure to complete said work, then this obligation shall be null and void; otherwise to remain in full force and effect.

Signed, sealed and dated this 6th day of March, 2003.

CENTEX HOMES, A Nevada General Partnership
Principal
By: [Signature]

SAFECO INSURANCE COMPANY OF AMERICA
By: [Signature]
ALLYSON DEAN Attorney-in-Fact

No. 7386

KNOW ALL BY THESE PRESENTS:

That **SAFECO INSURANCE COMPANY OF AMERICA** and **GENERAL INSURANCE COMPANY OF AMERICA**, each a Washington corporation, does each hereby appoint
*****LAWRENCE W. WALDIE; CARMEN MIMS; BRIAN M. LEBOW; DEBORAH GRIFFITH; ALLYSON DEAN; BRIDGETTE S. JACKSON; Dallas, Texas*****

its true and lawful attorney(s)-in-fact, with full authority to execute on its behalf fidelity and surety bonds or undertakings and other documents of a similar character issued in the course of its business, and to bind the respective company thereby.

IN WITNESS WHEREOF, SAFECO INSURANCE COMPANY OF AMERICA and **GENERAL INSURANCE COMPANY OF AMERICA** have each executed and attested these presents

this 1st day of June, 2001

R.A. Pierson

R.A. PIERSON, SECRETARY

Mike McGavick

MIKE MCGAVICK, PRESIDENT

CERTIFICATE

Extract from the By-Laws of **SAFECO INSURANCE COMPANY OF AMERICA**
and of **GENERAL INSURANCE COMPANY OF AMERICA:**

"Article V, Section 13. - FIDELITY AND SURETY BONDS ... the President, any Vice President, the Secretary, and any Assistant Vice President appointed for that purpose by the officer in charge of surety operations, shall each have authority to appoint individuals as attorneys-in-fact or under other appropriate titles with authority to execute on behalf of the company fidelity and surety bonds and other documents of similar character issued by the company in the course of its business... On any instrument making or evidencing such appointment, the signatures may be affixed by facsimile. On any instrument conferring such authority or on any bond or undertaking of the company, the seal, or a facsimile thereof, may be impressed or affixed or in any other manner reproduced; provided, however, that the seal shall not be necessary to the validity of any such instrument or undertaking."

Extract from a Resolution of the Board of Directors of **SAFECO INSURANCE COMPANY OF AMERICA**
and of **GENERAL INSURANCE COMPANY OF AMERICA** adopted July 28, 1970.

"On any certificate executed by the Secretary or an assistant secretary of the Company setting out,
(i) The provisions of Article V, Section 13 of the By-Laws, and
(ii) A copy of the power-of-attorney appointment, executed pursuant thereto, and
(iii) Certifying that said power-of-attorney appointment is in full force and effect,
the signature of the certifying officer may be by facsimile, and the seal of the Company may be a facsimile thereof."

I, R.A. Pierson, Secretary of **SAFECO INSURANCE COMPANY OF AMERICA** and of **GENERAL INSURANCE COMPANY OF AMERICA**, do hereby certify that the foregoing extracts of the By-Laws and of a Resolution of the Board of Directors of these corporations, and of a Power of Attorney issued pursuant thereto, are true and correct, and that both the By-Laws, the Resolution and the Power of Attorney are still in full force and effect.

IN WITNESS WHEREOF, I have hereunto set my hand and affixed the facsimile seal of said corporation

this 6TH day of MARCH, 2003



R.A. Pierson

R.A. PIERSON, SECRETARY

FINDINGS AND ORDER


CONCERNING THE MAINTENANCE OF THE

J. W. Brendle Drain, Hayden Run Section 2

On this *28th day of July, 2003*, the Hamilton County Drainage Board has held a hearing on the Maintenance Report and Schedule of Assessments of the *J. W. Brendle Drain, Hayden Run Section 2*.

Evidence has been heard. Objections were presented and considered. The Board then adopted the original/amended Schedule of Assessments. The Board now finds that the annual maintenance assessment will be less than the benefits to the landowners and issues this order declaring that this Maintenance Fund be established.


HAMILTON COUNTY DRAINAGE BOARD

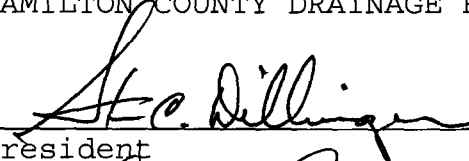

President



Member

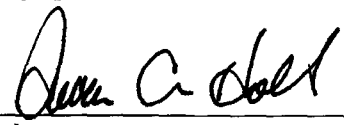

Member

Attest: 



CONSULTING ENGINEERS
LAND SURVEYORS

R.M. Stoepelwerth, PE, PLS • David J. Stoepelwerth, PE, PLS • Curtis C. Huff, PLS • Dennis D. Olmstead, PLS • Jeffery W. Darling, PLS

CERTIFICATE OF COMPLETION AND COMPLIANCE

To: Hamilton County Surveyor

Re: Hayden Run, Section Two

I hereby certify that:

1. I am a Registered Land Surveyor or Engineer in the State of Indiana.
2. I am familiar with the plans and specifications for the above referenced subdivision.
3. I have personally observed and supervised the completion of the drainage facilities for the above referenced subdivision.
4. The drainage facilities within the above referenced subdivision to the best of my knowledge, information and belief have been installed and completed in conformity with all plans and specifications.

Signature: Jeffery W. Darling Date: October 13, 2003

Type or Print Name: Jeffery W. Darling

Business Address: Stoepelwerth & Associates, Inc.
9940 Allisonville Road, Fishers, Indiana 46038

Telephone Number: (317) 849-5935

SEAL


INDIANA REGISTRATION NUMBER



900017

S/40605/Notice



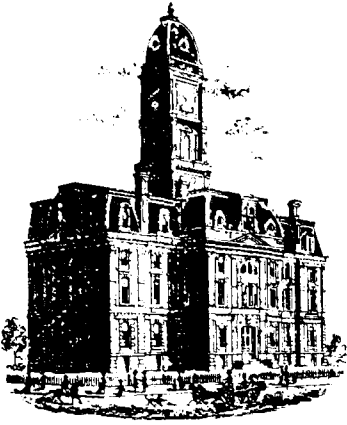

SURVEYOR'S OFFICE

Hamilton County

Kenton C. Ward, Surveyor

Phone (317) 776-8495

Fax (317) 776-9628

Suite 188

One Hamilton County Square

Noblesville, Indiana 46060-2230

To: Hamilton County Drainage Board

March 16, 2006

Re: JW Brendle Drain: Hayden Run Section 2 Arm

Attached are as-builts, certificate of completion & compliance, and other information for Hayden Run Section 2. An inspection of the drainage facilities for this section has been made and the facilities were found to be complete and acceptable.

During construction, changes were made to the drain, which will alter the plans submitted with my report for this drain-dated June 26, 2003. The report was approved by the Board at the hearing held July 28, 2003. (See Drainage Board Minutes Book 7, Pages 108-109)
The changes are as follows:

Structure:	Length:	Size	Material:	Up Invert:	Dn Invert	Grade:	Changes:
131-130	151	12	RCP	904.85	904.24	0.4	
130-129	43	12	RCP	904.24	903.67	1.33	
129-128	145	12	RCP	903.67	902.26	0.97	
128-127	148	12	RCP	902.26	900.09	1.47	-1
127-126	126	18	RCP	900.09	899.6	0.39	-1
126-125	36	30	RCP	899.6	899.46	0.39	
125-124	182	30	RCP	899.46	898.96	0.27	1
124-123	30	30	RCP	898.96	898.84	0.4	
123-122	289	30	RCP	898.84	895.57	1.13	-1
134-133	241	21	RCP	902.5	900.57	0.8	1
133-132	30	21	RCP	900.57	900.24	1.1	
132-126	144	27	RCP	900.24	899.06	0.44	

RCP Pipe Totals:

12	487
18	126
21	271
27	144
30	537

Total: 1565

6" SSD Streets:

Reedy Ct	525.5
Tuscany Blvd	536.5

Totalx2: 2124

Other Drain:

12" Plastic Tile	90
------------------	----

Total: 90

The length of the drain due to the changes described above is now **3,779 feet**.

The non-enforcement was approved by the Board at its meeting on July 28, 2003 and recorded under instrument #200600013845.


The following sureties were guaranteed by SAFECO Insurance Company and released by the Board on its November 28, 2005 meeting.

Bond-LC No: 6200099
Insured For: Storm Sewers
Amount: \$79,891.79
Issue Date: March 6, 2003

Bond-LC No: 6200100
Insured For: Erosion Control
Amount: \$6,882.34
Issue Date: March 6, 2003


I recommend the Board approve the drain's construction as complete and acceptable.

Sincerely,

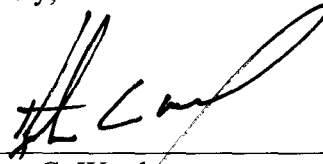

Kenton C. Ward,
Hamilton County Surveyor

KCW/slm

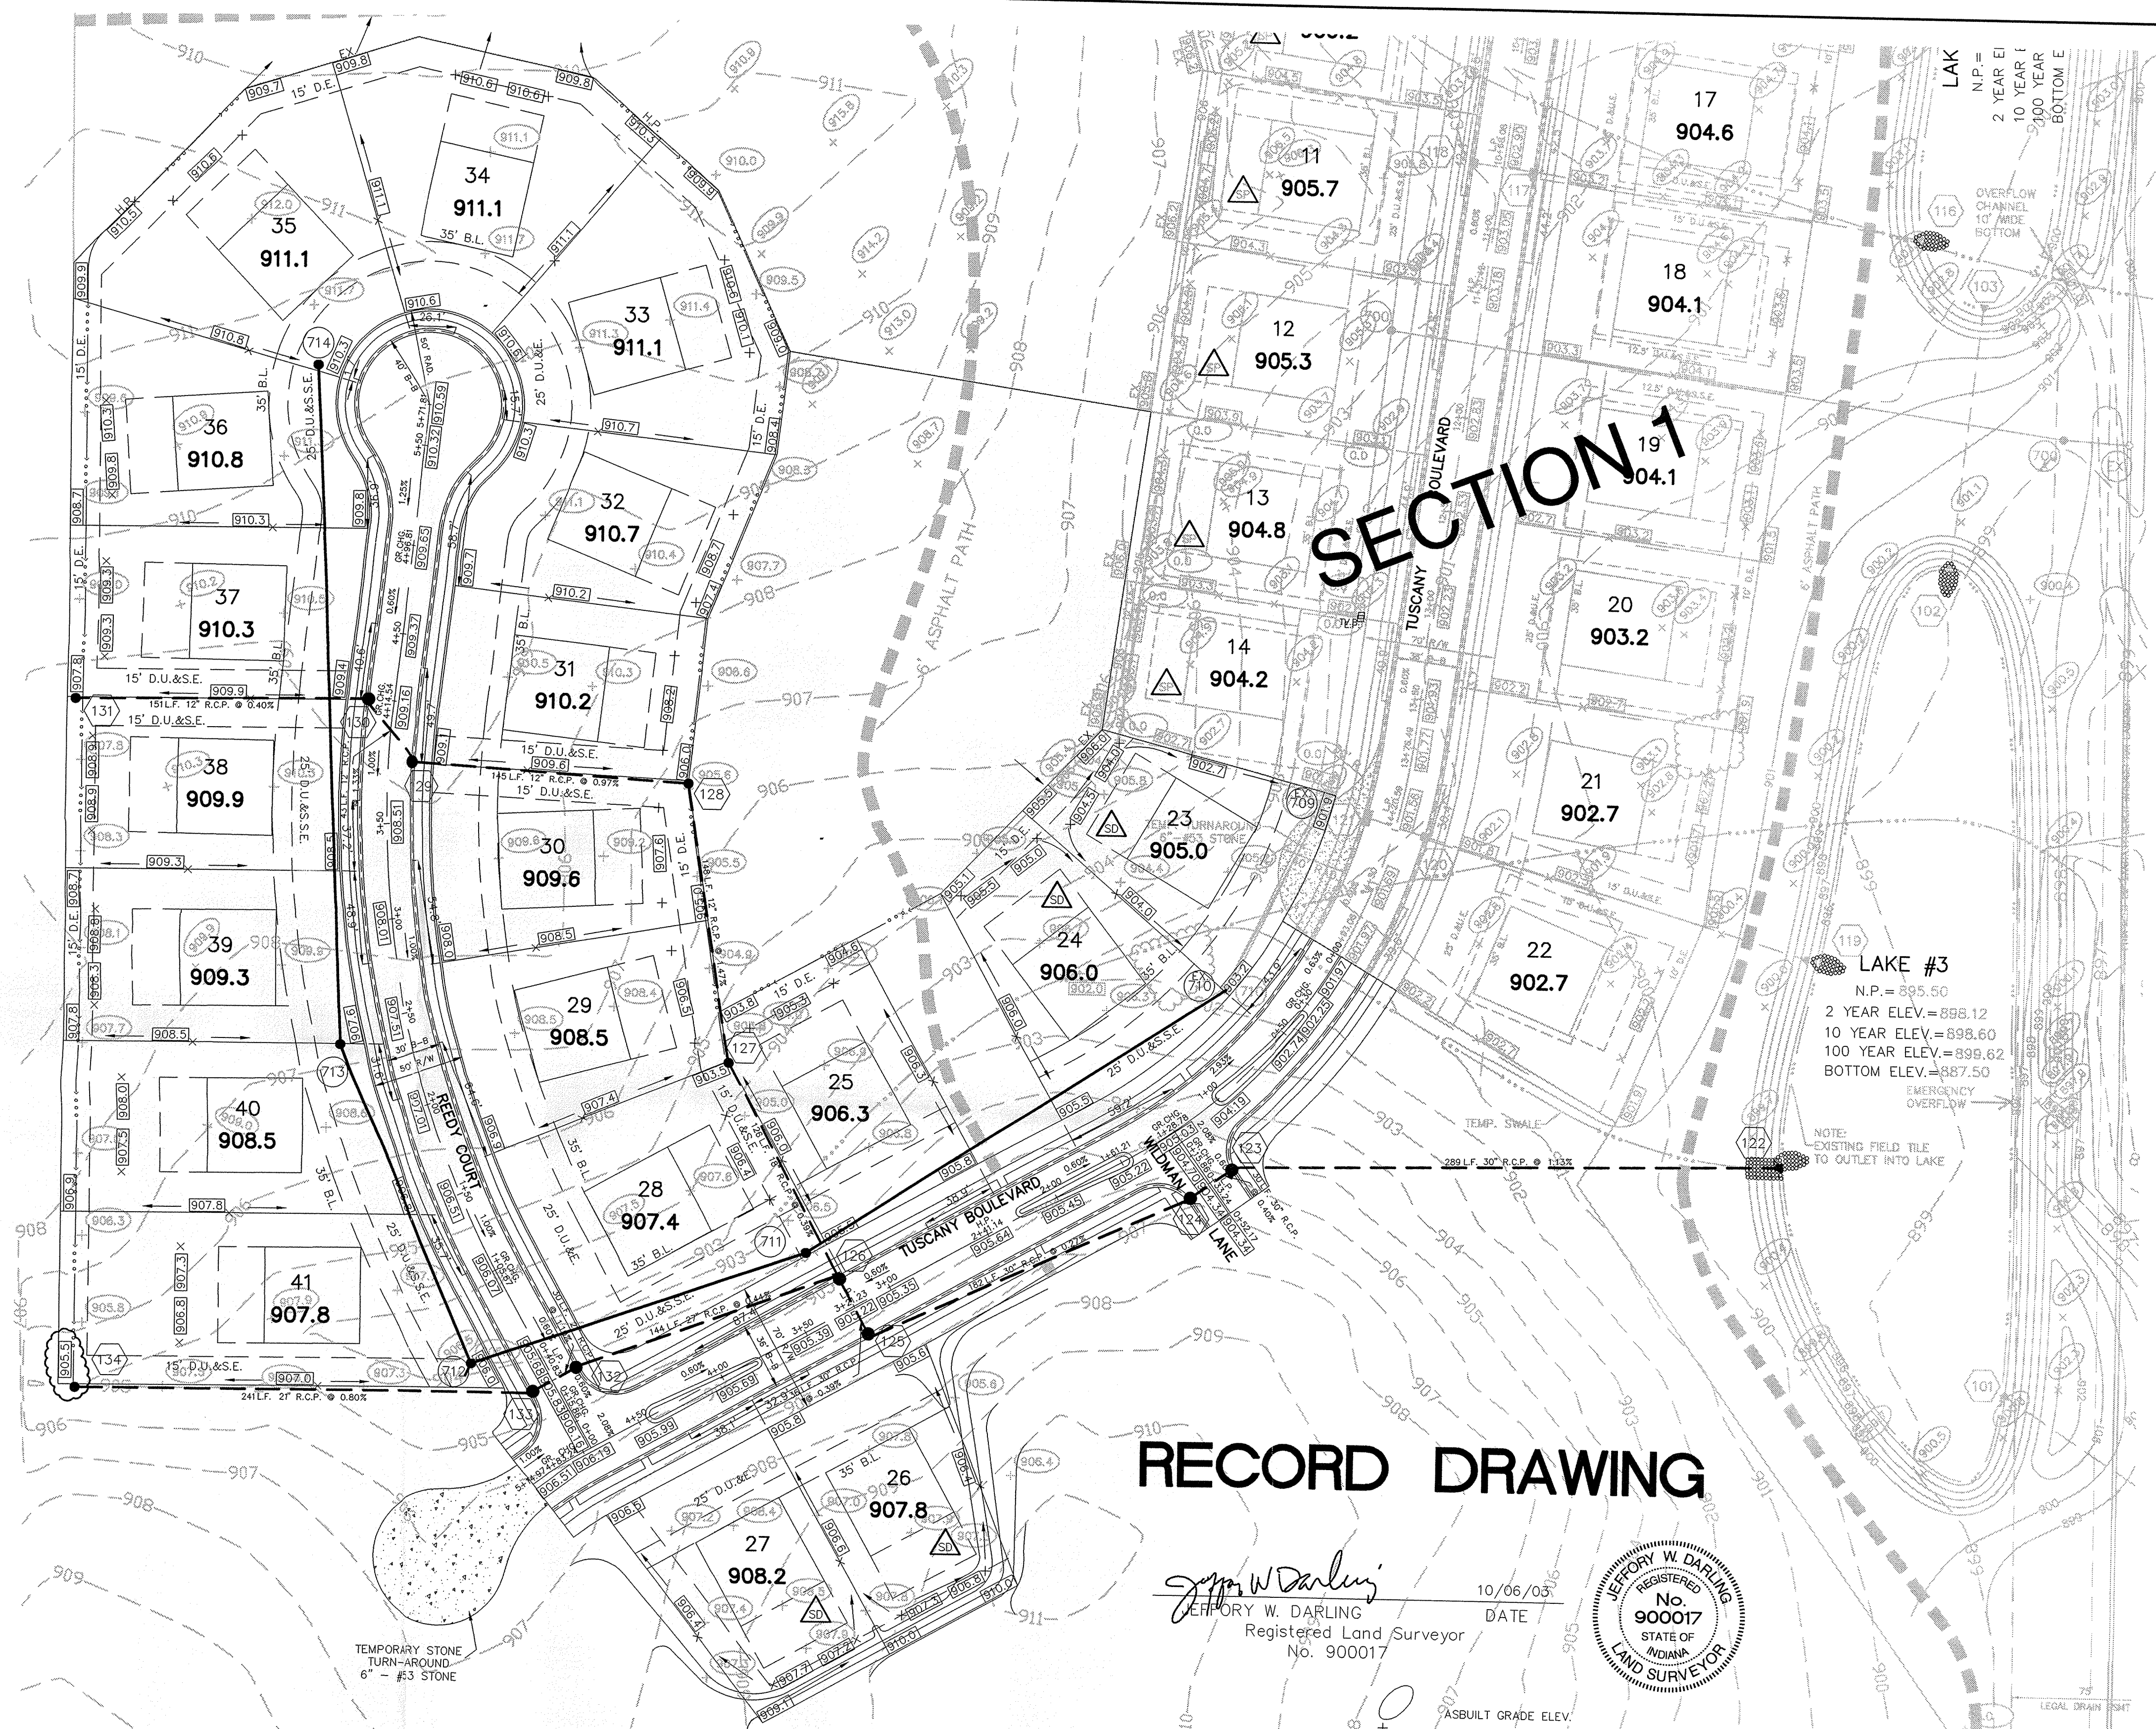

SCALE: 1" = 50'

LEGEND

- 848 — EXISTING CONTOUR
- 848 — EXISTING SANITARY SEWER
- 848 — EXISTING STORM SEWER
- 848 — PROPOSED GRADE
- 848 — PROPOSED CONTOUR
- 848 — PROPOSED SANITARY SEWER
- 848 — PROPOSED STORM SEWER
- 848 — PROPOSED SWALE
- 848 — PROPOSED 4" SIDEWALK (BY HOME BUILDER)

11
905.7
LOT NUMBER

PAD ELEVATION
PAD SIZE 50'x55'
HOUSE TO BE EXTENDED BACK TO 75'
SPECIAL DRAINAGE (FROM REAR OF LOT TO FRONT AROUND HOUSE.)

— 848 — DENOTES 4" SUBSURFACE DRAIN TO LOT
— 848 — DENOTES 6" SUBSURFACE DRAIN

— 848 — ROLL CURB

NOTE:
ALL OFF-SITE DRAIN TILES SHALL BE TIED INTO THE PROPOSED STORM SYSTEM OF THIS SECTION (WHERE APPLICABLE)

NOTE: DECORATIVE SIGNS, SPRINKLER SYSTEMS, TREES, LANDSCAPING MOUNDS, LIGHT POLES, OR OTHER SUCH AMENITIES ARE NOT PERMITTED IN THE RIGHT OF WAY.

ALL PADS SHOULD BE TESTED TO ASSURE A COMPACTION OF AT LEAST 95% OF THE MAXIMUM DRY DENSITY USING THE STANDARD PROCTOR TEST METHOD.

- EARTHWORK:**
1. EXCAVATION
 - A. Excavated material that is suitable may be used for fills. All unsuitable material and all surplus excavated material not required shall be removed from the site.
 - B. Provide and place any additional fill material from offsite as may be necessary to produce the grades required on plans. Fill obtained from offsite shall be of quality as specified for fills herein and the source approved by the Developer. It will be the responsibility of the Contractor for any costs for fill needed.
 2. REMOVAL OF TREES
 - A. All trees and stumps from area to be occupied by a road surface area and building pad. Trees and stumps shall not be buried on site.
 3. PROTECTION OF TREES
 - A. The Contractor shall, at the direction of the Developer, endeavor to save and protect trees of value and worth which do not impair construction of improvements as designed.
 - B. In the event cut or fill exceeds 0.5 foot over the root area, the Developer shall be consulted with respect of protective measure to be taken, if any, to preserve such trees.
 4. REMOVAL OF TOPSOIL
 - A. All topsoil shall be removed from all areas to be excavated. Topsoil should be stored at a location where it will not interfere with construction operations. The topsoil shall be free of debris and stones.
 5. UTILITIES
 - A. Rules and regulation governing the respective utility shall be observed in executing all work under this section.
 - B. It shall be the responsibility of the Contractor to determine the location of existing underground utilities 2 working days prior to commencing work. For utility locations to be marked call Toll Free 1-800-382-5544 within Indiana or 1-800-428-5200 outside Indiana.
 6. SITE GRADING
 - A. Do all cutting, filling, compacting of fills and rough grading required to bring entire project area to subgrade as shown on the drawing.
 - B. The tolerance for paved areas shall not exceed 0.05 feet above established subgrade. All other areas shall not exceed 0.05 feet plus or minus the established grade. Provide roundings at top and bottom of banks and other breaks in grade.
 - C. The Engineer shall be notified when the Contractor has reached the tolerance as stated above, so that field measurements and spot elevations can be verified by the Engineer. The Contractor shall not remove his equipment from the site until the Engineer has verified that the job meets the above tolerance.

RECORD DRAWING

Jeffery W. Darling
JEFFERY W. DARLING
Registered Land Surveyor
No. 900017

10/06/05
DATE




STORM TABLE

Str. No.	Type	Tc/Rim	Inverts	Dir.
122	CONCRETE END SECTION		895.50	(E)
123	CURB INLET W/MANHOLE	904.50	898.88	(W)
124	CURB INLET W/MANHOLE	904.50	898.88	(W)
125	CURB INLET W/MANHOLE	905.20	899.58	(NW/NE)
126	CURB INLET W/MANHOLE	905.20	899.58	(SE/SW)
127	YARD INLET	900.00	900.00	(NW/SE)
128	YARD INLET	906.00	902.22	(W/SE)
129	CURB INLET W/MANHOLE	908.86	903.67	(NW/E)
130	CURB INLET W/MANHOLE	909.16	904.09	(SE/W)
131	YARD INLET	907.80	904.80	(E)
132	CURB INLET W/MANHOLE	905.65	900.20	(NE/SW)
133	CURB INLET W/MANHOLE	905.65	900.50	(W/NE)
134	YARD INLET	905.50	902.42	(E)

NOTE: SIDEWALK ADJACENT TO COMMON AREA TO BE INSTALLED BY CONTRACTOR.

NOTE: CHAIRBACK CURB WITH REVERSE SLOPE MUST BE USED AROUND ALL ISLANDS.

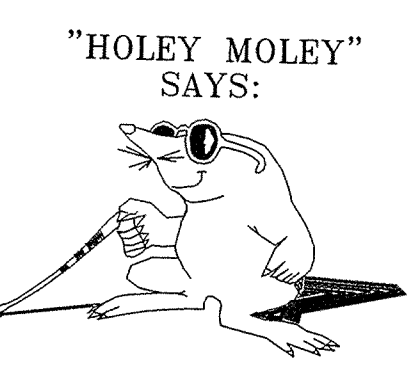

"HOLEY MOLEY" SAYS:
1-800-382-5544
CALL TOLL FREE
1-800-428-5200
FOR CALLS OUTSIDE OF INDIANA


CAUTION
LOCATION OF ALL EXISTING UNDERGROUND UTILITIES SHOWN ON THIS PLAN ARE BASED UPON ABOVE GROUND EVIDENCE. (including, but not limited to, manholes, inlets, valves, & marks made upon the ground by others.) AND ARE SPECULATIVE IN NATURE. THERE MAY ALSO BE OTHER EXISTING UNDERGROUND UTILITIES FOR WHICH THERE IS NO ABOVE GROUND EVIDENCE OR FOR WHICH NO ABOVE GROUND EVIDENCE WAS OBSERVED. THE EXACT LOCATIONS OF SAID EXISTING UNDERGROUND UTILITIES SHOULD BE VERIFIED BY THE CONTRACTOR PRIOR TO ANY AND ALL CONSTRUCTION.

BENCHMARKS:

T.B.M.#1 (S&A) - NAIL SET @ S. SIDE, TEL. POLE ON THE S. SIDE OF 131ST APPROX. 70'± W OF W PROPERTY LINE 1.5' UP FROM GROUND.
ELEV. = 916.10

T.B.M.#2 (S&A) - NAIL SET @ W. SIDE OF PWR POLE ON THE S. SIDE OF 131ST APPROX. 130'± E. OF E. PROPERTY LINE 1.5' UP FROM GROUND. POLE #55-125
ELEV. = 906.04

S&A CP (M4) - REBAR SET @ S. SIDE OF 131ST APPROX. 300'± E. OF W. PROPERTY LINE.
ELEV. = 911.65

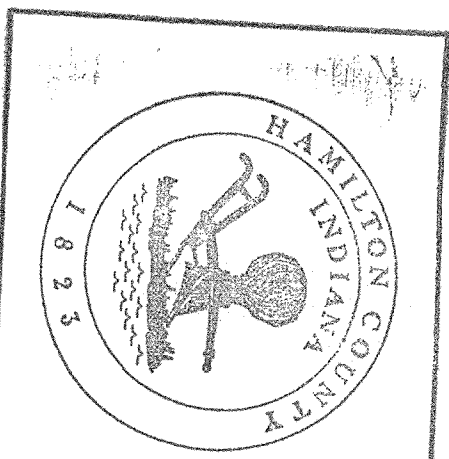

Emy Date: 1-12-05
5171

This information was gathered for input into the Hamilton County Geographic Information System. Only Geographical Information System data considered an official record of this GIS.

CONSULTING ENGINEERS - LAND SURVEYORS
(317) 849-5935 1-800-728-6917 FAX: (317) 849-5942

INDIANAPOLIS INDIANA

SITE DEVELOPMENT PLAN
HAYDEN RUN SECTION 2

INDIANAPOLIS INDIANA


CARMEL

SHEET NO. **3**
OF 15 SHEETS
JOB NO. 40605

DATE	REVISIONS	BY
1/12/04	REVISED AS BUILT PER CO. SURVEYOR	
10/06/05	AS-BUILTS	
6/7/03	REVISED STORM 126-134 PER DEVELOPER	
6/7/02	REVISED CAL DE SAC TO 40'	


CERTIFIED: *David J. Stapp*

REGISTERED PROFESSIONAL ENGINEER
No. 19358
STATE OF INDIANA

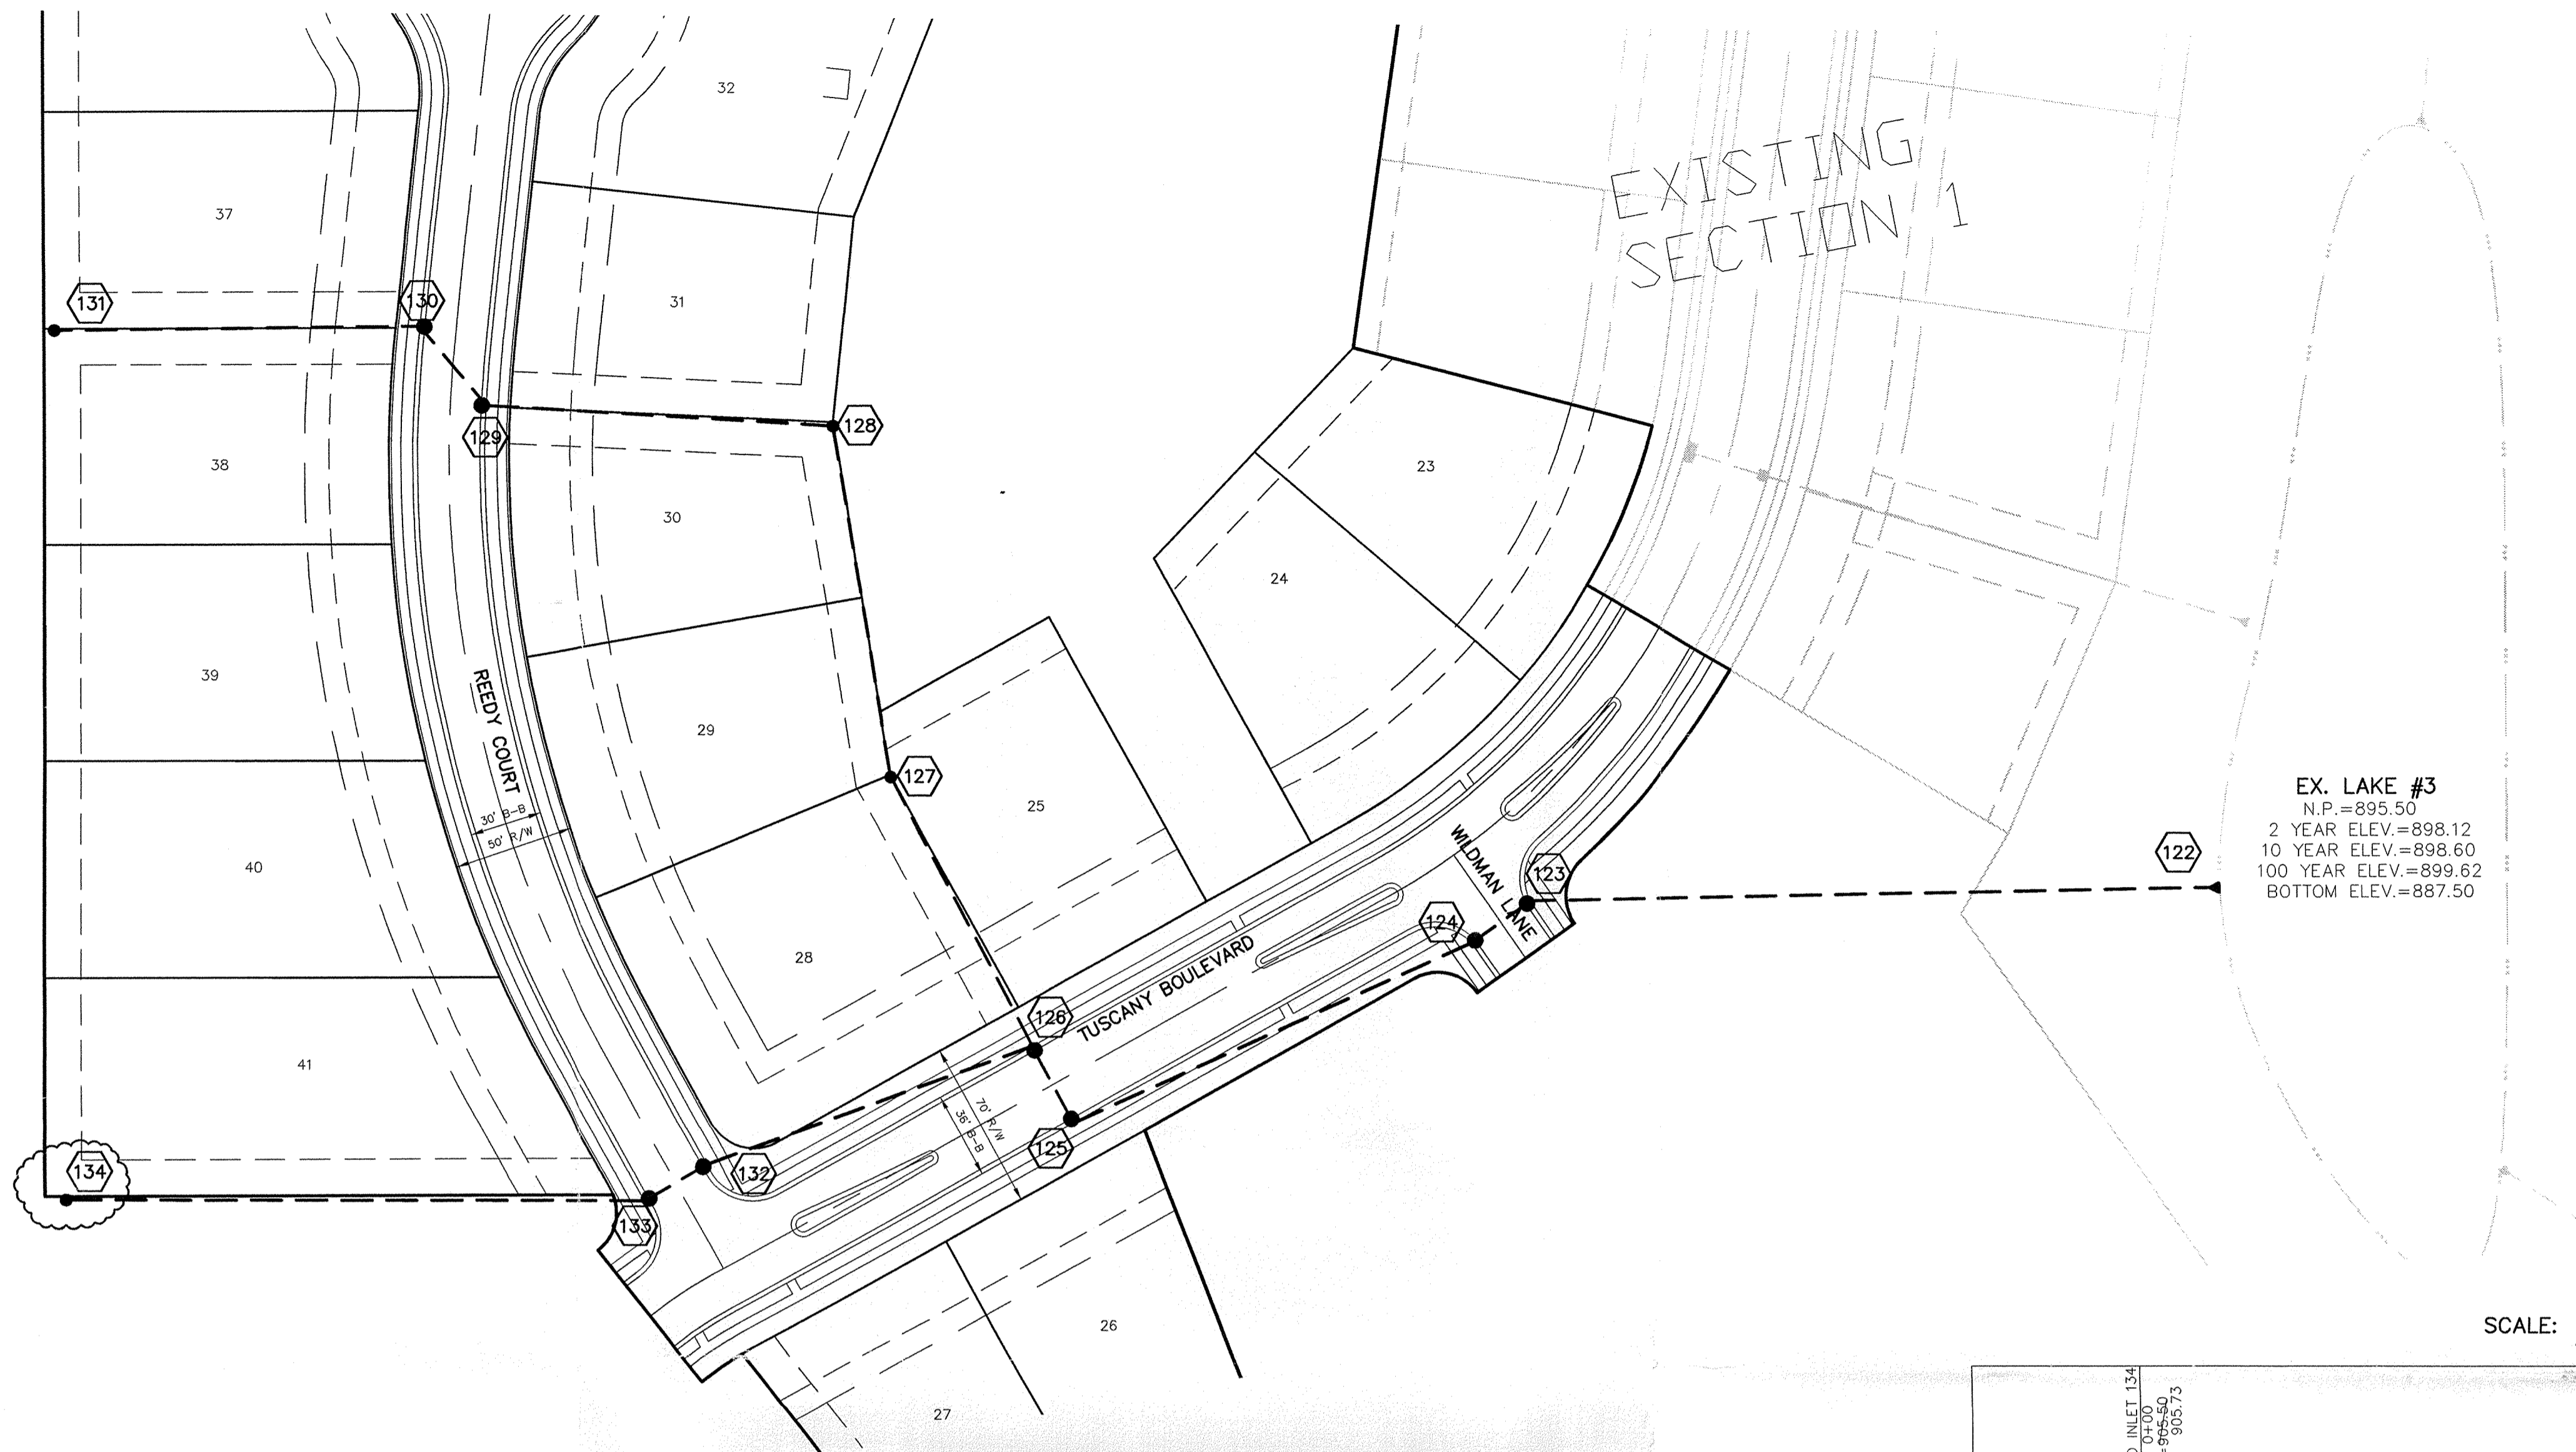

EX. LAKE #3
 N.P.=895.50
 2 YEAR ELEV.=898.12
 10 YEAR ELEV.=898.60
 100 YEAR ELEV.=899.62
 BOTTOM ELEV.=887.50

SCALE: 1" = 50'

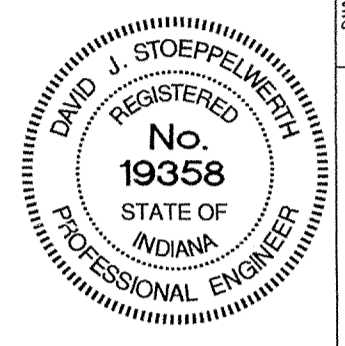

OWN BY	DATE	REVISIONS
DAVID J. STOPPELMEIER	5/7/02	
DATE	MARK	BY
5/7/02		
DATE	MARK	BY
5/7/02		
DATE	MARK	BY
5/7/02		
DATE	MARK	BY
5/7/02		

CERTIFIED: 5/7/02
 CONSULTING ENGINEERS - LAND SURVEYORS
 (317) 849-5935 1-800-728-6917 FAX: (317) 849-5942
 INDIANAPOLIS INDIANA



STORM SEWER PLAN & PROFILE
 HAYDEN RUN SECTION 2
 CARMEL INDIANA




This information was gathered for input into the Hamilton County Geographical Information System. This document is considered an official record of the GIS.
 Entry Date: 1-13-04
 Entered by: SLM

RECORD DRAWING

Jeffery W. Darling
 JEFFERY W. DARLING
 Registered Land Surveyor
 No. 900017
 DATE 10/06/03



SCALE: 1" = 50' HOR.
 1" = 5' VERT.

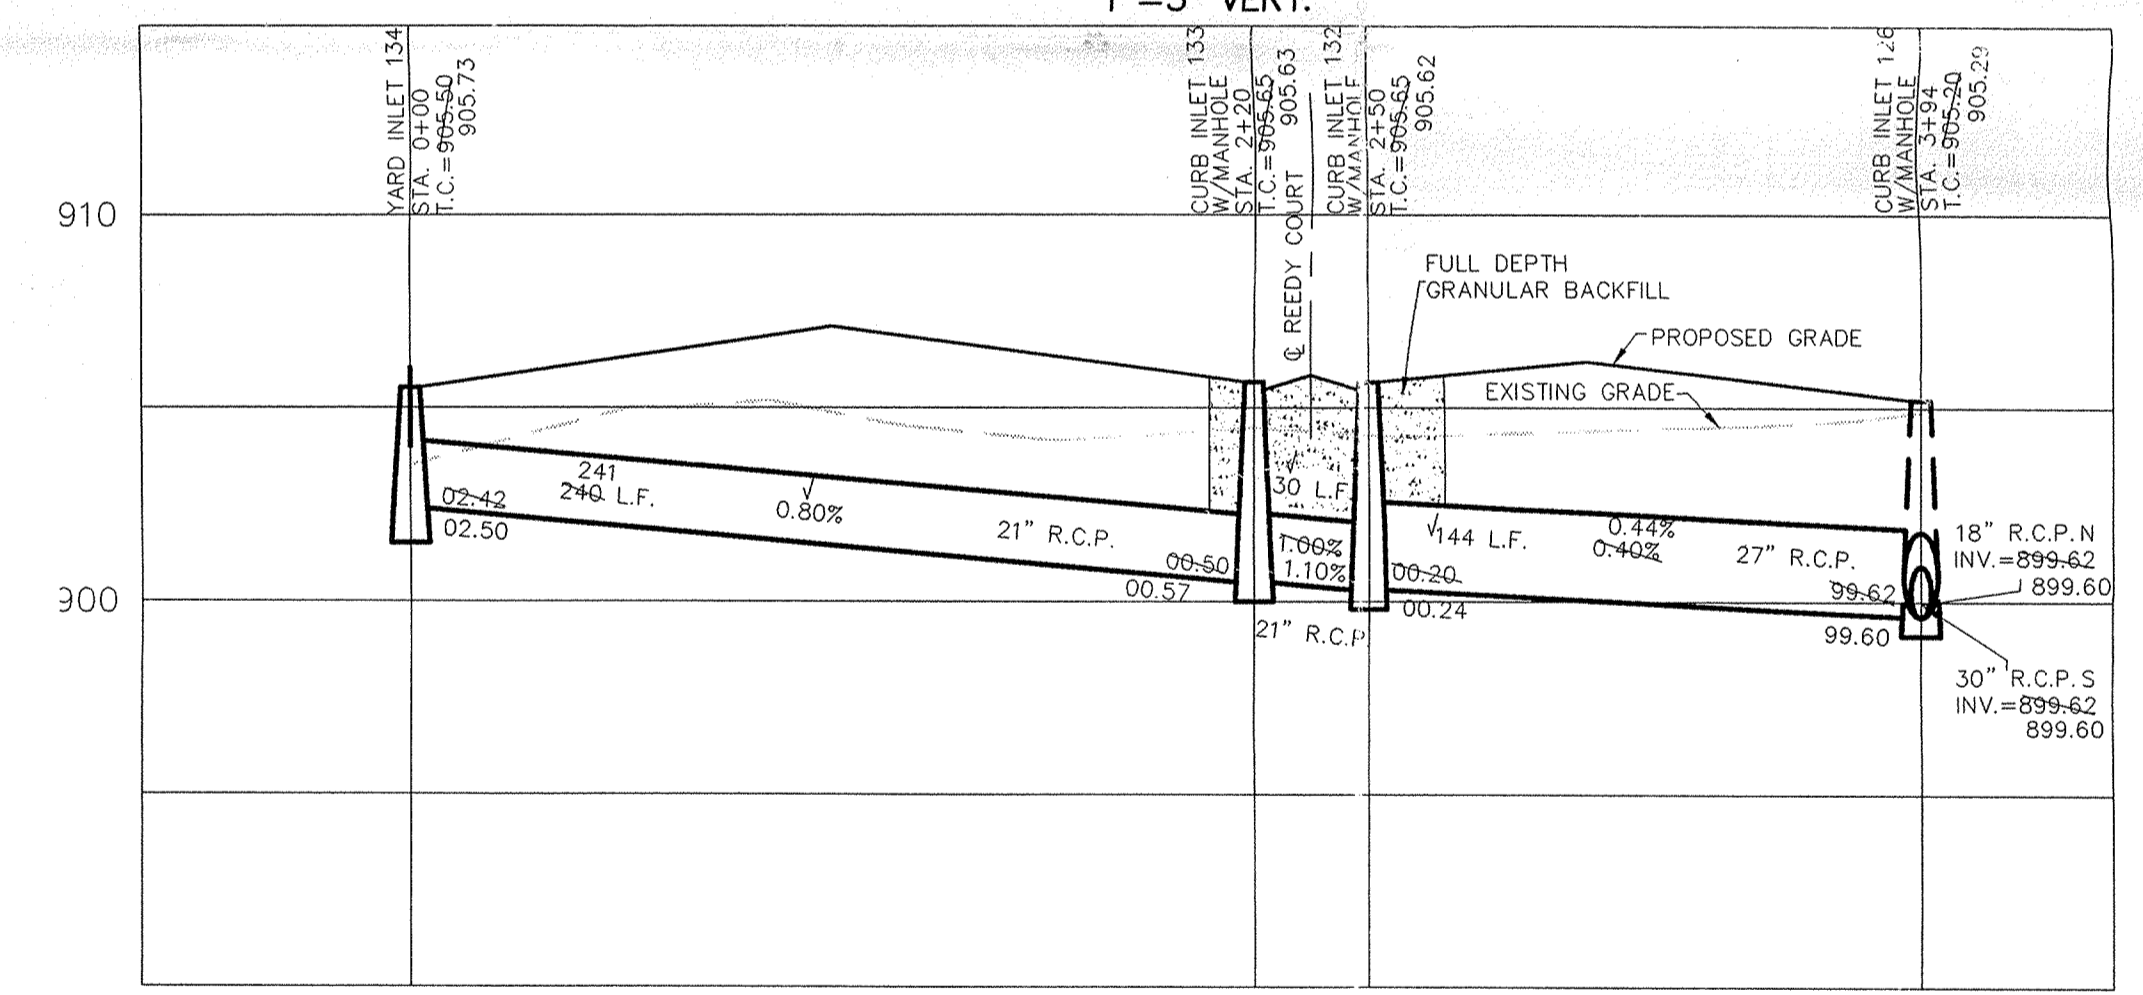

SCALE: 1" = 50' HOR.
 1" = 5' VERT.

