



SURVEYOR'S OFFICE

Hamilton County

Kenton C. Ward, CFM
 Surveyor of Hamilton County
 Phone (317) 776-8495
 Fax (317) 776-9628

Suite 188
 One Hamilton County Square
 Noblesville, Indiana 46060-2230

To: Hamilton County Drainage Board

September 26, 2007

Re: JW Brendle Drain: Trails at Hayden Run

Attached are as-builts, certificate of completion & compliance, and other information for Trails at Hayden Run. An inspection of the drainage facilities for this section has been made and the facilities were found to be complete and acceptable.

During construction, changes were made to the drain, which will alter the plans submitted with my report for this drain-dated October 11, 2005. The report was approved by the Board at the hearing held January 23, 2006. (See Drainage Board Minutes Book 9, Pages 22-24)
 The changes are as follows:

Structure:	Length:	Size	Material:	Up Invert:	Dn Invert	Grade:	Changes:
109-108	52	30	RCP	914.61	914.52	0.17	2
111-110	214	30	RCP	914.98	914.65	0.15	
109-106	30	12	RCP	915.61	915.43	0.6	
106-105	151	18	RCP	915.43	915.2	0.15	1
105-105a	78	18	RCP	915.2	914.14	0.33	-1
145-144	30	12	RCP	915.76	915.65	0.37	
144-143	216	15	RCP	915.65	914.99	0.31	
100A-EX	66	15	RCP	914.13	914.32	0.26	2
100-100A	40	15	RCP	914.32	914.48	0.4	
104-103	45	15	RCP	914.92	914.78	0.31	1
103-102	52	18	RCP	914.78	914.61	0.32	
102-101	58	18	RCP	914.61	914.47	0.24	-1
115-114	125	12	RCP	916.4	915.73	0.53	
113-112	221	21	RCP	915.65	915.07	0.28	
119-118	151	12	RCP	916.5	915.89	0.4	-1
117-116	256	18	RCP	915.76	914.96	0.31	1
120-118	37	12	RCP	916.1	915.89	0.56	
124-123	121	12	RCP	916.04	915.69	0.29	1
123-122	33	15	RCP	915.69	915.55	0.42	1
122-121	217	18	RCP	915.55	914.96	0.27	1
130-129	118	12	RCP	916.64	916.36	0.24	-2
129-128	58	15	RCP	916.36	916.28	0.14	

128-127	120	18	RCP	916.26	915.95	0.23	
127-126	172	18	RCP	915.95	915.45	0.29	2
126-125	97	18	RCP	915.45	914.81	0.66	4
131-128	30	12	RCP	916.35	916.28	0.23	
138-137	123	24	RCP	916.65	916.14	0.41	1
136-135	56	27	RCP	916.08	915.89	0.34	2
135-134	137	27	RCP	915.89	915.53	0.26	1
134-133	192	30	RCP	915.53	915.25	0.15	1
133-132	107	30	RCP	915.25	914.9	0.33	
139-140	30	12	RCP	916.81	916.49	1.07	
140-137	117	12	RCP	916.49	916.14	0.3	2
142B-142A	113	12	RCP	916.2	915.87	0.29	1
142A-142	33	12	RCP	915.77	915.73	0.3	1
142-141	149	18	RCP	915.73	915.25	0.32	-1
109-110	30	24" X 38"	ERCP	914.65	914.61	0.13	
114-113	32	14" X 23'	ERCP	915.73	915.68	0.16	
118-117	49	14" X 23"	ERCP	915.89	915.76	0.27	-1
137-136	30	19" X 30"	ERCP	916.14	916.08	0.2	
142-141	30	14" X 23"	ERCP	915.71	915.73	0.13	

6" SSD Streets:

Brandt Ln	1071
Traham Dr	158.5
Winings Ln	940.5
Langham Dr.	756.5
Ferrell Dr	928
Framingham Ln	186.5
Barlow Dr	240.5
x2	

Total: 8563

6" SSD Lots:

LOTS 4-5	200
----------	-----

Total: 200

Other Drain:

ERCP	171
------	-----

Total: 171

RCP Pipe Totals:

12	935
15	458
18	1350
21	221
24	123
27	193
30	565

Total: 3845

The length of the drain due to the changes described above is now **12,779 feet**.

The non-enforcement was approved by the Board at its meeting on January 23, 2006 and recorded under instrument #200600004928.


The following sureties were guaranteed by National City Bank and released by the Board on its January 9, 2006 meeting.

Bond-LC No: SCL011175
Insured For: Storm Sewers
Amount: \$211,168.00
Issue Date: June 10, 2005

Bond-LC No: SCL011172
Insured For: Subsurface Drains
Amount: \$50,603.00
Issue Date: June 10, 2005

I recommend the Board approve the drain's construction as complete and acceptable.


Sincerely,

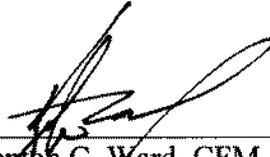A handwritten signature in black ink, appearing to read 'K. Ward', written over a horizontal line.

Kenton C. Ward, CFM
Hamilton County Surveyor


KCW/slm

THE TRAILS AT HAYDEN RUN

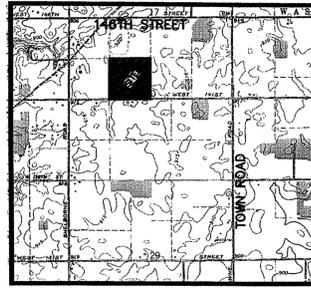

VICINITY MAP
NOT TO SCALE

Developed by:
EQUICOR COMPANIES
9011 NORTH MERIDIAN STREET
SUITE 202
INDIANAPOLIS, IN 46260
(317)573-8100
FAX (317)573-9100

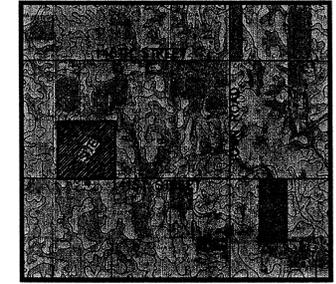


SOILS MAP
NOT TO SCALE

SOILS MAP

SHT.	INDEX DESCRIPTION
C001	COVER SHEET
C100&C101	TOPOGRAPHICAL SURVEY
C200	SITE DEVELOPMENT PLAN
C300-C301	STORMWATER POLLUTION & PREVENTION PLAN & SPECS
C400-C409	STREET PLAN & PROFILES / ENTRANCE PLAN & INTERSECTION DETAILS / TRAFFIC CONTROL / TRAFFIC MAINTENANCE / TRAFFIC WIDENING / TRAFFIC DETAILS
C500-C503	SANITARY SEWER PLAN & PROFILES
C600-C603	STORM SEWER PLAN & PROFILES
C700&C701	WATER PLANS
C800-C804	CONSTRUCTION DETAILS SANITARY STORM STREET LANDSCAPE PLANS

- Mm1 Miami silt loam, 0-2 % slopes- This nearly level, deep, well drained soil is on slight rises on uplands. Permeability is moderate in the subsoil and the substratum. Available water capacity is high. The main soil features that adversely affect engineering uses of this soil are moderate potential for frost action, moderate permeability, and moderate shrink-swell potential. This soil has severe limitations for local roads and streets. The base material needs to be strengthened with suitable material.
- Cro1 Crosby silt loam, 0-3 percent slopes- this soil is light colored, silty in texture and on sloping uplands. It is deep and somewhat poorly drained with slow permeability. It has high available water for plant growth and medium organic matter content. The soil has compact till starting at a depth between 20 -40 inches. The main soil features that affect urban development uses are seasonal high water table, moderate shrink-swell potential, high potential frost action and slow permeability.
- B1 Brookston silty clay loam- this soil is dark colored, silty in texture and on depositional uplands. It is deep and very poorly drained with moderate permeability. It has high available water for plant growth and high organic matter content. It has compact till starting at a depth of 40 to 60 inches. The main soil features that affect the urban development uses are seasonal high water table, high potential frost action, moderate shrink-swell potential, moderate permeability and ponded surface water.
- Mm2 Miami silt loam, 2-6 percent slopes- this soil is light colored, silty in texture and on sloping uplands. It is deep and well drained with moderate permeability. It has moderate available water for plant growth and a medium organic matter content. It has compact till starting at a depth between 20-40 inches. The main soil features that adversely affect urban development uses are moderate potential frost action, moderate shrink-swell potential, moderately slow permeability, low strength and erosion during construction.
- Mm2c Miami silt loam, 6-12 % slopes severely eroded- this moderately sloping, deep well drained soil is on knolls and knolls along streams and drainage ways on uplands. Permeability is moderate in the subsoil and moderately slow in the substratum. This soil is suitable for urban development. The main soil features that adversely affect the engineering uses of this soil are moderate potential frost action, moderate shrink-swell potential, and moderately slow permeability. The hazard of erosion is high during construction.
- Fx3 Fox loam, 8 to 18 % slopes, severely eroded- This moderate sloping, well-drained soil is on side slopes adjacent to drainageways on terraces and in terraced areas on uplands. It is moderately deep over sand and gravelly sand. Permeability is moderate in the subsoil and rapid in the underlying material. Available water capacity is low. This soil has moderate limitations for urban development (Shrink). Features that adversely affect engineering uses of this soil are moderate frost action, moderate shrink-swell potential, moderate permeability in the subsoil and very rapid permeability in the under lying material. Topsoil should be stockpiled for use in exposed areas.
- We Westland silty clay loam - This nearly level, deep, very poorly drained soil is in depressions, swales, and narrow drainageways on outwash plains. Runoff from higher adjacent soils is ponded on this soil. Permeability is slow. The water table is commonly at the surface or is at a depth of less than one foot in winter and early spring. Available water capacity is high. Surface runoff is ponded or is very slow. The main soil features that adversely affect engineering uses of this soil are a seasonal high water table, high potential frost action, moderate shrink-swell potential, and slow permeability. The base material for roads needs to be replaced or strengthened with suitable material.
- Oa1 Oakley silt loam, 0-2 % slopes- This nearly level, deep well drained soil is mainly on broad terraces. Permeability and available water capacity is moderate. This soil is suitable for urban development. Features that adversely affect engineering uses of this soil are moderate frost action, moderate shrink-swell potential, moderate permeability in the subsoil and very rapid permeability in the under lying material.
- Oa2 Oakley silt loam, 2-6 % slope, eroded- This gently sloping, deep well drained soil is mainly on broad terraces. Permeability and available water capacity is moderate. This soil is suitable for urban development. Features that adversely affect engineering uses of this soil are moderate frost action, moderate shrink-swell potential, moderate permeability in the subsoil and very rapid permeability in the under lying material. This soil has severe limitations for local roads because of low strength. The base material of roads needs to be strengthened with suitable material.

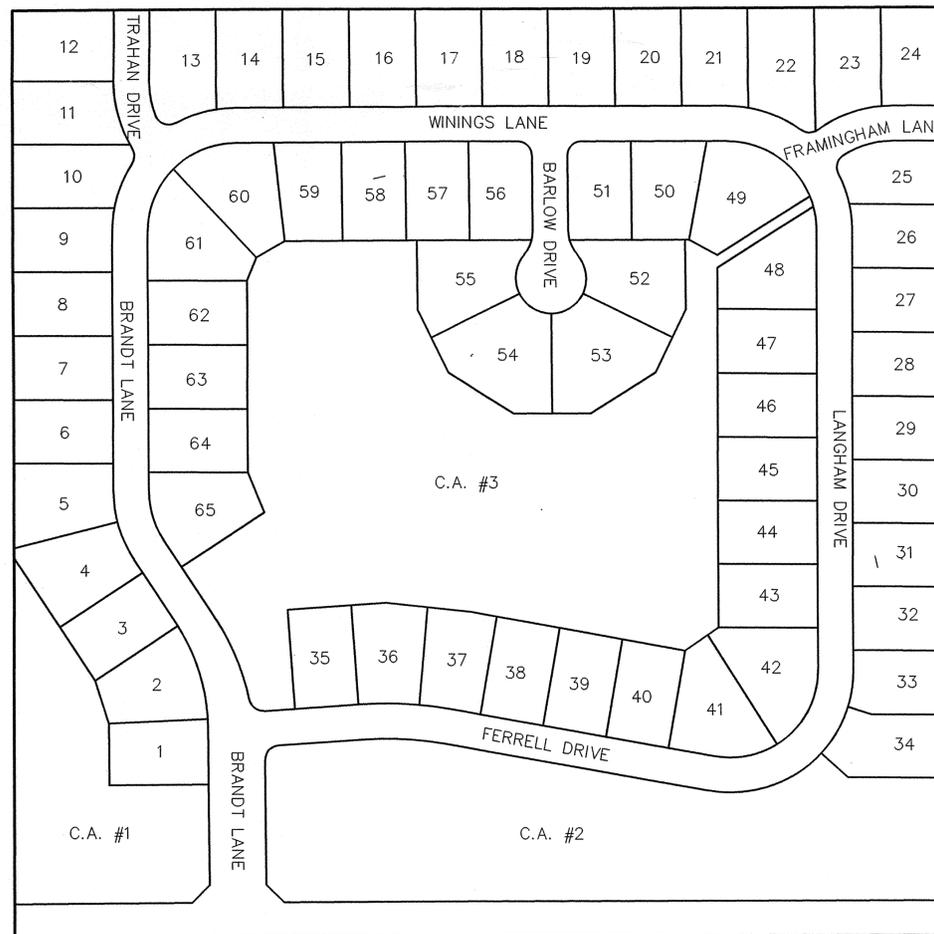


RECORD DRAWING

Jeffery W. Darling
JEFFERY W. DARLING
Registered Land Surveyor
No. 900017

9/23/05
DATE



This information was gathered for input into the Hamilton County Geographic Information System (GIS). This document is considered an official record of the GIS.
Entry Date: 8-28-07
Entered By: SLM

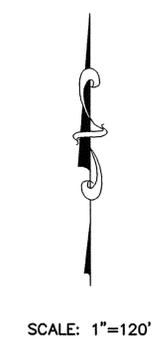

SCALE: 1"=120'

SECTION 1 DESIGN DATA


65 LOTS	= 1.62 LOTS/ACRE
40.033 AC.	
STREET A	1154.18 L.F.
STREET B	943.11 L.F.
STREET C	218.50 L.F.
STREET D	256.56 L.F.
STREET E	216.57 L.F.
STREET F	858.65 L.F.
STREET G	810.15 L.F.

PLANS PREPARED BY:

STOEPPELWERTH & ASSOCIATES, INC.
CONSULTING ENGINEERS & LAND SURVEYORS
9940 ALLISONVILLE ROAD FISHERS, INDIANA 46038
PHONE: (317)-849-5935
FAX: (317)-849-5942

PLANS CERTIFIED BY:

David J. Stoepfelwerth
DAVID J. STOEPPELWERTH DATE 6/1/04
PROFESSIONAL ENGINEER
NO. 19358

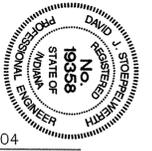

SHT.	REVISIONS DESCRIPTION
ALL	REV. PER AGENCY COMMENTS 2/17/05 ZJM
ALL	REV. PER TAC COMMENTS 3/14/05 TWF
ALL	REV. PER TAC COMMENTS 4/14/05 ZJM
ALL	REV. PER COMMENTS 5/17/05 TWF & WAB
ALL	ADD APPROVED STREET NAMES 6/22/05 TWF
ALL	AS-BUILTS 10/25/05 SEG

LEGEND

- EXISTING EDGE OF WOODS
- EXISTING CONTOUR
- EXISTING SANITARY SEWER
- EXISTING STORM SEWER
- PROPOSED GRADE
- MATCH EXISTING
- PROPOSED CONTOUR
- PROPOSED SANITARY SEWER
- PROPOSED STORM SEWER
- PROPOSED SWALE
- PROPOSED 5' SIDEWALK (BY HOME BUILDER) (DEVELOPER SHALL INSTALL SIDEWALKS ALONG ALL COMMON AREAS)
- LOT NUMBER
- PAD ELEVATION
- PAD SIZE: 60'X70' (UNLESS OTHERWISE NOTED)
- PROPOSED 6" UNDERDRAINS
- DENOTES 4" SUBSURFACE DRAIN TO LOT
- DENOTES 6" SUBSURFACE DRAIN
- ROLL CURB

100 874.1

ALL PADS SHOULD BE TESTED TO ASSURE A COMPACTION OF AT LEAST 95 PERCENT OF THE MAXIMUM DRY DENSITY USING THE STANDARD PROCTOR TEST METHOD.

ALL EXISTING OFF-SITE DRAIN TILES THAT ARE ENCOUNTERED SHALL BE TIED INTO THE PROPOSED STORM SEWER SYSTEM WITH A POSITIVE OUTFLOW

- D.U.&S.E. DRAINAGE, UTILITY & SANITARY SEWER EASEMENT
D.U.S.E. DRAINAGE UTILITY & SEWER EASEMENT
D.U.E. DRAINAGE & UTILITY EASEMENT
L.M.A.E. LANDSCAPE, MAINTENANCE ACCESS EASEMENT
S.L.E. SIGN LANDSCAPE EASEMENT
D.E. DRAINAGE EASEMENT
B.S.L. BUILDING SETBACK LINE
N.R. NON RADIAL
N.A.E. NON ACCESS EASEMENT
P.A.E. PUBLIC ACCESS EASEMENT
T.P.E. TREE PRESERVATION EASEMENT
R/W RIGHT OF WAY
C.A. COMMON AREA
- BENCHMARKS**
- S&A TBM #1
1.0'± UP FROM GROUND ON EAST SIDE ELECTRIC POLE. PWP #74-693
10TH POLE FROM TOWNE ROAD ON S. SIDE OF 146TH STREET.
ELEV.=919.28

NOTE TO CONTRACTOR:
CONTRACTOR SHALL VERIFY DEPTHS OF ALL EXISTING ONSITE UTILITIES PRIOR TO CONSTRUCTION TO CONFIRM THERE IS NOT ANY CONFLICTS WITH OTHER UTILITIES, STORM SEWERS OR STREETS. CONFLICTS AFTER CONSTRUCTION BEGINS ARE SOLELY THE CONTRACTOR'S RESPONSIBILITY.

RECORD DRAWING

Jeffery W. Darling
JEFFERY W. DARLING
Registered Land Surveyor
No. 900017


10/21/05
DATE



STR. NO.	TYPE	LOC. / DIM.	INVERT	DIRECTION
100	CONCRETE END SECTION	919.30	914.40	SW
101	MANHOLE	919.30	914.50	W
102	CONCRETE END SECTION	919.30	914.50	W
103	CURB INLET	919.26	914.67	W
104	YARD INLET	918.00	915.45	W
105	YARD INLET	918.00	915.45	W
106	CONCRETE END SECTION	918.57	915.00	N
107	DR. CURB INLET	918.57	915.52	S
108	CONCRETE END SECTION	918.57	915.00	N
109	CURB INLET	918.66	914.50	N&S
110	CURB INLET	918.66	915.00	N&S
111	CONCRETE END SECTION	918.66	915.00	W
112	CONCRETE END SECTION	919.10	915.00	W
113	CURB INLET	919.10	915.50	SE&W
114	DR. CURB INLET	919.10	915.66	SE&W
115	CURB INLET	919.20	915.00	NE
116	CONCRETE END SECTION	919.20	915.00	NW
117	CURB INLET	919.30	915.90	SE&W
118	CONCRETE END SECTION	919.30	916.42	SW
119	CONCRETE END SECTION	919.30	915.00	N
120	CURB INLET	919.50	915.50	SE&W
121	CURB INLET	919.50	915.78	SE&W
122	CONCRETE END SECTION	919.50	915.00	NE
123	CONCRETE END SECTION	919.50	915.34	SW&E
124	CURB INLET	919.50	916.80	NE&SW
125	CONCRETE END SECTION	919.50	916.75	W
126	MANHOLE	919.50	916.80	W
127	CURB INLET	919.50	916.80	NE&SW
128	CURB INLET	919.50	916.80	NE&SW
129	CONCRETE END SECTION	919.50	916.75	W
130	CONCRETE END SECTION	919.50	916.31	SW
131	CURB INLET	919.50	916.31	SW
132	CONCRETE END SECTION	919.50	915.70	SW&E
133	YARD INLET	919.00	915.50	SE&W
134	YARD INLET	919.00	915.50	SE&W
135	MANHOLE	920.50	915.89	SE&W
136	CURB INLET	919.50	915.89	SE&W
137	CURB INLET	919.50	916.19	S&NW
138	CONCRETE END SECTION	920.35	916.74	S
139	CURB INLET	920.35	916.80	SW
140	CURB INLET	920.35	916.71	SE&W
141	DR. CURB INLET	919.11	915.03	SE&W
142	DR. CURB INLET	919.11	915.69	SE&W
143	CURB INLET	919.20	915.00	SE&W
144	MANHOLE	919.70	915.78	NW&E
145	CONCRETE END SECTION	919.12	915.12	W
146	CURB INLET	919.11	915.68	E&W
147	CURB INLET	919.11	915.77	E&W
200	MANHOLE	918.00	912.23	N&SE
201	MANHOLE	921.40	912.69	W
202	MANHOLE	917.20	913.12	E

"HOLEY MOLEY" SAYS:
CAUTION
LOCATION OF ALL EXISTING UNDERGROUND UTILITIES SHOWN ON THIS PLAN ARE BASED UPON ABOVE GROUND EVIDENCE, INCLUDING, BUT NOT LIMITED TO, MANHOLES, TIE-INS, VALVES, METER BOXES, AND OTHER ABOVE GROUND UTILITIES. THERE MAY ALSO BE OTHER EXISTING UNDERGROUND UTILITIES FOR WHICH THERE IS NO ABOVE GROUND EVIDENCE OR FOR WHICH NO ABOVE GROUND EVIDENCE WAS OBSERVED. THE EXACT LOCATION OF ANY EXISTING UNDERGROUND UTILITIES SHOULD BE VERIFIED BY THE CONTRACTOR PRIOR TO ANY AND ALL CONSTRUCTION.

1-800-382-5544
1-800-428-5200
FOR CALLS OUTSIDE OF INDIANA

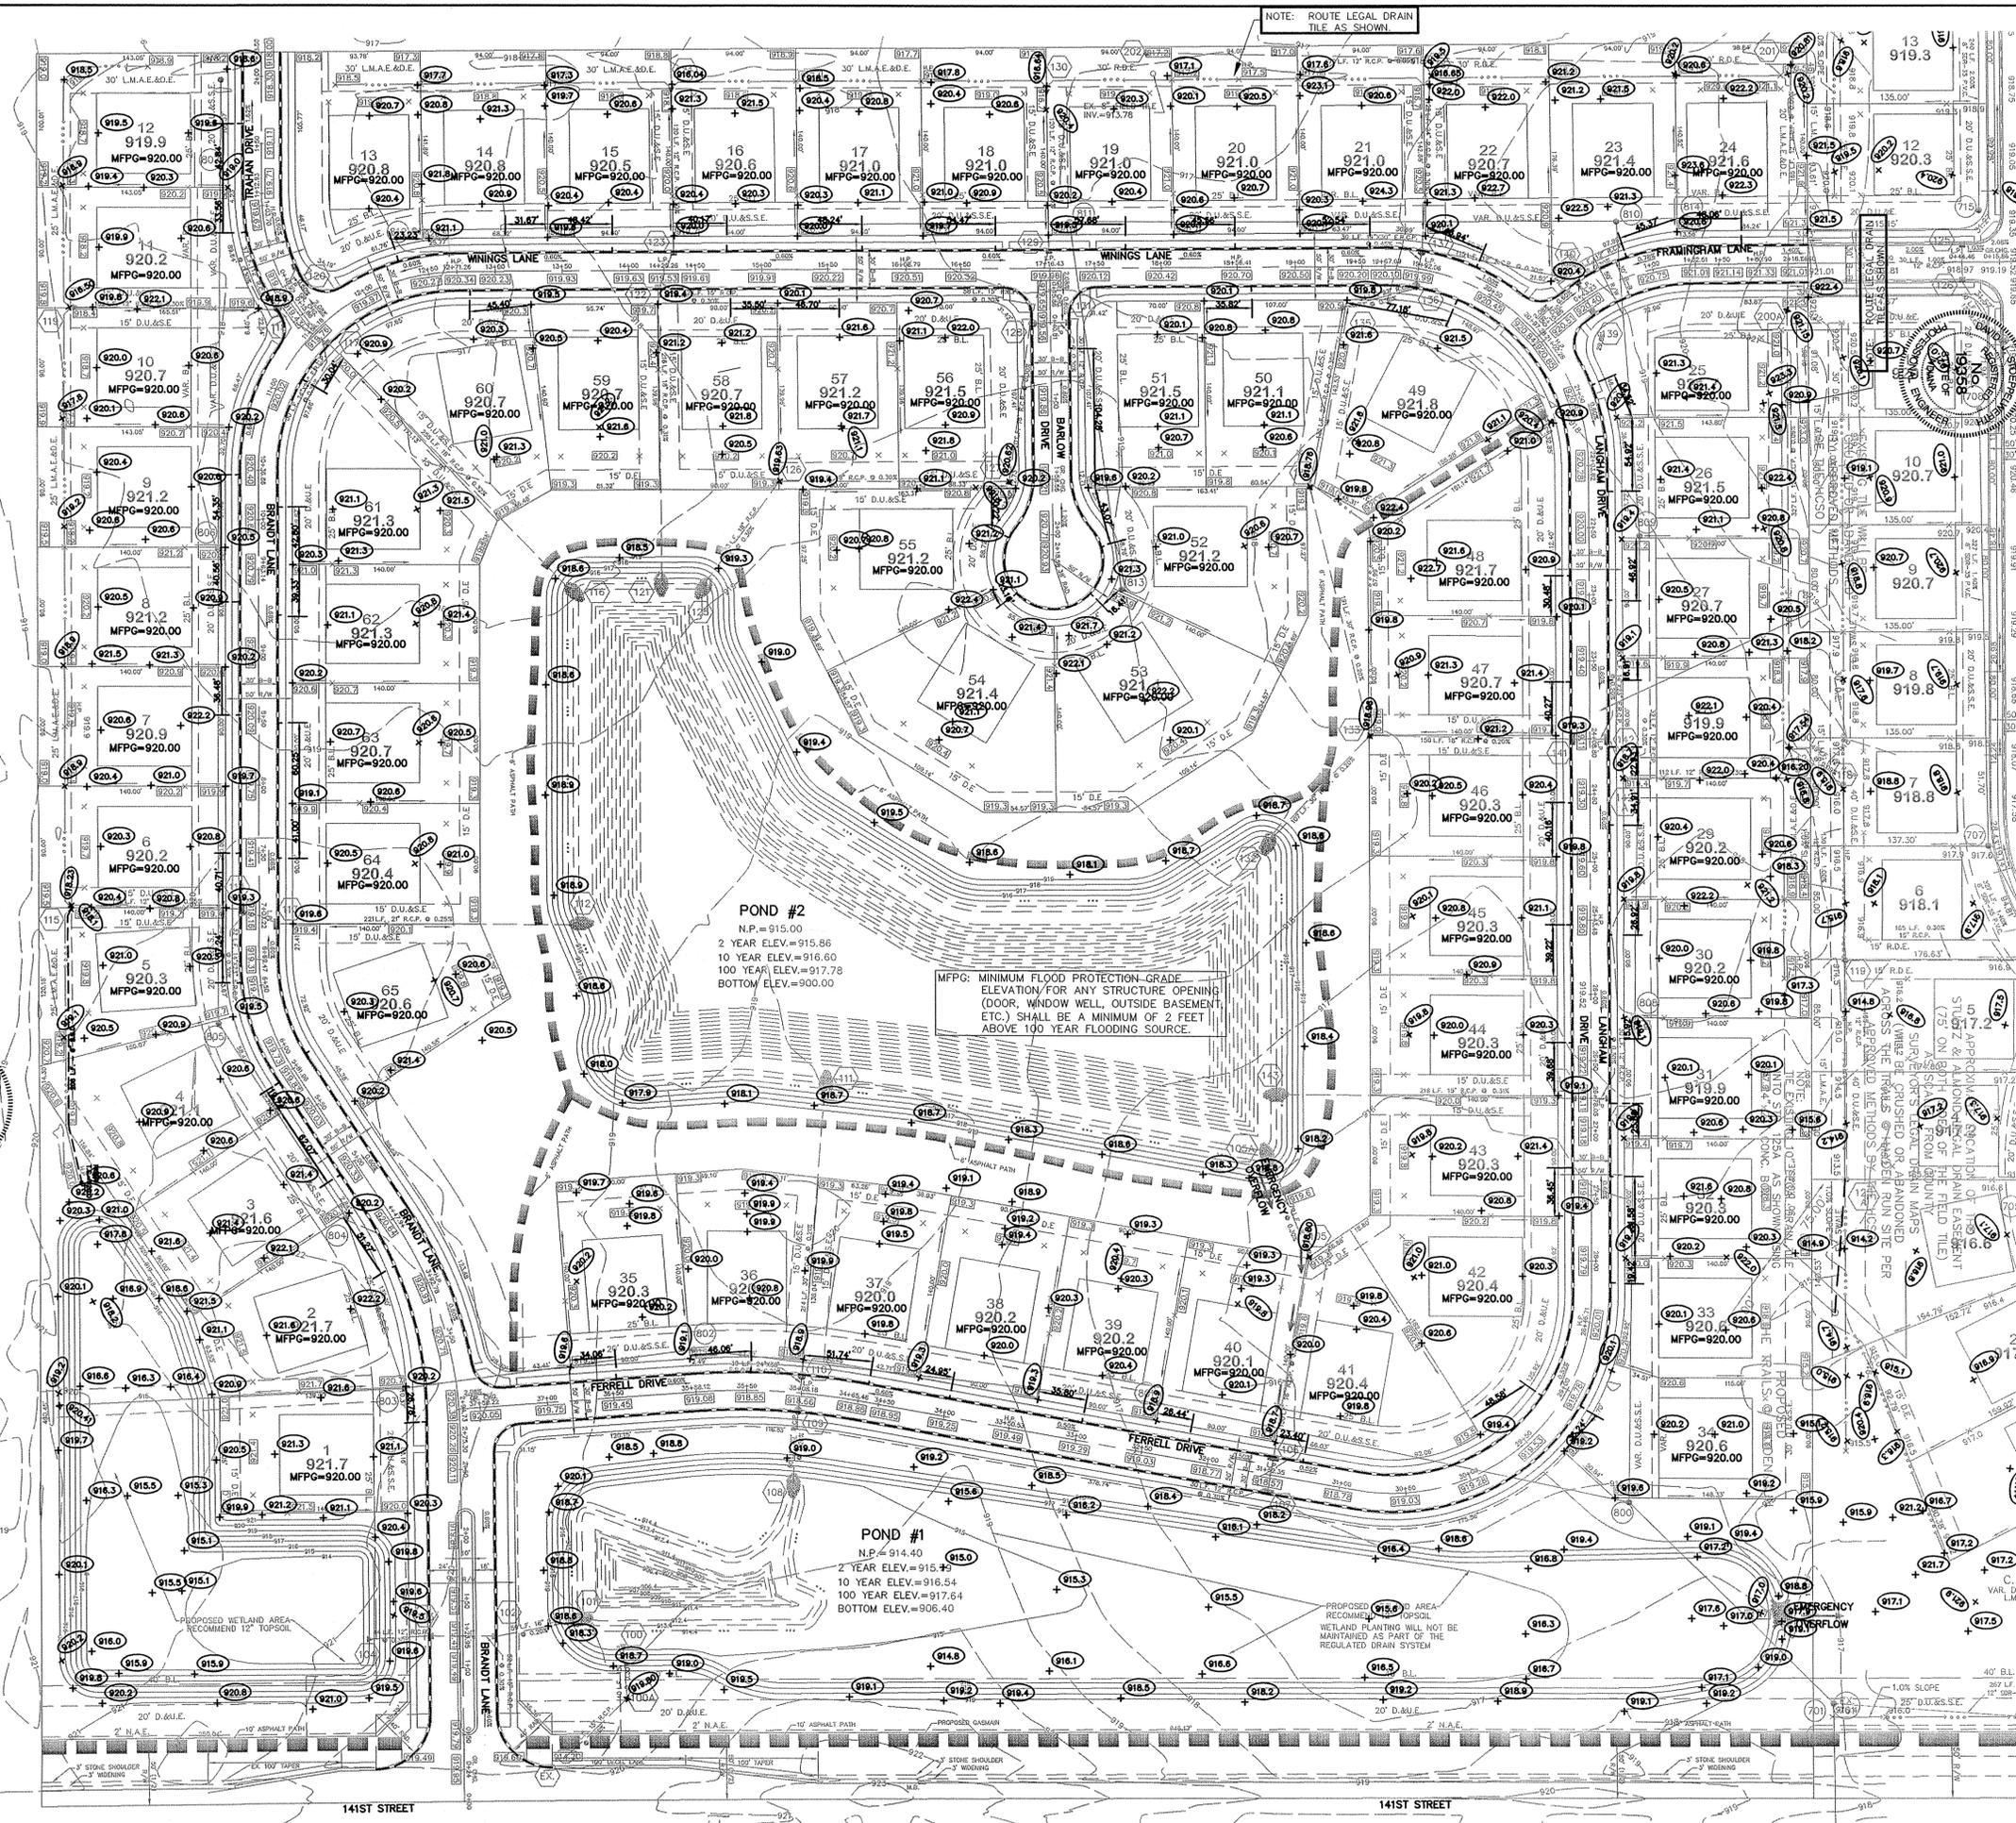

NOTE: ROUTE LEGAL DRAIN TILE AS SHOWN.

AS-BUILT

DATE: 6/1/04

BY: David J. Stapp

CERTIFIED: 6/1/04

CONSULTING ENGINEERS - LAND SURVEYORS
(317) 849-5935 1-800-728-6917 FAX: (317) 849-5942

INDIANA

INDIANA

SITE DEVELOPMENT PLAN
THE TRAILS @ HAYDEN RUN
CARMEL

SHEET NO. C200

JOB NO. 45370EQU

LEGEND

- EXISTING EDGE OF WOODS
- EXISTING CONTOUR
- EXISTING SANITARY SEWER
- EXISTING STORM SEWER
- PROPOSED GRADE
- MATCH EXISTING
- PROPOSED CONTOUR
- PROPOSED SANITARY SEWER
- PROPOSED STORM SEWER
- PROPOSED SWALE
- PROPOSED 5' SIDEWALK (BY HOME BUILDER)
(DEVELOPER SHALL INSTALL SIDEWALKS ALONG ALL COMMON AREAS)
- LOT NUMBER
- PAD ELEVATION
PAD SIZE: 60'X70'
(UNLESS OTHERWISE NOTED)
- PROPOSED 6" UNDERDRAINS
- DENOTES 4" SUBSURFACE DRAIN TO LOT
- DENOTES 6" SUBSURFACE DRAIN
- ROLL CURB

SCALE: 1" = 60'

ALL PADS SHOULD BE TESTED TO ASSURE A COMPACTION OF AT LEAST 95 PERCENT OF THE MAXIMUM DRY DENSITY USING THE STANDARD PROCTOR TEST METHOD.



ALL EXISTING OFF-SITE DRAIN TILES THAT ARE ENCOUNTERED SHALL BE TIED INTO THE PROPOSED STORM SEWER SYSTEM WITH A POSITIVE OUTFLOW

- D.U.&S.E. DRAINAGE, UTILITY & SANITARY SEWER EASEMENT
- D.U.E. DRAINAGE UTILITY & SEWER EASEMENT
- D.U.E. DRAINAGE & UTILITY EASEMENT
- L.M.A.E. LANDSCAPE, MAINTENANCE ACCESS EASEMENT
- S.L.E. SIGN LANDSCAPE EASEMENT
- D.E. DRAINAGE EASEMENT
- B.S.L. BUILDING SETBACK LINE
- N.R. NON RADIAL
- N.A.E. NON ACCESS EASEMENT
- P.A.E. PUBLIC ACCESS EASEMENT
- T.P.E. TREE PRESERVATION EASEMENT
- R/W RIGHT OF WAY
- C.A. COMMON AREA

BENCHMARKS


S&A TBM #1
 1.0'± UP FROM GROUND ON EAST SIDE ELECTRIC POLE. PWP #74-693
 10TH POLE FROM TOWNE ROAD ON S. SIDE OF 146TH STREET.
 ELEV.=919.28

NOTE TO CONTRACTOR: CONTRACTOR SHALL VERIFY DEPTHS OF ALL EXISTING ONSITE UTILITIES PRIOR TO CONSTRUCTION TO CONFIRM THERE IS NOT ANY CONFLICTS WITH OTHER UTILITIES, STORM SEWERS OR STREETS. CONFLICTS AFTER CONSTRUCTION BEGINS ARE SOLELY THE CONTRACTOR'S RESPONSIBILITY.

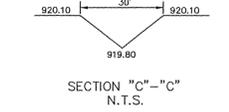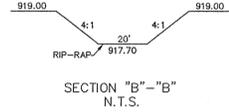

CAUTION
 LOCATION OF ALL EXISTING UNDERGROUND UTILITIES SHOWN ON THIS PLAN ARE BASED UPON AERIAL PHOTOGRAPHIC EVIDENCE, INCLUDING, BUT NOT LIMITED TO, manholes, valves, and markers made upon the ground by others, and ARE SPECULATIVE IN NATURE. THERE MAY ALSO BE OTHER EXISTING UNDERGROUND UTILITIES FOR WHICH THERE IS NO ABOVE GROUND EVIDENCE OR FOR WHICH NO ABOVE GROUND EVIDENCE WAS OBSERVED. THE EXACT LOCATIONS OF SAID EXISTING UNDERGROUND UTILITIES SHOULD BE VERIFIED BY THE CONTRACTOR PRIOR TO ANY AND ALL CONSTRUCTION.

1-800-382-5544
 CALL TOLL FREE
 1-800-428-5200
 FOR CALLS OUTSIDE OF INDIANA

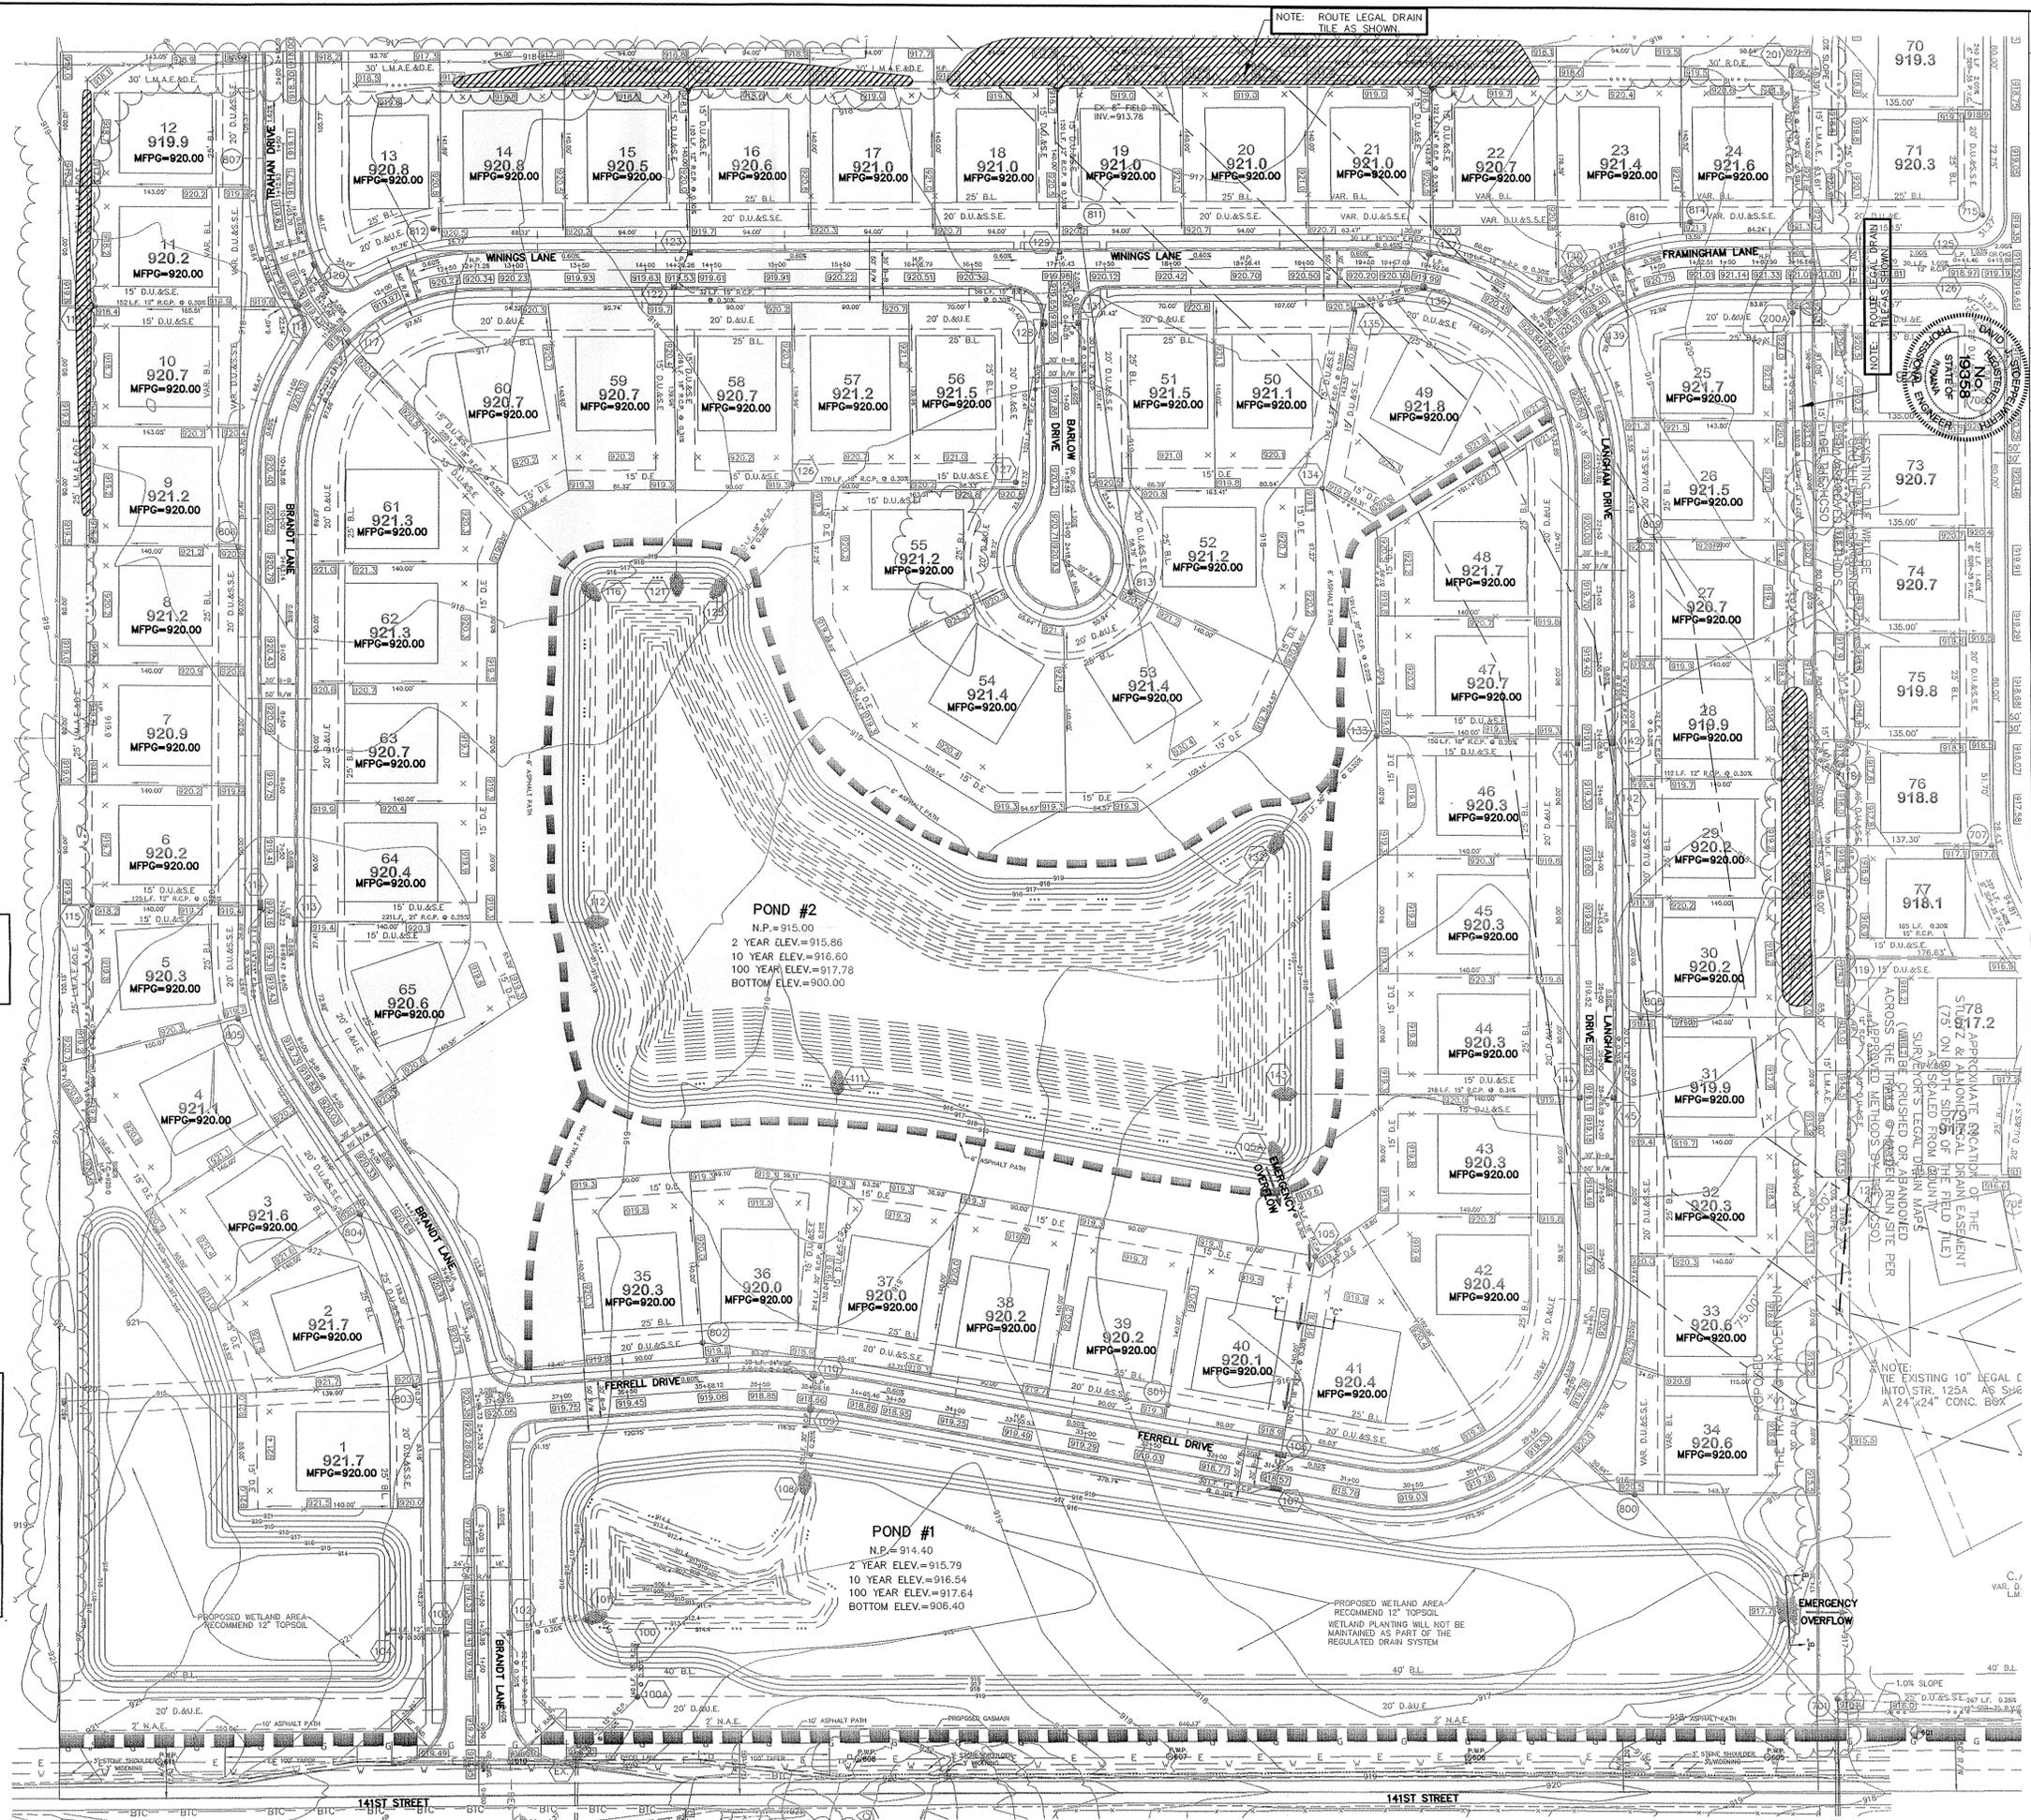

CERTIFIED: 6/1/04


CONSULTING ENGINEERS - LAND SURVEYORS
 (317) 849-5935 1-800-728-6917 FAX: (317) 849-5942
 FISHERS INDIANA

FLOOD ROUTING PLAN
 THE TRAILS @ HAYDEN RUN
 CARMEL INDIANA

SHEET NO. C201
 JOB NO. 45370EQU

REVISIONS

NO.	DATE	MARK	REVISIONS	BY

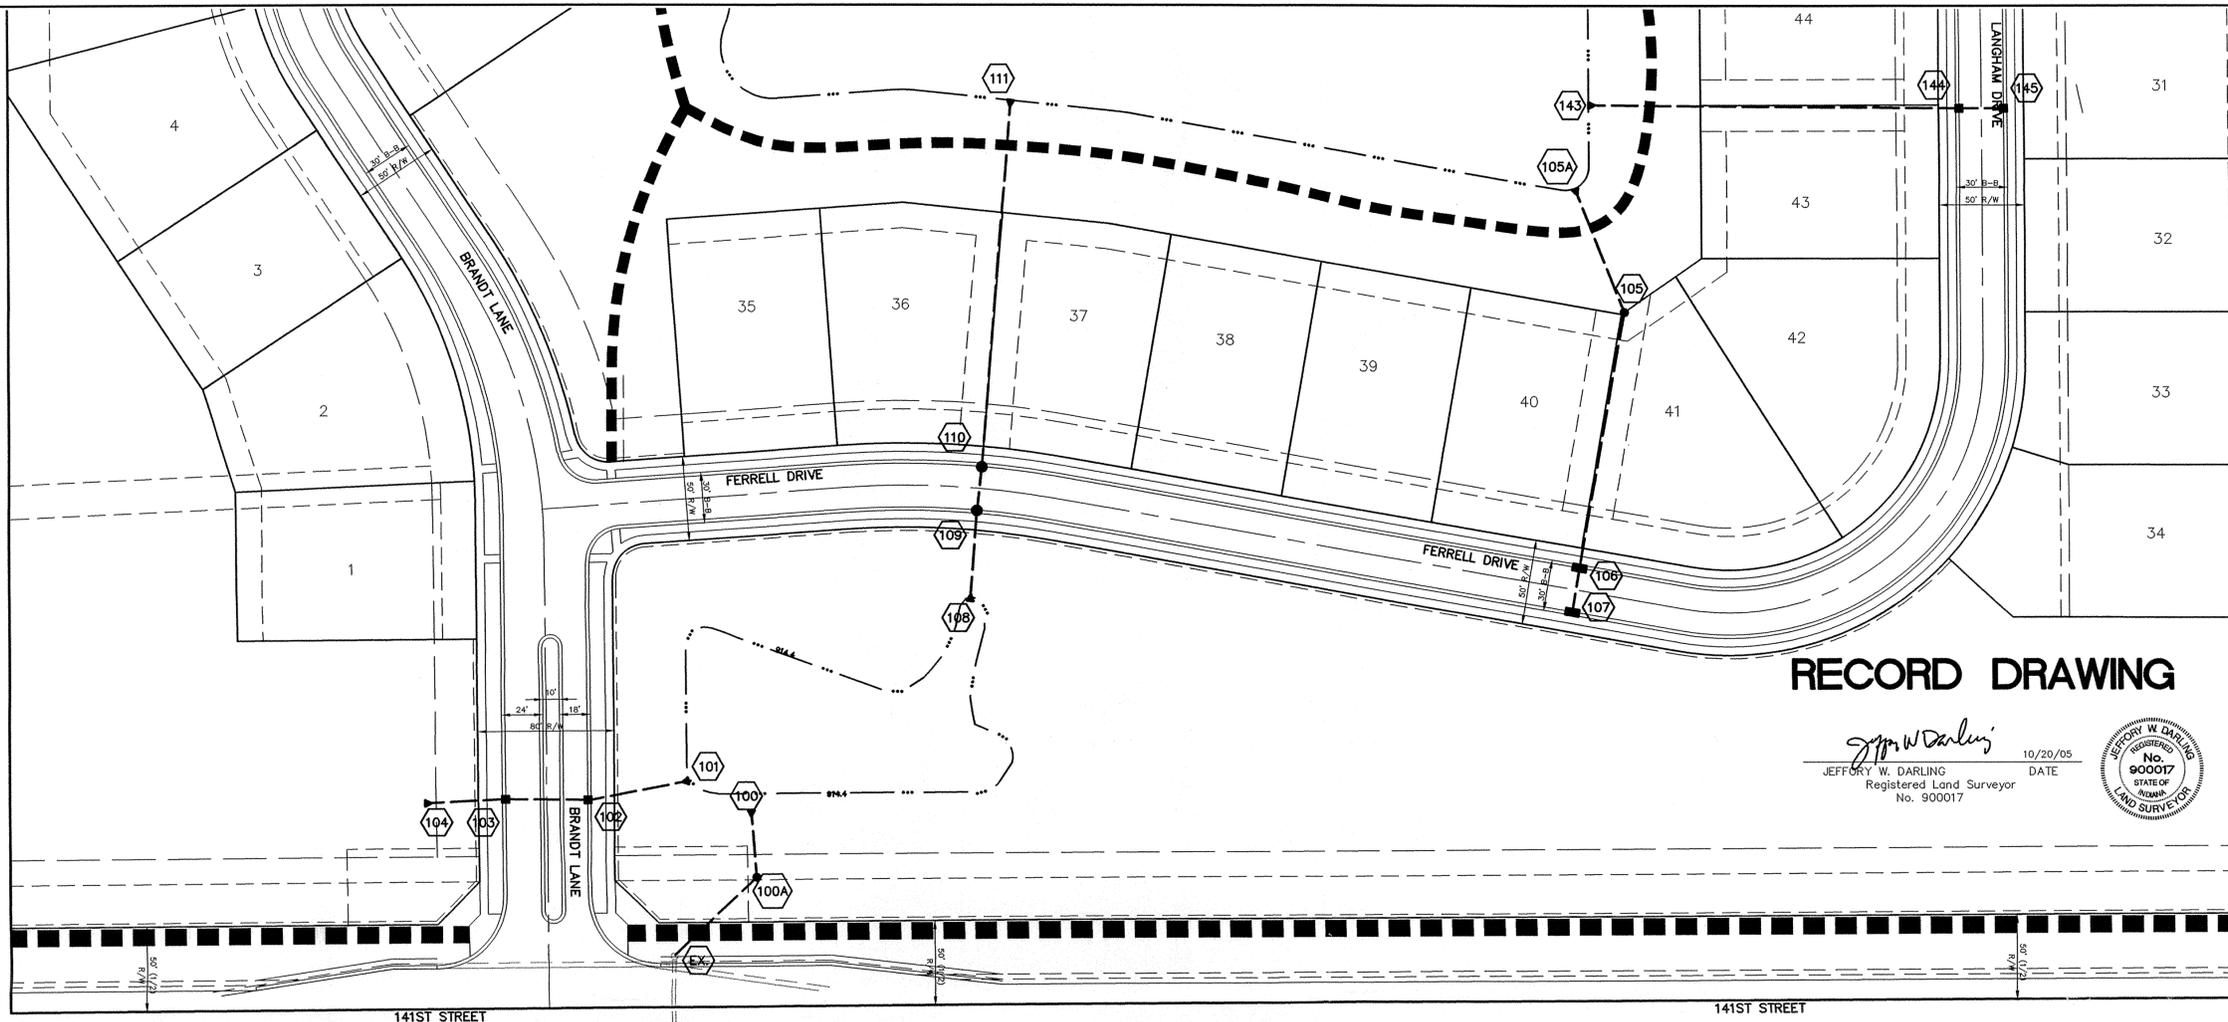

RECORD DRAWING

JEFFORY W. DARLING
 Registered Land Surveyor
 No. 900017
 DATE: 10/20/05



NOTE:
 CONSTRUCTION TOLERANCE FOR YARD INLETS
 WILL BE +0.0' TO -0.20'

NOTE:
 *EXCEPT FOR FORCE MAINS, CONTRACTOR TO
 INSTALL CONCRETE CRADLES WHEN THE VERTICAL
 SEPARATION (AS MEASURED FROM THE EXTERIOR
 OF THE PIPES) BETWEEN SANITARY SEWER FACILITIES
 AND STORM SEWERS IS 18" OR LESS.*

ALL MANHOLES TO BE CONSTRUCTED WITH ONE
 4" RISER RING TO ESTABLISH PLAN CASTING GRADE.

ALL CURB INLET CASTINGS TO BE NEENAH R-3501-L2



ALL EXISTING OFF-SITE DRAIN TILES THAT ARE
 ENCOUNTERED SHALL BE TIED INTO THE PROPOSED
 STORM SEWER SYSTEM WITH A POSITIVE OUTFLOW






SCALE: 1" = 50'

NOTE: BEDDING, HAUNCHING, AND INITIAL BACKFILL FOR
 ALL RCP INSTALLATIONS SHALL BE B-BORROW FOR
 STRUCTURE BACKFILL MEETING THE MATERIAL
 REQUIREMENTS OF THE INDOT. BEDDING SHALL BE
 PLACED IN THE TRENCH BOTTOM SUCH THAT AFTER
 THE PIPE IS INSTALLED TO GRADE AND LINE,
 THERE REMAINS A 4-INCH MINIMUM DEPTH OF
 MATERIAL BELOW THE PIPE BARREL AND A MINIMUM
 OF 3-INCHES BELOW THE BELL. FOR PIPE SIZES
 66-INCHES AND LARGER, THE MINIMUM DEPTH OF
 MATERIAL BELOW THE PIPE BARREL SHALL BE
 6-INCHES. BEDDING, HAUNCHING AND INITIAL
 BACKFILL SHALL BE COMPACTED IN 6-INCH
 MAXIMUM LIFTS TO NOT LESS THAN 95% STANDARD
 PROCTOR DENSITY FOR THE ENTIRE DEPTH OF THE
 MATERIAL PLACED. THE BACKFILL SHALL BE
 BROUGHT UP EVENLY ON BOTH SIDES OF THE
 PIPE FOR THE FULL LENGTH OF THE PIPE.
 HAUNCHING SHALL EXTEND TO THE SPRINGLINE OF
 THE PIPE. THE LIMIT OF INITIAL BACKFILL SHALL BE
 6-INCHES ABOVE THE SPRINGLINE. MINIMUM
 TRENCH WIDTH SHALL BE THE OUTSIDE DIAMETER
 OF THE PIPE PLUS 18-INCHES.

NOTE: FINAL BACKFILL FOR ALL RCP INSTALLATIONS
 UNDER AND WITHIN 5- FEET OF PAVEMENT SHALL
 BE B-BORROW FOR STRUCTURE BACKFILL MEETING
 THE MATERIAL REQUIREMENTS OF THE INDOT AND
 SHALL BE COMPACTED IN 6-INCH MAXIMUM LIFTS
 TO NOT LESS THAN 95% STANDARD PROCTOR
 DENSITY FOR THE ENTIRE DEPTH OF THE MATERIAL
 PLACED. THE BACKFILL FOR THE TOP 6-INCHES
 OF THE EXCAVATION BELOW THE START OF THE
 AGGREGATE SUBBASE OF THE PAVEMENT SHALL BE
 NO. 53 STONE MEETING THE MATERIAL
 REQUIREMENTS OF THE INDOT AND SHALL BE
 COMPACTED TO NOT LESS THAN 95% STANDARD
 PROCTOR DENSITY. FINAL BACKFILL FOR ALL RCP
 INSTALLATIONS GREATER THAN 5- FEET OF
 PAVEMENT SHALL BE CLEAN FILL MATERIAL FREE
 OF ROCKS LARGER THAN 6-INCHES IN DIAMETER,
 FROZEN LUMPS OF SOIL, WOOD OR OTHER
 EXTRANEOUS MATERIAL, COMPACTED IN 12-INCH
 MAXIMUM LIFTS TO NOT LESS THAN 90% STANDARD
 PROCTOR DENSITY FOR THE ENTIRE DEPTH OF THE
 EXCAVATION.

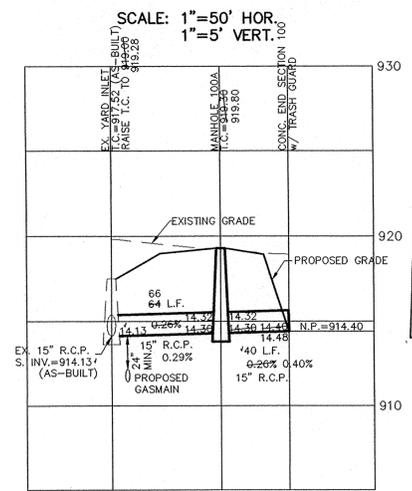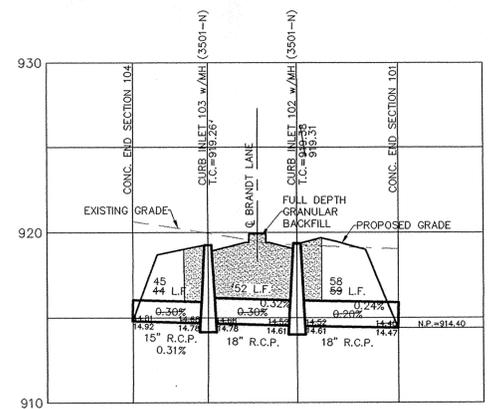

This information was gathered for input into the
 Hamilton County Geographic Information
 System (GIS). This document is considered an
 official record of the GIS.
 Entry Date: 8-28-07
 Entered By: SLM

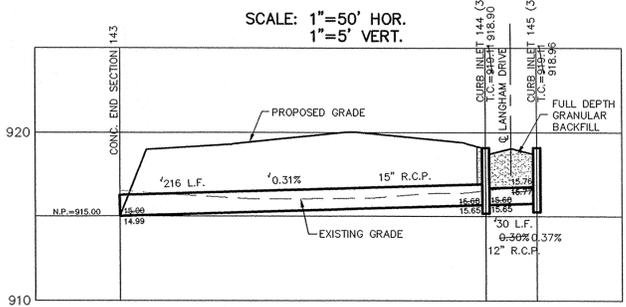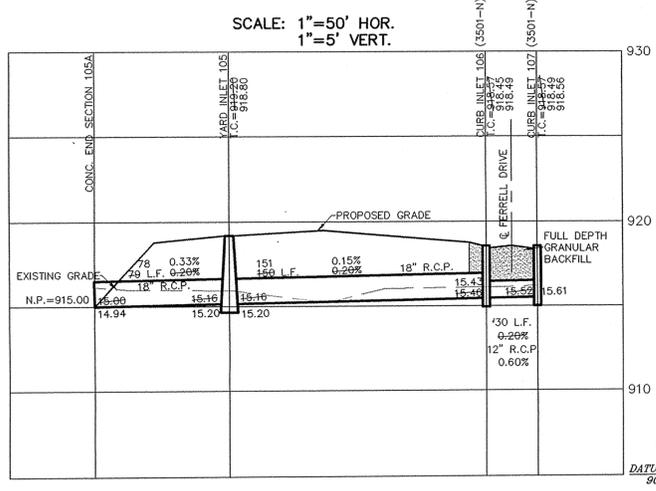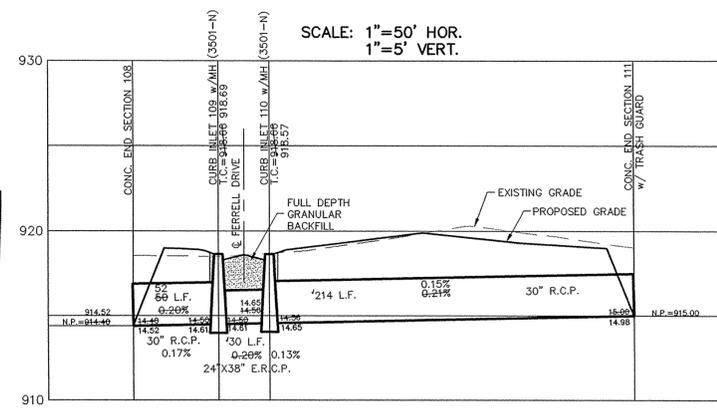

PIPE SIZE	STRUCTURES LESS THAN 48" FROM T/C TO INVERT	STRUCTURES GREATER THAN 48" FROM T/C TO INVERT	ANGLE AND QUALITY OF PIPES WILL REQUIRE SPECIAL DESIGN	STEPS REQUIRED	CURB CASTING *R-3501 N	CASTING *3501 TL & TR
12" to 18"	24"x24"		DESIGN APPROVAL	No	Yes	Yes
12" to 21"	30"x30"		DESIGN APPROVAL	No	Yes	Yes
18" to 21"		MH/BOX	DESIGN APPROVAL	Yes	Yes	Yes
21" to 27"	24"x36"		DESIGN APPROVAL	No	No	Yes
12" to 24"	36"x36"		DESIGN APPROVAL	No	Yes	Yes
24" OR LARGER			DESIGN APPROVAL	No	No	Yes
24" OR LARGER		MH/BOX	DESIGN APPROVAL	Yes**	Yes	Yes

* PIPES NO LARGER THAN 18" CAN BE USED IN THE 2' SIDE OF THIS BOX
 ** INCOMING AND OUT GOING PIPES EFFECT STEPS IN THIS STRUCTURE

SPECIAL NOTE:
 STRUCTURES GREATER THAN 48" FROM T/C TO INVERT WILL BE A
 M.H. OR A BOX WITH STEPS UNLESS SPECIAL DESIGN IS APPROVED.


SPECIAL NOTE:
 STRUCTURES WILL BE DESIGNED FOR MAXIMUM FLOW IN PIPES

SPECIAL NOTE:
 COUNTY MAY REQUIRE STEPS TO BE INSTALLED AFTER
 STRUCTURE IS SET, TO IMPROVE ACCESS.

CERTIFIED: 6/1/04
 David J. Stappert
 CONSULTING ENGINEERS - LAND SURVEYORS
 (317) 849-5935 1-800-728-6917 FAX: (317) 849-5942
 FISHERS INDIANA



STORM SEWER PLAN & PROFILE
 THE TRAILS @ HAYDEN RUN
 CARMEL INDIANA

SHEET NO.
C600
 JOB NO. 45370EQU

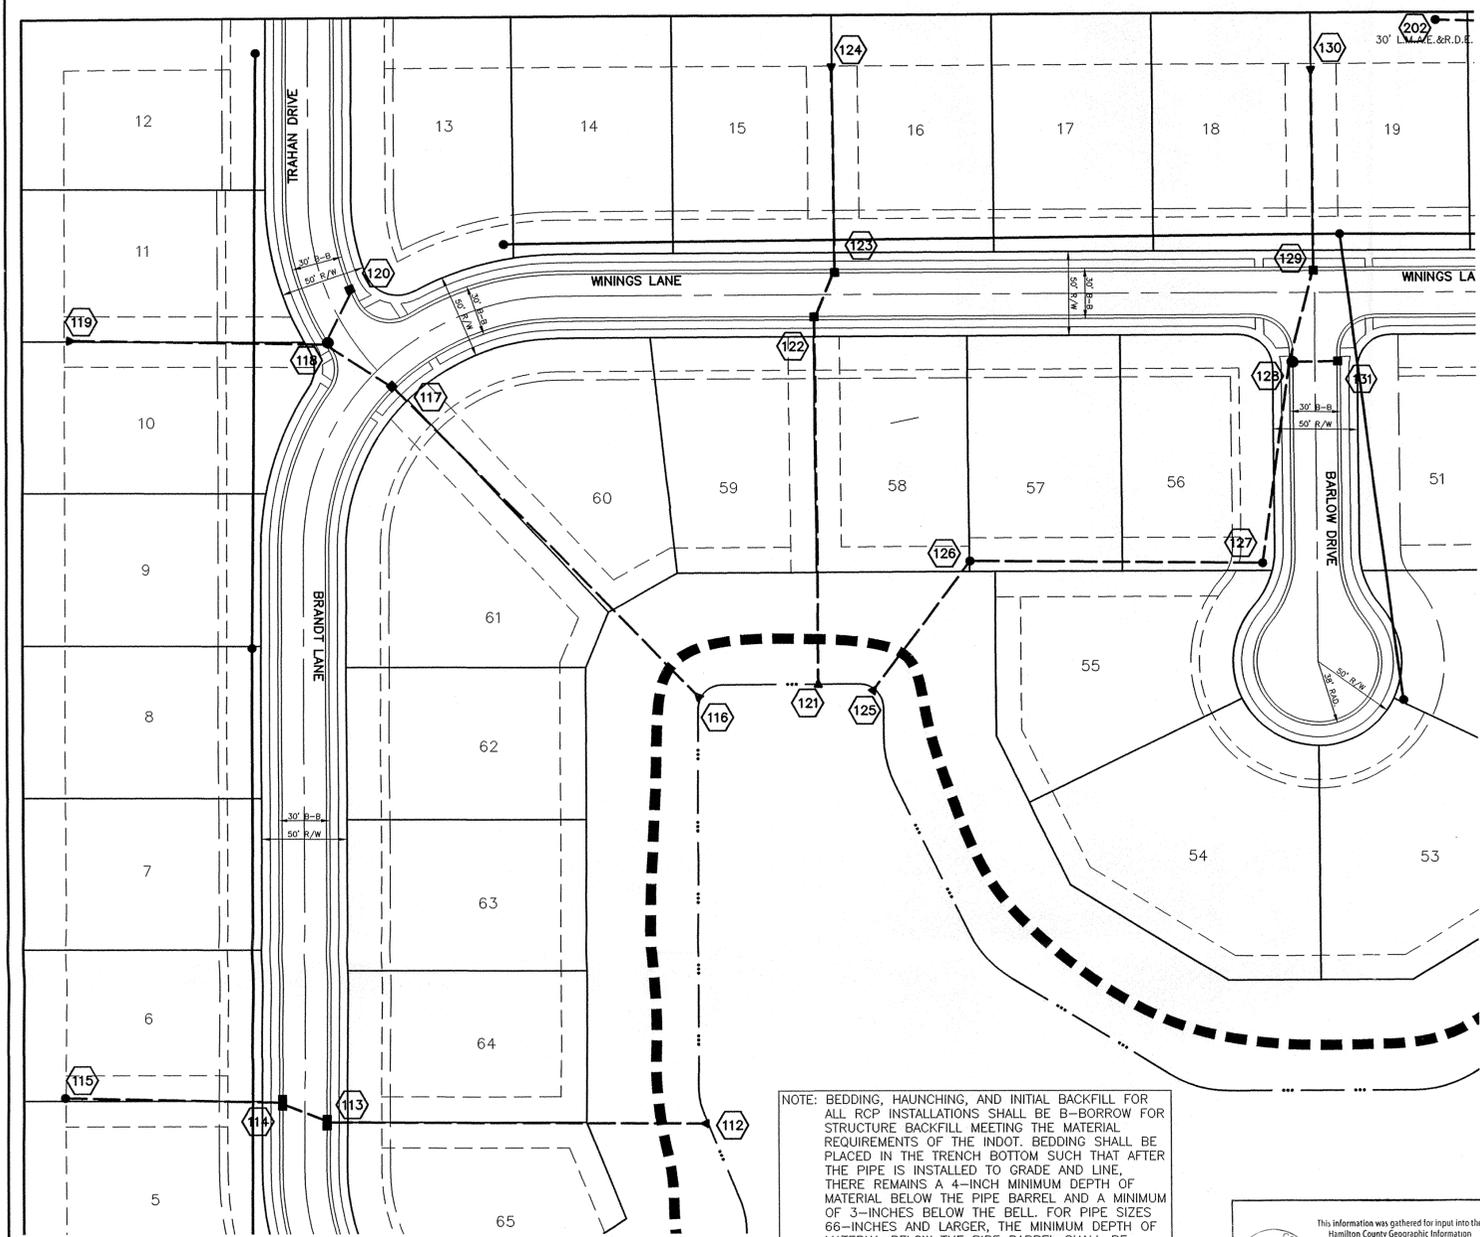

NOTE: BEDDING, HAUNCHING, AND INITIAL BACKFILL FOR ALL RCP INSTALLATIONS SHALL BE B-BORROW FOR STRUCTURE BACKFILL MEETING THE MATERIAL REQUIREMENTS OF THE INDOT. BEDDING SHALL BE PLACED IN THE TRENCH BOTTOM SUCH THAT AFTER THE PIPE IS INSTALLED TO GRADE AND LINE, THERE REMAINS A 4-INCH MINIMUM DEPTH OF MATERIAL BELOW THE PIPE BARREL AND A MINIMUM OF 3-INCHES BELOW THE BELL. FOR PIPE SIZES 66-INCHES AND LARGER, THE MINIMUM DEPTH OF MATERIAL BELOW THE PIPE BARREL SHALL BE 6-INCHES. BEDDING, HAUNCHING AND INITIAL BACKFILL SHALL BE COMPACTED IN 6-INCH MAXIMUM LIFTS TO NOT LESS THAN 95% STANDARD PROCTOR DENSITY FOR THE ENTIRE DEPTH OF THE MATERIAL PLACED. THE BACKFILL SHALL BE BROUGHT UP EVENLY ON BOTH SIDES OF THE PIPE FOR THE FULL LENGTH OF THE PIPE. HAUNCHING SHALL EXTEND TO THE SPRINGLINE OF THE PIPE. THE LIMIT OF INITIAL BACKFILL SHALL BE 6-INCHES ABOVE THE SPRINGLINE. MINIMUM TRENCH WIDTH SHALL BE THE OUTSIDE DIAMETER OF THE PIPE PLUS 18-INCHES.

This information was gathered for input into the Hamilton County Geographic Information System (GIS). This document is considered an official record of the GIS.
 Entry Date: 8-28-07
 Entered By: SLM

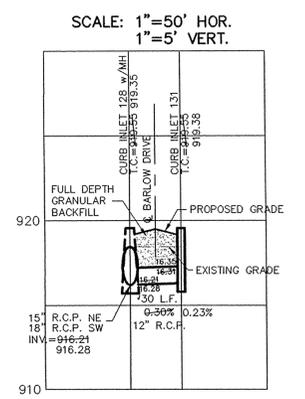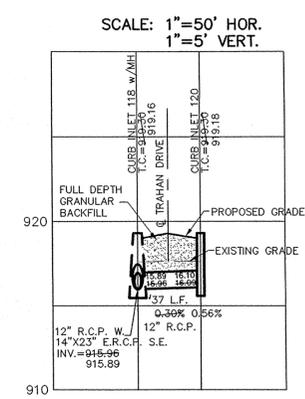



NOTE: CONSTRUCTION TOLERANCE FOR YARD INLETS WILL BE +0.0' TO -0.20'

NOTE: EXCEPT FOR FORCE MAINS, CONTRACTOR TO INSTALL CONCRETE GRADLES WHEN THE VERTICAL SEPARATION (AS MEASURED FROM THE EXTERIOR OF THE PIPES) BETWEEN SANITARY SEWER FACILITIES AND STORM SEWERS IS 18" OR LESS.

ALL MANHOLES TO BE CONSTRUCTED WITH ONE 4" RISER RING TO ESTABLISH PLAN CASTING GRADE.

ALL CURB INLET CASTINGS TO BE NEENAH R-3501-L2



ALL EXISTING OFF-SITE DRAIN TILES THAT ARE ENCOUNTERED SHALL BE TIED INTO THE PROPOSED STORM SEWER SYSTEM WITH A POSITIVE OUTFLOW

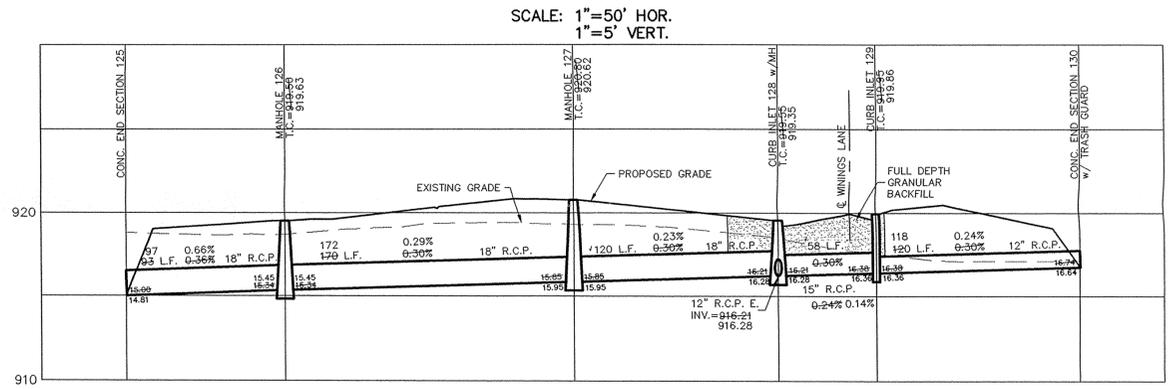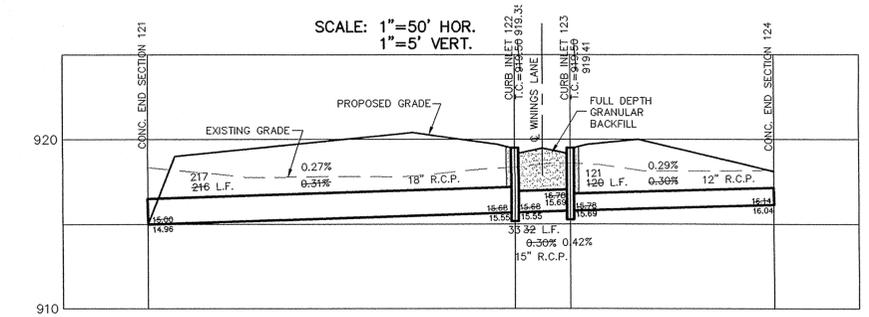

NOTE: FINAL BACKFILL FOR ALL RCP INSTALLATIONS UNDER AND WITHIN 5- FEET OF PAVEMENT SHALL BE B-BORROW FOR STRUCTURE BACKFILL MEETING THE MATERIAL REQUIREMENTS OF THE INDOT AND SHALL BE COMPACTED IN 6-INCH MAXIMUM LIFTS TO NOT LESS THAN 95% STANDARD PROCTOR DENSITY FOR THE ENTIRE DEPTH OF THE MATERIAL PLACED. THE BACKFILL FOR THE TOP 6-INCHES OF THE EXCAVATION BELOW THE START OF THE AGGREGATE SUBBASE OF THE PAVEMENT SHALL BE NO. 53 STONE MEETING THE MATERIAL REQUIREMENTS OF THE INDOT AND SHALL BE COMPACTED TO NOT LESS THAN 95% STANDARD PROCTOR DENSITY. FINAL BACKFILL FOR ALL RCP INSTALLATIONS GREATER THAN 5- FEET OF PAVEMENT SHALL BE CLEAN FILL MATERIAL FREE OF ROCKS LARGER THAN 6-INCHES IN DIAMETER, FROZEN LUMPS OF SOIL, WOOD OR OTHER EXTRANEIOUS MATERIAL, COMPACTED IN 12-INCH MAXIMUM LIFTS TO NOT LESS THAN 90% STANDARD PROCTOR DENSITY FOR THE ENTIRE DEPTH OF THE EXCAVATION.

RECORD DRAWING

JEFFERY W. DARLING
 Registered Land Surveyor
 No. 900017
 DATE: 10/20/05

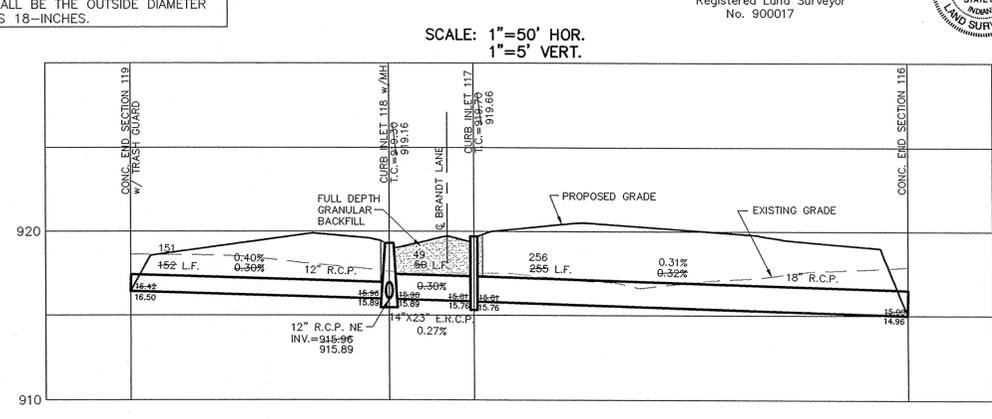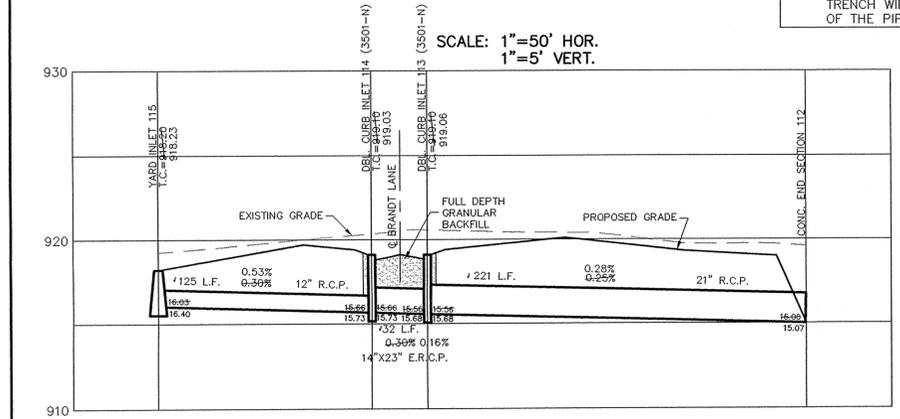

CURB INLET TABLE

PIPE SIZE	STRUCTURES LESS THAN 48" FROM T/C TO INVERT	STRUCTURES GREATER THAN 48" FROM T/C TO INVERT	ANGLE AND QUALITY OF PIPES WILL REQUIRE SPECIAL DESIGN	STEPS REQUIRED	CURB CASTING "R-3501 N"	CASTING "3501 TL & TR"
12" to 18"	24"x24"		DESIGN APPROVAL	No	Yes	Yes
12" to 21"	30"x30"		DESIGN APPROVAL	No	Yes	Yes
18" to 21"		MH/BOX	DESIGN APPROVAL	Yes	Yes	Yes
21" to 27"	24"x36"		DESIGN APPROVAL	No	No	Yes
12" to 24"	36"x36"		DESIGN APPROVAL	No	Yes	Yes
24" OR LARGER			DESIGN APPROVAL	No	No	Yes
24" OR LARGER		MH/BOX	DESIGN APPROVAL	Yes**	Yes	Yes

* PIPES NO LARGER THAN 18" CAN BE USED IN THE 2' SIDE OF THIS BOX.
 ** INCOMING AND OUT GOING PIPES EFFECT STEPS IN THIS STRUCTURE.

SPECIAL NOTE: STRUCTURES DEEPER THAN 48" FROM T/C TO INVERT WILL BE A MH OR A BOX WITH STEPS UNLESS SPECIAL DESIGN IS APPROVED.

SPECIAL NOTE: STRUCTURES WILL BE DESIGNED FOR MAXIMUM FLOW IN PIPES.

SPECIAL NOTE: COUNTY MAY REQUIRE STEPS TO BE INSTALLED AFTER STRUCTURE IS SET, TO IMPROVE ACCESS.

CONSULTING ENGINEERS - LAND SURVEYORS
 (317) 849-5935 1-800-728-6917 FAX: (317) 849-5942
 FISHERS INDIANA

STORM SEWER PLAN & PROFILE
 THE TRAILS @ HAYDEN RUN
 CARMEL INDIANA

SHEET NO. C601
 JOB NO. 45370EQU

DATE: 6/1/04
 BY: David J. Stappach

REVISIONS

RECORD DRAWING

APPROXIMATE LOCATION OF THE STULTZ & ALMOND LEGAL DRAIN EASEMENT (75' ON BOTH SIDES OF THE FIELD TILE) AS SCALED FROM COUNTY SURVEYOR'S LEGAL DRAIN MAPS (WILL BE CRUSHED OR ABANDONED ACROSS THE TRAILS @ HAYDEN RUN SITE PER APPROVED METHODS BY THE CITY OF CARMEL ENGINEER)

Jeffrey W. Darling
JEFFREY W. DARLING
Registered Land Surveyor
No. 900017

10/20/05
DATE



PIPE SIZE	STRUCTURES LESS THAN 48" FROM T/C TO INVERT	STRUCTURES GREATER THAN 48" FROM T/C TO INVERT	ANGLE AND QUALITY OF PIPES WILL REQUIRE SPECIAL DESIGN	STEPS REQUIRED	CURB CASTING #R-3501 N	CASTING #3501 TL & TR
12" to 18"	24"x24"		DESIGN APPROVAL	No	Yes	Yes
12" to 21"	30"x30"		DESIGN APPROVAL	No	Yes	Yes
18" to 21"		MH/BOX	DESIGN APPROVAL	Yes	Yes	Yes
21" to 27"	24"x36"		DESIGN APPROVAL	No	No	Yes
12" to 24"	36"x36"		DESIGN APPROVAL	No	Yes	Yes
24" OR LARGER	DESIGN APPROVAL	MH/BOX	DESIGN APPROVAL	No	No	Yes
			DESIGN APPROVAL	Yes**	Yes	Yes

* PIPES NO LARGER THAN 18" CAN BE USED IN THE 2' SIDE OF THIS BOX
** INCOMING AND OUT GOING PIPES EFFECT STEPS IN THIS STRUCTURE

SPECIAL NOTE: STRUCTURES DEEPER THAN 48" FROM T/C TO INVERT WILL BE A MANHOLE OR A BOX WITH STEPS UNLESS SPECIAL DESIGN IS APPROVED.
SPECIAL NOTE: STRUCTURES WILL BE DESIGNED FOR MAXIMUM FLOW IN PIPES
SPECIAL NOTE: COUNTY MAY REQUIRE STEPS TO BE INSTALLED AFTER STRUCTURE IS SET, TO IMPROVE ACCESS.

SCALE: 1" = 50'






NOTE: CONSTRUCTION TOLERANCE FOR YARD INLETS WILL BE +0.0' TO -0.20'

NOTE: *EXCEPT FOR FORCE MAINS, CONTRACTOR TO INSTALL CONCRETE CRADLES WHEN THE VERTICAL SEPARATION (AS MEASURED FROM THE EXTERIOR OF THE PIPES) BETWEEN SANITARY SEWER FACILITIES AND STORM SEWERS IS 18" OR LESS.*

ALL MANHOLES TO BE CONSTRUCTED WITH ONE 4" RISER RING TO ESTABLISH PLAN CASTING GRADE.

ALL CURB INLET CASTINGS TO BE NEENAH R-3501-L2

ALL EXISTING OFF-SITE DRAIN TILES THAT ARE ENCOUNTERED SHALL BE TIED INTO THE PROPOSED STORM SEWER SYSTEM WITH A POSITIVE OUTFLOW

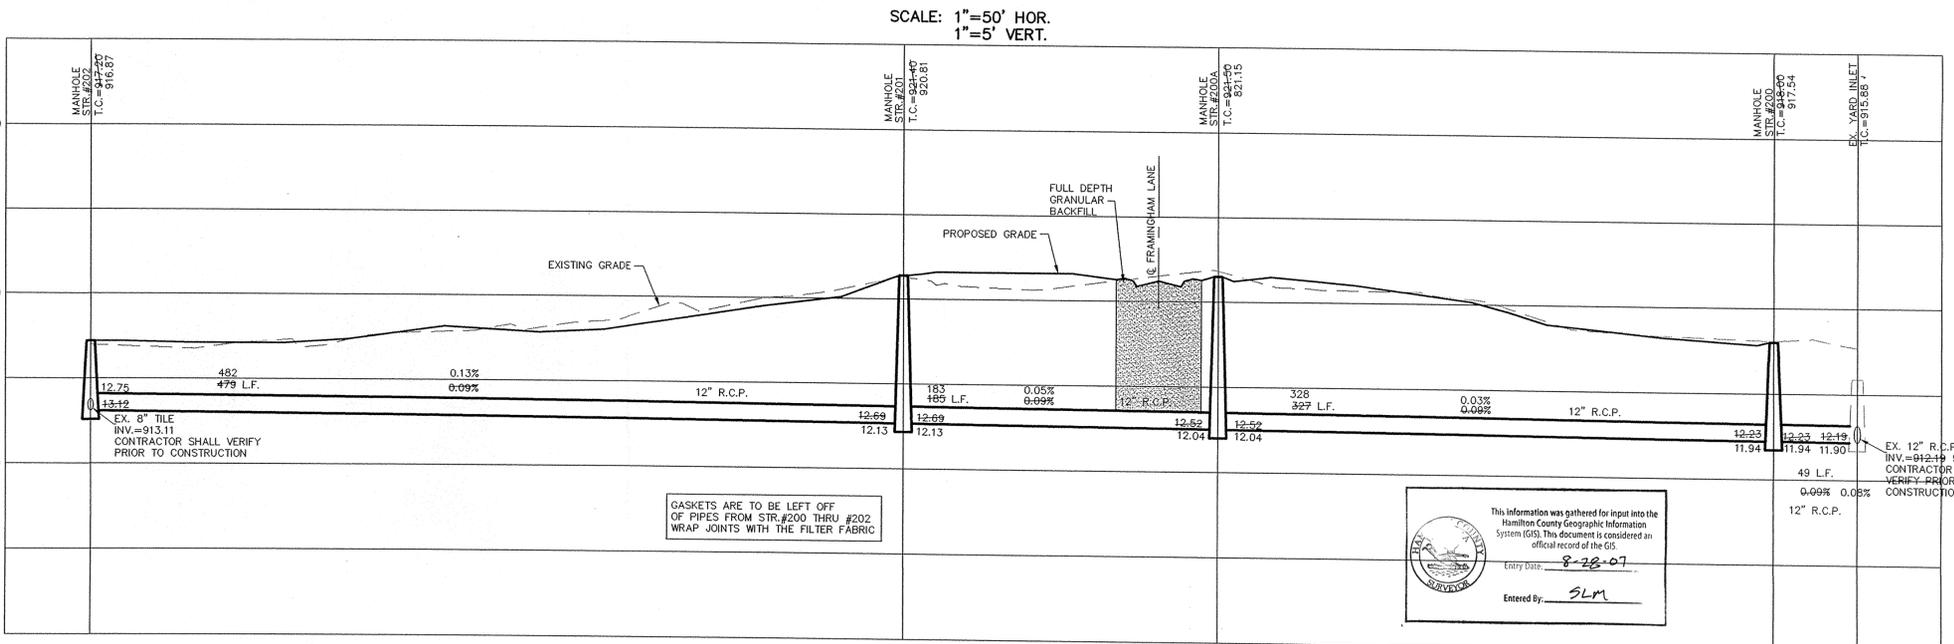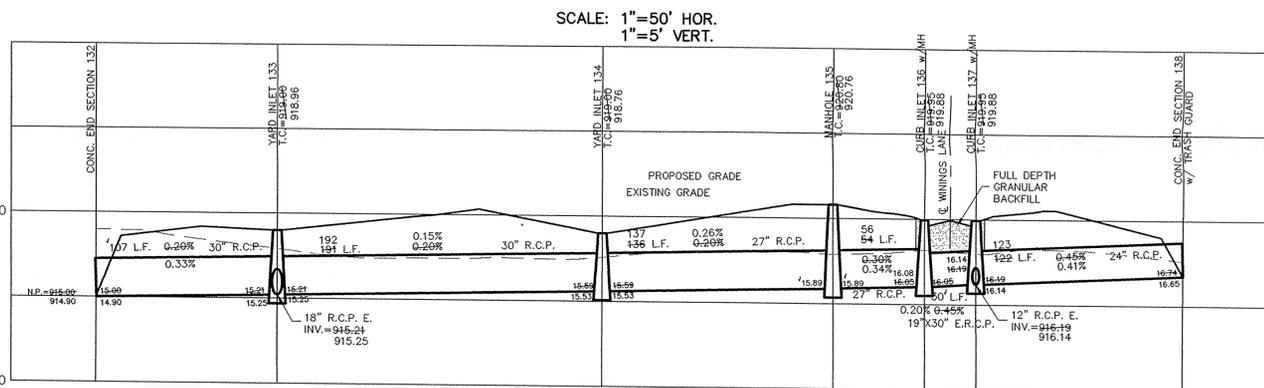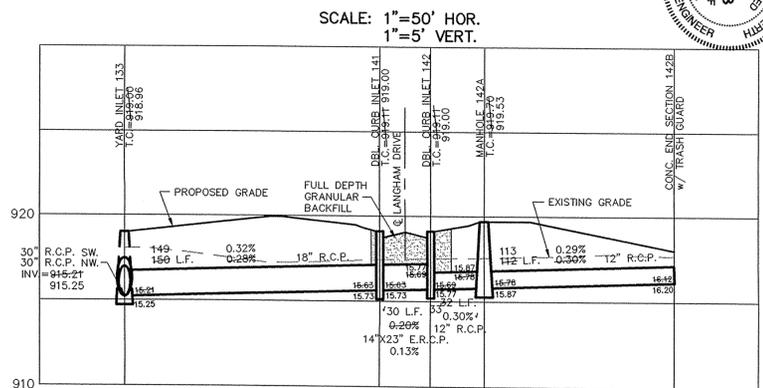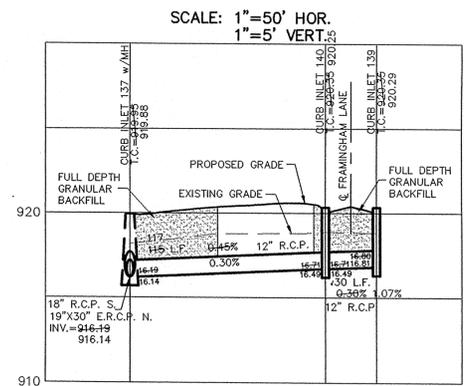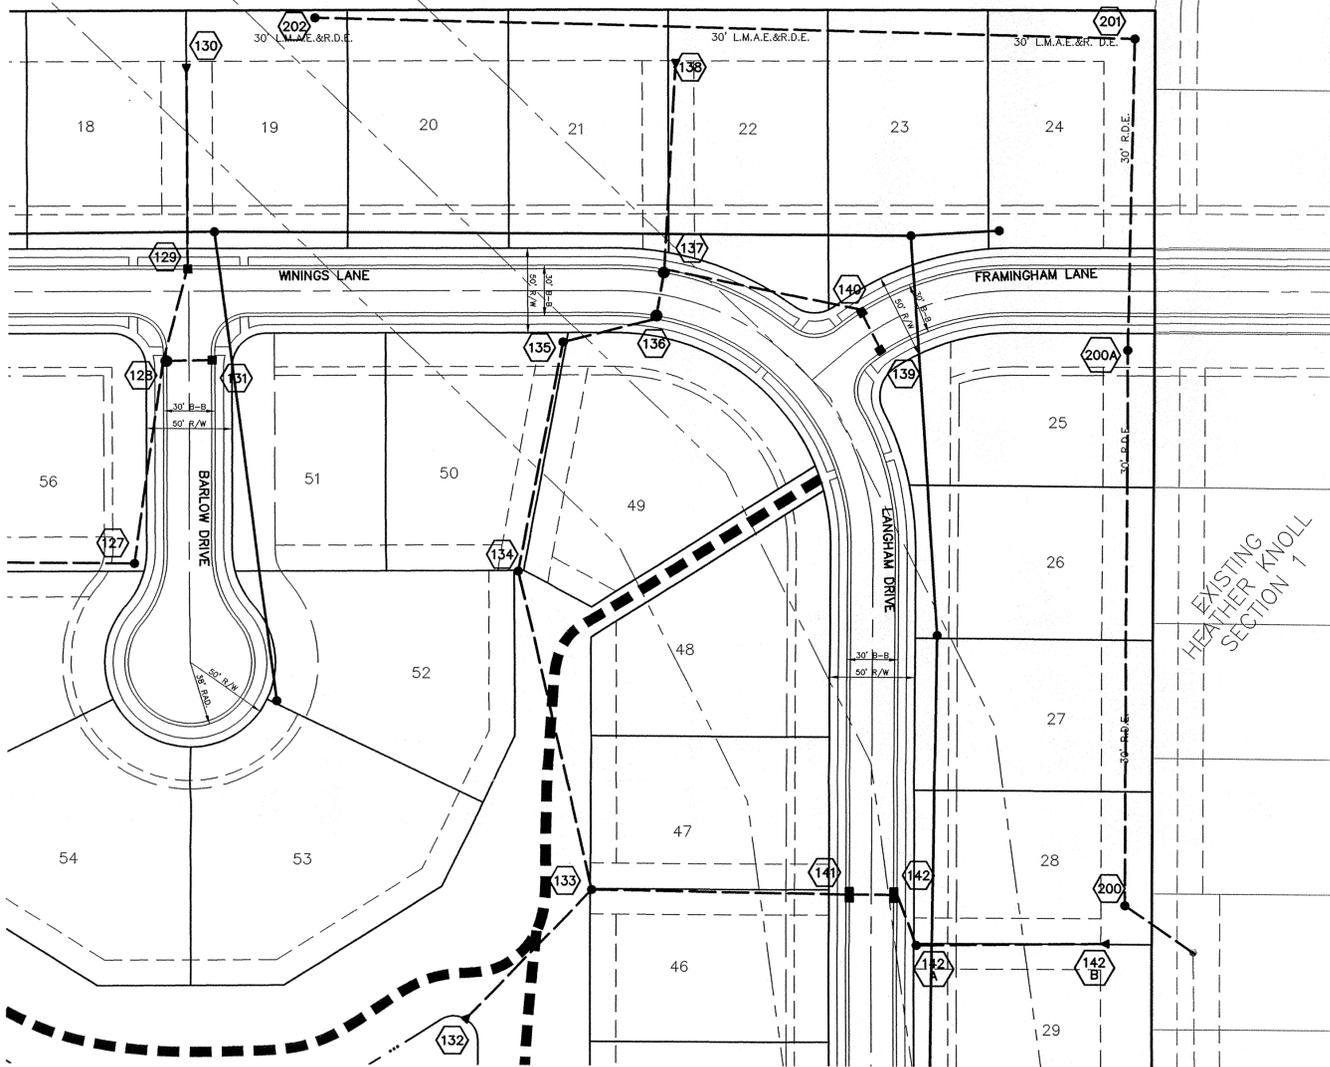

NOTE: BEDDING, HAUNCHING, AND INITIAL BACKFILL FOR ALL RCP INSTALLATIONS SHALL BE B-BORROW FOR STRUCTURE BACKFILL MEETING THE MATERIAL REQUIREMENTS OF THE INDOT. BEDDING SHALL BE PLACED IN THE TRENCH BOTTOM SUCH THAT AFTER THE PIPE IS INSTALLED TO GRADE AND LINE, THERE REMAINS A 4-INCH MINIMUM DEPTH OF MATERIAL BELOW THE PIPE BARREL AND A MINIMUM OF 3-INCHES BELOW THE BELL. FOR PIPE SIZES 66-INCHES AND LARGER, THE MINIMUM DEPTH OF MATERIAL BELOW THE PIPE BARREL SHALL BE 6-INCHES. BEDDING, HAUNCHING AND INITIAL BACKFILL SHALL BE COMPACTED IN 6-INCH MAXIMUM LIFTS TO NOT LESS THAN 95% STANDARD PROCTOR DENSITY FOR THE ENTIRE DEPTH OF THE MATERIAL PLACED. THE BACKFILL SHALL BE BROUGHT UP EVENLY ON BOTH SIDES OF THE PIPE FOR THE FULL LENGTH OF THE PIPE. HAUNCHING SHALL EXTEND TO THE SPRINGLINE OF THE PIPE. THE LIMIT OF INITIAL BACKFILL SHALL BE 6-INCHES ABOVE THE SPRINGLINE. MINIMUM TRENCH WIDTH SHALL BE THE OUTSIDE DIAMETER OF THE PIPE PLUS 18-INCHES.

NOTE: FINAL BACKFILL FOR ALL RCP INSTALLATIONS UNDER AND WITHIN 5- FEET OF PAVEMENT SHALL BE B-BORROW FOR STRUCTURE BACKFILL MEETING THE MATERIAL REQUIREMENTS OF THE INDOT AND SHALL BE COMPACTED IN 6-INCH MAXIMUM LIFTS TO NOT LESS THAN 95% STANDARD PROCTOR DENSITY FOR THE ENTIRE DEPTH OF THE MATERIAL PLACED. THE BACKFILL FOR THE TOP 6-INCHES OF THE EXCAVATION BELOW THE START OF THE AGGREGATE SUBBASE OF THE PAVEMENT SHALL BE NO. 53 STONE MEETING THE MATERIAL REQUIREMENTS OF THE INDOT AND SHALL BE COMPACTED TO NOT LESS THAN 93% STANDARD PROCTOR DENSITY. FINAL BACKFILL FOR ALL RCP INSTALLATIONS GREATER THAN 5- FEET OF PAVEMENT SHALL BE CLEAN FILL MATERIAL FREE OF ROCKS LARGER THAN 6-INCHES IN DIAMETER, FROZEN LUMPS OF SOIL, WOOD OR OTHER EXTRANEOUS MATERIAL, COMPACTED IN 12-INCH MAXIMUM LIFTS TO NOT LESS THAN 90% STANDARD PROCTOR DENSITY FOR THE ENTIRE DEPTH OF THE EXCAVATION.

GASKETS ARE TO BE LEFT OFF OF PIPES FROM STR.#200 THRU #202 WRAP JOINTS WITH THE FILTER FABRIC

This information was gathered for input into the Hamilton County Geographic Information System (GIS). This document is considered an official record of the GIS.

Entry Date: 8-28-07
Entered By: SLM

CERTIFIED: 6/1/04
CONSULTING ENGINEERS - LAND SURVEYORS
(317) 849-5935 1-800-728-6917 FAX: (317) 849-5942
INDIANA
FISHERS
INDIANA
CARMEL
STORM SEWER PLAN & PROFILE
THE TRAILS @ HAYDEN RUN
SHEET NO. C602
JOB NO. 45370EQU