

**Drain:** BRIDGEWATER DRAIN **Drain #:** 245  
**Improvement/Arm:** BRIDGEWATER - SECTION 4  
**Operator:** JDH **Date:** 10-31-03  
**Drain Classification:** Urban/Rural **Year Installed:** 1991

### GIS Drain Input Checklist

- Digitize & Attribute Tile Drains N/A
- Digitize & Attribute Storm Drains JAB 10-31
- Digitize & Attribute SSD JAB 11-3
- Digitize & Attribute Open Ditch N/A
- Sum drain lengths & Validate JAB 11-3
- Enter Improvements into Posse JAB 11-3
- Enter Drain Age into Posse Jan 11-6
- Sum drain length for Watershed in Posse Jan 11-6
- Stamp Plans JAB 11-3
- Pull Source Documents for Scanning JAB 11-3

11-24-2003 Qc'd summary OK SIM ✓

**Gasb 34 Footages for Historical Cost  
Drain Length Log**

Drain-Improvement: BRIDGEWATER DRAIN-SECTION 1

Drain Type:	Size:	Length <small>SURVEYOR'S PLANS AS QUILTS</small>	Length (DB Query)	Length Reconcile	If Applicable	
					Price:	Cost:
SSD	6"	5530	5450'	-80'		
RCP	12"	673'	673'	∅		
	15"	737'	737'	∅		
	18"	327'	327'	∅		
	21"	142'	142'	∅		
CMP	15"	225'	225'	∅		
	18"	85'	85'	∅		
	21"	230'	230'	∅		
Sum:		<u>7,949'</u>	<u>7,869'</u>	<u>-80'</u>		

Final Report: \_\_\_\_\_

Comments:

SURVEYOR'S REPORT SHOWS INCORRECT LENGTH OF 7,999', THIS SHOULD BE 7,949'  
AS QUILTS SHOW 7,949'

80' DIFFERENCE IN SSD (6") IS DUE TO REMOVAL OF 80' OF SSD WHEN SECTION 2 WAS CONSTRUCTED  
(SEE AS QUILTS FOR SECTION 2).

**Gasb 34 Footages for Historical Cost  
Drain Length Log**

Drain-Improvement: BRIDGEWATER DRAIN - SECTION 1


Drain Type:	Size:	Length (SURVEYOR'S REPORT AS QUILTS)	Length (DB Query)	Length Reconcile	If Applicable	
					Price:	Cost:
SSD	6"	5530'	5,450'	Ø		
RCP	12"	673'	673'	Ø		
	15"	737'	737'	Ø		
	18"	327'	327'	Ø		
	21"	142'	142'	Ø		
CMP	15"	225'	225'	Ø		
	18"	85'	85'	Ø		
	21"	230'	230'	Ø		

Sum: 7,949' 7,869' Ø

Final Report: \_\_\_\_\_

Comments:

SURVEYOR'S REPORT SHOWS TOTAL LENGTH AS 7,999' WHICH IS INCORRECT.  
AS QUILTS SHOW LENGTH OF 7,949' WHICH IS CORRECT.

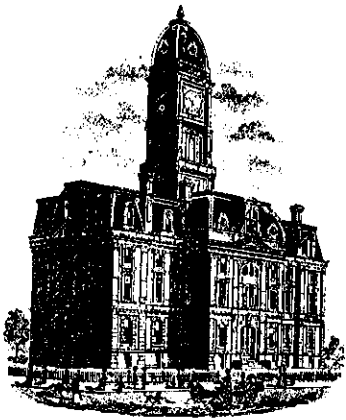

SURVEYOR'S OFFICE  
**Hamilton County**

*Kenton C. Ward, Surveyor*

776-9626

942 Maple Avenue May 15, 1991  
Noblesville, Indiana 46060

TO: Hamilton County Drainage Board

RE: Bridgewater Drain-Section 1

Attached is a petition, non-enforcement request, plans, calculations, constructions contract and assessment roll for the Bridgewater Drain, Section 1.

I have reviewed the submittals and petition and have found each to be in proper form.

I have made a personal inspection of the land described in the petition. Upon doing so, I believe that the drain is practicable; will improve the public health; benefit a public highway and be of public utility; and that the costs, damages and expenses of the proposed drain will probably be less than the benefits accruing to the owners of land likely to be benefitted. The drain will consist of the following:

6" SSD	5530ft	18" RCP	327ft
12" RCP	673ft	18" CMP	85ft
15" RCP	962ft	21" RCP	372ft


The total length of the drain will 7999 feet.

Subsurface Drain (SSD) main line under the roadway curb shall be part of the regulated drain. Laterals to each lot will not be

considered as part of the regulated drain system. The existing 18" pipe under Fall Creek Road is to be considered as part of the regulated drain system including its outlet into Geist Reservoir.

I have reviewed the plans and believe the drain will benefit each lot equally. Therefore, I recommend each lot be assessed equally. I recommend a maintenance assessment of \$30.00 per lot, \$5.00 per acre for roadways, with a \$30.00 minimum. With this assessment the total annual assessment for the drain/this section will be \$ 1207.80 .

I recommend a hearing be set for July 1991. I also recommend the Board approve the attached non-enforcement request upon approval of this project.

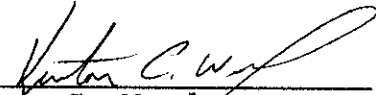  
\_\_\_\_\_  
Kenton C. Ward  
Hamilton County Surveyor

KCW/no

STATE OF INDIANA )  
 )  
COUNTY OF HAMILTON )

TO: HAMILTON COUNTY DRAINAGE BOARD  
% Hamilton County Surveyor, Courthouse, Noblesville, IN 46060

In the matter of Bridgewater Subdivision,  
Section \_\_\_\_\_ Drain Petition.

Petitioner is the owner of all lots in the land affected by the proposed new regulated drain. The drainage will affect various lots in Bridgewater Section One, a subdivision in Hamilton County, Indiana. The general route of such drainage shall be in existing easements and along public roads as shown in the plans on file in the Surveyor's Office.

Petitioner believes that the cost, damages and expenses of the proposed improvement will be less than the benefits which will result to the owners of the land likely to be benefited thereby. Petitioner believes the proposed improvements will:

- (a) improve public health
- (b) benefit a public street
- (c) be of public utility

Petitioner agrees to pay the cost of construction of the drainage system and requests periodic maintenance assessments by the Board thereafter.

The Petitioner also agrees to the following:

1. To provide the Drainage Board a Performance Bond for the portion of the drainage system which will be made a regulated drain. The bond will be in the amount of 100% of the Engineers estimate. The bond will be in effect until construction of 100% of the system is completed and so certified by the Engineer.
2. The Petitioner shall retain an Engineer throughout the construction phase. At completion of the project the Petitioner's Engineer shall certify that the drainage system which is to be maintained as a regulated drain has been constructed as per construction plans.

3. The Petitioner agrees to request in writing to the County Surveyor any changes from the approved plan and must receive written authorization from the County Surveyor prior to implementation of the change. All changes shall be documented and given to the Surveyor to be placed in the Drain File.
  
4. The Petitioner shall instruct his Engineer to provide a reproducible print on a 24" x 36" mylar of the final design of the Drainage System. This shall be submitted to the County Surveyor prior to the release of the Performance Bond.
  
5. The Petitioner shall comply with the Erosion Control Plan as as specified on the construction plans. Failure to comply with the Erosion Control Plan shall be determined by the Board as being an obstruction to the drainage system. The County Surveyor shall immediately install or repair the needed measures at Petitioners cost as per IC 36-9-27-46.

The Petitioner further requests that the Drain be classified as an Urban Drain.

*Allen E. Rosenberg*

Signed \_\_\_\_\_

Allen Rosenberg

Printed Name  
 President The Marina II Corporation  
 General Partner of the Marina Limited  
 Partnership

Signed \_\_\_\_\_

Printed Name \_\_\_\_\_

RECORDED OWNER(S) OF LAND INVOLVED

DATE \_\_\_\_\_

**Irrevocable Letter of Credit**

INB National Bank  
One Indiana Square  
Indianapolis, Indiana 46266



**INB**

Date: **April 30, 1991bj**

SWIFT Address: INBI US 44 Telex Number 205615 Phone: 266-6153

INB NO.  
**SB 035472**

Credit Number Advising Bank No.

Advising Bank

Applicant

**The Marina Limited Partnership  
20999 Hague Road  
Noblesville, Indiana 46060**

Beneficiary

**Hamilton County Commissioners &  
Hamilton County Drainage Board  
Court House  
Noblesville, Indiana 46060**

Amount

**USD 58,200.00**

Expiration Date

**April 29, 1994**

We hereby issue in your favor this irrevocable letter of credit which is available against the following documents:

Drafts drawn at— **SIGHT**

on **INB National Bank**

bearing the clause; "Drawn under irrevocable letter of credit No. **SB 035472**

Other documents:

**Certification by the Hamilton County Commissioners and Hamilton County Drainage Board of Noblesville, Indiana, for non-compliance with the specifications required for storm sewers in Bridgewater subdivision, Section I, by The Marina Limited Partnership, such certification may not antedate the Letter of Credit and:**

**Certification by the Hamilton County Commissioners and Hamilton County Drainage Board of Noblesville, Indiana, that funds drawn under this Letter of Credit will be used to bring the storm sewers into compliance in accordance with the specifications referenced.**

Special Conditions:

We hereby engage with  You  drawers and/or bona fide holders that drafts drawn and negotiated in conformity with the terms of this credit will be duly honored on presentation and that drafts accepted within the terms of this credit will be duly honored at maturity.

The amount of each draft must be endorsed on the reverse of this credit by the negotiating bank.

~~The amount of each draft must be endorsed on the reverse of this credit by the negotiating bank.~~

Very truly yours,

Advising Bank's Notification

Place/date/name/signature of advising bank.

Except so far as otherwise expressly stated, this documentary credit is subject to the Uniform Customs and Practice for Documentary Credits (1993 Revision) International Chamber of Commerce (Publication No. 400)

SWIFT CODE: INBIUS33



**CERTIFICATE OF COMPLETION AND COMPLIANCE**

TO: HAMILTON COUNTY SURVEYOR

RE: Bridgewater Subdivision, Section One

I hereby certify that:

- 1.) I am a Registered Land Surveyor In the State of Indiana,
- 2.) I am familiar with the plans and specifications for the above referenced subdivision,
- 3.) I have personally observed and supervised the completion of the Drainage Facilities for the above referenced subdivision, and
- 4.) To the best of my knowledge, information and belief, the Drainage Facilities within the subdivision has been installed and completed in conformity with all plans and specifications.

Signature: Joseph A. Sharp Date: May 17, 1991

Type or Printed Name: Joseph A. Sharp


Business Address: 7172 Graham Road

Indianapolis, IN 46250

Telephone: (317) 842-6777

INDIANA REGISTERED NUMBER

15179

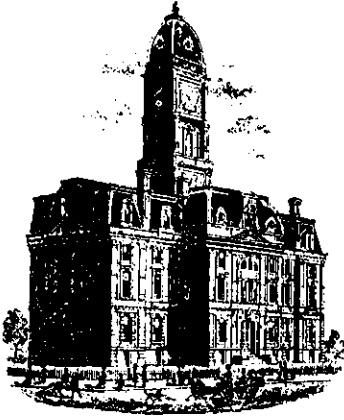

SURVEYOR'S OFFICE  
**Hamilton County**

*Kenton C. Ward, Surveyor*

*Phone (317) 776-8495*

*Fax (317) 776-9628*

*Suite 146*

*One Hamilton County Square*

*Noblesville, Indiana 46060-2230*

July 23, 1996

TO: Hamilton County Drainage Board

RE: Bridgewater Drain-Section 1


Attached are As-Builts, Certificate of Completion and Compliance, and other information for Bridgewater Drain-Section 1. An inspection of the drainage facilities for this section has been made and the facilities were found to be complete and acceptable.

During construction of the drain there were not any significant changes made to the plan submitted with my report dated May 15, 1991. Therefore, the length of the drain remains at 7,999 feet. Note STR 607 to End Section was incorrectly reported as RCP instead of CMP as was STR 611 to End Section.


The non-enforcement was approved by the Board at its meeting on July 15, 1991.

The Bond or Letter of Credit from INB, Number 035472, dated April 30, 1991, in the amount of \$58,200.00, has been recommended for release in a letter to the Commissioners dated October 22, 1991.


I recommend the Board approve the drains construction as complete and acceptable.

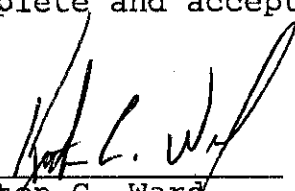  
\_\_\_\_\_  
Kenton C. Ward  
Hamilton County Surveyor  
KCW/no

NOTE:  
 1. CUTS SHOWN ARE APPROXIMATE, TAKEN FROM EXISTING GRADE TO INVERT OF PIPE.  
 2. FIELD ADJUSTMENT BY ENGINEER MAY BE REQUIRED AT ALL OUTFALL POINTS TO INSURE PROPER OUTFALL CONDITIONS.

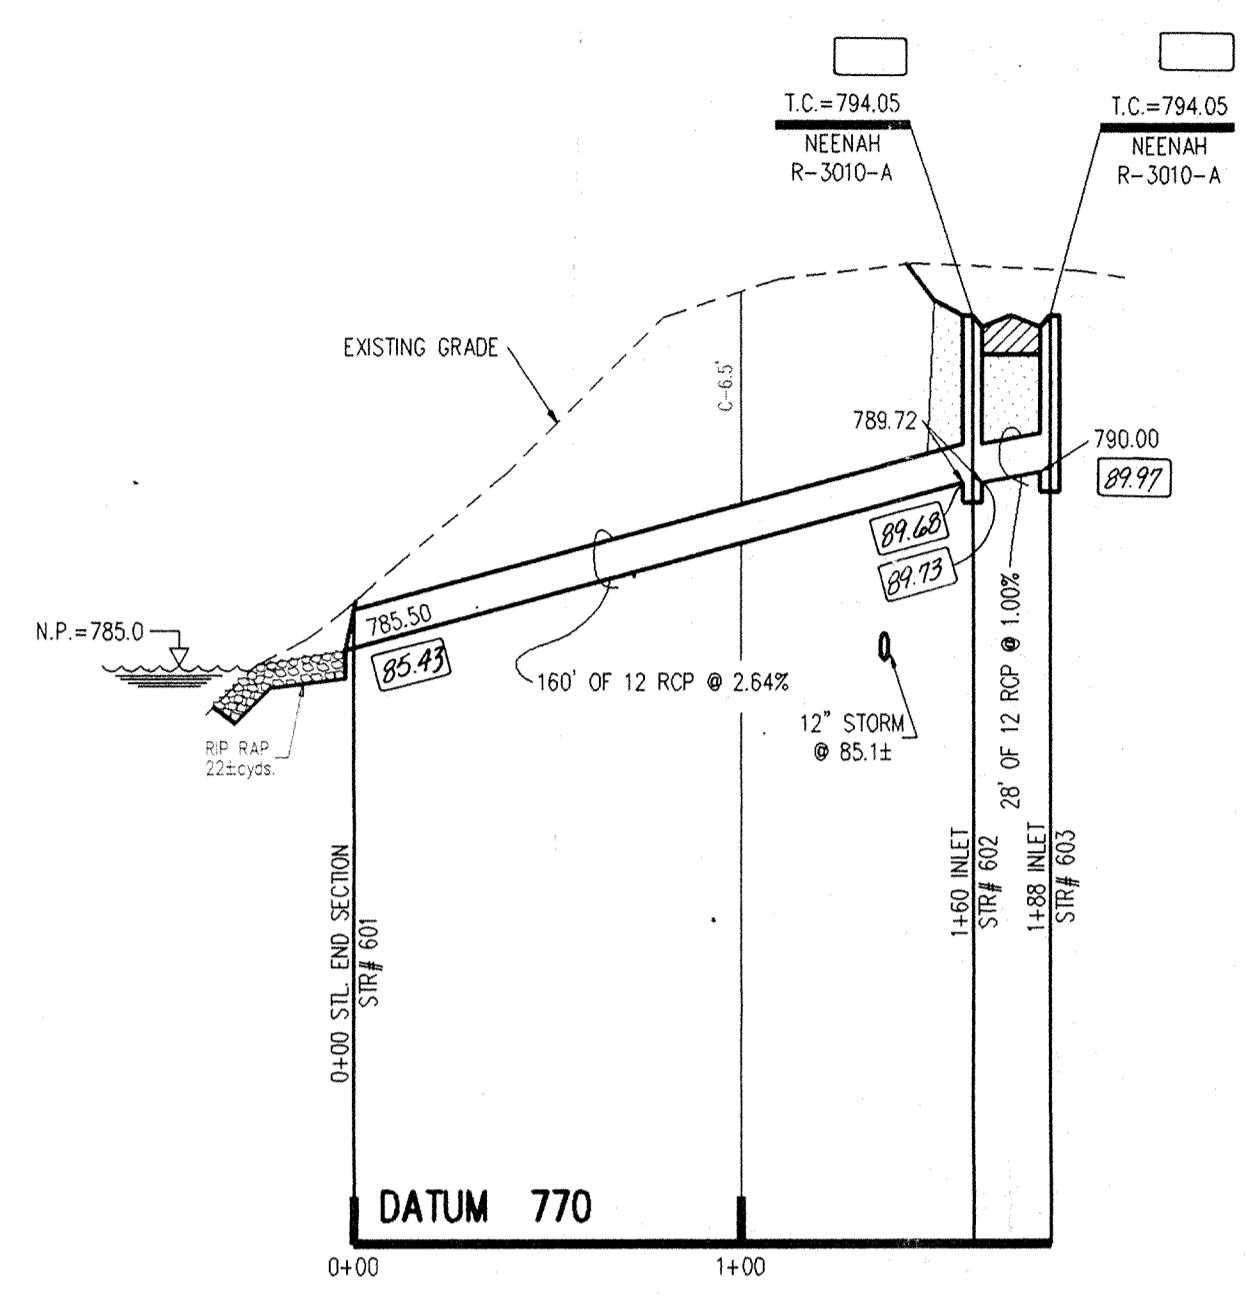


**PROFILE ONE**

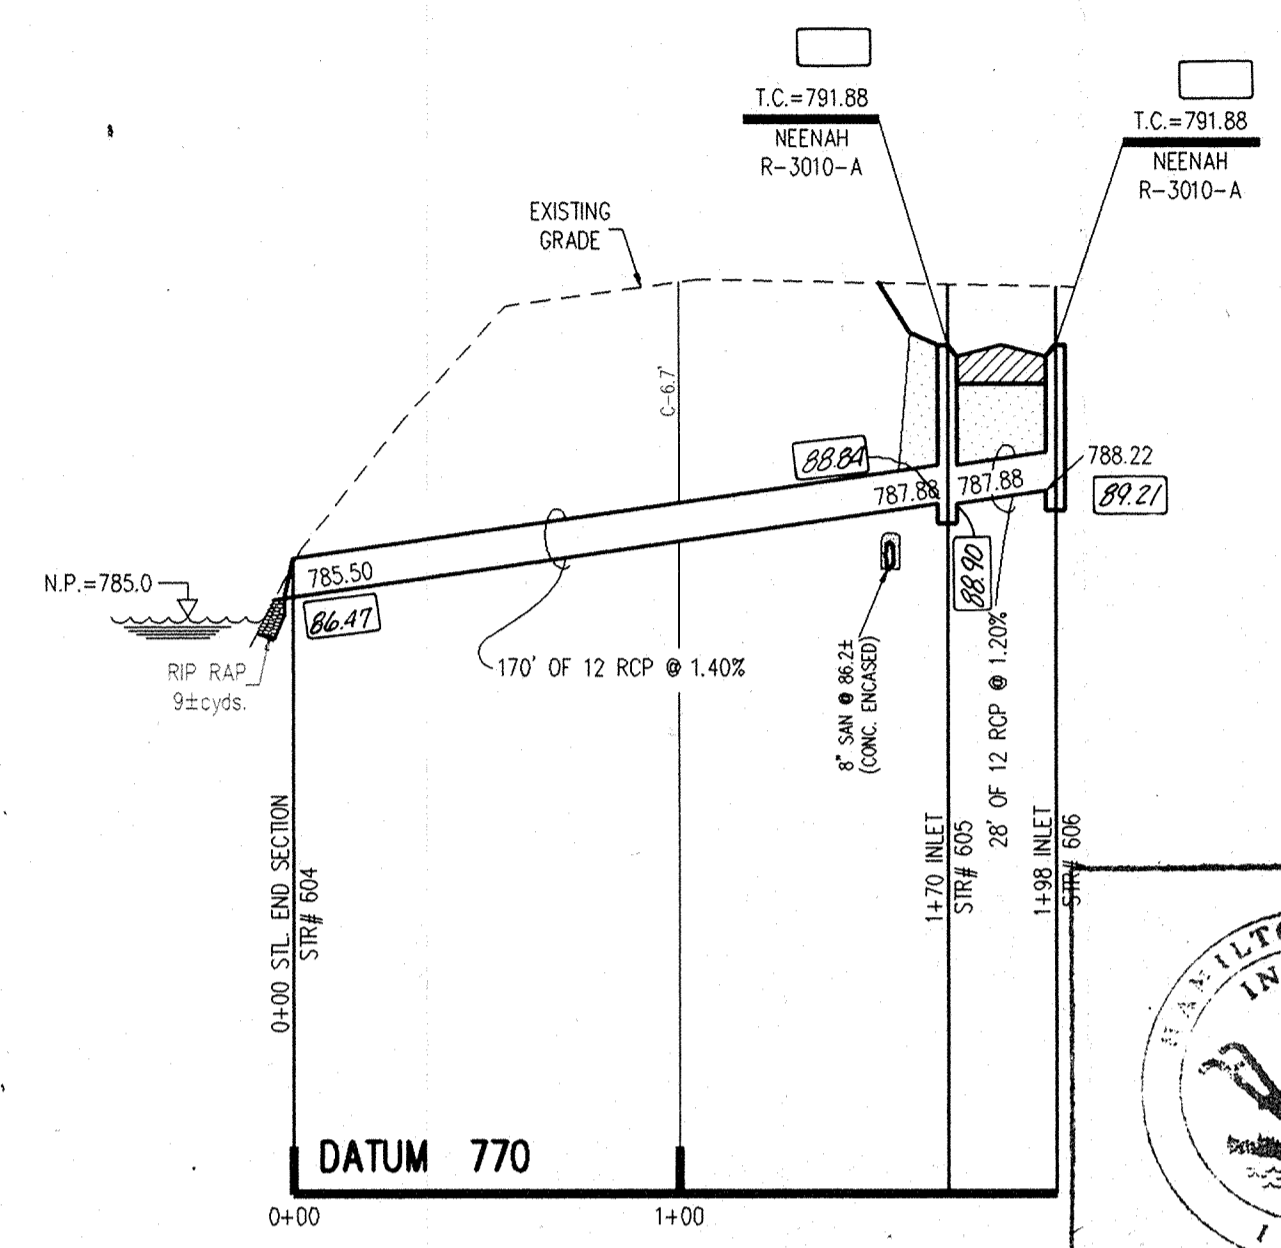


**PROFILE TWO**




This information was gathered for input into the Hamilton County Geographical Information System. This document is considered an official record of the GIS.  
 Entry Date: 10-31-03  
 Entered by: JDH

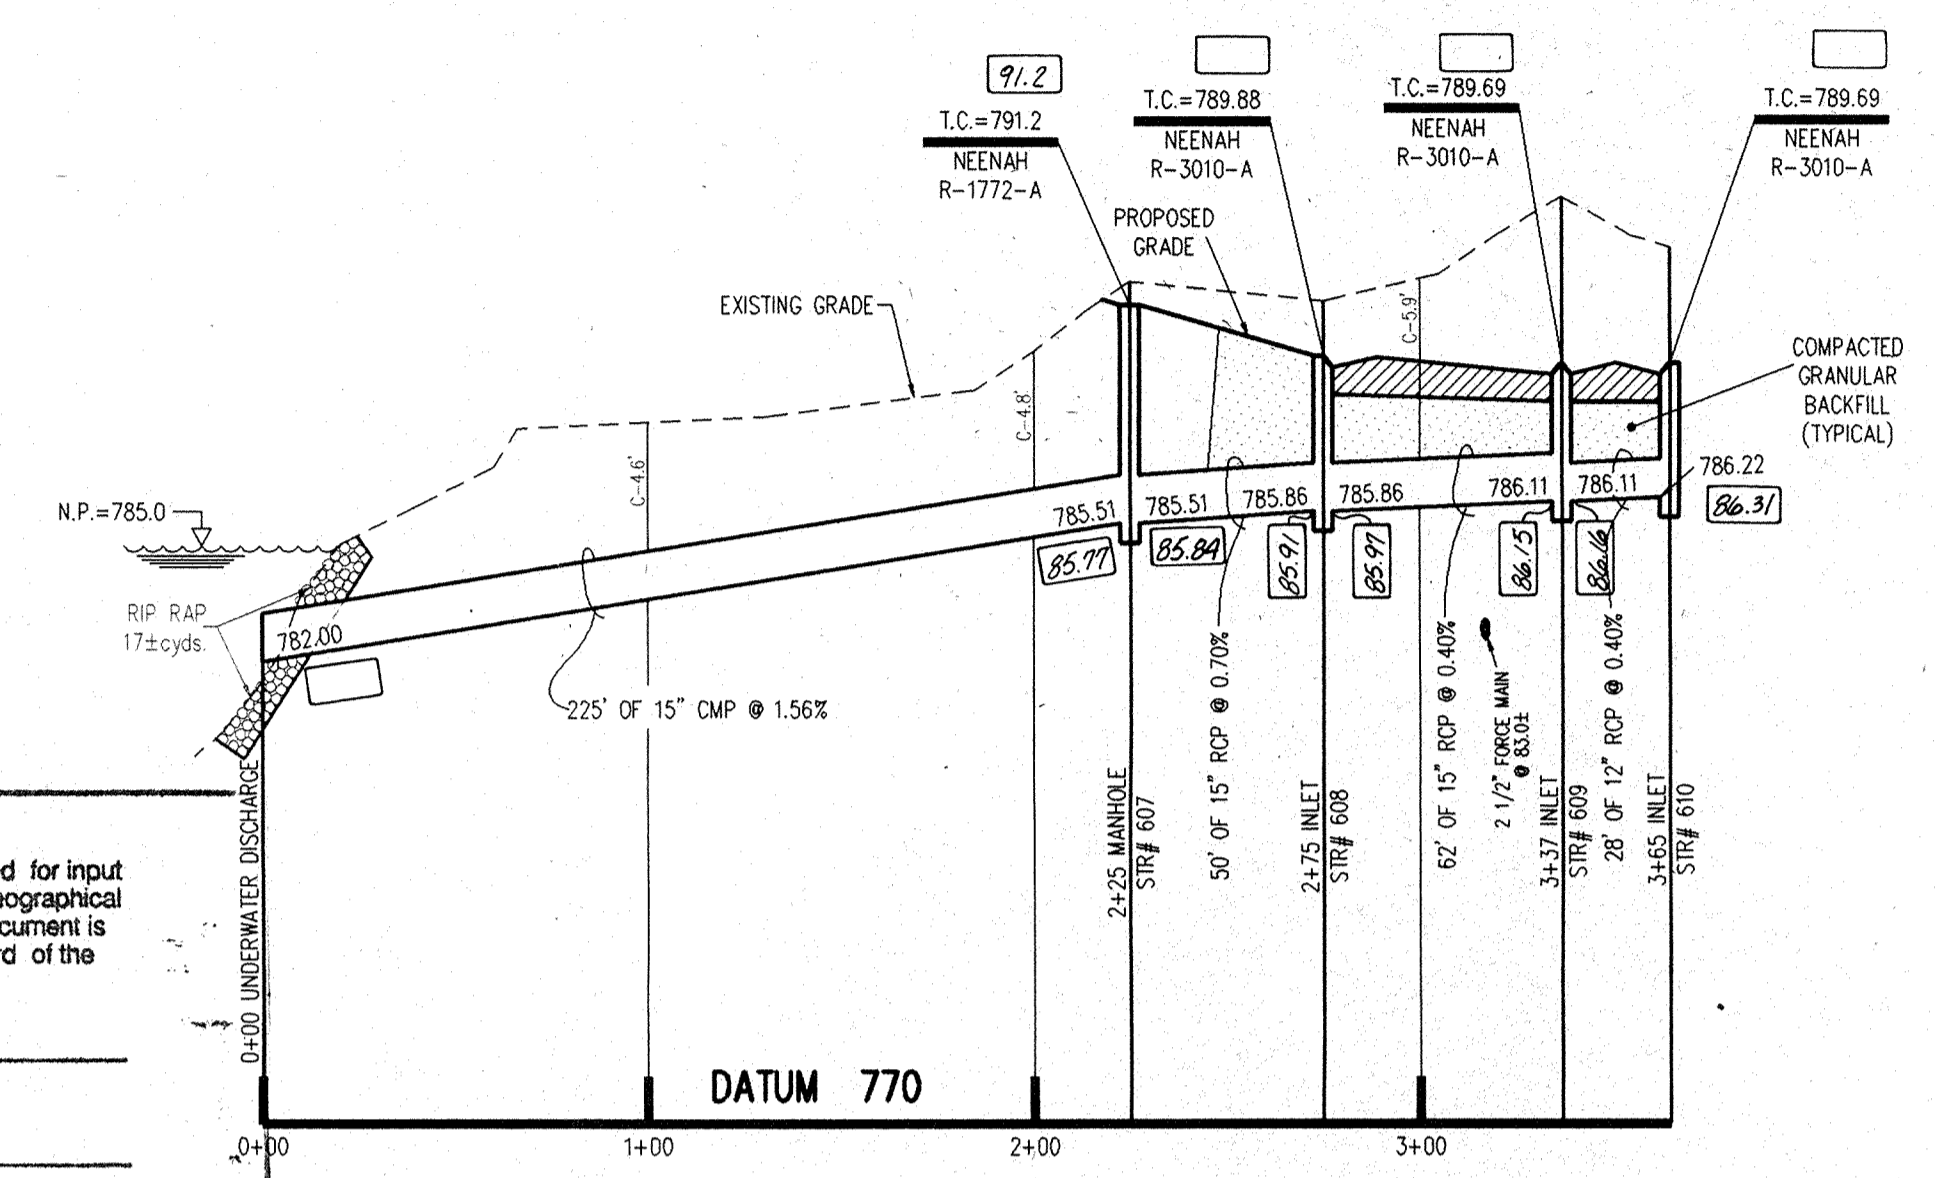


**PROFILE THREE**

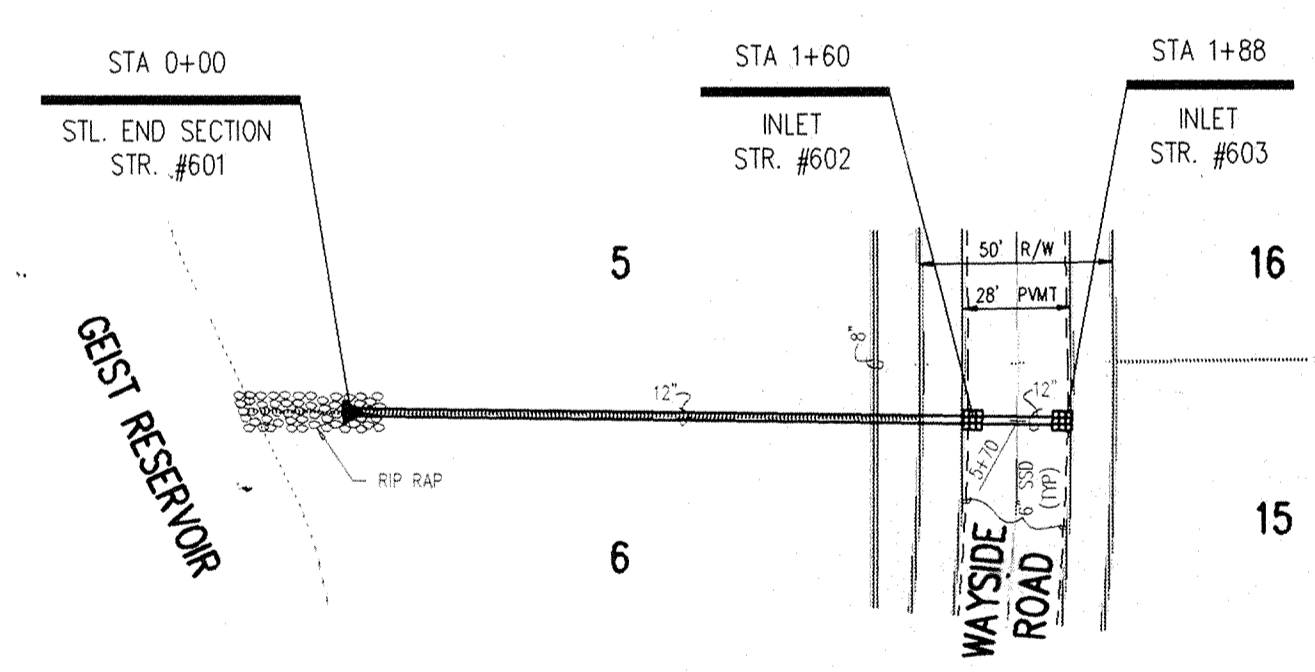

**PLAN ONE**

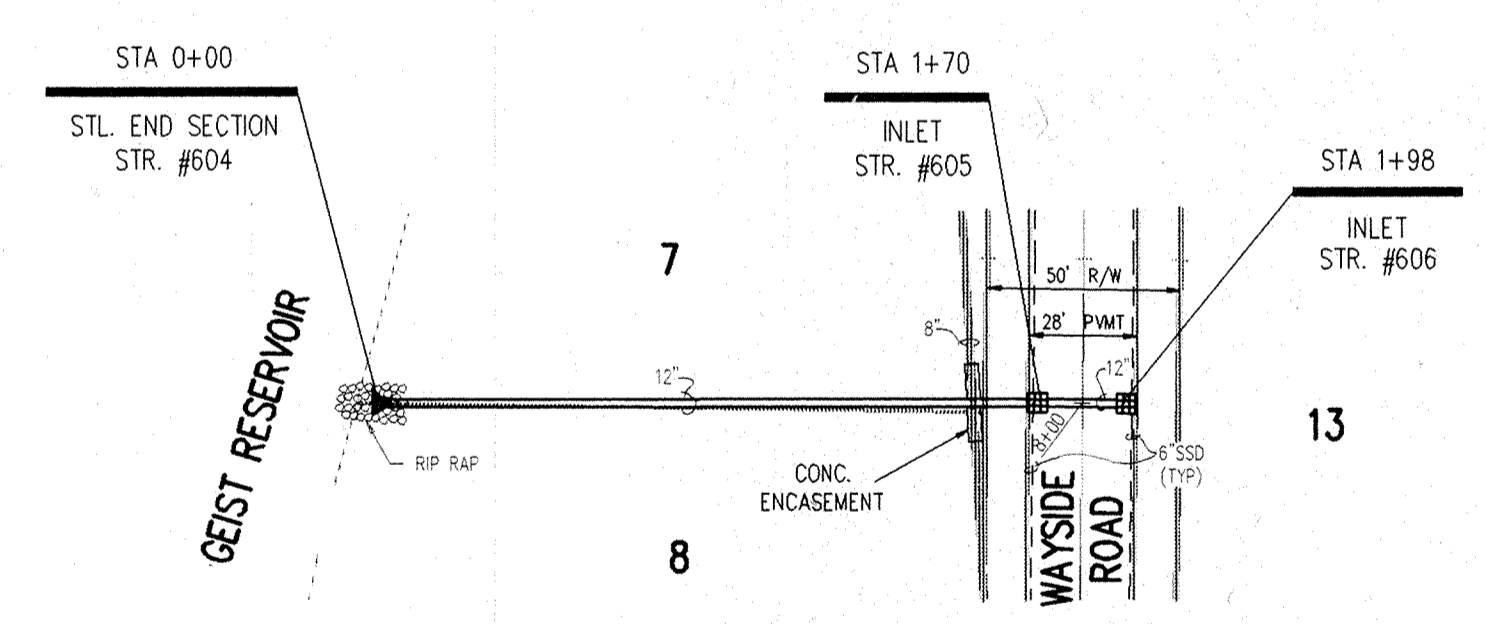

**PLAN TWO**

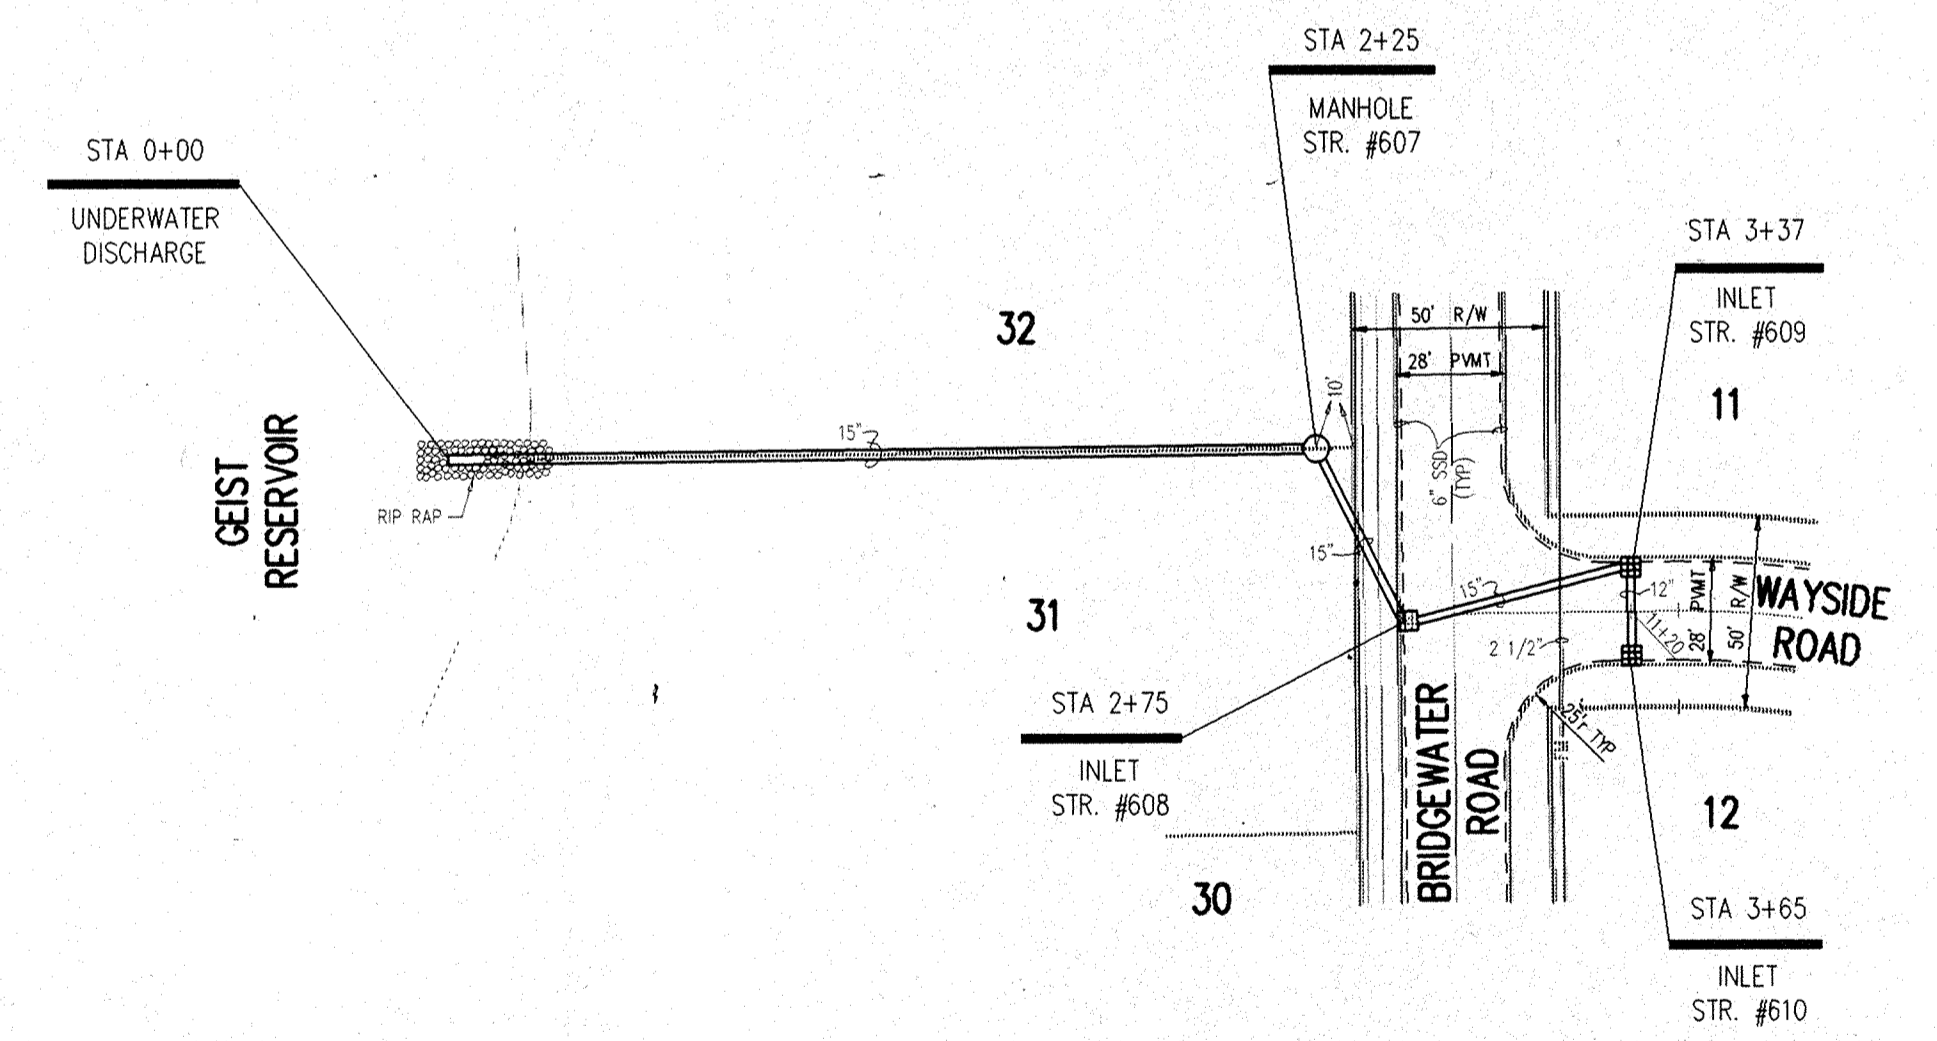


**PLAN THREE**

DATE: 08-09-1990 TIME: 08:18 FILE: D:\001081



CERTIFIED BY: *Joseph A. Sharp*  
 DATE: 6-26-90

REVISIONS	
7-16-90	REV. PER DRAFT AND TECH. CHECK
8-8-90	REV. SANITARY SEWERS
4-2-91	ADDED 85-DEGREE INFO TO S&P

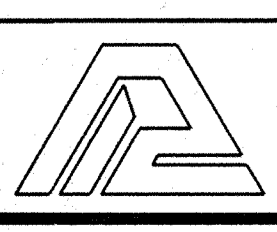

**PAUL I. CRIFE, INC.**  
 7172 GRAHAM ROAD  
 INDIANAPOLIS, INDIANA 46250  
 (317) 842-6777

- CIVIL ENGINEERING
- LAND SURVEYING
- ARCHITECTURE
- LAND PLANNING

ENG. CHK: \_\_\_\_\_  
 DRAWN BY: *JDH*  
 TECH. CHK: *AG*  
 DRAFTING CHK: *JDH*


SCALE: HORZ. 1"=50'  
 VERT. 1"=5'  
 DATE: 6-9-90  
 CLIENT: MARINA

DRAWING TITLE: **STORM SEWER - PLAN & PROFILE**

DWG. TYPE	FILE NUMBER	SHEET: <b>13</b>
JOB NUMBER		OF 17
801108-210210		

BRIDGEWATER - SECTION ONE  
 MAY 08 1991  
 HAMILTON COUNTY SURVEYOR


NOTE:  
 1. CUTS SHOWN ARE APPROXIMATE, TAKEN FROM EXISTING GRADE TO INVERT OF PIPE.  
 2. FIELD ADJUSTMENT BY ENGINEER MAY BE REQUIRED AT ALL OUTFALL POINTS TO INSURE PROPER OUTFALL CONDITIONS.




This information was gathered for input into the Hamilton County Geographical Information System. This document is considered an official record of the GIS.

Entry Date: 10-31-93

Entered by: JDH

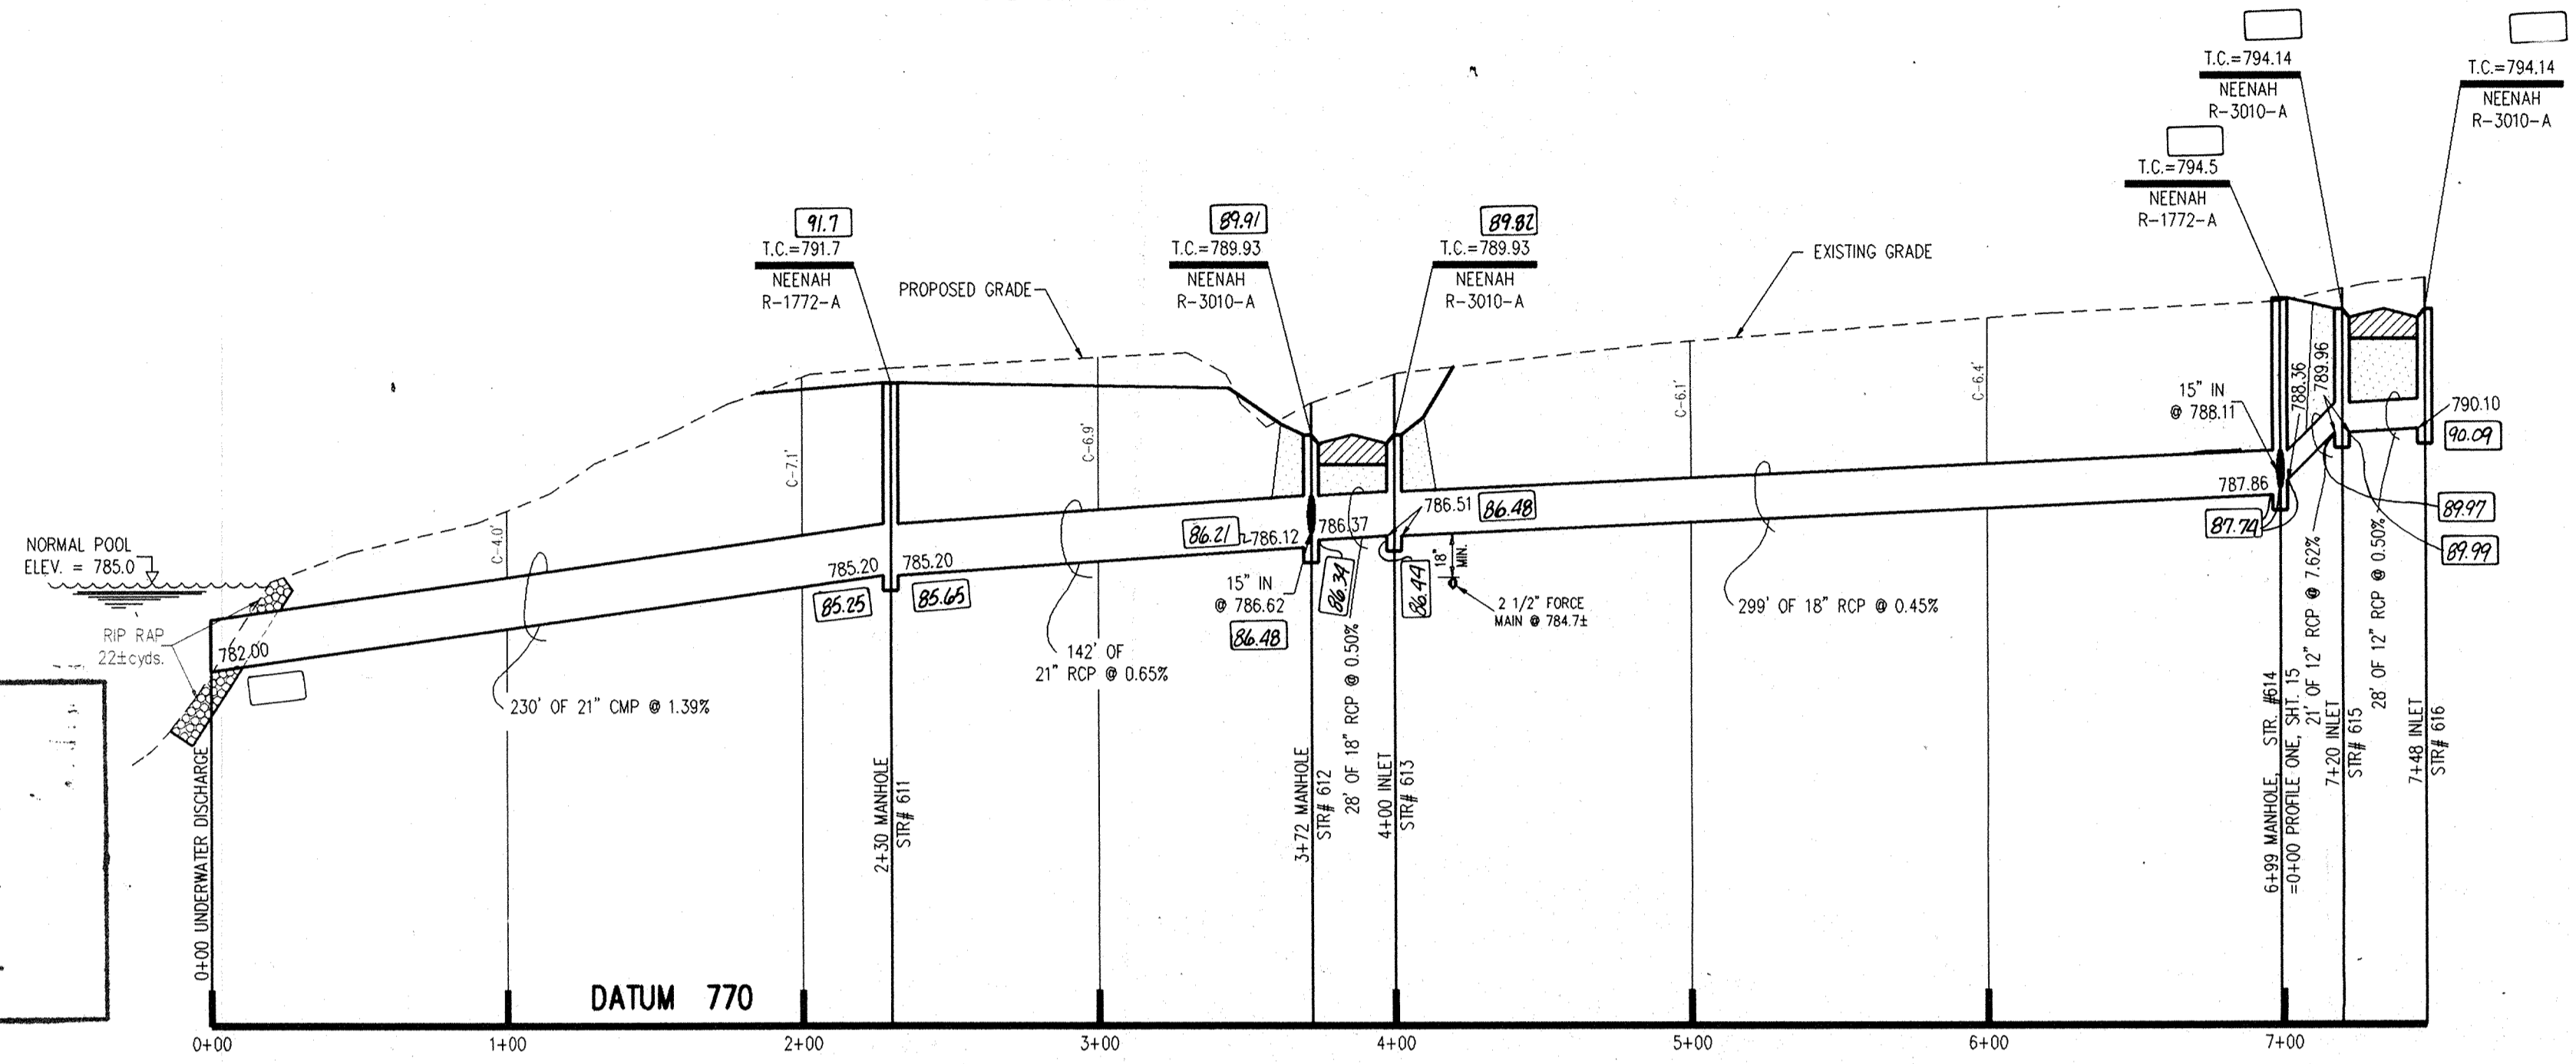

**PROFILE ONE**

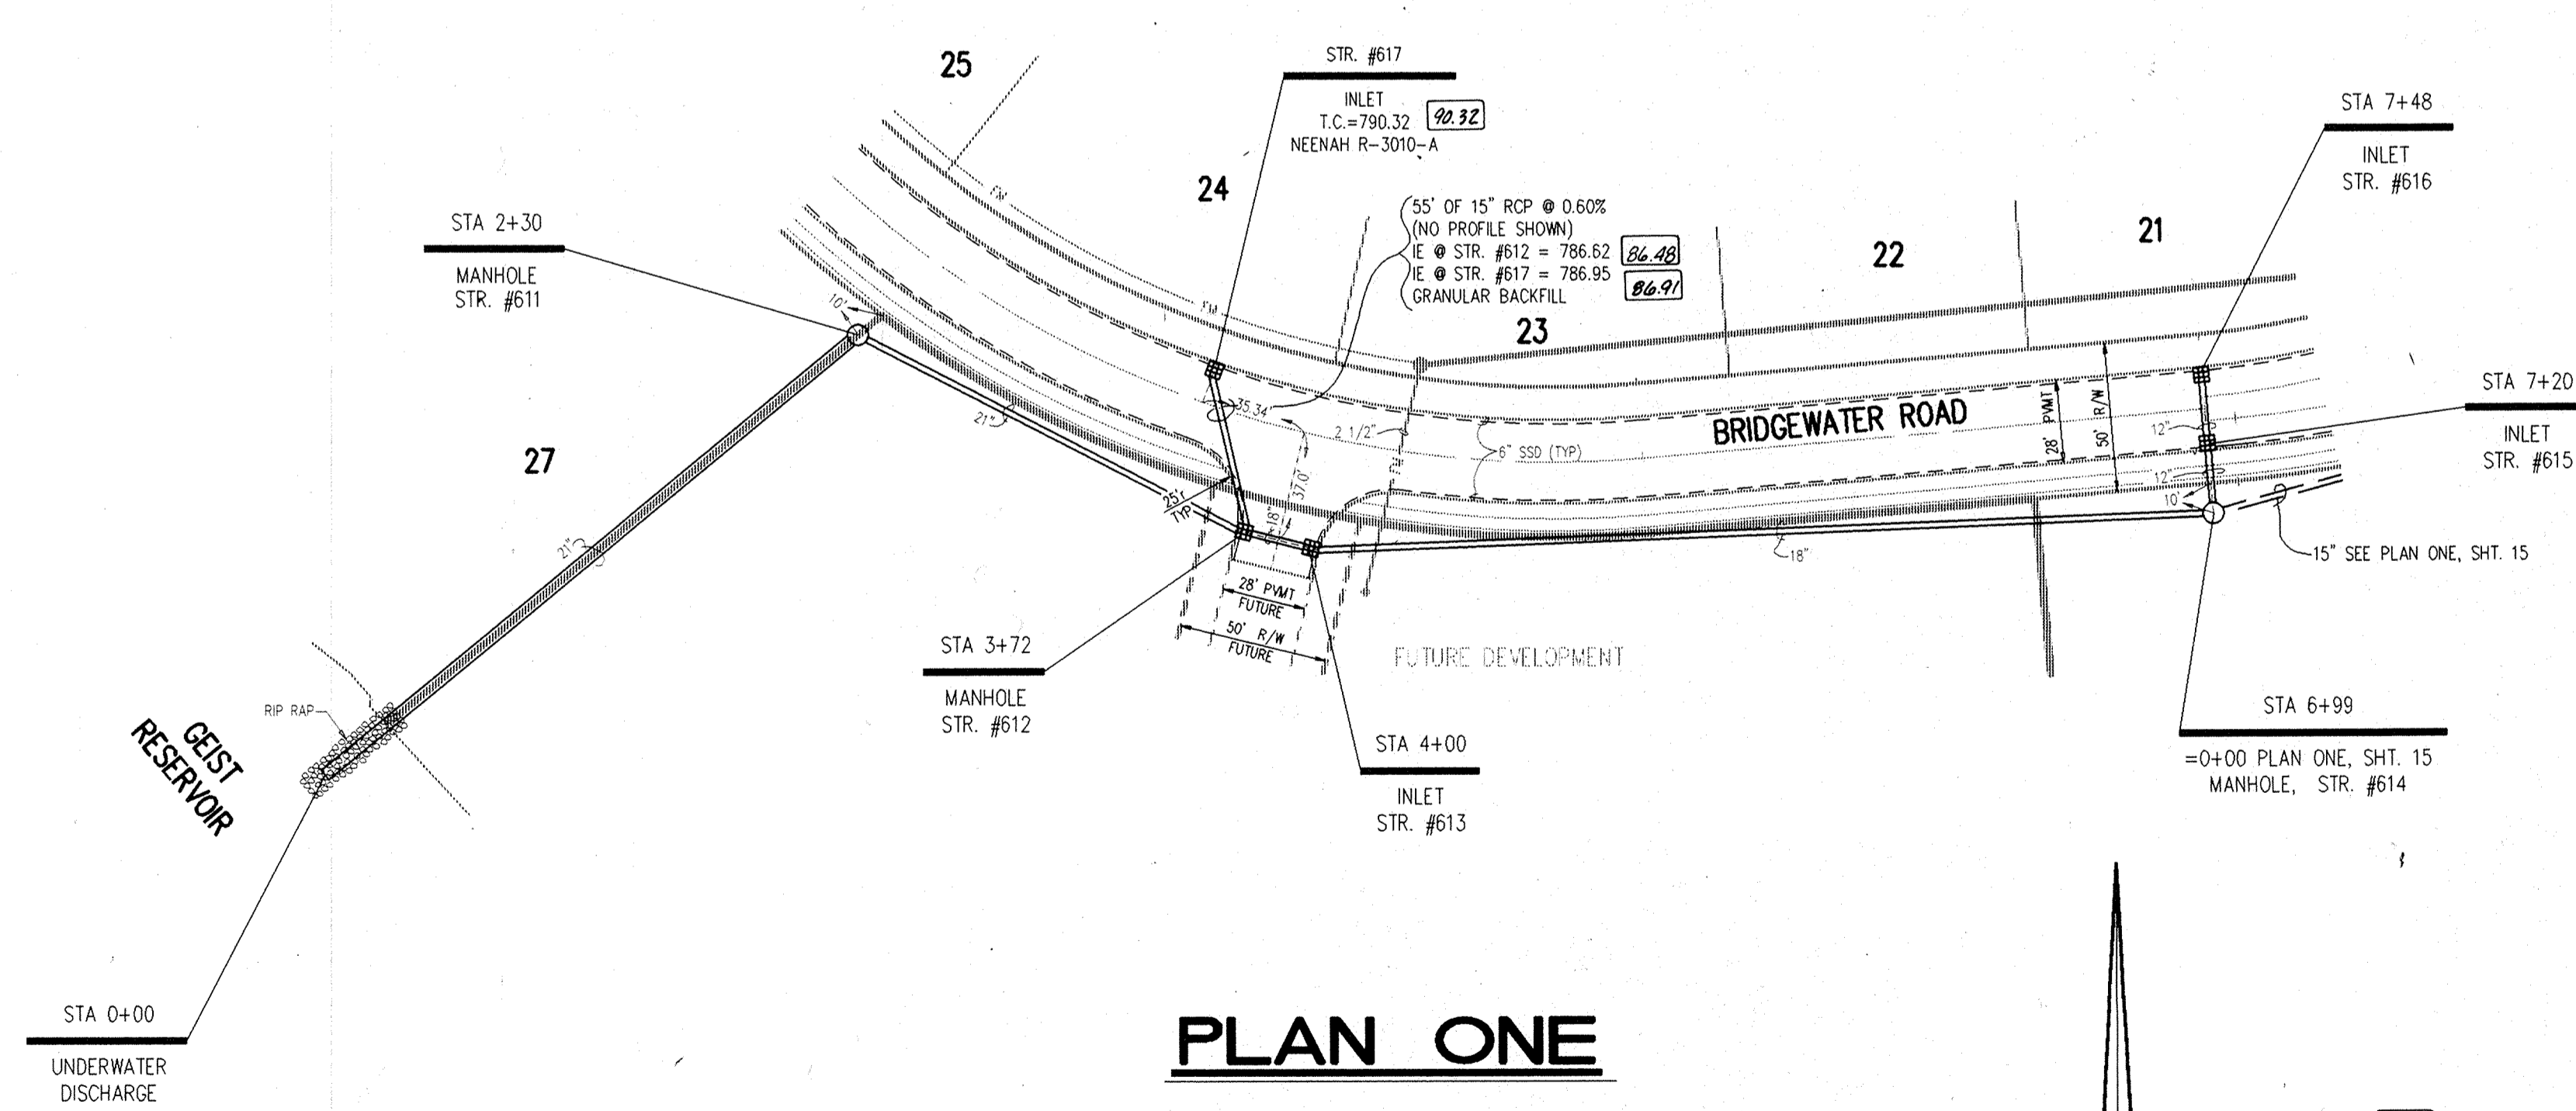

**PLAN ONE**

22.00' = AS-BUILT INFORMATION


FILED  
 MAY 08 1994  
 OFFICE OF HAMILTON COUNTY SURVEYOR

DATE: 08-09-1990 TIME: 08:23 FILE: D:800827



CERTIFIED BY:  
*Joseph A. Shyne*  
 6-26-90 DATE

REVISIONS	
7-16-90	REV. PER DRAFT AND TECH. CHECK
8-8-90	REV. SANITARY SEWERS
4-2-91	ADDED AS-BUILT INFO TO S&P UNCS

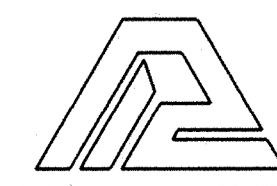

**PAUL I. CRIFE, INC.**  
 7172 GRAHAM ROAD  
 INDIANAPOLIS, INDIANA 46250  
 (317) 842-6777

- CIVIL ENGINEERING
- LAND SURVEYING
- ARCHITECTURE
- LAND PLANNING

ENG. CHK: \_\_\_\_\_  
 TECH. CHK: JG  
 DRAWN BY: JAS  
 DRFTNG. CHK: JAS


SCALE: HORZ. 1"=50'  
 VERT. 1"=5'  
 DRAWING TITLE: **STORM SEWER - PLAN & PROFILE**

DATE: 6-6-90  
 CLIENT: **MARINA**


DWG. TYPE	FILE NUMBER
JOB NUMBER	
801108-120200	

SHEET: **14**  
 OF 17


NOTE:  
 1. CUTS SHOWN ARE APPROXIMATE, TAKEN FROM EXISTING GRADE TO INVERT OF PIPE.  
 2. FIELD ADJUSTMENT BY ENGINEER MAY BE REQUIRED AT ALL OUTFALL POINTS TO INSURE PROPER OUTFALL CONDITIONS.

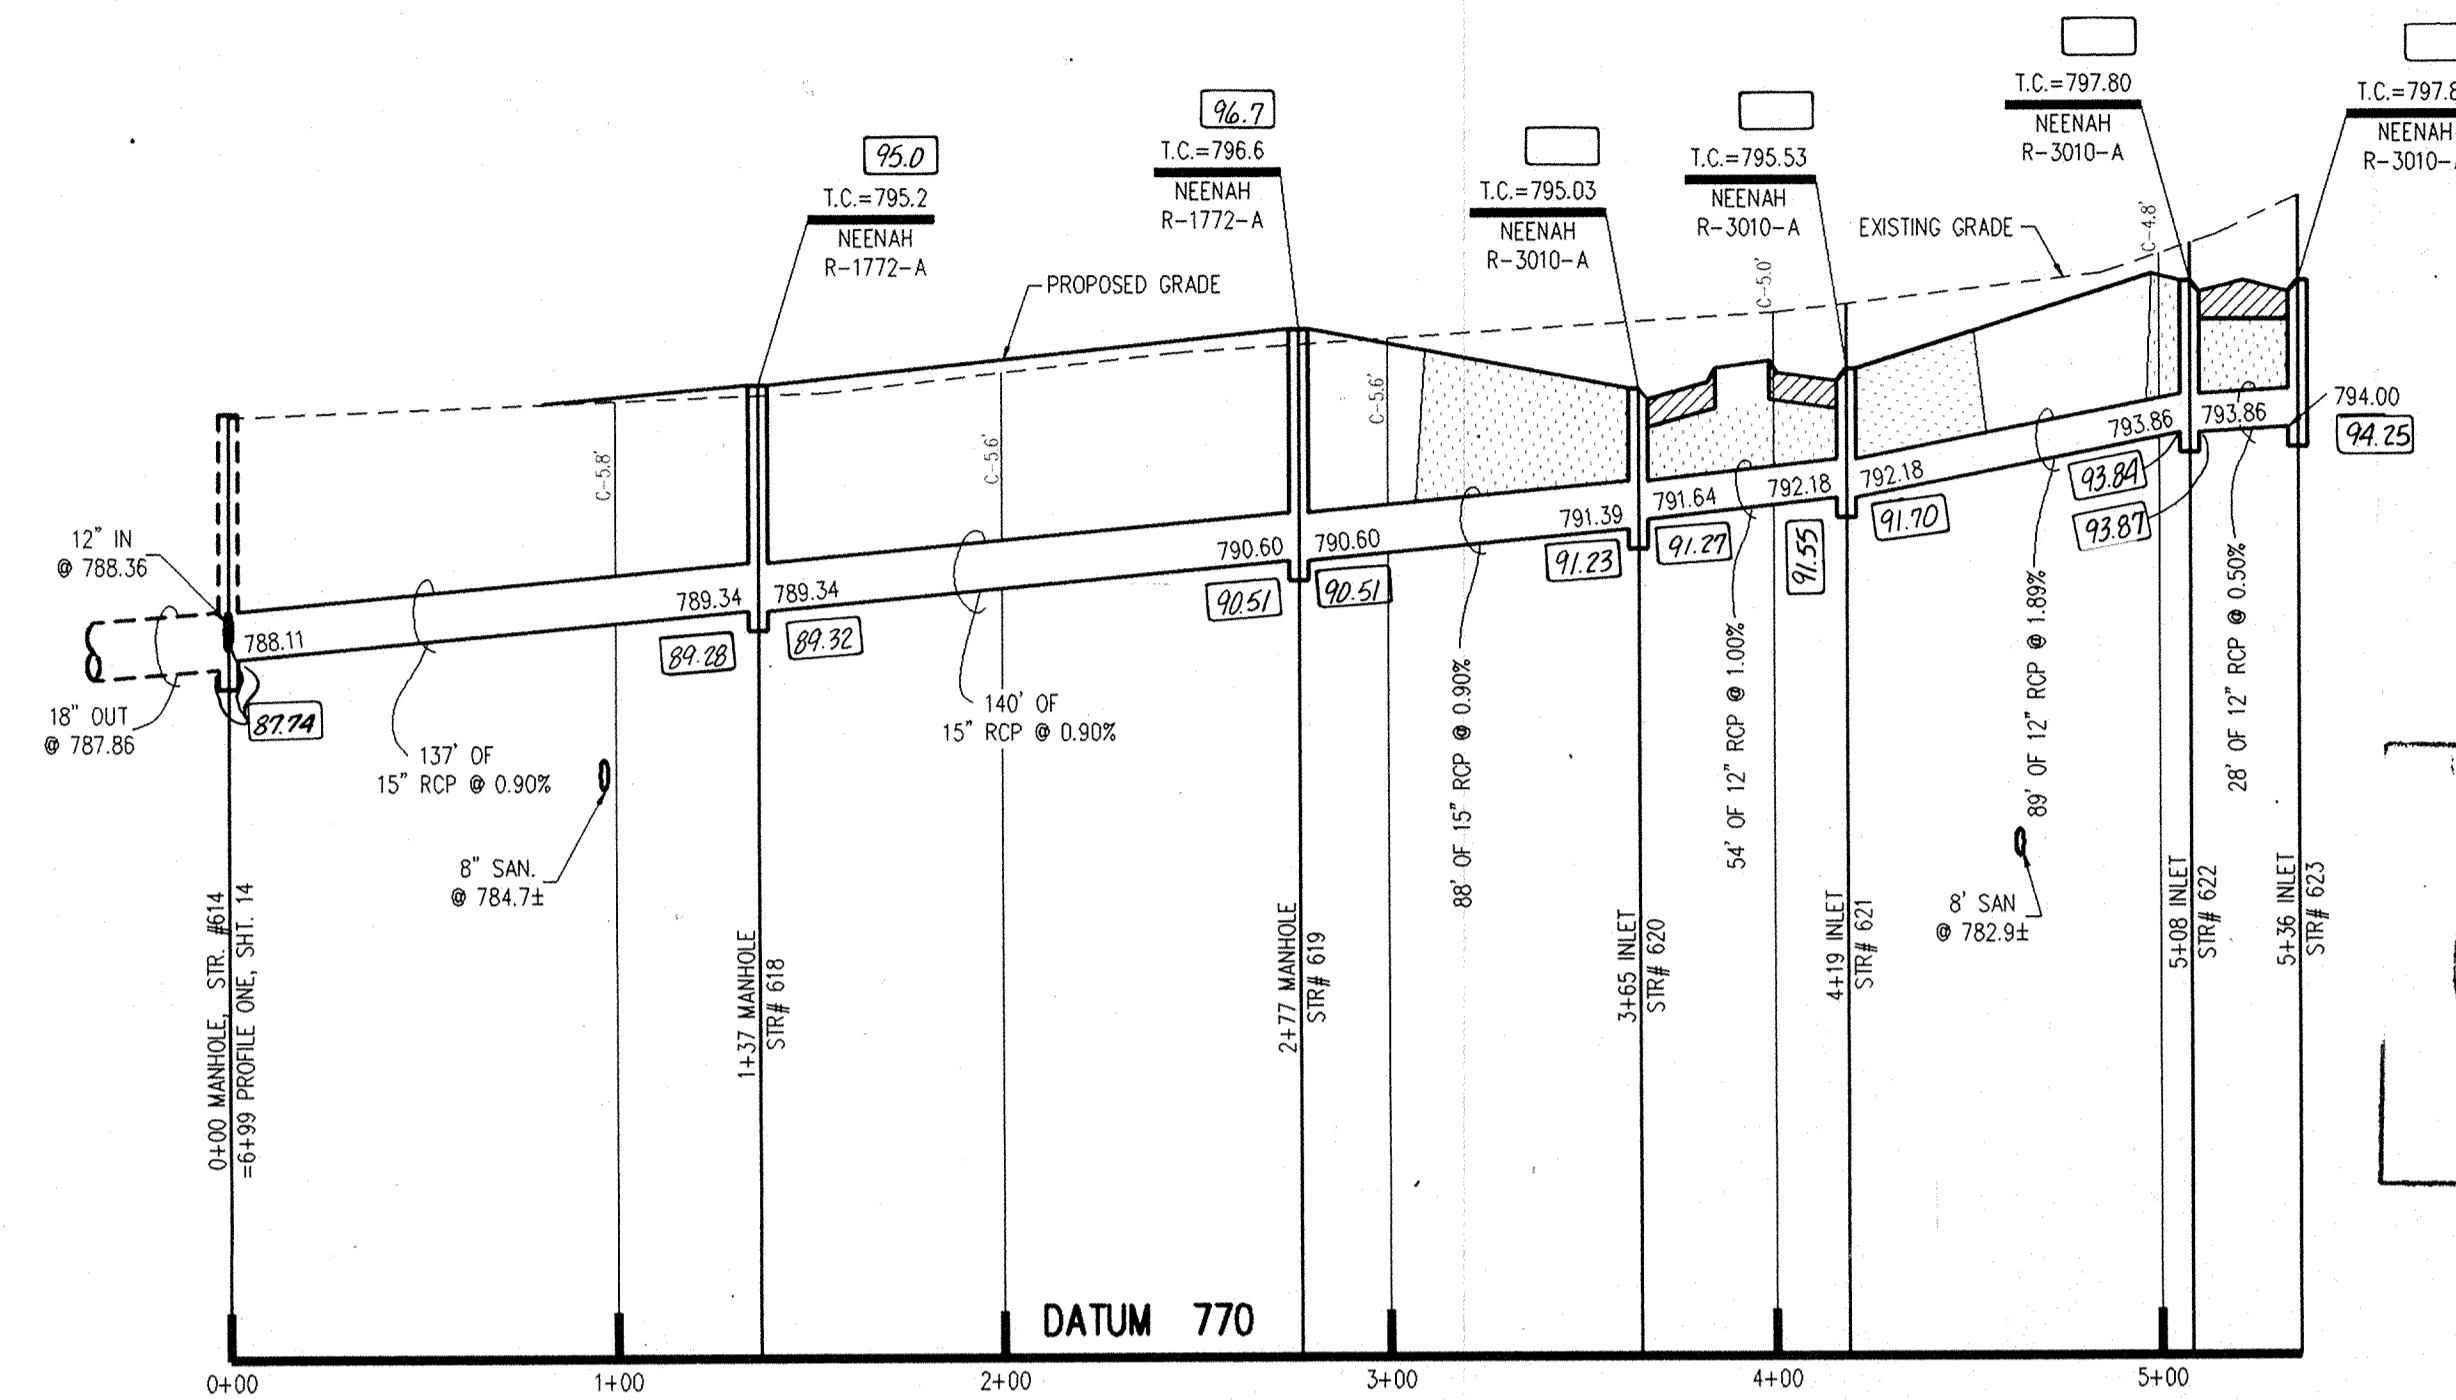


**PROFILE ONE**

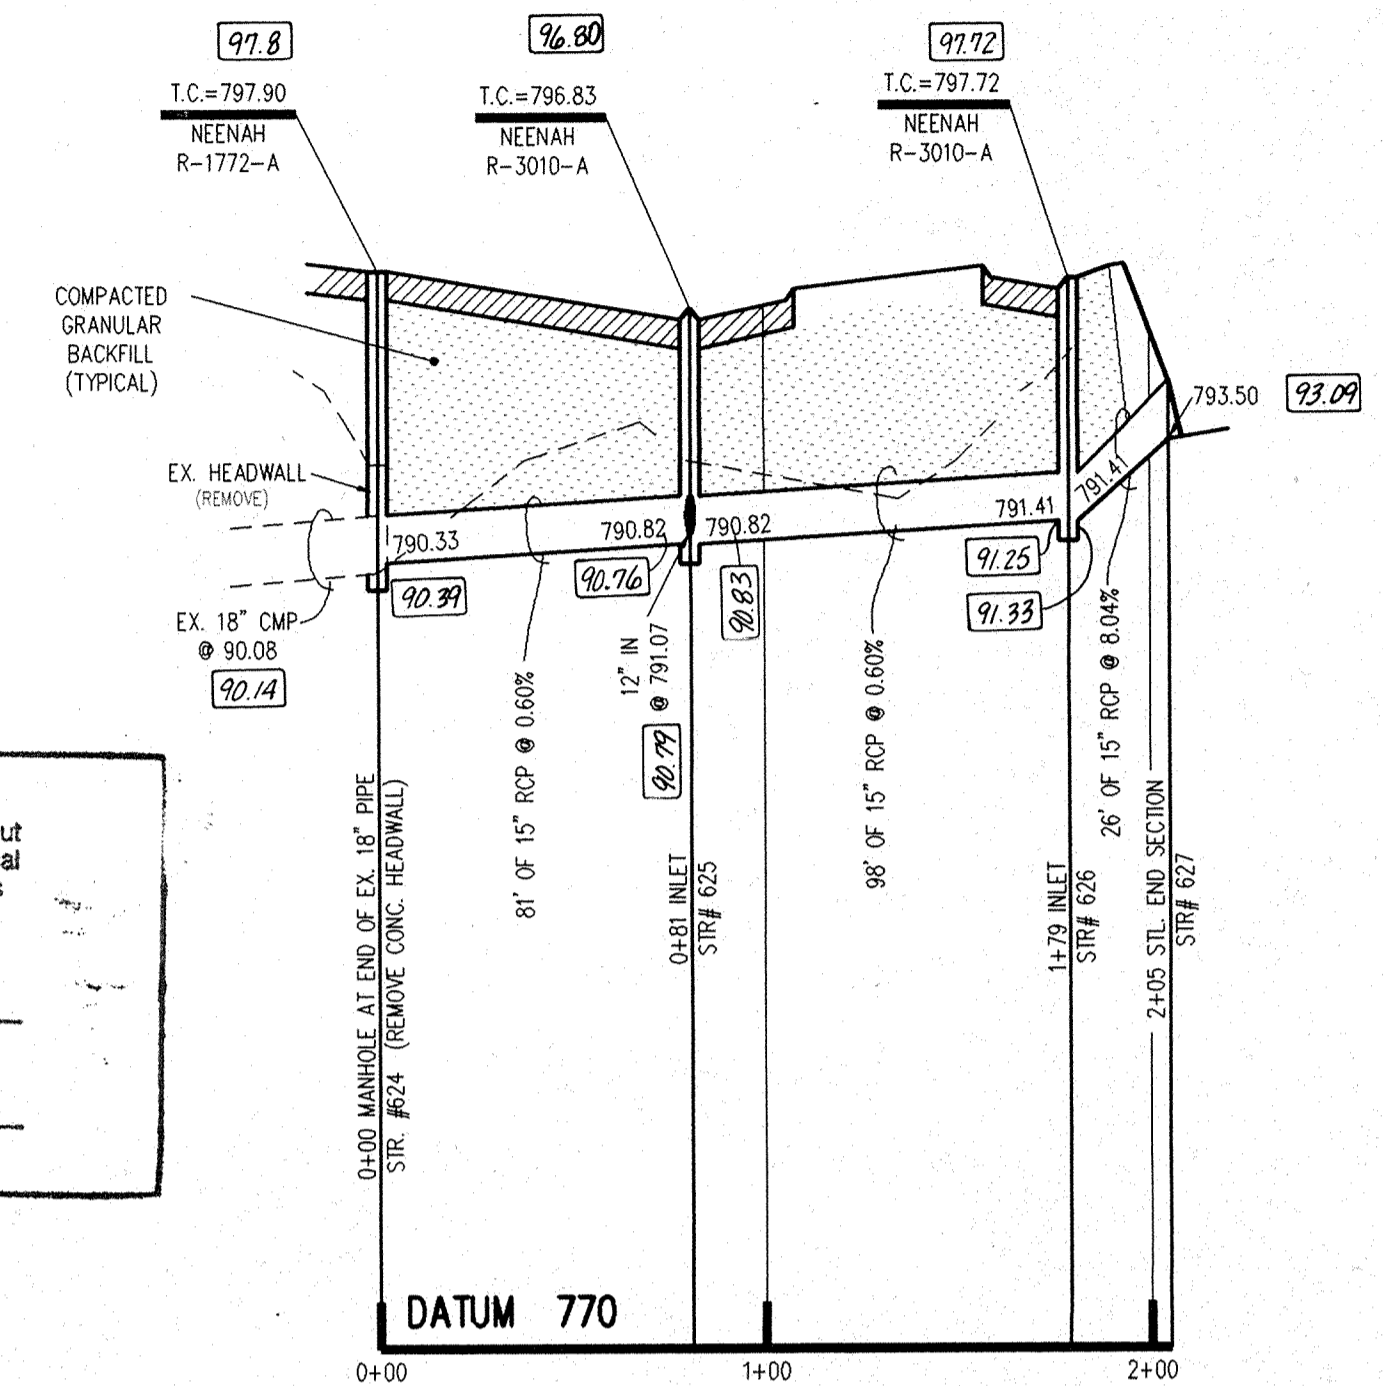


**PROFILE TWO**


 This information was gathered for input into the Hamilton County Geographical Information System. This document is considered an official record of the GIS.  
 Entry Date: 10-31-03  
 Entered by: JDH

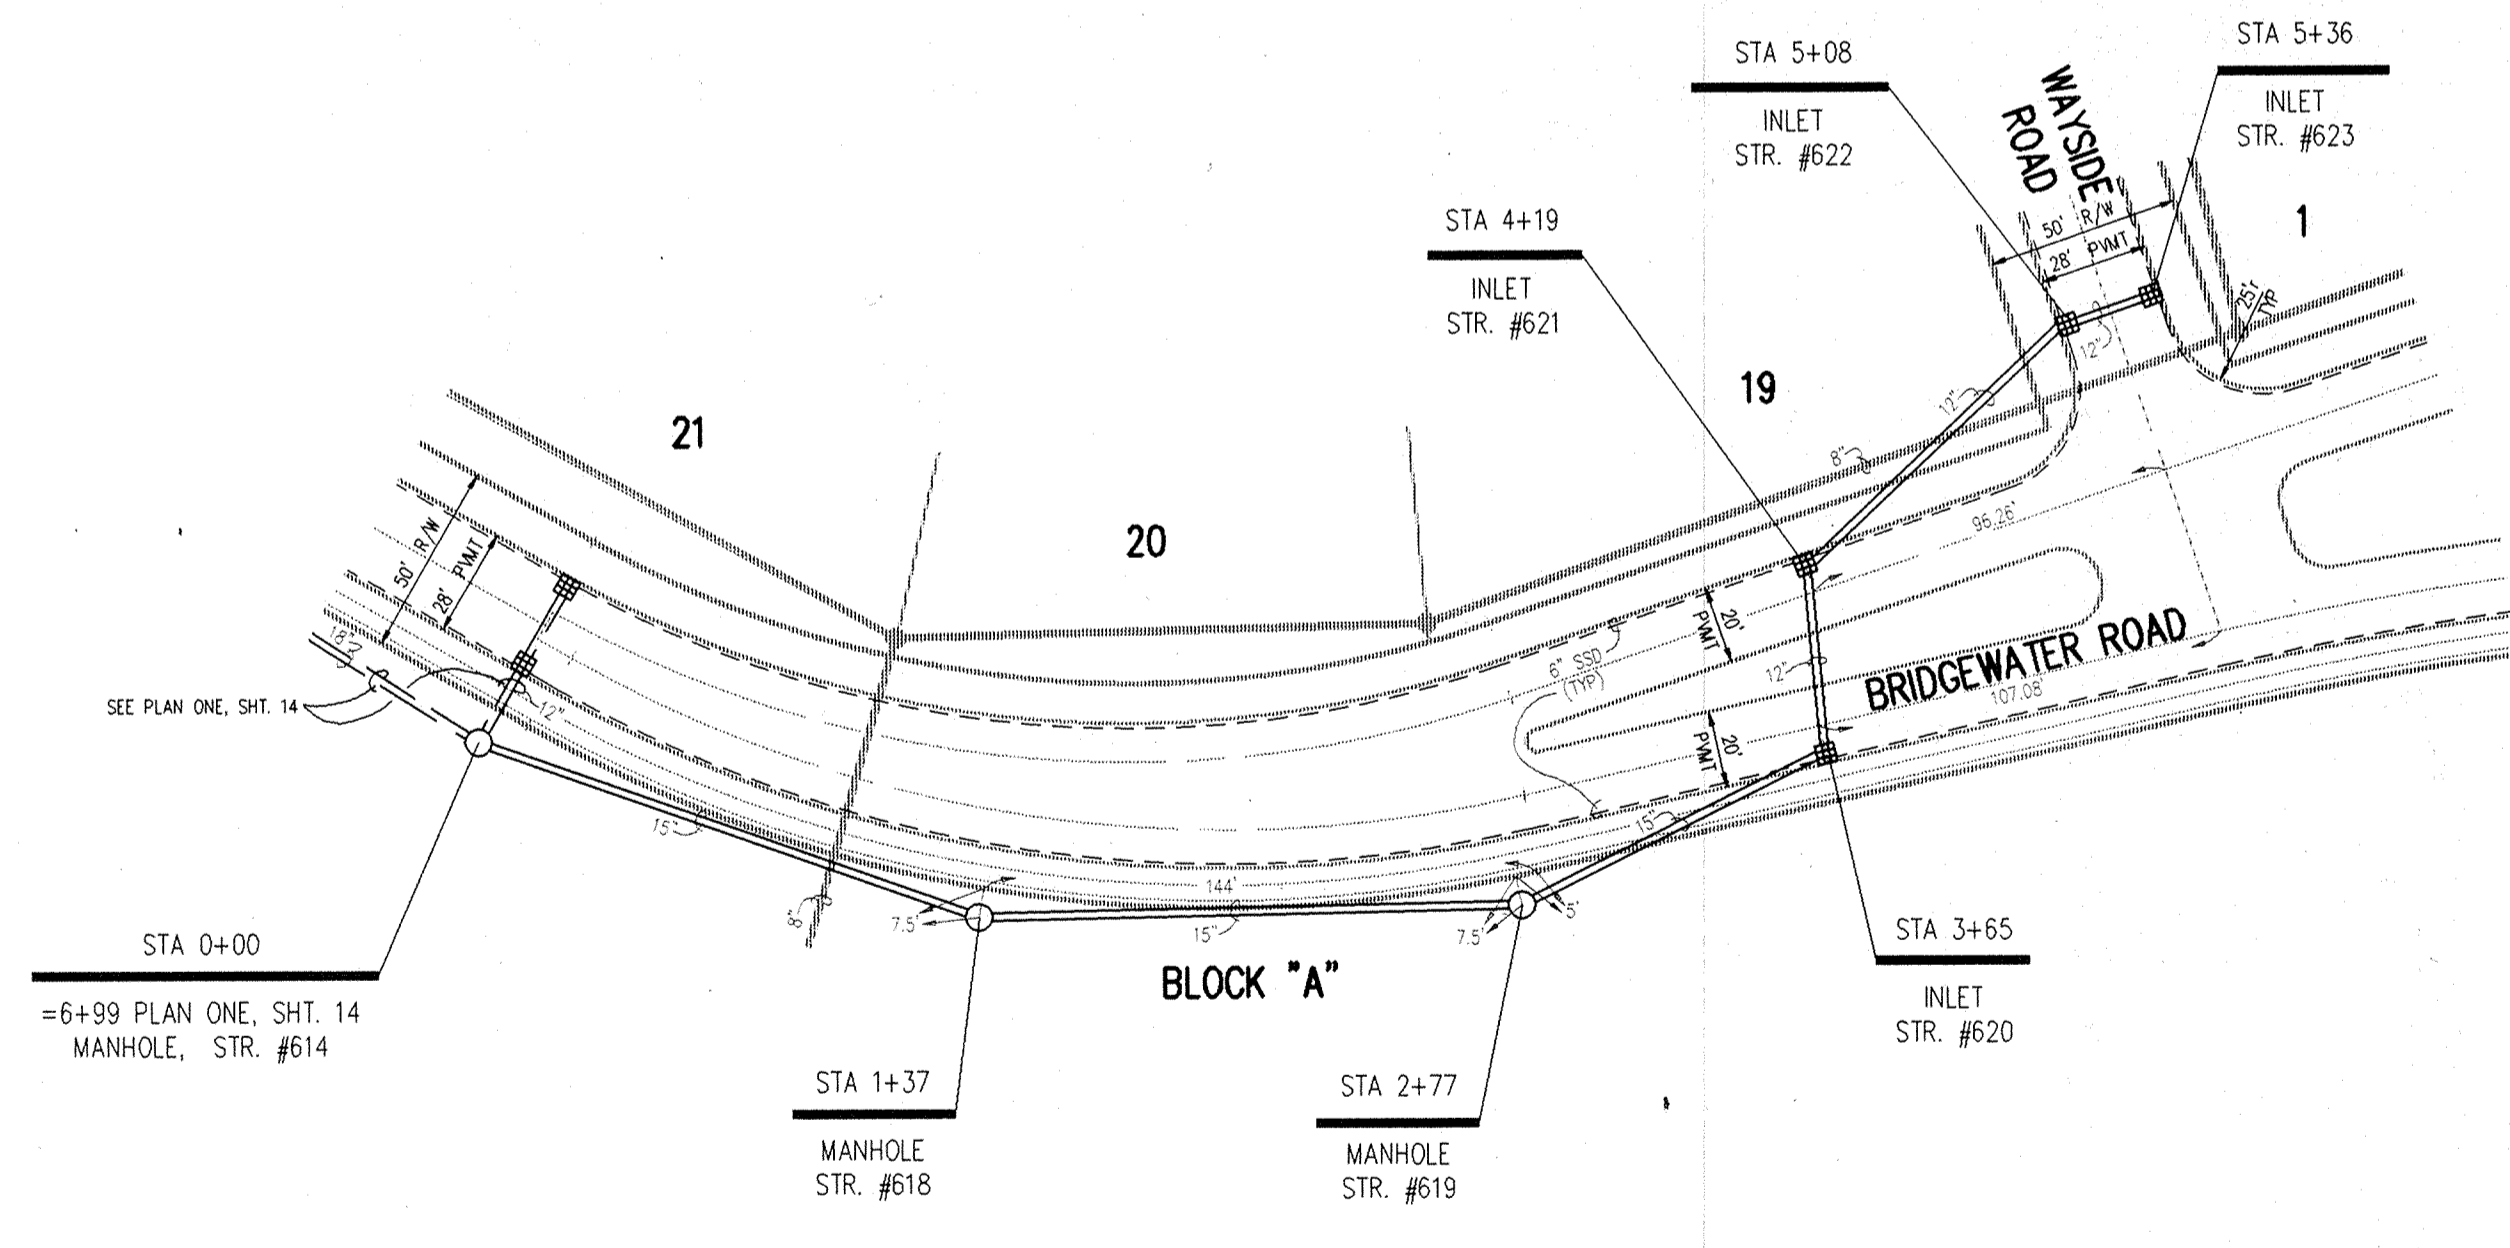

**PLAN ONE**

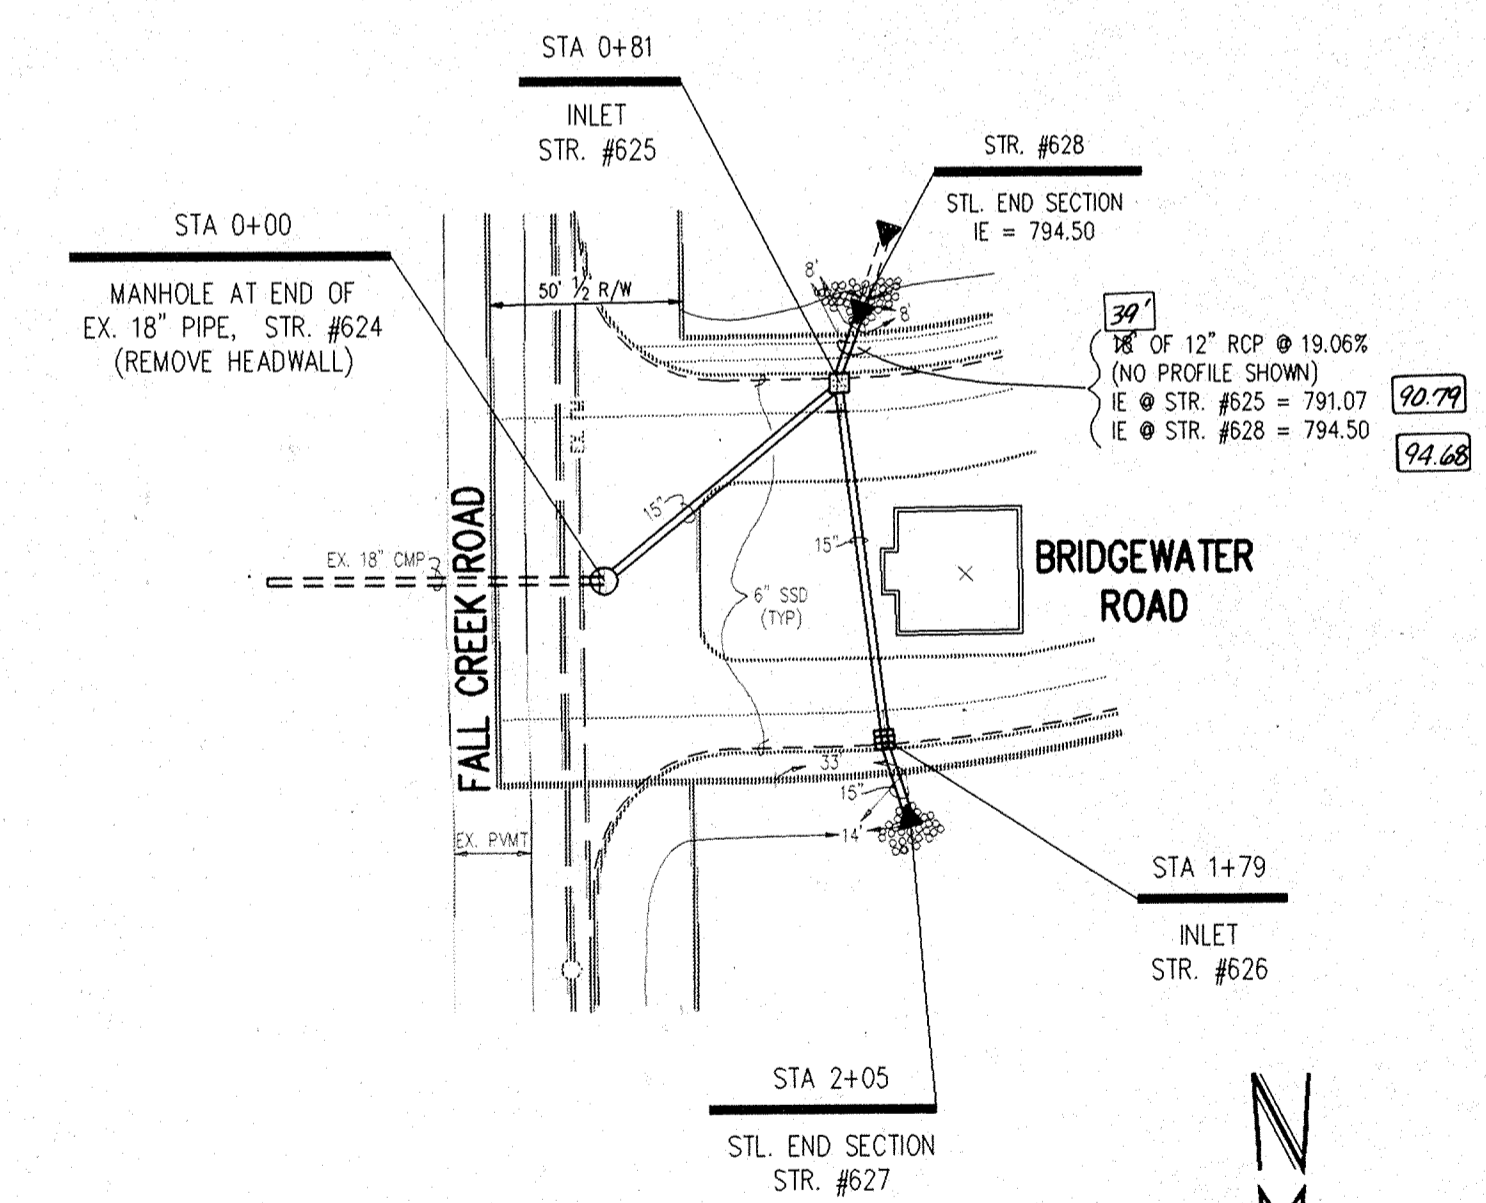

**PLAN TWO**

0000 = AS-BUILT INFORMATION

FILED  
 MAY 08 1994  
 OFFICE OF HAMILTON COUNTY SURVEYOR


BRIDGEWATER - SECTION ONE

DATE: 06-26-1990 TIME: 07:48 FILE: D8200083



CERTIFIED BY:  
*Joseph A. Sharp*  
 6-26-90 DATE

REVISIONS	DATE	BY
4-2-91 ADDED AS-BUILT INFO TO S&P'S		
7-16-90 REV PER DRAFT AND TECH. CHECK		
8-5-90 REV SANITARY SEWES		
9-6-90 REV P-TWO (MIDNED ENTRANCE)		
9-24-90 REV P-TWO (MIDNED ENTRANCE - AGAIN)		

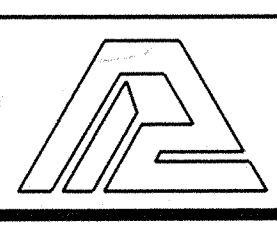

**PAUL I. CRIFE, INC.**  
 7172 GRAHAM ROAD  
 INDIANAPOLIS, INDIANA 46250  
 (317) 842-6777

- CIVIL ENGINEERING
- LAND SURVEYING
- ARCHITECTURE
- LAND PLANNING

ENG. CHK: \_\_\_\_\_  
 TECH. CHK: \_\_\_\_\_  
 DRAWN BY: *JAS*  
 DRAFTING CHK: *JAS*

SCALE: HORIZ. 1"=50'  
 VERT. 1"=5'  
 DATE: 6-9-90




CLIENT: **MARINA**  
 DRAWING TITLE: **STORM SEWER - PLAN & PROFILE**

DWG. TYPE	FILE NUMBER	SHEET:
		<b>15</b>
JOB NUMBER		
801108-2102010		OF 17

DIMENSIONS OF GALVANIZED STEEL END SECTIONS FOR ROUND PIPE


DIMENSIONS IN INCHES				DIMENSIONS IN INCHES				STD. PIPE SIZE & CONN. USAGE GALVANIZED STEEL PIPE					
PIPE DIA. IN INCHES	L 1 1/2"	W2	APPROX. SLOPE	PIPE DIA. IN INCHES	GAGE	A" 1"	B"(MAX.)	H" 1"	Type Conn.	Round	Pipe - Arch	1"	1/2"
12	21	24	2 1/2	12	16	6	6	6	#1	12" Thru 24"			
18	26	30	2 1/2	18	16	8	8	8	#2	30" Thru 36"			
24	31	36	2 1/2	24	16	10	10	10	#3	42" Thru 84"			
30	36	42	2 1/2	30	14	12	12	12					
36	41	48	2 1/2	36	14	14	14	14					
42	46	54	2 1/2	42	12	16	16	16					
48	51	60	2 1/2	48	12	18	18	18					
54	56	66	2 1/2	54	12	20	20	20					
60	61	72	2 1/2	60	12	22	22	22					
66	66	78	2 1/2	66	12	24	24	24					
72	71	84	2 1/2	72	12	26	26	26					
78	76	90	2 1/2	78	12	28	28	28					
84	81	96	2 1/2	84	12	30	30	30					

STANDARD CONNECTIONS: Type #1 Shall Be Connector Lug With Threaded Rod. Type #2 Shall Be Threaded Rod With Rod Holder. Type #3 Shall Be Riveted Or Bolted Connection. NOTE Standard Dimensions For Galvanized Steel End Sections For Pipe-Arch May Be Found On Misc. Standards Sheet E, Dated July, 1972, The Indiana State Highway Standards Specifications.

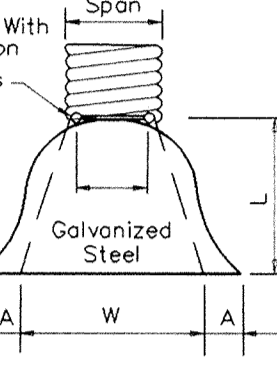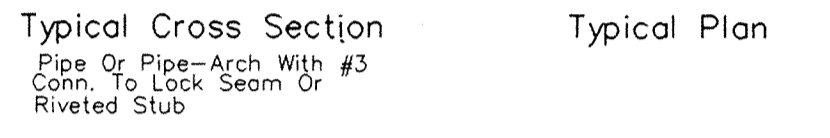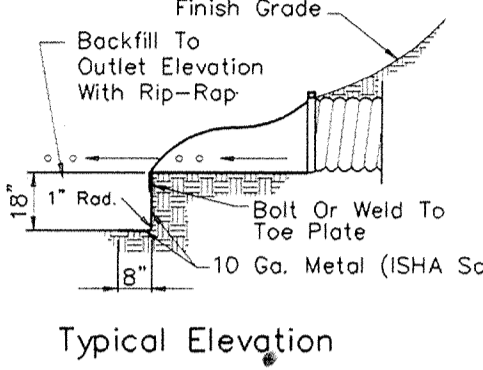


STANDARD STEEL END SECTION DETAIL

Scale: None

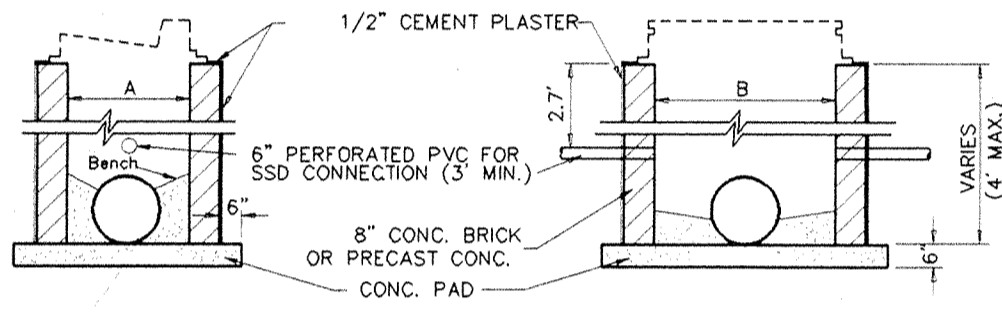


CASTING	A	B	C	D
R-3010-A	24"	25"	24" 4'-0"	24" 4'-0"
R-1712-B-SP	26" 9		27" 4'-0"	27" 4'-0"
R-1772-A	25" 6		30" 4'-4"	30" 4'-4"
			36" 5'-0"	36" 5'-0"
			42" 5'-4"	42" 5'-4"
			48" 6'-0"	48" 6'-0"
			54" 6'-8"	54" 6'-8"

NOTE: STRUCTURES TO BE CIRCULAR UNLESS OTHERWISE SPECIFIED.

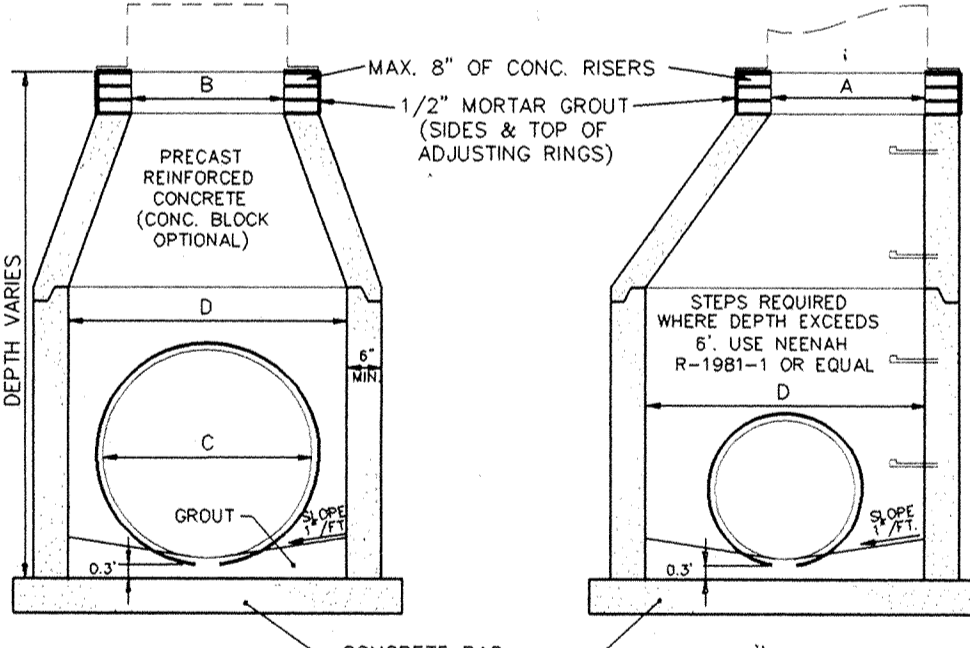


STORM MANHOLE

NO SCALE

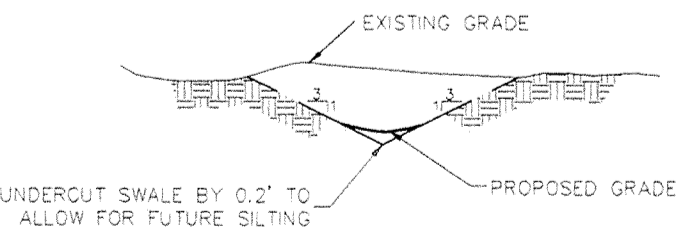


TYPICAL SWALE DETAIL

NO SCALE

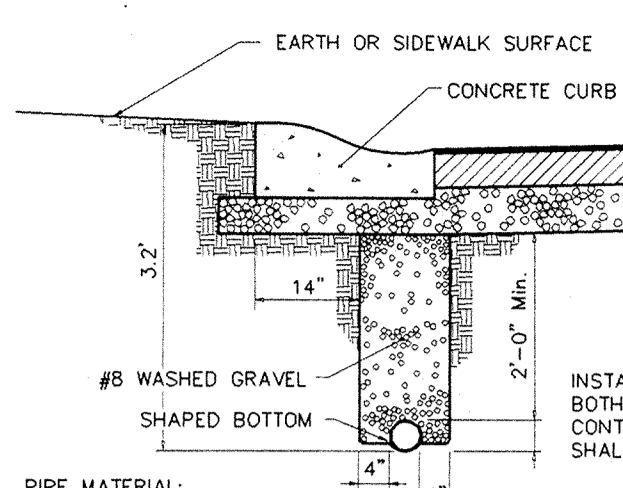


TYPICAL CURB DETAIL WITH VALLEY GUTTER

NO SCALE

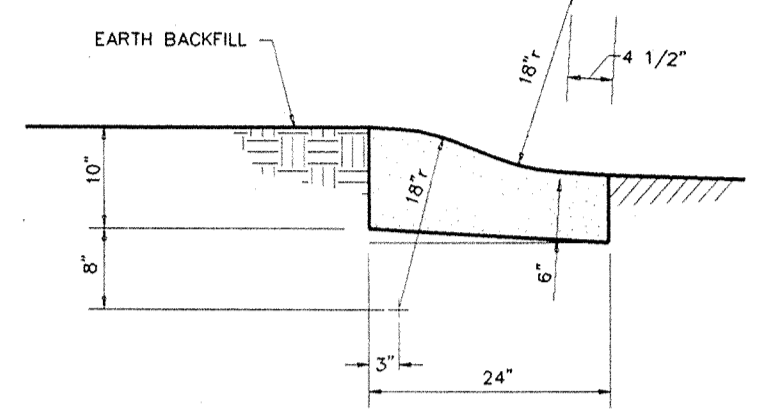


TYPICAL ROLL CURB DETAIL WITH REVERSED SLOPE GUTTER

NO SCALE

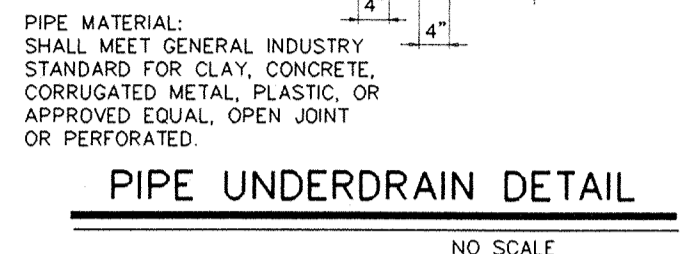


PIPE UNDERDRAIN DETAIL

NO SCALE

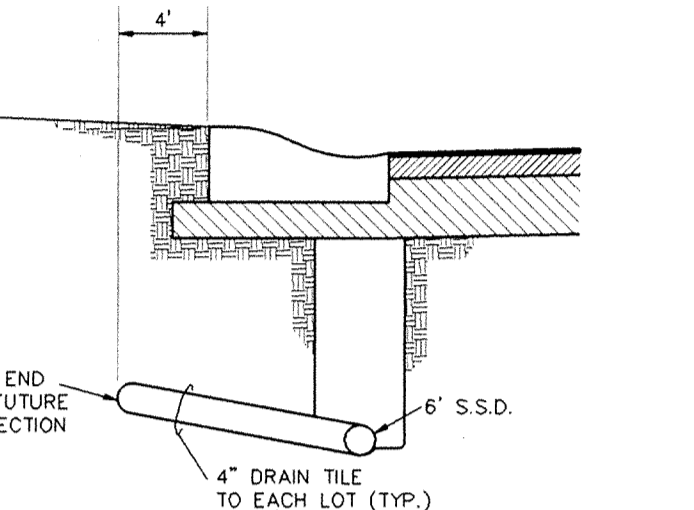


TYPICAL UNDERDRAIN LATERAL

NO SCALE

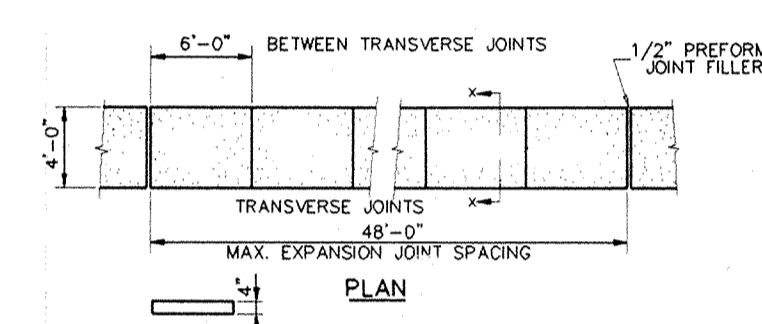


TYPICAL SIDEWALK DETAIL

NO SCALE

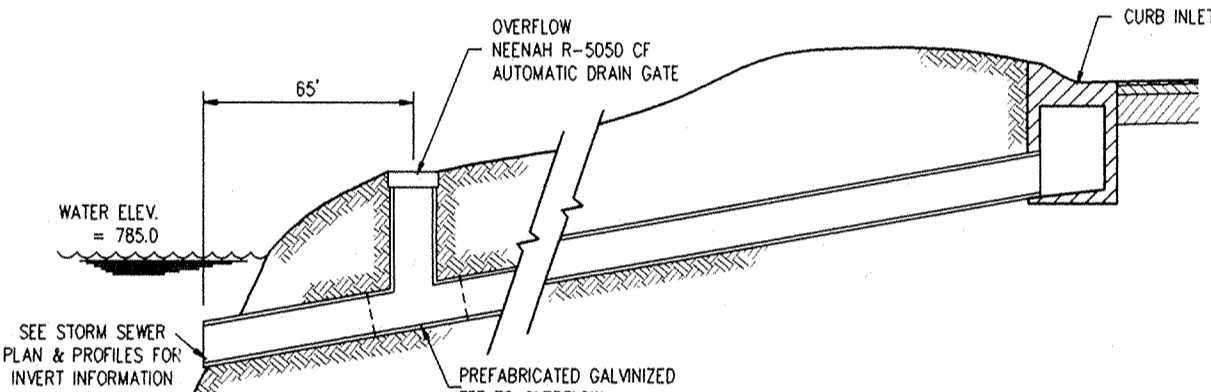


TYP. UNDERWATER DISCHARGE DETAIL

NO SCALE

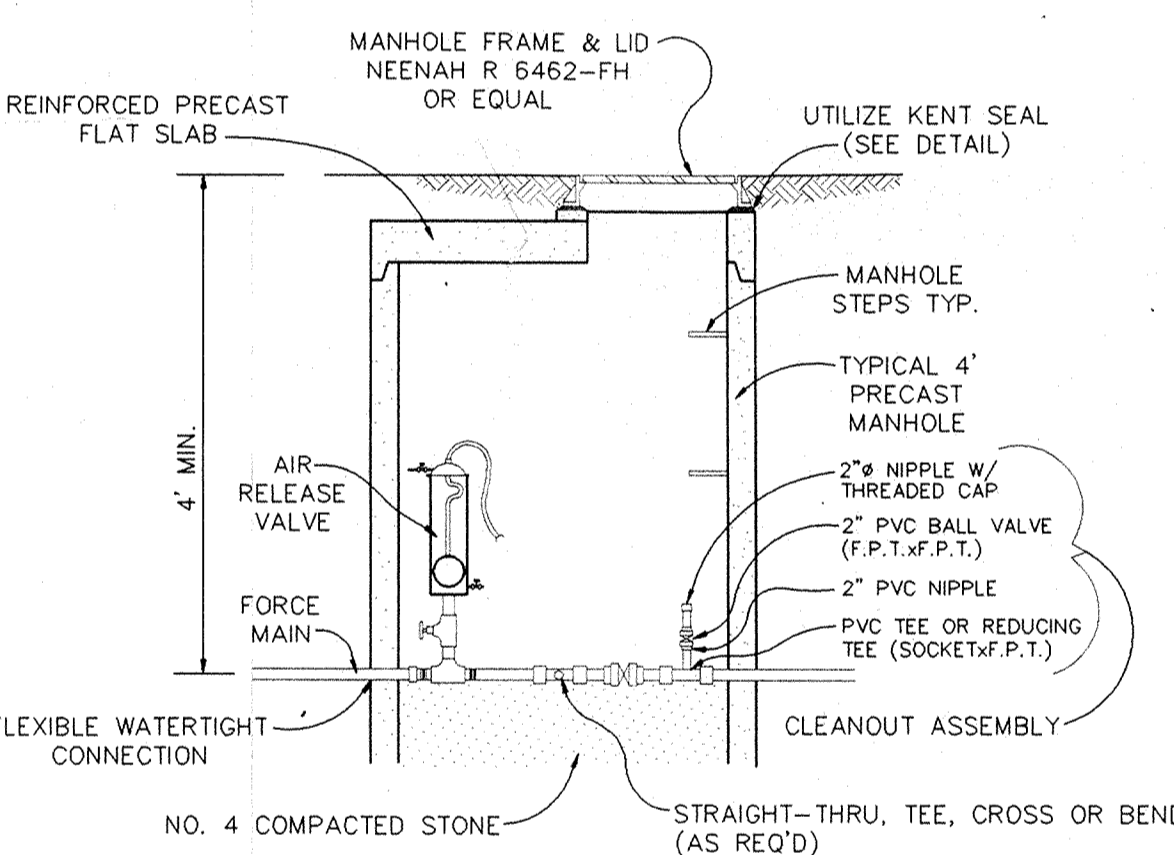

AIR RELEASE VALVE MANHOLE

NO SCALE

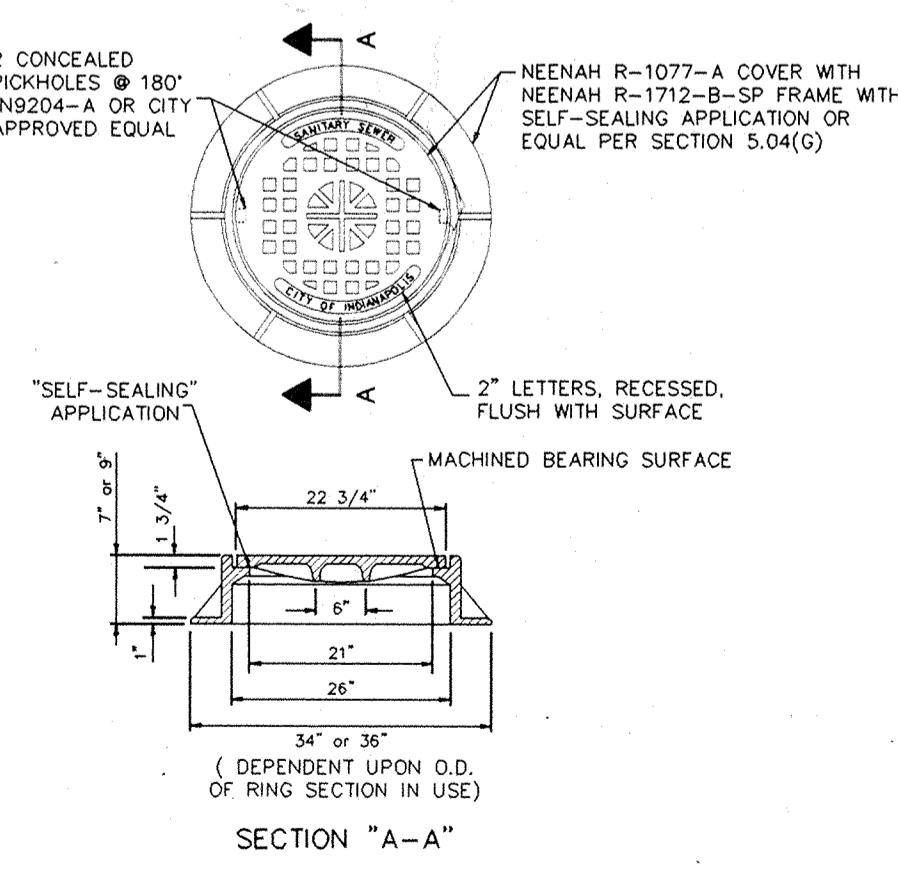

SANITARY SEWER MANHOLE FRAME & COVER


NO SCALE

MARK	POTABLE & NON-POTABLE SYSTEM-150 PSI TEST PRES.					
	4"	6"	8"	10"	12"	16"
A (90°)	1.1	2.6	4.6	7.5	10.4	18.2
B (45°)	0.7	1.4	2.5	4.0	5.7	9.3
C (22 1/2°)	0.3	0.8	1.3	2.0	2.9	5.3

1. ABOVE TABLES INDICATES CU. FT. OF CONC. REQUIRED WITH A SOIL PRESSURE OF 2000 P.S.F. MIN. 2. PLACE PAPER OR PLASTIC BETWEEN FITTING & CONCRETE. 3. THRUST BLOCKING MUST BE PLACED AT EVERY "T" OR BEND IN LINE.


THRUST BLOCKING TABLE

NO SCALE

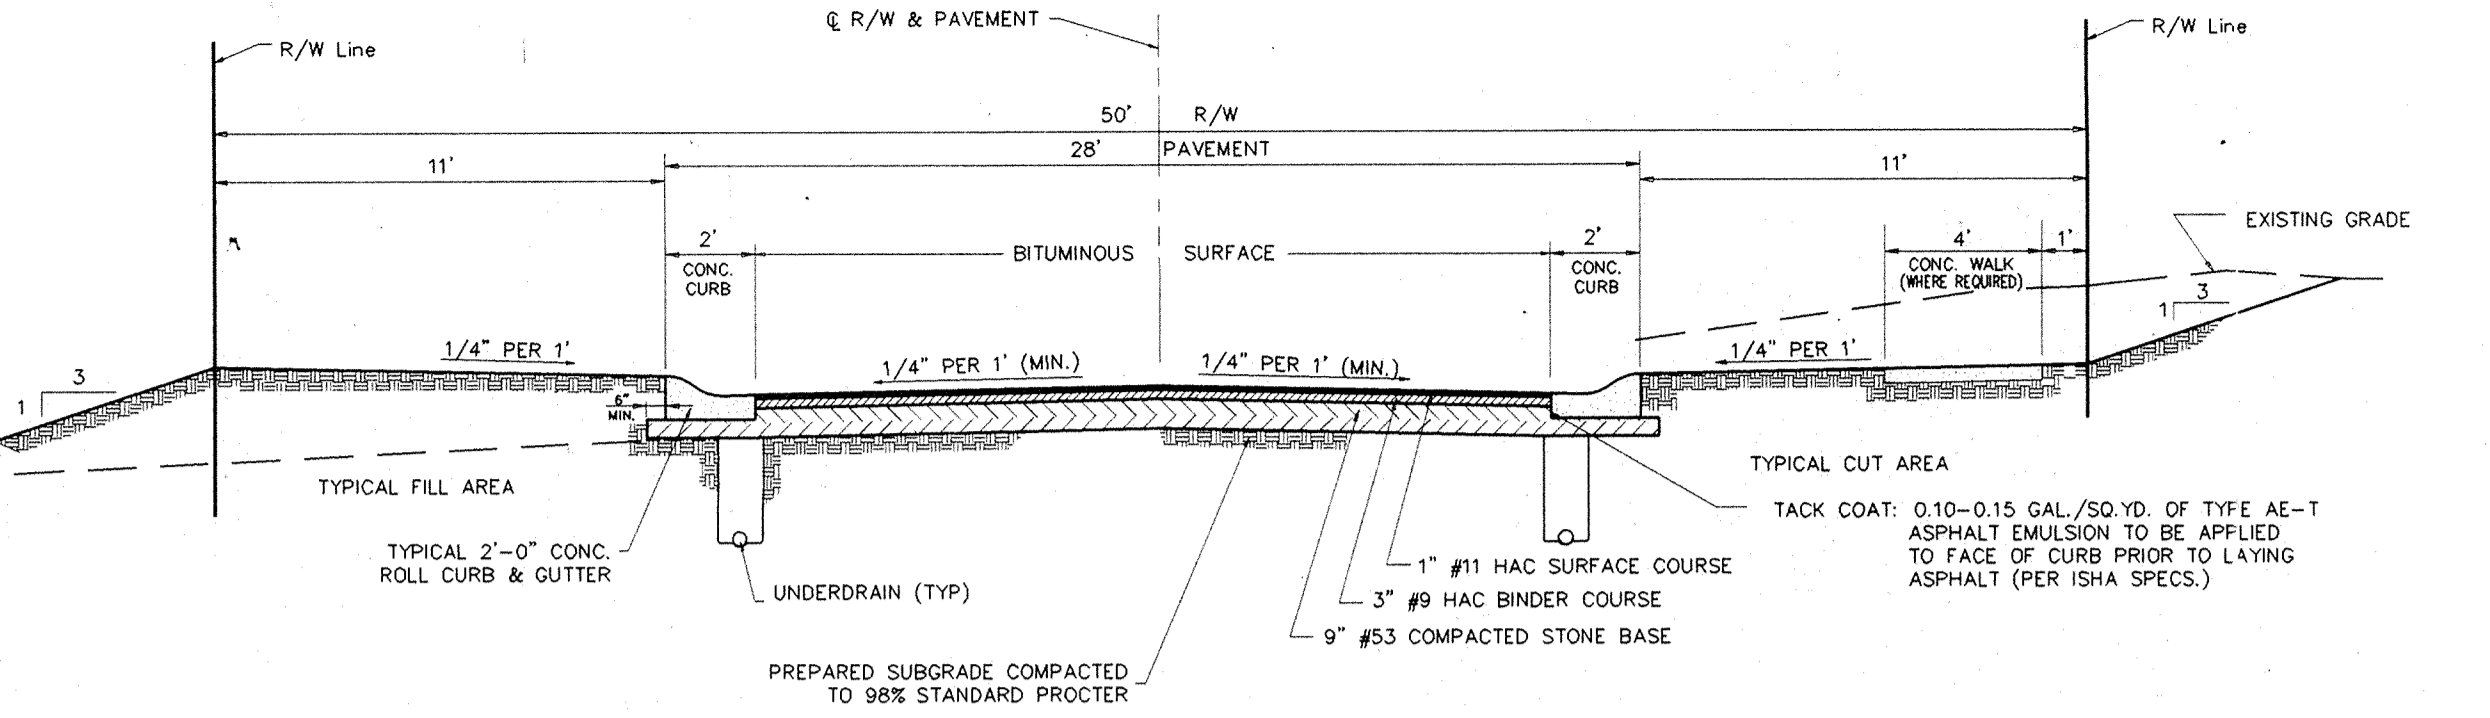

TYPICAL STREET CROSS SECTION

NO SCALE

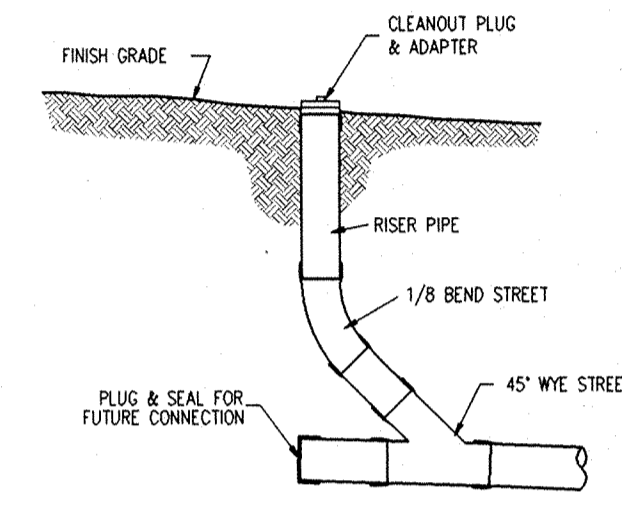


CLEANOUT DETAIL

NO SCALE


CASTING NOTE: SEWER CASTINGS SPECIFIED IN THESE PLANS ARE NEENAH FOUNDRY CO. CASTINGS. EQUAL CASTING TYPES BY EAST JORDAN IRON WORKS, INC. MAY BE SUBSTITUTED. LISTED BELOW ARE ACCEPTABLE E.J.I.W. SUBSTITUTIONS.

NEENAH	E.J.I.W.
R-1712-B-SP	1051-3 HD
R-3010-A	1710
R-1772-A	1022-1 HD

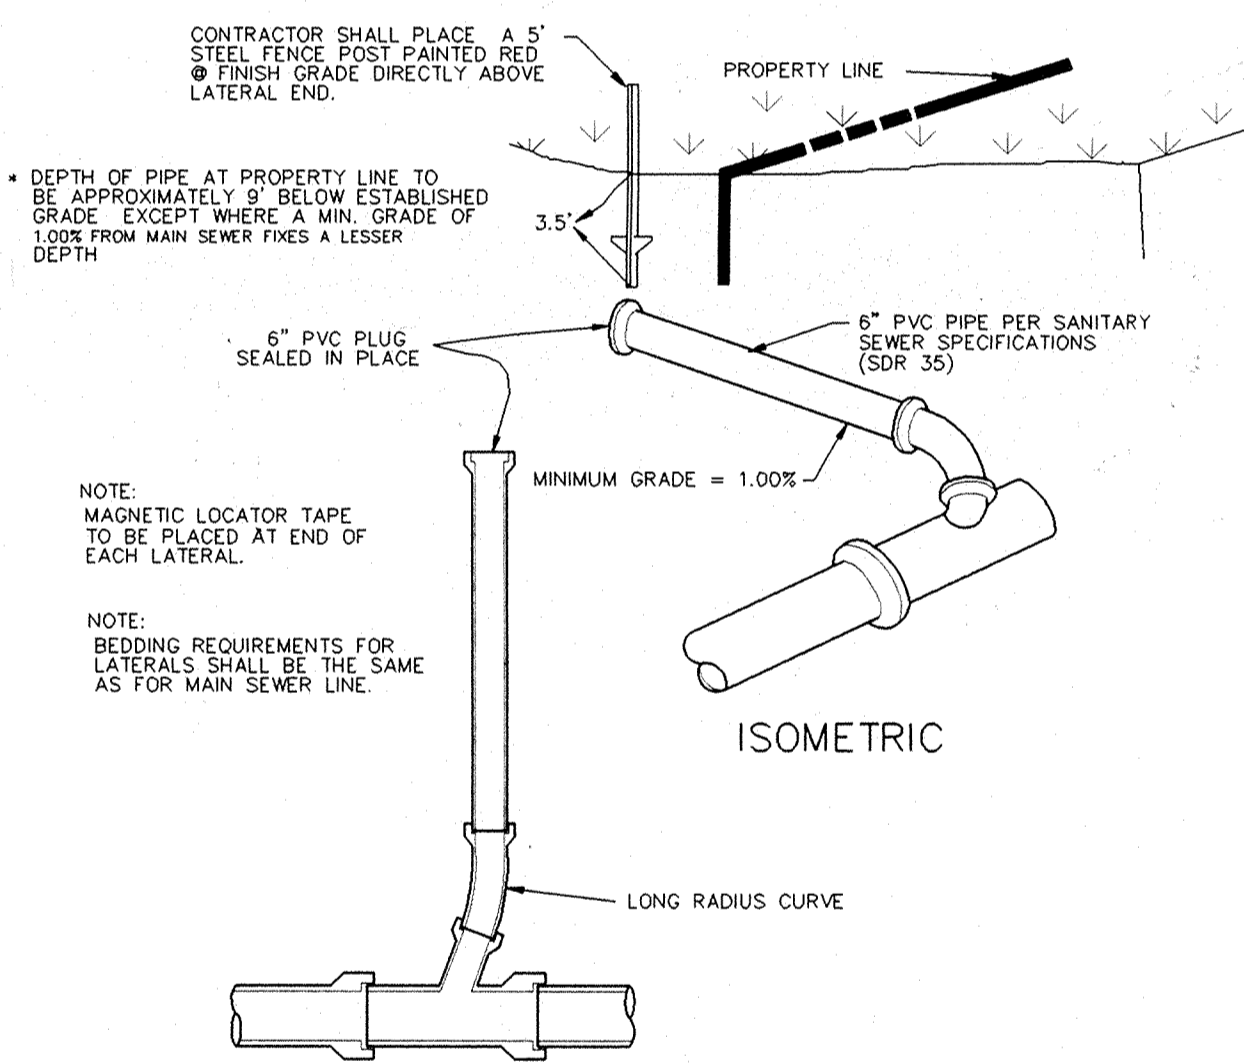

LATERAL CONNECTION TO MAIN SEWER


NO SCALE

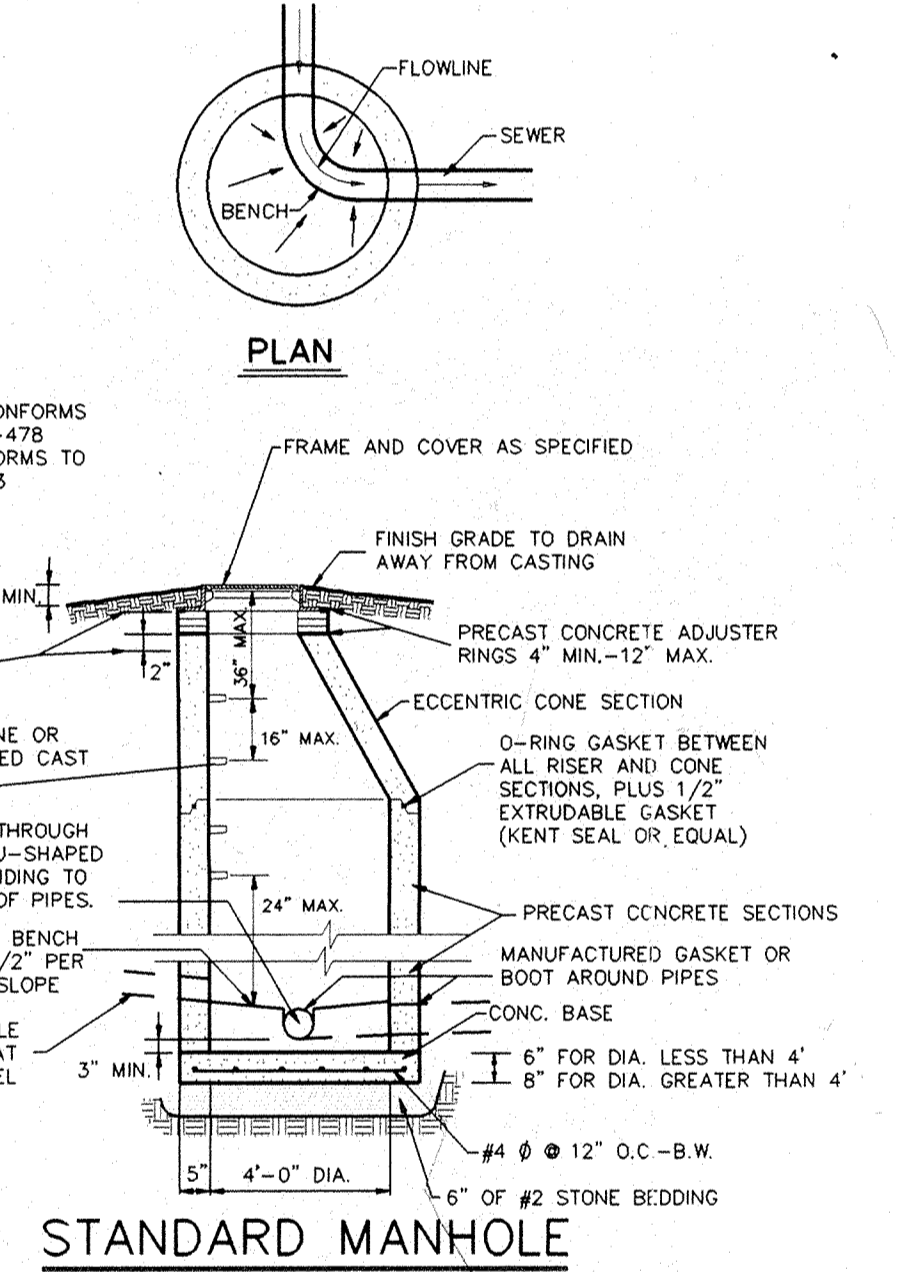

STANDARD MANHOLE


FOR SANITARY SEWERS AS ILLUSTRATED

NO SCALE

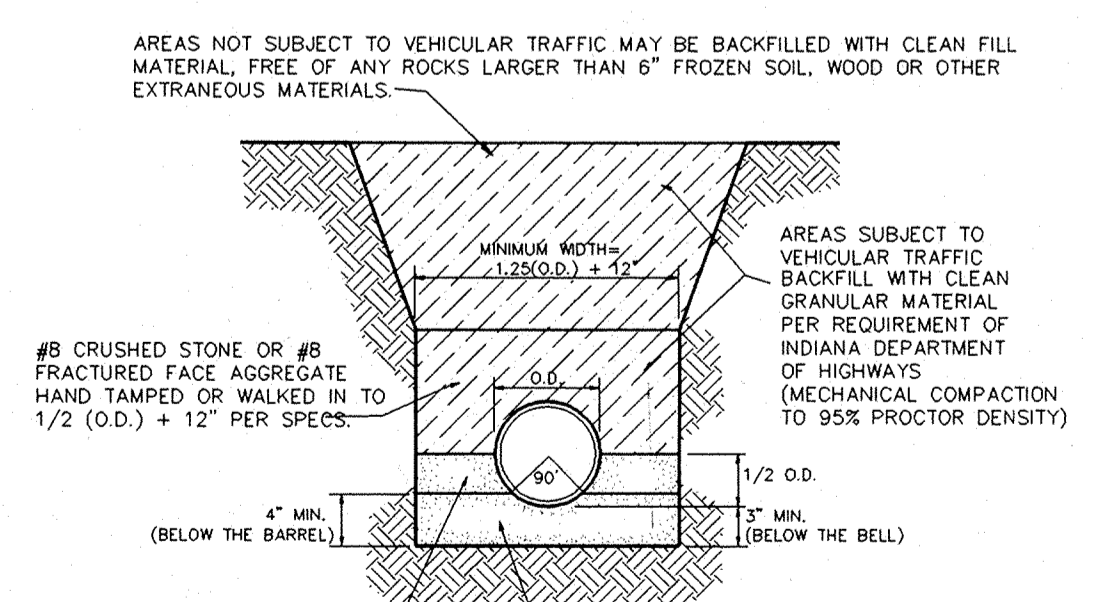


FLEXIBLE PIPE BEDDING DETAIL

PVC & HDPE PIPE

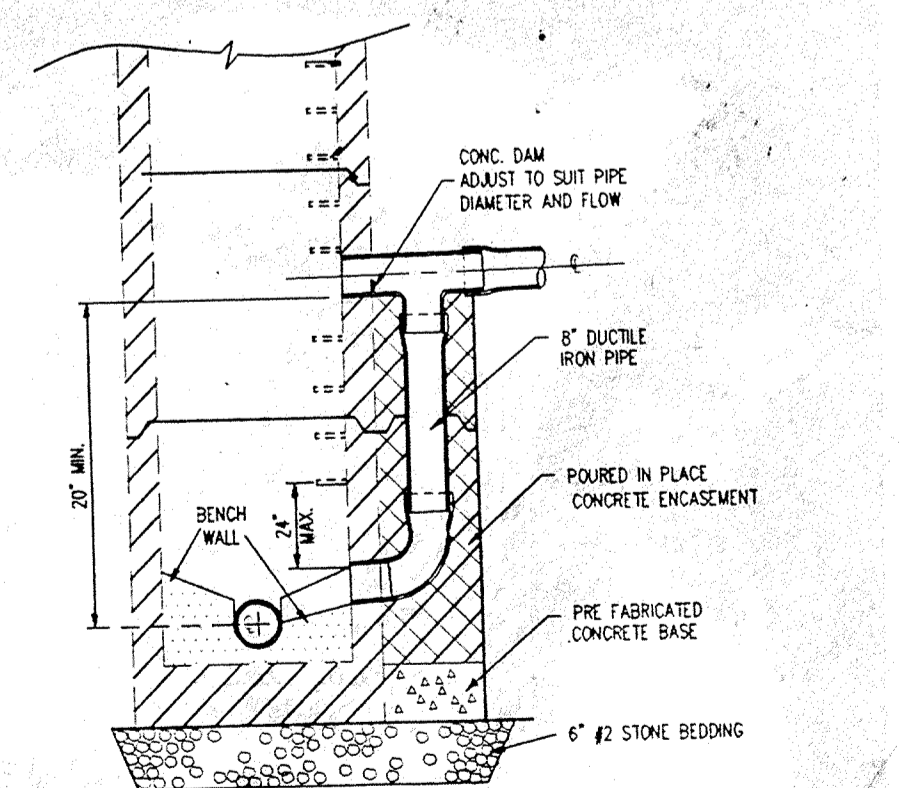

IN-PLACE DROP MANHOLE

NO SCALE

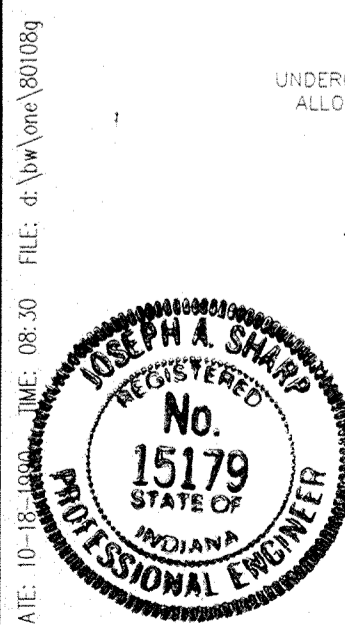

CERTIFIED BY: [Signature] DATE: 10-26-90

REVISIONS
10-17-90 Added Thrust blocks, MH casting, RW/WH



**PAUL I. CRIFE, INC.**  
7172 GRAHAM ROAD  
INDIANAPOLIS, INDIANA 46250  
(317) 842-6777

- CIVIL ENGINEERING
- LAND SURVEYING
- ARCHITECTURE
- LAND PLANNING

ENG. CHK: [Blank]  
TECH. CHK: [Blank]

DRAWN BY: [Blank]  
DRFTNG. CHK: [Blank]

SCALE: NO SCALE  
DATE: 6-9-90  
DRAWING TITLE: STANDARD DETAILS

CLIENT: MARINA

BRIDGEWATER - SECTION-ONE	
DWG. TYPE	FILE NUMBER
JOB NUMBER	
80108-20200	

SHEET 16

SITE WORK GENERAL NOTES AND SPECIFICATIONS

NOTICES AND PERMITS

- A. The Contractor shall be responsible for obtaining, or verifying, that all permits and approvals are obtained from the respective City, County and State agencies prior to starting construction.
B. It shall be the Contractor's responsibility to determine the exact location of all existing utilities in the vicinity of the construction area prior to starting construction.
C. It shall be the Contractor's responsibility for notification and coordination of all construction with the respective utility companies.
D. It shall be the responsibility of the developer and Contractor to maintain quality control throughout the project; failure to do so may result in the removal and replacement of the defective work.
E. It is essential that the work to be done in conjunction with this project shall be installed according to these specifications.

CLEARING AND GRUBBING

- A. Clearing and grubbing shall consist of cutting, removal and satisfactory disposal of all trees, down timber, brush, projecting roots, stumps, rubbish, boulders, broken concrete, fencing (as designated), and other material on the project site and within the boundary as shown on the Construction Documents and/or as designated by "construction limits".
B. All "unsuitable material" from clearing operations stated in Item II-A shall be removed to disposal areas off of the project site; unless a "Bury Pit" shall be utilized in an area where it shall not be beneath building areas and/or pavement areas and shall not be located in an area where storm drainage structures shall be located or where impoundment of surface drainage may occur.
C. Materials shall not be disposed of by burning unless approved by the local Fire Marshall.

TREE REMOVAL AND PROTECTION

- A. Trees shall be removed from the project site only where the area is to be occupied by road and surfaced areas.
B. Trees shall be removed from the project site as directed by the developer, and so designated.
C. Trees shall be removed from the project site where they interfere directly with the placement of storm or sanitary sewers, and that such excavation is or will be fatal to such adjacent trees.
D. The Contractor shall endeavor to save and protect trees of value and worth which do not impair construction or improvements as designated.
E. The Contractor shall be responsible for determining the method for protection of tops, trunks and roots of existing trees on the project site that are to remain.

STRIPPING OF TOPSOIL

- A. The Contractor shall verify that all topsoil has been removed in the areas to be occupied by road, walks and designated building areas.
B. Topsoil shall be kept separated from suitable fill materials and shall not be used as fill under pavement and/or building areas.
C. Topsoil shall be stored at a location where it does not interfere with construction operations.
D. Topsoil shall be reasonably free from subsoil debris and stones.

GRADING

- A. The Contractor shall perform all grading operations to bring subgrades, after final compaction, to the required grades and sections for site improvement.
B. Subgrade shall be proofrolled with suitable equipment and all spongy and otherwise unsuitable material shall be removed and replaced with suitable material.
C. Subgrade shall be prepared in compliance with Section 207.02 of the I.S.H.C. standard specifications for all areas of street construction.
D. See ROAD CONSTRUCTION.
E. All fill material shall be formed from soil free of deleterious material.

CONCRETE CURB AND WALKS

- A. See Detail Sheet for type and details.
B. Concrete shall be ready mixed Portland cement conforming to ASTM C-150, and water. Aggregate shall conform to ASTM C-33. Compressive strength of concrete at 28 days shall be 4000 p.s.i.
C. Application
1. Place concrete only on a moist, compacted subgrade or base free from loose material.
2. Concrete shall be deposited so as to require as little rehandling as practicable.
3. Except as otherwise specified, cure all concrete by one of the methods described in Section 501.17 of the I.S.H.C. Specifications, 1978 edition.

SANITARY SEWER CONSTRUCTION

- A. Current City of Indianapolis Sanitary Sewer District, County and State specifications shall prevail as to materials and methods of construction.
B. The Contractor shall be responsible for obtaining or verifying all permits for all or portions of this project to starting of construction.
C. Sanitary sewers shall be installed in accordance with the Indiana State Board of Health Permit (327 IAC).
D. Sanitary sewers shown on the construction plans were designed with Poly Vinyl Chloride Pipe in accordance with ASTM D-3034 (S.D.R. 35).
E. No construction of sanitary sewers will be allowed to commence until a valid SPC-15 Permit from the Indiana Dept. of Environmental Management is obtained.
F. Sanitary manholes shall be precast concrete in accordance with ASTM C-478.
G. Castings shall be of type and kind as shown on the Detail Sheet.
H. Water and sewer line crossings and separations shall be in accordance with Ten State Standards and local codes.
I. All future sewer installation, either connected to or extended from this system shall be constructed in accordance with these specifications.
J. No roof drains, footing, and/or surface water drains may be connected to the sanitary sewer system, including temporary connections during construction.
K. Buildings shall be serviced by a 6" minimum sanitary sewer lateral.
L. The Contractor shall provide the Engineer with "as-built" locations and information for all sanitary sewers and laterals including elevations.
M. Manhole sections shall have 10" rings, which shall meet ASTM C-433.
N. Manhole waterstops shall be installed at all connections to manholes, where flexible-type manhole connections are not used.
O. All precast manholes shall be bedded on a granular foundation (12" min.).
P. The Contractor shall remove by pumping or other suitable methods any water which may accumulate in trenches.
Q. The Contractor shall be responsible for all tests for leakage, infiltration and deflection as established by the City of Indianapolis and the State Board of Health.
R. Pipe shall be laid in open trenches, except when conditions require and the appropriate approving agencies give written permission for tunneling or jacking of pipe.
S. Trench shall be opened sufficiently ahead of pipe laying to reveal obstructions, and shall be properly protected and/or barricaded when left unattended.
T. Trenches shall be sheeted and braced as necessary to protect workman and adjacent structures.
U. Manhole inverts shall be shaped for flow channels with concrete and smoothly finished with a U-shaped section conforming to the inside diameter of the connecting sewers.
V. The casting elevations are set by plan. However, the castings are to be adjusted in the field by the Engineer's representative should a discrepancy occur between plan grade and existing grade.
W. All connections to existing manholes shall be core drilled unless otherwise approved by accepting agency.
X. All sanitary sewer lines upon completion will be required to pass a low pressure air test or infiltration test, unless otherwise directed by the Engineer.
Y. Ductile Iron Pipe Specification:
1. Pipe shall conform to ANSI Specification A21.51 and AWWA C-151, latest revision.
2. Ductile Iron Pipe shall be Class 50 and provided in minimum laying lengths of eighteen (18) feet.
3. Fittings shall be standardized for the type of pipe and joint specified and shall comply with ANSI A-21.10, AWWA C-110.
4. All provisions of DPW Standards, 1989 Section 5-6 shall be complied with.

STORM

- 1. Storm sewer pipe shall be reinforced concrete (R.C.P.) in accordance with ASTM-C-76, or corrugated metal pipe (CMP) one size larger in accordance with AASHTO spec. M-36.
2. Exceptional areas may require additional subsurface drainage. Street and storm sewer contractors shall include in their bids a unit cost per foot of installation of 4" or 6" dia. perforated plastic underdrain (see detail sheet).
3. Rip-rap shall be installed at pipe inlets or outlets as the owner/engineer directs.
4. Storm sewer discharge areas and inverts are tentative and are subject to field modifications according to the unit prices submitted by the Contractor on the contract documents.
5. The Contractor shall provide at least 2' of cover over all storm sewers.
6. All drainage pipe and ditch outfalls to receiving streams shall be constructed in accordance with drawings, subject however, to any modification required by City of Carmel at the time installation is completed and to any adjustments needed for field conditions not adequately anticipated by the design drawings.
7. Casting Elevations are set by plan. However, the casting elevations are to be adjusted in the field by the Engineer's representative should a discrepancy occur between plan grade and existing grade.
8. All structures and all cuts under proposed paved areas shall be backfilled with granular material in addition to areas specifically noted on the plans.
9. The Contractor shall contact all utility companies before any construction is started.
10. The Contractor shall be responsible for obtaining all State, Highway, City and County permits.
11. The Contractor will be reimbursed for any additional labor and/or materials arising from the changes other than minor adjustments to manholes authorized by the Engineer.

Seeding Specifications:

- 1. Swales/Grassed Waterways: Permanent seeding shall take place between March 1 and May 15 or from August 10 to October 15 with the following per acre:
25# Kentucky 31 Fescue
15# Kentucky Blue Grass
1000# 12-12-12 Fertilizer
3000# Mulch (Straw)
2. If grades are established between May 15 and August 10, a temporary seeding consisting of 40# of Annual Ryegrass shall be planted per acre.
3. If grades are established between October 15 and December 30, either Rye (grain) or Wheat may be used at the rate of 2 bushels/Ac.
4. If temporary seeding is established prior to permanent seeding, the mulch may be eliminated except in "bare" areas.
5. If grading occurs during December, January, or February, no seeding will take place till spring planting time; however, it is imperative that all sediment filters and traps are in place prior to bulk earthmoving or clearing.
6. All areas along street (approximately 25 foot behind curb) shall be seeded the same as swales.
7. All lots where grading has occurred, shall be seeded with the temporary seeding process.
8. All dates shown are nominal, and may be varied with concurrence of the Engineer or the Local Soil Conservationist.

Soil Erosion Control Summary

The following is a list in sequence of construction activities to control soil erosion:


- 1. Contractor shall install sediment traps and straw bale filters, as shown.
2. Rough grade the site (sides of swales, mounds and ponds to be seeded and mulched immediately upon completion).
3. Contractor shall control mud accumulation on all streets surrounding project by installing stone surface at all locations where construction traffic leaves the site.
4. Maintain all filters and traps during construction to prevent any blockages from accumulated sediment.
5. Contractor shall install all sanitary sewers, storm sewers, subsurface drains, and water mains.
6. All proposed street areas shall be paved as soon as possible after subgrade is prepared.
7. All disturbed areas shall be seeded and mulched as specified below.
8. Contractor shall remove all temporary erosion and sediment controls only when there is a sufficient growth of ground cover to prevent further erosion.

FILED

MAY 08 1990


BRIDGEWATER OFFICE OF HAMILTON COUNTY SURVEYOR

Table with columns: DWG. TYPE, FILE NUMBER, SHEET, JOB NUMBER, OF 17. Values: 80108-20200, 17.

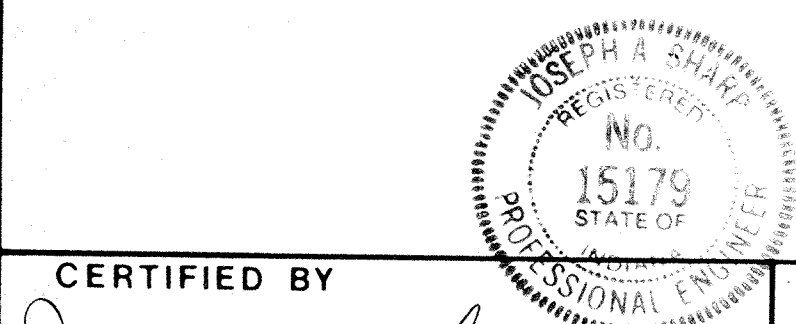

CERTIFIED BY Joseph A. Sharp 6-26-90 DATE

Table with columns: REVISIONS, DATE. Contains revision notes for infiltration spec and subgrade spec.

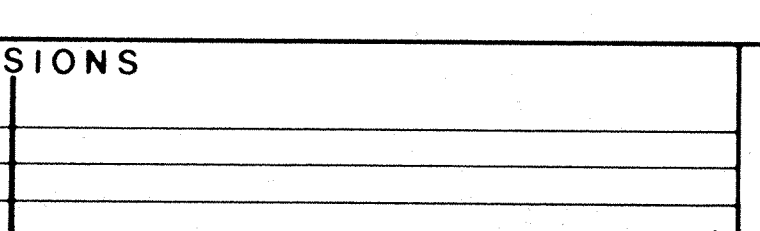

PAUL I. CRIFE, INC. 7172 GRAHAM ROAD INDIANAPOLIS, INDIANA 46250 (317) 842-6777

Table with columns: TECH. CHK., DRAWN BY, SCALE, DATE, CLIENT, DFTNG. CHK., DRAWING TITLE. Values: 16, MARINA, SPECIFICATIONS.