







SURVEYOR'S OFFICE  
**Hamilton County**

Kenton C. Ward, Surveyor

Suite 146

776-8495

One Hamilton County Square

Noblesville, Indiana 46060-2233 August 21, 1995

To: Hamilton County Drainage Board

RE: Castetter-Randall Legal  
Drain Northeast Commerce  
Park

Attached are as-builts, certificate of completion & compliance, and other information for Northeast Commerce Park. An inspection of the drainage facilities for this section has been made and the facilities were found to be complete and acceptable. This was done under my report dated April 15, 1986.

The drain is as follows: There is 633 feet of 48" RCP, 538 feet of 54" RCP, and 99 feet of 36" RCP. Original E.F. Castetter Drain was replaced with 48" RCP from structure number 9 to structure number 10. Original Drain was also replaced from structure number 10 to station 47+13 of the old drain. The original drain was vacated from station 47+13 to station 54+60 where the headwall outlets to the open ditch for a total of 747 feet. The total new frontage is 1270 feet.

The net gain in length of the drain due to the changes described above is 523 feet.

I recommend the Board approve the drains construction as complete and acceptable.

Sincerely,



Kenton C. Ward  
Hamilton County Surveyor

KCW/nw

**CERTIFICATION FOR "RECORD DRAWING".**

CERTIFIED BY: *[Signature]* (ENGINEER)  
 CERTIFIED BY: *[Signature]* (DEVELOPER)  
 STR. #7

**JOHN V. SCHNEIDER**  
 REGISTERED  
 NO. 14653  
 STATE OF INDIANA  
 PROFESSIONAL ENGINEER

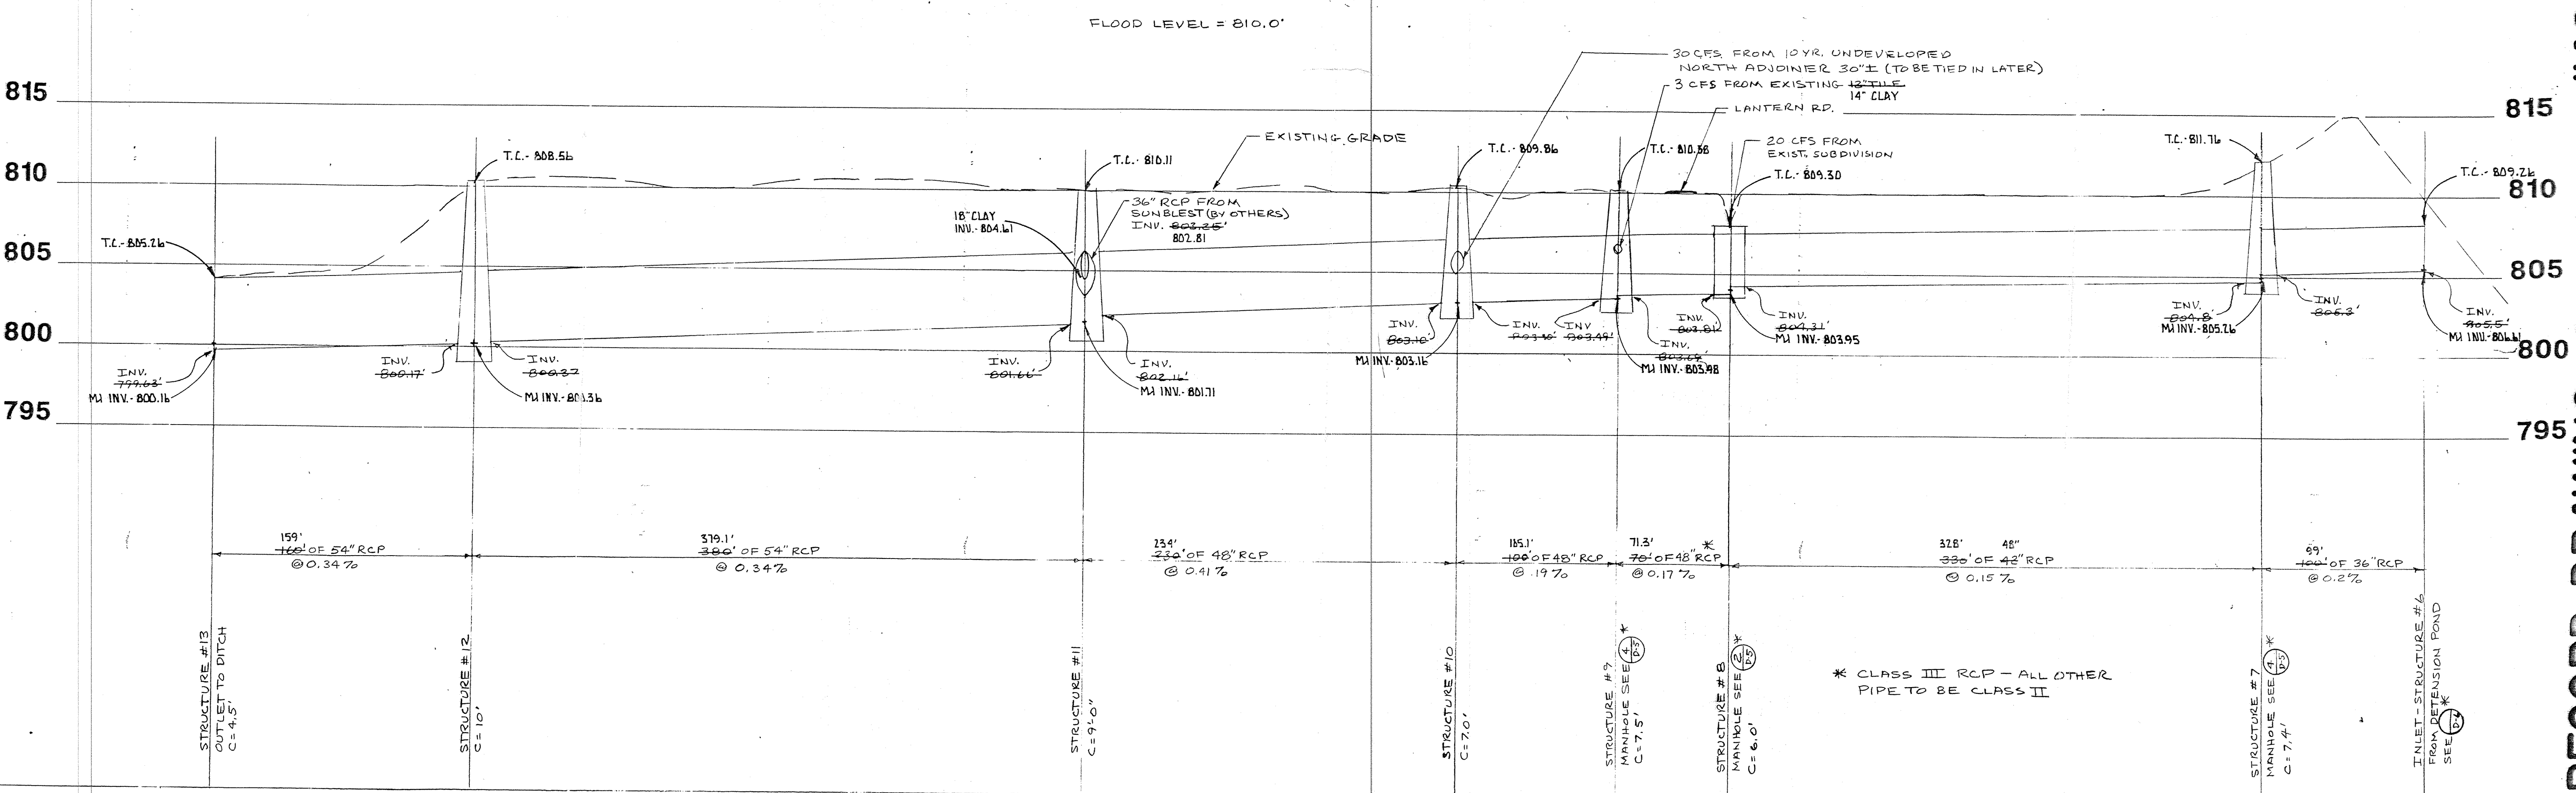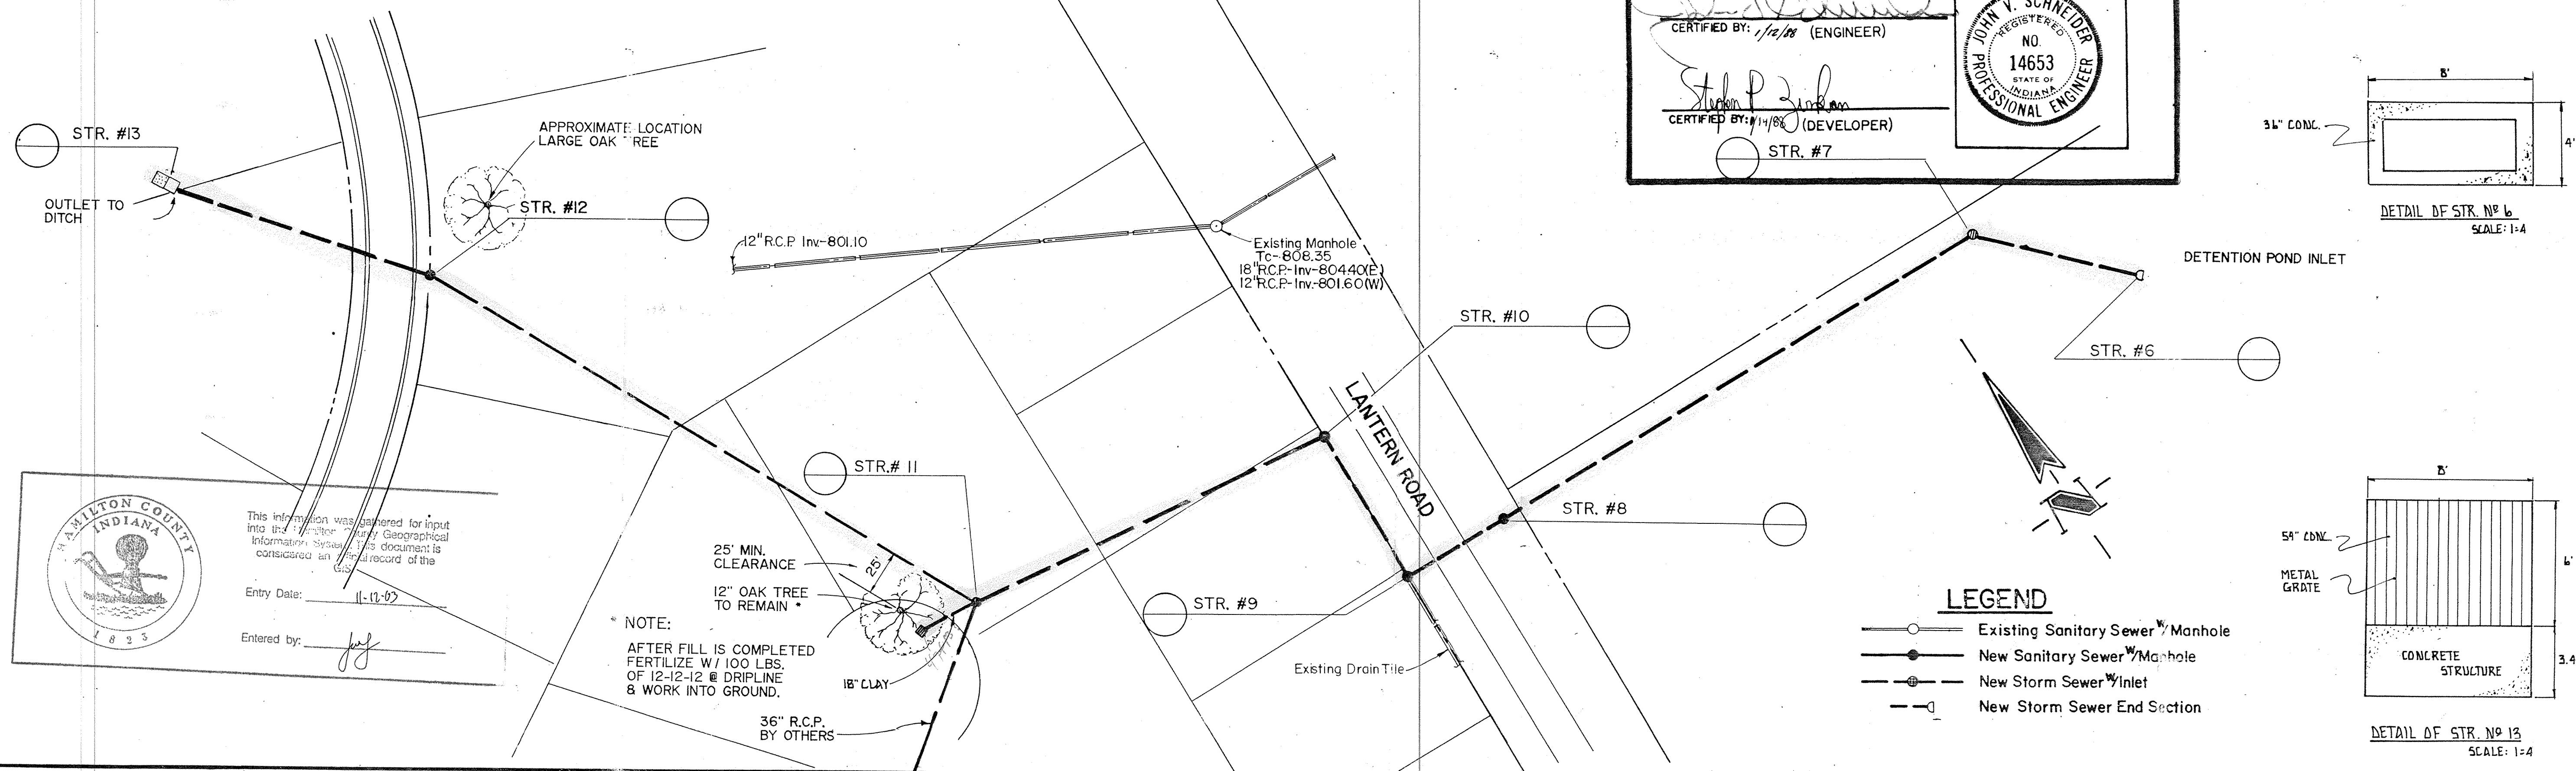

HAMILTON COUNTY INDIANA

This information was prepared for input into the Hamilton County Geographical Information System. This document is considered an official record of the County.

Entry Date: 11-11-92

Entered by: *[Signature]*

NOTE:  
 AFTER FILL IS COMPLETED FERTILIZE W/ 100 LBS. OF 12-12-12 & DRIPLINE & WORK INTO GROUND.

RECORD DRAWING 01/11/88 "AS BUILT" STORM SEWER

PROJECT: N.E. COMMERCE PARK, FOR NO. 599

PREPARED FOR: FLYNN-ZINKAN REALTY CORP.

TITLE: STORM SEWER PLAN

SCALE: AS NOTED

SHEET 3

NO.	DATE	BY	REVISIONS
1	11-11-92	J.V.S.	REVISED FOR RECORD DRAWING

SCHEIDT ENGINEERING CORPORATION  
 3075 NORTH POST ROAD  
 INDIANAPOLIS, INDIANA 46228

CIVIL ENGINEERS AND SURVEYORS

(317) 806-8282  
 P.O. BOX 25068

CERTIFIED *[Signature]*