

**Drain:** CHESWICK PLACE DRAIN      **Drain #:** 264  
**Improvement/Arm:** CHESWICK PLACE - SECTION 1  
**Operator:** JOH      **Date:** 11-13-03  
**Drain Classification:** Urban/Rural    **Year Installed:** 1994

### **GIS Drain Input Checklist**

- Pull Source Documents for Scanning gjt 11-13
- Digitize & Attribute Tile Drains N/A
- Digitize & Attribute Storm Drains gjt 11-14
- Digitize & Attribute SSD gjt 11-14
- Digitize & Attribute Open Ditch N/A
- Stamp Plans gjt 11-14
- Sum drain lengths & Validate gjt 11-14
- Enter Improvements into Posse gjt 11-14
- Enter Drain Age into Posse jmg 11-17
- Sum drain length for Watershed in Posse jmg 11-17
- Check Database entries for errors gjt 11-14

Gasb 34 Footages for Historical Cost  
Drain Length Log

Drain-Improvement: CHESWICK PLACE GRAIN - CHESWICK PLACE - SECTION 1

Drain Type:	Size:	Length (AS-QUILTS )	Length (DB Query)	Length Reconcile	Price:	Cost:
SSO	6"	10,820'	10,820'	Ø		
RCP	12"	2,505'	2,505	Ø		
	15"	567'	567'	Ø		
	18"	1,312'	1,312'	Ø		
	21"	150'	150'	Ø		
	24"	1,044'	1,044'	Ø		
	30"	314'	314'	Ø		

Sum:      - 16,712'    16,712'    Ø

Final Report: \_\_\_\_\_

Comments:

---



---



SURVEYOR'S OFFICE  
Hamilton County

Kenton C. Ward, Surveyor

Suite 146

776-8495

One Hamilton County Square

Noblesville, Indiana 46060-2230

February 23, 1994

5/23/94 9:10

TO: Hamilton County Drainage Board

RE: Cheswick Place Drain-Section 1

Attached is a petition, non-enforcement request, plans, calculations, quantity summary and assessment roll for the Cheswick Place Drain-Section 1. I have reviewed the submittals and petition and have found each to be in proper form.

I have made a personal inspection of the land described in the petition. Upon doing so, I believe that the drain is practicable; will improve the public health; benefit a public highway and be of public utility; and that the costs, damages and expenses of the proposed drain will probably be less than the benefits accruing to the owners of land likely to be benefitted.

The drain will consist of the following:

6"	SSD	10,822 ft	21"	RCP	150 ft
12"	RCP	2,529 ft	24"	RCP	1,043 ft
15"	RCP	563 ft	30"	RCP	320 ft
18"	RCP	1,311 ft			

The total length of the drain will be 16,738 feet.

The retention pond (lake) located in Common Area #1 is not to be considered part of the regulated drain. Only the inlet and

outlet will be maintained as part of the regulated drain. The maintenance of the pond (lake) will be the responsibility of the Homeowners Association. The Board will however, retain jurisdiction for ensuring the storage volume for which the lake was designed. Thereby, allowing no fill or easement encroachments.

The subsurface drains (SSD) to be part of the regulated drain are those located under the curbs. Only the main SSD lines which are located within the Right of Way (R/W) are to be maintained as regulated drain. Laterals for individual lots will not be considered part of the regulated drain.

I have reviewed the plans and believe the drain will benefit each lot equally. Therefore, I recommend each lot be assessed equally. I also believe that no damages will result to landowners by the construction of this drain. I recommend a maintenance assessment of \$30.00 per lot, \$5.00 per acre for roadways, with a \$30.00 minimum. With this assessment the total annual assessment for the drain, this section will be \$ 1986.30.


Parcels assessed for this drain may be assessed for the Williams Creek or Collins & Osborn Drain at sometime in the future. Parcels assessed for this drain will also be assessed for the O.F. Henley Drain.

I believe this proposed drain meets the requirements for

Urban Drain Classification as set out in IC 36-9-27-67 to 69.  
Therefore, this drain shall be designated as an Urban Drain.

I recommend that upon approval of the above proposed Urban Drain that the Board also approve the attached non-enforcement request. This request is for the reduction of the regulated drain easement to those easement widths as shown on the secondary plat for Cheswick Place Section 1 as recorded in the office of the Hamilton County Recorder.

I recommend the Board set a hearing for this proposed drain  
*May*  
for ~~April~~ 1994.

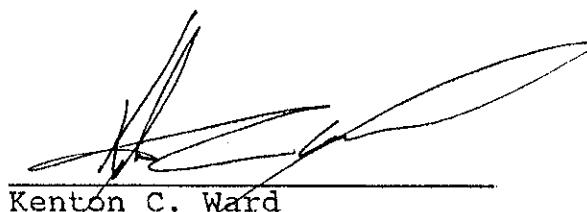  
Kenton C. Ward  
Hamilton County Surveyor

KCW/no

NBD Bank, N.A.  
One Indiana Square  
Indianapolis, Indiana 46266

N  
B  
D

IRREVOCABLE LETTER OF CREDIT NUMBER SB036333

November 4, 1993gt

BENEFICIARY

Board of Commissioners  
of the County of Hamilton  
ATT: Gini Hiuches  
Room 16, Courthouse  
Noblesville, IN 46060

APPLICANT

Cheswick Corporation  
P.O. Box 553  
Carmel, IN 46032

Expiration date: November 1, 1994

Amount USD 176,804.00

We hereby issue in your favor this irrevocable letter of credit, which is available against the following documents:

Drafts drawn at sight on NBD Bank, N.A., Indianapolis, Indiana bearing the clause "Drawn under irrevocable letter of credit number SB036333 dated November 4, 1993".

Beneficiary's signed certificate stating that the applicant has failed to construct the necessary storm sewers at the Applicant's Cheswick Subdivision, Section I (including the necessary off-site work).

We hereby engage with you drawers and/or bona fide holders that drafts drawn and negotiated in conformity with the terms of this letter of credit will be duly honored on presentation and that drafts accepted within the terms of this credit will be duly honored at maturity.

Except so far as otherwise expressly stated, this documentary credit is subject to the Uniform Customs and Practice for Documentary Credits (1983 Revision) International Chamber of Commerce Publication No. 400.

Regards,

Gina C. Shueran

RELEASE OF MAINTENANCE/PERFORMANCE BOND  
RELEASE OF LETTER OF CREDIT

HAMILTON COUNTY BOARD OF COMMISSIONERS

BY: John C. Dillingham

BY: John C. Dillingham

BY: William R. Clark

DATED: 11/23/93

ATTEST: John M. O'Brien  
HAMILTON COUNTY AUDITOR

This document was obtained from the Digital Archives of the Hamilton County Surveyor's Office; One Hamilton Co. Square, Ste. 188, Noblesville, IN 46060

CERTIFICATE OF COMPLETION AND COMPLIANCE

Address of premises on which  
land alteration was accomplished 136th Street to 141st Street on the East  
side of Ditch Road

Inspection Date(s): September 6, 1994 Permit No. \_\_\_\_\_

Relative to plans prepared by: Stoeppelwerth and Associates, Inc.  
on February 12, 1993.

I hereby certify that:

To the best of my knowledge, information and belief such land  
alteration has been performed and completed in conformity with the improved  
plan, except STR. 802A was not constructed

Signature David J. Stoeppelwerth Date: October 27, 1994

Typed Name: David J. Stoeppelwerth Phone: (317) 849-5935

Business Address 9940 Allisonville Rd., P.O. Box 509007  
Indianapolis, In. 46250

Surv.  Engr.  Arch.  Indiana Registration No. P.E. 19358, R.L.S.  
S0474



10265COM/IWP/FORM



SURVEYOR'S OFFICE

# Hamilton County

Kenton C. Ward, Surveyor

776-8495

Suite 146

One Hamilton County Square

Noblesville, Indiana 46060-2230

October 5, 1995

TO: Hamilton County Drainage Board

RE: Cheswick Place Drain

Attached are as-builts, certificate of completion & compliance, and other information for Cheswick Place Section 1. An inspection of the drainage facilities for this section has been made and the facilities were found to be complete and acceptable.

During construction, changes were made to the drain which will alter the plans submitted with my report for this drain dated February 23, 1994. The changes are as follows:

STR. 802 to 806 consists of 15" RCP which was shortened from 265' to 263'.  
STR. 808 to 809 consists of 24" RCP which was shortened from 205' to 198'.  
STR. 809 to 810 consists of 24" RCP which was lengthened from 123' to 125'.  
STR. 810 to 811 consists of 24" RCP which was lengthened from 440' to 442'.  
STR. 811 to 812 consists of 21" RCP which was lengthened from 40' to 41'.  
STR. 812 to 814 consists of 21" RCP which was shortened from 110' to 109'.  
STR. 899 to 897 consists of 12" RCP which was shortened from 216' to 213'.  
STR. 898 to 897 consists of 12" RCP which was shortened from 65' to 64'.  
STR. 845 to 846 consists of 12" RCP which was shortened from 270' to 268'.  
STR. 834 to 833 consists of 15" RCP which was shortened from 185' to 183'.  
STR. 818 to 816 consists of 12" RCP which was shortened from 140' to 138'.  
STR. 816 to 815 consists of 15" RCP which was lengthened from 40' to 42'.  
STR. 815 to 814 consists of 18" RCP which was shortened from 175' to 173'.  
STR. 830 to 824 consists of 18" RCP which was shortened from 405' to 404'.  
STR. 824 to 822 consists of 24" RCP which was lengthened from 40' to 44'.  
STR. 822 to 821 consists of 30" RCP which was lengthened from 130' to 132'.  
STR. 821 to 820 consists of 30" RCP which was shortened from 190' to 182'.  
STR. 836 to 835 consists of 12" RCP which was shortened from 60' to 51'.  
STR. 835 to 835A consists of 12" RCP which was lengthened from 155' to 160'.  
STR. 835A to 827 consists of 12" RCP which was shortened from 175' to 173'.  
STR. 827 to 828 consists of 15" RCP which was lengthened from 40' to 42'.  
STR. 828 to 826 consists of 18" RCP which was lengthened from 160' to 162'.  
STR. 826 to 824 consists of 18" RCP which was lengthened from 80' to 82'.  
STR. 831 to 826 consists of 12" RCP which was shortened from 205' to 201'.  
STR. 829 to 828 consists of 12" RCP which was lengthened from 45' to 46'.  
STR. 836A to 835 consists of 12" RCP which was lengthened from 30' to 34'.

Attached also is a non-enforcement for the drain which I recommend that the Board approve at this time. The non-enforcement was approved by the Board at its meeting on October 10, 1994.


Page # 2 Cheswick Place Drain, October 5, 1995

The bond or letter of credit from NBD Bank, NA, number SB 036333, dated November 4, 1993, in the amount of \$176,804.00, has been recommended for release in a letter to the Commissioners dated December 28, 1994.


I recommend the Board approve the drains construction as complete and acceptable.

The length of the drain due to the changes described above is now  
16,712 feet.

Sincerely,

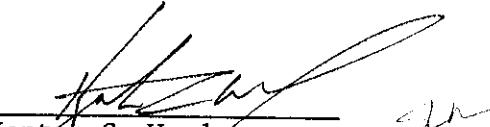  
\_\_\_\_\_  
Kenton C. Ward  
Hamilton County Surveyor

KCW/sh

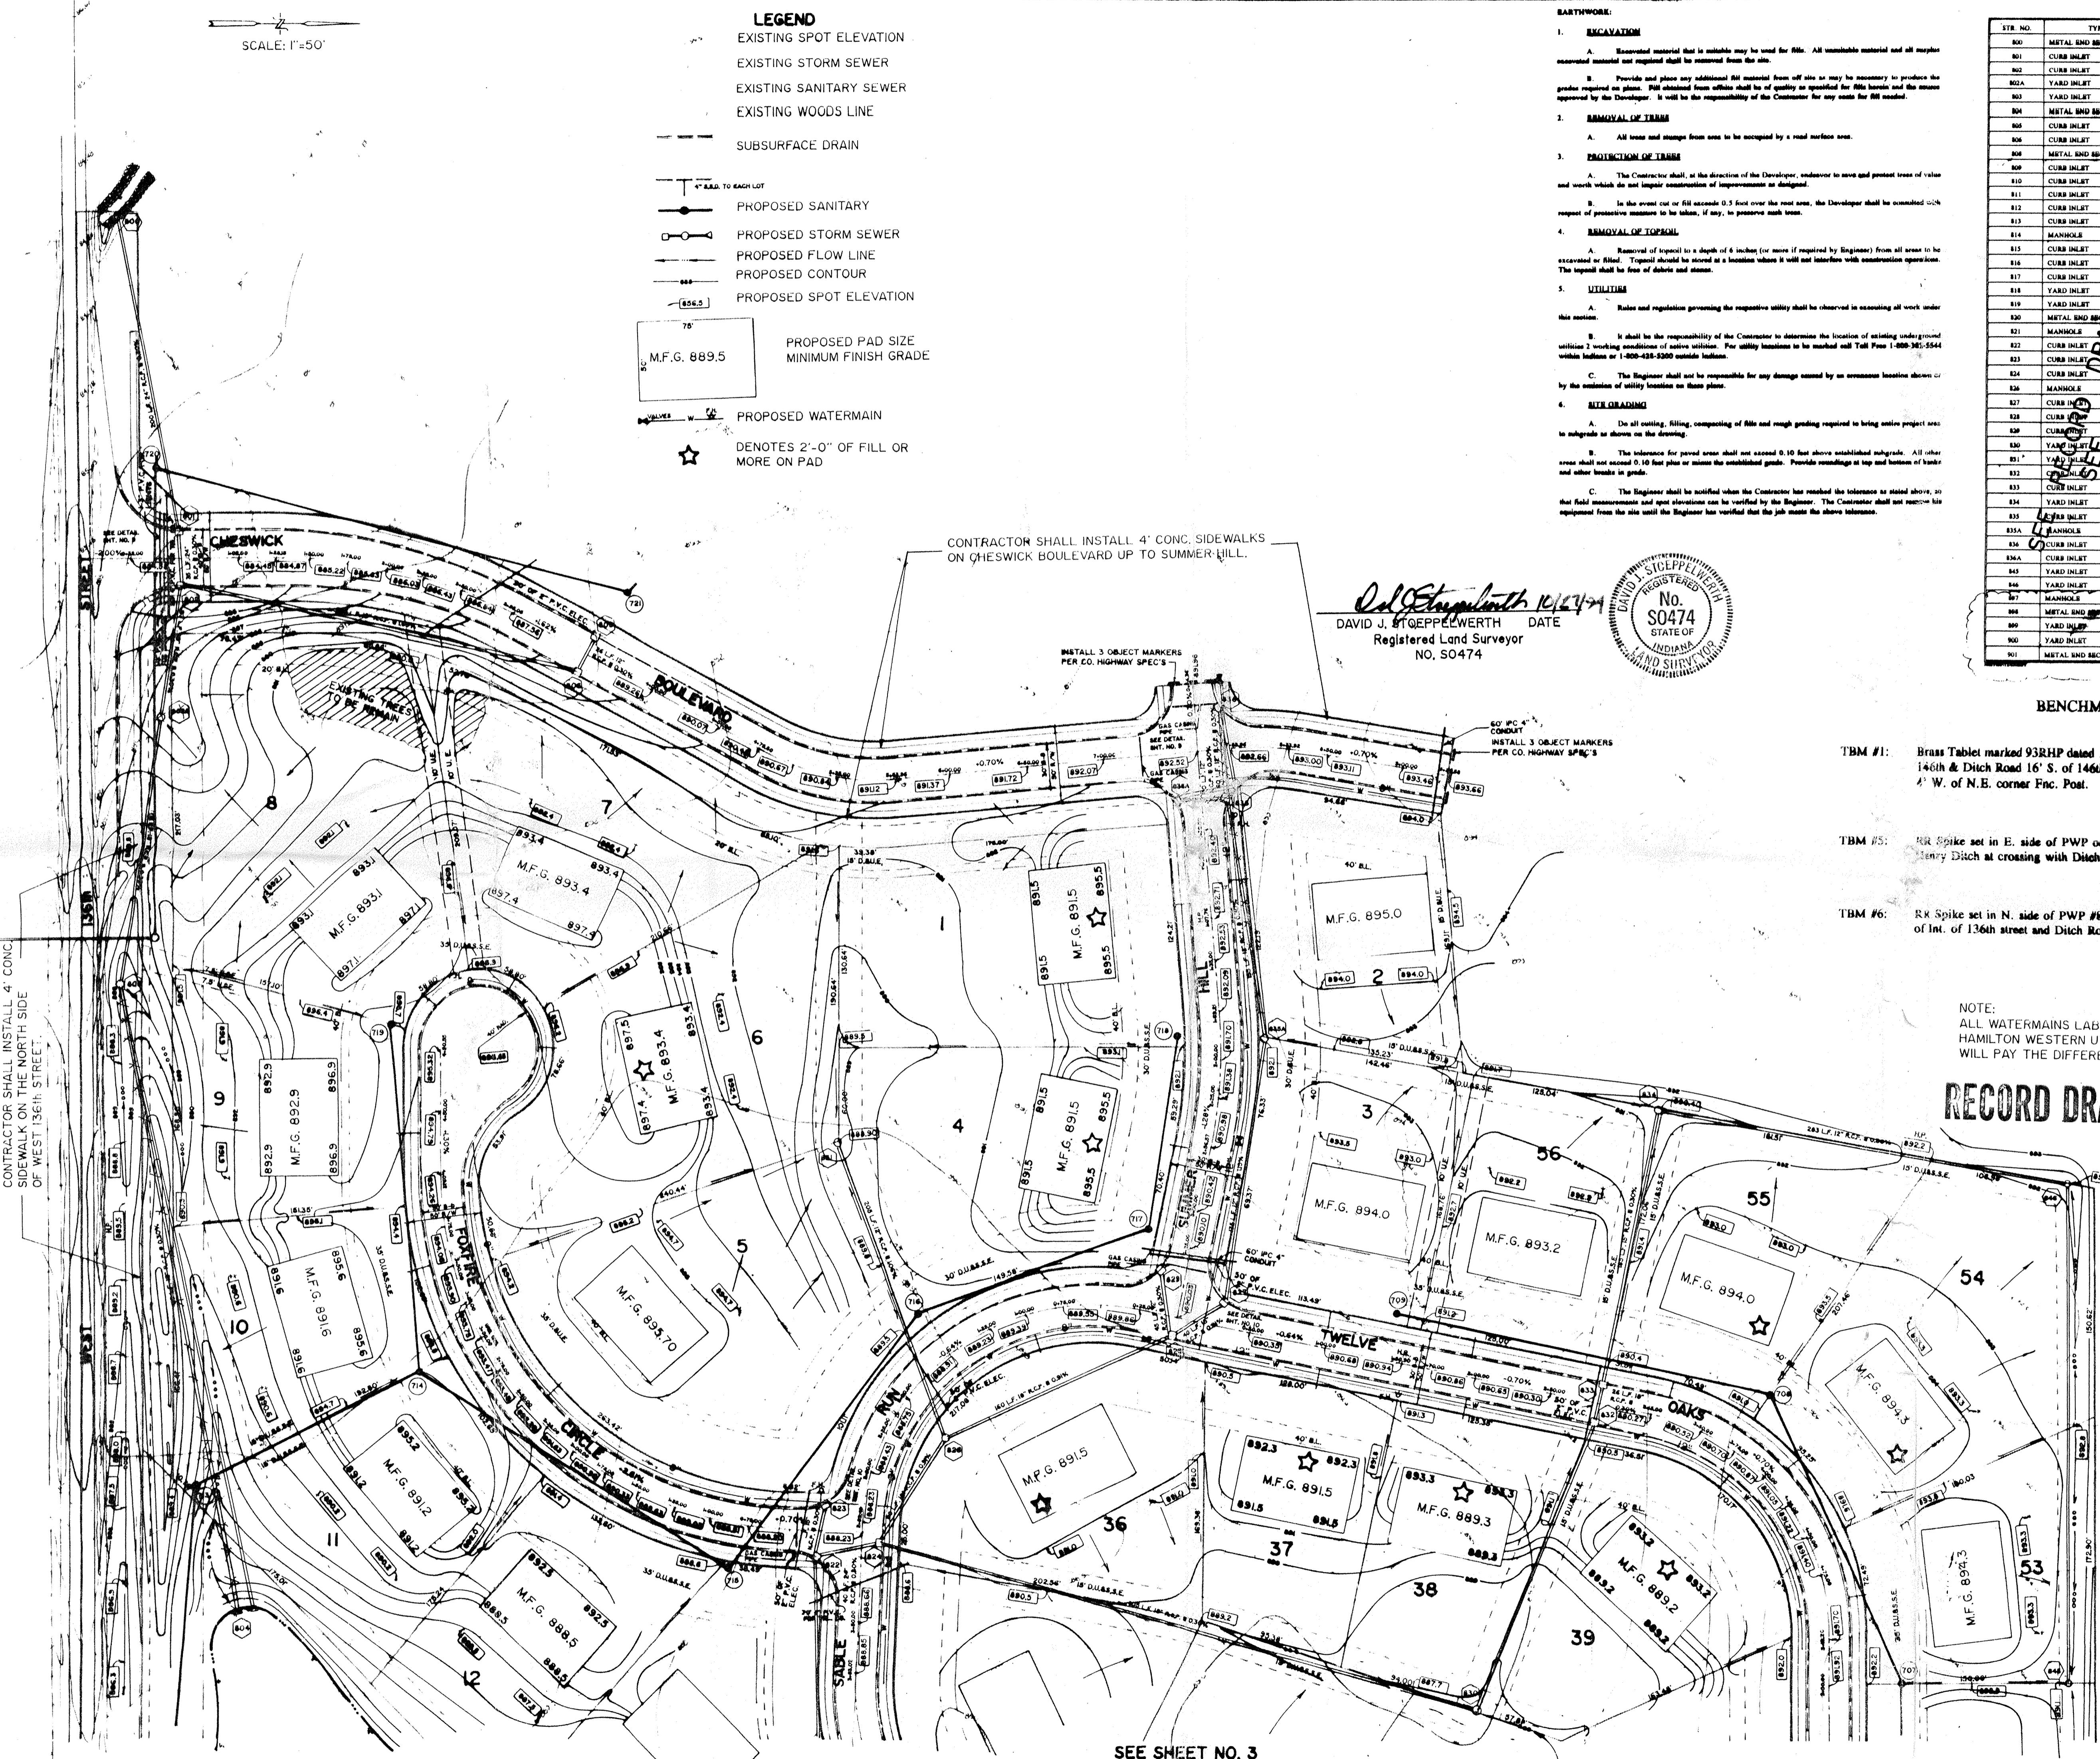

**EARTHWORK:**


- EXCAVATION**
  - A. Excavated material that is suitable may be used for fills. All unsuitable material and all materials excavated not required shall be removed from the site.
  - B. Provide and place any additional fill material from off site as may be necessary to produce the grades required on plans. Fill material from offsite shall be of quality as specified for fills herein and the manner approved by the Developer. It will be the responsibility of the Contractor for any costs for fill needed.
- REMOVAL OF TREES**
  - A. All trees and stumps from one to be occupied by a real surface area.
- PROTECTION OF TREES**
  - A. The Contractor shall, at the direction of the Developer, endeavor to save and protect trees of value and worth which do not impair construction of improvements as designed.
  - B. In the event cut or fill exceed 0.5 foot over the root area, the Developer shall be consulted with respect of protective measures to be taken, if any, to preserve such trees.
- REMOVAL OF TOPSOIL**
  - A. Removal of topsoil to a depth of 6 inches (or more if required by Engineer) from all areas to be excavated or filled. Topsoil should be stored at a location where it will not interfere with construction operations. The topsoil shall be free of debris and stones.
- UTILITIES**
  - A. Rules and regulation governing the respective utility shall be observed in executing all work under this section.
  - B. It shall be the responsibility of the Contractor to determine the location of existing underground utilities & working conditions of active utilities. For utility locations to be marked call Toll Free 1-800-365-5544 within Indiana or 1-800-423-5300 outside Indiana.
  - C. The Engineer shall not be responsible for any damage caused by an erroneous location shown or by the omission of utility location on these plots.
- Site Grading**
  - A. Do all cutting, filling, compacting of fill and rough grading required to bring entire project area to grade as shown on the drawing.
  - B. The tolerance for paved areas shall not exceed 0.10 foot above established subgrade. All other areas shall not exceed 0.10 foot plus minus the established grade. Provide rollings at top and bottom of banks and other breaks in grade.
  - C. The Engineer shall be notified when the Contractor has reached the tolerance as stated above, so that field measurements and spot elevations can be verified by the Engineer. The Contractor shall not remove his equipment from the site until the Engineer has verified that the job meets the above tolerance.

STORM SEWER TABLE		
STR. NO.	TYPE	TOMM
S00	METAL END SECTION	879.26
S01	CURB INLET	884.30
S02	CURB INLET	884.30
S02A	YARD INLET	884.40
S03	CURB INLET	887.70
S04	METAL END SECTION	882.00
S05	CURB INLET	888.87
S06	CURB INLET	888.87
S08	METAL END SECTION	882.00
S09	CURB INLET	888.78
S10	CURB INLET	888.84
S11	CURB INLET	888.31 (S) (N)
S12	CURB INLET	888.45 (S) (N)
S13	CURB INLET	888.40
S14	MANHOLE	888.76 (N) (W)
S15	CURB INLET	888.28 (N) (W)
S16	CURB INLET	888.04
S17	CURB INLET	888.40
S18	YARD INLET	888.40
S20	METAL END SECTION	882.00
S21	MANHOLE	888.60
S22	CURB INLET	888.76
S23	CURB INLET	888.94 (N) (W)
S24	CURB INLET	888.12
S26	MANHOLE	888.30
S27	CURB INLET	888.61 (N) (W)
S28	CURB INLET	888.03
S29	CURB INLET	888.78
S30	YARD INLET	887.20
S31	YARD INLET	888.50
S32	CURB INLET	888.03
S33	CURB INLET	888.03
S34	YARD INLET	888.40
S35	YARD INLET	888.13 (N) (W)
S35A	MANHOLE	888.50
S36	CURB INLET	888.30
S42	YARD INLET	888.10
S47	MANHOLE	888.00
S64	METAL END SECTION	888.00
S69	YARD INLET	887.30
S90	YARD INLET	888.10
S91	METAL END SECTION	888.87

**DRAWING RECORD**

CONSULTING ENGINEERS-LAND SURVEYORS		
DAVID J. STOEPELWERTH No. S0474 STATE OF INDIANA LAND SURVEYOR REGISTERED		
10/27/94		
EFFECTIVE DATE 10/27/94		
INSTRUMENT 100 ft. T.S. 100 ft. C.C.H.		
INSTRUMENT 100 ft. T.S. 100 ft. C.C.H.		
SITE DEVELOPMENT PLAN		
CHESWICK PLACE SECTION I		
PRINTED		
FILED		
OCT 28 1994		
HAMILTON COUNTY DRAINAGE BOARD		
CARMEL		
SHEET NO. 2 OF 26 SHEETS		
12450		

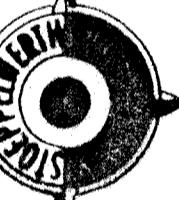

**RECORD DRAWING**

This information was gathered for input  
into the Hamiton County Geographical  
Information System. This document is  
considered an official record of the  
GIS.

Entered by: JOH  
Date: 10/27/94

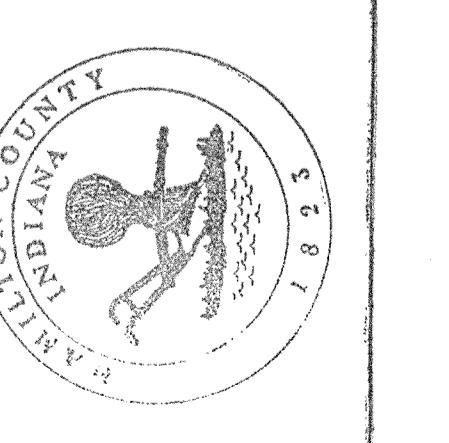


PRINTED  
OCT 27 1994

HAMILTON COUNTY DRAINAGE BOARD  
SECRETARY

CARMEL


FILE NUMBER  
SECTION  
SHEET NUMBER

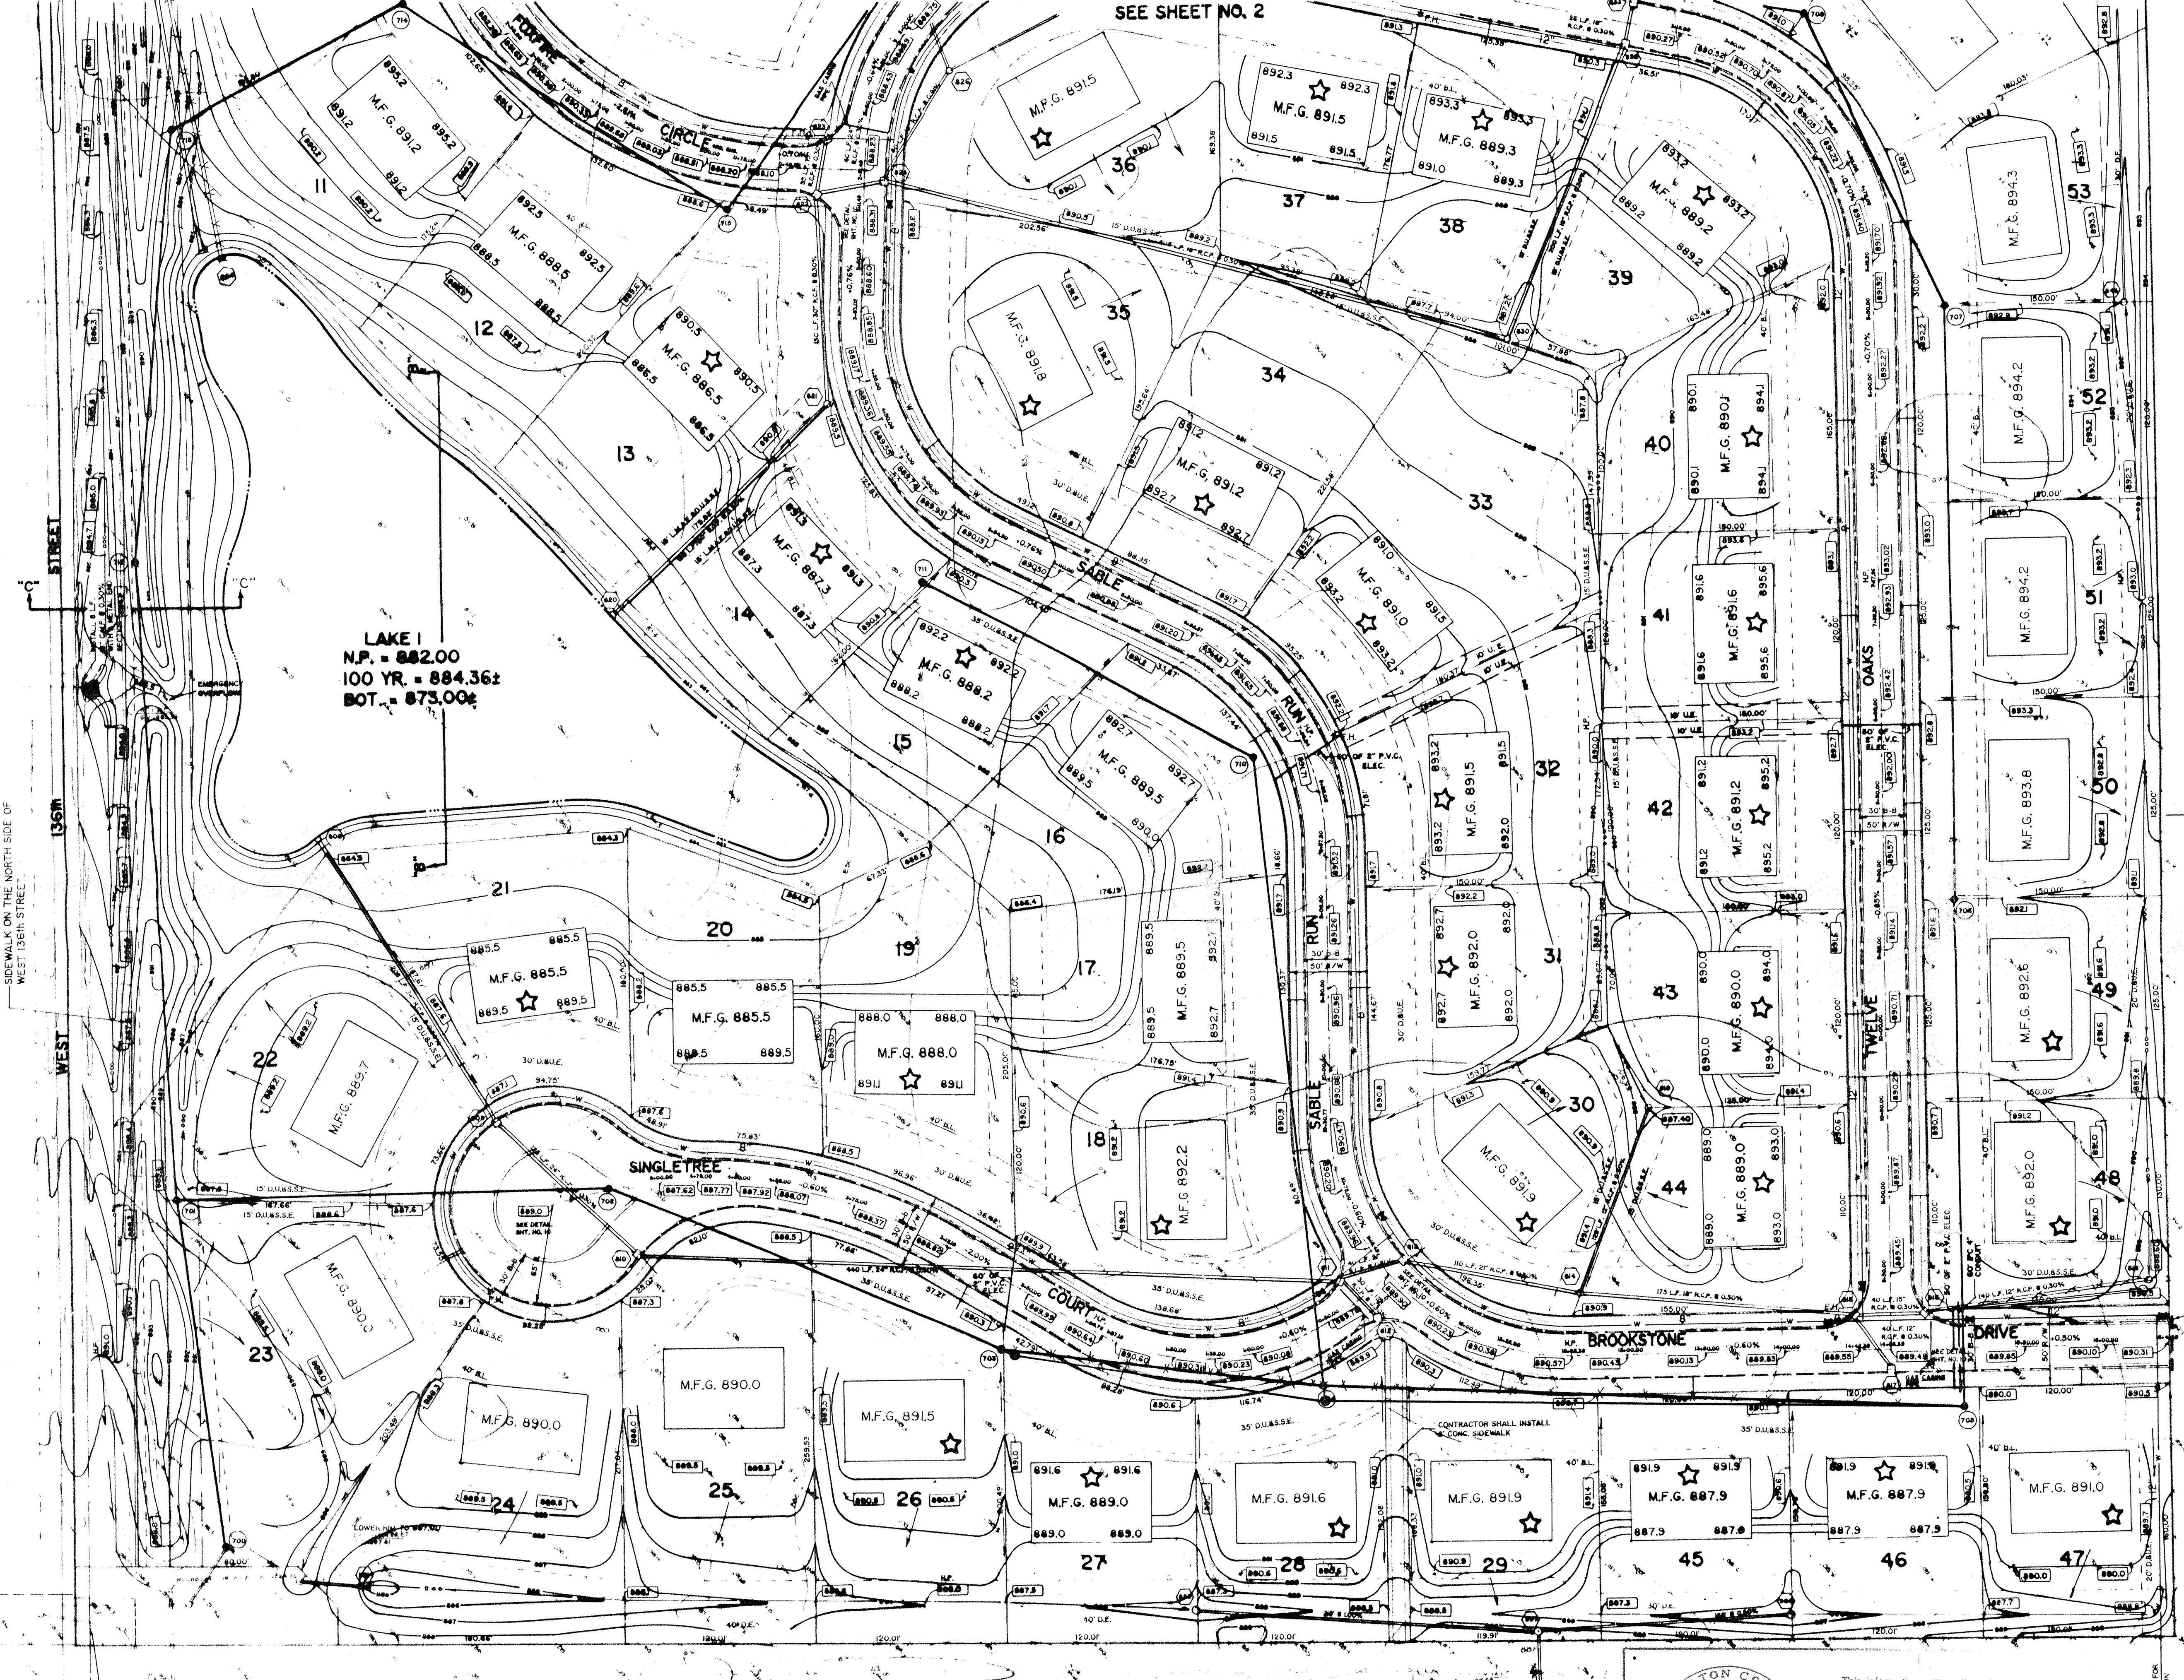

NOTE:  
ALL WATERMAINS LABELED 12"  
HAMILTON WESTERN UTILITIES  
WILL PAY THE DIFFERENCE FROM 8"

## RECORD DRAWING

DAVID J. STOEPELWERTH DATE  
Registered Land Surveyor  
NO. S0474

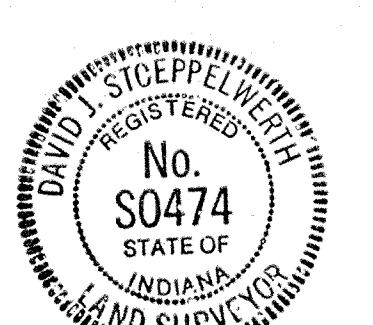


## SITE DEVELOPMENT PLAN CHESWICK PLACE SECTION I

SHEET NO.  
OF 26 SHEETS  
12450

CARMEL


FILED  
01/28/94  
DEPT. OF LAND SURVEY  
HAMILTON COUNTY, INDIANA

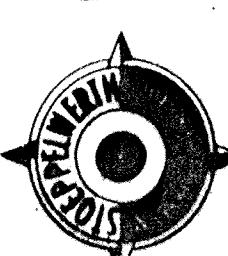


This information was gathered from the Hamilton County Geographic Information System. This information is considered an official record of the HCS.

Entry Date: 11-14-03

Entered by: JDH

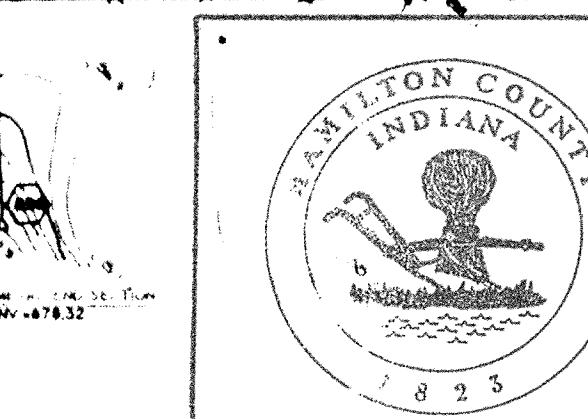

FILE NUMBER	W.A.B.	01/22/94
SECTION	1125 (4)	AS-BUILT
SHEET NUMBER	1013 (3)	Rev'D. S.D. PLANS 24-24
	1013 (3)	Rev'd. Plat. Com. 2nd. Plat. Changes
	ADU PROP. CON. TOL.	LMC
	ADU OWNERS NAME	BY
	DATE	MARK
	2/12/93	


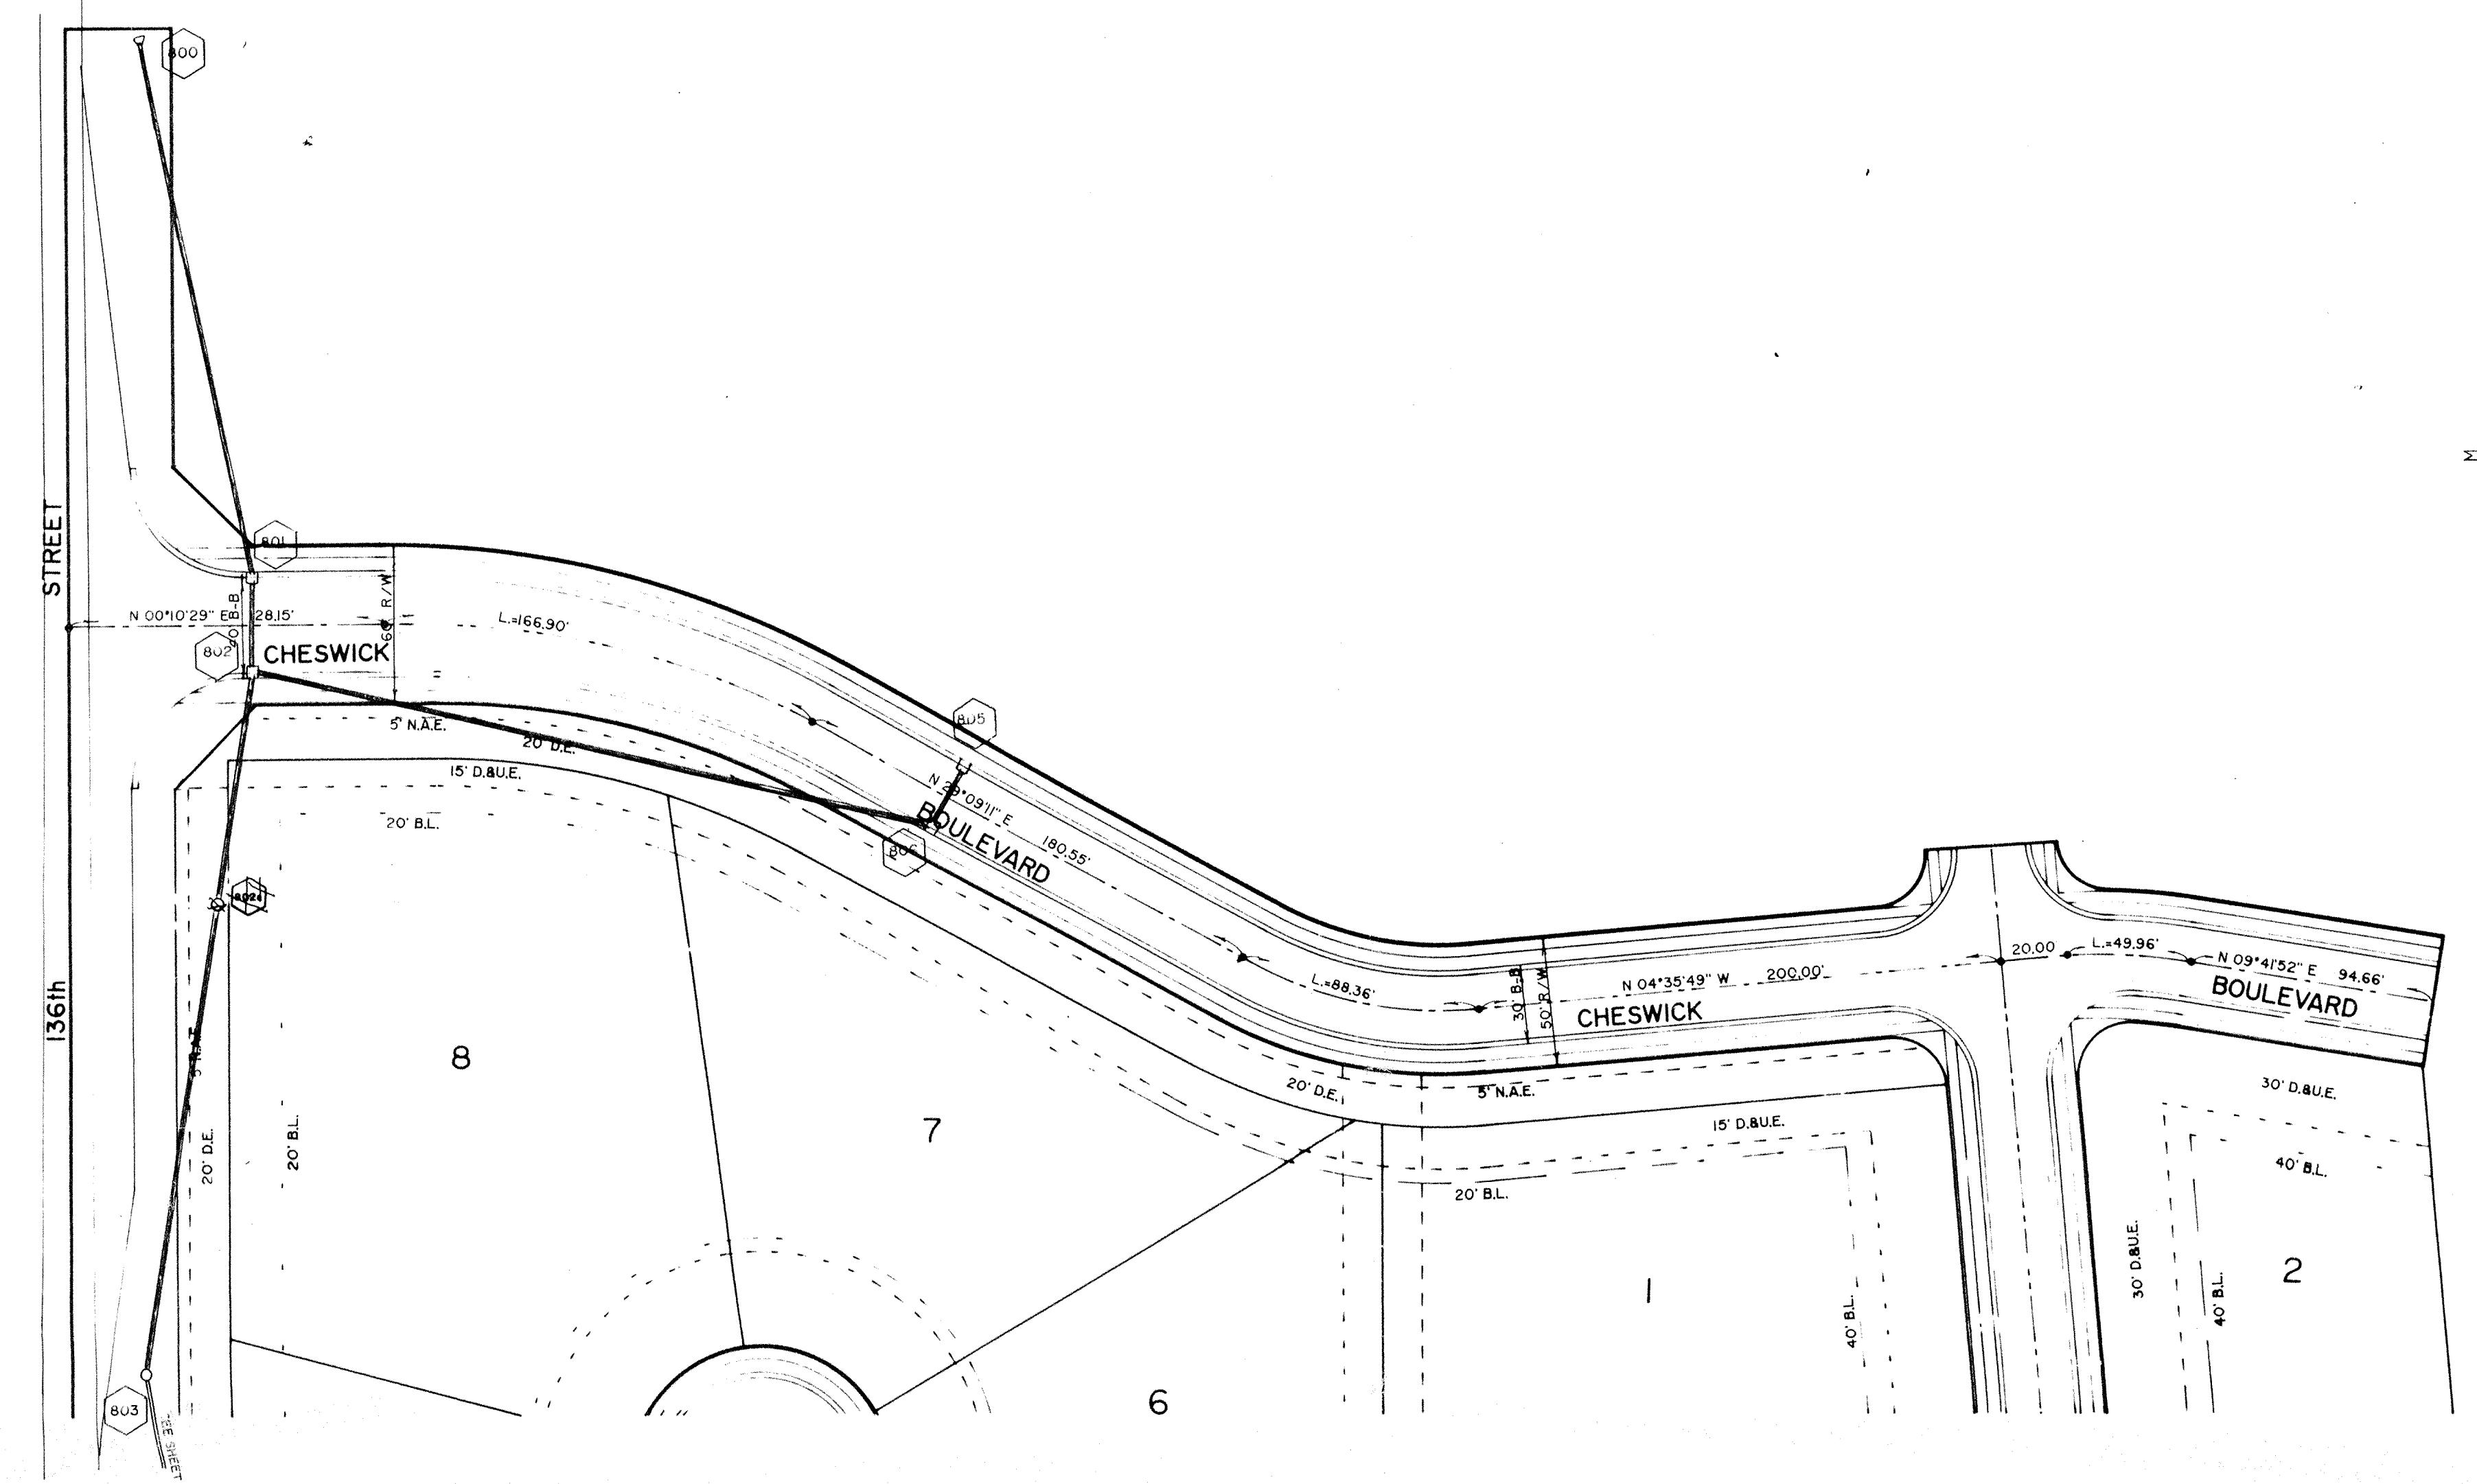


NOTE:

DAVID J. STOEPELWERTH DATE  
Registered Land Surveyor  
NO. S0474




# ECORD DRAWING

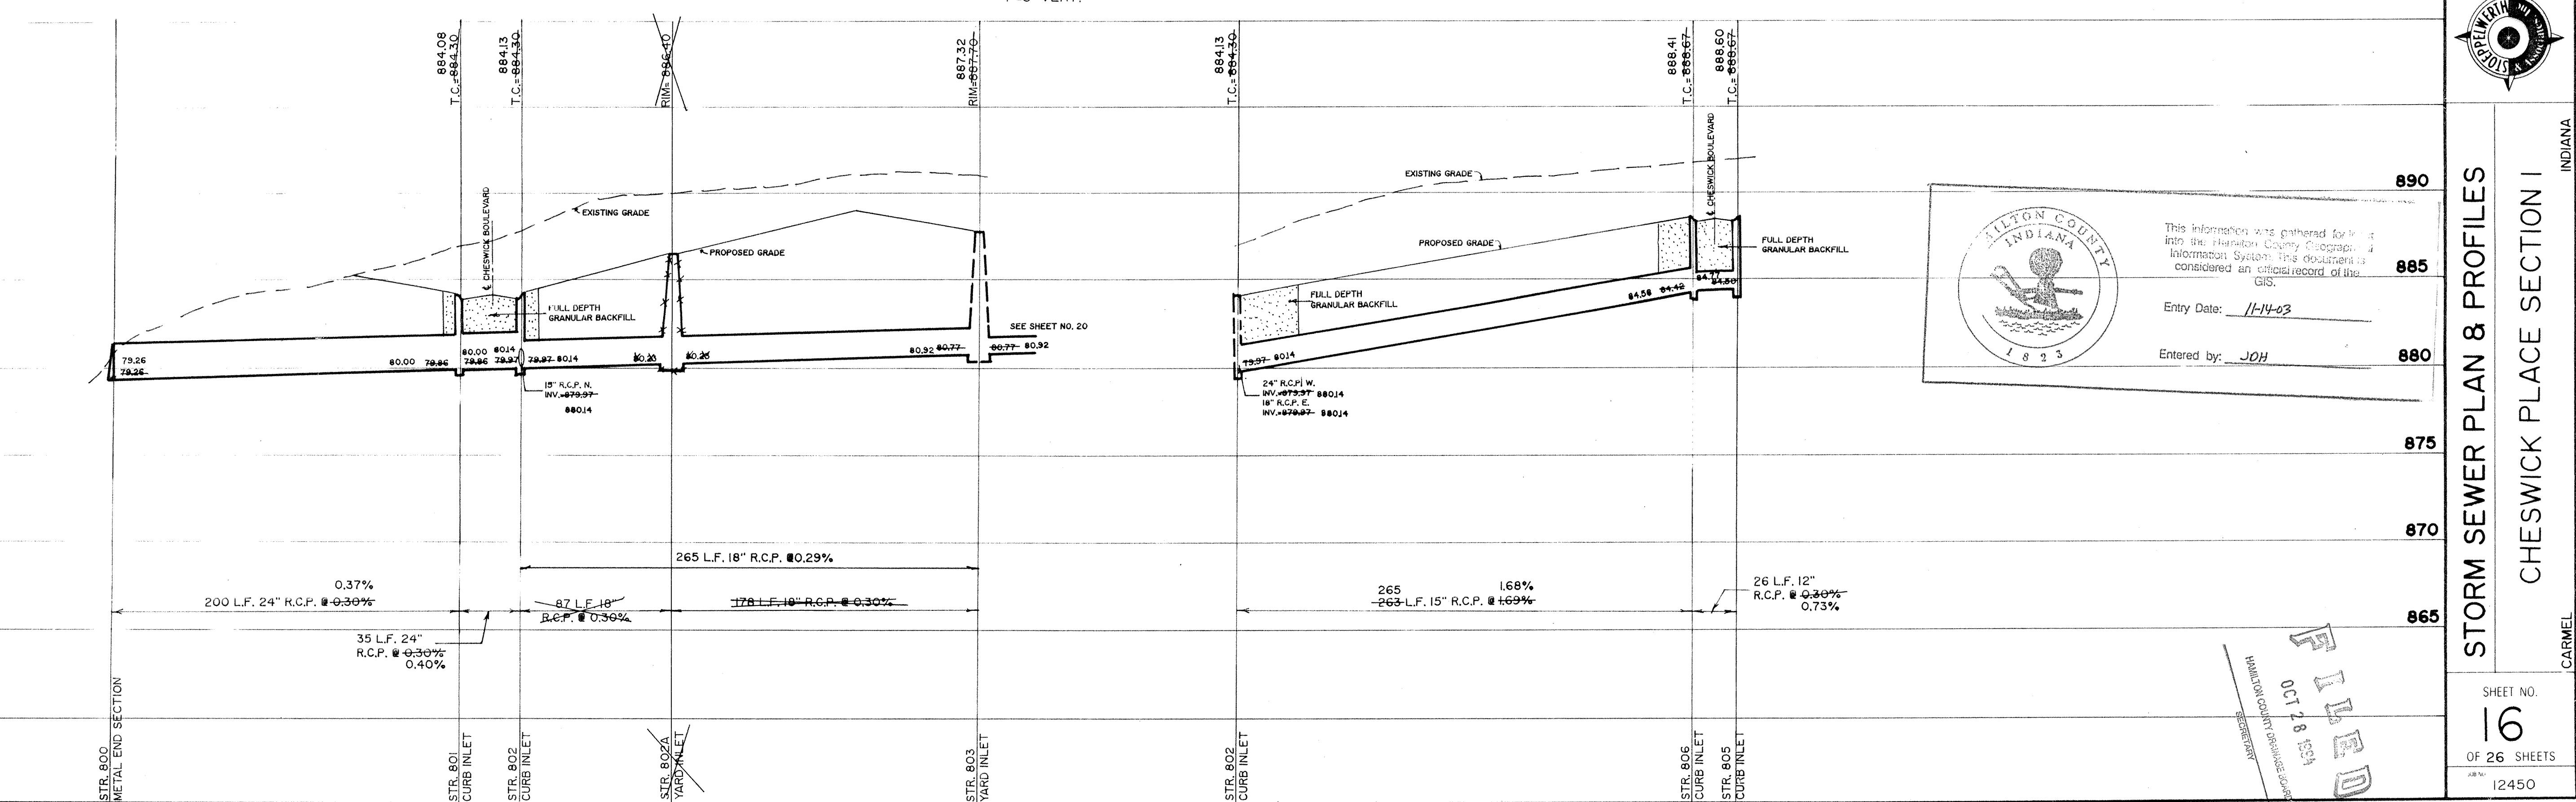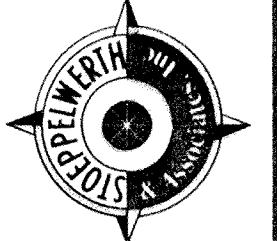




SCALE: 1'=50'

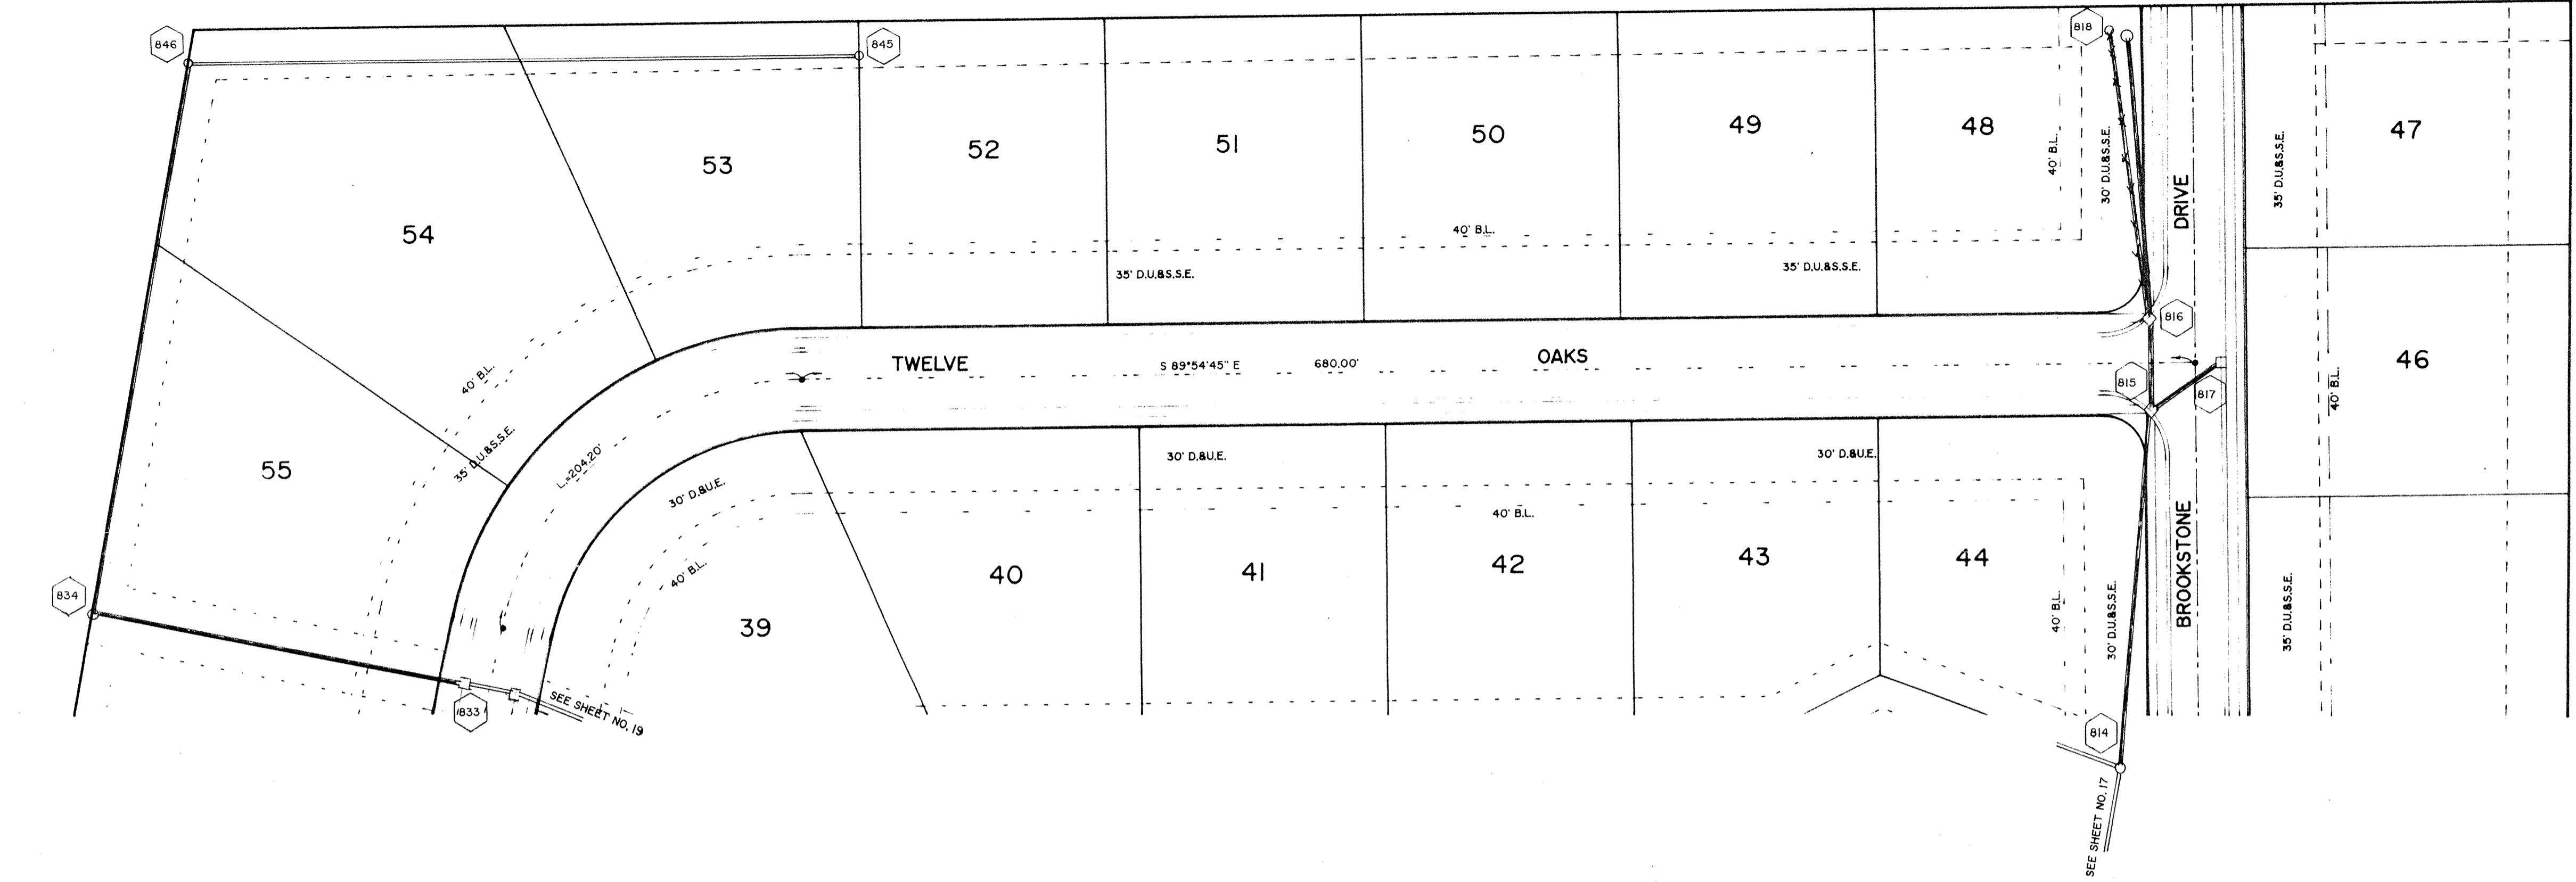

*DAVID J. STOEPPELWERTH*  
DAVID J. STOEPPELWERTH DATE  
Registered Land Surveyor  
No. SO474



## RECORD DRAWING

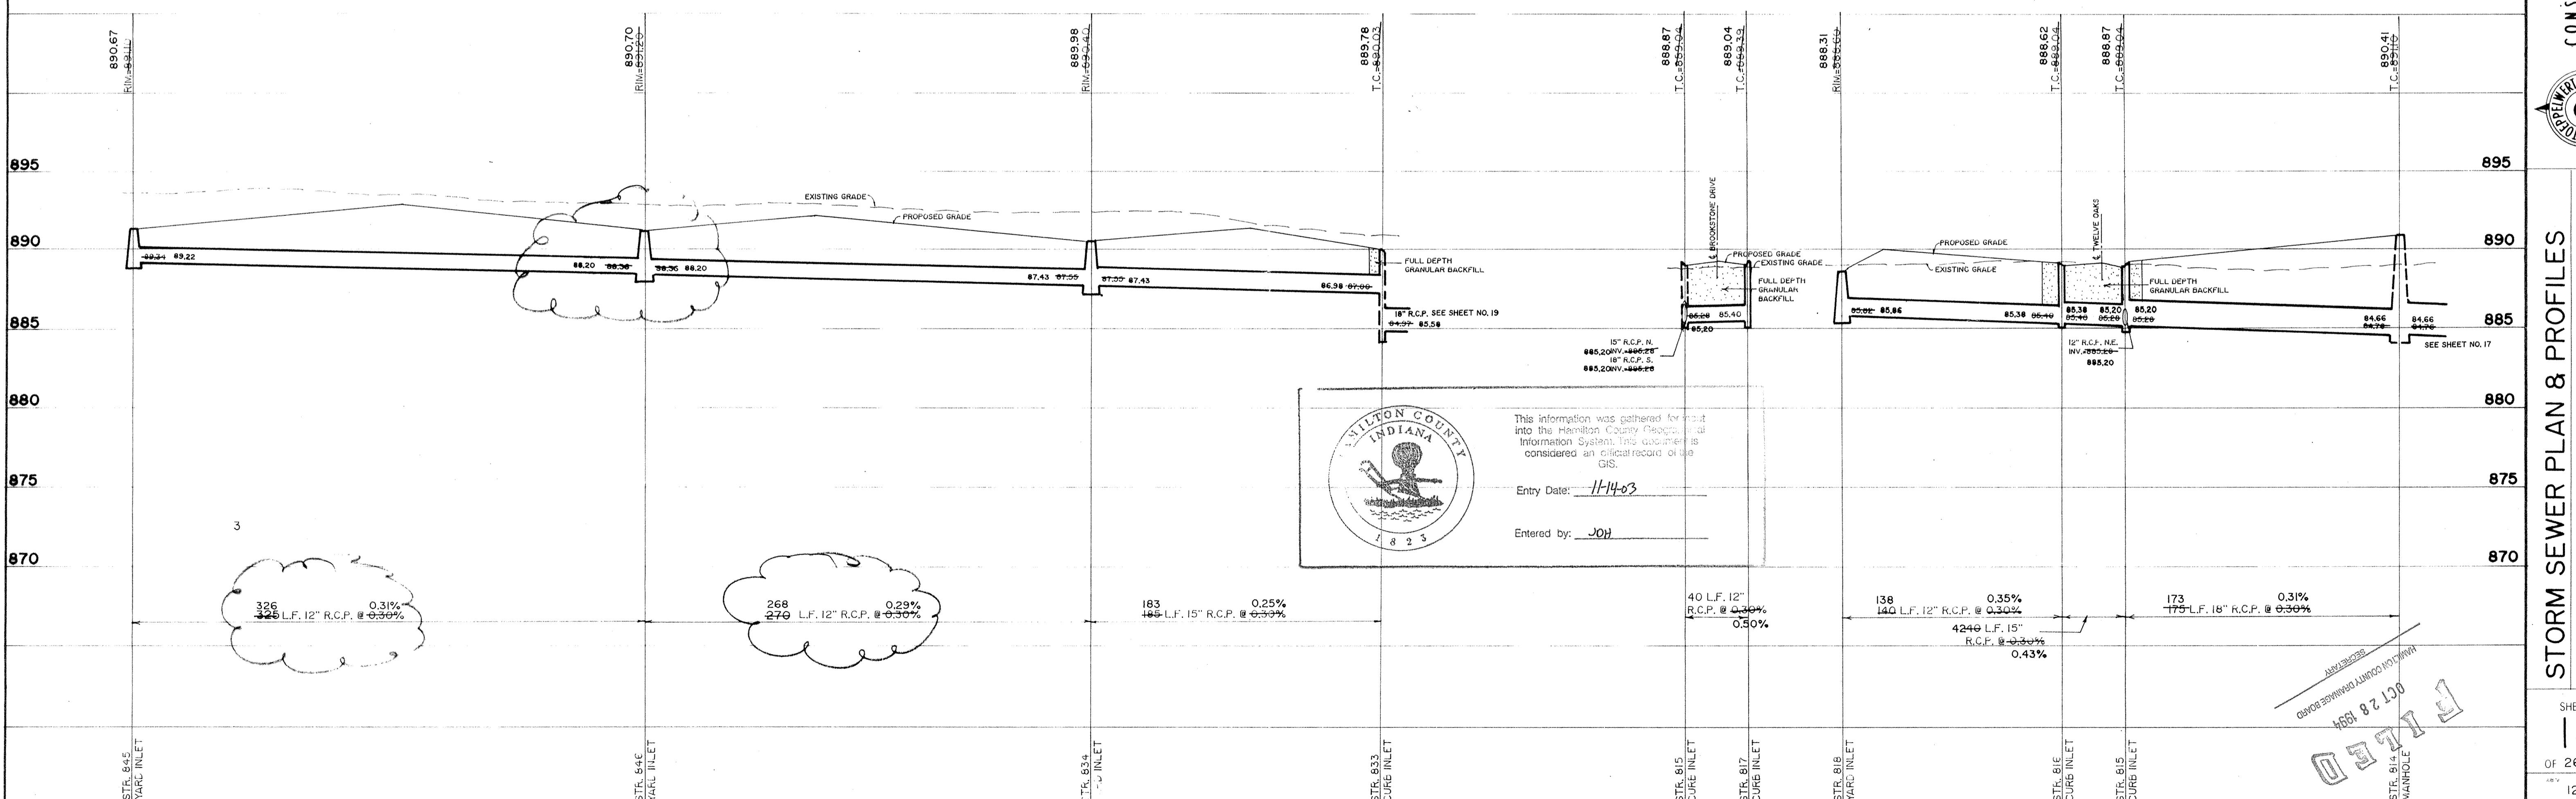SCALE: 1'=50' HOR.  
1'=5' VERT.

AC-BL	JOB NUMBER 17460
SECTION 1	DATE 10/12/93
SHEET NUMBER 1	REV STR. 845 & STR. 846
	REVISIONS
	BY

CERTIFIED: <i>DAVID J. STOEPPELWERTH</i>	REGISTRATION NO. 19388
DAVID J. STOEPPELWERTH	STATE OF INDIANA
CONSULTING ENGINEERS/LAND SURVEYORS	LAND SURVEYOR
(317) 849-5935 FAX: (317) 849-5942	INDIANA
INDIANAPOLIS	RECEIVED



