

Gasb 34 Footages for Historical Cost
Drain Length Log

Drain-Improvement: Clarendon Creek - Southpark II

| Drain Type: | Size: | Length () | Length (DB Query) | Length Reconcile | Price: | Cost: |
|-------------|-------|---------------|----------------------|---------------------|--------|-------|
| SSD | 6" | 3302' | N/A | | | |
| RCP | 21" | 142' | | | | |
| | 30" | 159' | | | | |
| | 36" | 1598' | | | | |
| | 42" | 364' | | | | |
| | 60" | 31' | | | | |
| OPEN DITCH | | 1640' | | | | |
| | | | | | | |
| | | | | | | |

Sum: 7236' \$127,000.00

Final Report: N/A

Comments:

NO FINAL REPORT OR ASBUILTS → DATA NOT INPUT INTO GIS

PENCILED CHANGES AND INITIAL REPORT REFLECT CORRECTIONS TO ERRORS MADE WHEN REPORT WAS TYPED.

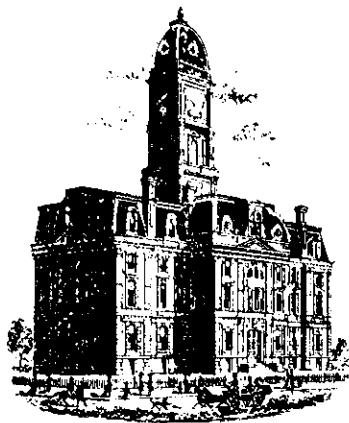

Kenton C. Ward, Surveyor

Phone (317) 776-8495

Fax (317) 776-9628

Suite 188

One Hamilton County Square

Noblesville, Indiana 46060-2230

September 19, 2002

To: Hamilton County Drainage Board

Re: Harmon Clark Drain

Attached is a petition and plans for the proposed relocation of the Harmon Clark Drain. The relocation is being proposed by WLB Associates, Incorporated, Oakridge Investments LTD and Hinshaw Realty, Incorporated. The proposal is to relocate and reconstruct the Harmon Clark Drain from Sta. 6+50 through Sta. 23+00 of the original description of South Park II.

Through

20+50

The line will consist of the following:

| | | | | | |
|---------|----------|---------|----------|------------|----------|
| 6" SSD | 3,302 ft | 30" RCP | 159 ft | 42" RCP | 364 ft |
| 21" RCP | 142 ft | 36" RCP | 1,598 ft | 60" RCP | 31 ft |
| | | | | Open Ditch | 1,640 ft |

The open ditch listed above is that which crosses Lot 2 between Str. 717 to the detention facility located in Common Area "A" as shown on the plan for South Park II by Weihe Engineers, Inc. dated August 14, 2002 revised October 2, 2002. The open ditch is also along the west row of the Monon from the northeast corner of South Park II to the detention facility in Common Area "A". It shall also include that portion of open ditch from storm structure #720 to the south property line of South Park II.

7236

The total length of new Drain shall be 3,394 feet. The 1,650 feet of original drain between Sta. 6+50 and Sta. 23+00 shall be vacated. This proposal will add an additional 2,284 feet to the drains total length.

5836

I believe this proposed drain meets the requirements for Urban Drain Classification as set out in IC 36-9-27-67 to 69. Therefore, this drain shall be designated as an Urban Drain.

The retention lake located in Common Area "A" is to be considered part of the regulated drain. The inlet and outlet will be maintained as part of the regulated drain and the lake is to be considered as open ditch. The maintenance of the lake will not include mowing responsibility of the property owner. The Board will also retain jurisdiction for ensuring the storage volume for which the lake was designed will be retained. Thereby, allowing no fill or easement encroachments.

The subsurface drains (SSD) to be part of the regulated drain are those located under the curbs. Only the main SSD lines which are located within the right-of-way are to be maintained as regulated drain. Laterals for individual lots will not be considered part of the regulated drain.

The cost of the relocation is to be paid by WLB Associates, Inc., Oakridge Investments LTD and Hinshaw Realty, Inc. Because the project is to be paid by the petitioner and is within the boundaries of the petitioners property the project falls under the requirements as set out in IC 36-9-27-52.5. Therefore, a public hearing with 30 day notice is not required for the petition.

The petitioner has provided the letter of credit as follows:

Name of Bonding Co./Bank: Irwin Union Bank


Bond/LC Number:

Bond/LC Date:

Bond/LC Amount: \$127~~\$~~,000.00

Bond Term: 1 Year

I recommend approval by the Board at this time.

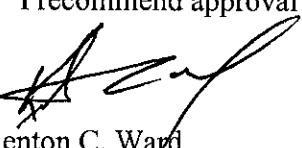

Kenton C. Ward
Hamilton County Surveyor

KCW/ljm

HCDB - 2003-
00025**SUBDIVISION PERFORMANCE BOND**Bond # 5003397

KNOW ALL MEN BY THESE PRESENTS, that we Oakridge Investments LP, Joint venture
DBA Oakridge Owners, 12443 Charing Cross Road, Carmel, IN 46033

as Principal, and Bond Safeguard Insurance Company, 1919 S. Highland Avenue,
Bldg. A, Suite 300, Lombard, IL 60148

authorized to do business in the State of Indiana, as Surety are held firmly bound unto _____,
Hamilton County Board of Commissioners

as Obligee, in the penal sum of One Hundred Twenty Seven Thousand and No/100-----

----- (\$ 127,000.00)

for the payment of which sum well and truly to be made, we bind ourselves, our heirs, administrators,
executors, successors and assigns, jointly and severally firmly by these present;

WHEREAS, the above bounden Principal has been granted approval by the above named Obligee for
Relocation and Reconstruction of the Harmon Clark Drain in Southoak Park

NOW, THEREFORE, the condition of the obligation is such, that if the said Principal shall complete the
above improvements in accordance with the plans and specifications prepared by _____

_____, and shall indemnify and save harmless the Obligee
from all costs and damages which it may suffer by reason of failure to do so, and fully reimburse and
repay Obligee any outlay and expense which it may incur in making good any such default, then this
obligation shall be null and void, otherwise to remain in full force and effect.

THE FOREGOING OBLIGATION, however, is limited by the following express conditions, the
performance of which shall be a condition precedent to any rights of claims or recovery hereunder:

1. Upon the discovery by the Obligee, or by the Obligee's agent or representative, of any act or omission that shall or might involve a loss hereunder, the Obligee shall endeavor to give written notice thereof with the fullest information obtainable at the time to the Surety.
2. Legal proceedings for recovery hereunder may not be brought unless begun within twelve (12) months from the date of the discovery of the act or omission of the Principal on account of which claim is made.
3. The Principal shall be made a party to any suit or action for recovery hereunder, and no judgment shall be rendered against the Surety in excess of the penalty of this instrument.
4. No right of action shall accrue hereunder to or for the use or benefit of anyone other than the Obligee, and the Obligee's right hereunder may not be assigned without the written consent of the Surety.

SIGNED, SEALED AND DATED this 9th Day of April, 2003,
Oakridge Investments, LP, Joint
Venture DBA Oakridge Owners

Bond Safeguard Insurance Company

By: L. Dale Hinshaw

By: Deborah M. Roth
Deborah M. Roth, Attorney-in-Fact

POWER OF ATTORNEY

AO 20423

Bond Safeguard INSURANCE COMPANY

KNOW ALL MEN BY THESE PRESENTS, that **BOND SAFEGUARD INSURANCE COMPANY**, an Illinois Corporation with its principal office in Lombard, Illinois, does hereby constitute and appoint:

Anthony George Balzano,

Deborah M. Roth, Jacqueline Demeter

its true and lawful Attorney(s)-In-Fact to make, execute, seal and deliver for, and on its behalf as surety, any and all bonds, undertakings or other writings obligatory in nature of a bond.

This authority is made under and by the authority of a resolution which was passed by the Board of Directors of **BOND SAFEGUARD INSURANCE COMPANY** on the 7th day of November, 2001 as follows:

Resolved, that the President of the Company is hereby authorized to appoint and empower any representative of the Company or other person or persons as Attorney-In-Fact to execute on behalf of the Company any bonds, undertakings, policies, contracts of indemnity or other writings obligatory in nature of a bond not to exceed \$500,000.00, Five Hundred Thousand Dollars, which the Company might execute through its duly elected officers, and affix the seal of the Company thereto. Any said execution of such documents by an Attorney-In-Fact shall be as binding upon the Company as if they had been duly executed and acknowledged by the regularly elected officers of the Company. Any Attorney-In-Fact, so appointed, may be removed for good cause and the authority so granted may be revoked as specified in the Power of Attorney.

Resolved, that the signature of the President and the seal of the Company may be affixed by facsimile on any power of attorney granted, and the signature of the Vice President, and the seal of the Company may be affixed by facsimile to any certificate of any such power and any such power or certificate bearing such facsimile signature and seal shall be valid and binding on the Company. Any such power so executed and sealed and certificate so executed and sealed shall, with respect to any bond or undertaking to which it is attached, continue to be valid and binding on the Company.

IN WITNESS THEREOF, **BOND SAFEGUARD INSURANCE COMPANY** has caused this instrument to be signed by its President, and its Corporate Seal to be affixed this 7th day of November, 2001.



BOND SAFEGUARD INSURANCE COMPANY

BY

David E. Campbell
President

ACKNOWLEDGEMENT

On this 7th day of November, 2001, before me, personally came David E. Campbell to me known, who being duly sworn, did depose and say that he is the President of **BOND SAFEGUARD INSURANCE COMPANY**, the corporation described in and which executed the above instrument; that he executed said instrument on behalf of the corporation by authority of his office under the By-laws of said corporation.



Janet L. Coppock
Notary Public

CERTIFICATE

I, the undersigned, Secretary of **BOND SAFEGUARD INSURANCE COMPANY**, An Illinois Insurance Company, DO HEREBY CERTIFY that the original Power of Attorney of which the foregoing is a true and correct copy, is in full force and effect and has not been revoked and the resolutions as set forth are now in force.

Signed and Sealed at Lombard, Illinois this 9th Day of April, 2003



Donald D. Buchanan
Secretary

CERTIFICATE OF COMPLETION AND COMPLIANCE

To: Hamilton County Surveyor

Re: South Oak Industrial Park Storm As-builts

I hereby certify that:

1. I am a Registered Land Surveyor or Engineer in the State of Indiana.
2. I am familiar with the plans and specifications for the above referenced subdivision.
3. I have personally observed and supervised the completion of the drainage facilities for the above referenced subdivision.
4. The drainage facilities within the above referenced subdivision to the best of my knowledge, information and belief have been installed and completed in conformity with all plans and specifications.


Signature: Allan H. Weihe Date: Sept 19, 2003

Type or Print Name: Allan H. Weihe

Business Address: Weihe Engineers, Inc., 10505 N. College Avenue,
Indianapolis, Indiana 46280

Telephone Number: 317-846-6611

SEAL

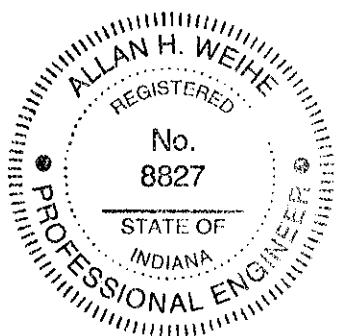

INDIANA REGISTRATION NUMBER

8827



Kenton C. Ward, Surveyor

Phone (317) 776-8495

Fax (317) 776-9628

Suite 188

One Hamilton County Square
Noblesville, Indiana 46060-2230

To: Hamilton County Drainage Board

August 31, 2004

Re: Harmon Clark Drain: South Oak Ind. Park Arm

Attached are as-builts, certificate of completion & compliance, and other information for South Oak Industrial Park Arm. An inspection of the drainage facilities for this section has been made and the facilities were found to be complete and acceptable.

During construction, changes were made to the drain, which will alter the plans submitted with my report for this drain-dated September 19, 2002. The report was approved by the Board at the hearing held October 14, 2002. (See Drainage Board Minutes Book 6, Pages 457-458)

The changes are as follows:

| | | | | | | | |
|-----|--------|--------|----|-----|------|-----|----|
| 705 | 891.56 | 883.56 | | | | | |
| 704 | 887.33 | 881.4 | 36 | 376 | 0.57 | | |
| 704 | 887.33 | 881.4 | | | | | |
| 703 | 888.16 | 880.67 | 36 | 184 | 0.4 | | |
| 703 | 888.16 | 880.67 | | | | | |
| 702 | 885.49 | 877.86 | 36 | 409 | 0.69 | | |
| 702 | 885.49 | 877.86 | | | | | |
| 701 | 886.93 | 876.51 | 42 | 285 | 0.47 | | |
| 701 | 886.93 | 876.51 | | | | | |
| 700 | | 875.98 | 42 | 79 | 0.67 | | |
| 707 | 892.04 | 887.54 | | | | | |
| 706 | 898.67 | 885.67 | 36 | 270 | 0.69 | 279 | -9 |
| 706 | 898.67 | 885.67 | | | | | |
| 705 | 891.56 | 883.56 | 36 | 350 | 0.6 | | |
| 720 | | 875.94 | | | | | |
| 721 | 881.67 | 875.84 | 60 | 31 | 0.32 | | |
| 716 | 887.69 | 881.59 | | | | | |
| 715 | 887.62 | 878.46 | 21 | 29 | 3.34 | | |
| 715 | 887.62 | 878.46 | | | | | |
| 714 | | 876.12 | 21 | 103 | 4.37 | | |
| 719 | 891.69 | 887.25 | | | | | |
| 718 | 891.74 | 886.99 | 30 | 29 | 0.9 | | |
| 718 | 891.74 | 886.99 | | | | | |
| 717 | | 886.74 | 30 | 47 | 0.53 | | |

| | | | | | | | |
|-----|--------|--------|----|----|------|--|--|
| 712 | 884.3 | 878.68 | | | | | |
| 711 | 884.16 | 878.32 | 30 | 29 | 1.24 | | |
| 711 | 884.16 | 878.32 | | | | | |
| 702 | 885.49 | 877.86 | 30 | 33 | 1.39 | | |

6" SSD Streets:

| | |
|---------------|------|
| South Park Dr | 1650 |
| x2 | |

Total: 3300

RCP Pipe Totals:

| | |
|---------------|-------------|
| 21 | 132 |
| 30 | 138 |
| 36 | 1589 |
| 42 | 364 |
| 60 | 31 |
| Total: | <u>2254</u> |

Other Drain:

| | |
|---------------|-------------|
| open ditch | 1730 |
| Total: | <u>1730</u> |

The length of the drain due to the changes described above is now **7284 feet**.

The non-enforcement was approved by the Board at its meeting on September 19, 2002 and recorded under instrument #200300081241.

The following sureties were guaranteed by Irwin Union Bank and released by the Board on its May 24, 2004 meeting.

Bond-LC No: 5003397


Insured For: Storm Sewers

Amount: \$127,000.00

Issue Date: April 9, 2003

I recommend the Board approve the drain's construction as complete and acceptable.

Sincerely,

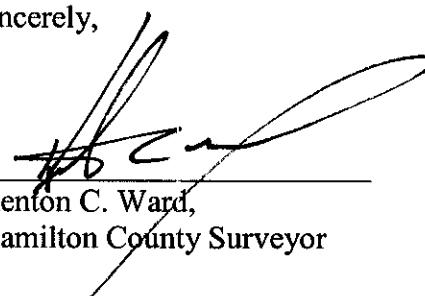
Kenton C. Ward,
Hamilton County Surveyor

KCW/slm

CONSTRUCTION PLANS FOR SOUTH OAK INDUSTRIAL PARK WESTFIELD, IN

INDEX

| SHEET NO. | DESCRIPTION |
|-----------|---------------------------------------|
| 1 | TITLE SHEET |
| 2 | EXISTING CONDITIONS / DEMOLITION PLAN |
| 3 | DEVELOPMENT PLAN |
| 3A | OFFSITE DEVELOPMENT PLAN |
| 4-5 | STREET PLAN & PROFILE SHEETS |
| 6-8 | STORM SEWER PLAN & PROFILE SHEETS |
| 9 | SANITARY SEWER PLAN & PROFILE SHEETS |
| 10 | SANITARY SEWER DETAILS |
| 11 | SANITARY SEWER SPECIFICATIONS |
| 12 | EROSION CONTROL PLAN |
| 13 | EROSION CONTROL PLAN |
| 14 | DETAIL SHEET |
| 15 | DETAIL SHEET - HAMILTON COUNTY |
| 16-17 | SPECIFICATION SHEET |
| 18 | WATER MAIN PLAN |
| 19 | WATER DETAIL SHEET |
| 20 | WATER SPECIFICATION SHEET |

REVISIONS

| SHEET NO. | DESCRIPTION | DATE |
|---------------|---|---------|
| ALL | REVISIONS PER T.A.C. REVIEW | 9/16/02 |
| 3,6-8,9,12,18 | MINOR REVISIONS TO STORM | 10/2/02 |
| ALL | MINOR REVISIONS | 2/17/03 |
| 6,8,14,18 | ADDED CATCH BASIN TO STR. #701, 711, 715, 718. REVISED WESTFIELD'S DETAIL SHEET | 4/16/03 |
| 3,9 | REVISIONS TO SANITARY | 4/28/03 |
| 3,6-8 | STORM SEWER AS-BUILTS | 9/15/03 |
| 3,9 | SANITARY SEWER AS-BUILTS | 2/25/04 |


DESIGN DATA: 8/14/02
 TOTAL ACREAGE - 35.29± ACRES
 NUMBER LOTS - 2
 STREET LENGTH: 1651.65'

| | |
|------------------|---------|
| SOUTH PARK | 1651.65 |
| SOUTH PARK DRIVE | 1651.65 |
| TOTAL LENGTH | 1651.65 |




PER INDIANA STATE LAW - I.C. 36-1-2-1, IT IS
 AGAINST THE LAW TO EXCAVATE WITHOUT
 NOTIFYING THE UNDERGROUND LOCATION SERVICE
 TWO (2) WORKING DAYS BEFORE COMMENCING WORK.

Cat Monday through Friday - AM to 6 PM
 1-800-382-5544 1-800-426-5200
 www.indiana.com/ulsc

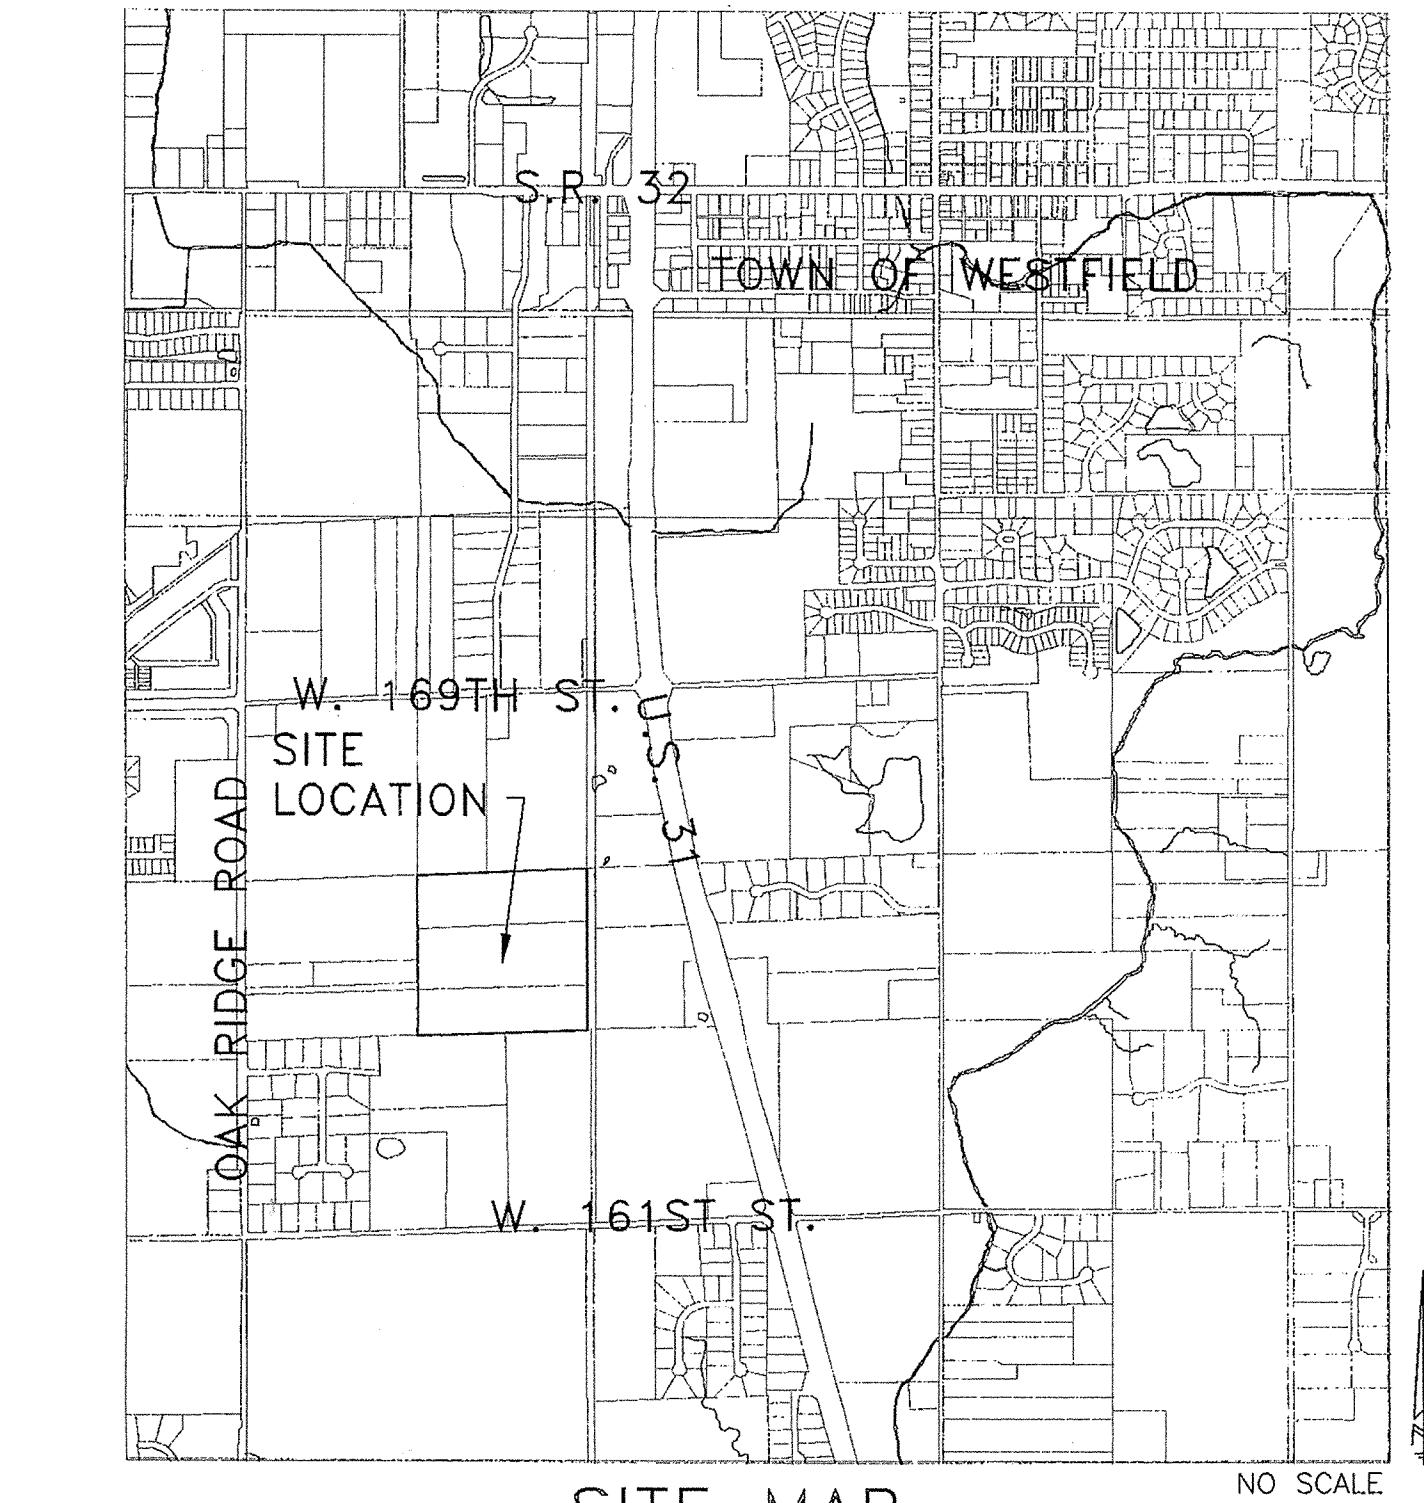


SITE MAP

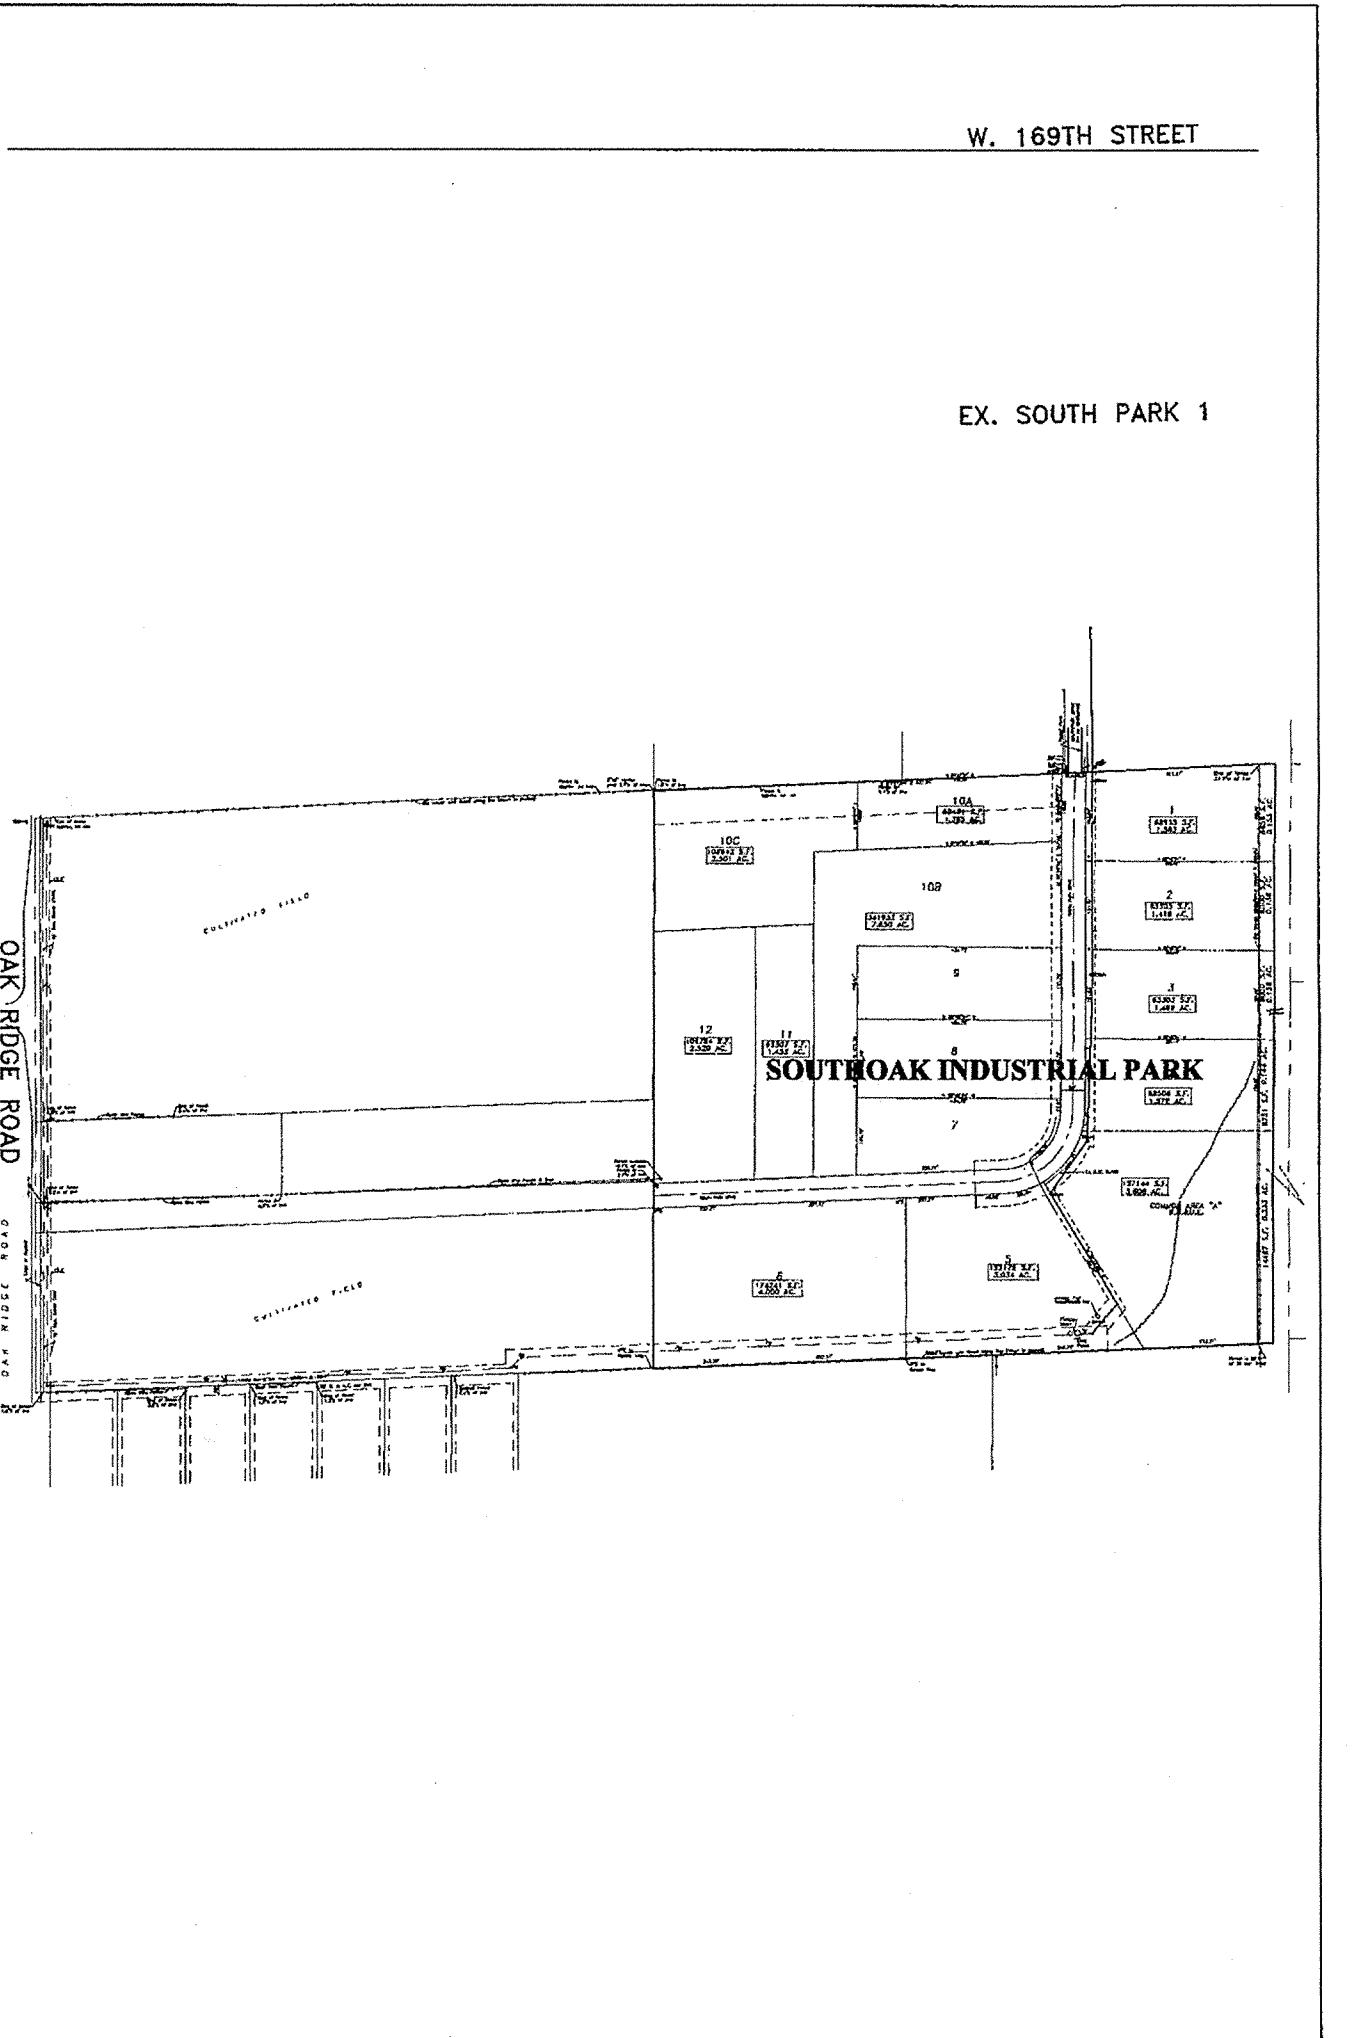

SITE LOCATION MAP

WEIHE ENGINEERS, INC.

10505 NORTH COLLEGE AVENUE
 INDIANAPOLIS, IN 46280
 (317) 845-0546
 TOLL-FREE (800) 452-5468
 ALLAN H. WEIHE, REGISTERED CIVIL ENGINEER
 REGISTERED LAND SURVEYOR
 PRESIDENT
 CIVIL ENGINEERS • LAND SURVEYORS • LAND PLANNERS • LANDSCAPE ARCHITECTS

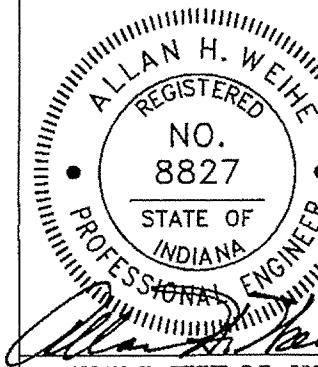

SOUTH OAK INDUSTRIAL PARK

PREPARED FOR:

DALE HINSHAW

12443 Charing Cross Road

Carmel, IN 46032

TELEPHONE: (317) 846-9795

CONTACT PERSON: DALE HINSHAW

PLANS PREPARED BY:

WEIHE ENGINEERS, INC.

10505 N. COLLEGE AVE.

INDIANAPOLIS, IN 46280

TELEPHONE: (317) 846-6611

CONTACT PERSON: MAX MOUSER

FILED

MAR 01 2004

OFFICE OF HAMILTON COUNTY SURVEYOR

TITLE SHEET

DALE HINSHAW

Part of the N.W. 1/4 of Section 18 North, Range 3 East, Township 18 North, Hamilton County, IN

RECORD DRAWING

SANITARY SEWER AS-BUILTS

SANITARY SEWER STRUCTURES ONLY

2/25/04


RECORD DRAWING

STORM SEWER AS-BUILTS

STORM SEWER STRUCTURES ONLY

9/15/03

PROJECT NO. W00-1253

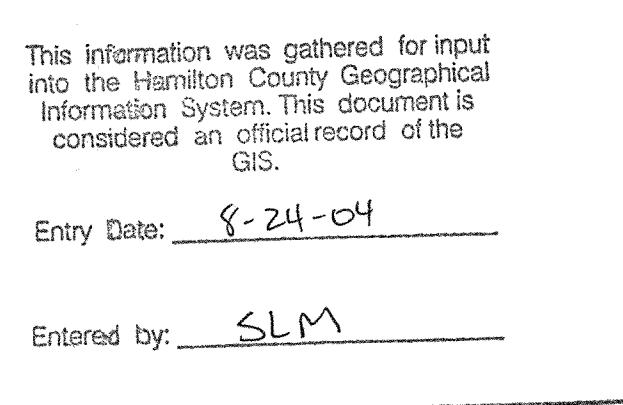

This information was gathered for input
 into the Hamilton County Geographical
 Information System. This document is
 considered an official record of the
 GIS.

Entry Date: 8-24-04

Entered by: SLM

PREPARED FOR:

DALE HINSHAW

Part of the N.W. 1/4 of Section 18 North, Range 3 East, Township 18 North, Hamilton County, IN

RECORD DRAWING

SANITARY SEWER AS-BUILTS

SANITARY SEWER STRUCTURES ONLY

2/25/04

RECORD DRAWING

STORM SEWER AS-BUILTS

STORM SEWER STRUCTURES ONLY

9/15/03

PROJECT NO. W00-1253

WEIHE ENGINEERS, INC.

1050 NORTH COLLEGE AVENUE
INDIANAPOLIS, INDIANA 46280
(317) 946-6611 FAX (317) 843-0546
TOLL FREE (800) 452-0408

1050 NORTH COLLEGE AVENUE
INDIANAPOLIS, INDIANA 46280
(317) 946-6611 FAX (317) 843-0546
TOLL FREE (800) 452-0408

1050 NORTH COLLEGE AVENUE
INDIANAPOLIS, INDIANA 46280
(317) 946-6611 FAX (317) 843-0546
TOLL FREE (800) 452-0408

LEGEND

- = RIGHT-OF-WAY LINE
- - - STORM SEWER LINE
- SWALE
- SANITARY SEWER LINE
- SANITARY SEWER MANHOLE
- SANITARY SEWER LATERAL
- FLOW DIRECTION
- EXISTING SPOT ELEVATION
- PROPOSED ELEVATION
- STORM BEEHIVE INLET
- INVERT
- T.C. TOP OF CASTING
- INV. INVERT
- RCP REINFORCED CONCRETE PIPE
- M.H. MANHOLE
- STR. STRUCTURE
- D. & U.E. DRAINAGE AND UTILITY EASEMENT
- S.D. & U.E. DRAINAGE, UTILITY EASEMENT
- SAN H.C. SANITARY SEWER
- H.C. HANDICAP RAMP
- M.E. MATCH EXISTING GRADE
- STM SUBSURFACE DRAIN
- GRANULAR BACKFILL
- CONCRETE END SECTION
- SUBSURFACE DRAIN
- SANITARY SEWER PIPE (SDR-35)
- S.S.D. TYPICAL
- S.S.P. PROPOSED
- EX. EXISTING
- R. RADIUS

SCALE: 1" = 60'
0 30 60 120

GENERAL NOTES:

- 1) THE CONTRACTOR SHALL BE RESPONSIBLE FOR OBTAINING, OR VERIFYING THAT ALL PERMITS AND APPROVALS ARE OBTAINED FROM THE RESPECTIVE CITY, COUNTY, AND STATE AGENCIES PRIOR TO STARTING CONSTRUCTION.
 - 2) IT SHALL BE THE CONTRACTOR'S RESPONSIBILITY TO DETERMINE THE EXACT LOCATION OF ALL EXISTING UTILITIES IN THE VICINITY OF THE CONSTRUCTION AREA PRIOR TO STARTING CONSTRUCTION.
 - 3) IT SHALL BE THE CONTRACTOR'S RESPONSIBILITY TO NOTIFY AND COORDINATE CONSTRUCTION WITH ALL RESPECTIVE UTILITIES.
 - 4) ALL QUANTITIES GIVEN ON THESE PRINTS, VERBALLY OR IN THE SCOPE OF WORK SECTION ARE ESTIMATES AND SHALL BE CONFIRMED BY THE BIDDING CONTRACTORS.
 - 5) OCCUPATIONAL SAFETY AND HEALTH ADMINISTRATION (OSHA) STANDARDS FOR EXCAVATIONS; FINAL RULE 29 CFR PART 1926, SUBPART "P" APPLIES TO ALL EXCAVATIONS EXCEEDING FIVE (5) FEET IN DEPTH.
 - 6) IN ADDITION, EXCAVATIONS EXCEEDING TWENTY (20) FEET IN DEPTH REQUIRE THE DESIGN OF A TRENCH SAFETY SYSTEM BY A REGISTERED PROFESSIONAL ENGINEER.
 - 7) IT SHALL BE THE RESPONSIBILITY OF THE DEVELOPER AND CONTRACTOR TO MAINTAIN QUALITY CONTROL THROUGHOUT THIS PROJECT.
 - 8) TEMPORARY TRAFFIC CONTROL DURING CONSTRUCTION TO CONFORM TO APPLICABLE LOCAL STANDARDS.
 - 9) BEARINGS, DIMENSIONS, AND EASEMENTS ARE SHOWN FOR REFERENCE ONLY. SEE RECORD SURVEYS AND PLATS FOR EXACT INFORMATION.
 - 10) STANDARD BARRICADE TYPE IV IS TO BE PLACED AT ALL STUB STREETS.
 - 11) ALL SANITARY MANHOLES IN NON-PAVED AREAS SHALL BE 3' ABOVE GRADE.
 - 12) ANY PRIVATE FIELD TILES FOUND ON THE SITE ARE TO BE OUTLETTED INTO AN ACCEPTABLE OUTLET.
 - 13) HARMON CLARK DRAIN TO BE CRUSHED AND DESTROYED ACROSS PROPOSED SOUTH PARK 2 AND NO WORK TO OCCUR WITHIN EXISTING REGULATED DRAIN EASEMENT UNTIL PLANS ARE APPROVED AND THE HEARING IS HELD BEFORE HAMILTON COUNTY DRAINAGE BOARD.
- NOTES:
- 1) CURB UNDERDRAINS (PER D.O.T. STANDARD DETAIL 30-30) WILL BE INSTALLED THROUGHOUT THIS ENTIRE PROJECT.
 - 2) 2' ROLLED CURB & GUTTER "TYPE I" SHALL BE INSTALLED THROUGHOUT ENTIRE PROJECT AS SHOWN UNLESS NOTED OTHERWISE.
 - 3) CONTRACTOR TO DESIGNATE SANITARY LATERAL ENDS WITH A WOODEN 2x4" STAKE, PAINTED BRIGHT GREEN.
 - 4) 13.5 ACRES COMING ONTO SOUTH PARK TWO DEVELOPMENT SHALL BE CONNECTED INTO THE PROPOSED DRAINAGE SYSTEM IN ORDER TO MAINTAIN POSITIVE DRAINAGE.
 - 5) THE LOWEST FLOOR ELEVATION RECEIVING GRAVITY SERVICE MUST BE A MINIMUM OF ONE FOOT ABOVE THE TOP OF CASTING OF THE NEAREST SANITARY MANHOLE, OR A GRINDER PUMP SHALL BE REQUIRED.

OFFSITE WATERSHED

STRUCTURE DATA TABLE

| STRUCTURE NO. | TC/RIM ELEV. | INV. IN | INV. OUT | DEPTH | STR. SIZE | STR. TYPE | CASTING TYPE | Pipe Size | DIRECTION OF PIPE IN/OUT |
|---------------|--------------|---------|----------|--------|-----------|-----------|---|-----------|--|
| 700 | NONE | E86-00 | 875.98 | 876.00 | 875.98 | N/A | C.E.S. | N/A | N/S |
| 701 | 886-00 | 886.93 | E86-46 | 876.51 | 5.57' | 72" | MANHOLE SOLID (R-1772) | 42" | N/S |
| 702 | 885-20 | 885.49 | E86-13 | 877.86 | 7.20' | 72" | MANHOLE SOLID (R-1772) | 42" | N/S |
| 703 | 884-00 | 888.16 | E86-53 | 880.67 | 8.00' | 72" | MANHOLE SOLID (R-1772) | 42" | W/E |
| 704 | 887-00 | 887.33 | E86-51 | 881.41 | 3.22' | 72" | MANHOLE BEEHIVE (R-4342) | 36" | W/E |
| 705 | 889-20 | 891.56 | E88-51 | 883.56 | 8.00' | 72" | MANHOLE BEEHIVE (R-4342) | 36" | W/E |
| 706 | 888-00 | 898.67 | E85-05 | 885.67 | 8.00' | 72" | MANHOLE SOLID (R-1772) | 36" | S/E |
| 707 | 891-50 | 892.04 | N/A | 887.50 | 887.54 | 1.17' | 4x4" Box Inlet w/ 6" Throat Openings - See Detail | 36" | N |
| 711 | 884-40 | 884.16 | E86-35 | 878.32 | 876.38 | 878.32 | 3x3" | 60" | MANHOLE CURB (R-3501-R) |
| 712 | 884-40 | 884.30 | N/A | 878.49 | 878.68 | 1.01' | 3.19' | 60" | MANHOLE CURB (R-3501-R) |
| 714 | NONE | E87-00 | 876.12 | 876.00 | 876.12 | N/A | C.E.S. | N/A | 21" |
| 715 | 887-71 | 887.62 | E88-62 | 880.62 | 887.45 | 880.62 | 5.22" | 48" | MANHOLE CURB (R-3501-R) |
| 716 | 887-71 | 887.69 | E88-71 | 881.59 | 881.71 | 881.59 | 3.74" | 41.12" | 36"x36" INLET CURB (R-3501-R) |
| 717 | NONE | E88-00 | 886.74 | E88-10 | 886.74 | N/A | C.E.S. | N/A | 30" |
| 718 | 889-79 | 891.73 | E88-14 | 886.99 | 887.14 | 886.99 | 1.86" | 60" | MANHOLE CURB (R-3501-R) |
| 719 | 889-79 | 891.69 | E88-23 | 887.25 | 887.29 | 887.25 | 1.74" | 1.65" | 60" |
| 720 | NONE | E85-00 | 875.94 | 875.65 | 875.94 | N/A | C.E.S. | N/A | 60" |
| 721 | 881-50 | 881.67 | E84-00 | 875.84 | 876.00 | 875.84 | 0 | 72"x72" | NOTE: DEPTH = 1/4" (INV. + Dia. + Thickness) |

SANITARY SEWER STRUCTURE TABLE

| STRUCTURE NUMBER | TOP OF CASTING | INVERT (IN) | INVERT (OUT) |
|------------------|----------------|-------------|---------------------------|
| EX. 901 | 889-30 | 888.86 | 873.71 (NE,W) 873.24 (SE) |
| 902 | 889-60 | 889.78 | 874-88 874.52 |
| 903 | 893-60 | 893.57 | 876-76 876.86 |
| 904 | 896-50 | 896.39 | 878-05 878.27 |

SANITARY SEWER NOTES:

- 1) THIS PLAN IS INDICATING SANITARY SEWER LATERALS TO STOP NO CLOSER THAN 10 FEET FROM THE BUILDING LINE. AT NO TIME SHALL THE CONTRACTOR EXCAVATE PAST THE BUILDING LINE DURING INSTALLATION OF ANY UTILITIES. IF EXCAVATION IS REQUIRED PAST THE BUILDING LINE, MATERIAL SHALL BE REPLACED AND COMPACTED TO THE SAME PASTING POINT AS PROVIDED. SANITARY SEWER LATERALS ARE TO BE SETTING WITHIN THE BUILDABLE AREA OF ALL LOTS. SANITARY LATERALS ARE TO BE INSTALLED AT NO GREATER THAN 45 DEGREE ANGLE COMING FROM THE MAIN.
- 2) ALL DROP STRUCTURES MUST BE AN OUTSIDE DROP. INSIDE DROP STRUCTURES ARE NOT ALLOWED.

FILED

MAR 8 2004

OFFICE OF HAMILTON COUNTY SURVEYOR

DALE HINSHAW

PREFEDED FOR:

Part of the N.W. 1/4 of Section 12, Township 18 North, Range 3 East, Hamilton County, Indiana

3

RECORD DRAWING

SANITARY SEWER AS-BUILTS
SANITARY SEWER STRUCTURES ONLY

2/25/04

RECORD DRAWING

STORM SEWER AS-BUILTS
STORM SEWER STRUCTURES ONLY

9/15/03

3

PROJECT NO.
W00-1253

WEIHE ENGINEERS, INC.

1005 NORTH COLLEGE AVENUE
INDIANAPOLIS, INDIANA 46280
(317) 946-6611 FAX (317) 843-0546

ALLAN H. WEIHE
REGISTERED CIVIL ENGINEER
REGISTERED LAND SURVEYOR
PRESIDENT

CIVIL ENGINEERS * LAND SURVEYORS * LAND PLANNERS * LANDSCAPE ARCHITECTS

SOUTH OAK INDUSTRIAL PARK

DALE HINSHAW

STORM PLAN & PROFILE SHEET

PREPARED FOR:

RECORD DRAWING

STORM SEWER AS-BUILTS

STORM SEWER STRUCTURES ONLY

9/15/03

PROJECT NO.

W00-1253

FILED

MAR 6 2004

6

6




6

6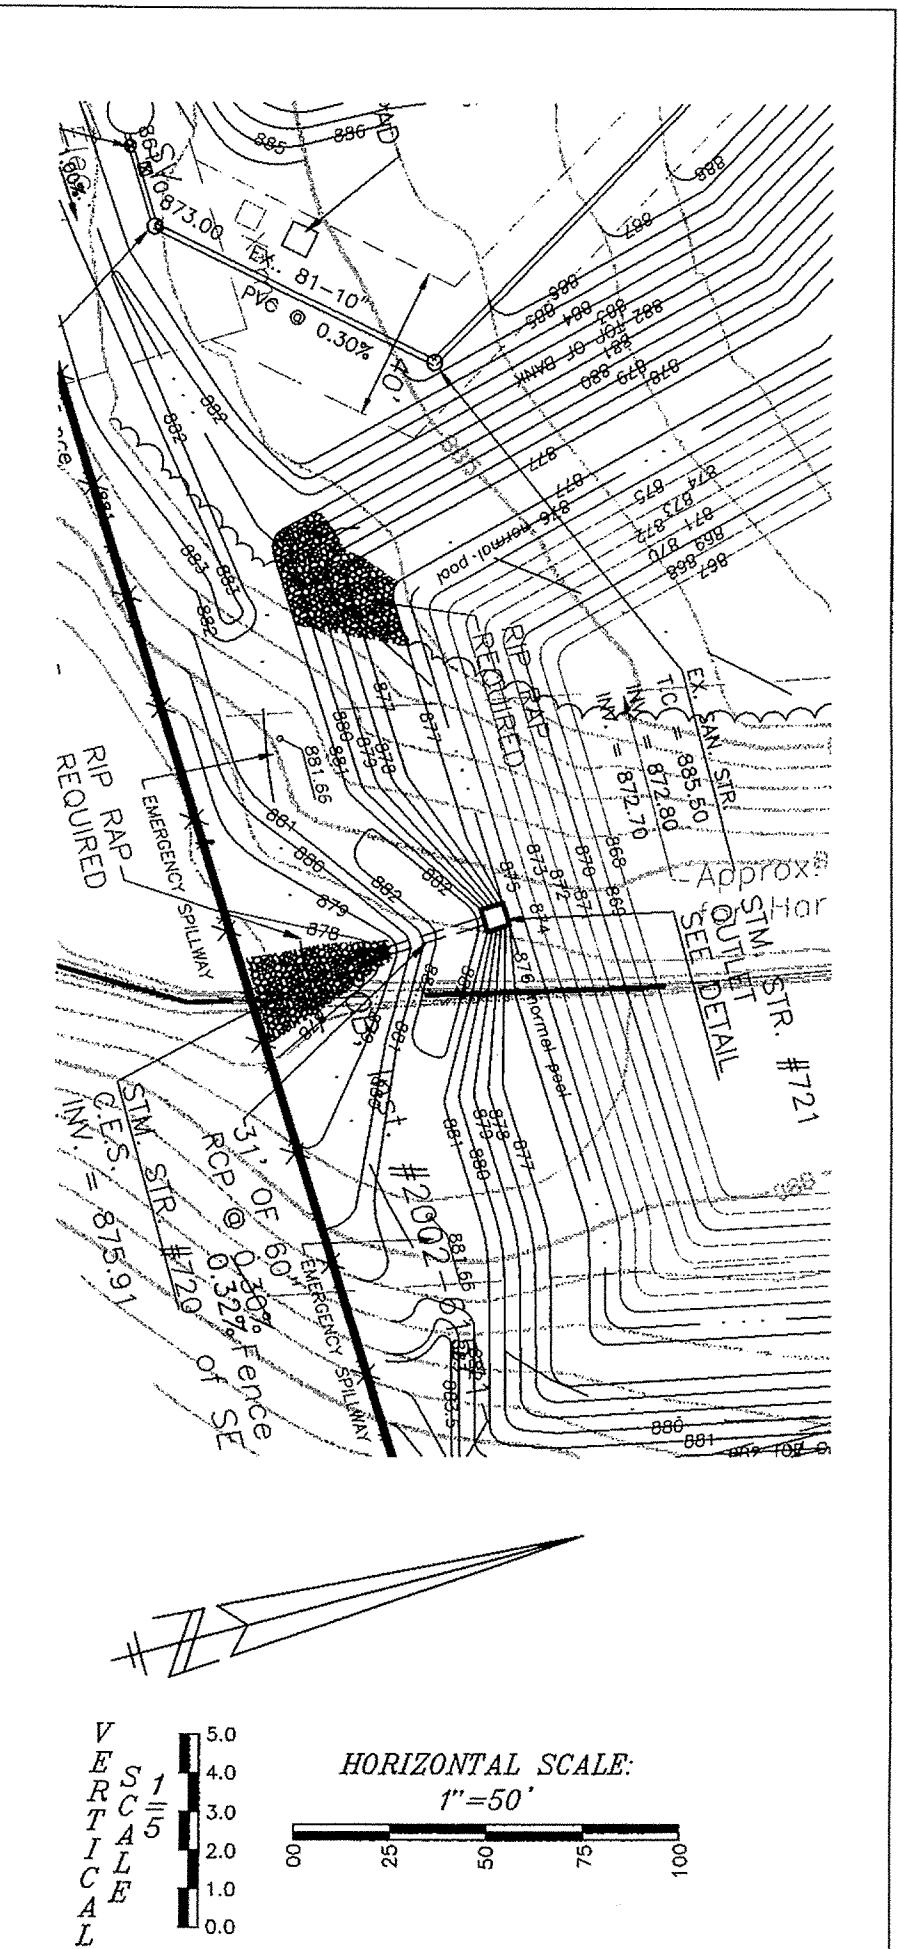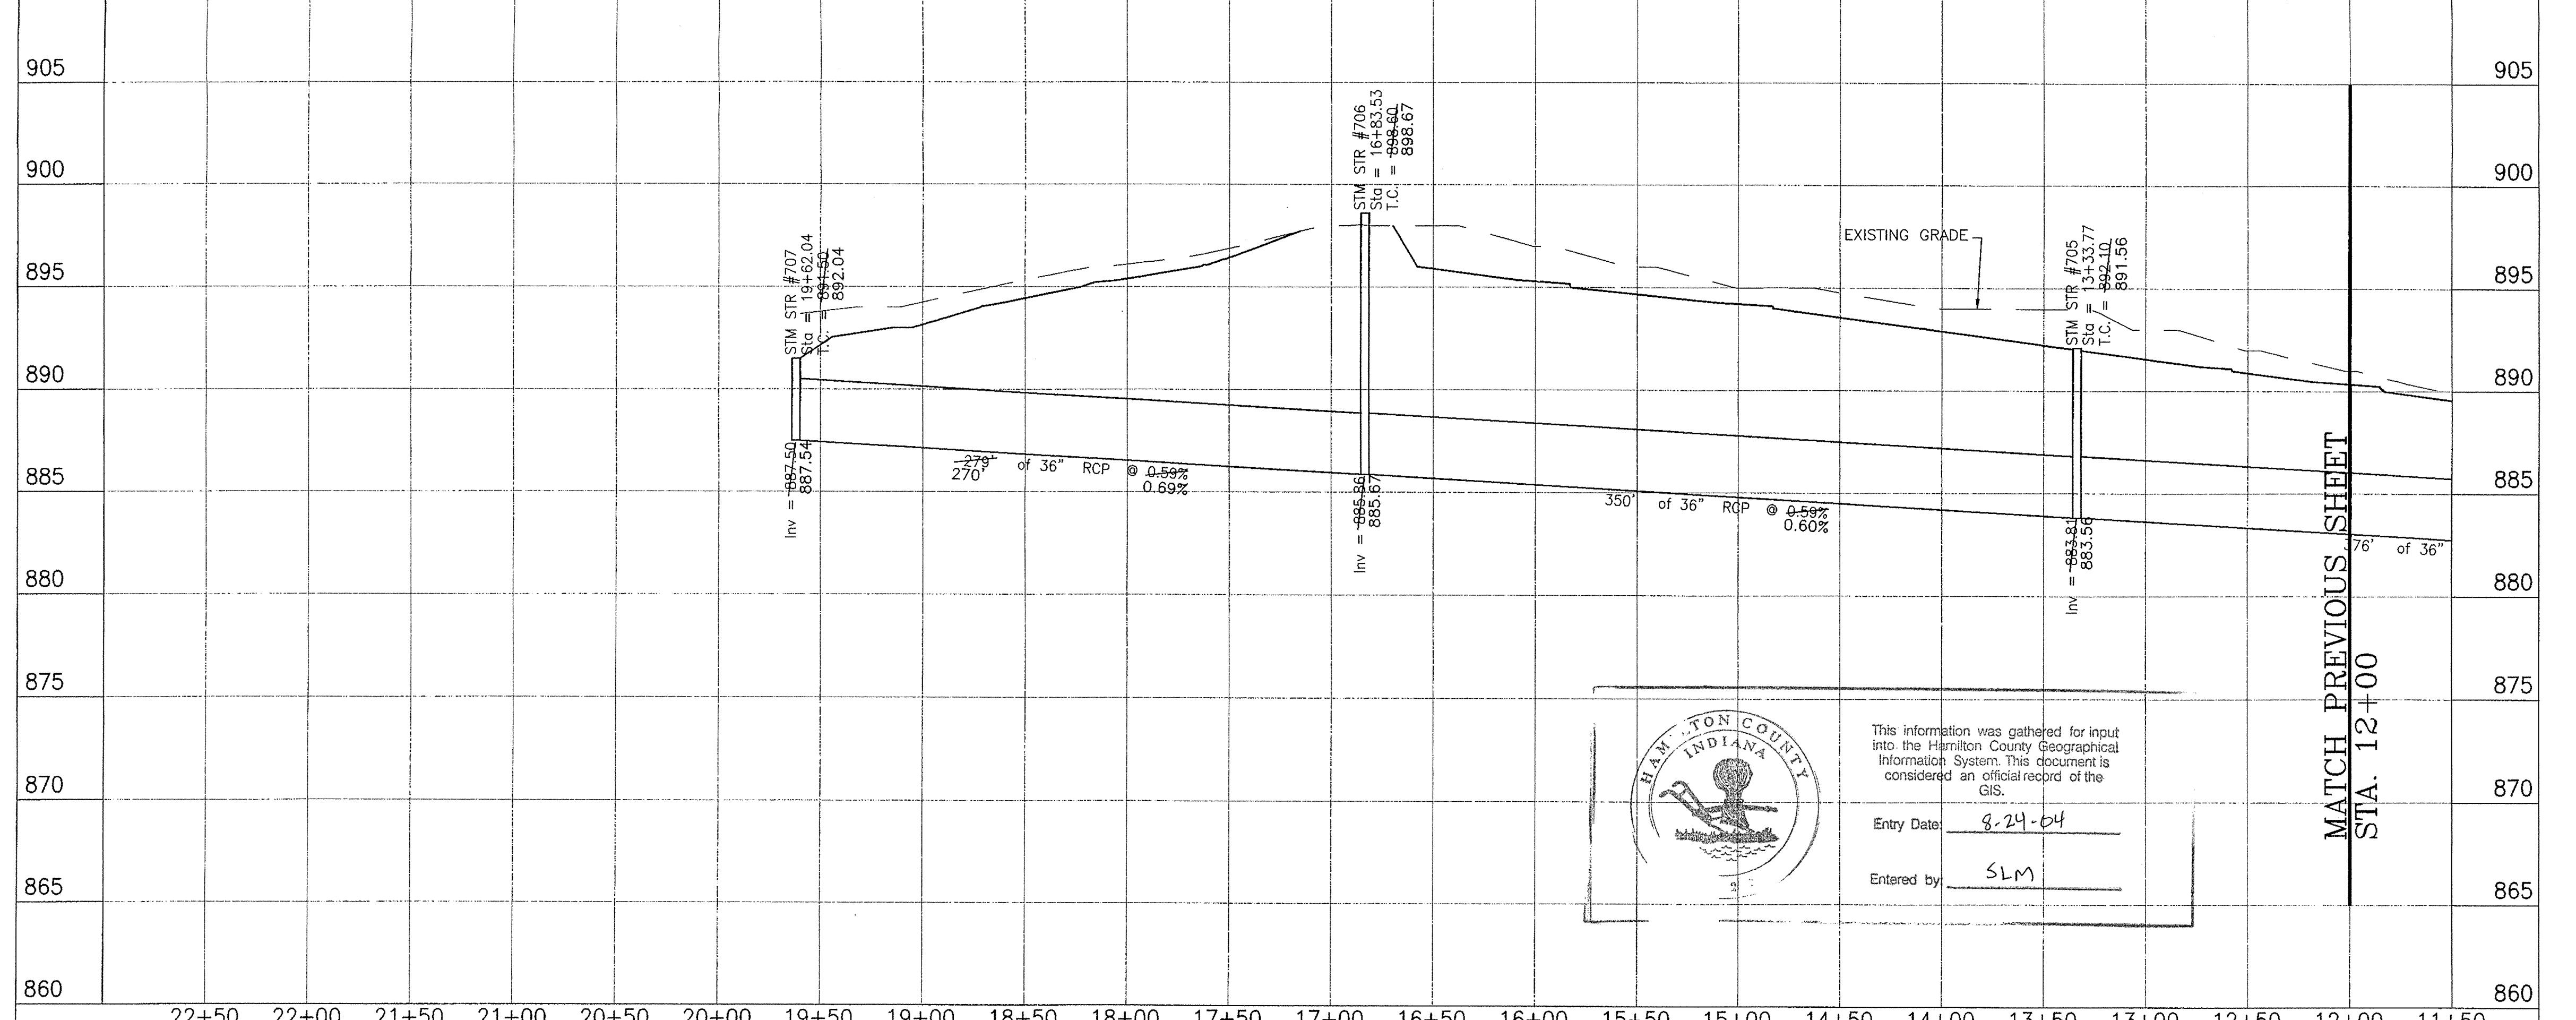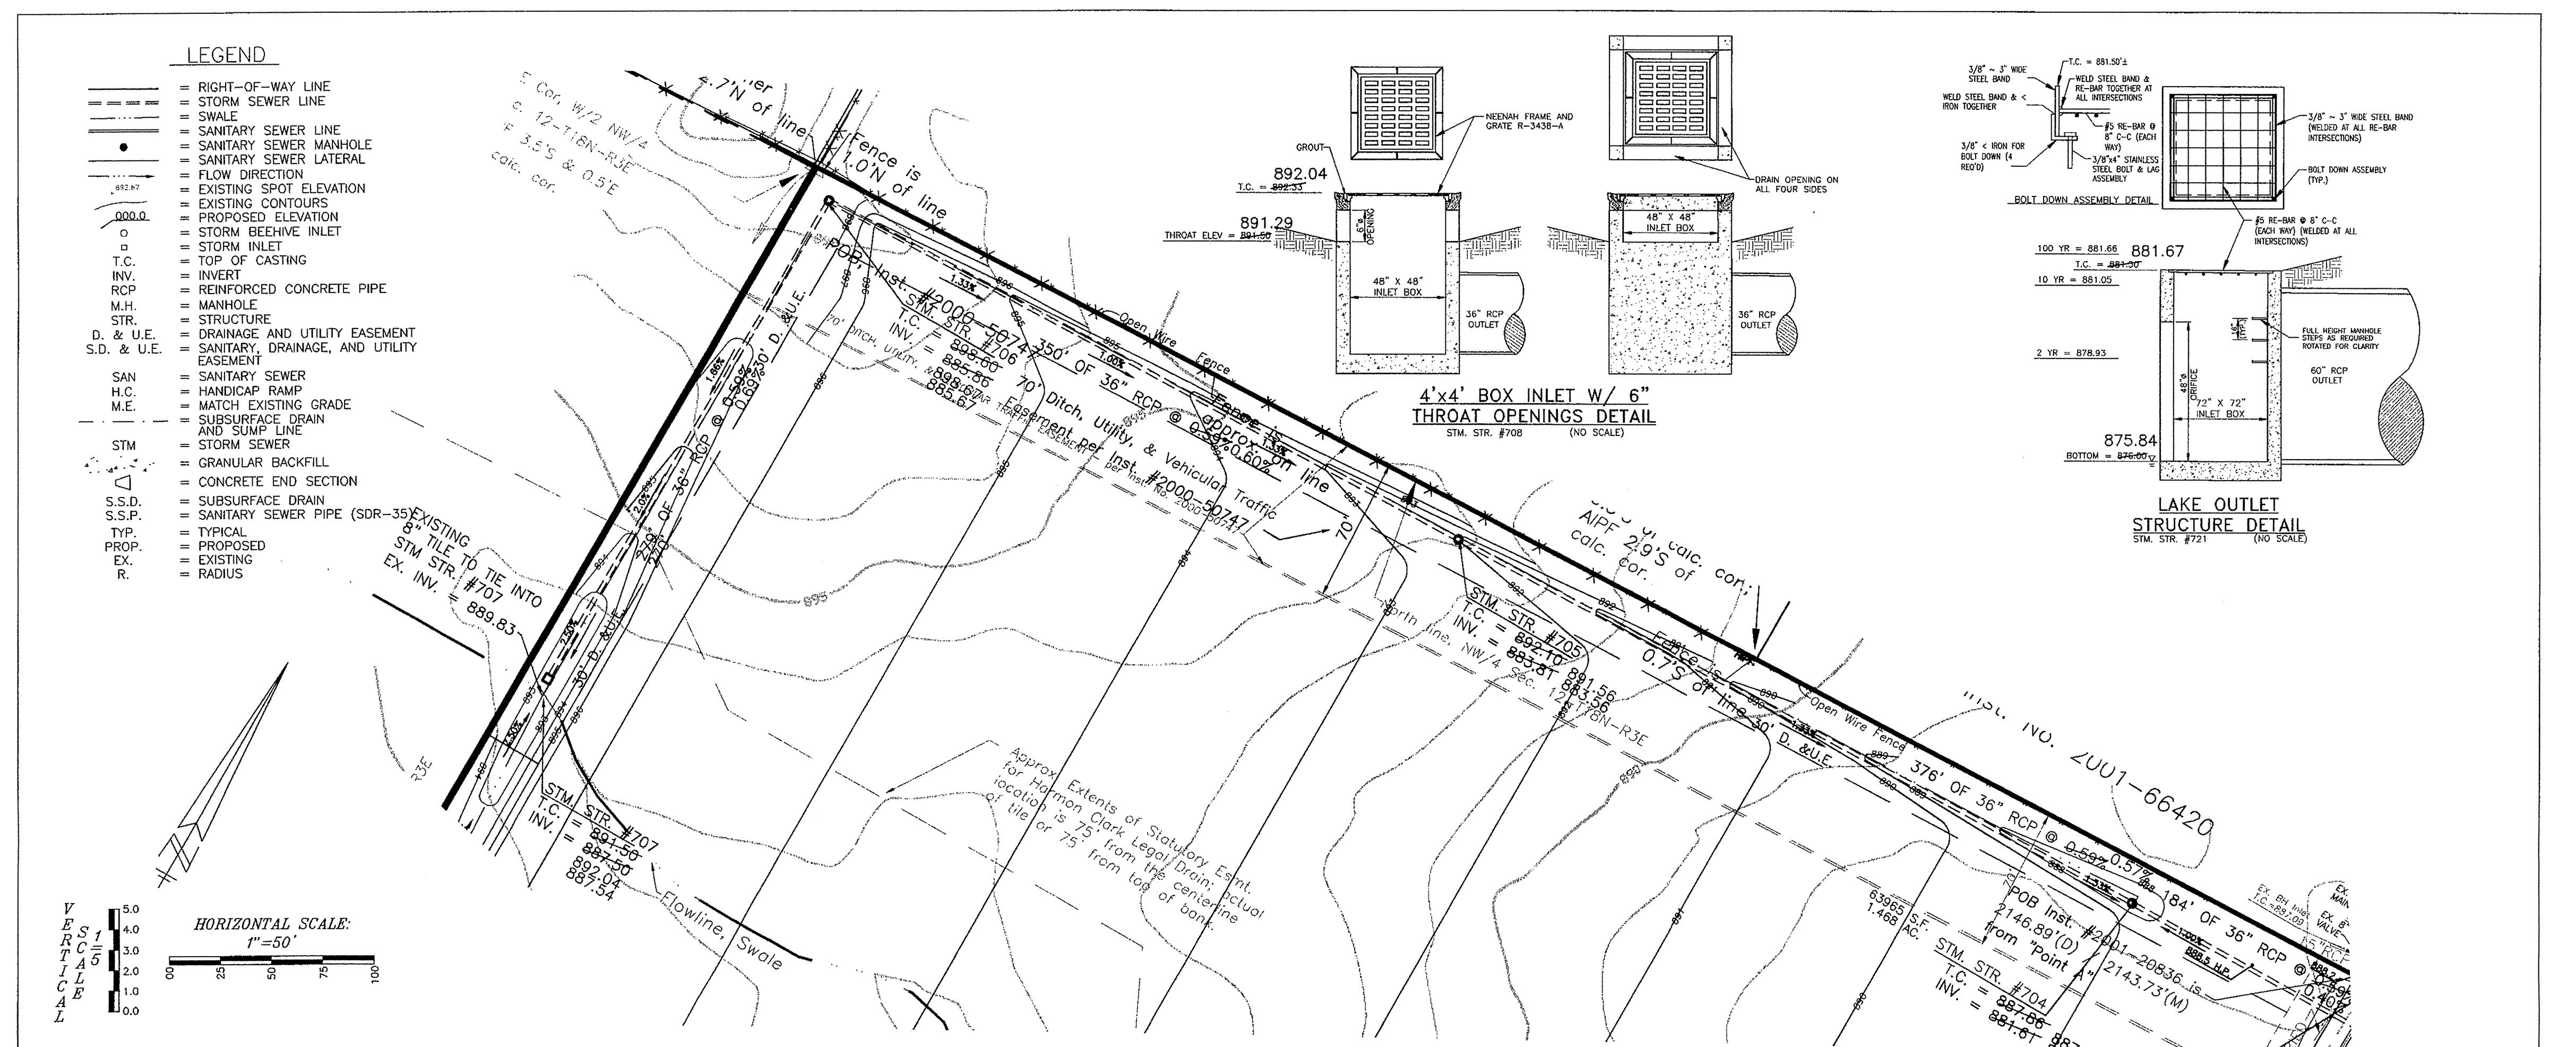

DALE HINSHAW
Part of the NW 1/4 of Section 12, Township 18 North, Range 3 East, Madison Township, Hamilton County, Indiana

PREPARED FOR:

SOUTH OAK INDUSTRIAL PARK

STORM PLAN & PROFILE SHEET

SHEET NO.


7


PROJECT NO.

W00-1253

WEIHE ENGINEERS, INC.
1655 NORTHERN COLLEGE AVENUE
INDIANAPOLIS, INDIANA 46256
TEL: (317) 842-5466
TOLL FREE: (800) 452-5466

ALLAN H. WEIHE
REGISTERED CIVIL ENGINEER
REGISTERED LAND SURVEYOR
PRESIDENT
CIVIL ENGINEERS • LAND SURVEYORS • LAND PLANNERS • LANDSCAPE ARCHITECTS

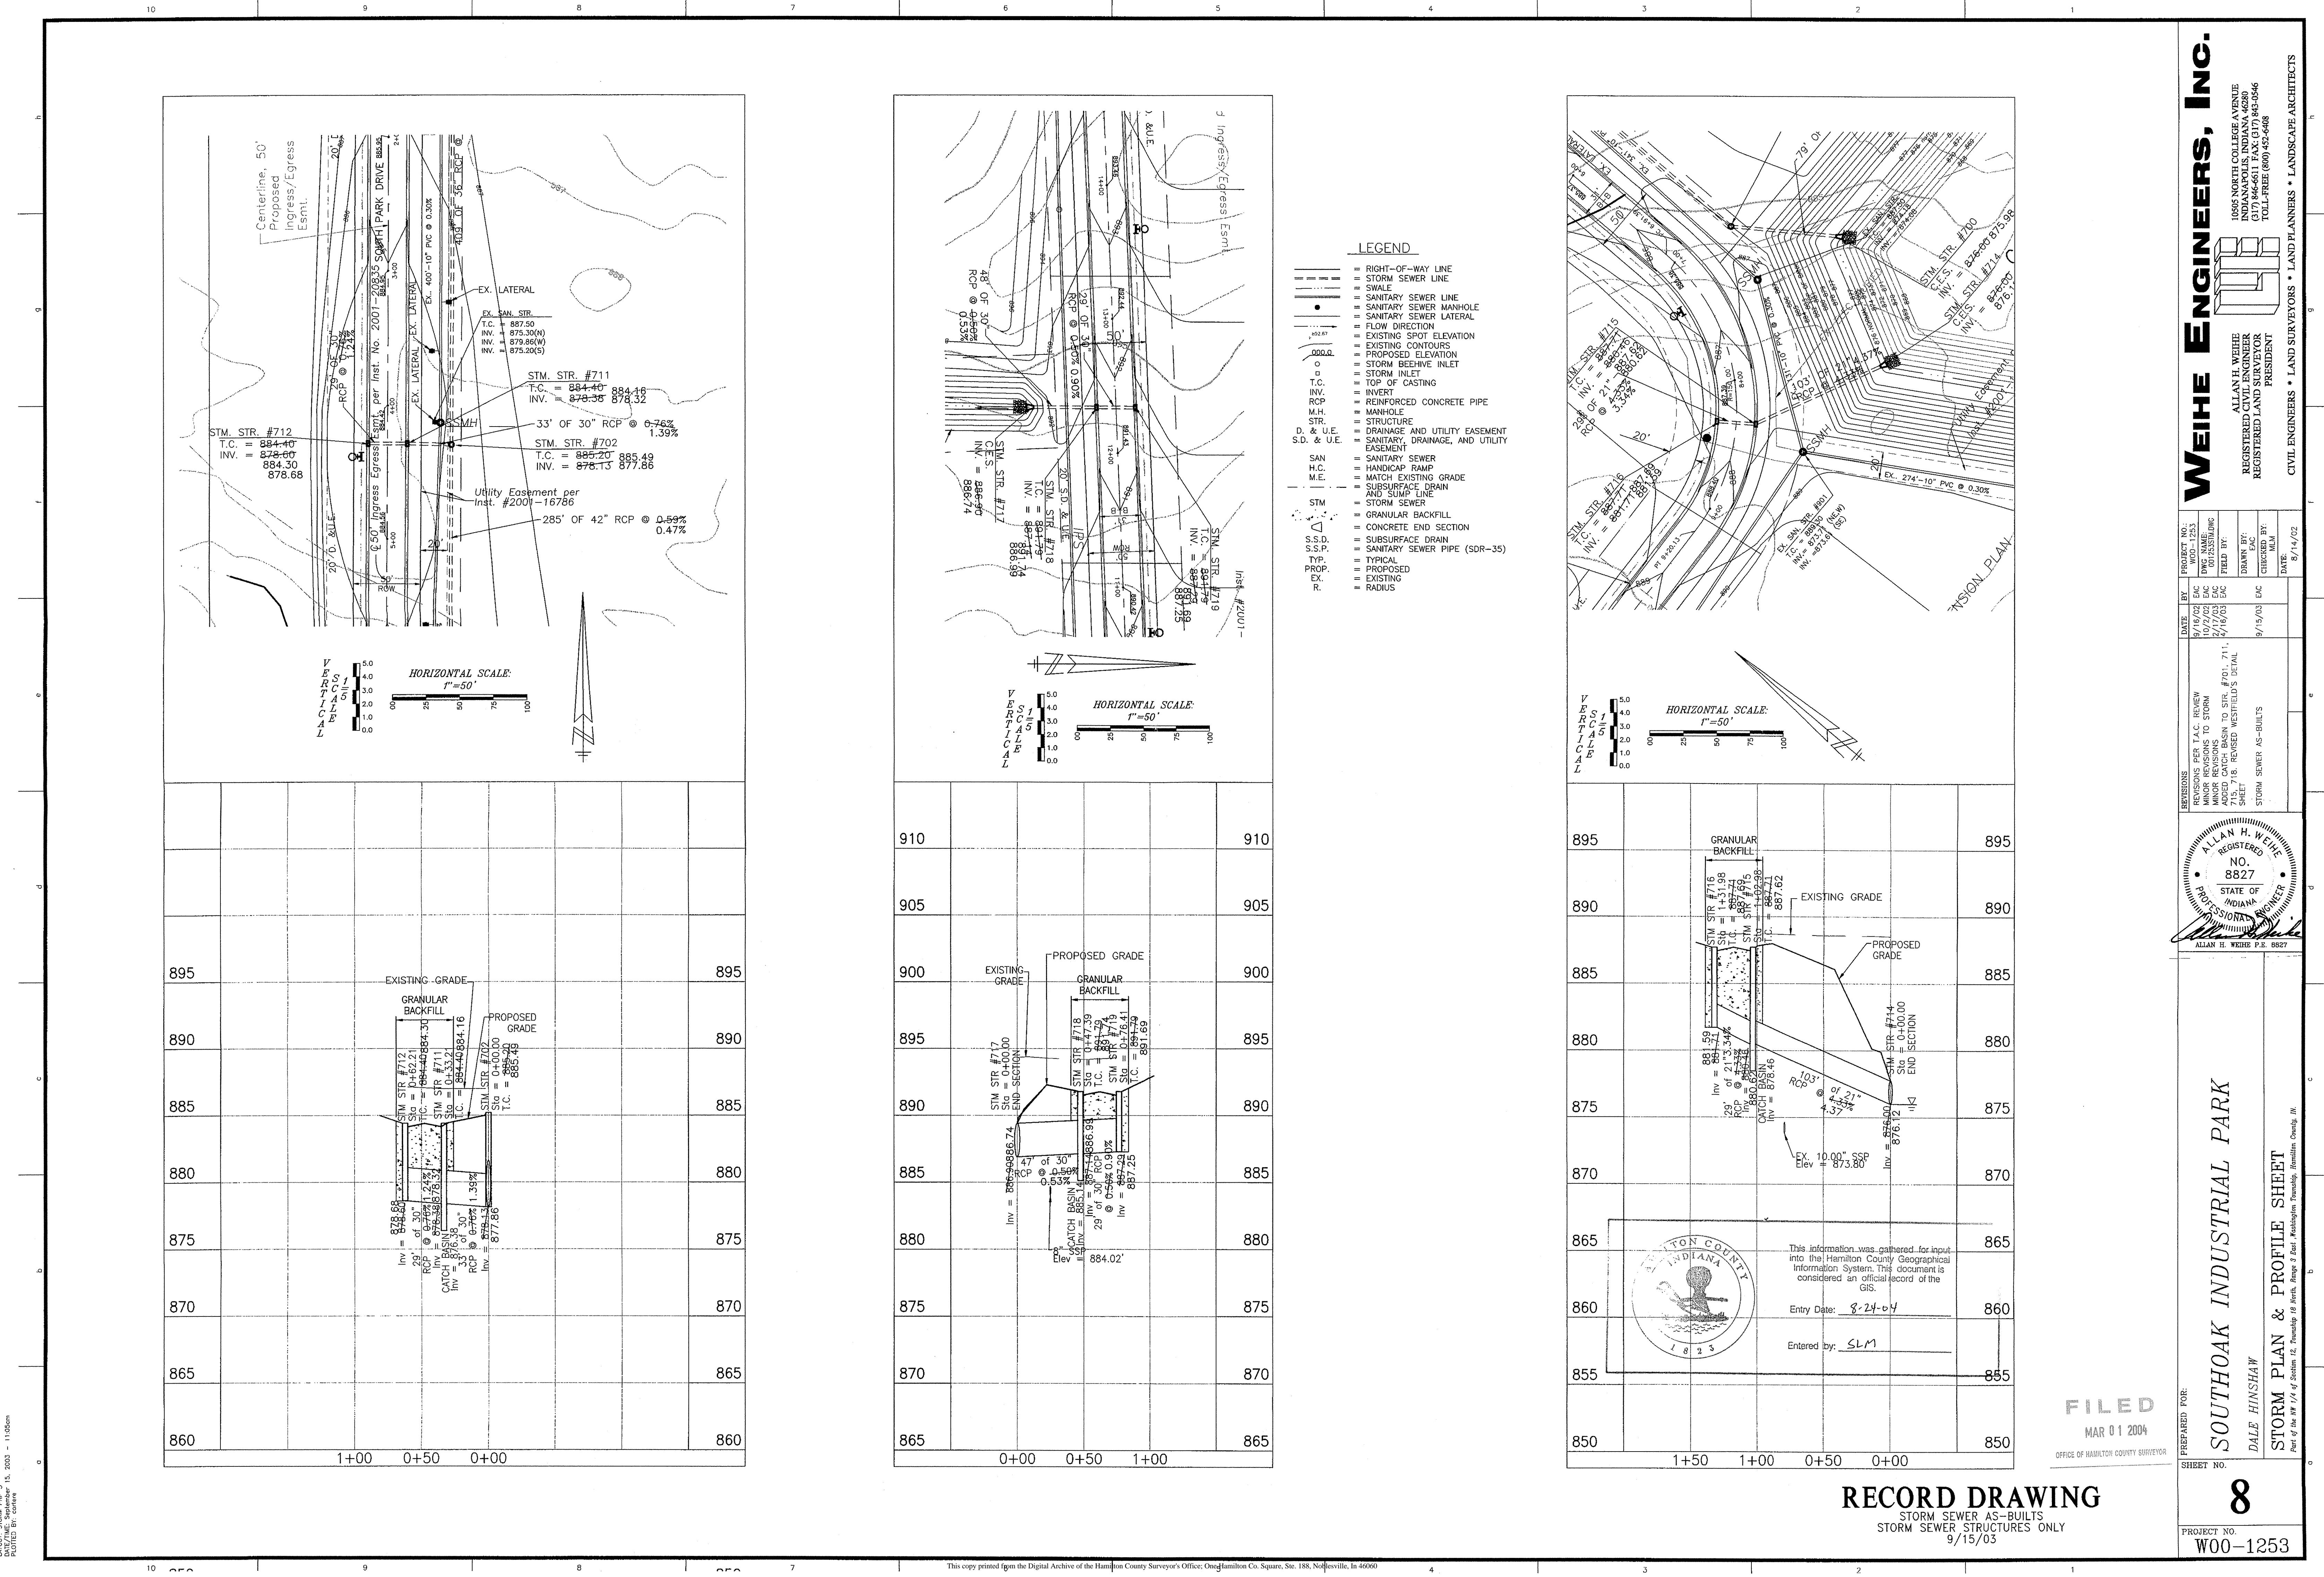

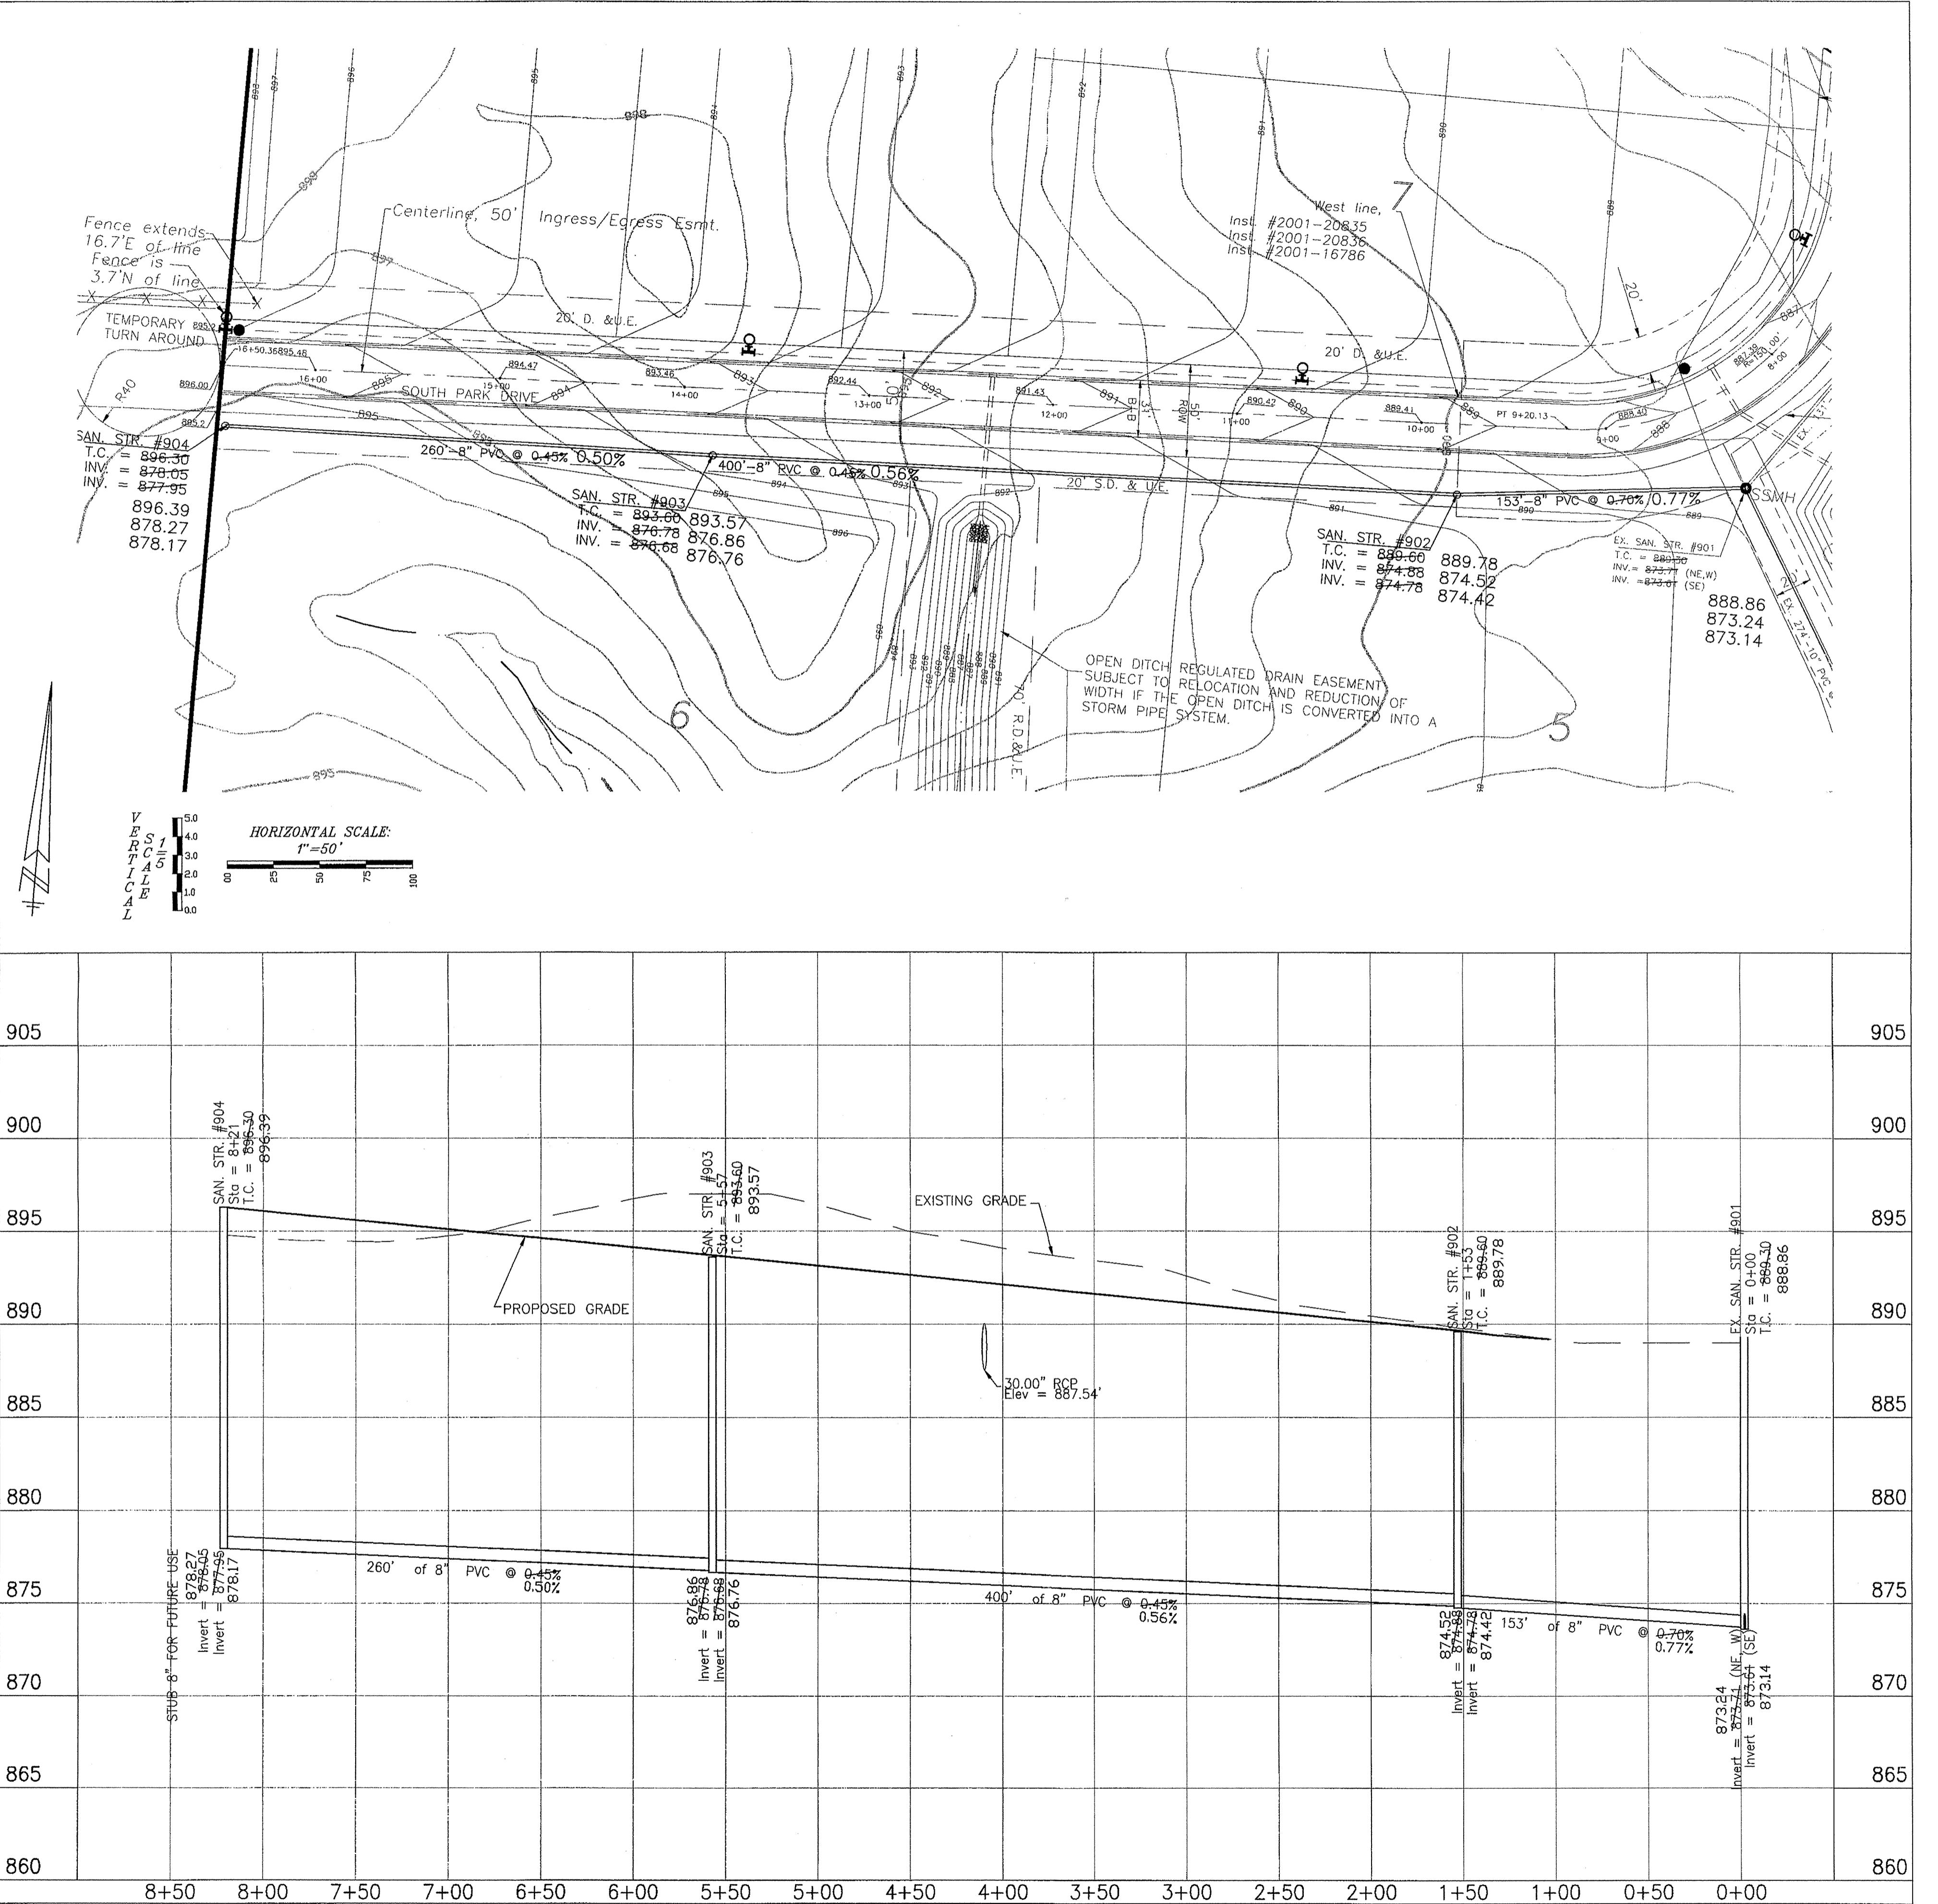

This information was gathered for input into the Hamilton County Geographical Information System. This document is considered an official record of the GIS.
Entry Date: 8-24-04

Entered by: SLM

FILED
MAR 01 2004
OFFICE OF HAMILTON COUNTY SURVEYOR

DALE HINSHAW
Part of the 1/4 of Section 12, Township 8 North, Range 3 East, Madison Township, Hamilton County, IN

RECORD DRAWING
SANITARY SEWER AS-BUILTS
SANITARY SEWER STRUCTURES ONLY
2/25/04

9
PROJECT NO.
W00-1253

| | | |
|-----------------------------|---------|-----|
| REVISIONS | DATE | BY |
| REVISIONS PER T.A.C. REVIEW | 9/18/02 | EAC |
| MINOR REVISIONS TO STORM | 10/2/02 | EAC |
| MINOR REVISIONS | 2/17/03 | EAC |
| FIELD BY: | | |
| REVISIONS TO SANITARY | 4/28/03 | EAC |
| SANITARY SEWER AS-BUILTS | 2/25/04 | EAC |
| CHECKED BY: | | |
| DATE: 8/14/02 | | |

ALLAN H. WEIHE
REGISTERED PROFESSIONAL ENGINEER
NO. 8827
STATE OF INDIANA
ALLAN H. WEIHE P.E. 8827