

Kenton C. Ward, CFM
Surveyor of Hamilton County
Phone (317) 776-8495
Fax (317) 776-9628

Suite 188
One Hamilton County Square
Noblesville, Indiana 46060-2230

Map Correction-Field Verification

Drain Number: #345 Cool Creek

Drain Length: 1700

Drain Name: Oak Woods

Change + / - : 40

Date: 07-27-2016


New Length: 1740

Verified By: SAB, SLM

Notes & Sketch: WO-2016-00216

Tile was located and mapped with GPS. Risers were also set. See attached map for corrected location. The corrected map should now reflect 841 feet of 6" plastic, 530 feet of 8" plastic and 369 feet of open ditch.

Suzanne L. Mills
GIS Specialist

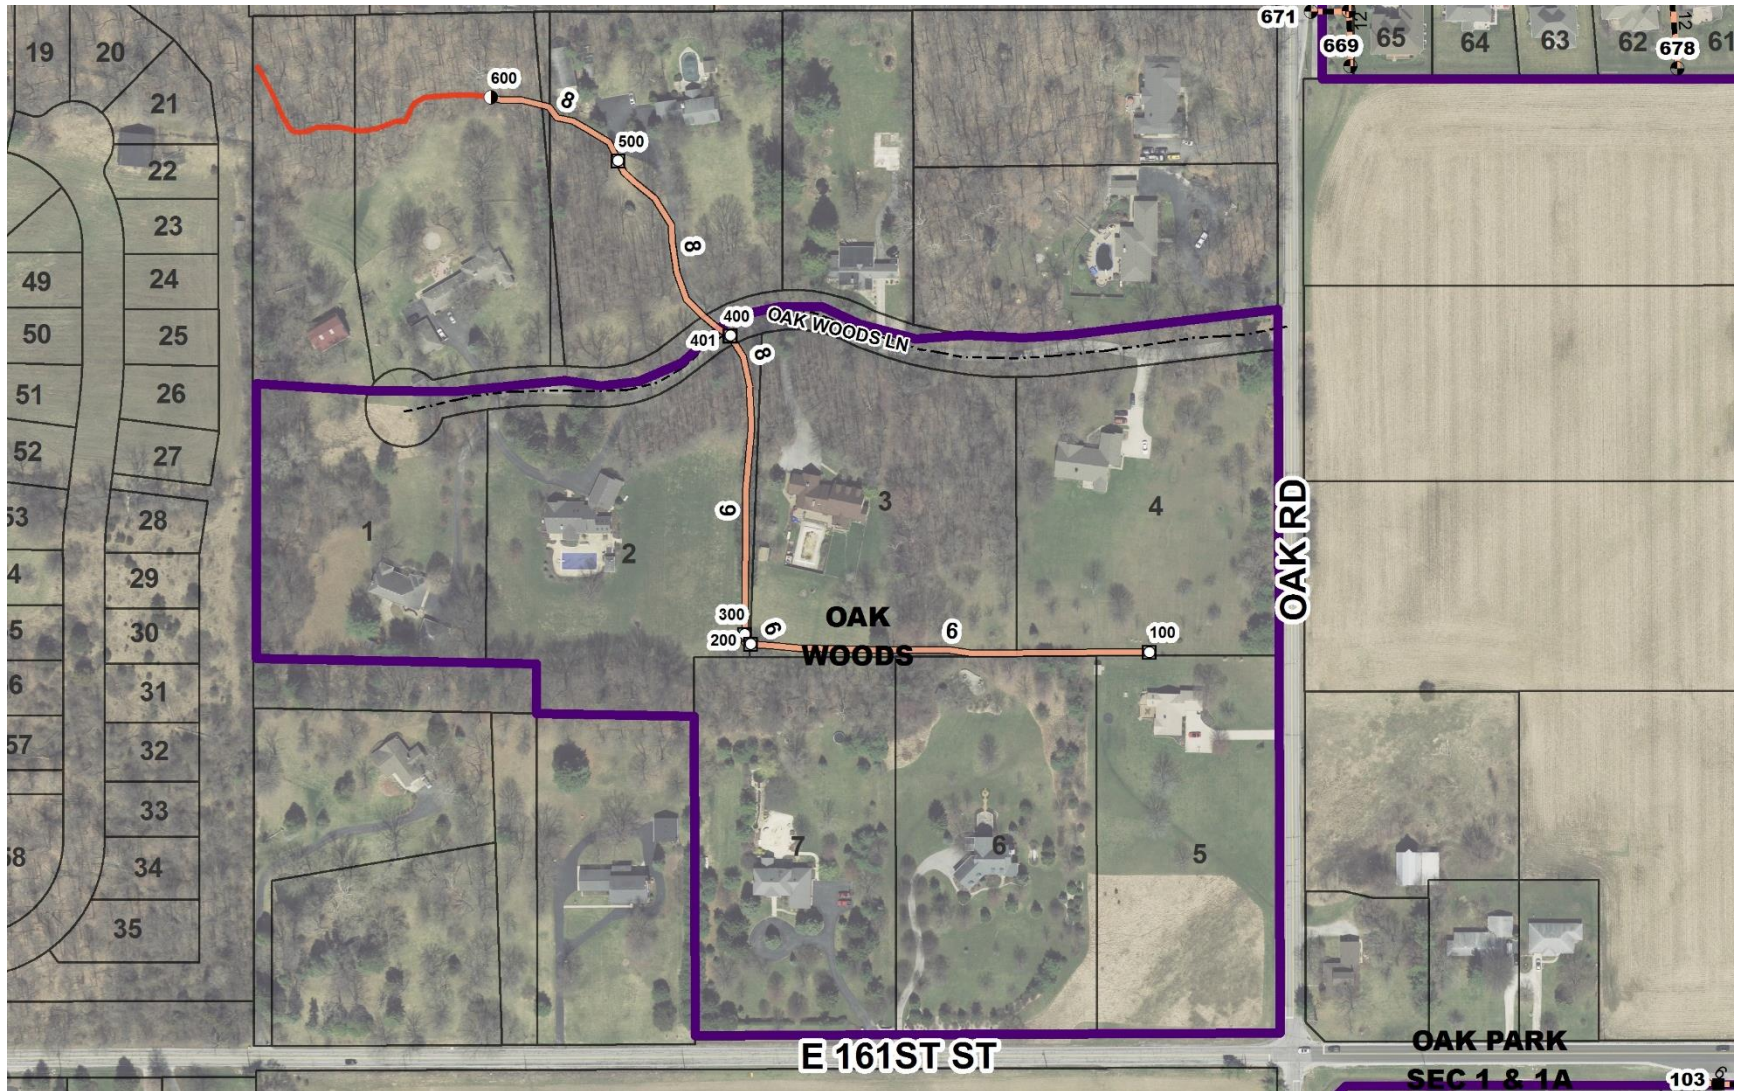

This map was compiled by the Hamilton County Surveyor's Office. Although strict accuracy standards have been employed in the compilation of this map, Hamilton County does not warrant or guarantee the accuracy of the information contained herein and disclaims any and all liability resulting from any error or omission in this map.

COOL CREEK DRAIN Oak woods Arm

Printing Date: 07/27/2016
 Prepared By: Suzanne Mills, GISP
 Hamilton County Surveyor's Office
 One Hamilton County Square, Ste 188
 Noblesville, IN 46060
 317-776-8495

