

Kenton C. Ward, CFM
Surveyor of Hamilton County
Phone (317) 776-8495
Fax (317) 776-9628

Suite 188
One Hamilton County Square
Noblesville, Indiana 46060-2230

Map Correction-Field Verification

Drain Number: 345

Drain Length: 3152

Drain Name: Springmill Crossing Sec. 6

Change +/- : 2

Date: 07-09-2013


New Length: 3154

Verified By: SAB, GRH

Notes & Sketch:

It was noted that our maps did not reflect the change of drain completed with WO-98-216. This work was completed based upon a directive by the Drainage Board to vacate the existing SSD across the rear lots of 239-243. (DRB 4, PG 562-563) The SSD then was relocated towards the pipeline 20 feet and blind tapped into the pipe outleting from existing structure 427. Therefore, 674 feet of 6" SSD was relocated with 676 feet of 6" PVC.

Suzanne L. Mills
GIS Specialist

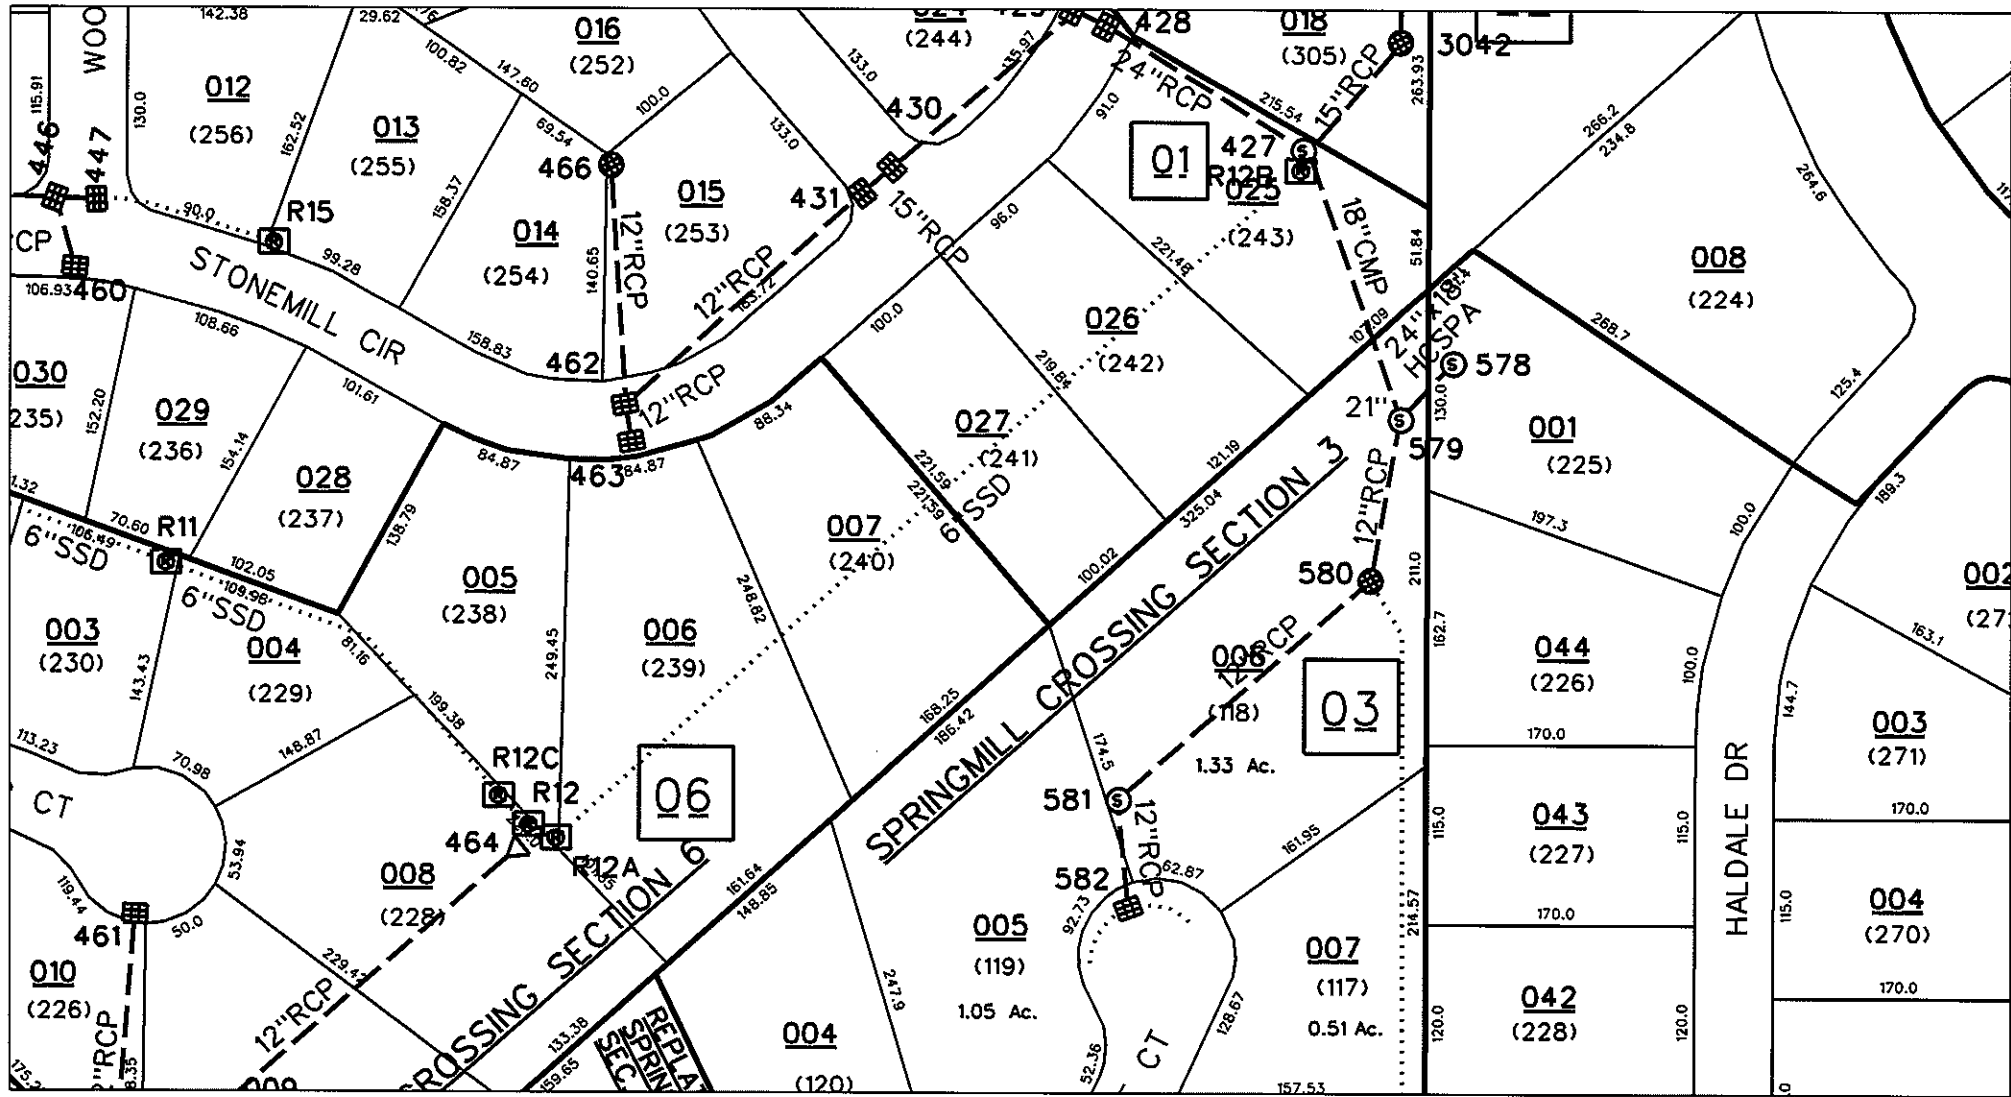

sub_rg_drn.dgn 7/9/2013 3:43:32 PM