



SURVEYOR'S OFFICE

# Hamilton County

*Kenton C. Ward, CFM*  
*Surveyor of Hamilton County*  
*Phone (317) 776-8495*  
*Fax (317) 776-9628*

*Suite 188*  
*One Hamilton County Square*  
*Noblesville, Indiana 46060-2230*

June 5, 2009

To: Hamilton County Drainage Board

Re: Westfield Farms Drain – Western Way Road Improvements Reconstruction

Attached are petitions and plans for the proposed reconstruction of the Westfield Farms Drain, Greyhound Pass and Village Extension Arm. The reconstruction is being proposed by the City of Westfield. The proposal is to enclose 15 feet of open ditch in 30 inch RCP within the right of way of Western Way.

The reconstructed drain shall consist of 15 feet of RCP and a manhole from Str. 2 of the Westfield Farms Drain, Greyhound Pass and Village Extension Arm to Str. 43 of the same drain. The end section (Str. 2) was removed and 8 feet of 30" RCP was added and connected to the new manhole, which is Str. 20 per the road project plans. The end section (Str. 43) was also removed and 7 feet of 30" RCP was added and connected in Str. 20. This is as shown on the construction plans prepared by HNTB, having job number 426519-DS-001, and dated June 13, 2008.

The drain in total will consist of the following lengths:

15 feet of 30" RCP

The total length of new drain shall be 15 feet. The 15 feet of open ditch from the original Westfield Farms Drain between Str. 2 and Str. 43 per my original report to the Board, dated May 19, 2000, with a hearing date of May 22, 2000 (Drainage Board Minutes Book 5, Pages 374 and 375), shall be vacated. This proposal will not change the overall length of the Westfield Farms Drain.


The cost of the reconstruction is to be paid by the City of Westfield. Because the project is to be paid by the petitioner and is within the boundaries of the petitioner's right of way, the project falls under the requirements as set out in IC 36-9-27-52.5. Therefore, a notice of hearing is not required for the petition.

The easement for the drain will remain the same easement that was in the right of way prior to this reconstruction.

Since this project is being completed by the City of Westfield and part of a road project, no bond was submitted.

I recommend approval by the Board at this time.

Sincerely,

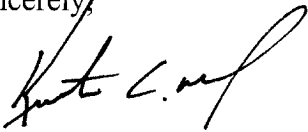A handwritten signature in black ink, appearing to read "Kenton C. Ward". The signature is fluid and cursive, with a large loop at the end.

Kenton C. Ward, CFM  
Hamilton County Surveyor

KCW/pll

**Gasb 34 Asset Price &  
Drain Length Log**

**Drain-Improvement:** Westfield Farms Drain: Western Way & Greyhound Pass Reconstruction

Drain Type:	Size:	Length	Length (DB Query)	Length Reconcile	If Applicable	
					Price:	Cost:
RCP	30	36			\$24.60LF	\$885.60
<b>Sum:</b>		<u>36</u>				<u>\$885.60</u>

Final Report: 36

Comments:  
Revised based upon Final Report Footages  
 \_\_\_\_\_  
 \_\_\_\_\_  
 \_\_\_\_\_  
 \_\_\_\_\_

HAMILTON COUNTY DRAINAGE BOARD  
NOBLESVILLE, INDIANA

IN RE: Greyhound Pass & Western Way Road Project )  
Hamilton County, Indiana )

PETITION FOR RELOCATION AND RECONSTRUCTION


City of Westfield (hereinafter "Petitioner"),  
hereby petitions the Hamilton County Drainage Board for authority to relocate and improve a  
section of the Westfield Farms Drain, and in support of  
said petition advises the Board that:

1. Petitioner owns real estate through which a portion of the Westfield Farms Drain runs.
2. Petitioner plans to develop its real estate with roads, buildings, utilities, storm drains, sanitary sewers and other structures.
3. Petitioner's proposed development of its real estate will require relocation and reconstruction of a portion of the Westfield Farms Drain, as specifically shown on engineering plans and specifications filed with the Hamilton County Surveyor.
4. The work necessary for the proposed relocation and reconstruction will be undertaken at the sole expense of the Petitioner and such work will result in substantial improvement to the Westfield Farms Drain, without cost to other property owners on the watershed of the Westfield Farms Drain.
5. Proposed relocation and reconstruction will not adversely affect other land owners within the drainage shed.
6. Petitioner requests approval of the proposed relocation and reconstruction under IC 36-9-27-52.5.

WHEREFORE, Petitioner requests that an Order issued from the Hamilton County Drainage Board authorizing relocation and reconstruction of the Westfield Farms Drain, in conformance with applicable law and plans and specifications on file with the Hamilton County Surveyor.

Kurt J. Wanninger  
Signed

KURT J. WANNINGER  
Printed

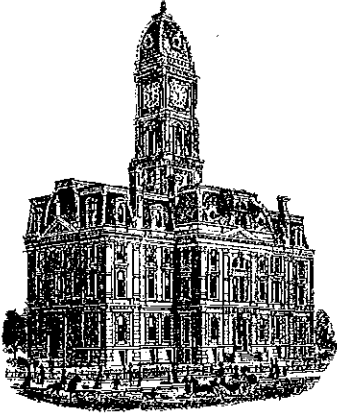

*Kenton C. Ward, CFM*  
*Surveyor of Hamilton County*  
*Phone (317) 776-8495*  
*Fax (317) 776-9628*

*Suite 188*  
*One Hamilton County Square*  
*Noblesville, Indiana 46060-2230*

**To: Hamilton County Drainage Board**

**September 4, 2013**

**Re: Cool Creek – Westfield Farms Drain: Western Way Rd Improvements Reconstruction**

Attached are plans and other information for Western Way Rd Improvements. An inspection of the drainage facilities for this section has been made and the facilities were found to be complete and acceptable.

During construction, changes were made to the drain, which will alter the plans submitted with my report for this drain-dated June 5, 2009. The report was approved by the Board at the hearing held June 22, 2009. (See Drainage Board Minutes Book 12, Pages 93-94)

The changes are as follows:

The 30" RCP was lengthened from 16 feet to 36 feet drain. The length of the drain due to the changes described above is now **36 feet**. There was also 15 feet of open ditch that was removed along with two end sections (Str. 43 & Str. 2). Therefore, this project added 21 feet of drain to the watershed's overall length.

The work was done in existing right of way. Therefore, no additional drainage easements were required. The project was paid for by the City of Westfield. Thus, no sureties were required.

I recommend the Board approve the drain's construction as complete and acceptable.


Sincerely,

---

Kenton C. Ward, CFM  
Hamilton County Surveyor

KCW/slm


SEC. 13, T-18-N, R-3-E  
WASHINGTON TOWNSHIP  
HAMILTON COUNTY

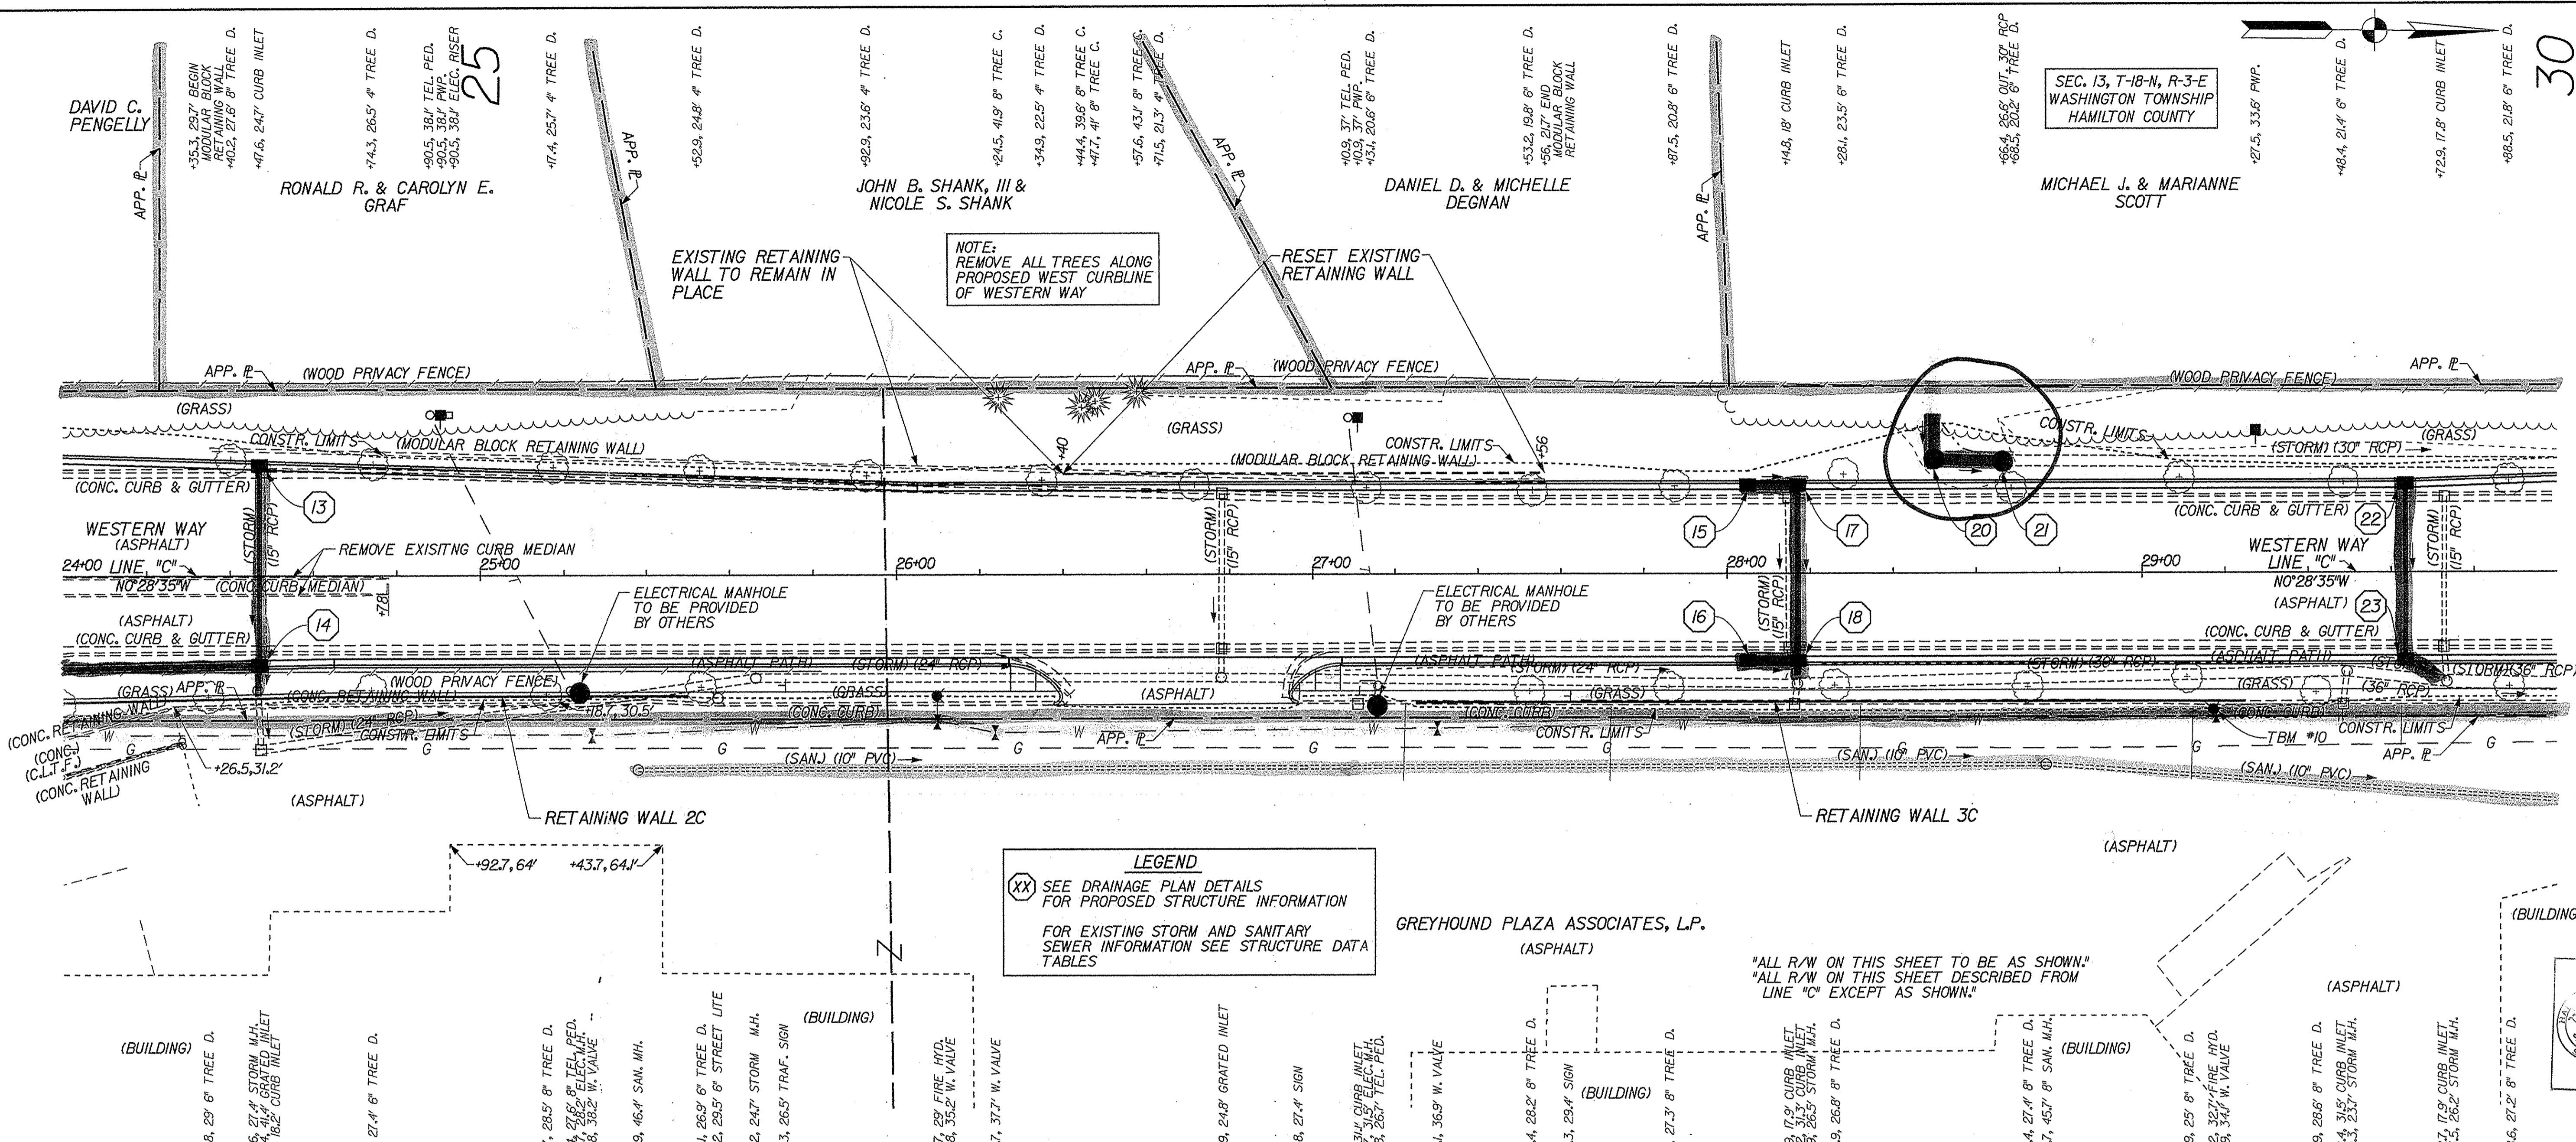

**LEGEND**  
 (XX) SEE DRAINAGE PLAN DETAILS FOR PROPOSED STRUCTURE INFORMATION  
 FOR EXISTING STORM AND SANITARY SEWER INFORMATION SEE STRUCTURE DATA TABLES

"ALL R/W ON THIS SHEET TO BE AS SHOWN."  
 "ALL R/W ON THIS SHEET DESCRIBED FROM LINE "C" EXCEPT AS SHOWN."

This information was gathered for input into the Hamilton County Geographic Information System (GIS). This document is considered an official record of the GIS.  
 Entry Date: 9/17/2013  
 Entered By: SLM

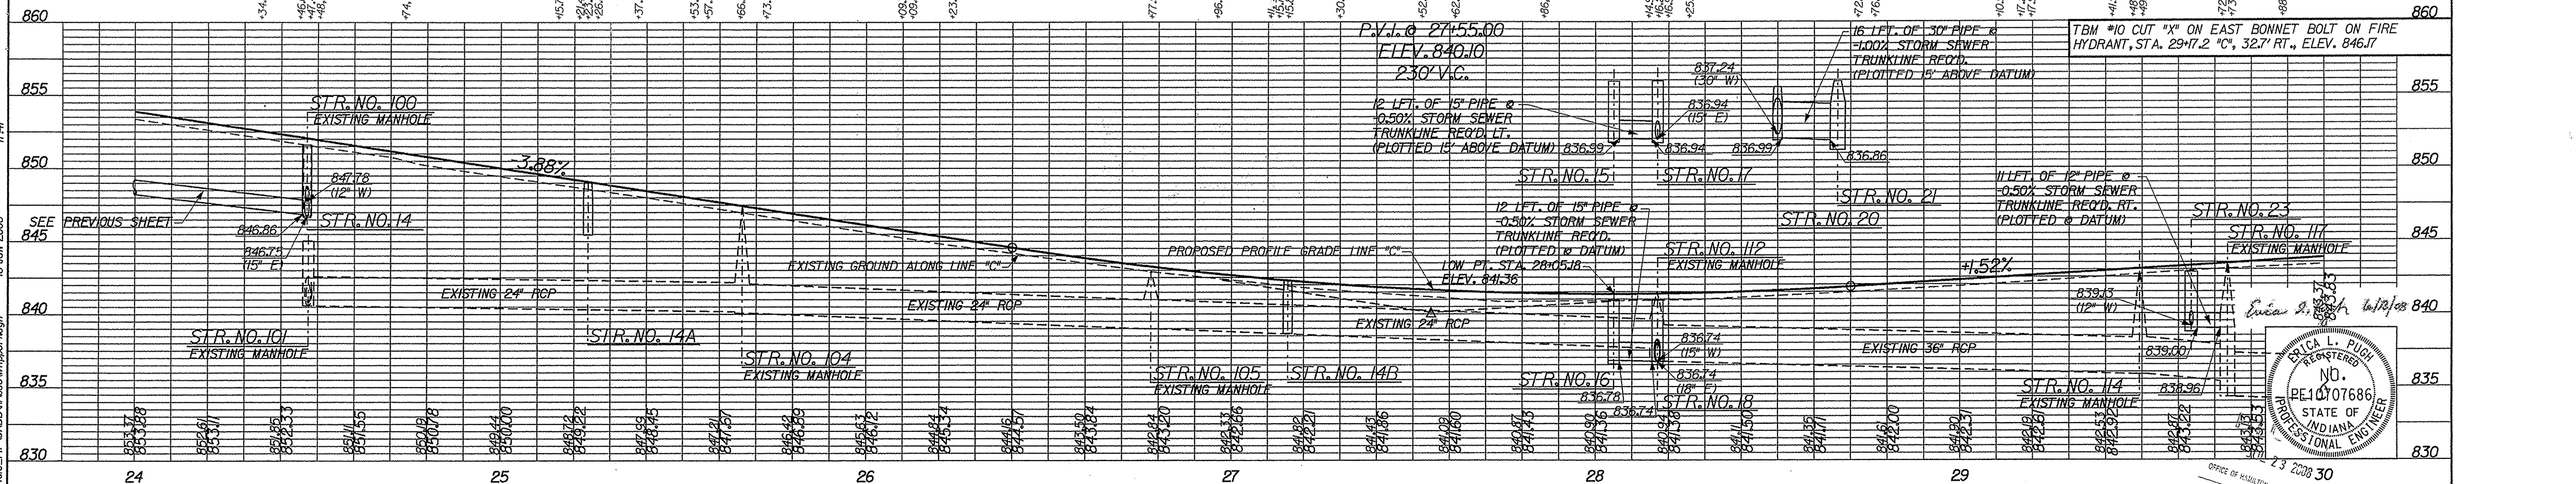

NO.	REVISIONS	DESIGNED	CHECKED
1		ELP	PBS
2		CPH	ELP

**HNTB** HNTB INDIANA, INC.  
 111 Monument Circle, Indianapolis, Indiana 46204-5178

PLAN AND PROFILE  
 WESTERN WAY  
 LINE "C"

SCALE  
 HORIZ. 1" = 20'  
 VERT. 1" = 5'

DATE: 9/17/2013

PROJECT NO. 42619-DS-001

