

Kenton C. Ward, Surveyor

Phone (317) 776-8495

Fax (317) 776-9628

Suite 188

One Hamilton County Square

Noblesville, Indiana 46060-2230

January 3, 2006

To: Hamilton County Drainage Board

Re: Crooked Creek Drain, Mayflower Arm – West Carmel Marketplace Relocation

Attached is a petition and plans for the proposed relocation of the Mayflower Arm of the Crooked Creek Drain. The relocation is being proposed by Duke Construction, L.P. The proposal is to reconstruct the Mayflower Arm, Crooked Creek Drain from a point 27 feet downstream of Str. 6 of the Mayflower Arm and relocate the drain along future 99th Street to Crooked Creek.

The relocated drain shall consist of those lengths of pipes between the following structures as shown on the plans by Woolpert, dated October 20, 2004, and having job number 61287.03: Starting approximately 27 feet downstream of existing Structure 6 is the location for Str. 94, then the drain continues to Str. 93, 8, 7, 6, 5, 4, 97, 3, 2, 1, 85, and 84. Structure 84 is an end section that outlets into Lake B, the drain then continues as 150 feet of open ditch through Lake B to Str. 74 and 73. Structure 73 is an end section that discharges into the Crooked Creek Drain at the approximate location the Mayflower Drain currently discharges.

Also, additional new drain shall be those lengths of pipes between the following structures: 94 to 9, 94 to 10, 7 to 46, 46 to 47, 6 to 42, 42 to 43, 43 to 44, 44 to 45, 45 to 41, 5 to 23, 23 to 24, 24 to 25, 25 to 31, 4 to 20, 20 to 21, 3 to 18, and 18 to 88. Also to be included is Structure 77 to 89, 89 to 86, 86 to 78, 79 to 90, 90 to 80, 81 to 82, and 82 to 83.

The drain in total will consist of the following lengths:

12" RCP – 279 ft	15" RCP – 95 ft	24" RCP – 454 ft
30" RCP – 154 ft	36" RCP – 258 ft	42" RCP – 331 ft
48" RCP – 714 ft	54" RCP – 657 ft	Open Ditch – 150 ft

As part of this reconstruction, Structure 105 of the Crooked Creek Drain, Commerce Drive Extension Arm and the 27 feet of pipe to Str. 106 will be removed.

The total length of new tile shall be 3092 feet. The 1,748 feet of the original Mayflower Arm between 27 feet downstream of Str. 6 and Str. 9A and 135 of open drain between Str. 9A and Crooked Creek, per the original 1974 construction plans, and 27 feet

between Str. 105 and Str. 106 of the Commerce Drive Extension Arm, per my report to the Board dated June 23, 2003 (DB 7 pgs 123-124), shall be vacated. This proposal will add an additional 1344 feet to the Mayflower Arm and remove 27 feet from the Commerce Drive Extension Arm, for a total addition of 1317 feet to the Crooked Creek Drain.

The retention ponds (Ponds B, C, D, and E) located in Common Areas Block D and E are to be considered part of the regulated drain. Pond maintenance shall include the inlets, outlets, sediment removal, and erosion control along the banks as part of the regulated drain. The maintenance of the ponds, such as mowing and aquatic vegetation control will be the responsibility of the association or property owner. The Board will also retain jurisdiction for ensuring the storage volume which the ponds were designed will be retained, thereby, allowing no fill or easement encroachments.

Retention pond A and the storm sewer from Str. 75 to 87 and 87 to 76 shall remain private and will be the maintenance responsibility of the association or property owner per the agreement with the Board and Duke, D.B. 8, pages 176-177, 183-184, and 217.

The cost of the relocation is to be paid by Duke Construction, L.P. Because the project is to be paid by the petitioner and is within the boundaries of the petitioner's property, the project falls under the requirements as set out in IC 36-9-27-52.5. Therefore, a hearing is not required for the petition.

For the relocated drain located within the boundaries of West Carmel Marketplace, I recommend that the Board also approve the attached non-enforcement request. The request is for the reduction of the regulated drain easement to those easement widths as shown on the secondary plat for West Carmel Marketplace as recorded in the office of the Hamilton County Recorder.

The petitioner has provided the Performance Bond as follows:

Name of Bonding Company: Western Surety Company
Bond Number: 929352993
Bond Date: December 13, 2004
Bond Amount: \$323,961.00

I believe this proposed drain meets the requirements for Urban Drain Classification as set out in IC 36-9-27-67 to 69. Therefore, this drain shall be designated as an Urban Drain.

I recommend approval by the Board at this time.

Sincerely,



Kenton C. Ward
Hamilton County Surveyor

KCW/grh

HAMILTON COUNTY DRAINAGE BOARD
NOBLESVILLE, INDIANA

IN RE: _____)
Hamilton County, Indiana)


PETITION FOR RELOCATION AND RECONSTRUCTION


DUKE CONSTRUCTION, L.P. (hereinafter Petitioner”),

hereby petitions the Hamilton County Drainage Board for authority to relocate and improve a section of the MAYFLOWER PARK ARM OF THE Drain, and in support of CROOKED CREEK REGULATED said petition advises the Board that:

1. Petitioner owns real estate through which a portion of the MAYFLOWER PARK ARM OF THE CROOKED CREEK REGULATED Drain runs.
2. Petitioner plans to develop its real estate with roads, buildings, utilities, storm drains, sanitary sewers and other structures.
3. Petitioner’s proposed development of its real estate will require relocation and reconstruction of a portion of the MAYFLOWER PARK ARM OF THE CROOKED CREEK REGULATED Drain, as specifically shown on engineering plans and specifications filed with the Hamilton County Surveyor.
4. The work necessary for the proposed relocation and reconstruction will be undertaken at the sole expense of the Petitioner and such work will result in substantial improvement to the MAYFLOWER PARK ARM OF THE CROOKED CREEK REGULATED Drain, without cost to other property owners on the watershed of the _____ Drain.
5. Proposed relocation and reconstruction will not adversely affect other land owners within the drainage shed.
6. Petitioner requests approval of the proposed relocation and reconstruction under IC 36-9-27-52.5.

WHEREFORE, Petitioner requests that an Order issued from the Hamilton County Drainage Board authorizing relocation and reconstruction of the MAYFLOWER PARK ARM OF THE CROOKED CREEK REGULATED Drain, in conformance with applicable law and plans and specifications on file with the Hamilton County Surveyor.


Signed _____
Cynthia J. Schembre
Printed _____

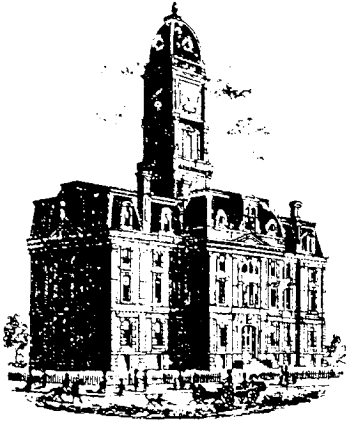

SURVEYOR'S OFFICE

Hamilton County

Kenton C. Ward, CFM
Surveyor of Hamilton County
 Phone (317) 776-8495
 Fax (317) 776-9628

Suite 188
One Hamilton County Square
Noblesville, Indiana 46060-2230

To: Hamilton County Drainage Board

February 3, 2009

Re: Crooked Creek Drain: Mayflower Arm- West Carmel Marketplace Relocation

Attached are as-builts, certificate of completion & compliance, and other information for West Carmel Marketplace Relocation of the Mayflower Arm. An inspection of the drainage facilities for this section has been made and the facilities were found to be complete and acceptable.

During construction, changes were made to the drain, which will alter the plans submitted with my report for this drain-dated January 3, 2006. The report was approved by the Board at the hearing held February 27, 2006. (See Drainage Board Minutes Book 9, Pages 84-85)

The changes are as follows:

Structure:	Length:	Size	Material:	Up Invert:	Dn_Invert	Grade:
94-8	59	36	RCP	878.31	879.2	1.51
8-7	195	36	RCP	878.84	877.02	0.93
7-6	95	42	RCP	877.02	876.77	0.26
6-5	328	48	RCP	876.77	876.38	0.12
5-4	265	48	RCP	876.38	876.24	0.05
4-97	86	48	RCP	875.84	875.72	0.14
97-3	31	48	RCP	875.61	875.77	0.51
3-2	159	54	RCP	875.45	875.38	0.04
2-1	192	54	RCP	875.4	875.04	0.19
1-85	192	54	RCP	874.93	874.18	0.39
85-84	114	54	RCP	874.13	874.19	-0.05
74-73	66	24	RCP	873.89	873.61	0.42
10-94	66	12	RCP	883.29	883.65	0.45
9-94	24	12	RCP	883.65	883.08	2.6
47-46	44	12	RCP	885	884.8	0.45
45-44	36	12	RCP	884.76	884.1	1.8
44-43	42	15	RCP	884.1	883.76	0.79
43-42	44	15	RCP	883.76	883.35	0.95
41-45	20	12	RCP	885	884.76	1.2
6-42	9	15	RCP	883.35	882.58	1.11

31-25	32	12	RCP	884.5	884.36	0.45
25-24	39	30	RCP	878.94	877.98	0.53
24-23	44	30	RCP	877.98	877.75	0.52
23-5	9	30	RCP	877.75	876.38	0.53
21-20	46	12	RCP	881.96	881.5	1
20-4	9	12	RCP	881.5		1.9
18-3	9	30	RCP	876.03	875.57	0.5
88-18	53	30	RCP	876.28	876.03	0.47
86-78	59	24	RCP	874.14	874.12	0.14
89-86	55	24	RCP	874.12	874.2	-0.15
77-89	86	24	RCP	874.19	874.14	0.06
80-90	41	24	RCP	874.25	874.07	0.44
90-79	115	24	RCP	874.07	874.12	-0.04
81-82	140	42	RCP	874.01	873.96	-0.07
82-83	79	42	RCP	873.96	873.98	-0.02
7-46	9	12	RCP	884.8	884.72	

RCP Pipe Totals:

12	286
15	95
24	422
30	154
36	254
42	314
48	710
54	657

Total: 2892

Other Drain:

150-OPEN DITCH	
-------------------	--


The length of the drain due to the changes described above is now **3042 feet**. The project removed 1804 feet of the existing Mayflower Arm and 124 feet of the Commerce Drive Arm. The non-enforcement was approved by the Board at its meeting on February 27, 2006 and recorded under instrument #200677172.

The following sureties were guaranteed by Western Surety Company expired on December 13, 2006.

Bond-LC No: 929352993
Insured For: Storm Sewers
Amount: \$323,961.00
Issue Date: December 13, 2004

I recommend the Board approve the drain's construction as complete and acceptable.

Sincerely,

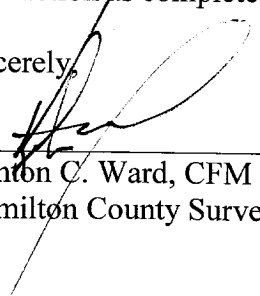

 Kenton C. Ward, CFM
 Hamilton County Surveyor

WEST CARMEL MARKETPLACE PHASE 1

DOCKET NOS. 04050029-30V, 04050033-36V, 04070008-10V, 04050028DP/ADLS
9901 NORTH MICHIGAN ROAD
CARMEL, INDIANA
OCTOBER 20, 2004

OWNER:


Duke Realty Corporation

600 East 96th Street, Suite 100, Indianapolis, IN 46240 317.808.6000

CONTRACTOR:

Duke Construction Limited Partnership


600 East 96th Street, Suite 100, Indianapolis, IN 46240 317.808.6000

 **WOOLPERT, INC.**
7140 Waldemar Drive
Indianapolis, Indiana
46268-4192
317.299.7500
WOOLPERT FAX: 317.291.5805

I HEREBY CERTIFY THAT THESE DRAWINGS
DEPICT AS-BUILT FIELD DATA AND WERE
PREPARED BY WOOLPERT, INC.




John R. Heshelman
JOHN R. HESHELMAN, L.S.
S0386
DATE: 4/13/07

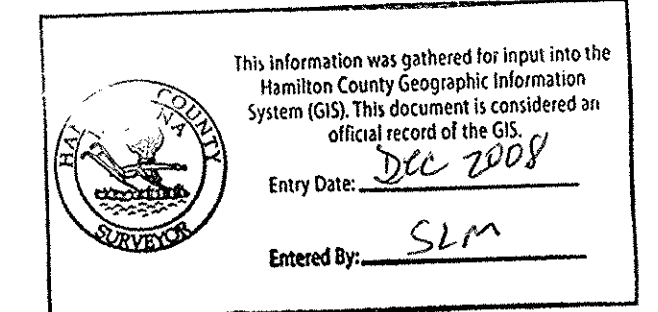


STORM SEWER AS-BUILT

SITE PLAN

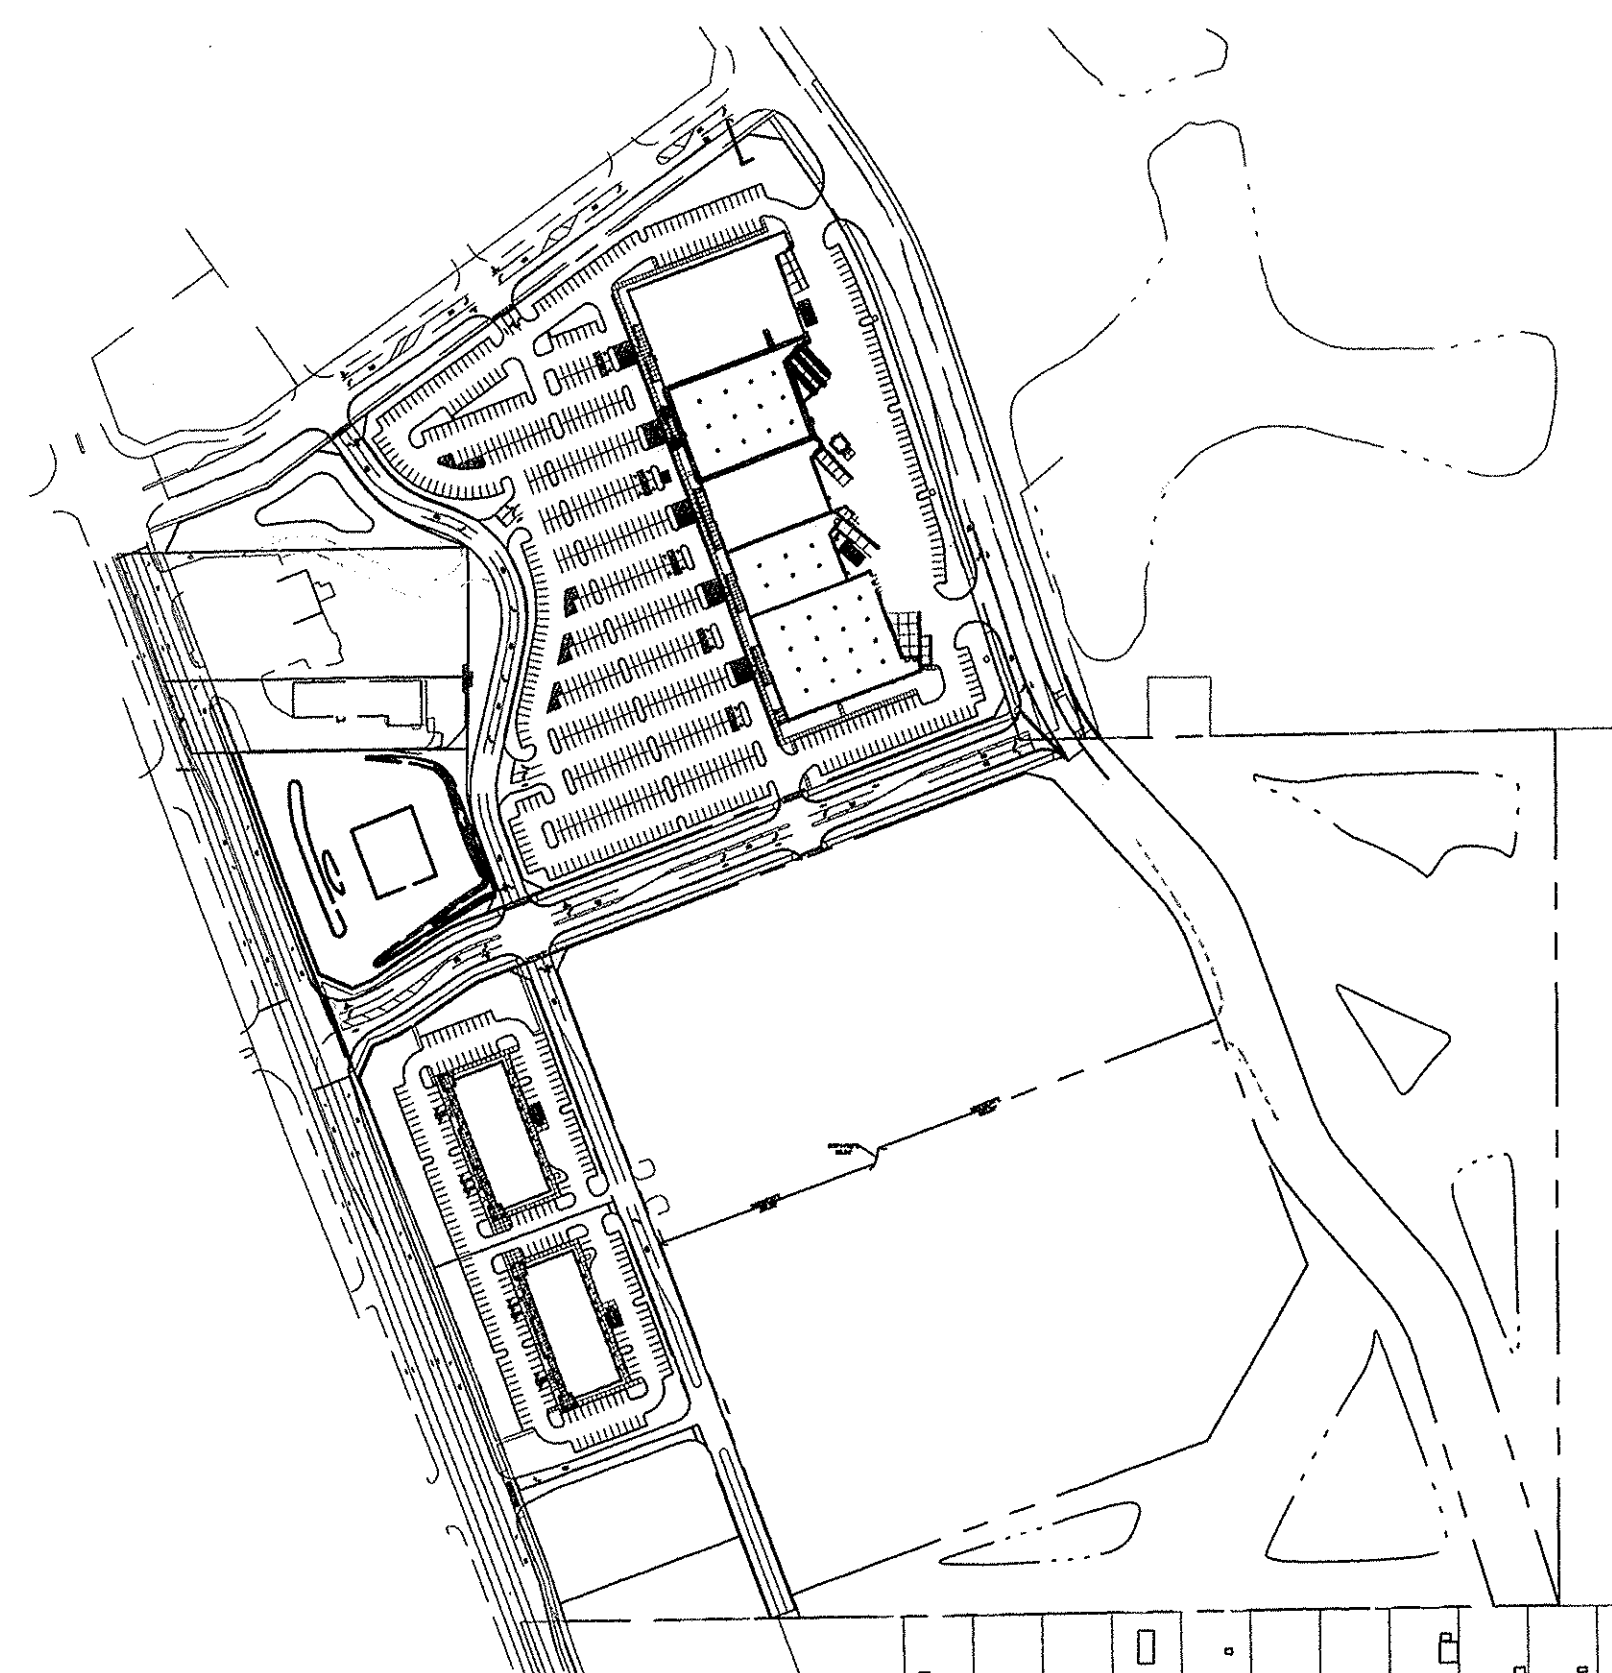

VICINITY MAP

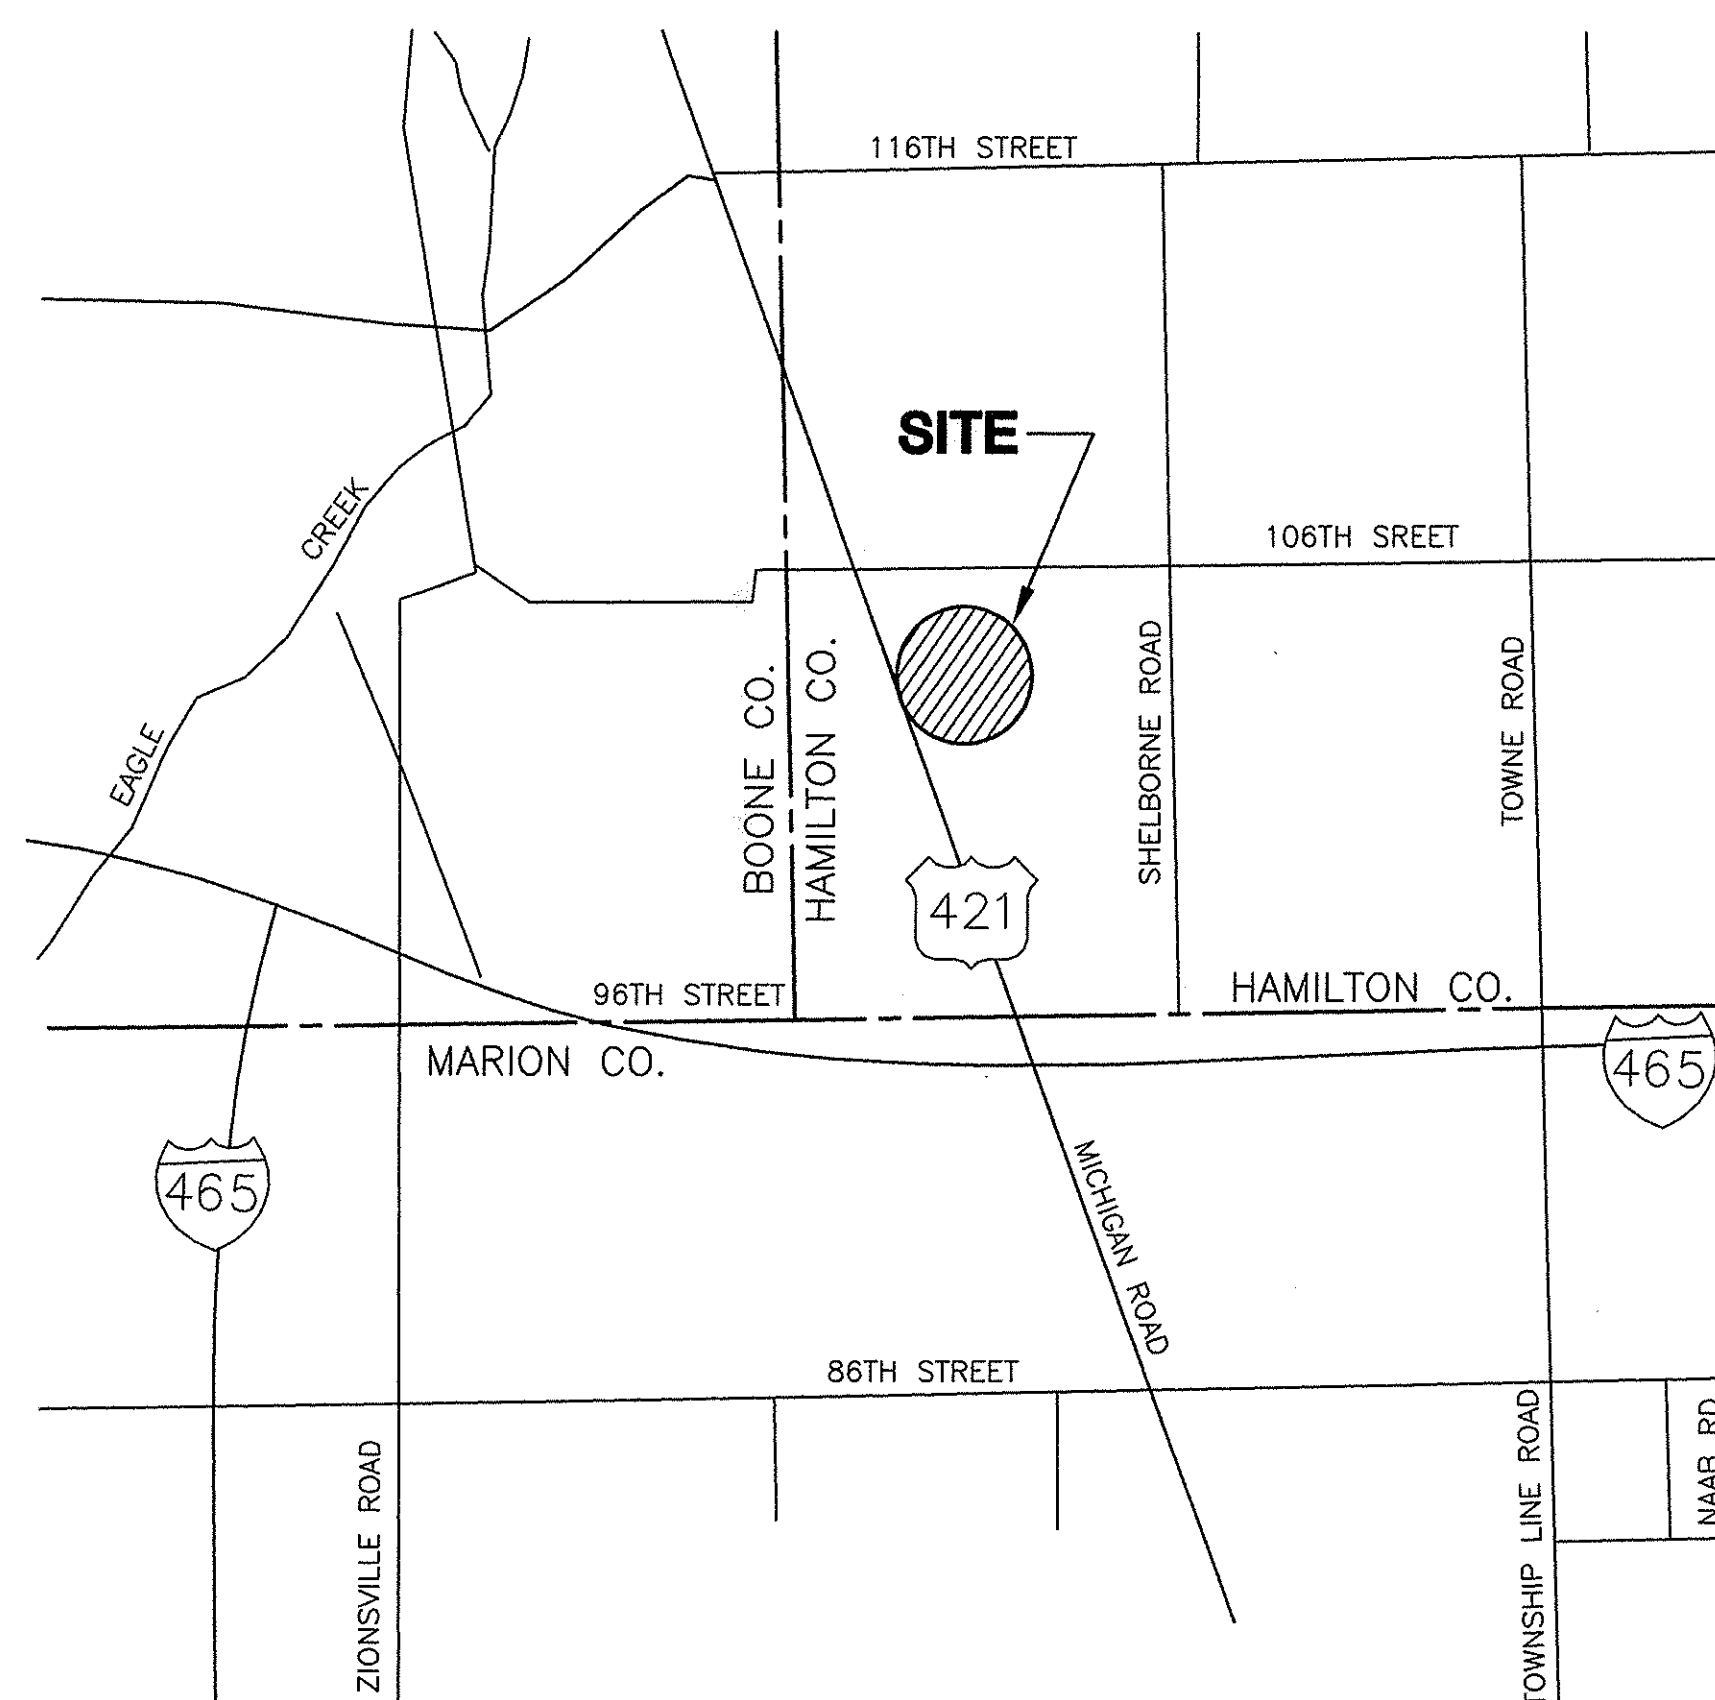

SHEET INDEX

26	10/06/06	C000	COVER SHEET
01	10/20/04	-0001	SPECIFICATIONS-SHEET
04	04/27/06	-0100	EXISTING CONDITIONS & DEMOLITION PLAN - NORTH HALF
04	04/27/06	-0101	EXISTING CONDITIONS & DEMOLITION PLAN - SOUTH HALF
04	04/27/06	-0102	EXISTING CONDITIONS & DEMOLITION PLAN - EAST HALF
02	05/09/06	-0200	OVERALL SITE PLAN
02	05/09/06	-0201	SITE PLAN - ENTRANCE AREAS
02	10/04/06	-0202	SITE PLAN - RETAIL CENTER AREA
04	04/27/06	-0203	SITE PLAN - 'B' SHOPS AREA
02	05/09/06	-0300	GRADING PLAN - ENTRANCE AREAS
02	10/04/06	-0301	GRADING PLAN - RETAIL CENTER AREA
04	04/27/06	-0302	GRADING PLAN - 'B' SHOPS AREA
02	12/02/05	-0303	GRADING PLAN - DETENTION PONDS AREA
12	06/02/05	-0304	EROSION CONTROL PLAN
04	04/27/06	-0305	EROSION CONTROL PLAN BLOCK F & H
02	05/09/06	-C400	UTILITY PLAN - ENTRANCE AREAS
02	10/04/06	-C401	UTILITY PLAN - RETAIL CENTER AREA
04	04/27/06	C402	UTILITY PLAN - 'B' SHOPS AREA
02	10/04/06	C403	UTILITY PLAN - DETENTION PONDS AREA
02	12/02/05	-C404	ROAD PLAN & PROFILE - LINE 'A'
02	12/02/05	-C405	STORM PLAN & PROFILES
02	12/02/05	-C406	SANITARY & STORM PLAN & PROFILES
05	12/28/04	-C407	STORM PLAN & PROFILES
02	12/02/05	-C408	SANITARY PLAN & PROFILE
02	10/04/06	-C409	UTILITY PLAN - UTILITY CONNECTIONS
02	05/09/06	-0500	LANDSCAPE PLAN - ENTRANCE AREAS
02	10/04/06	-0501	LANDSCAPE PLAN - RETAIL CENTER AREA
02	12/14/05	-0502	LANDSCAPE PLAN - 'B' SHOPS AREA
12	06/02/05	-0503	LANDSCAPE PLAN - PERIMETER BUFFERWARDS
01	11/05/04	-0600	DETAILS
11	06/17/05	C601	DETAILS
02	10/04/06	-0602	DETAILS
04	12/29/04	-0603	DETAILS
01	10/20/04	-0604	DETAILS - HAMILTON COUNTY HIGHWAY DEPARTMENT
03	12/07/04	C605	DETAILS - HAMILTON COUNTY SURVEYOR'S OFFICE
04	04/27/06	-0606	DETAILS - EROSION CONTROL BLOCK F & H
02	05/09/06	-0700	LIGHTING PLAN - ENTRANCE AREAS
01	12/02/05	-0701	LIGHTING PLAN - RETAIL CENTER AREA
01	12/02/05	-0702	LIGHTING PLAN - 'B' SHOPS AREA
01	12/02/05	-0800	MAINTENANCE OF TRAFFIC PLAN

DRAWING INDEX LEGEND

○ MOST RECENT ISSUE OR REVISION DATE

○ C000 COVER SHEET

○ LATEST REVISION NUMBER

○ FILLED CIRCLE INDICATES DRAWING INCLUDED WITH THIS ISSUE

No.	DATE	REVISION
26	10/06/06	PER OWNER FOR HOMEGOODS
25	05/09/06	DRIVE REVISION PER CLIENT
24	04/27/06	DRIVE EXT. & MASS GRADING BLOCK F & H
23	03/14/06	BID PACK #8 - OFFICE MAX
22	12/19/05	PER OWNER FOR B-SHOPS
21	12/06/05	BID PACK #7 FOR PETCO/BESTBUY
20	12/05/05	PER OWNER FOR CTRWD
19	11/07/05	BID PACK #6
18	10/24/05	BID PACK #5 FOR BEST BUY & PETCO
17	09/20/05	PER OWNER
16	08/25/05	PER OWNER AND HCHD

PROJECT No.: 61287.03

C000

Layer State: . Layout Tab Name: COVER SHEET, Images: . Xrefs: LAST SAVED BY: mcdougals, OCT 06, 2006 - 13:40:54 G:\SVA\Projects\66163 West Carmel Mktpl\66163-COV.dwg, Plotted By: CollinsM, Plotted: Apr 13, 2007 - 3:22pm



WOOLPERT, INC.
7140 Waldemar Drive
Indianapolis, Indiana
46268-4192
317.299.7500
317.291.5805

Revisions:	Date	Description
1	01/21/05	PER CHDWD, HCSD
2	01/21/05	PER HCSD, OWNER
3	06/07/05	STORM SEWER REV.
4	06/07/05	PER OWNER
5	06/07/05	PER OWNER
6	11/23/05	BID PACK #1
7	12/19/05	DRIVE EXT.
8	04/27/06	GRAVING BLK. F & H

Scale: 1"=50'

Date: 10/20/04

Drawn By: PJD

Checked By: DK

WEST CARMEL MARKETPLACE - PHASE 1

9901 NORTH MICHIGAN ROAD
CARMEL, INDIANA

UTILITY PLAN - 'B' SHOPS AREA

Certified By:

Drawing Number:

C402

18 or 40 Sheets

Date Rec'd Job Number:

WNC301-001

A/E Job Number:

61287.03

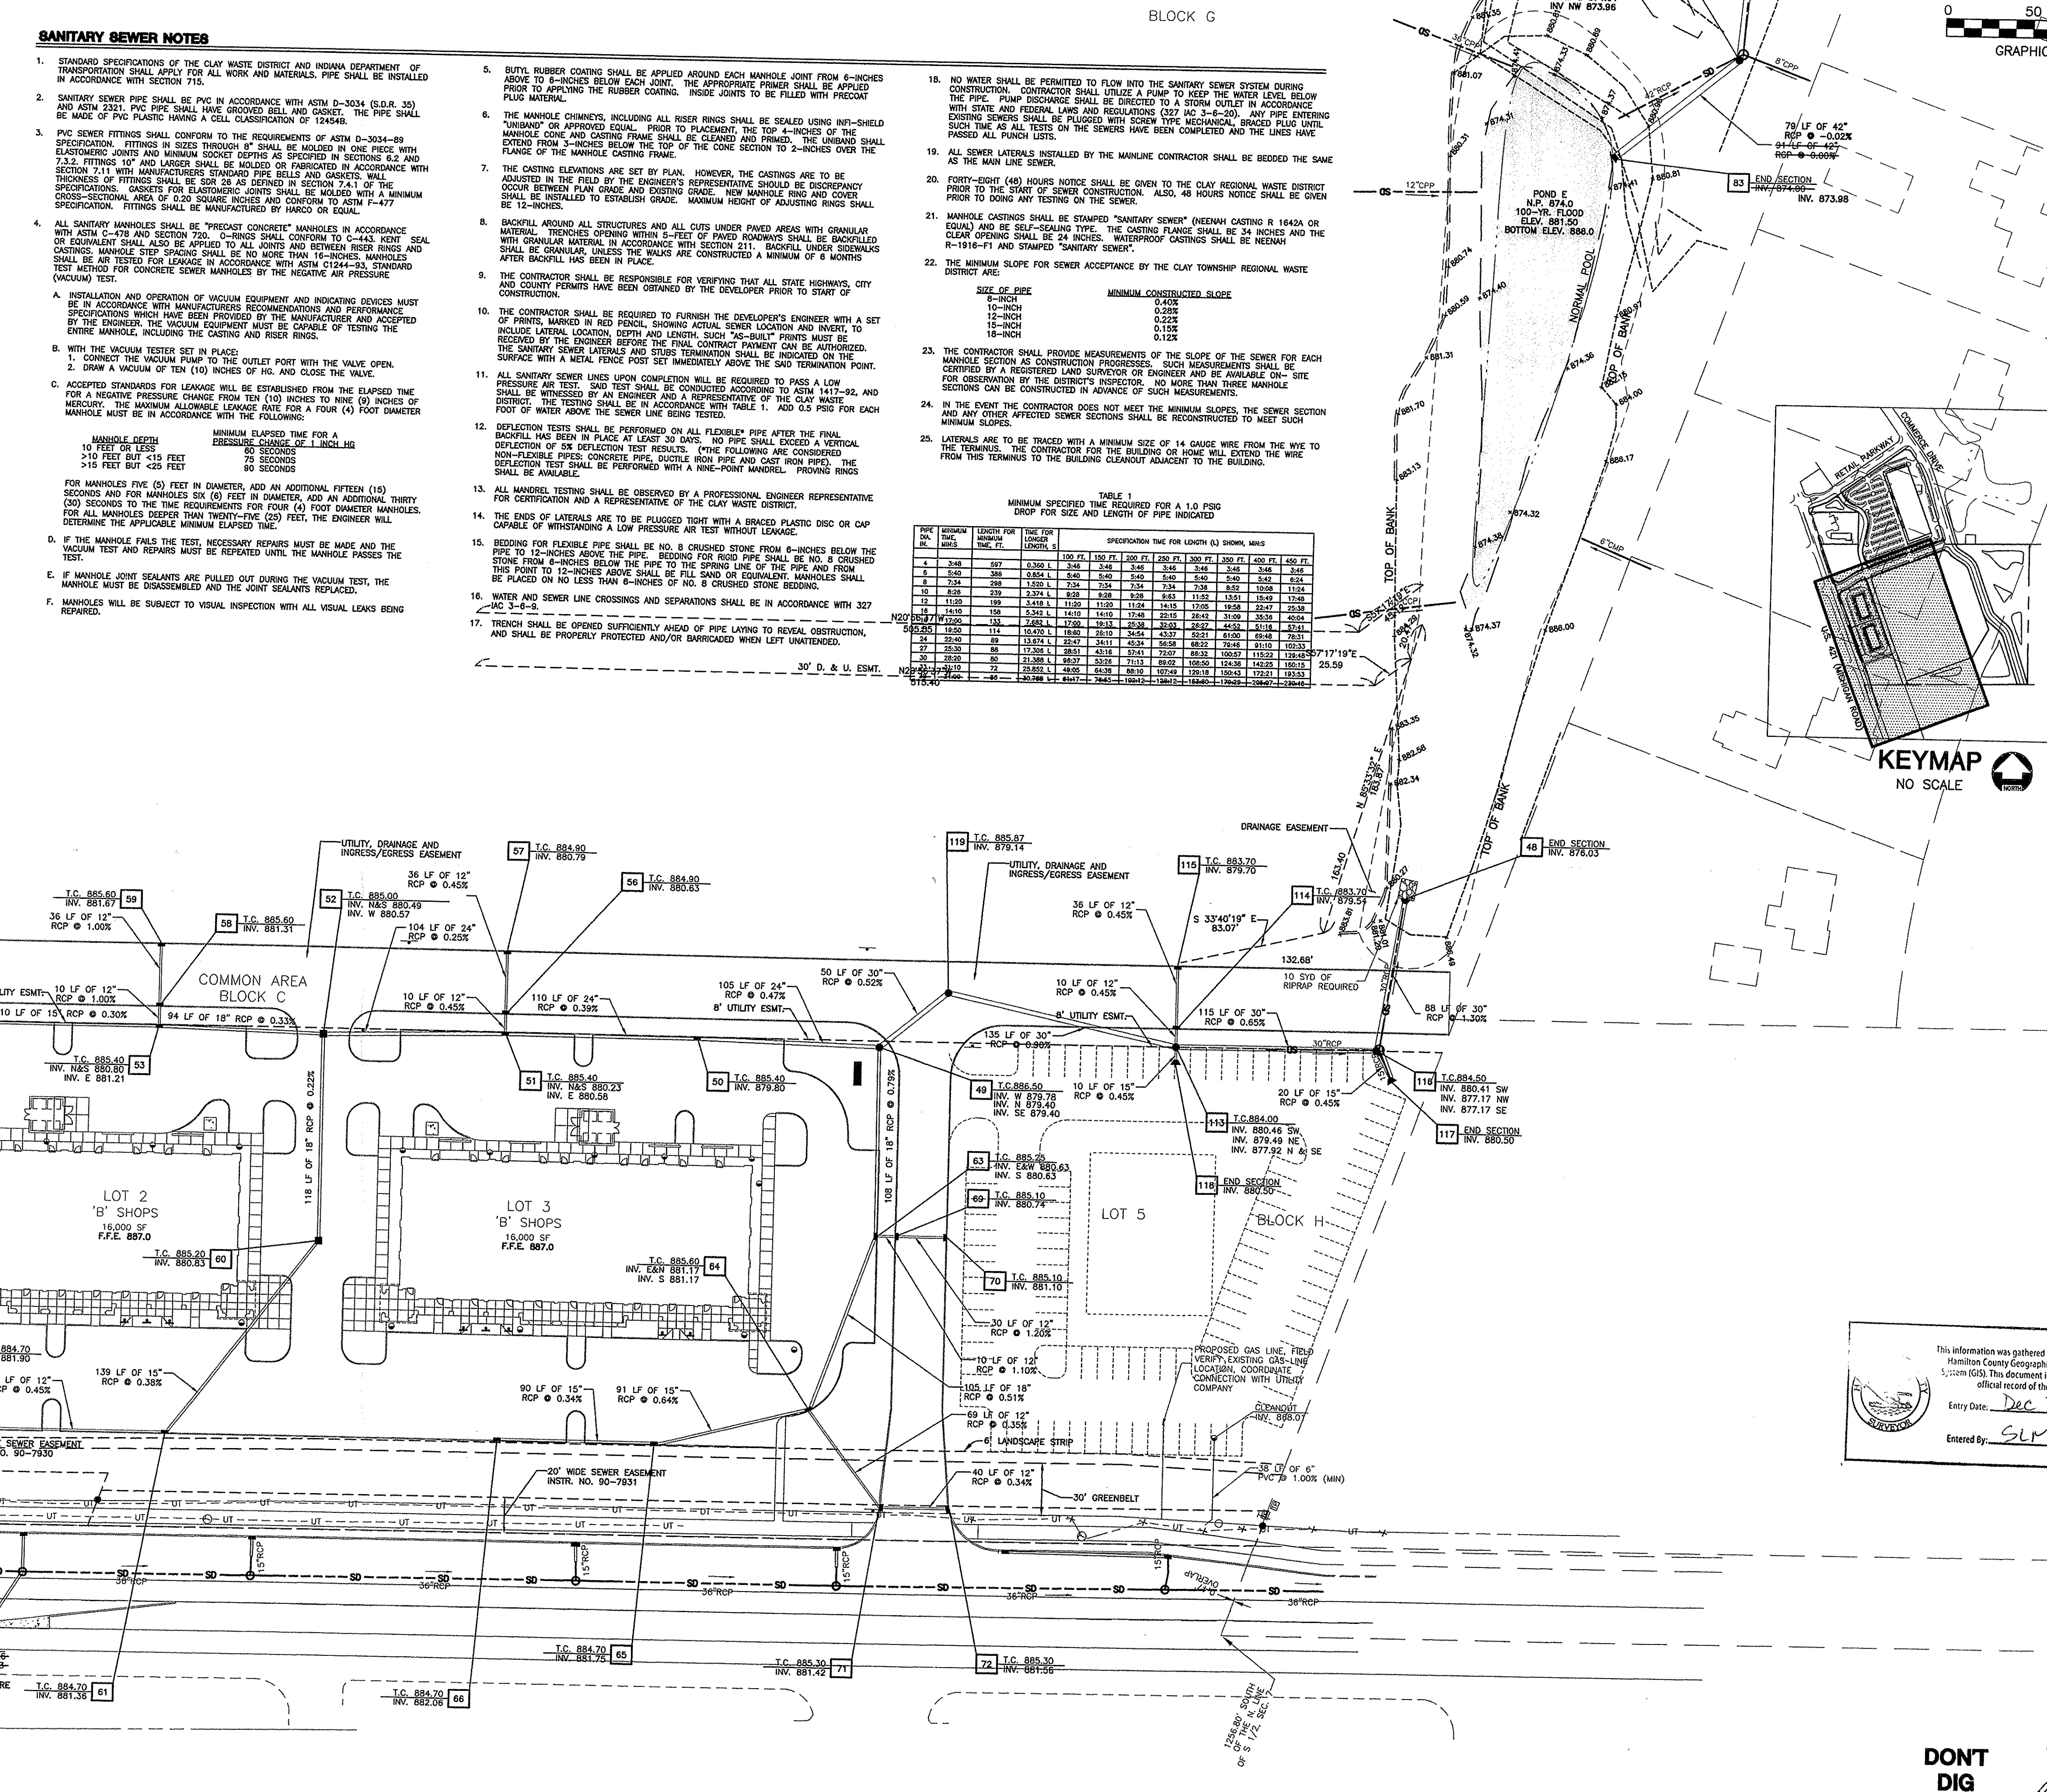
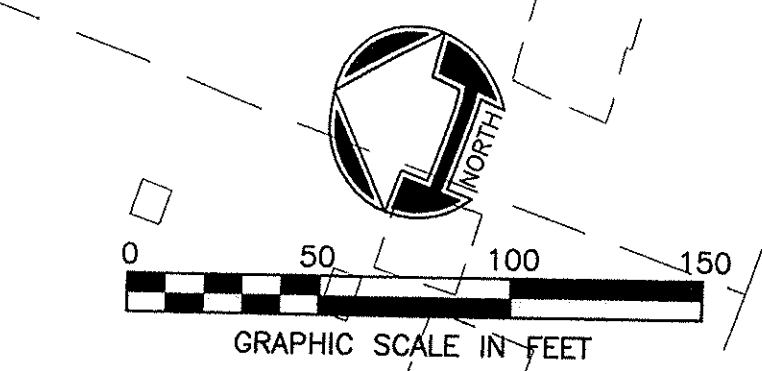



TABLE 1
MINIMUM SPECIFIED TIME REQUIRED FOR A 1.0 PSIG DROP FOR SIZE AND LENGTH OF PIPE INDICATED

PIPE DIA. IN.	LENGTH FOR TIME TEST LOWER		SPECIFICATION TIME FOR LENGTH (L) SHOWN, MINS								
	MINIMUM	MAXIMUM	100 FT	150 FT	200 FT	250 FT	300 FT	350 FT	400 FT	450 FT	500 FT
6	348	507	250	348	446	544	642	740	838	936	1034
8	540	789	384	540	720	900	1080	1260	1440	1620	1800
10	724	1070	512	724	966	1208	1450	1692	1934	2176	2418
12	908	1359	640	908	1216	1524	1832	2140	2448	2756	3064
14	1092	1641	768	1092	1456	1820	2184	2548	2912	3276	3640
16	1276	1920	896	1276	1704	2132	2560	2988	3416	3844	4272
18	1460	2172	1024	1460	1952	2444	2936	3428	3920	4412	4904
20	1644	2430	1152	1644	2196	2748	3300	3852	4404	4956	5508
22	1828	2688	1280	1828	2448	3068	3688	4308	4928	5548	6168
24	2012	2946	1408	2012	2688	3364	4040	4716	5392	6068	6744
26	2196	3204	1536	2196	2928	3604	4280	4956	5632	6308	6984
28	2380	3462	1664	2380	3116	3792	4468	5144	5820	6496	7172
30	2564	3720	1792	2564	3344	4020	4696	5372	6048	6724	7400
32	2748	3978	1920	2748	3576	4252	4928	5604	6280	6956	7632
34	2932	4236	2048	2932	3808	4484	5160	5836	6512	7188	7864
36	3116	4494	2176	3116	4064	4740	5416	6092	6768	7444	8120
38	3300	4752	2304	3300	4296	4972	5648	6324	7000	7676	8352
40	3484	5010	2432	3484	4528	5204	5880	6556	7232	7908	8584
42	3668	5268	2560	3668	4760	5436	6112	6788	7464	8140	8816
44	3852	5526	2688	3852	4992	5668	6344	7020	7696	8372	9048
46	4036	5784	2816	4036	5224	5900	6576	7252	7928	8604	9280
48	4220	6042	2944	4220	5456	6132	6808	7484	8160	8836	9512
50	4404	6300	3072	4404	5688	6364	7040	7716	8392	9068	9744
52	4588	6558	3200	4588	5920	6596	7272	7948	8624	9300	9976
54	4772	6816	3328	4772	6152	6828	7504	8180	8856	9532	10208
56	4956	7074	3456	4956	6384	7060	7736	8412	9088	9764	10440
58	5140	7332	3584	5140	6616	7292	7968	8644	9320	9996	10672
60	5324	7590	3712	5324	6848	7524	8200	8876	9552	10228	10904
62	5508	7848	3840	5508	7080	7756	8432	9108	9784	10460	11136
64	5692	8106	3968	5692	7312	7988	8664	9340	10016	10692	11368
66	5876	8364	4096	5876	7544	8220	8896	9572	10248	10924	11600
68	6060	8622	4224	6060	7776	8452	9128	9804	10480	11156	11832
70	6244	8880	4352	6244	8008	8684	9360	10036	10712	11388	12064
72	6428	9138	4480	6428	8240	8916	9592	10268	10944	11620	12296
74	6612	9396	4608	6612	8472	9148	9824	10500	11176	11852	12528
76	6796	9654	4736	6796	8704	9380	10056	10732	11408	12084	12760
78	6980	9912	4864	6980	8936	9612	10288	10964	11640	12316	12992
80	7164	10170	4992	7164	9168	9844	10520	11196	11872	12548	13224

- SANITARY SEWER NOTES**
- STANDARD SPECIFICATIONS OF THE CLAY WASTE DISTRICT AND INDIANA DEPARTMENT OF TRANSPORTATION SHALL APPLY FOR ALL WORK AND MATERIALS. PIPE SHALL BE INSTALLED IN ACCORDANCE WITH SECTION 715.
 - SANITARY SEWER PIPE SHALL BE PVC IN ACCORDANCE WITH ASTM D-3034 (S.D.R. 35) AND ASTM 2321. PVC PIPE SHALL HAVE GROOVED BELL AND GASKET. THE PIPE SHALL BE MADE OF PVC PLASTIC HAVING A CELL CLASSIFICATION OF 12454B.
 - PVC SEWER FITTINGS SHALL CONFORM TO THE REQUIREMENTS OF ASTM D-3034-89 SPECIFICATION. FITTINGS IN SIZES THROUGH 8" SHALL BE MOULDED IN ONE PIECE WITH THICKNESS OF FITTINGS SHALL BE 50% AS DEFINED IN SECTION 7.1.1 OF THE SPECIFICATIONS. GASKETS FOR ELASTOMERIC JOINTS SHALL BE MOULDED WITH A MINIMUM CROSS-SECTIONAL AREA OF 0.20 SQUARE INCHES AND CONFORM TO ASTM F-477 SPECIFICATION. FITTINGS SHALL BE MANUFACTURED BY HARCO OR EQUAL.
 - ALL SANITARY MANHOLES SHALL BE "PRECAST CONCRETE" MANHOLES IN ACCORDANCE WITH ASTM C-778 AND SECTION 710. D-RINGS SHALL CONFORM TO C-443. KENT SEAL CASTINGS MANHOLE STEP SPRINGS SHALL BE APPLIED TO ALL JOINTS AND BETWEEN RISER RINGS AND SHALL BE AIR TESTED FOR LEAKAGE IN ACCORDANCE WITH ASTM C1244-83 STANDARD TEST METHOD FOR CONCRETE SEWER MANHOLES BY THE NEGATIVE AIR PRESSURE (VACUUM) TEST.
 - INSTALLATION AND OPERATION OF VACUUM EQUIPMENT AND INDICATING DEVICES MUST BE IN ACCORDANCE WITH MANUFACTURER'S RECOMMENDATIONS AND PERFORMANCE SPECIFICATIONS WHICH HAVE BEEN PROVIDED BY THE MANUFACTURER AND ACCEPTED BY THE ENGINEER. THE VACUUM EQUIPMENT MUST BE CAPABLE OF TESTING THE EXTREME MANHOLE, INCLUDING THE CASTING AND RISER RINGS.
 - WITH THE VACUUM TESTER SET IN PLACE:
 - CONNECT THE VACUUM PUMP TO THE OUTLET PORT WITH THE VALVE OPEN. DRAW A VACUUM OF TEN (10) INCHES OF HG. AND CLOSE THE VALVE.
 - DRAW A VACUUM OF TEN (10) INCHES OF HG. AND CLOSE THE VALVE.
 - ACCEPTED STANDARDS FOR LEAKAGE WILL BE ESTABLISHED FROM THE ELAPSED TIME FOR A NEGATIVE PRESSURE CHANGE FROM TEN (10) INCHES TO NINE (9) INCHES OF MERCURY. THE MAXIMUM ALLOWABLE LEAKAGE RATE FOR A FOUR (4) FOOT DIAMETER MANHOLE MUST BE IN ACCORDANCE WITH THE FOLLOWING:

MANHOLE DEPTH	MINIMUM ELAPSED TIME FOR A PRESSURE CHANGE OF 1 INCH HG
10 FEET OR LESS	60 SECONDS
>10 FEET BUT <15 FEET	75 SECONDS
>15 FEET BUT <25 FEET	90 SECONDS
 - FOR MANHOLES FIVE (5) FEET IN DIAMETER, ADD AN ADDITIONAL FIFTEEN (15) SECONDS AND FOR MANHOLES SIX (6) FEET IN DIAMETER, ADD AN ADDITIONAL THIRTY (30) SECONDS TO THE TIME REQUIREMENTS FOR FOUR (4) FOOT DIAMETER MANHOLES. FOR ALL MANHOLES DEEPER THAN THIRTY-FIVE (35) FEET, THE ENGINEER WILL DETERMINE THE APPLICABLE MINIMUM ELAPSED TIME.
 - IF THE MANHOLE FAILS THE TEST, NECESSARY REPAIRS MUST BE MADE AND THE TEST, TEST AND REPAIRS MUST BE REPEATED UNTIL THE MANHOLE PASSES THE TEST.
 - IF MANHOLE JOINT SEALANTS ARE PULLED OUT DURING THE VACUUM TEST, THE MANHOLE MUST BE DISASSEMBLED AND THE JOINT SEALANTS REPLACED.
 - MANHOLES WILL BE SUBJECT TO VISUAL INSPECTION WITH ALL VISUAL LEAKS BEING REPAIRED.
 - BUTYL RUBBER COATING SHALL BE APPLIED AROUND EACH MANHOLE JOINT FROM 6-INCHES ABOVE TO 6-INCHES BELOW EACH JOINT. THE APPROPRIATE COATING SHALL BE APPLIED PRIOR TO APPLYING THE RUBBER COATING. INSIDE JOINTS TO BE FILLED WITH PRECAST PLUM MATERIAL.
 - THE MANHOLE CHIMNEYS, INCLUDING ALL RISER RINGS SHALL BE SEALED USING INTI-SHIELD "UNIBAND" OR APPROVED EQUAL. PRIOR TO PLACEMENT, THE TOP 4-INCHES OF THE EXTEND FROM 3-INCHES BELOW THE TOP OF THE CONE SECTION TO 2-INCHES OVER THE FLANGE OF THE MANHOLE CASTING FRAME.
 - THE CASTING ELEVATIONS ARE SET BY PLAN. HOWEVER, THE CASTINGS ARE TO BE OCCUR BETWEEN PLAN GRADE AND EXISTING GRADE. NEW MANHOLE RING AND COVER SHALL BE INSTALLED TO ESTABLISH GRADE. MAXIMUM HEIGHT OF ADJUSTING RINGS SHALL BE 12-INCHES.
 - BACKFILL AROUND ALL STRUCTURES AND ALL CUTS UNDER PAVED AREAS WITH GRANULAR MATERIAL. TRENCHES OPENING WITHIN 5-FEET OF PAVED ROADWAYS SHALL BE BACKFILLED WITH GRANULAR MATERIAL IN ACCORDANCE WITH SECTION 211. BACKFILL UNDER SIDEWALKS AFTER BACKFILL HAS BEEN IN PLACE.
 - THE CONTRACTOR SHALL BE RESPONSIBLE FOR VERIFYING THAT ALL STATE HIGHWAYS, CITY AND COUNTY PERMITS HAVE BEEN OBTAINED BY THE DEVELOPER PRIOR TO START OF CONSTRUCTION.
 - THE CONTRACTOR SHALL BE REQUIRED TO FURNISH THE DEVELOPER'S ENGINEER WITH A SET OF PRINTS, MARKED IN RED PENCIL, SHOWING ACTUAL SEWER LOCATION AND INVERT, TO BE RECEIVED BY THE ENGINEER BEFORE THE FINAL CONTRACT PAVEMENT CAN BE AUTHORIZED. SURFACE WITH A METAL FLANGE POST SET IMMEDIATELY ABOVE THE SAID TERMINATION POINT.
 - ALL SANITARY SEWER LINES UPON COMPLETION WILL BE REQUIRED TO PASS A LOW PRESSURE AIR TEST. SAID TEST SHALL BE CONDUCTED ACCORDING TO ASTM 1417-92, AND SHALL BE WITNESSED BY AN ENGINEER AND A REPRESENTATIVE OF THE CLAY WASTE DISTRICT. THE TESTING SHALL BE IN ACCORDANCE WITH TABLE 1. ADD 0.5 PSIG FOR EACH FOOT OF WATER ABOVE THE SEWER LINE BEING TESTED.
 - DEFLECTION TESTS SHALL BE PERFORMED ON ALL FLEXIBLE PIPE AFTER THE FINAL BACKFILL HAS BEEN IN PLACE AT LEAST 30 DAYS. NO PIPE SHALL EXCEED A VERTICAL DEFLECTION OF SIX PERCENTUM TEST RESULTS. (NOTE FOLLOWING ARE CONSIDERED NON-FLEXIBLE PIPES: CONCRETE PIPE, DUCTILE IRON PIPE, AND CAST IRON PIPE). THE DEFLECTION TEST SHALL BE PERFORMED WITH A NINE-POINT MANHOLE. PROVING RINGS SHALL BE AVAILABLE.
 - ALL MANHOLE TESTING SHALL BE OBSERVED BY A PROFESSIONAL ENGINEER REPRESENTATIVE CERTIFICATION AND A REPRESENTATIVE OF THE CLAY WASTE DISTRICT.
 - THE ENDS OF LATERALS ARE TO BE PLUGGED TIGHT WITH A BRACED PLUG DISC OR CAP CAPABLE OF WITHSTANDING A LOW PRESSURE AIR TEST WITHOUT LEAKAGE.
 - BEDDING FOR FLEXIBLE PIPE SHALL BE NO. 8 CRUSHED STONE FROM 6-INCHES BELOW THE PIPE TO 12-INCHES ABOVE THE PIPE. BEDDING FOR RIGID PIPE SHALL BE NO. 4 CRUSHED STONE FROM 6-INCHES BELOW THE PIPE TO THE SPRING LINE OF THE PIPE AND FROM THE SPRING LINE TO 12-INCHES ABOVE SHALL BE SILL SAND OR EQUIVALENT. MANHOLES SHALL BE PLACED ON NO LESS THAN 6-INCHES OF NO. 8 CRUSHED STONE BEDDING.
 - WATER AND SEWER LINE CROSSINGS AND SEPARATIONS SHALL BE IN ACCORDANCE WITH 327 IAC 3-6-2.
 - TRENCH SHALL BE OPENED SUFFICIENTLY AHEAD OF PIPE LAYING TO REVEAL OBSTRUCTION, AND SHALL BE PROPERLY PROTECTED AND/OR BARRICADED WHEN LEFT UNATTENDED.
 - NO WATER SHALL BE PERMITTED TO FLOW INTO THE SANITARY SEWER SYSTEM DURING CONSTRUCTION. CONTRACTOR SHALL FURNISH A PUMP TO KEEP THE WATER LEVEL BELOW THE PIPE. PUMP DISCHARGE SHALL BE DIRECTED TO A STORM OUTLET IN ACCORDANCE WITH STATE AND FEDERAL LAWS AND REGULATIONS (327 IAC 3-6-20). ANY PIPE ENTERING SUCH TIME AS ALL TESTS ON THE SEWERS HAVE BEEN COMPLETED AND THE LINES ARE OPENED SHALL BE PLUGGED WITH SCREEN TYPE MECHANICAL BRACED PLUG UNTIL PASSED ALL FINAL TESTS.
 - ALL SEWER LATERALS INSTALLED BY THE MAINLINE CONTRACTOR SHALL BE BEDDED THE SAME AS THE MAIN LINE SEWER.
 - FORTY-EIGHT (48) HOURS NOTICE SHALL BE GIVEN TO THE CLAY REGIONAL WASTE DISTRICT PRIOR TO THE START OF SEWER CONSTRUCTION. ALSO, 48 HOURS NOTICE SHALL BE GIVEN PRIOR TO DOING ANY TESTING ON THE SEWER.
 - MANHOLE CASTINGS SHALL BE STAMPED "SANITARY SEWER" (WEDMAN CASTING R 16424 OR EQUAL) AND BE SELF-SEALING TYPE. THE CASTING FLANGE SHALL BE 34 INCHES AND THE R-1916-F1 AND STAMPED "SANITARY SEWER".
 - THE MINIMUM SLOPE FOR SEWER ACCEPTANCE BY THE CLAY TOWNSHIP REGIONAL WASTE DISTRICT ARE:

SIZE OF PIPE	MINIMUM CONSTRUCTED SLOPE
8-INCH	0.41%
10-INCH	0.28%
12-INCH	0.22%
14-INCH	0.18%
15-INCH	0.12%
18-INCH	0.12%
 - THE CONTRACTOR SHALL PROVIDE MEASUREMENTS OF THE SLOPE OF THE SEWER FOR EACH MANHOLE SECTION AS CONSTRUCTION PROGRESSES. SUCH MEASUREMENTS SHALL BE CERTIFIED BY A REGISTERED LAND SURVEYOR OR ENGINEER AND BE AVAILABLE ON-SITE FOR OBSERVATION BY THE DISTRICT'S INSPECTOR. NO MORE THAN THREE MANHOLE SECTIONS CAN BE CONSTRUCTED IN ADVANCE OF SUCH MEASUREMENTS.
 - IN THE EVENT THE CONTRACTOR DOES NOT MEET THE MINIMUM SLOPES, THE SEWER SECTION MINIMUM SLOPES.
 - LATERALS ARE TO BE TRACED WITH A MINIMUM SIZE OF 14 GAUGE WIRE FROM THE WYE TO THE TERMINUS. THE CONTRACTOR FOR THE BUILDING OR HOME WILL EXTEND THE WIRE FROM THIS TERMINUS TO THE BUILDING CEMENT ADJACENT TO THE BUILDING.

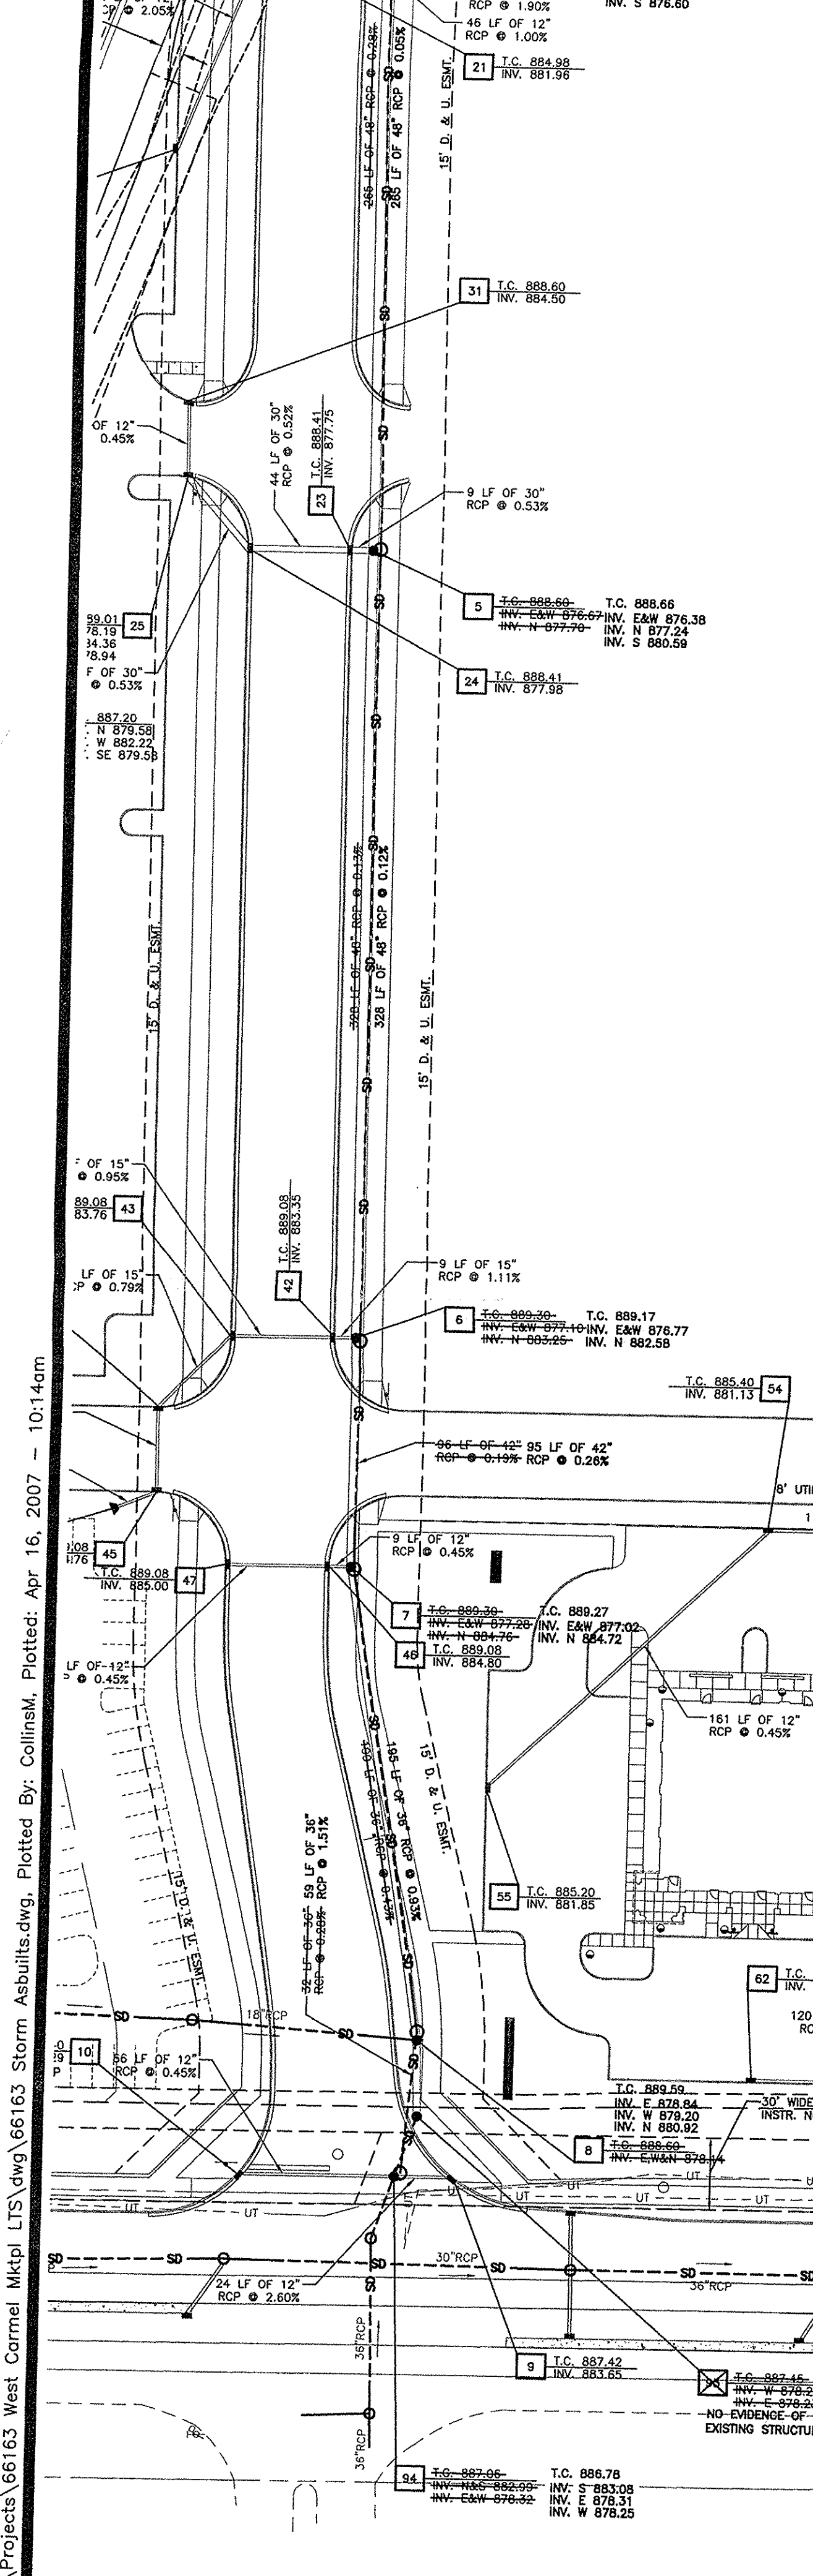

STORM SEWER AS-BUILT



This information was gathered for input into the Hamilton County Geographic Information System (GIS). This document is considered an official record of the GIS.

Entry Date: Dec 2008


Entered By: SLM



LAST SAVED BY: mcgoughsls, OCT 06, 2006 - 13:42:19
G:\SW\Projects\66163 West Carmel Mktpl LTS.dwg 66163 Storm Asbuilts.dwg, Plotted: Apr 16, 2007 - 10:14am
Xrefs:

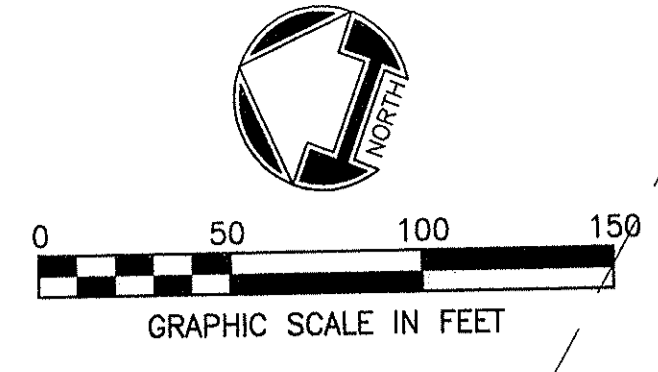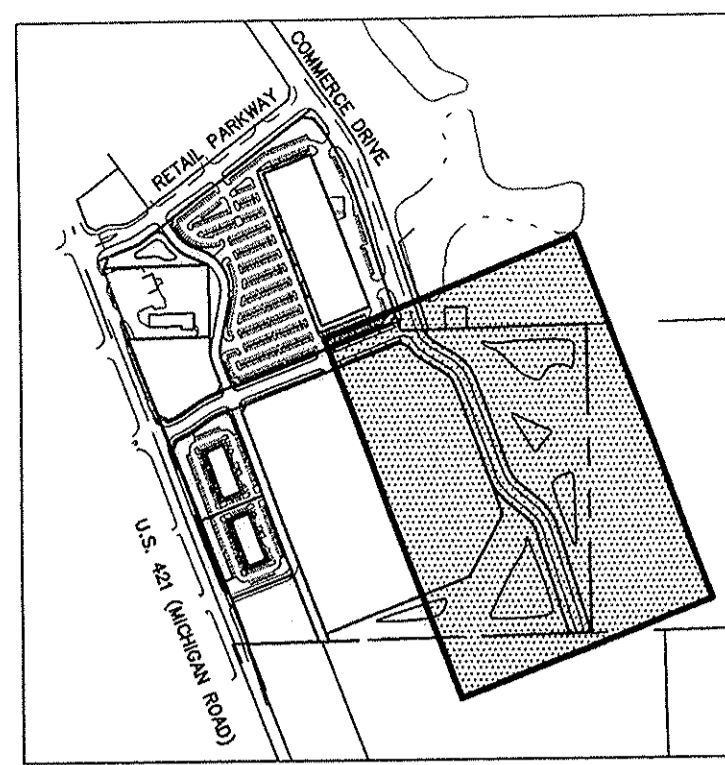

This information was gathered for input into the Hamilton County Geographic Information System (GIS). This document is considered an official record of the GIS.
Entry Date: Dec 2008
Entered By: GJM

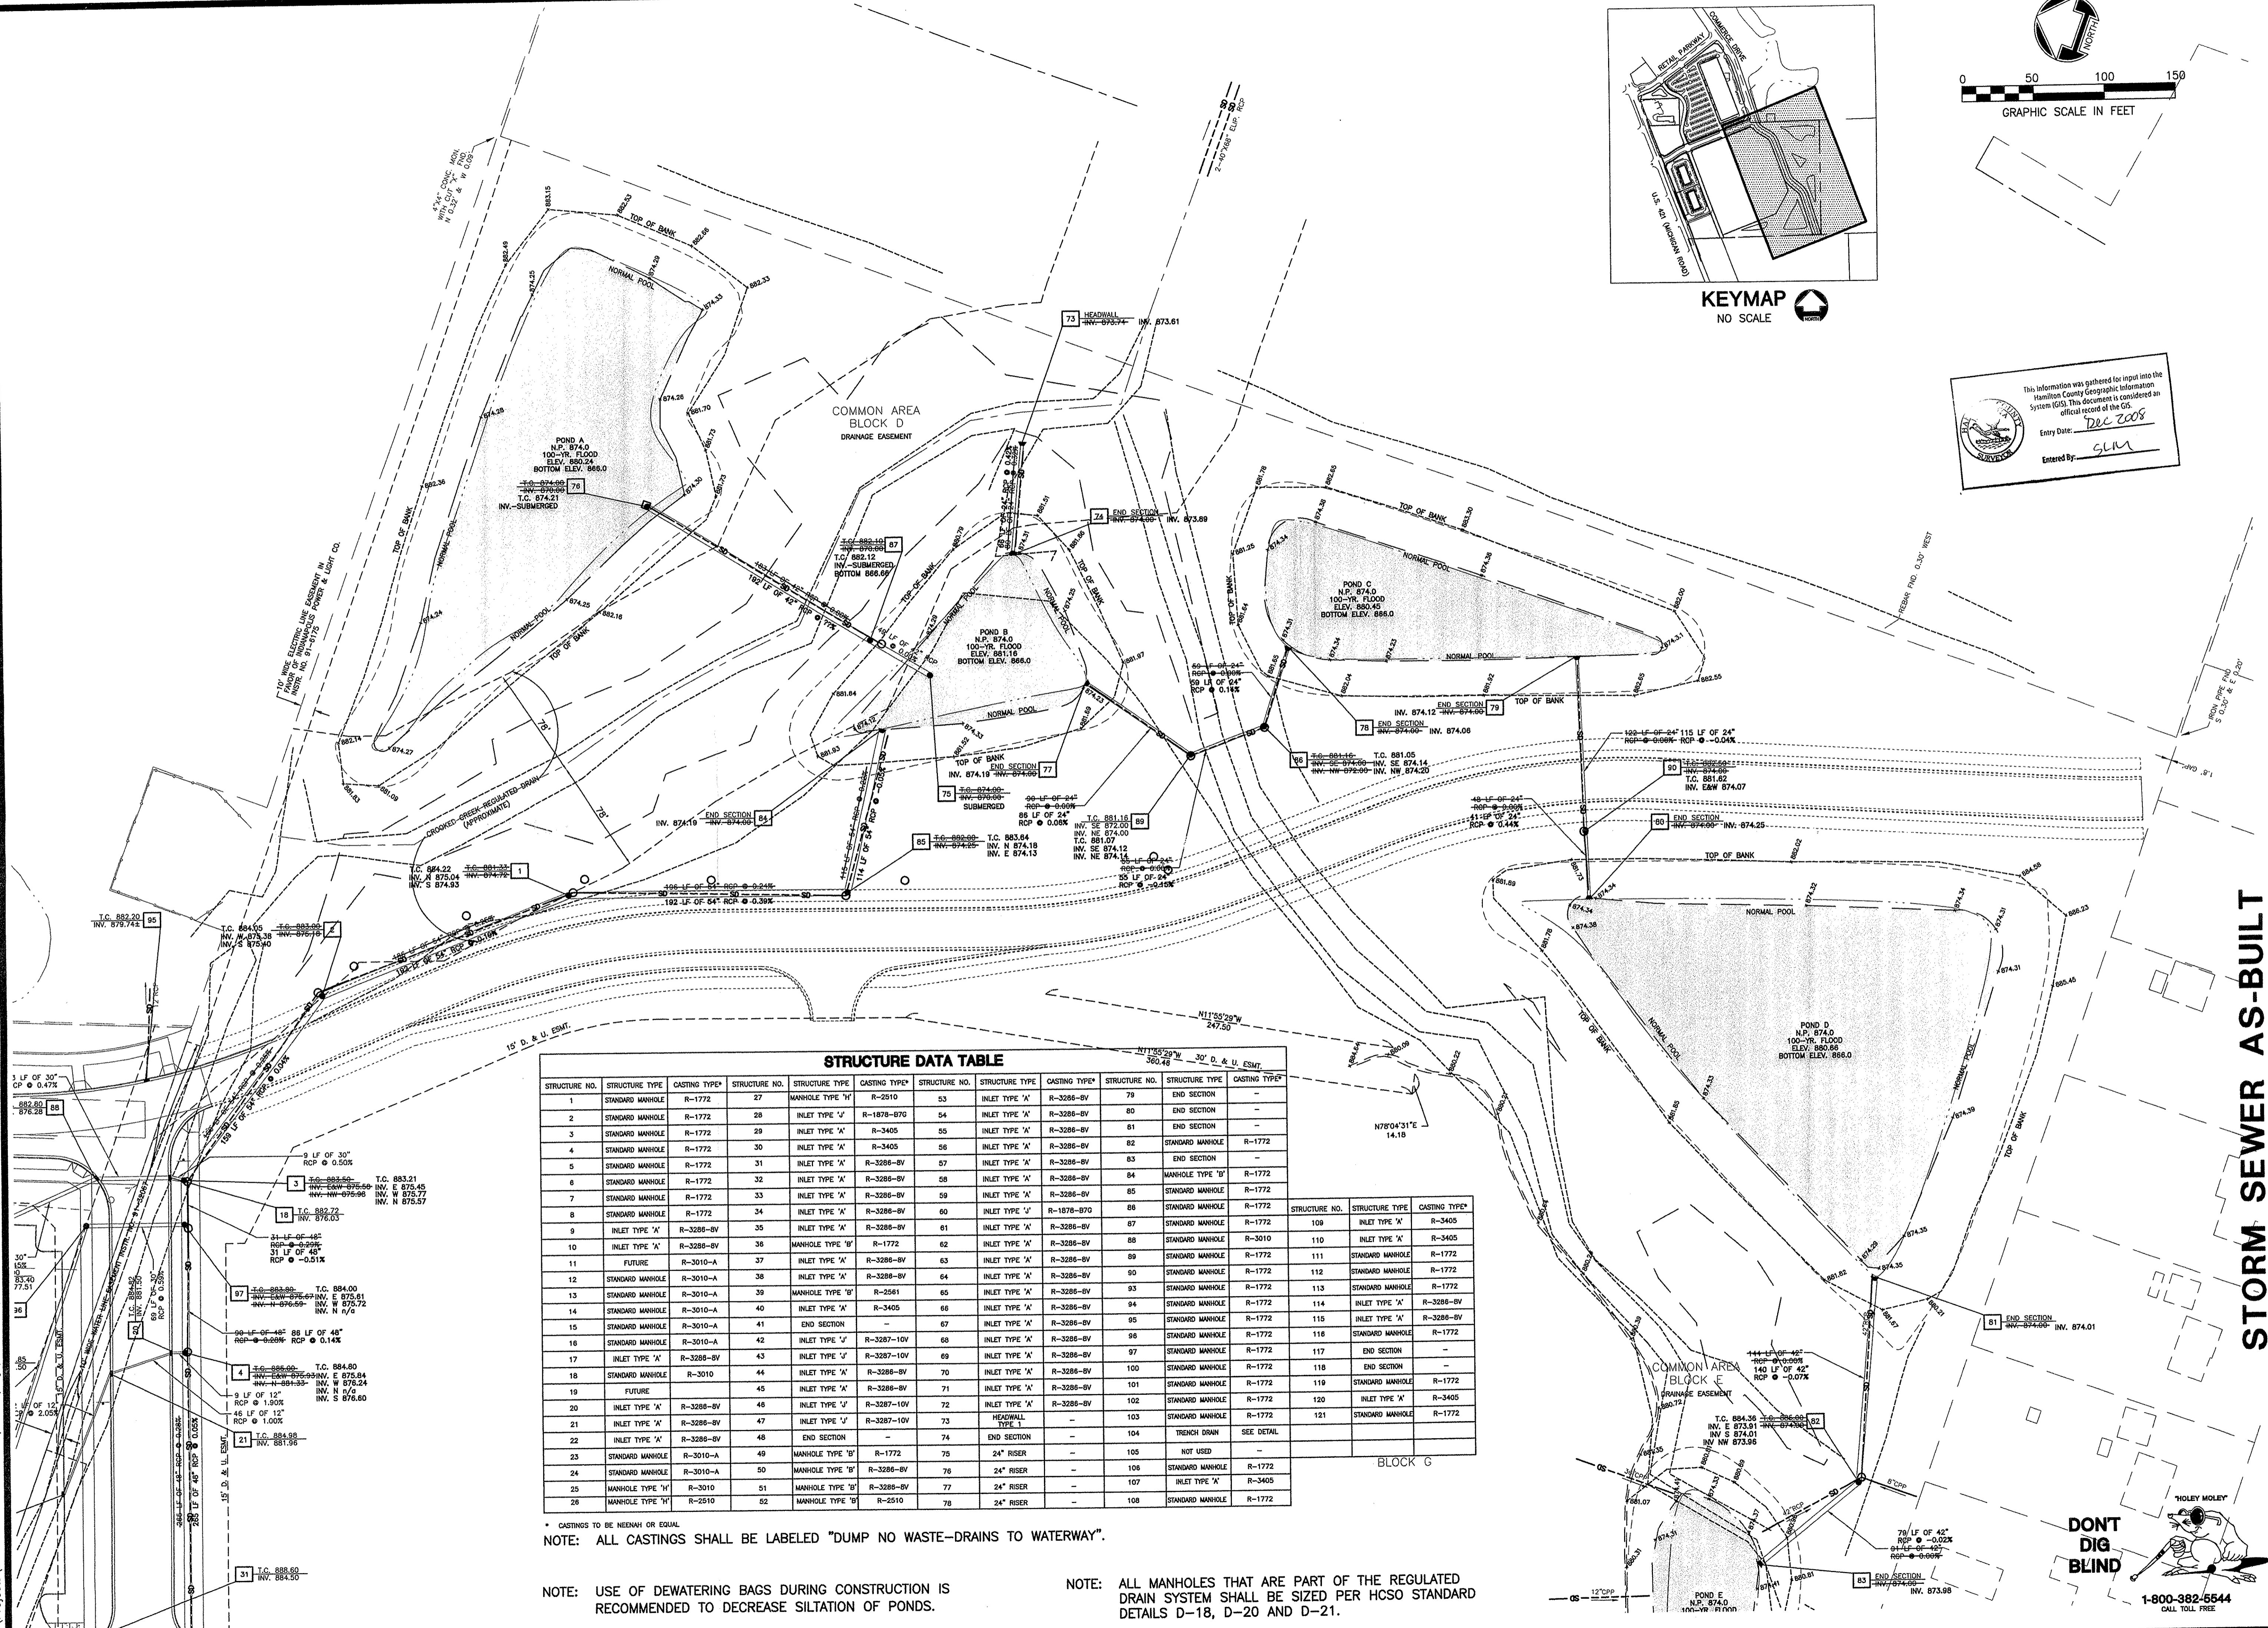

STRUCTURE DATA TABLE											
STRUCTURE NO.	STRUCTURE TYPE	CASTING TYPE*	STRUCTURE NO.	STRUCTURE TYPE	CASTING TYPE*	STRUCTURE NO.	STRUCTURE TYPE	CASTING TYPE*	STRUCTURE NO.	STRUCTURE TYPE	CASTING TYPE*
1	STANDARD MANHOLE	R-1772	27	MANHOLE TYPE 'H'	R-2510	53	INLET TYPE 'A'	R-3286-BV	79	END SECTION	-
2	STANDARD MANHOLE	R-1772	28	INLET TYPE 'X'	R-1878-B70	54	INLET TYPE 'A'	R-3286-BV	80	END SECTION	-
3	STANDARD MANHOLE	R-1772	29	INLET TYPE 'X'	R-3405	55	INLET TYPE 'A'	R-3286-BV	81	END SECTION	-
4	STANDARD MANHOLE	R-1772	30	INLET TYPE 'X'	R-3405	56	INLET TYPE 'A'	R-3286-BV	82	STANDARD MANHOLE	R-1772
5	STANDARD MANHOLE	R-1772	31	INLET TYPE 'X'	R-3286-BV	57	INLET TYPE 'A'	R-3286-BV	83	END SECTION	-
6	STANDARD MANHOLE	R-1772	32	INLET TYPE 'X'	R-3286-BV	58	INLET TYPE 'A'	R-3286-BV	84	MANHOLE TYPE 'B'	R-1772
7	STANDARD MANHOLE	R-1772	33	INLET TYPE 'X'	R-3286-BV	59	INLET TYPE 'A'	R-3286-BV	85	STANDARD MANHOLE	R-1772
8	STANDARD MANHOLE	R-1772	34	INLET TYPE 'X'	R-3286-BV	60	INLET TYPE 'U'	R-1878-B70	86	STANDARD MANHOLE	R-1772
9	INLET TYPE 'A'	R-3286-BV	35	INLET TYPE 'X'	R-3286-BV	61	INLET TYPE 'A'	R-3286-BV	87	STANDARD MANHOLE	R-1772
10	INLET TYPE 'A'	R-3286-BV	36	MANHOLE TYPE 'B'	R-1772	62	INLET TYPE 'A'	R-3286-BV	88	STANDARD MANHOLE	R-3010
11	FUTURE	R-3010-A	37	INLET TYPE 'X'	R-3286-BV	63	INLET TYPE 'A'	R-3286-BV	89	STANDARD MANHOLE	R-1772
12	STANDARD MANHOLE	R-3010-A	38	INLET TYPE 'X'	R-3286-BV	64	INLET TYPE 'A'	R-3286-BV	90	STANDARD MANHOLE	R-1772
13	STANDARD MANHOLE	R-3010-A	39	MANHOLE TYPE 'B'	R-2561	65	INLET TYPE 'X'	R-3286-BV	93	STANDARD MANHOLE	R-1772
14	STANDARD MANHOLE	R-3010-A	40	INLET TYPE 'X'	R-3405	66	INLET TYPE 'X'	R-3286-BV	94	STANDARD MANHOLE	R-1772
15	STANDARD MANHOLE	R-3010-A	41	END SECTION	-	67	INLET TYPE 'A'	R-3286-BV	95	STANDARD MANHOLE	R-1772
16	STANDARD MANHOLE	R-3010-A	42	INLET TYPE 'U'	R-3287-10V	68	INLET TYPE 'A'	R-3286-BV	96	STANDARD MANHOLE	R-1772
17	INLET TYPE 'X'	R-3286-BV	43	INLET TYPE 'U'	R-3287-10V	69	INLET TYPE 'A'	R-3286-BV	97	STANDARD MANHOLE	R-1772
18	STANDARD MANHOLE	R-3010-A	44	INLET TYPE 'X'	R-3286-BV	70	INLET TYPE 'X'	R-3286-BV	100	STANDARD MANHOLE	R-1772
19	FUTURE	-	45	INLET TYPE 'X'	R-3286-BV	71	INLET TYPE 'X'	R-3286-BV	101	STANDARD MANHOLE	R-1772
20	INLET TYPE 'A'	R-3286-BV	46	INLET TYPE 'U'	R-3287-10V	72	INLET TYPE 'X'	R-3286-BV	102	STANDARD MANHOLE	R-1772
21	INLET TYPE 'A'	R-3286-BV	47	INLET TYPE 'U'	R-3287-10V	73	HEADWALL TYPE 1	-	103	STANDARD MANHOLE	R-1772
22	INLET TYPE 'X'	R-3286-BV	48	END SECTION	-	74	END SECTION	-	104	TRENCH DRAIN	SEE DETAIL
23	STANDARD MANHOLE	R-3010-A	49	MANHOLE TYPE 'B'	R-1772	75	24" RISER	-	105	NOT USED	-
24	STANDARD MANHOLE	R-3010-A	50	MANHOLE TYPE 'B'	R-3286-BV	76	24" RISER	-	106	STANDARD MANHOLE	R-1772
25	MANHOLE TYPE 'H'	R-3010	51	MANHOLE TYPE 'B'	R-3286-BV	77	24" RISER	-	107	INLET TYPE 'X'	R-3405
26	MANHOLE TYPE 'H'	R-2510	52	MANHOLE TYPE 'B'	R-2510	78	24" RISER	-	108	STANDARD MANHOLE	R-1772









* CASTINGS TO BE NEARBY OR EQUAL
NOTE: ALL CASTINGS SHALL BE LABELED "DUMP NO WASTE--DRAINS TO WATERWAY".

NOTE: USE OF DEWATERING BAGS DURING CONSTRUCTION IS RECOMMENDED TO DECREASE SILTATION OF PONDS.







NOTE: ALL MANHOLES THAT ARE PART OF THE REGULATED DRAIN SYSTEM SHALL BE SIZED PER HCSD STANDARD DETAILS D-18, D-20 AND D-21.








1-800-382-5544
CALL TOLL FREE

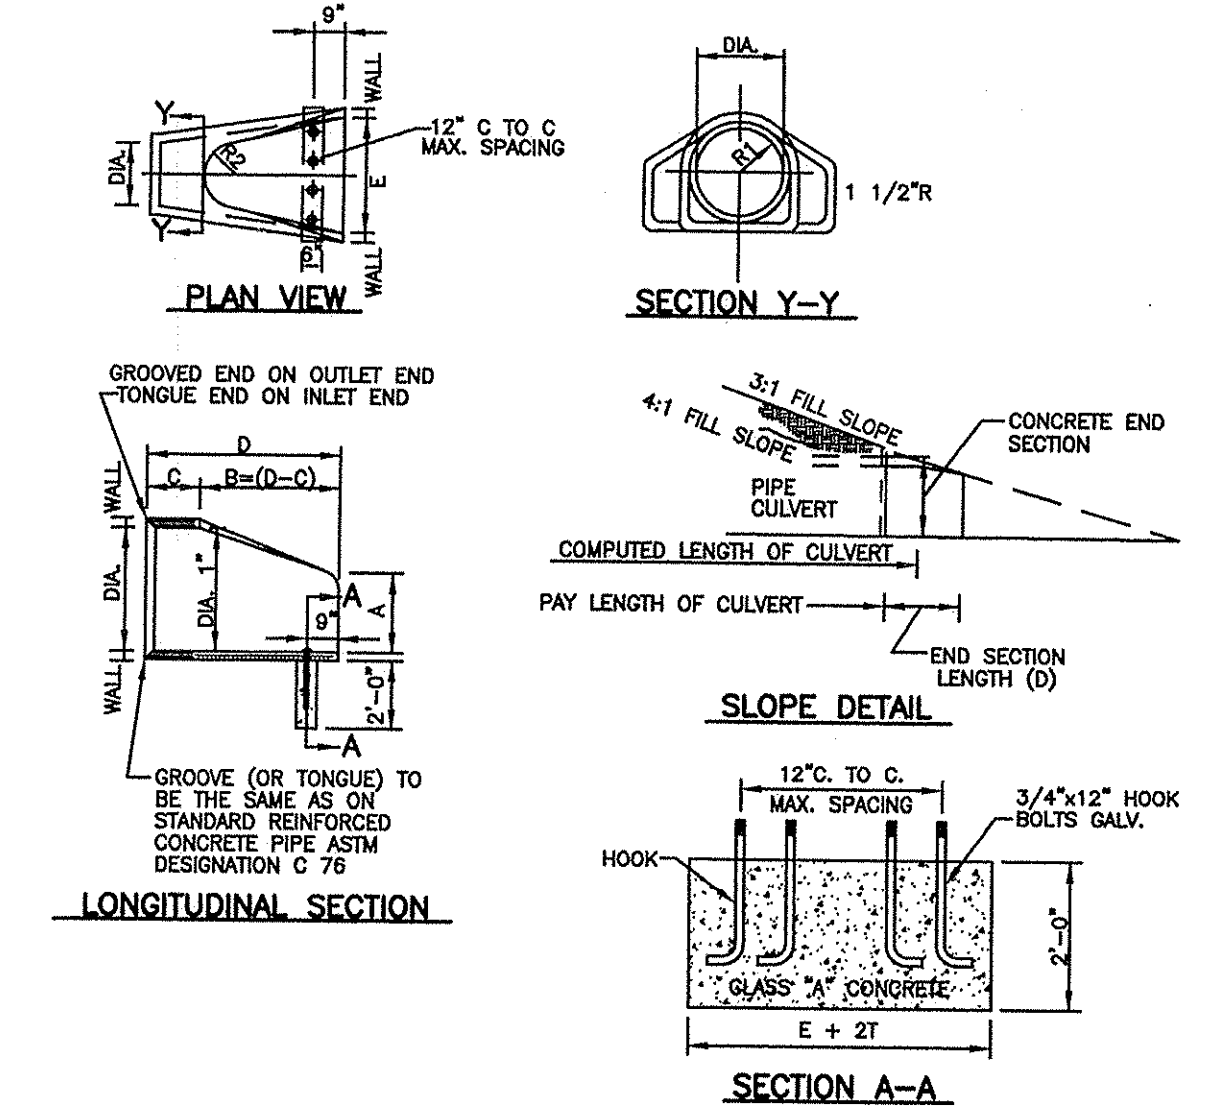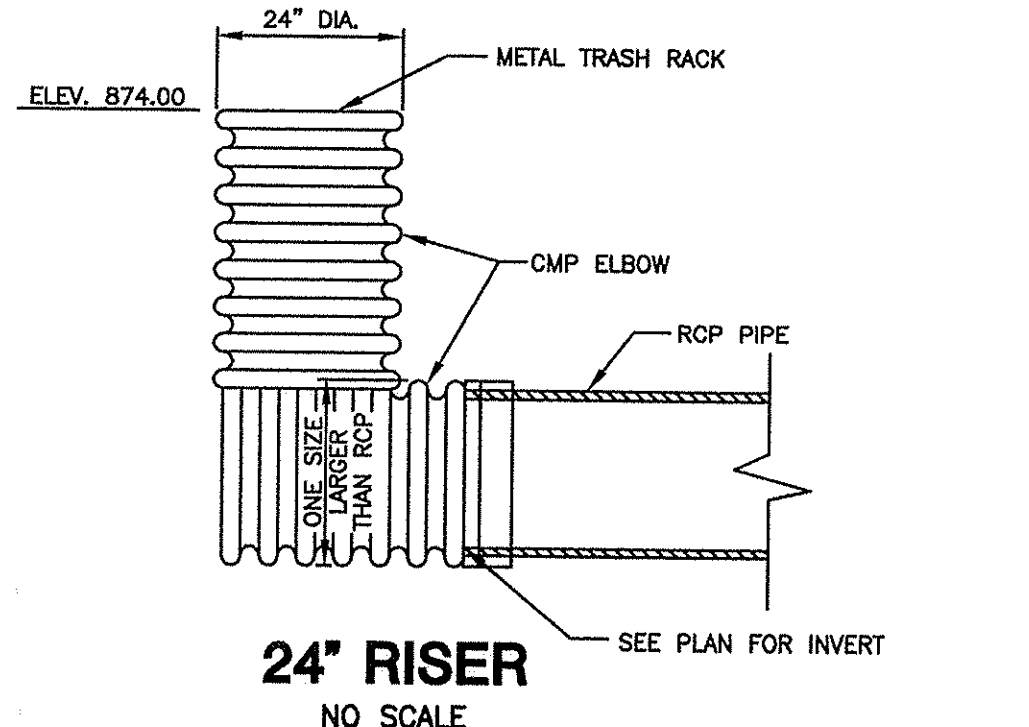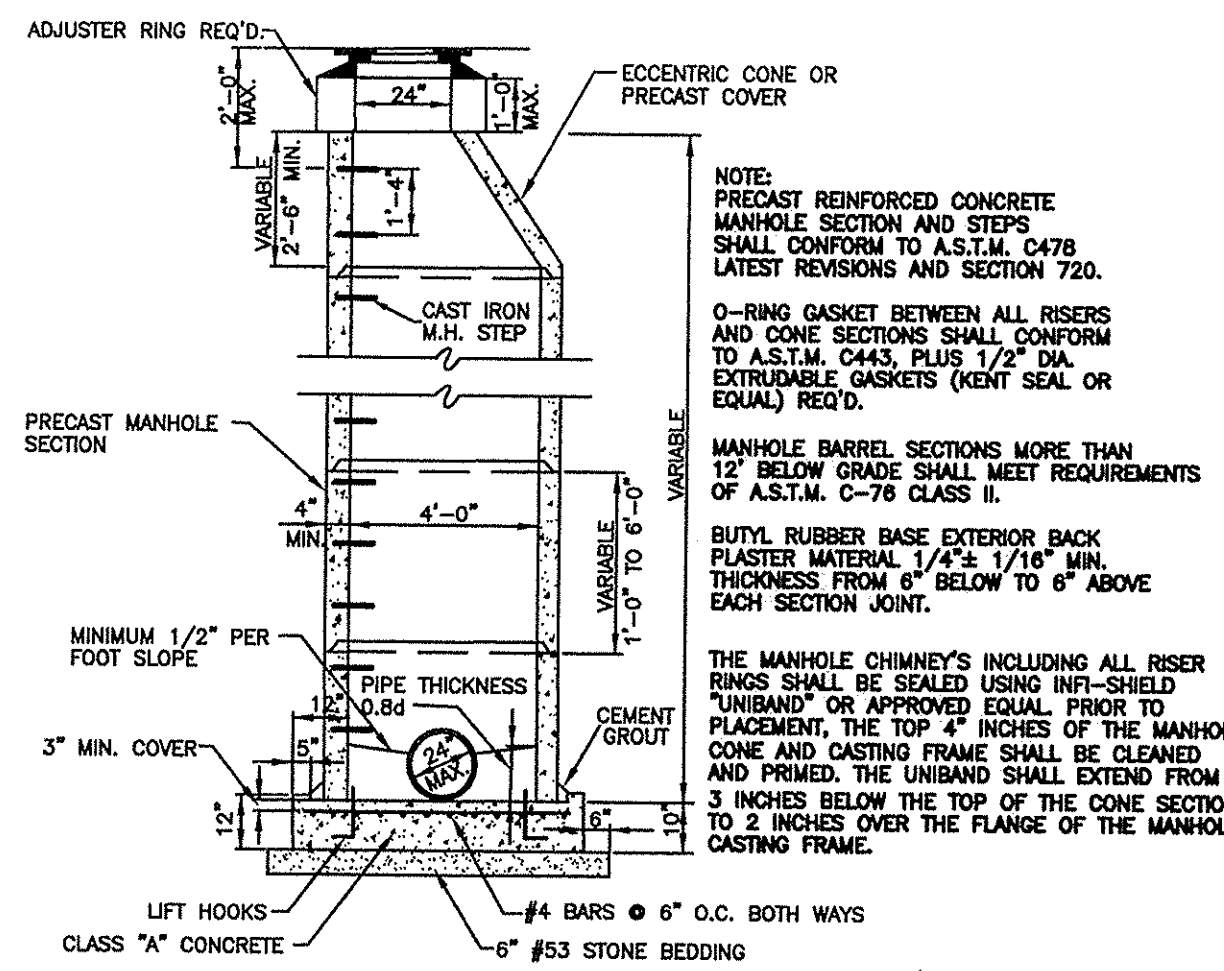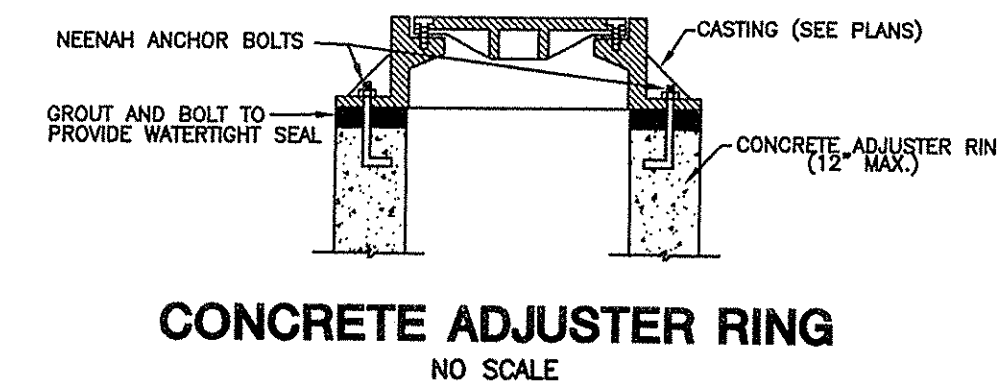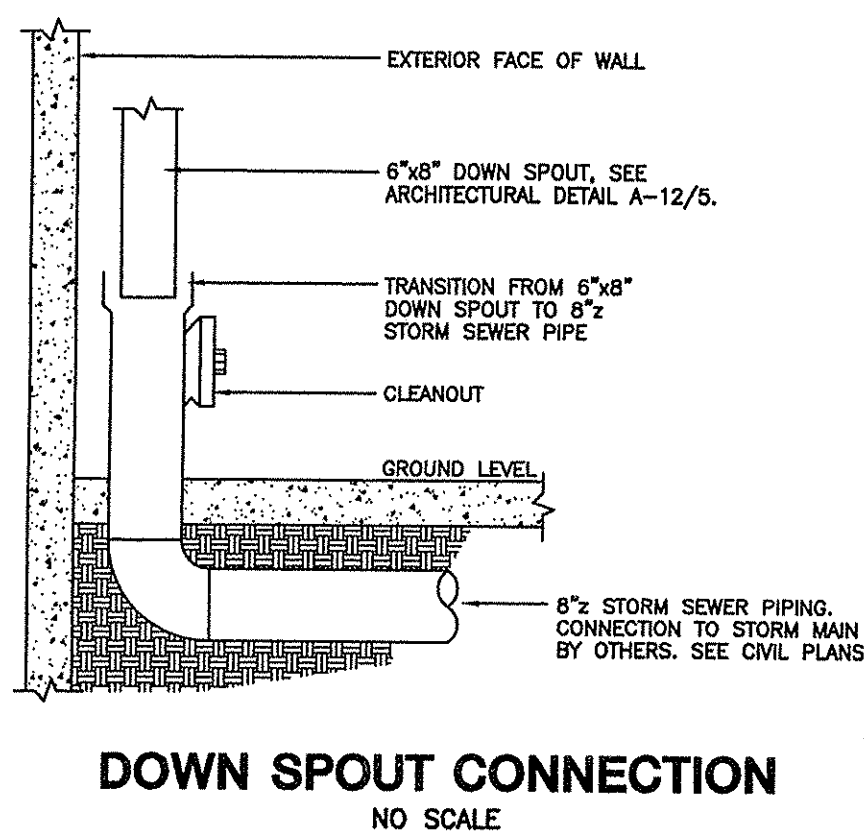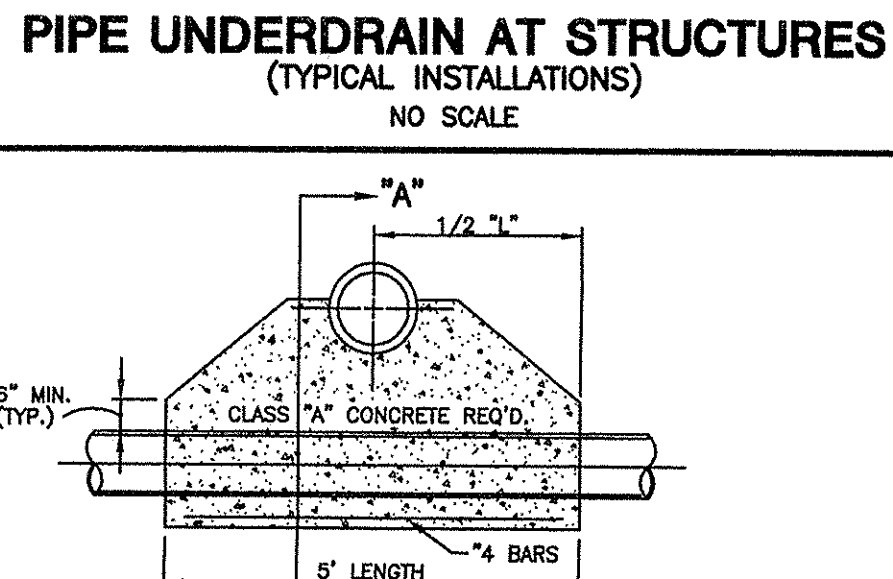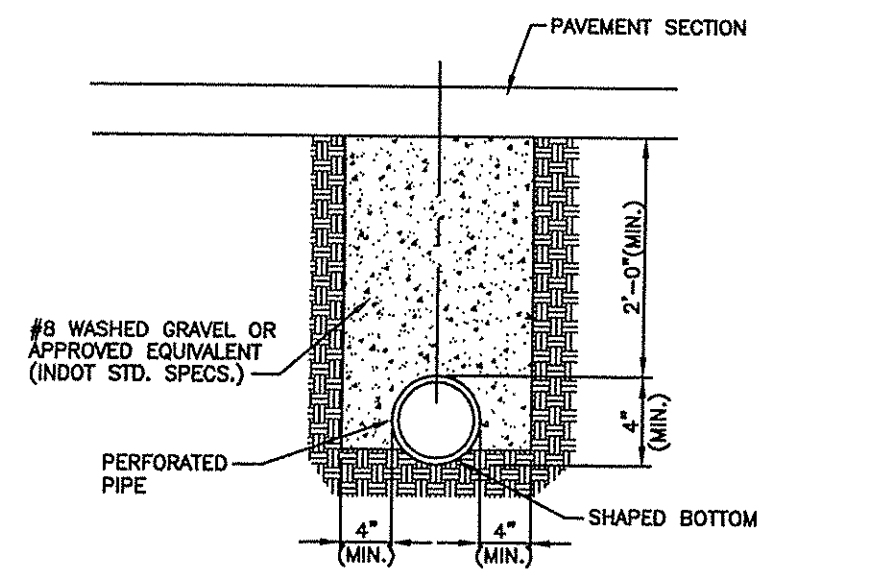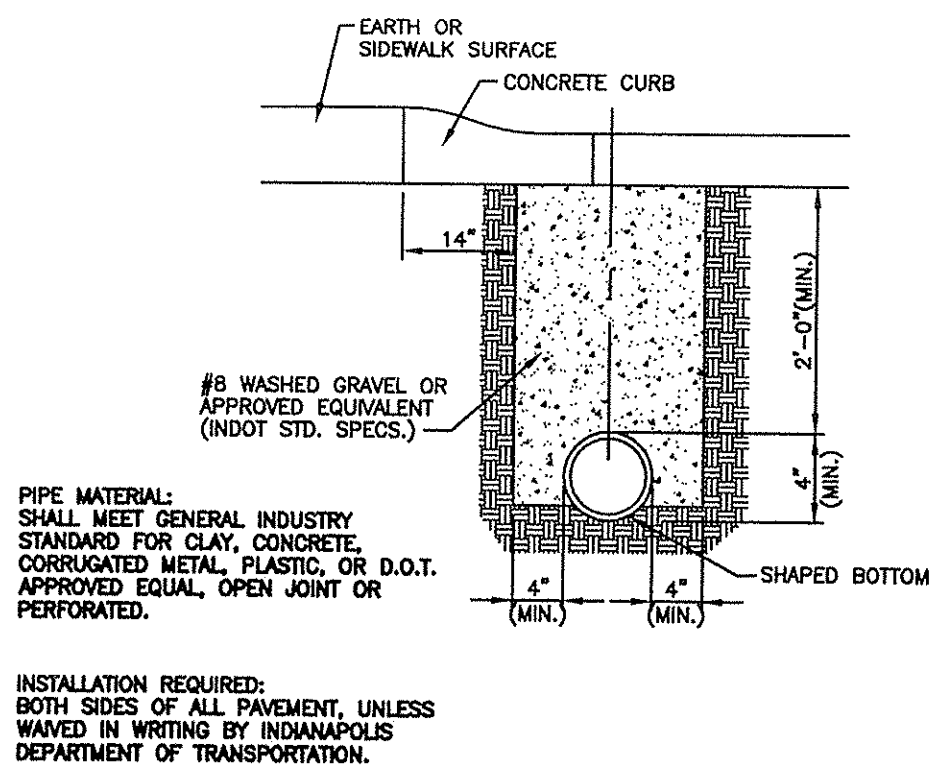

DIA.	WALL	WT. SEC.	A	B	C	D	E	R-1	R-2	SKIRT		
12	2	530	4	24	48	7/8	72	7/8	24	10 1/16	9	3 1/2
15	2 1/4	740	6	27	46	7/8	73	30	12 1/2	11	3 1/2	
18	2 1/2	990	9	27	46	7/8	73	38	16 1/2	12	4	
21	2 3/4	1290	9	38	58	7/8	73	42	16 1/8	13	4	
24	3	1590	9 1/2	43	1/2	33	73 1/2	48	17 3/4	14 1/2	4 1/2	
27	3 1/4	1930	10 1/2	48	25 1/2	73 1/2	54	48	16 11/16	14	4 1/2	
30	3 1/2	2190	12	54	19 3/4	73 3/4	60	18 5/16	15	5		
33	3 3/4	3150	13 1/2	58 1/2	39 1/4	97 3/4	66	23 3/4	17 1/2	5 1/2		
36	4	4100	15	63	34 3/4	97 3/4	72	27 1/4	22	5 1/2		
42	4 1/2	5390	21	83	35	98	78	27 1/4	22	5 3/4		
48	5	6950	24	72	28	98	84	28 1/8	22	5 3/4		
54	5 1/2	8040	27	65	35	100	90	32 7/8	24	6 1/4		
60	6	8750	30	60	39	99	96	36 3/4	24	6 3/4		
66	6 1/2	10630	24	78	21	99	102	35 11/16	24	7 1/4		
72	7	12520	34	78	21	99	108	38 5/8	24	7 3/4		
78	7 1/2	14430	24	78	21	99	114	41 15/16	24	8 1/2		
84	8	16350	24	78	21	99	120	44 13/16	24	9		

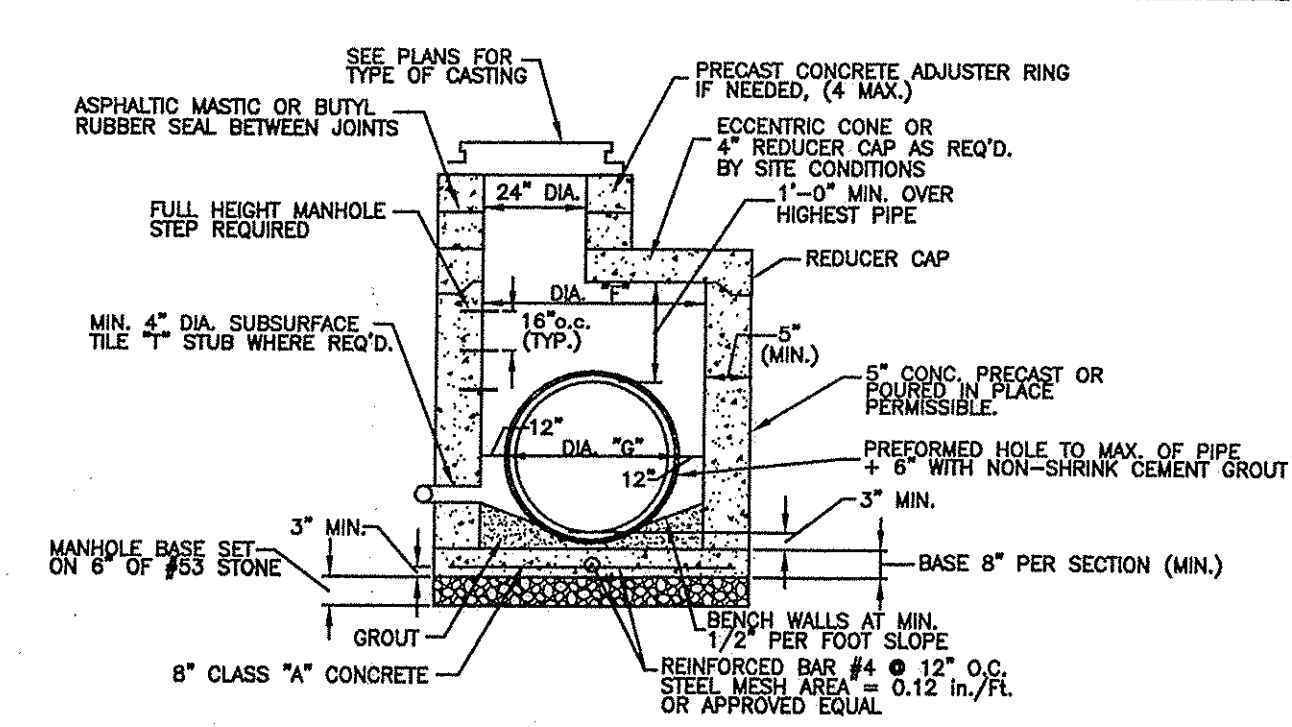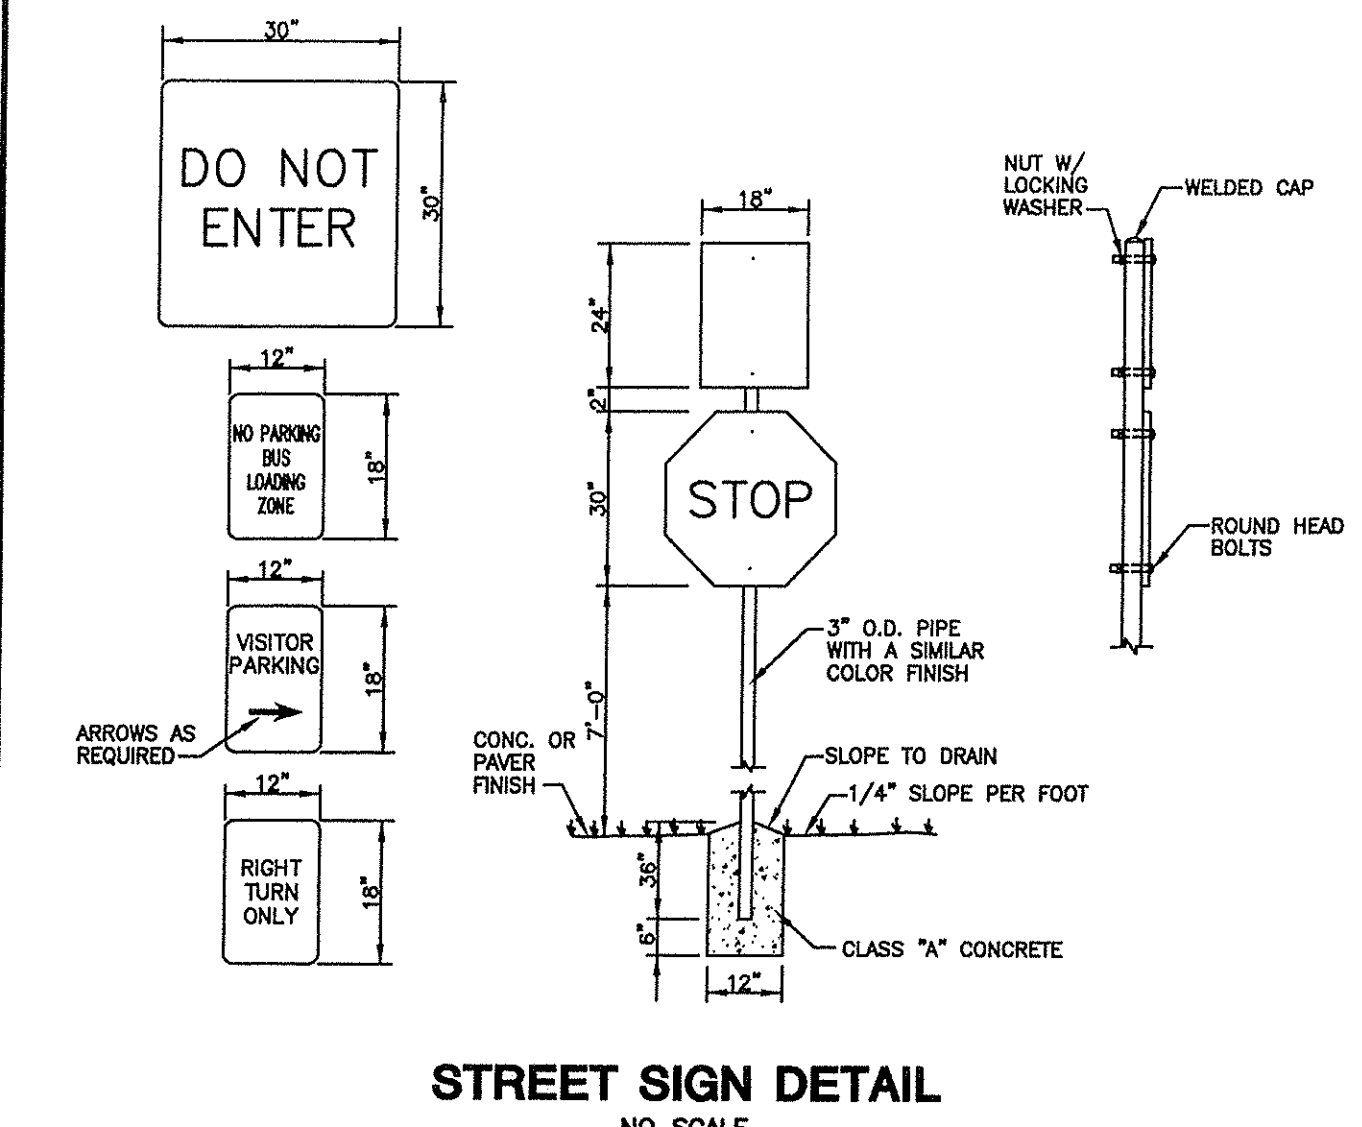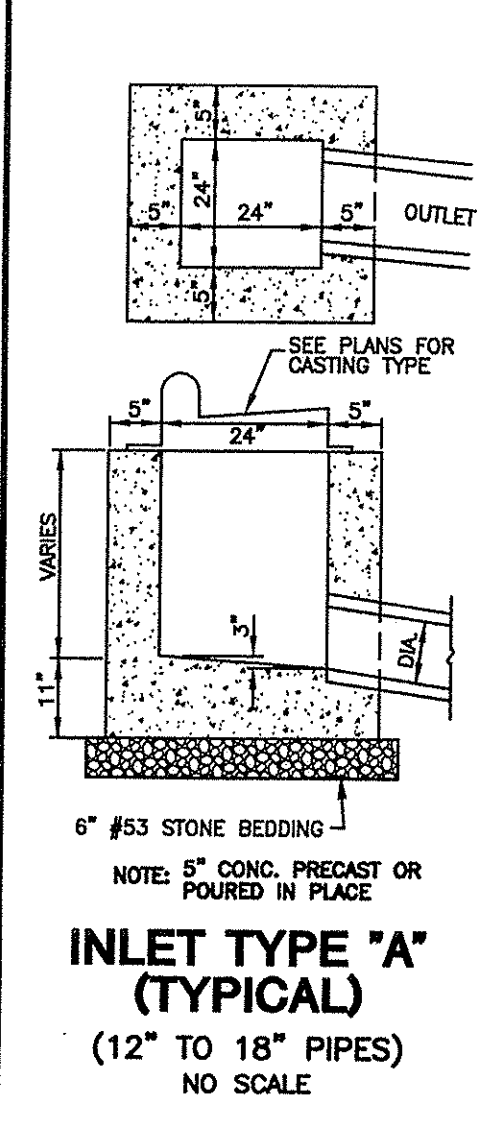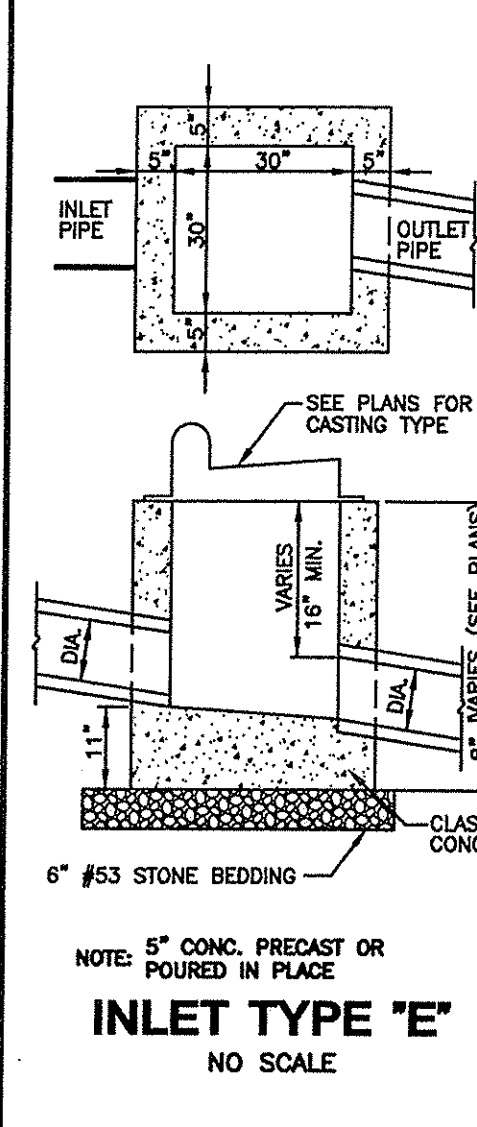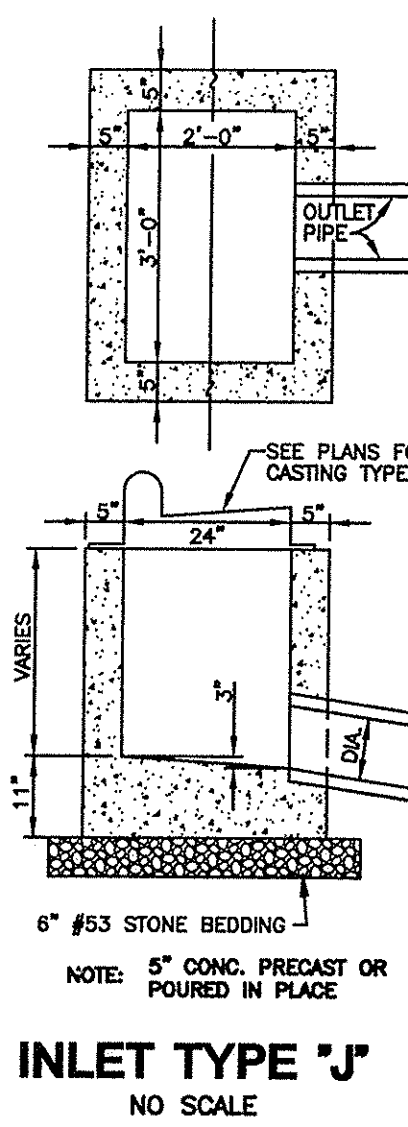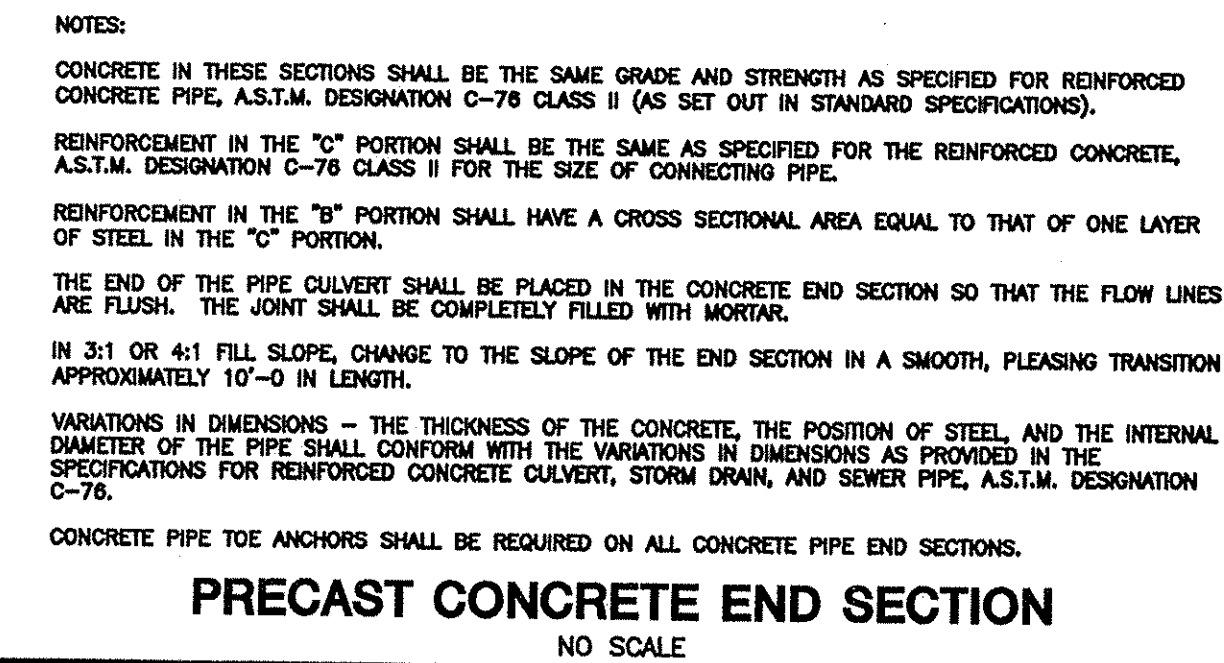

MANHOLE DIA. "E"	PIPE DIA. "G"	PIPE TURNS
36"	48"	GREATER THAN 45° TO 90° UP TO 80°
48"	58"	GREATER THAN 45° TO 90° UP TO 80°
60"	68"	GREATER THAN 45° TO 90° UP TO 80°
1500"	1268"	GREATER THAN 45° TO 90° UP TO 80°

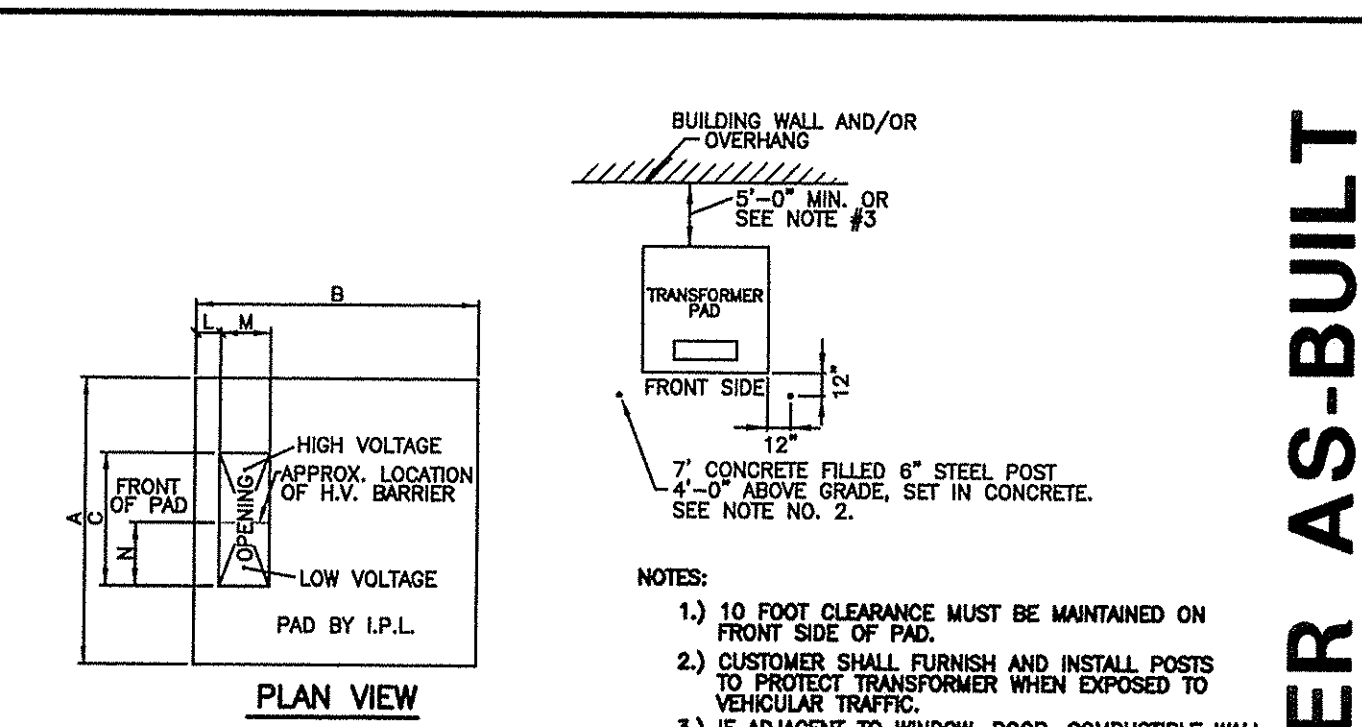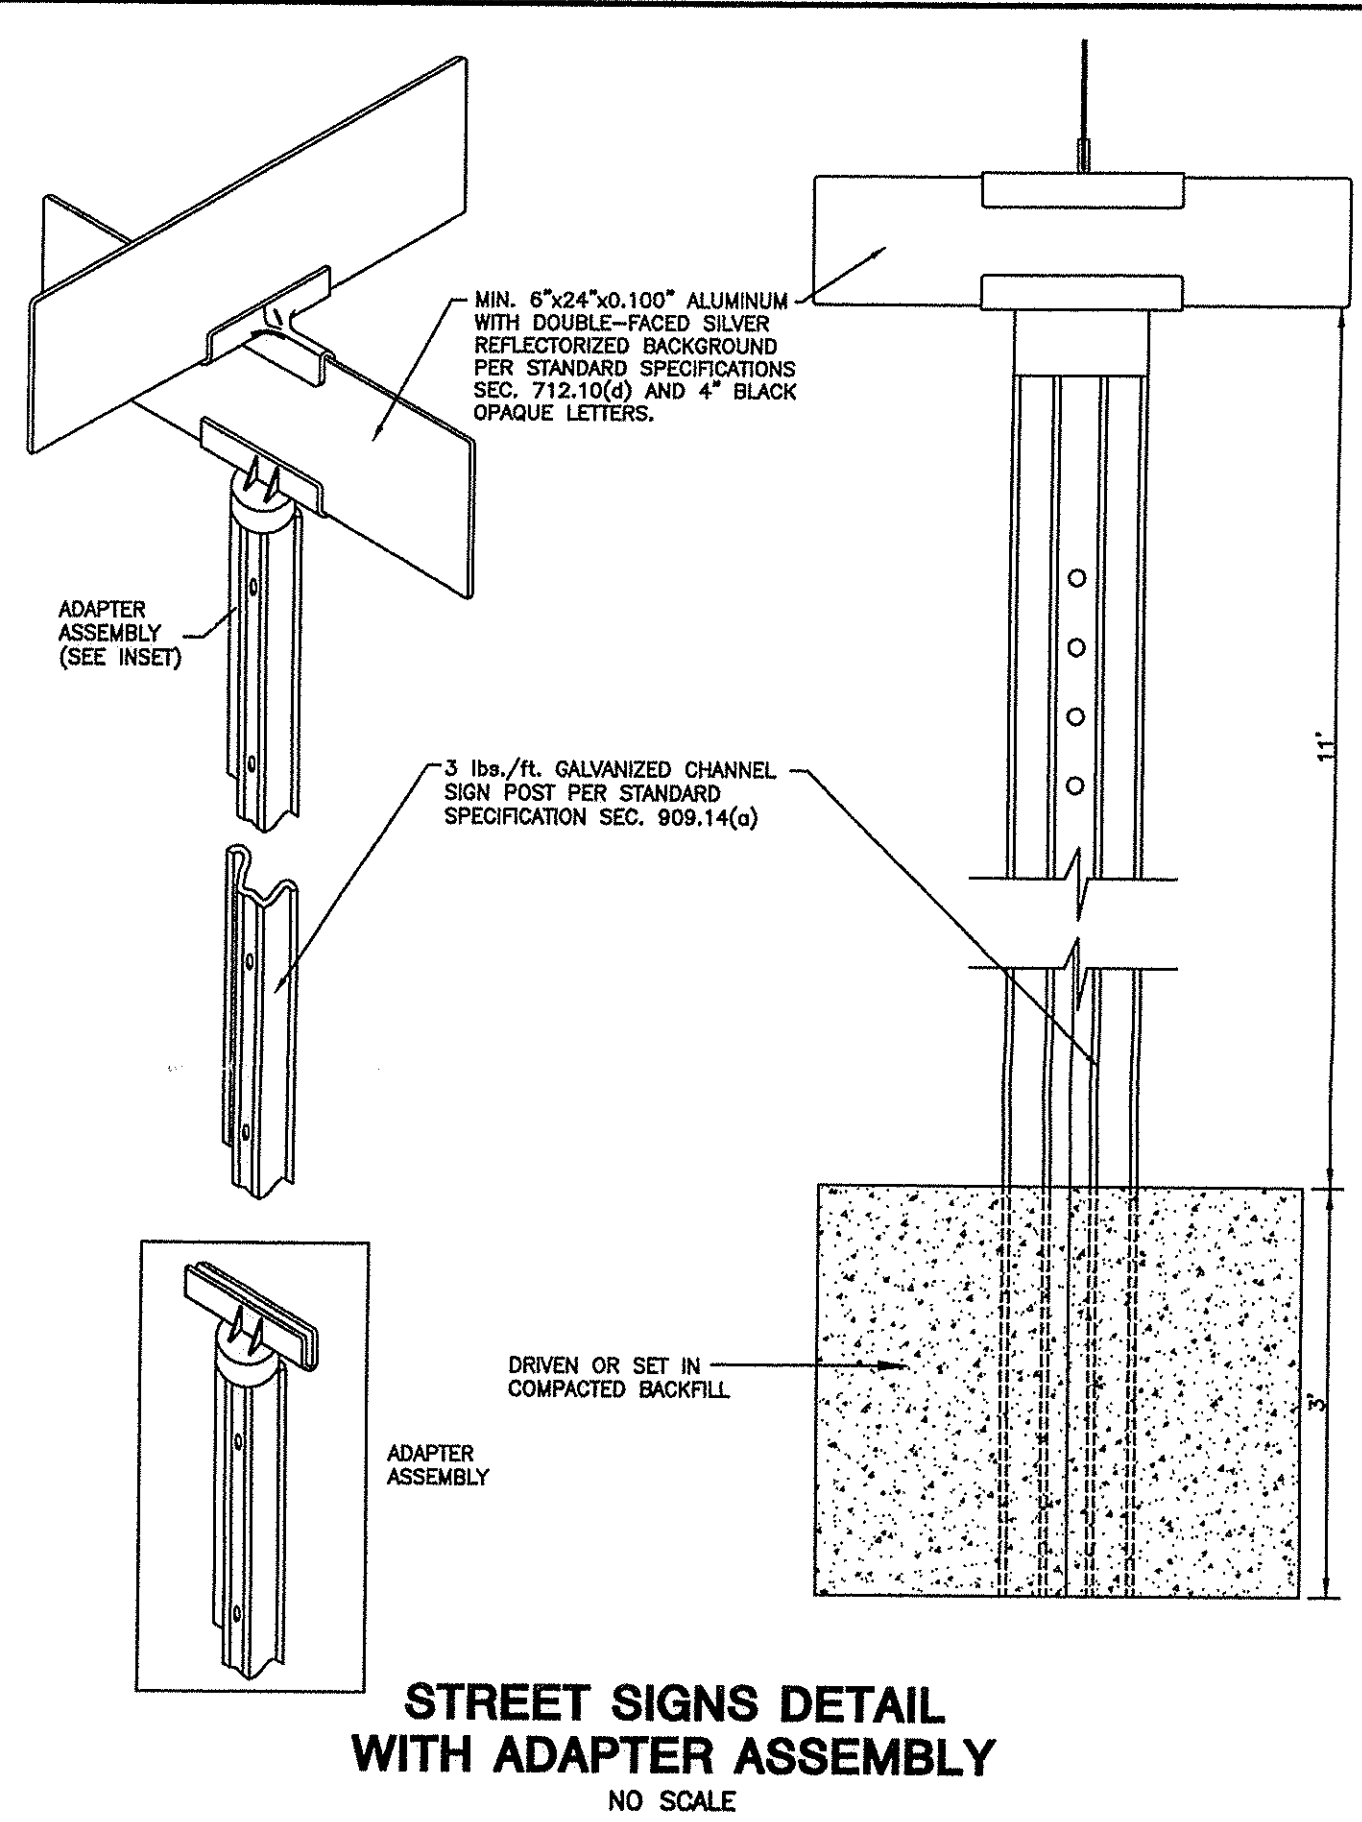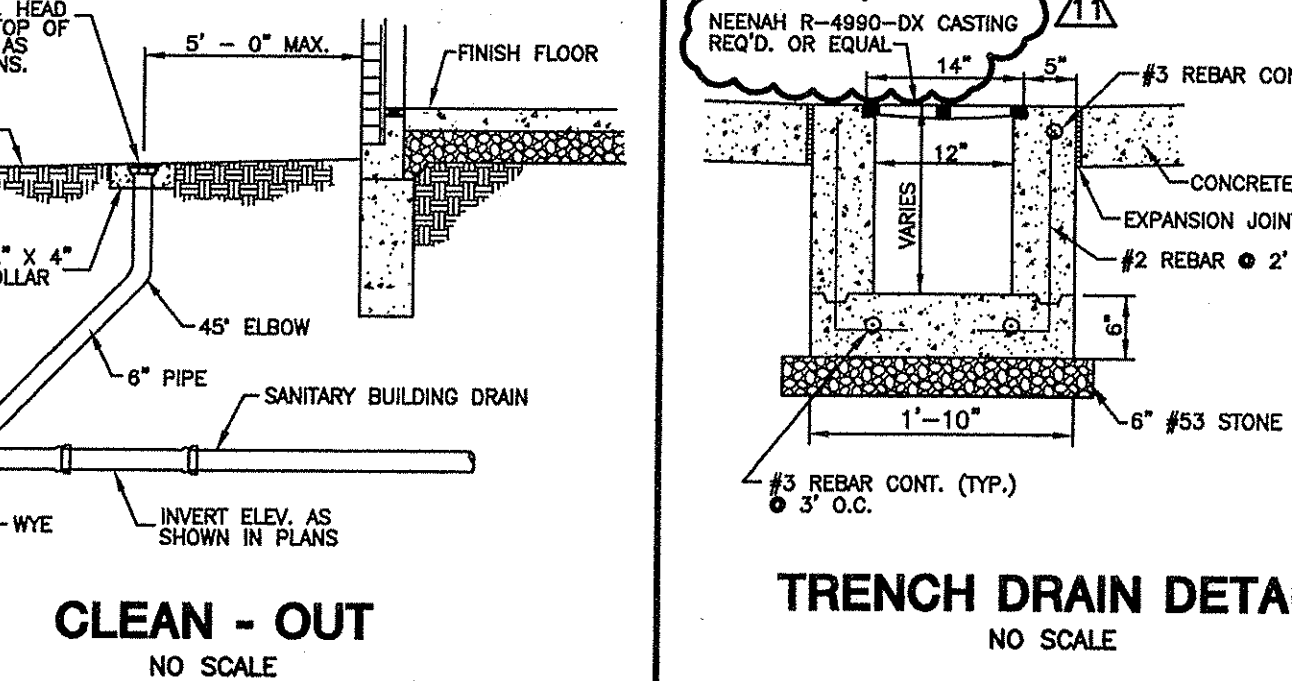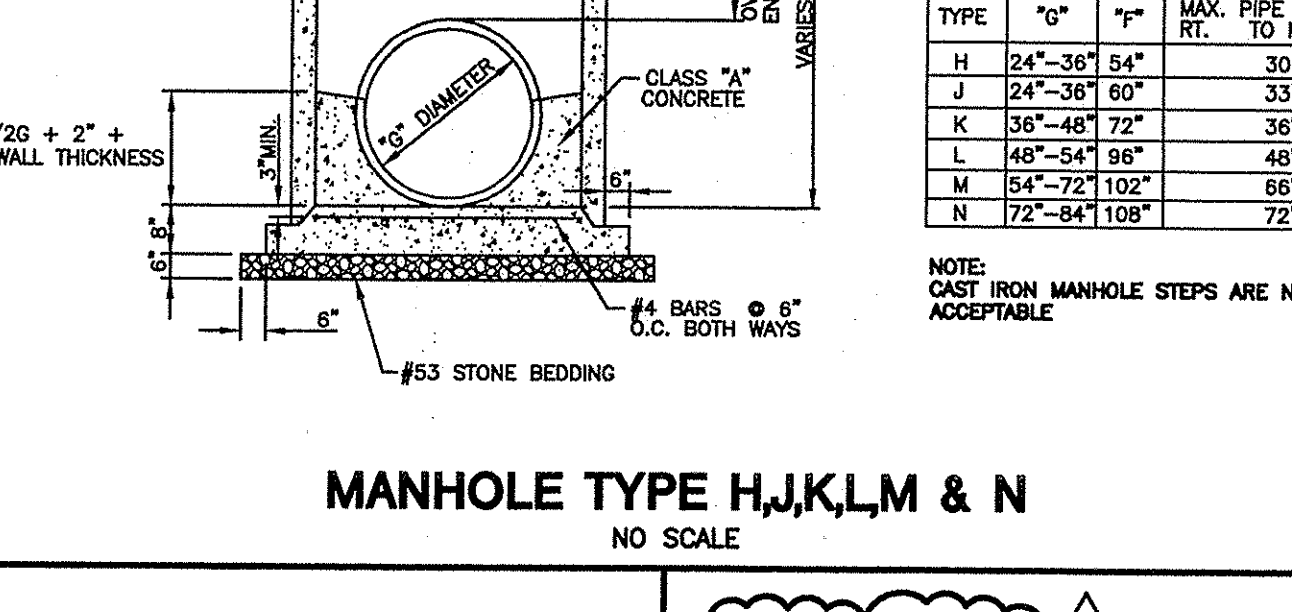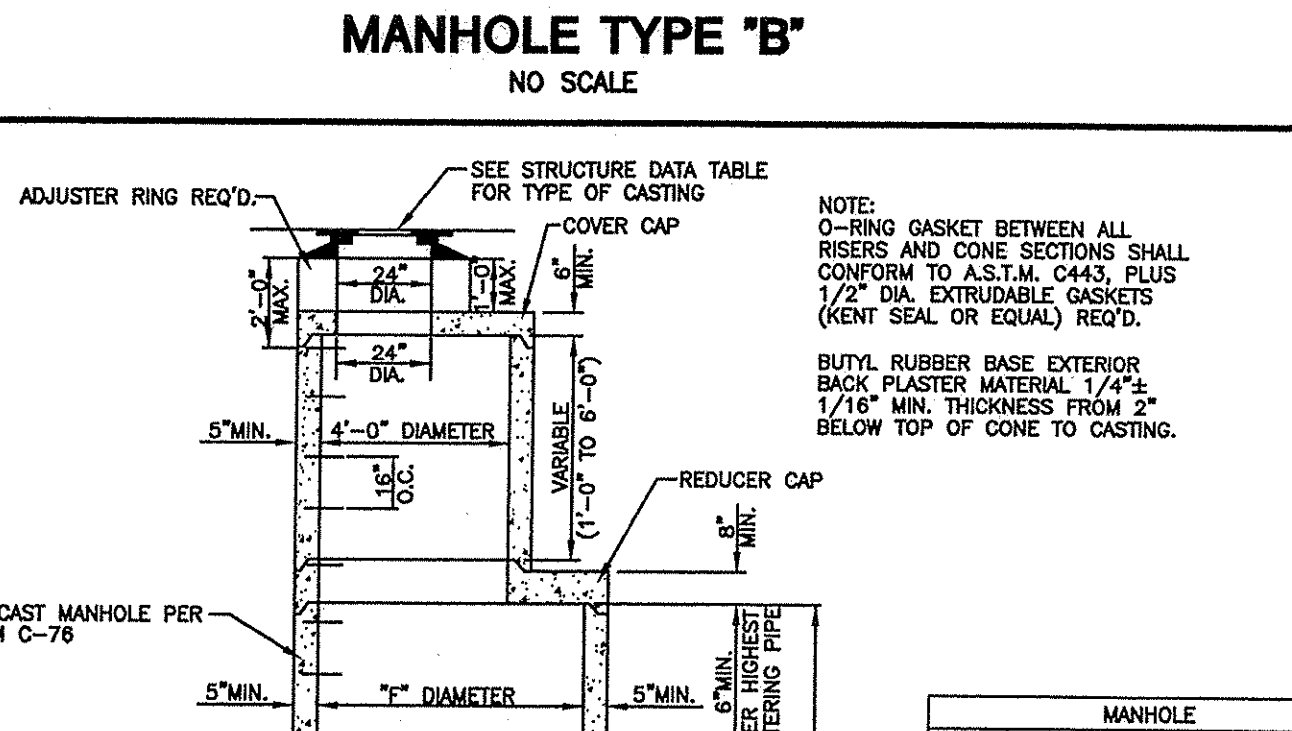

STOCK NO.	KVA	WT.	A	B	C	D	L	M	N	KVA	
1703-506	150-300	5800	75	80	44	15	1/2	9	15	19 1/2	150-300
1703-507	1703-507	10,100	84	84	44	20	9	15	19 1/2	500-1000	
1703-508	1500	12,800	84	84	48	18	9	17	23 1/2	1500	

ALL DIMENSIONS ARE IN INCHES

Duke
REALTY CORPORATION
500 East 96th Street
Suite 100
Indianapolis, IN 46240
Phone: (317) 808-8000
Fax: (317) 808-6797

WOOLPERT, INC.
7140 Waldemar Drive
Indianapolis, Indiana
46268-4192
317.299.7500
317.291.5805

WEST CARMEL MARKETPLACE - PHASE 1
9901 NORTH MICHIGAN ROAD
CARMEL, INDIANA


STORM SEWER AS-BUILT

Scale: AS SHOWN
Date: 10/20/04
Drawn By: P.J.D.
Checked By: GSS


Certified By:

Drawing Number: **C601**
31 of 40 Sheets
Duke Realty Job Number: **WNC301-001**
A/E Job Number: **61287.03**


Layout Tab Name: C605, Images: c-4.bmp, D-21.jpg, D-20.jpg, D-12.jpg, D-10.jpg, T-3.jpg, SSD-1.jpg, O-5.jpg, O-4.jpg, O-2.jpg, O-1.jpg, P-1.bmp, S-1.bmp, S-2.bmp, S-3_MKE.bmp, S-4.bmp, Stone ford.bmp, u-3.bmp, u-4.bmp, X.ret;

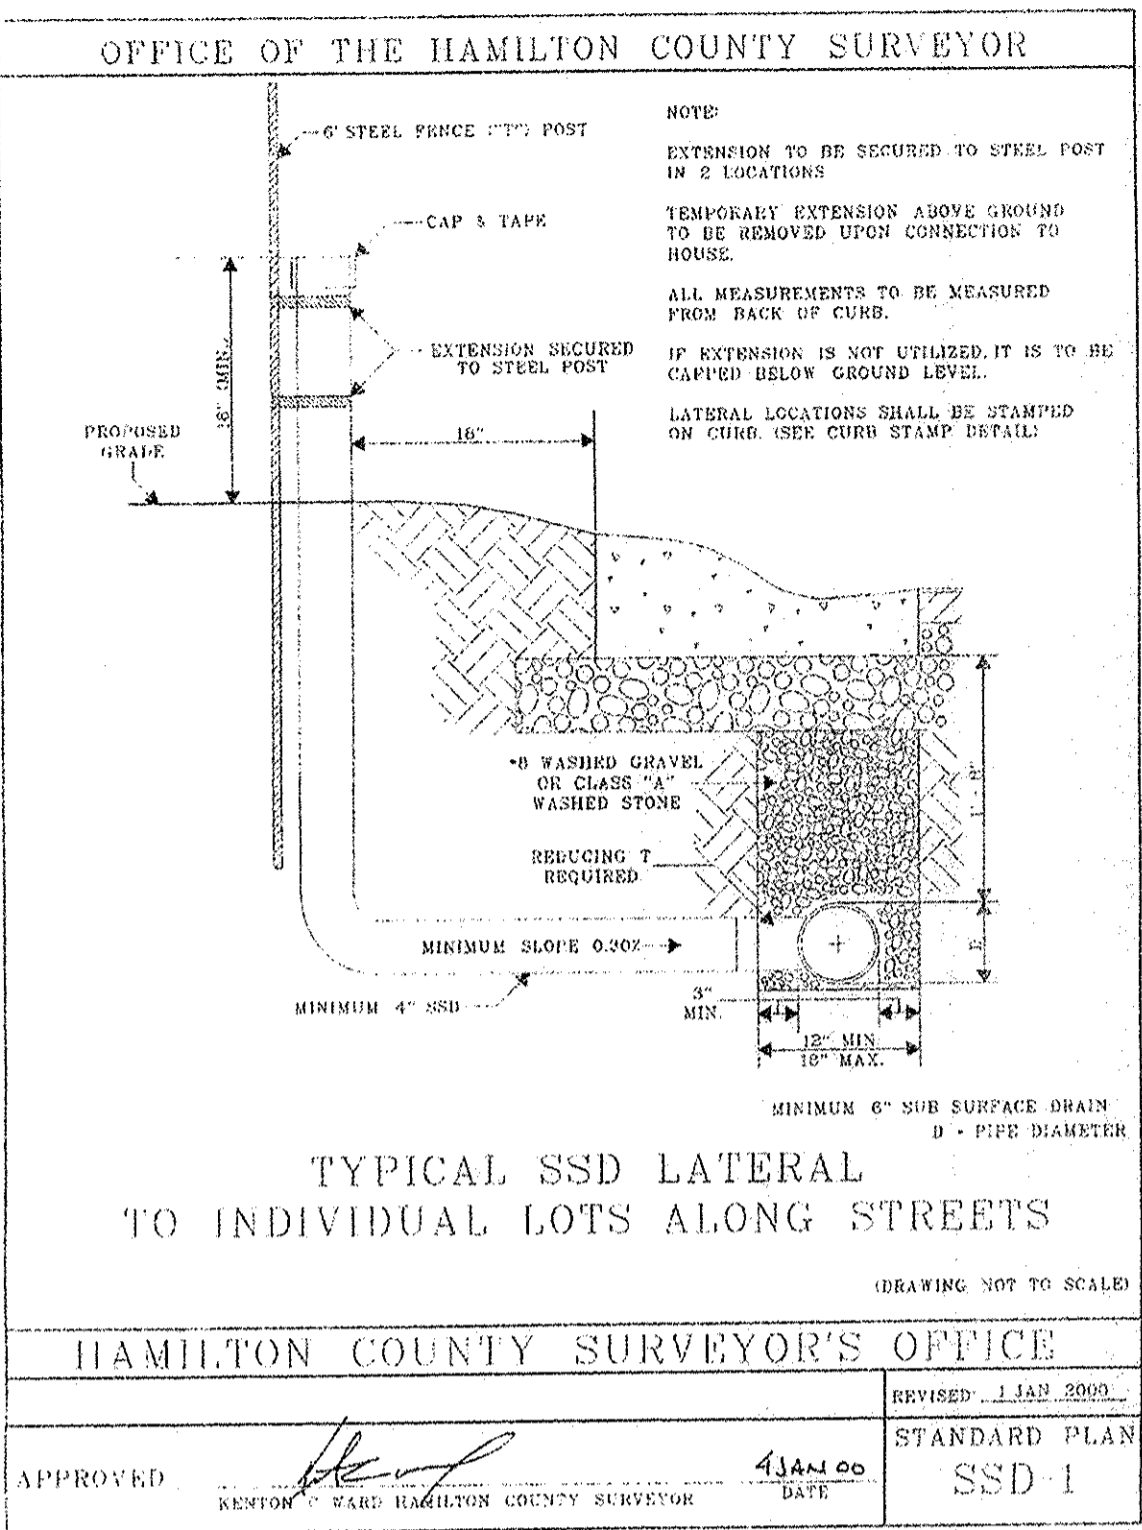

OFFICE OF THE HAMILTON COUNTY SURVEYOR
HAMILTON COUNTY SURVEYOR'S OFFICE
REVISED 1 JAN 2000
APPROVED: KENTON C. WARD, HAMILTON COUNTY SURVEYOR
DATE: 4 JAN 00
STANDARD PLAN
SSD 1

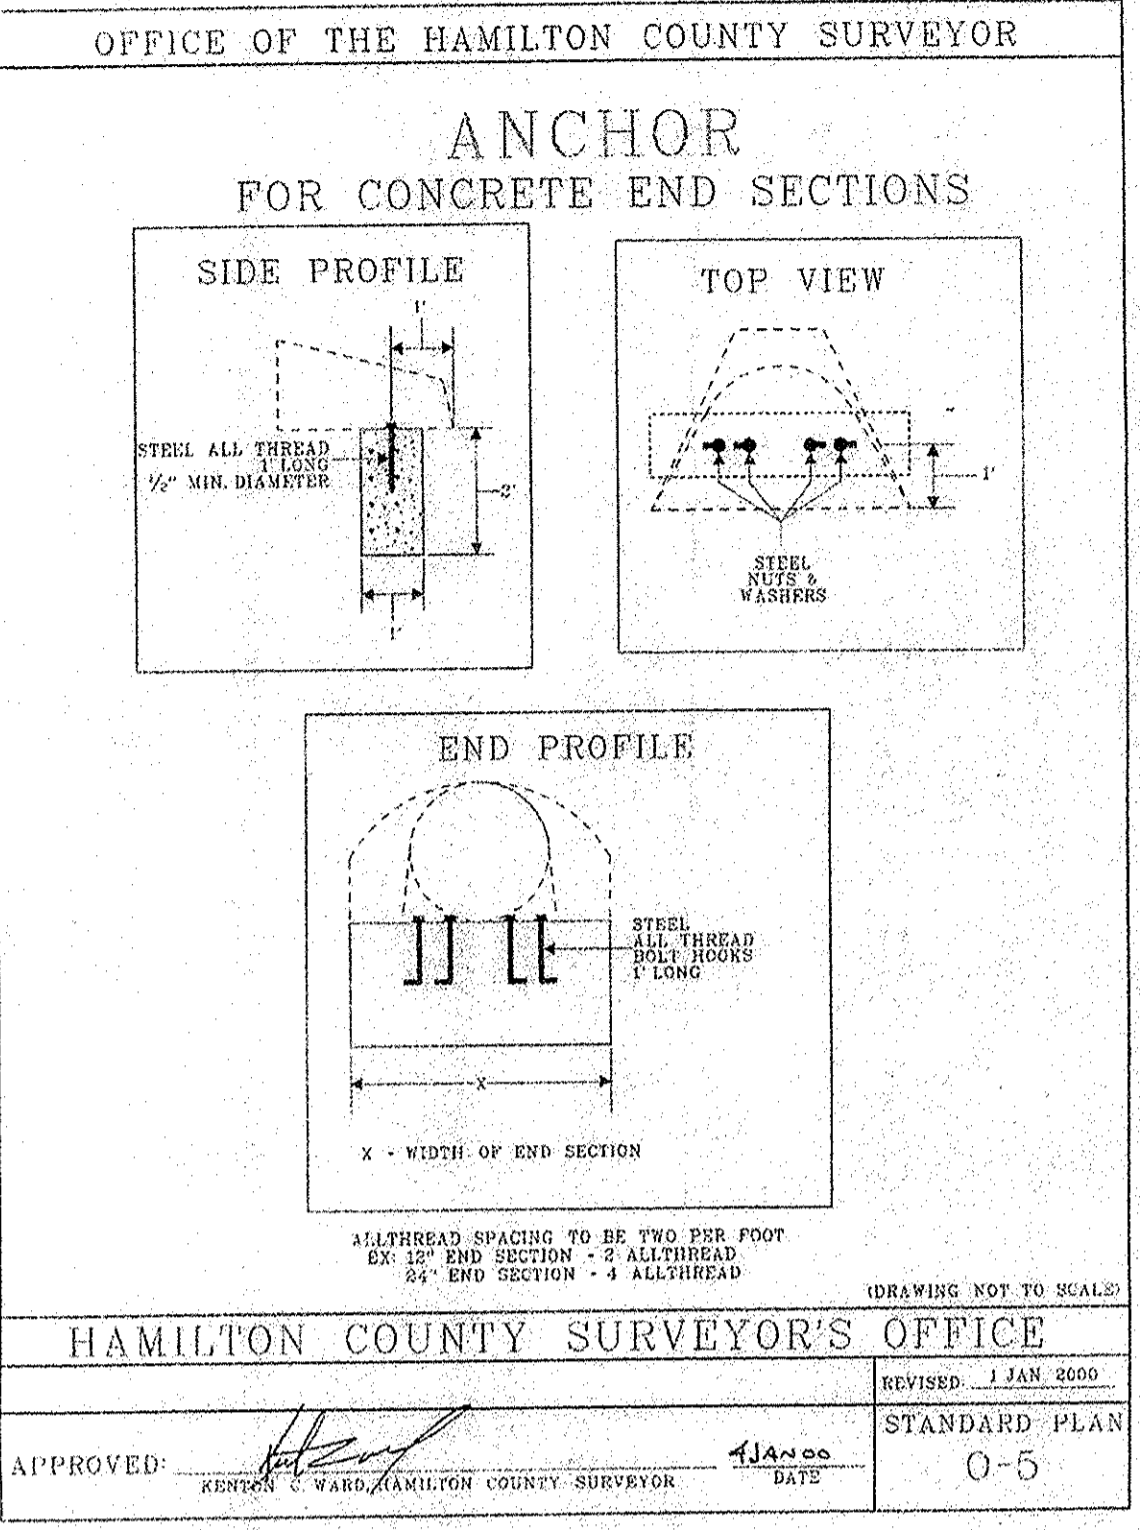


OFFICE OF THE HAMILTON COUNTY SURVEYOR
HAMILTON COUNTY SURVEYOR'S OFFICE
REVISED 1 JAN 2000
APPROVED: KENTON C. WARD, HAMILTON COUNTY SURVEYOR
DATE: 4 JAN 00
STANDARD PLAN
0-5

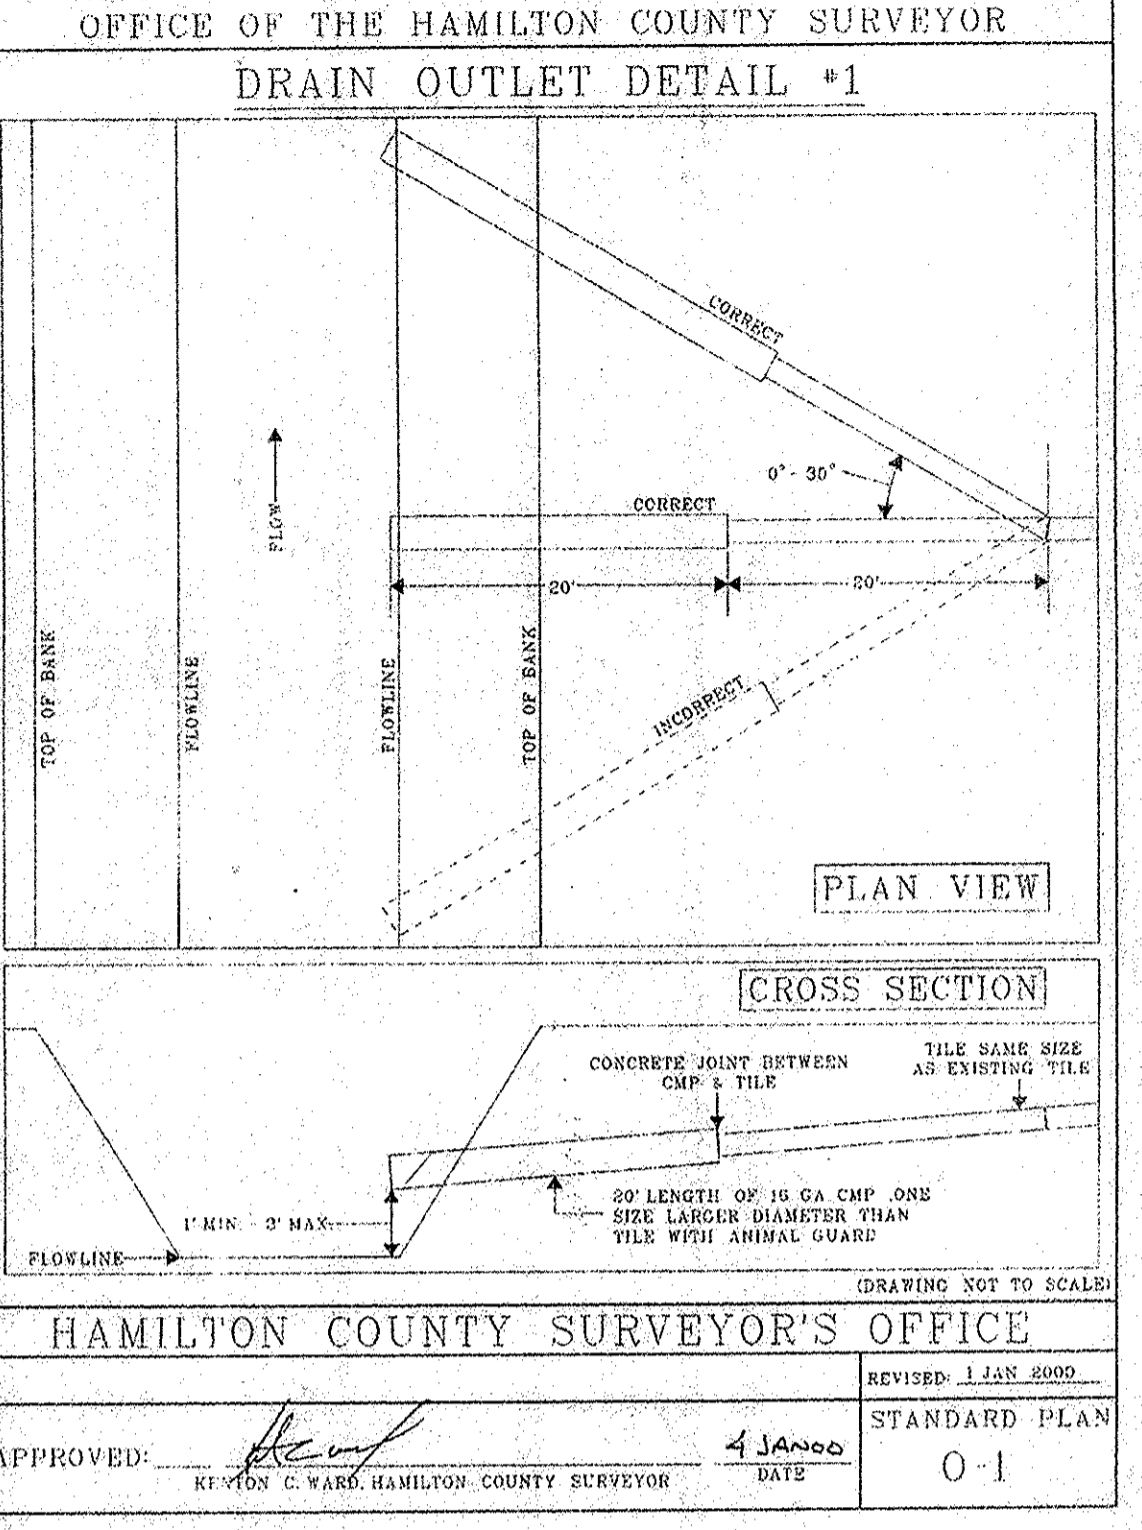


OFFICE OF THE HAMILTON COUNTY SURVEYOR
HAMILTON COUNTY SURVEYOR'S OFFICE
REVISED 1 JAN 2000
APPROVED: KENTON C. WARD, HAMILTON COUNTY SURVEYOR
DATE: 4 JAN 00
STANDARD PLAN
0-1

DEBRIS GUARD. TABLE: Approx. V-bar Size, H-bar Size, No. of V-bar, No. of H-bar, Bolt Dia., Bolt Dim. Includes a table with 10 rows of dimensions and a note: 1. BARS & PLATES ARE HOT-ROLLED STEEL. 2. BARS PLATES & PIPES ARE FINISHED WITH 3 COATS OF ALUMINUM PAINT. 3. BOLTS ARE GALVANIZED. 4. NO KEYS THROUGH PIPES WILL BE ALLOWED. 5. DEBRIS GUARD SHALL BE REMOVABLE.


OFFICE OF THE HAMILTON COUNTY SURVEYOR
HAMILTON COUNTY SURVEYOR'S OFFICE
REVISED 1 JAN 2000
APPROVED: KENTON C. WARD, HAMILTON COUNTY SURVEYOR
DATE: 4 JAN 00
STANDARD PLAN
D-12

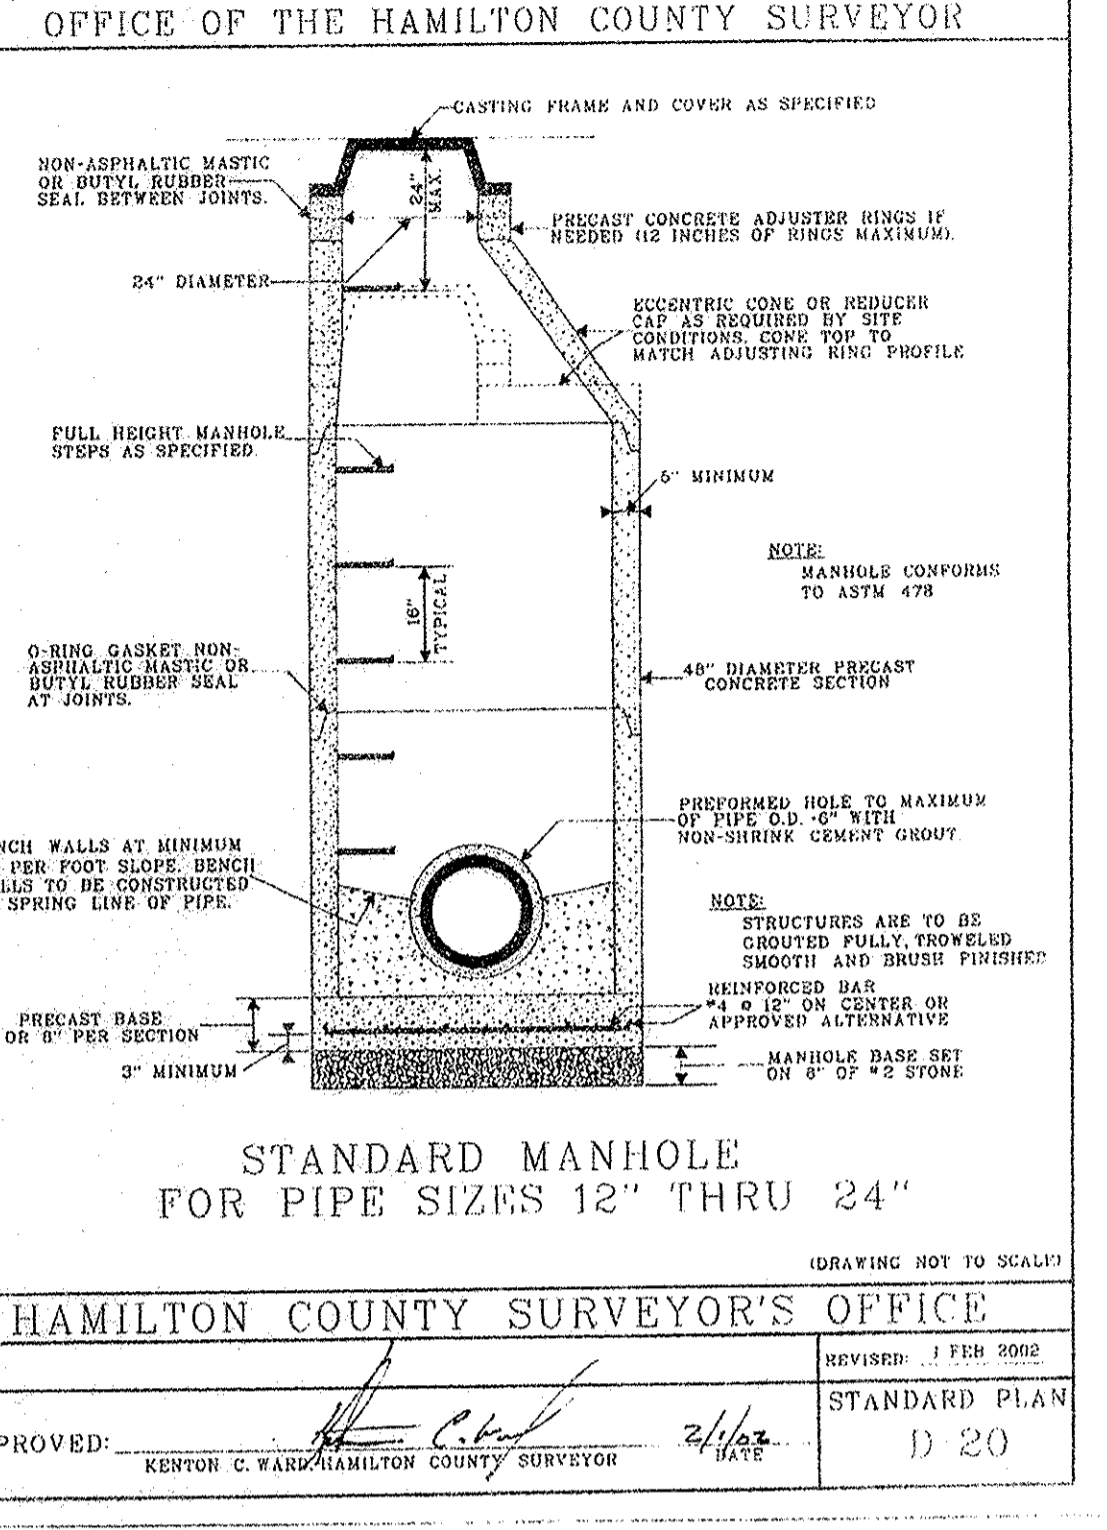


OFFICE OF THE HAMILTON COUNTY SURVEYOR
HAMILTON COUNTY SURVEYOR'S OFFICE
REVISED 1 FEB 2002
APPROVED: KENTON C. WARD, HAMILTON COUNTY SURVEYOR
DATE: 2/1/02
STANDARD PLAN
D 20

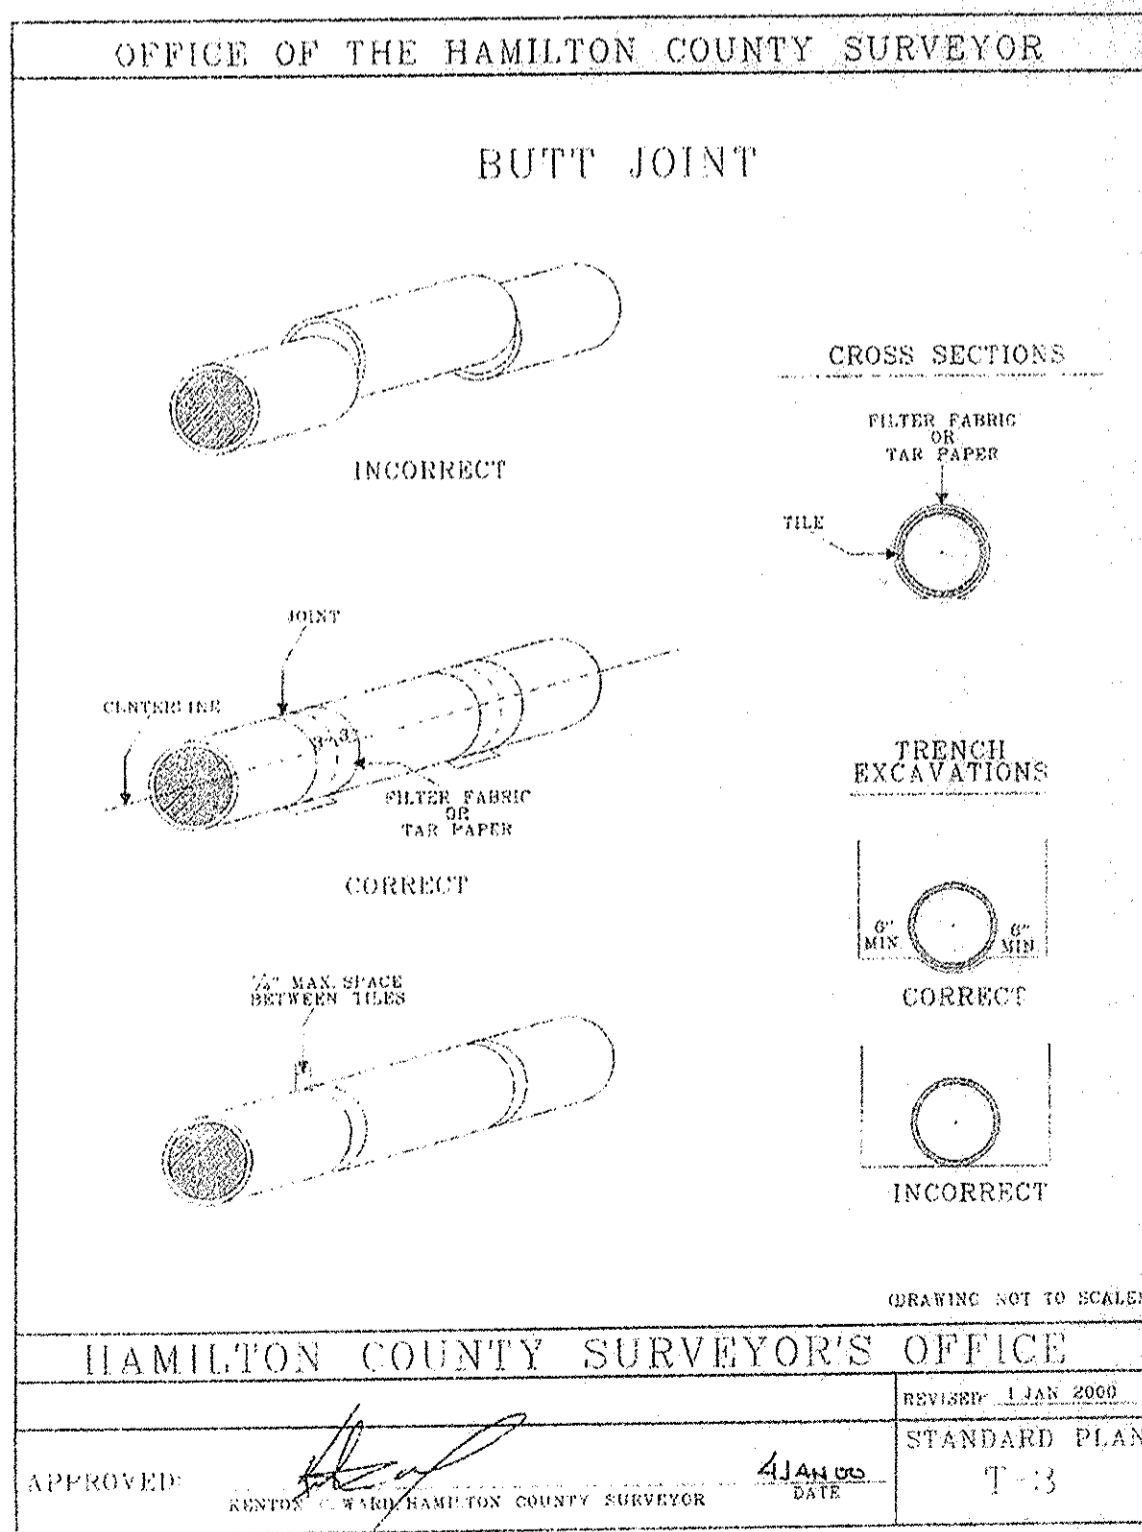


OFFICE OF THE HAMILTON COUNTY SURVEYOR
HAMILTON COUNTY SURVEYOR'S OFFICE
REVISED 1 JAN 2000
APPROVED: KENTON C. WARD, HAMILTON COUNTY SURVEYOR
DATE: 4 JAN 00
STANDARD PLAN
T-3

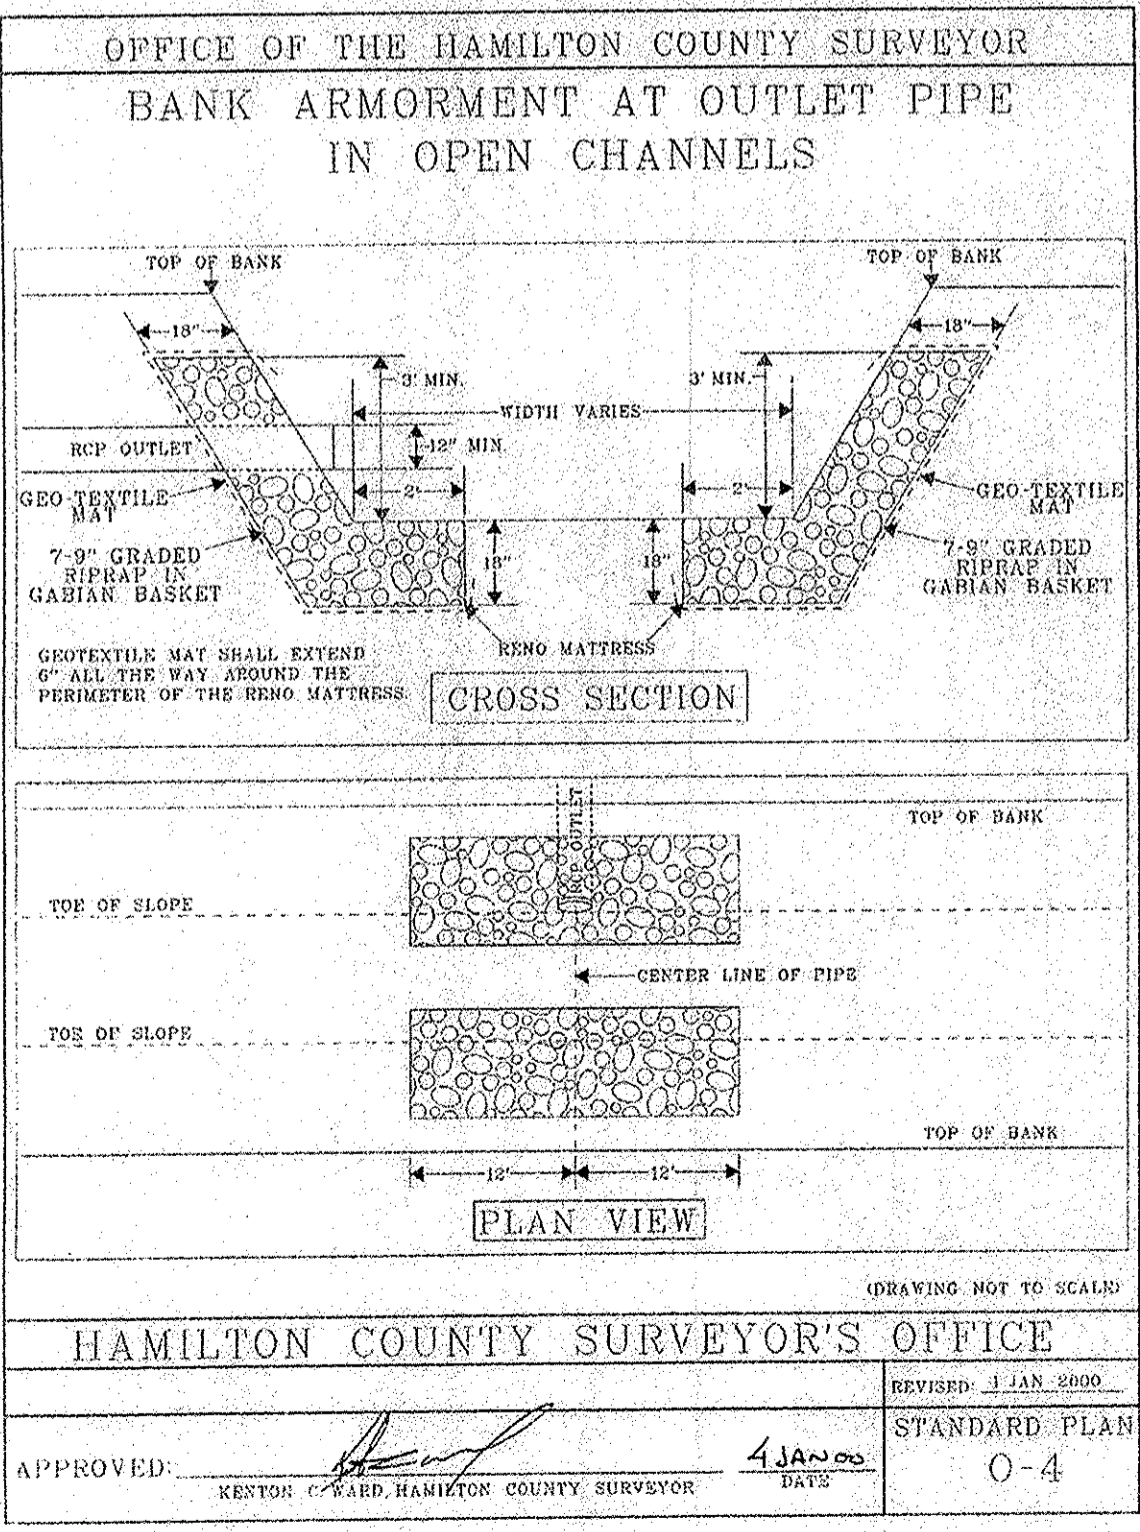


OFFICE OF THE HAMILTON COUNTY SURVEYOR
HAMILTON COUNTY SURVEYOR'S OFFICE
REVISED 1 JAN 2000
APPROVED: KENTON C. WARD, HAMILTON COUNTY SURVEYOR
DATE: 4 JAN 00
STANDARD PLAN
0-4

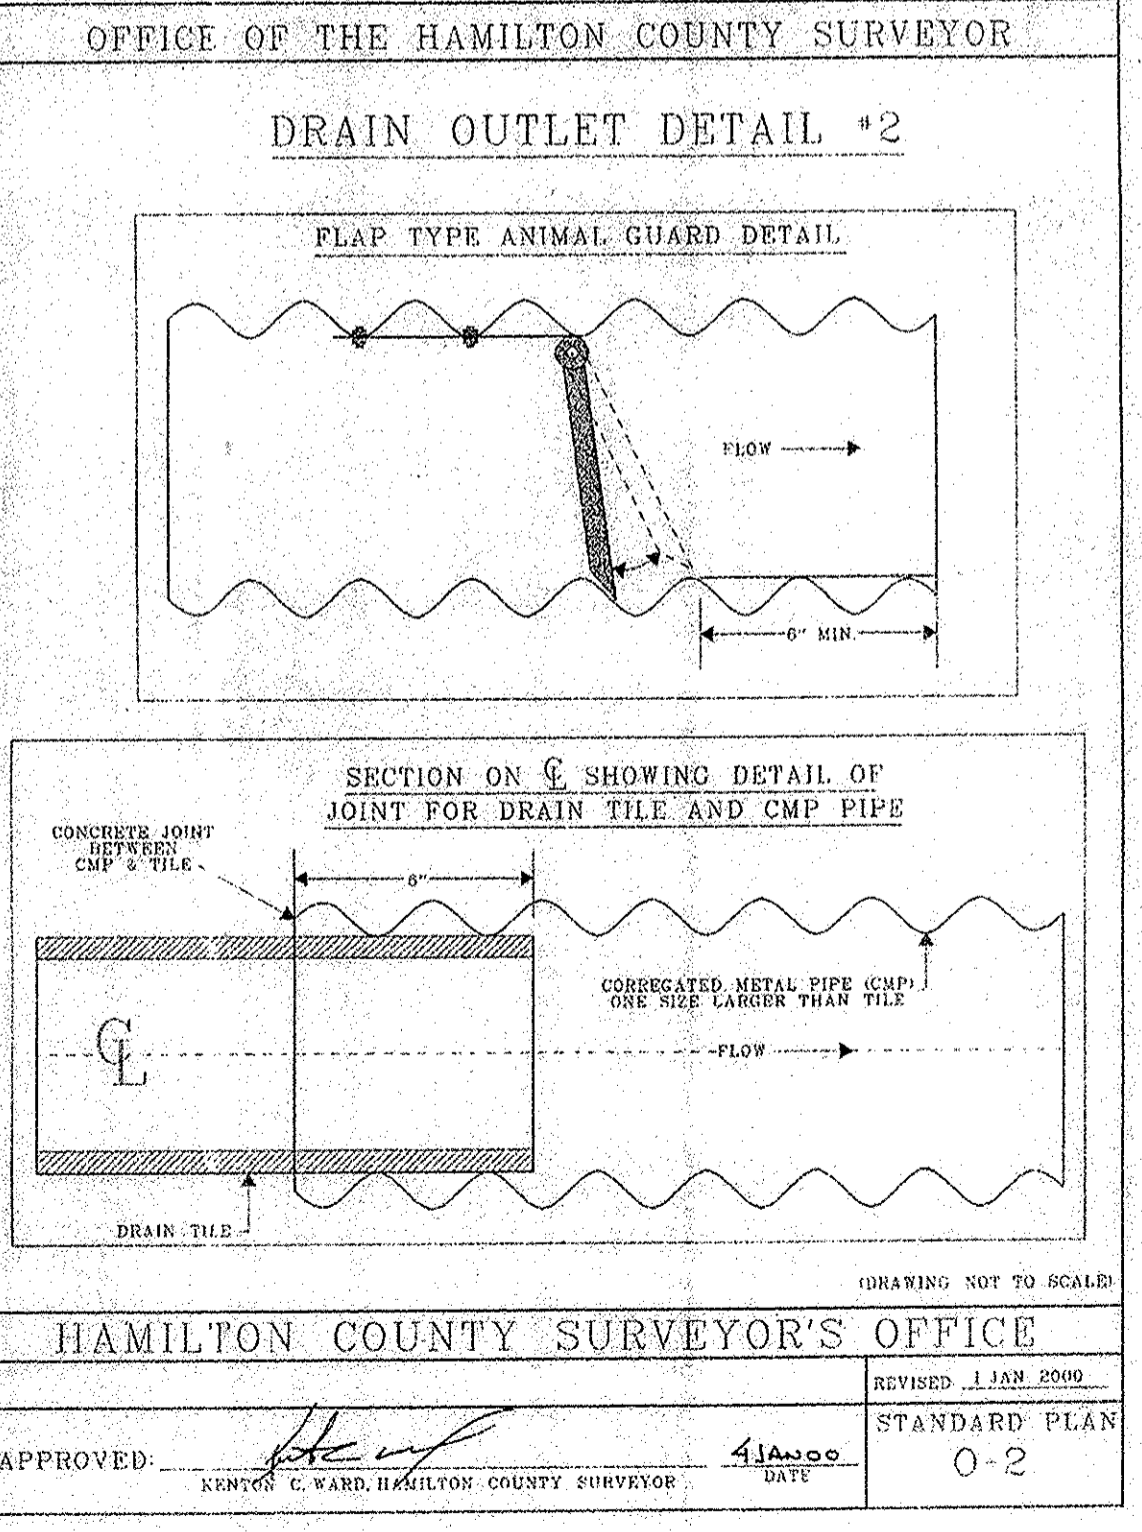


OFFICE OF THE HAMILTON COUNTY SURVEYOR
HAMILTON COUNTY SURVEYOR'S OFFICE
REVISED 1 JAN 2000
APPROVED: KENTON C. WARD, HAMILTON COUNTY SURVEYOR
DATE: 4 JAN 00
STANDARD PLAN
0-2

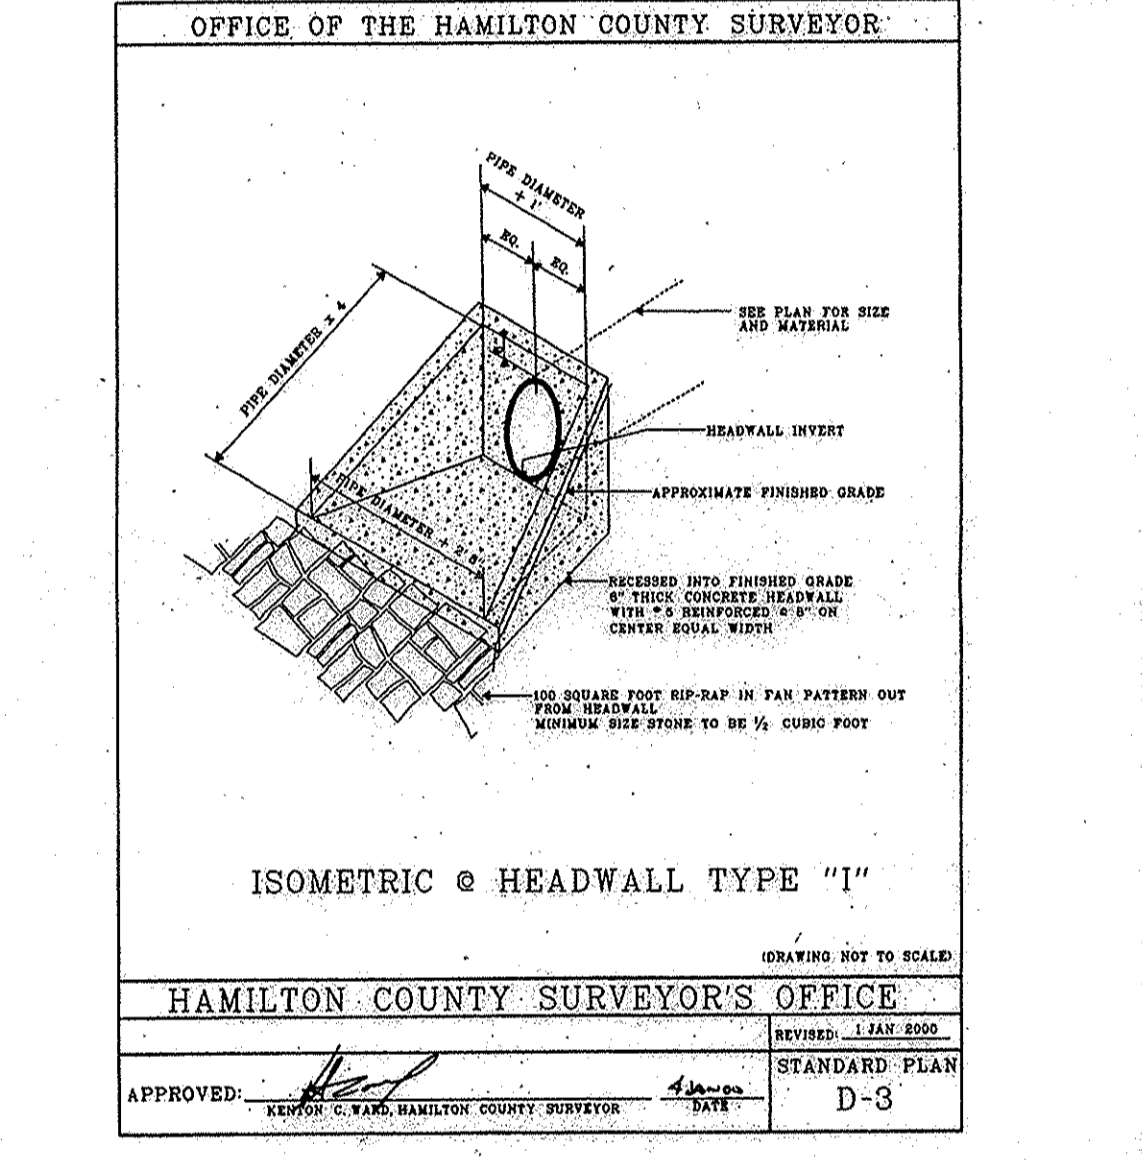

OFFICE OF THE HAMILTON COUNTY SURVEYOR
HAMILTON COUNTY SURVEYOR'S OFFICE
REVISED 1 JAN 2000
APPROVED: KENTON C. WARD, HAMILTON COUNTY SURVEYOR
DATE: 4 JAN 00
STANDARD PLAN
D-3

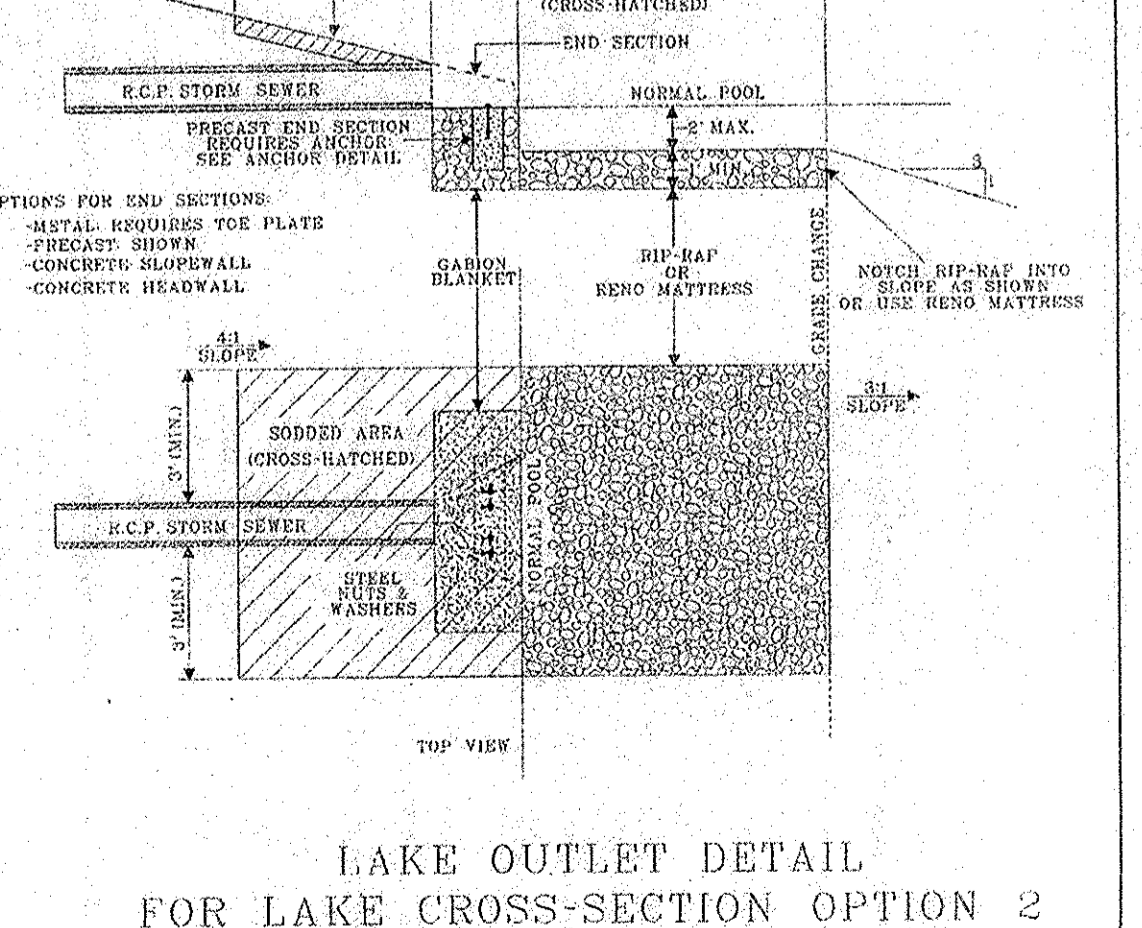

OFFICE OF THE HAMILTON COUNTY SURVEYOR
HAMILTON COUNTY SURVEYOR'S OFFICE
REVISED 1 JAN 2000
APPROVED: KENTON C. WARD, HAMILTON COUNTY SURVEYOR
DATE: 4 JAN 00
STANDARD PLAN
D-10

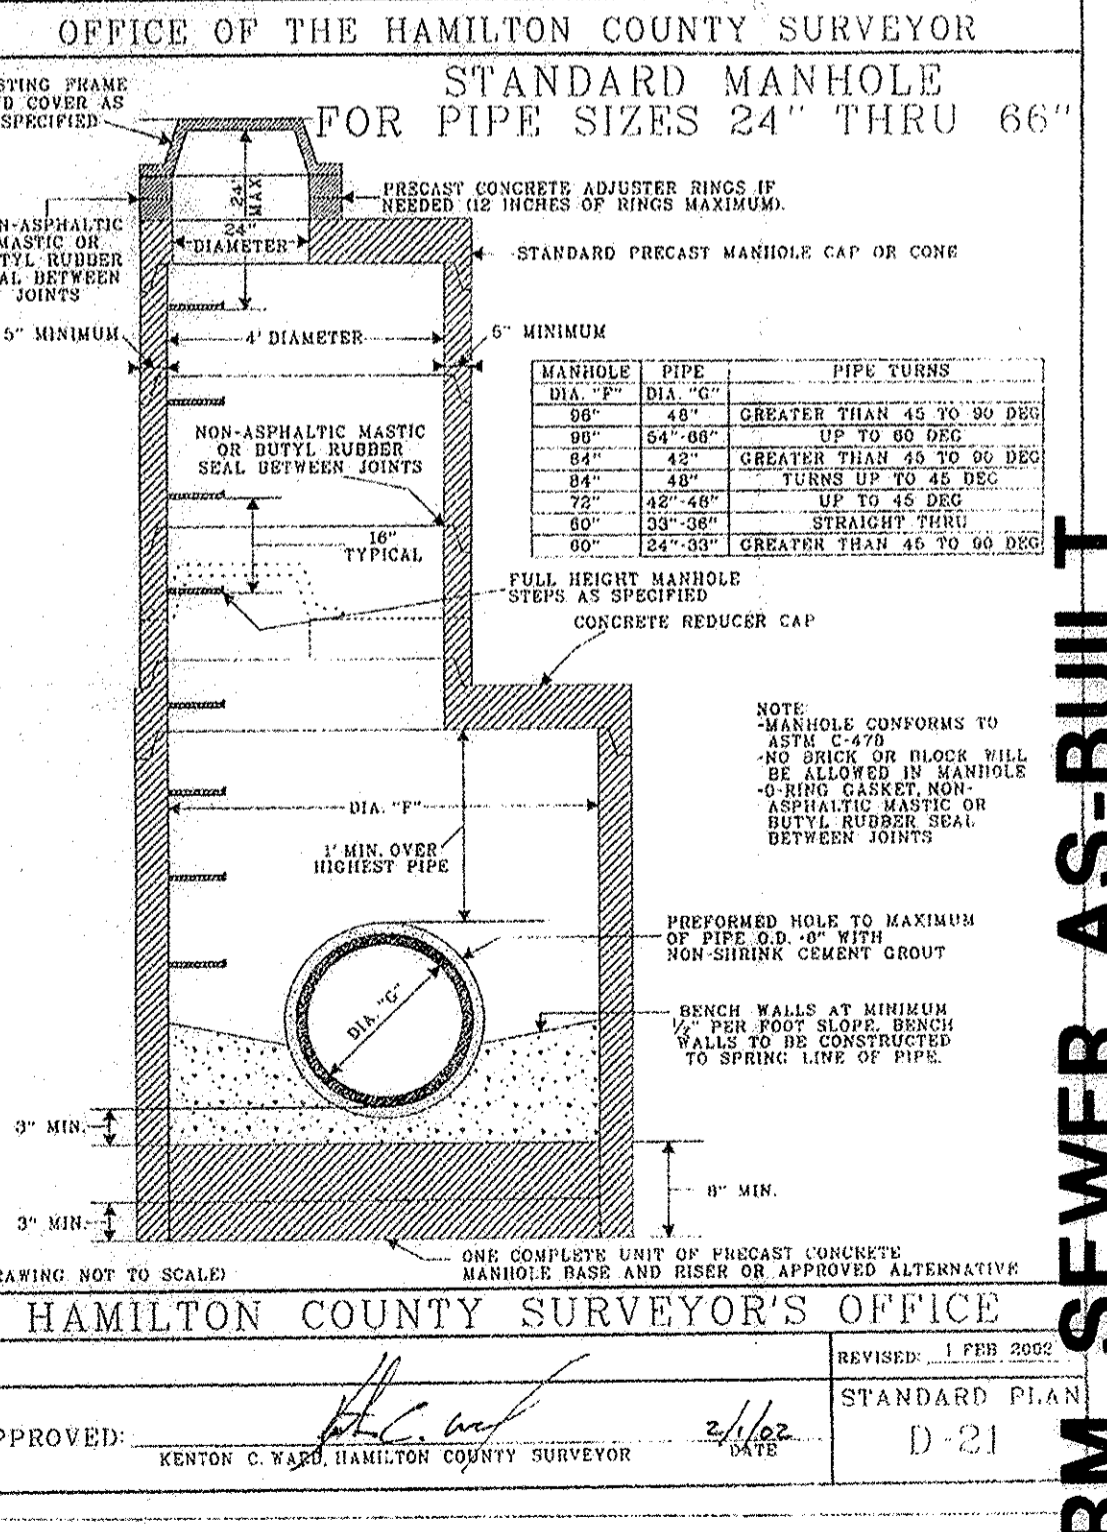

OFFICE OF THE HAMILTON COUNTY SURVEYOR
HAMILTON COUNTY SURVEYOR'S OFFICE
REVISED 1 FEB 2000
APPROVED: KENTON C. WARD, HAMILTON COUNTY SURVEYOR
DATE: 2/1/02
STANDARD PLAN
D-21

Duke REALTY CORPORATION 600 East 96th Street Suite 100 Indianapolis, IN 46240 Phone (317) 808-8000 Fax (317) 808-8787
WOOLPERT, INC. 7140 Waldemar Drive Indianapolis, Indiana 46268-4192 317.299.7500 FAX: 317.291.5805
WEST CARMEL MARKETPLACE - PHASE 1
9901 NORTH MICHIGAN ROAD CARMEL, INDIANA
DETAILS - HAMILTON COUNTY SURVEYOR'S OFFICE
Drawing Number: C605
35 of 40 Sheets
WNC301-001
61287.03