


Drain: CROOKED CREEK DRAIN **Drain #:** 250
Improvement/Arm: WESTON RIDGE - SECTION 2
Operator: JOH **Date:** 12-3-03
Drain Classification: Urban/Rural **Year Installed:** 1997

GIS Drain Input Checklist

- Pull Source Documents for Scanning JOH 12-3
- Digitize & Attribute Tile Drains N/A
- Digitize & Attribute Storm Drains JOH 12-3
- Digitize & Attribute SSD JOH 12-3
- Digitize & Attribute Open Ditch N/A
- Stamp Plans JOH 12-3
- Sum drain lengths & Validate JOH 12-3
- Enter Improvements into Posse JOH 12-3
- Enter Drain Age into Posse JOH 12-12
- Sum drain length for Watershed in Posse JOH 12-12
- Check Database entries for errors JOH 12-3

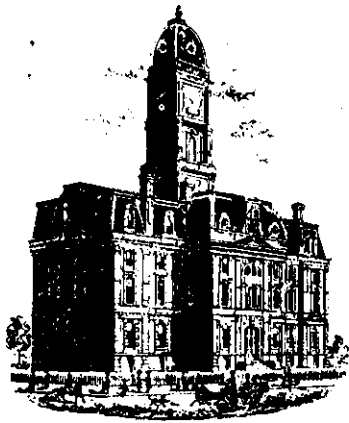

SURVEYOR'S OFFICE

Hamilton County

Kenton C. Ward, Surveyor

Phone (317) 776-8495

Fax (317) 776-9628

Suite 146

One Hamilton County Square

Noblesville, Indiana 46060-2230

June 5, 1997

TO: HAMILTON COUNTY DRAINAGE BOARD

RE: Crooked Creek Drain, Westin Ridge, Section 2 Arm

Attached is a petition, plans, non-enforcement request, calculations, quantity summary and assessment roll for the Westin Ridge, Section 2 Arm, Crooked Creek Drain. I have reviewed the submittals and petition and have found each to be in proper form.

I have made a personal inspection of the land described in the petition. Upon doing so, I believe that the drain is practicable; will improve the public health; benefit a public highway and be of public utility; and that the costs, damages and expenses of the proposed drain will probably be less than the benefits accruing to the owners of land likely to be benefited. The drain will consist of the following:

6" SSD	3,873 feet	21" RCP	30 feet
12" RCP	656 feet	24" RCP	470 feet
15" RCP	612 feet	27" RCP	200 feet
18" RCP	419 feet		

The total length of the drain will be 6,260 feet.

The subsurface drains (SSD) to be part of the regulated are those located under the curbs. Only the main SSD lines which are located within the Right-of Way are to be maintained as regulated of the drain. Laterals for individual lots will not be considered part of the regulated drain.

I have reviewed the plans and believe the drain will benefit each lot equally. Therefore, I recommend each lot be assessed equally. I also believe no damages will result to landowners

Page #2

the construction of this drain. I recommend a maintenance assessment of \$30.00 per lot, \$5.00 per acre for roadways, with a \$30.00 minimum. With this assessment the total annual assessment for this drain/this section will be \$ 993.30.

I believe this proposed drain meets the requirements for Urban Drain Classification as set out in IC 36-9-27-67 to 69. Therefore, this drain shall be designated as an Urban Drain.

I recommend that upon approval of the above proposed drain that the Board also approve the attached non-enforcement request. This request is for the reduction of the regulated drain easement to those easement widths as shown on the secondary plat for Westin Ridge Section 2 as recorded in the office of the Hamilton County Recorder.

I recommend the Board set a hearing for this proposed drain for July 1997.

Kenton C. Ward
Hamilton County Surveyor
KCW/no

STATE OF INDIANA)
)
COUNTY OF HAMILTON)

TO: HAMILTON COUNTY DRAINAGE BOARD
% Hamilton County Surveyor, Courthouse, Noblesville, IN 46060

In the matter of Weston Ridge Subdivision, Section Two Drain Petition.

Petitioner is the owner of all lots in the land affected by the proposed new regulated drain. The drainage will affect various lots in Weston Ridge subdivision in Hamilton County, Indiana. The general route of such drainage shall be in existing easements and along public roads as shown in the plans on file in the Surveyor's Office.

Petitioner believes that the cost, damages and expenses of the proposed improvement will be less than the benefits which will result to the owners of the land likely to be benefitted thereby. Petitioner believes the proposed improvements will:

- (a) improve public health
- (b) benefit a public street
- (c) be of public utility

Petitioner agrees to pay the cost of construction of the drainage system and requests periodic maintenance assessments by the Board thereafter.

The Petitioner also agrees to the following:

1. To provide the Drainage Board a Performance Bond for the portion of the drainage system which will be made a regulated drain. The bond will be in the amount of 100% of the Engineers estimate. The bond will be in effect until construction of 100% of the system is completed and so certified by the Engineer.

2. The Petitioner shall retain an Engineer throughout the construction phase. At completion of the project the Petitioner's Engineer shall certify that the drainage system which is to be maintained as a regulated drain has been constructed as per construction plans.

FILED
MAY 16 1997
OFFICE OF HAMILTON COUNTY SURVEYOR

3. The Petitioner agrees to request in writing to the County Surveyor any changes from the approved plan and must receive written authorization from the County Surveyor prior to implementation of the change. All changes shall be documented and given to the Surveyor to be placed in the Drain File.
4. The Petitioner shall instruct his Engineer to provide a reproducible print on a 24" x 36" mylar of the final design of the Drainage System. This shall be submitted to the County Surveyor prior to the release of the Performance Bond.
5. The Petitioner shall comply with the Erosion Control Plan as specified on the construction plans. Failure to comply with the Erosion Control Plan shall be determined by the Board as being an obstruction to the drainage system. The County Surveyor shall immediately install or repair the needed measures at Petitioner cost as per IC 36-9-27-46.

The Petitioner further requests that the Drain be classified as an Urban Drain.

Tim Walter

Printed Name



Signed

Printed Name

RECORDED OWNER(S) OF LAND INVOLVED

DATE 5/14/97

FORM\PETREG

FILED
MAY 16 1997
OFFICE OF HAMILTON COUNTY SURVEYOR



CONSULTING ENGINEERS
LAND SURVEYORS

R.M. Stoepelwerth, PE, PLS • David J. Stoepelwerth, PE, PLS • Curtis C. Huff, PLS • Dennis D. Olmstead, PLS • Jeffery W. Darling, PLS

April 25, 1997

Hamilton County Surveyor's Office
One Hamilton County Square
Noblesville, IN 46060

Attention: Kent Ward

Re: Weston Ridge
Section Two

Dear Mr. Ward:

The following is an engineer's estimate for the Weston Ridge Section Two.

Street Monuments	\$1540.00
Storm Sewer	\$75,000.00
Sub-surface drains	\$17,000.00
Erosion control	\$8,000.00
Total:	<u>\$101,540.00</u>

If you have any questions concerning these amounts please contact me at 849-5935.

Very truly yours,

STOEPEL WERTH & ASSOCIATES, INC.

David J. Stoepelwerth

Cc: Tim Walter

WAB97/19584D2

FILED

APR 29 1997

OFFICE OF HAMILTON COUNTY SURVEYOR

FINDINGS AND ORDER


CONCERNING THE MAINTENANCE OF THE

Westin Ridge Section 2 Crooked Creek DRAIN

On this 28th day of July 19 97, the Hamilton County Drainage Board has held a hearing on the Maintenance Report and Schedule of Assessments of the Westin Ridge Section 2 Crooked Creek Drain

Evidence has been heard. Objections were presented and considered. The Board then adopted the original/amended Schedule of Assessments. The Board now finds that the annual maintenance assessments will be less than the benefits to the landowners and issues this order declaring that this Maintenance Fund be established.

HAMILTON COUNTY DRAINAGE BOARD

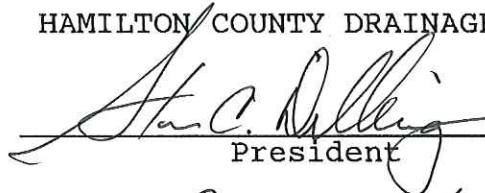


President



Member



Member

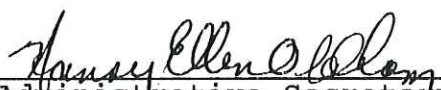ATTEST: 
Administrative Secretary
Revised 12/95



BOARD OF COMMISSIONERS
OF THE COUNTY OF HAMILTON

ATTEST:
HAMILTON COUNTY AUDITOR

SUBDIVISION BOND

DATE _____

Bond No.: 106091

Principal Amount: \$100,000.00

KNOW ALL MEN BY THESE PRESENTS, that we K.E. Properties, L.L.C.
1041 W. Main St., Carmel, IN 46032 as Principal, and _____
Frontier Insurance Company a New York Corporation,
as Surety, are held and firmly bound unto Hamilton County Commissioners
One Hamilton County Square, Noblesville, IN in the penal sum of _____
One Hundred Thousand and 00/100-----(Dollars)
(\$ 100,000.00-----), lawful money of the United States of America,
for the payment of which well and truly to be made, we bind
ourselves, our heirs, executors, administrators, successors and
assigns, jointly and severally, firmly by these presents.

WHEREAS, K.E. Properties, L.L.C.
has agreed to construct in Weston Ridge, section 2 Subdivision,
in Hamilton County, IN the following
improvements:

Storm Sewer, SSD and Erosion Control

CERTIFICATE OF COMPLETION AND COMPLIANCE

Address of premises on which land alteration was accomplished 106th Street and Shelborne Road

Inspection Date(s): _____ Permit No. _____

Relative to plans prepared by: Stoepelwerth & Associates, Inc.

on 2/12, 1997.

I hereby certify that:

To the best of my knowledge, information and belief such land alteration has been performed and completed in conformity with the improved plan, except _____
None

Signature Jeffery W. Darling Date: 12/10/1997

Type Name: Jeffery W. Darling Phone: (317) 849-5935



Business Address: 9940 Allisonville Road, Fishers, IN 46038


Surv. X Engr. _____ Arch. ___ Indiana Registration No. R.L.S. 900017



(SEAL)

FILED

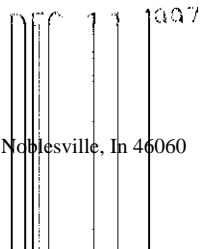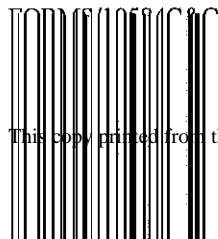

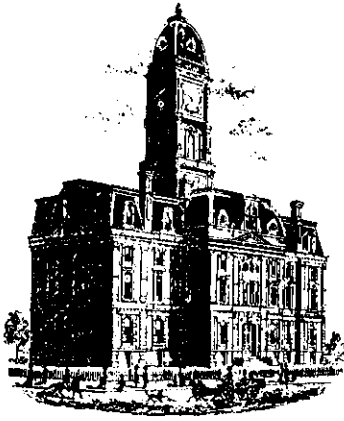

SURVEYOR'S OFFICE

Hamilton County

Kenton C. Ward, Surveyor

Phone (317) 776-8495

Fax (317) 776-9628

Suite 146

One Hamilton County Square

Noblesville, Indiana 46060-2230

To: Hamilton County Drainage Board

September 2, 1999

Re: Crooked Creek Drain: Weston Ridge Sec. 2

Attached are as-builts, certificate of completion & compliance, and other information for Weston Ridge Sec. 2. An inspection of the drainage facilities for this section has been made and the facilities were found to be complete and acceptable.

During construction, changes were made to the drain which will alter the plans submitted with my report for this drain dated June 5, 1997. The changes are as follows:

Structure: T.C.: I.E.: Pipe: Length: Original Plans: Difference:

955	905.72	902.77				
957	907.31	903.31	18	157	158	-1
957	907.31	903.31				
958	906.55	903.58	18	92	91	1
958	906.55	903.58				
959	906.6	903.82	15	30		
941	907.21	903.81				
EX. STR	905.7	902.55	15	180		
EX. STR	905.7	902.55				
940		903.17	12	200		
951	905.23	902.19				
954	905.66	902.69	24	140		
954	905.66	902.69				
955	905.72	902.77	21	30		
955	905.72	902.77				
956	905.29	903.36	15	173	172	1
EX. STR	903.8	900.7				
950	905.09	901.11	27	170		
950	905.09	901.11				
949	905.17	901.23	27	30		
949	905.17	901.23				

951	905.23	902.19	24	330		
951	905.23	902.19				
952	904.58	902.78	15	200		
952	904.58	902.78				
953		903.34	12	189	200	-11
949	905.17	901.23				
947	905.61	901.85	12	158		
947	905.61	901.85				
948	905.63	902.25	12	30		
EX. STR	902.53	898.58				
942	903.67	900.36	18	169	170	-1
942	903.67	900.36				
943	903.75	900.6	15	30		
943	903.75	900.6				
944	903.76	901.26	12	67	68	-1

6" SSD Streets:

WESTON DRIVE	867.13
COLE COURT	700.84
TRUMBULL CIRCLE	543.38
	X2

Total: 4222.7

**RCP Pipe
Totals:**

12	644
15	613
18	418
21	30
24	470
27	200

Total: 2375


The length of the drain due to the changes described above is now **6,597 feet**.

The non-enforcement was approved by the Board at its meeting on October 27, 1997 and recorded under instrument #9809802696.

The bond or letter of credit from Frontier Insurance Company, number 106091 for storm sewers, erosion control, subsurface drains and 106093 for street monumentation; in the amount of \$100,000 and \$1,540; was released June 29, 1998.

I recommend the Board approve the drains construction as complete and acceptable.

Sincerely,

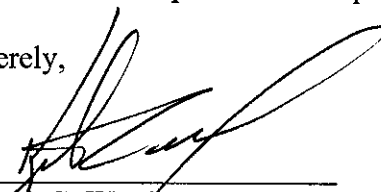

Kenton C. Ward,
Hamilton County Surveyor

KCW/slm

Asbuilt Structures

Project: WESTON RIDGE SEC. 2

Eng.Proj.#: 19584 stoeppelwerth

Structure: T.C.: I.E.: Pipe: Length: Original Plans: Difference:

	955	905.72	902.77				
	957	907.31	903.31	18	157	158	-1
	957	907.31	903.31				
	958	906.55	903.58	18	92	91	1
	958	906.55	903.58				
	959	906.6	903.82	15	30		
	941	907.21	903.81				
EX. STR		905.7	902.55	15	180		
EX. STR		905.7	902.55				
	940		903.17	12	200		
	951	905.23	902.19				
	954	905.66	902.69	24	140		
	954	905.66	902.69				
	955	905.72	902.77	21	30		
	955	905.72	902.77				
	956	905.29	903.36	15	173	172	1
EX. STR		903.8	900.7				
	950	905.09	901.11	27	170		
	950	905.09	901.11				
	949	905.17	901.23	27	30		
	949	905.17	901.23				
	951	905.23	902.19	24	330		
	951	905.23	902.19				
	952	904.58	902.78	15	200		
	952	904.58	902.78				
	953		903.34	12	189	200	-11
	949	905.17	901.23				
	947	905.61	901.85	12	158		
	947	905.61	901.85				
	948	905.63	902.25	12	30		
EX. STR		902.53	898.58				
	942	903.67	900.36	18	169	170	-1
	942	903.67	900.36				
	943	903.75	900.6	15	30		
	943	903.75	900.6				
	944	903.76	901.26	12	67	68	-1

6" SSD Streets:

WESTON DRIVE	867.13
COLE COURT	700.84
TRUMBULL CIRCLE	543.38

RCP Pipe Totals:

	12	644
	15	613
	18	418


	X2

Total: 4222.7

21	30
24	470
27	200

Total: 2375


Total Length of Drain: 6,597

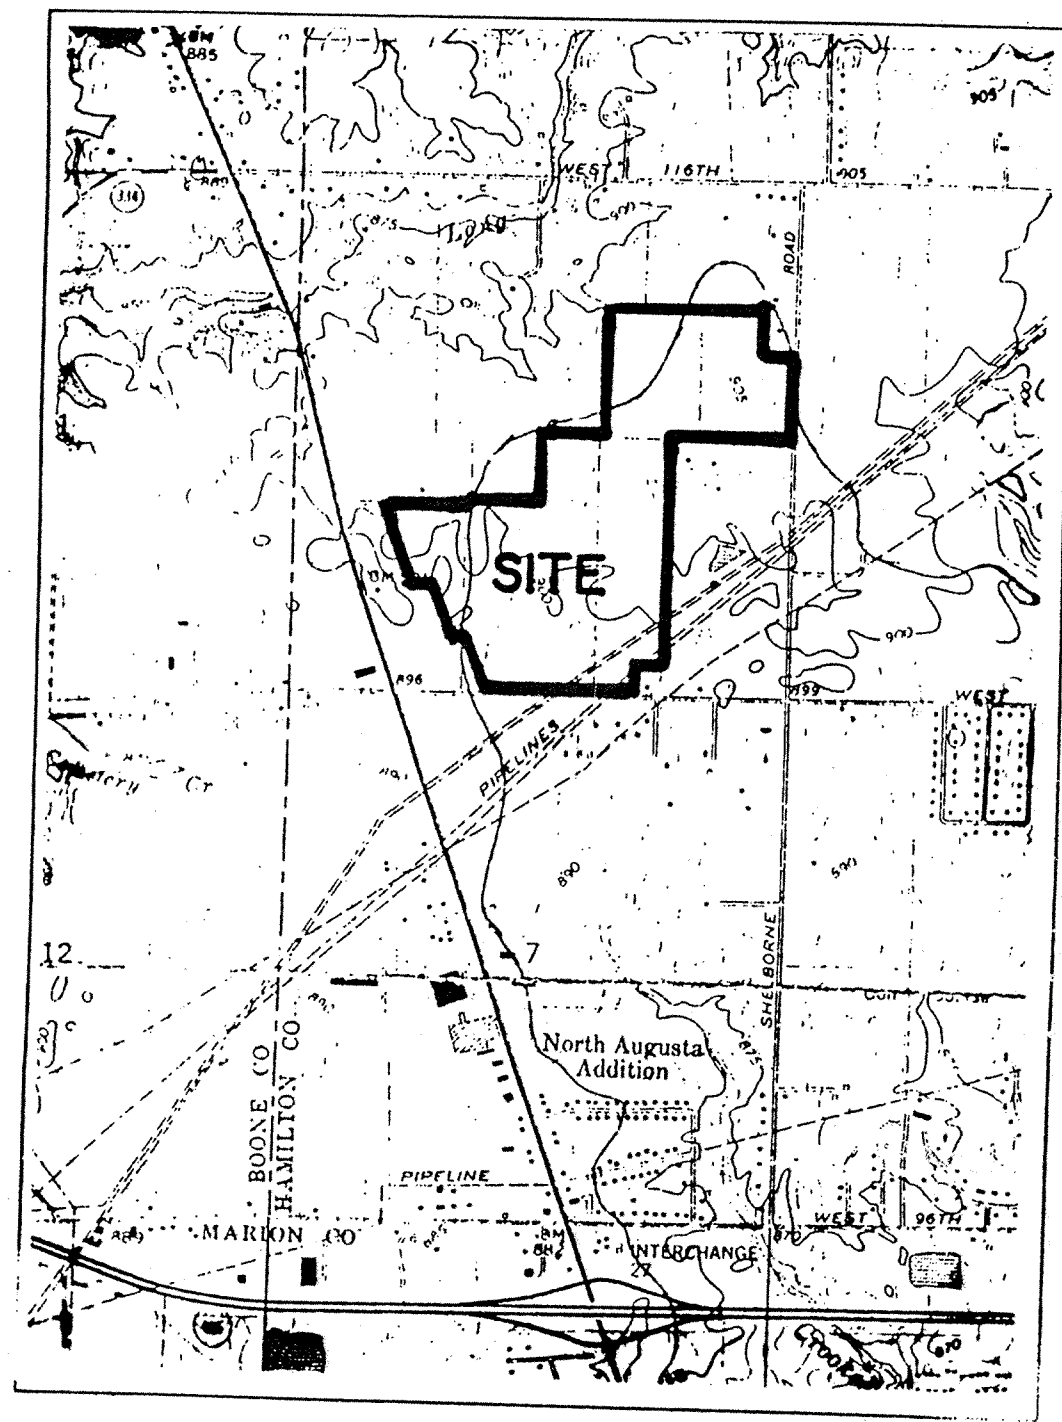

LOCATION MAP

WESTON RIDGE SECTION TWO

Developed by:
ESTRIDGE DEVELOPMENT COMPANY, INC.
 1041 WEST MAIN STREET
 CARMEL, INDIANA 46032
 (317)-582-2437

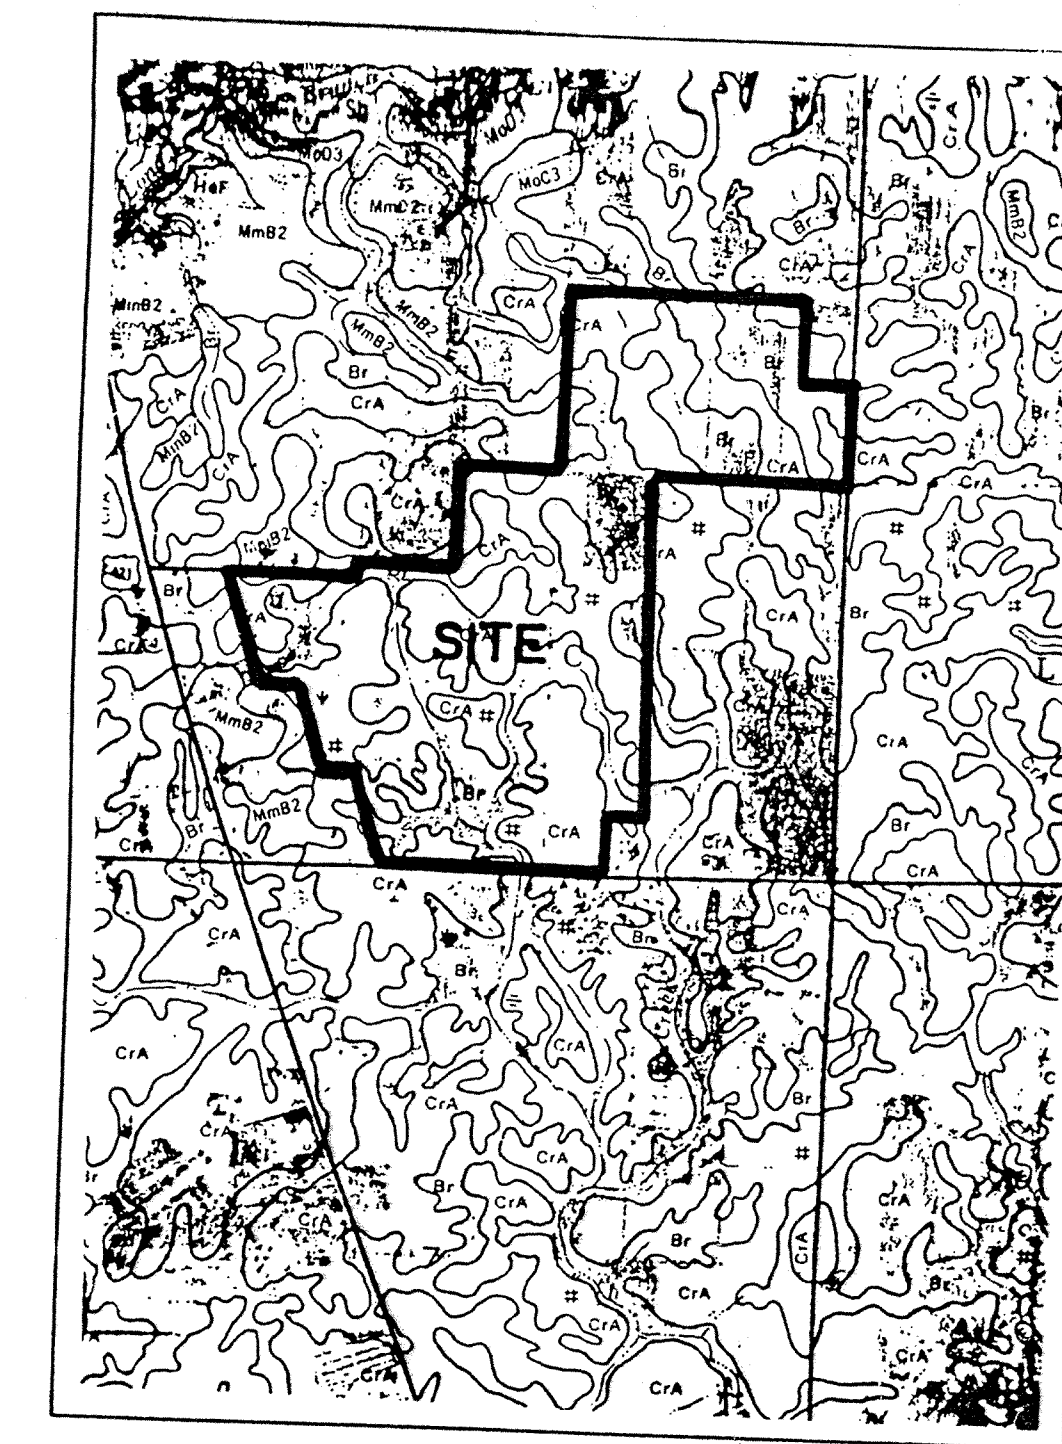



SOILS MAP

MmB2 MIAMI
 Br BROOKSTON
 CrA CROSBY

INDEX	
SHT.	DESCRIPTION
1	COVER SHEET
2	TOPOGRAPHICAL SURVEY
3	SITE DEVELOPMENT PLAN
4	EROSION CONTROL PLAN
5	STREET PLAN & PROFILE
6	STREET PLAN & PROFILE
7	INTERSECTION DETAILS
8	TRAFFIC CONTROL PLAN
9	SANITARY SEWER PLAN & PROFILES
10	SANITARY SEWER PLAN & PROFILES
11	STORM SEWER PLAN & PROFILES
12	STORM SEWER PLAN & PROFILES
13	STORM SEWER PLAN & PROFILES
14	WATER PLAN
15	OFFSITE LAKE PLAN
16	CONSTRUCTION DETAILS
17	CONSTRUCTION DETAILS
18	CONSTRUCTION DETAILS

RECORD DRAWING

Jeffrey W. Darling
 JEFFREY W. DARLING 10/16/97
 Registered Land Surveyor DATE
 No. 900017

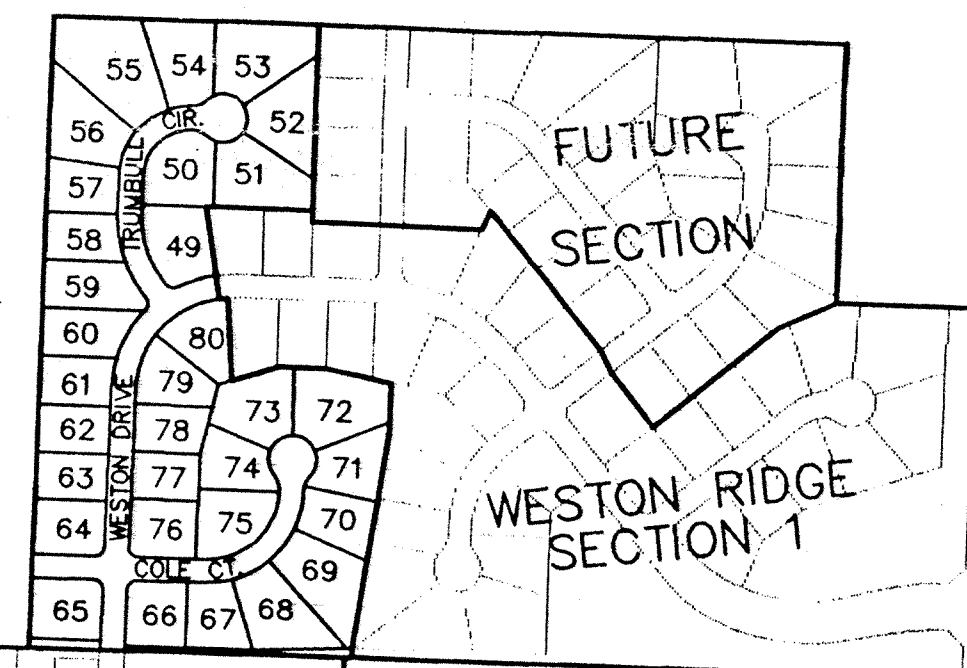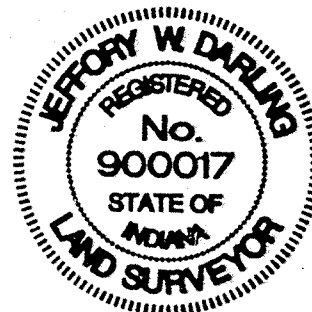


N.O.I. LETTER OPERATOR:
 TIM WALTERS
 ESTRIDGE DEVELOPMENT COMPANY, INC.
 1041 WEST MAIN STREET
 PHONE: (317)-582-2456 EXT.345

DESIGN DATA

32 LOTS = 1.84 LOTS/ACRE±
 17.393 AC.±
 WESTON DRIVE 867.13 L.F.
 COLE COURT 669.12 L.F.
 TRUMBULL CIRCLE 527.52 L.F.

REVISIONS	
SHT.	DESCRIPTION
ALL	REV. PER DEV. & TAC COMMENTS 3/3/97
3, 4, 6, 7, 12, 13, 16	REV. PER TAC COMMENTS 3/20/97
9, 10	AS BUILT 10/14/97
3, 11-13	AS BUILT 11/7/97

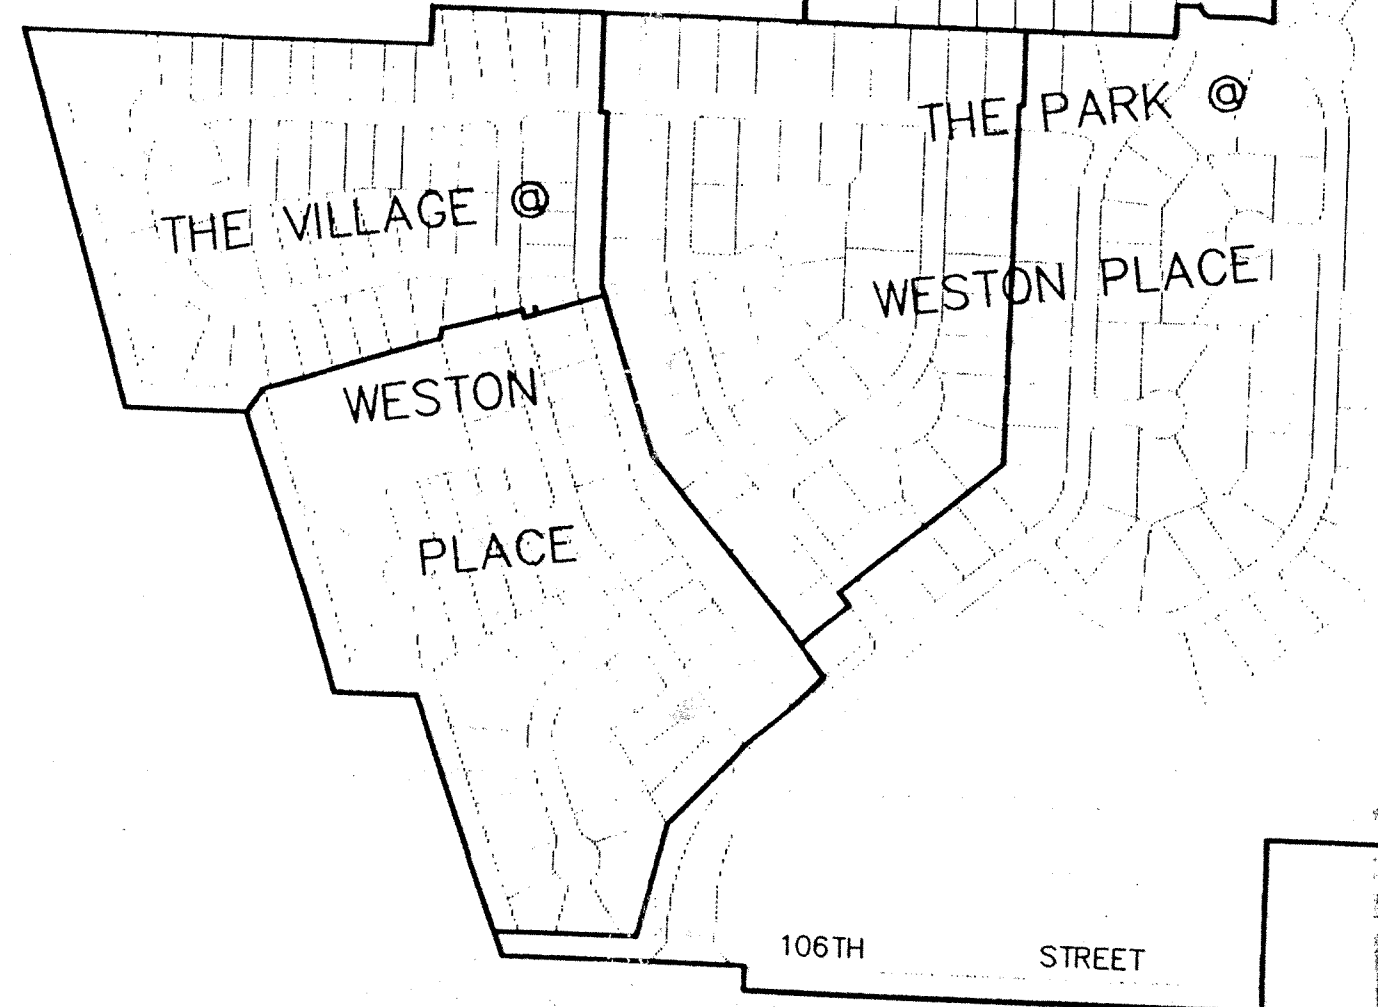


PLAT MAP

SCALE: 1" = 400'




This information was gathered from the
 into the Hamilton County
 Information System
 consensus of the
 GIS.
 Entry Date: 12-3-02
 Entered by: JQH

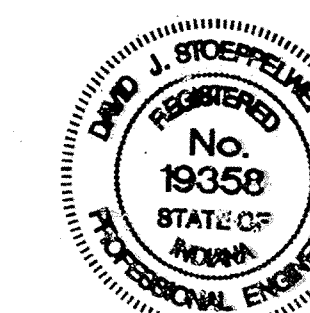

PLANS PREPARED BY:
STOEPPELWERTH & ASSOCIATES, INC.
 CONSULTING ENGINEERS & LAND SURVEYORS
 9940 ALLISONVILLE ROAD
 P.O. BOX 509007
 INDIANAPOLIS, INDIANA 46250
 PHONE: (317)-849-5935
 FAX: (317)-849-5942


PLANS CERTIFIED BY:

David J. Stoppelwerth 2/12/97
 DAVID J. STOEPPELWERTH DATE
 PROFESSIONAL ENGINEER
 NO. 19358

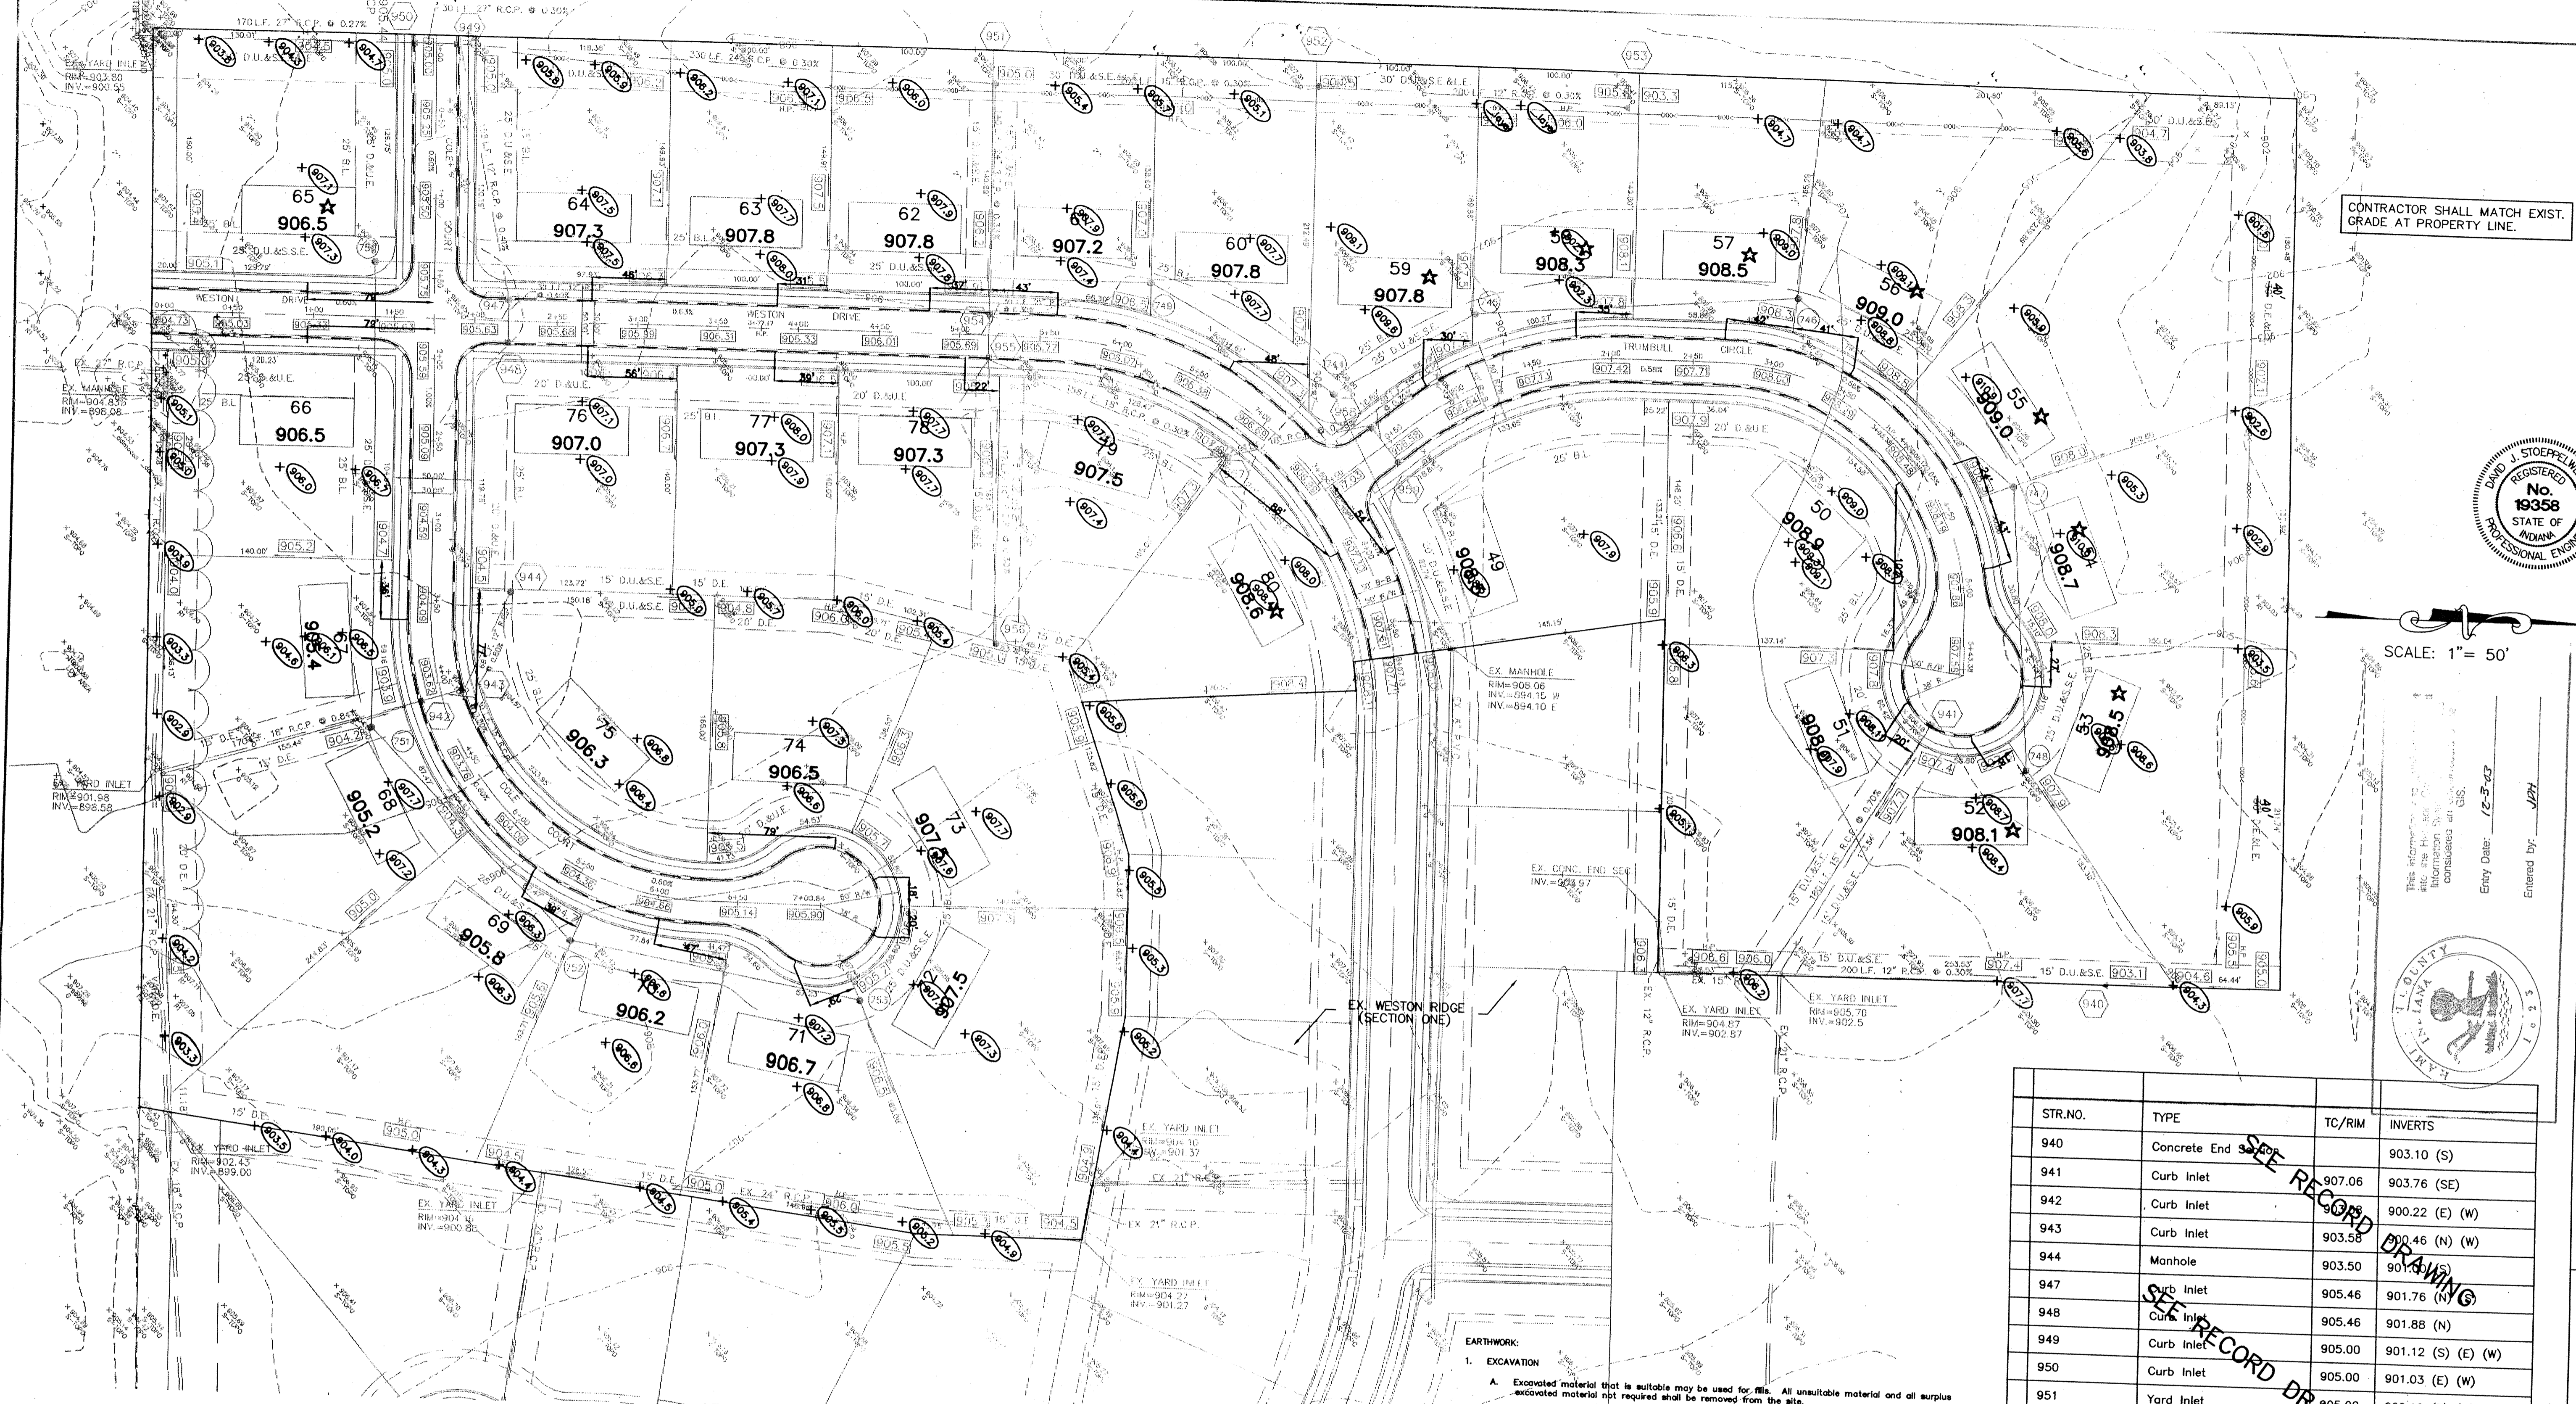


CONTRACTOR SHALL MATCH EXIST. GRADE AT PROPERTY LINE.

SCALE: 1" = 50'

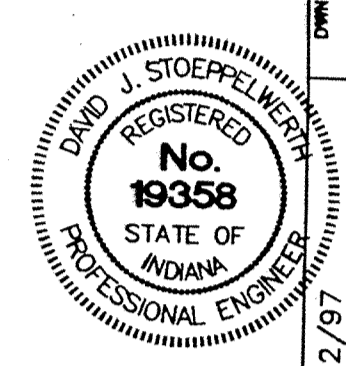


CERTIFIED: 2/12/97
 David J. Stoppelweert
 REGISTERED PROFESSIONAL ENGINEER
 No. 19358
 STATE OF INDIANA

CONSULTING ENGINEERS - LAND SURVEYORS
 (317) 849-5935 1-800-728-6917 FAX: (317) 849-5942
 INDIANAPOLIS INDIANA

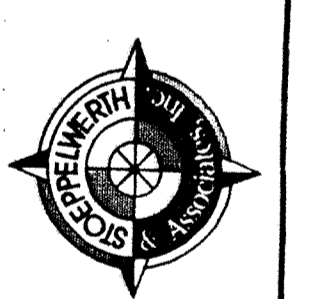

SITE DEVELOPMENT PLAN
 WESTON RIDGE SECTION TWO
 CARMEL INDIANA

SHEET NO. 3
 OF 18 SHEETS
 JOB NO. 10584

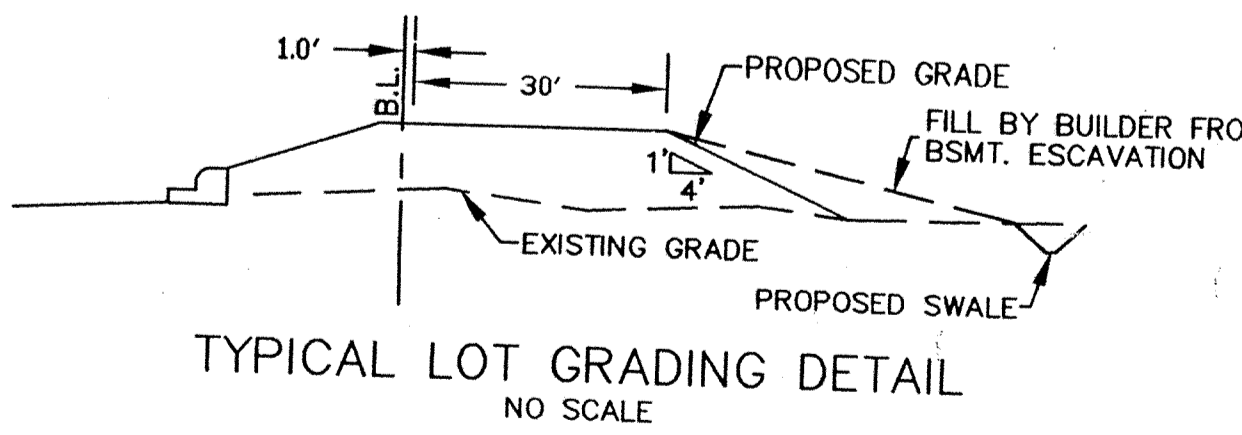

- LEGEND**
- EXISTING CONTOUR
 - EXISTING SANITARY SEWER
 - EXISTING STORM SEWER
 - PROPOSED GRADE
 - PROPOSED CONTOUR
 - PROPOSED SANITARY SEWER
 - PROPOSED STORM SEWER
 - PROPOSED SWALE
 - PROPOSED 4' SIDEWALK (BY HOME BUILDER) (UNLESS OTHERWISE NOTED)
 - LOT NUMBER
 - PAD ELEVATION DENOTES 2'-0" OF FILL OR MORE
 - PROPOSED 6" UNDERDRAINS
 - 4" S.S.D. TO LOT
 - ASBUILT ELEVATION

BENCHMARKS:
 U.S.G.S. S-78
 STANDARD TABLET SET IN CONCRETE APPROX.
 1000' N. OF 106TH ST. @ EAST R/W LINE
 OF U.S. #421. ELEV.=900.77

S. & A. #3
 P.K. NAIL IN NORTH FACE OF P.W.P. #12-128 A
 12" UP, POLE IS 33' WEST OF PANHANDLE
 EASTERN RED & WHITE GAS LINE MARKER
 ELEV.=895.04

RECORD DRAWING

Jeff W. Darling 12/9/97
 JEFFORY W. DARLING Registered Land Surveyor No. 900017 DATE




- EARTHWORK:**
1. EXCAVATION
 - A. Excavated material that is suitable may be used for fill. All unsuitable material and all surplus excavated material not required shall be removed from the site.
 - B. Provide and place any additional fill material from offsite as may be necessary to produce the grades required on plans. Fill obtained from offsite shall be of quality as specified for fill herein and the source approved by the Developer. It will be the responsibility of the Contractor for any costs for fill needed.
 2. REMOVAL OF TREES
 - A. All trees and stumps from area to be occupied by a road surface area. Trees and stumps shall not be buried on site.
 3. PROTECTION OF TREES
 - A. The Contractor shall, at the direction of the Developer, endeavor to save and protect trees of value and worth which do not impair construction of improvements as designed.
 - B. In the event cut or fill exceeds 0.5 foot over the root area, the Developer shall be consulted with respect of protective measure to be taken, if any, to preserve such trees.
 4. REMOVAL OF TOPSOIL
 - A. All topsoil shall be removed from all areas to be excavated or filled. Topsoil should be stored at a location where it will not interfere with construction operations. The topsoil shall be free of debris and stones.
 5. UTILITIES
 - A. Rules and regulation governing the respective utility shall be observed in executing all work under this section.
 - B. It shall be the responsibility of the Contractor to determine the location of existing underground utilities 2 working days prior to commencing work. For utility locations to be marked call Toll Free 1-800-382-5544 within Indiana or 1-800-428-5200 outside Indiana.
 6. SITE GRADING
 - A. Do all cutting, filling, compacting of fills and rough grading required to bring entire project area to subgrade as shown on the drawing.
 - B. All grade areas shall not exceed 0.10 feet plus or minus the established grade. Provide roundings at top and bottom of banks and other breaks in grade.
 - C. The Engineer shall be notified when the Contractor has reached the tolerance as stated above, so that field measurements and spot elevations can be verified by the Engineer. The Contractor shall not remove his equipment from the site until the Engineer has verified that the job meets the above tolerance.

STR.NO.	TYPE	TC/RIM	INVERTS
940	Concrete End		903.10 (S)
941	Curb Inlet	907.06	903.76 (SE)
942	Curb Inlet	907.06	900.22 (E) (W)
943	Curb Inlet	903.58	900.46 (N) (W)
944	Manhole	903.50	901.76 (N) (S)
947	Curb Inlet	905.46	901.88 (N)
948	Curb Inlet	905.46	901.88 (N)
949	Curb Inlet	905.00	901.12 (S) (E) (W)
950	Curb Inlet	905.00	901.03 (E) (W)
951	Yard Inlet	905.00	902.10 (E) (W)
952	Yard Inlet	905.00	902.70 (E) (W)
953	Concrete End Section		903.30 (W)
954	Curb Inlet	905.63	(E) (W)
955	Curb Inlet	905.63	(E) (W) (N)
956	Inlet	905.00	903.16 (W)
957	Manhole	907.20	903.12 (N) (S)
958	Curb Inlet	906.48	903.40 (S) (NE)
959	Curb Inlet	906.48	903.49 (SW)





19584SST.xls "HOLEY MOLEY" SAYS:
 1-800-382-5544 CALL TOLL FREE
 1-800-428-5200 FOR CALLS OUTSIDE OF INDIANA

CAUTION
 LOCATION OF ALL EXISTING UNDERGROUND UTILITIES SHOWN ON THIS PLAN ARE BASED UPON ABOVE GROUND EVIDENCE (including, but not limited to, manholes, inlets, valves, & marks made upon the ground by others) AND ARE SPECULATIVE IN NATURE. THERE MAY ALSO BE OTHER EXISTING UNDERGROUND UTILITIES FOR WHICH THERE IS NO ABOVE GROUND EVIDENCE OR FOR WHICH NO ABOVE GROUND EVIDENCE WAS OBSERVED. THE EXACT LOCATIONS OF SAID EXISTING UNDERGROUND UTILITIES SHOULD BE VERIFIED BY THE CONTRACTOR PRIOR TO ANY AND ALL CONSTRUCTION.

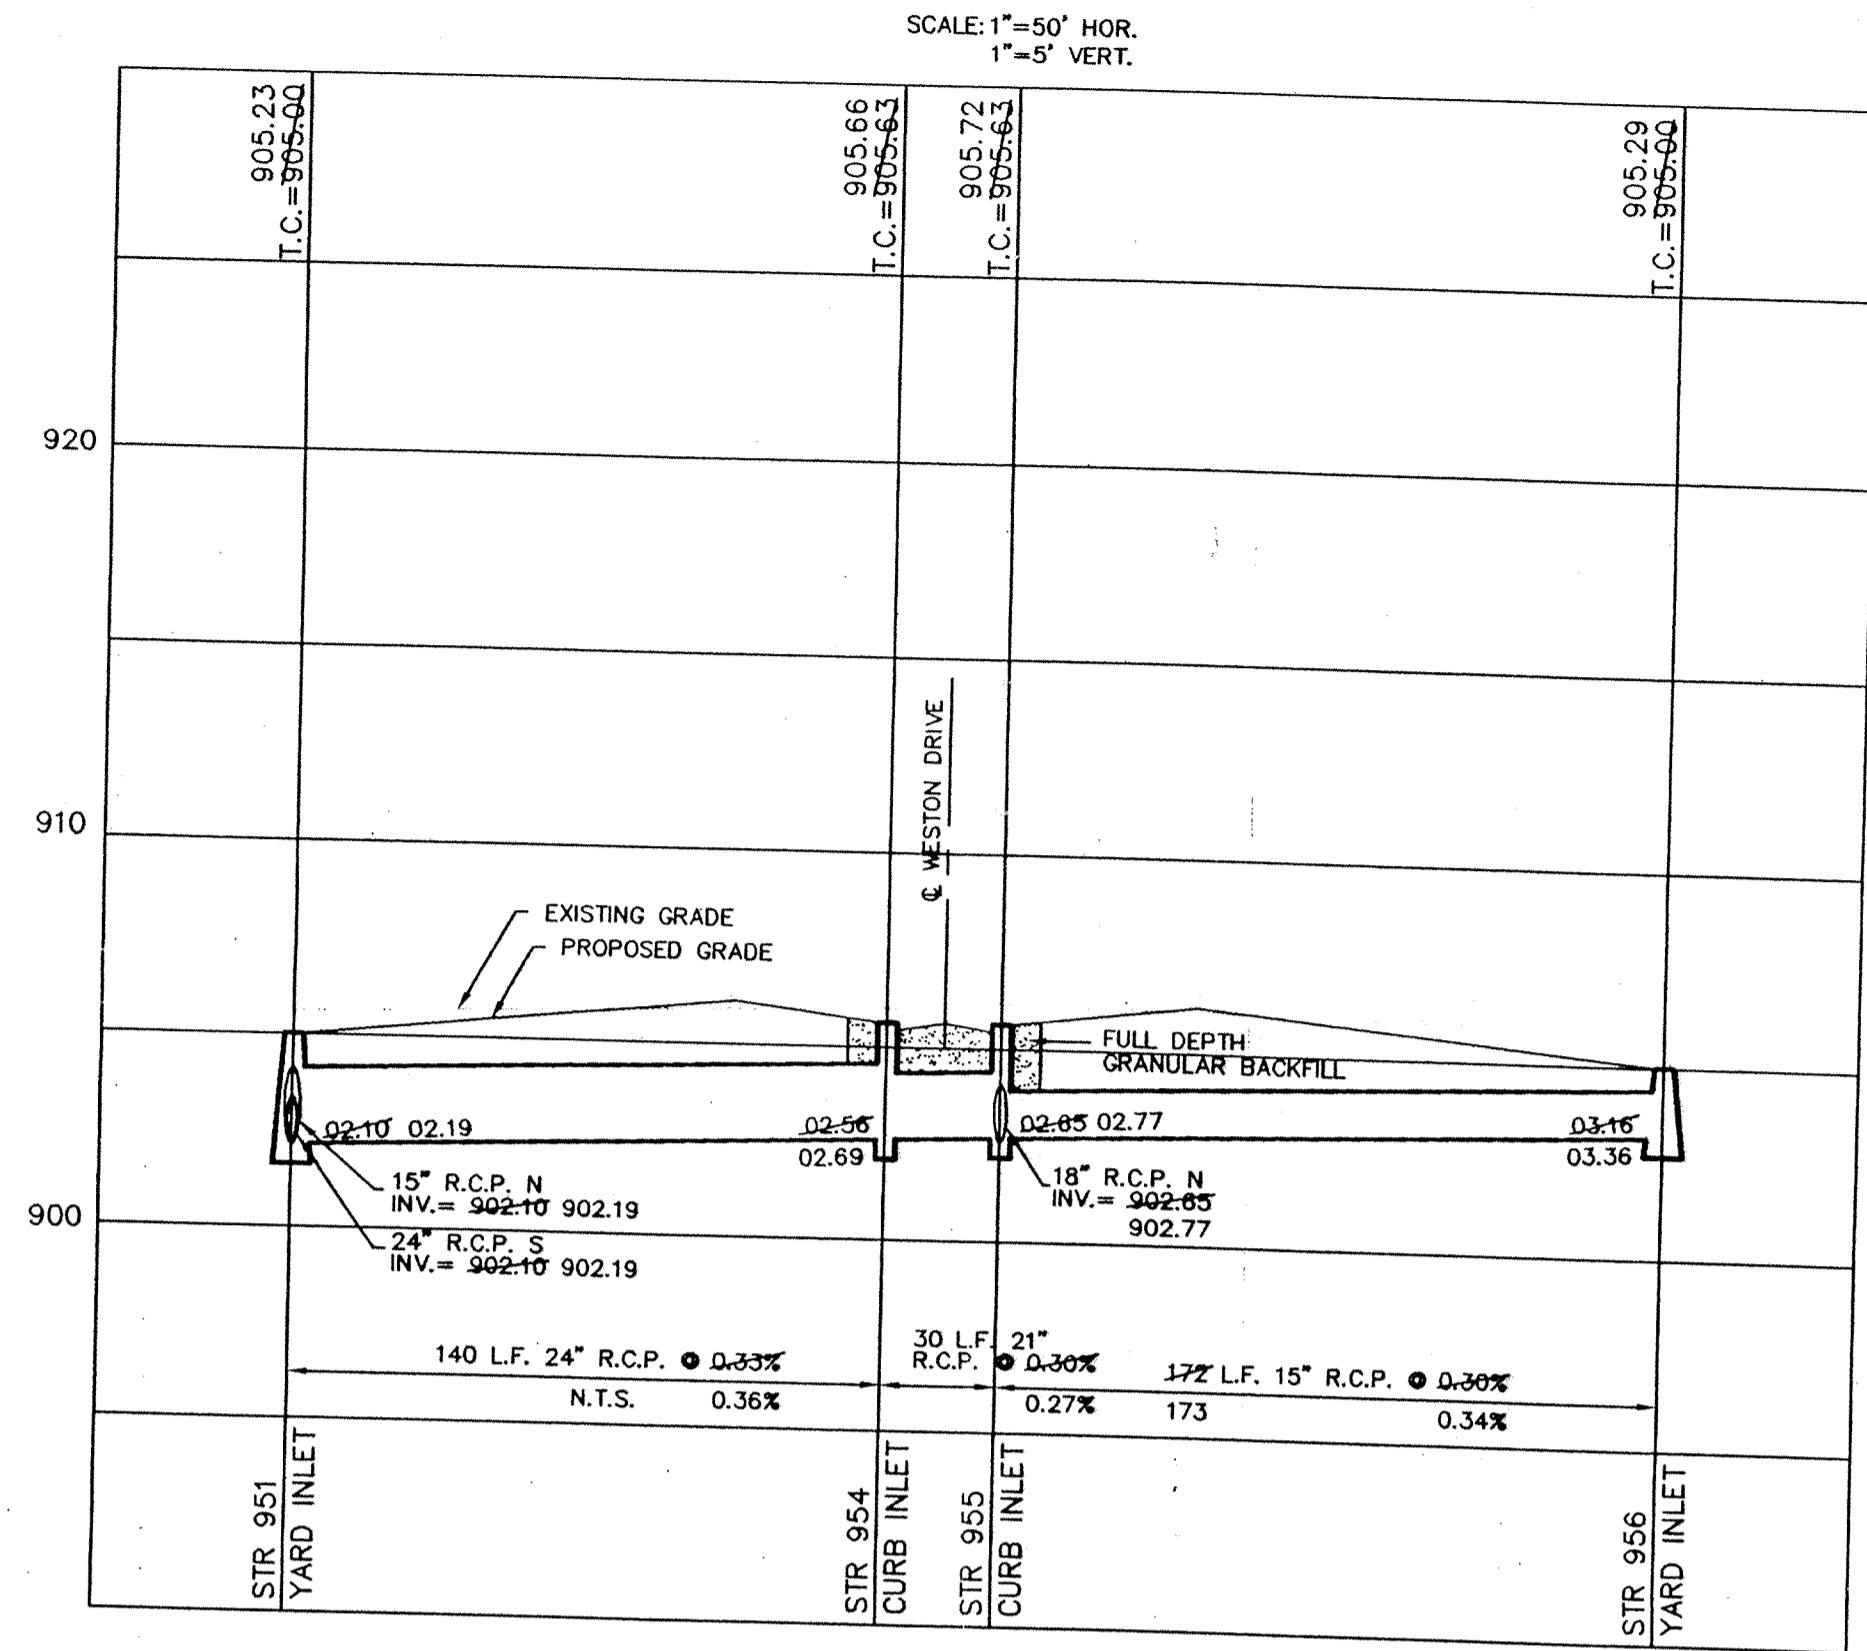


RECORD DRAWING

Jeffery W. Darling 10/16/97
 JEFFERY W. DARLING DATE
 Registered Land Surveyor
 No. 900017

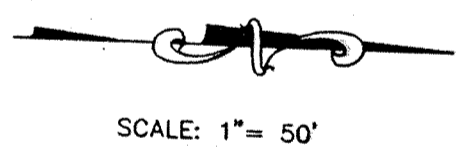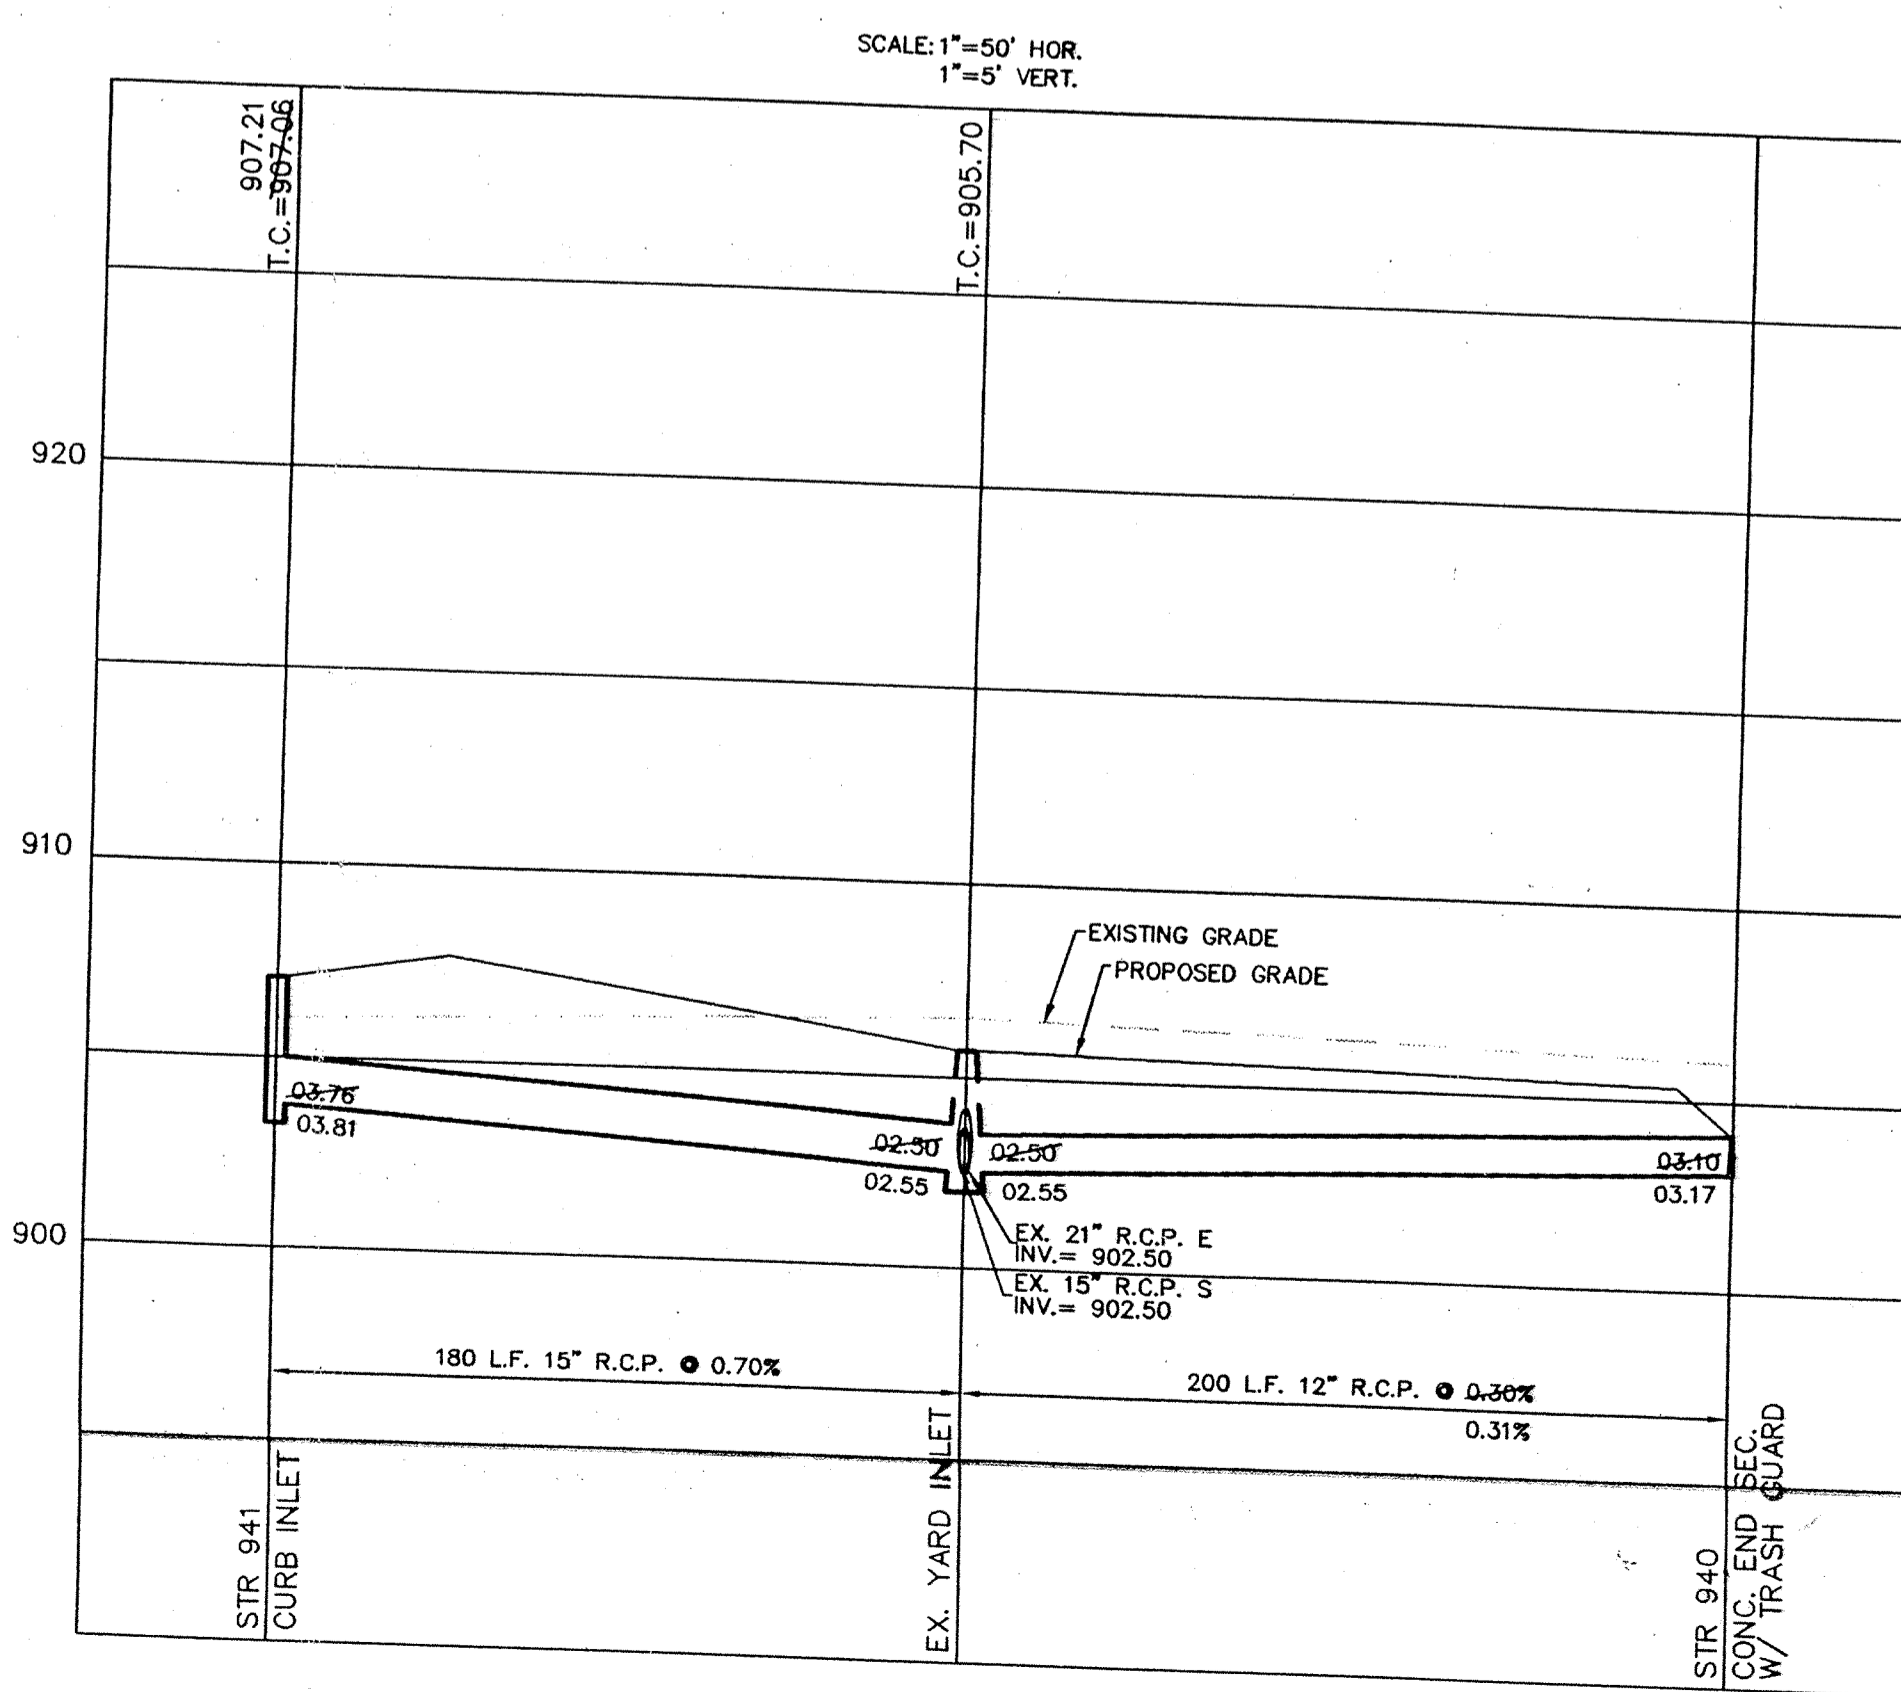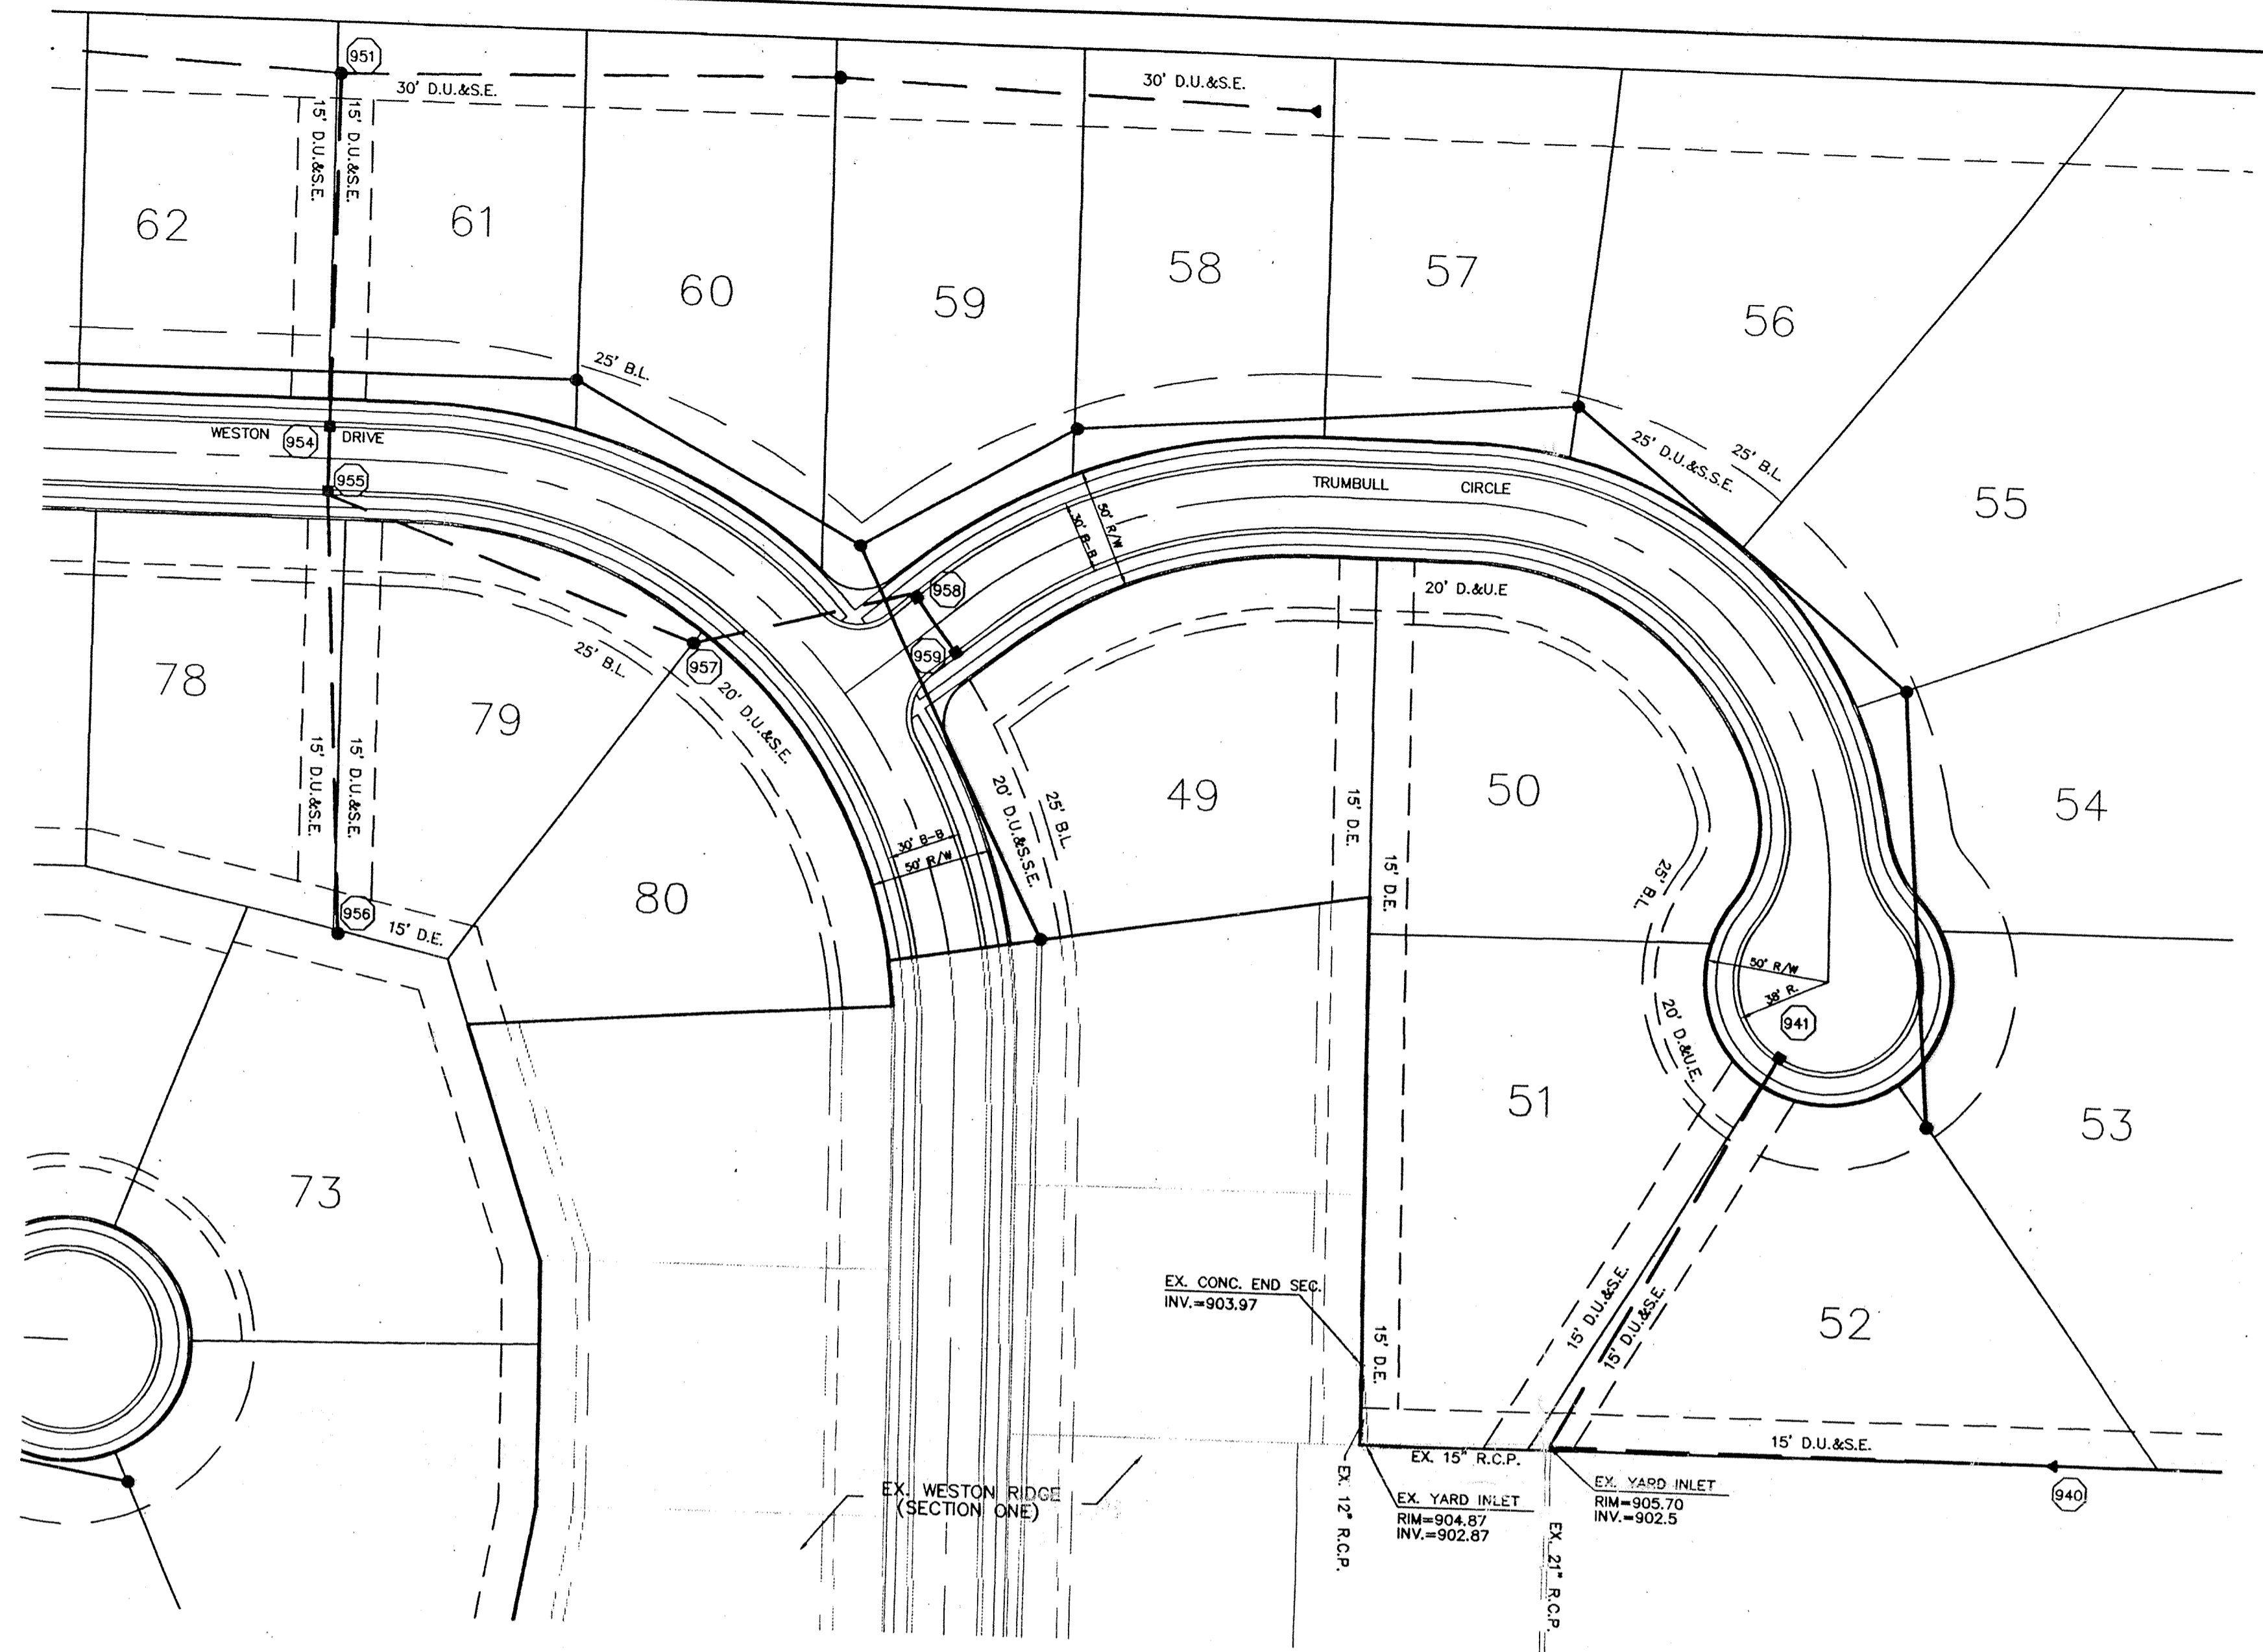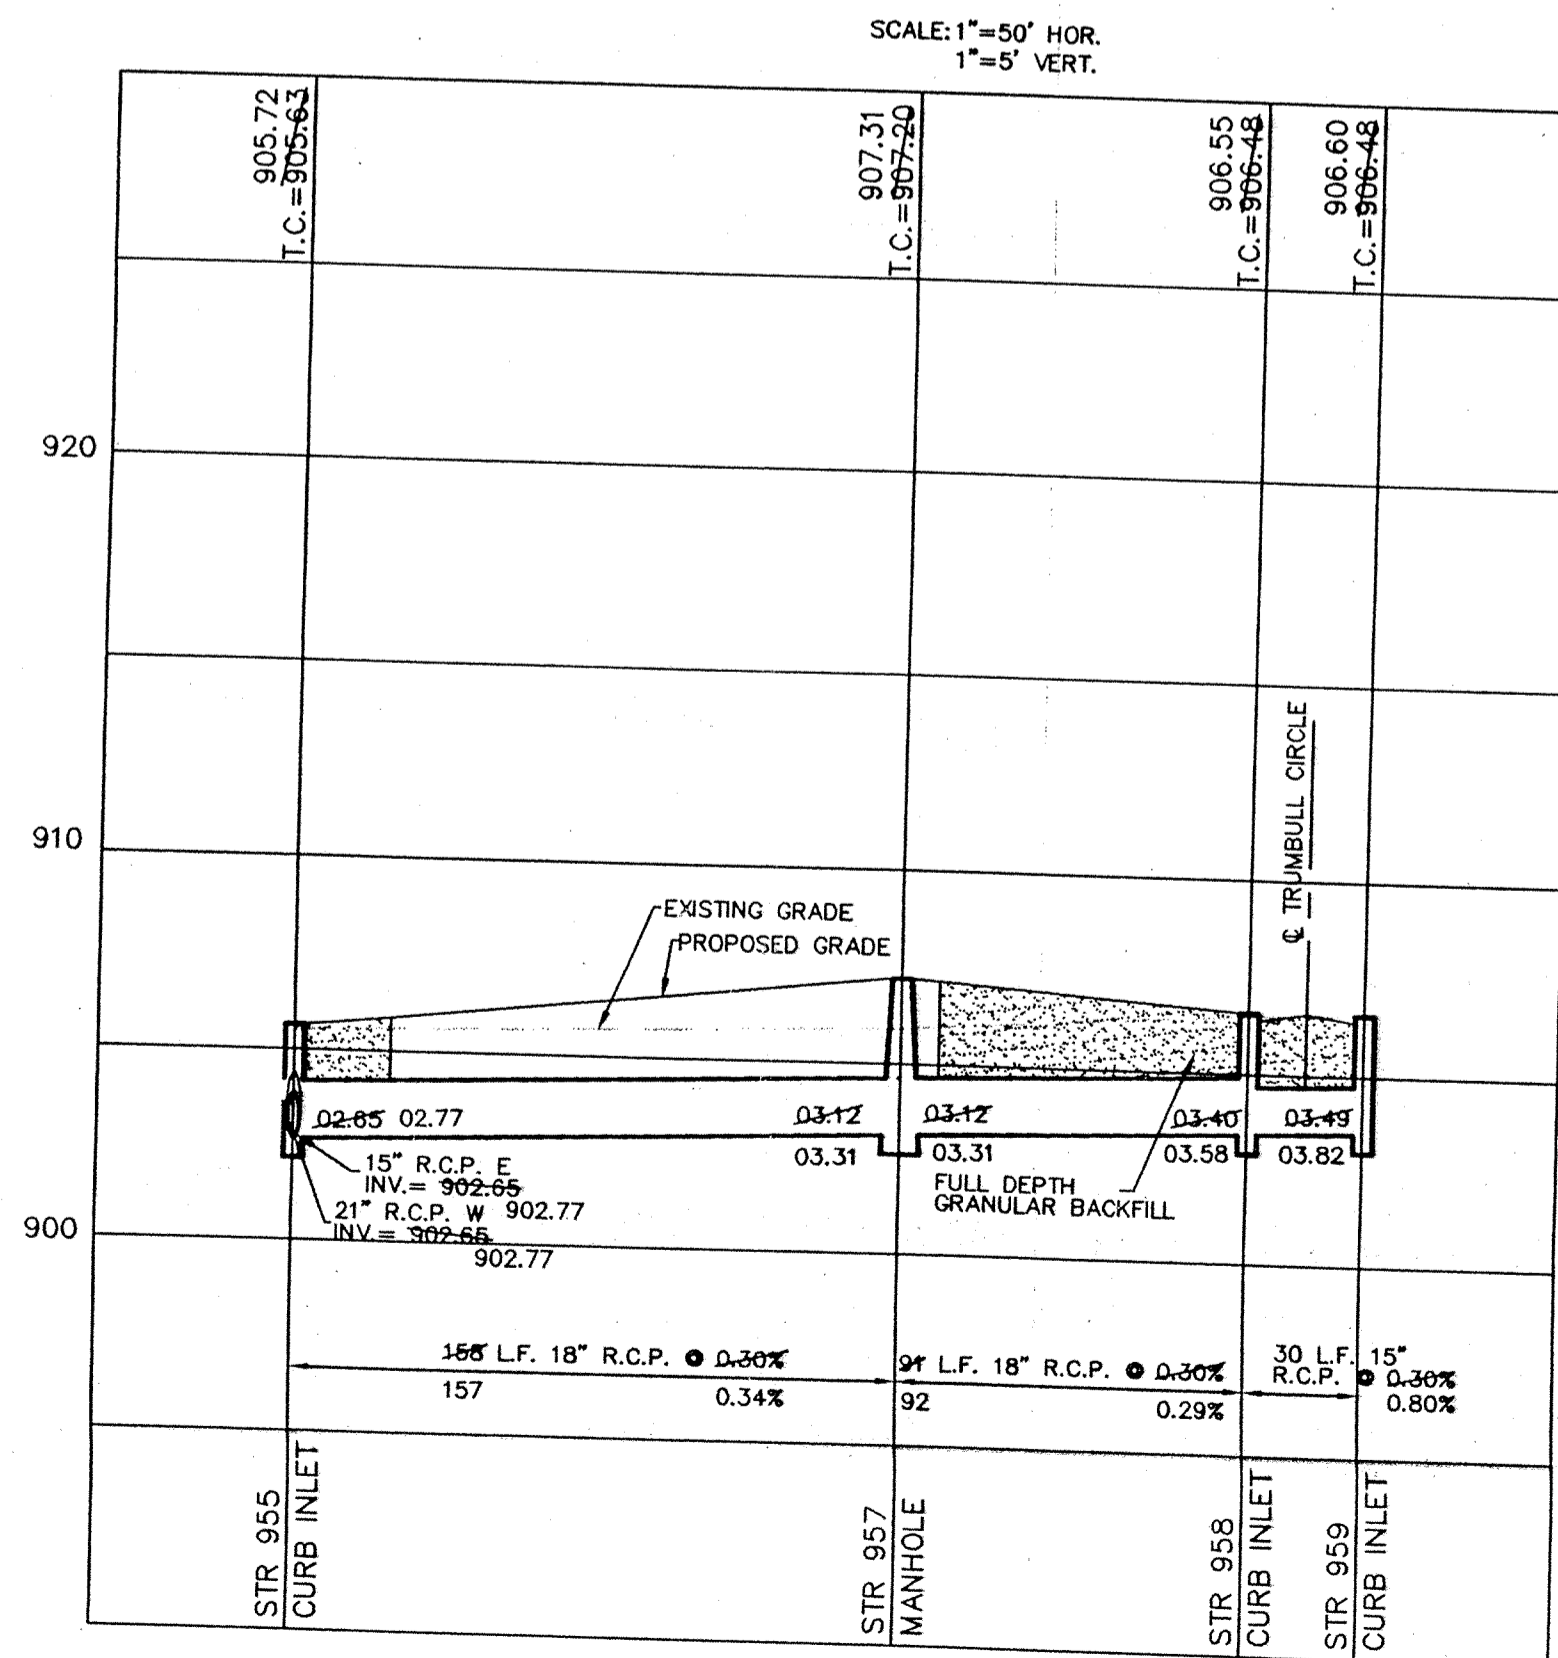

SCALE: 1"= 50'

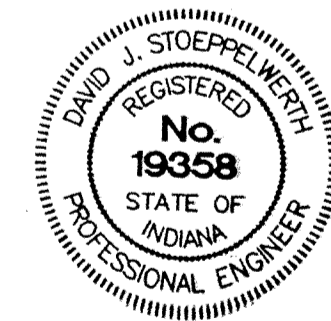


HAMILTON COUNTY INDIANA
 This agreement and the work hereunder is considered an integral part of the contract and is to be read in conjunction with the contract and the specifications.
 Entry Date: 12-3-83
 Entered by: JCH


CERTIFIED: 2/12/97
David J. Stoepelweerd
 CONSULTING ENGINEERS - LAND SURVEYORS
 (317) 849-5935 1-800-728-6917 FAX: (317) 849-5942
 INDIANAPOLIS INDIANA

STORM SEWER PLAN & PROFILE
 WESTON RIDGE SECTION TWO
 CARMEL INDIANA

DATE	BY	REVISIONS
2/12/97 <td> <td></td> </td>	<td></td>	

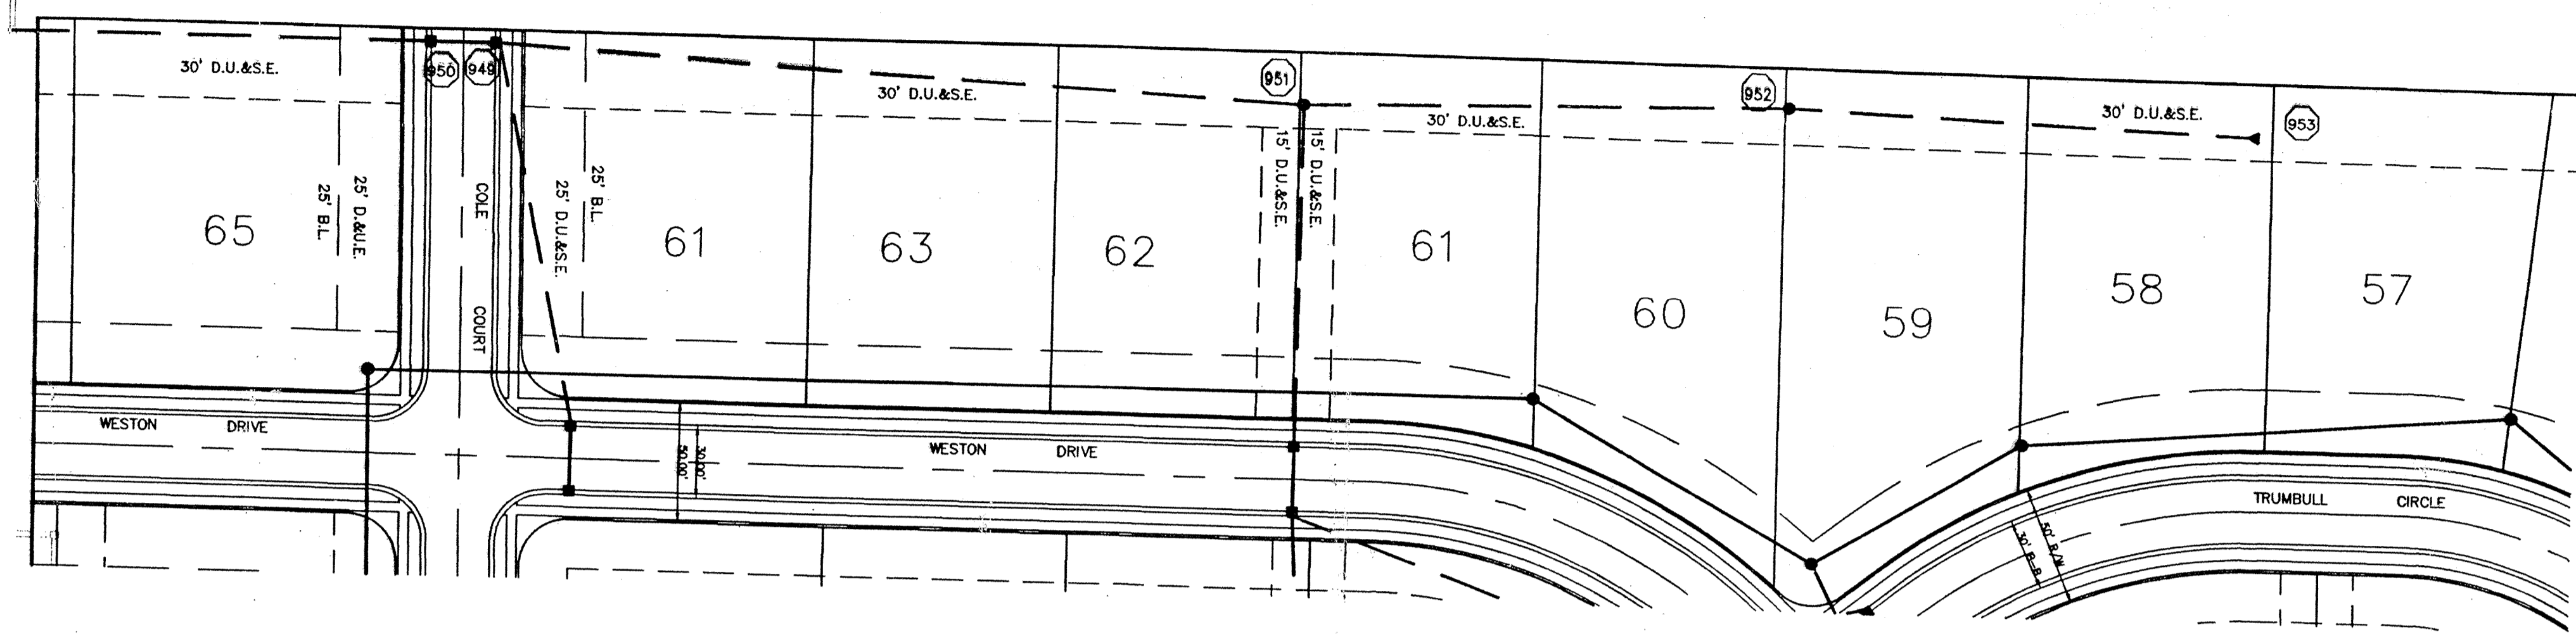


SCALE: 1" = 50'

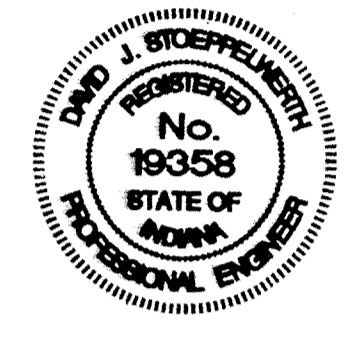

RECORD DRAWING

JEFFORY W. DARLING
 Registered Land Surveyor
 No. 900017
 DATE: 11/21/97

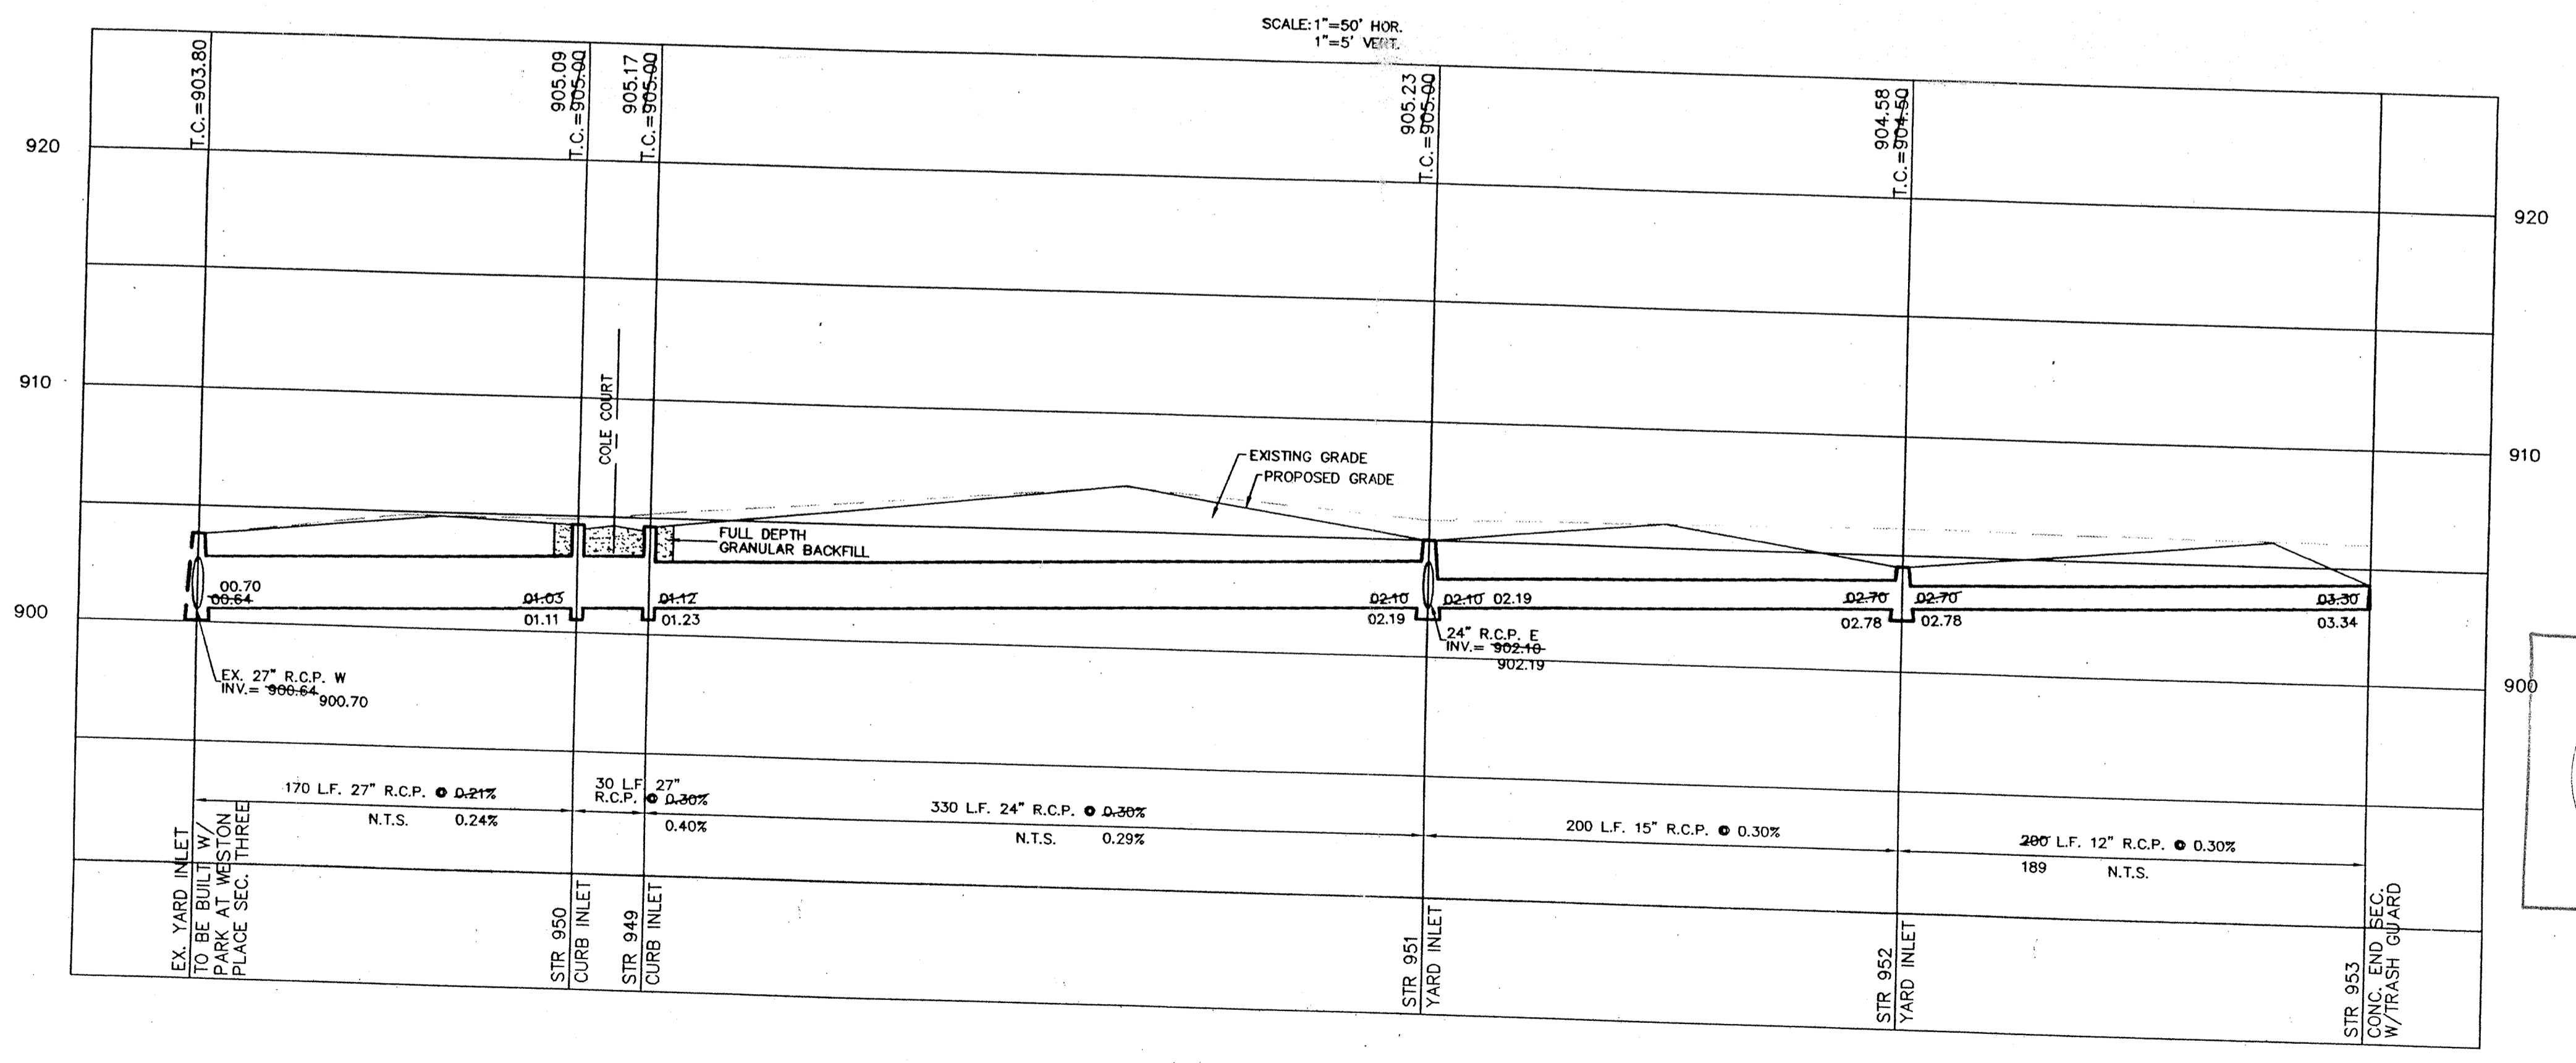





INDIANA COUNTY
 This information was gathered for input into the Hamilton County Geographical Information System. This document is considered an official record of the GIS.
 Entry Date: 12-8-03
 Entered by: JPH

CONSULTING ENGINEERS - LAND SURVEYORS
 (317) 849-5935 1-800-728-6917 FAX: (317) 849-5942
 INDIANAPOLIS INDIANA

STORM SEWER PLAN & PROFILE
WESTON RIDGE SECTION TWO
 CARMEL

DATE	BY	REVISIONS
2/12/97	WAB	REV PER TAC COMMENTS
3/7/97	WAB	REV PER TAC COMMENTS
3/7/97	WAB	REV PER TAC COMMENTS

CERTIFIED: 2/12/97
 David J. Stapp

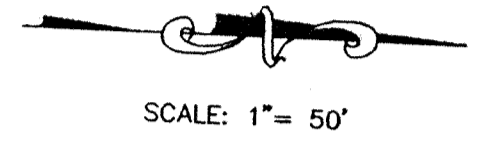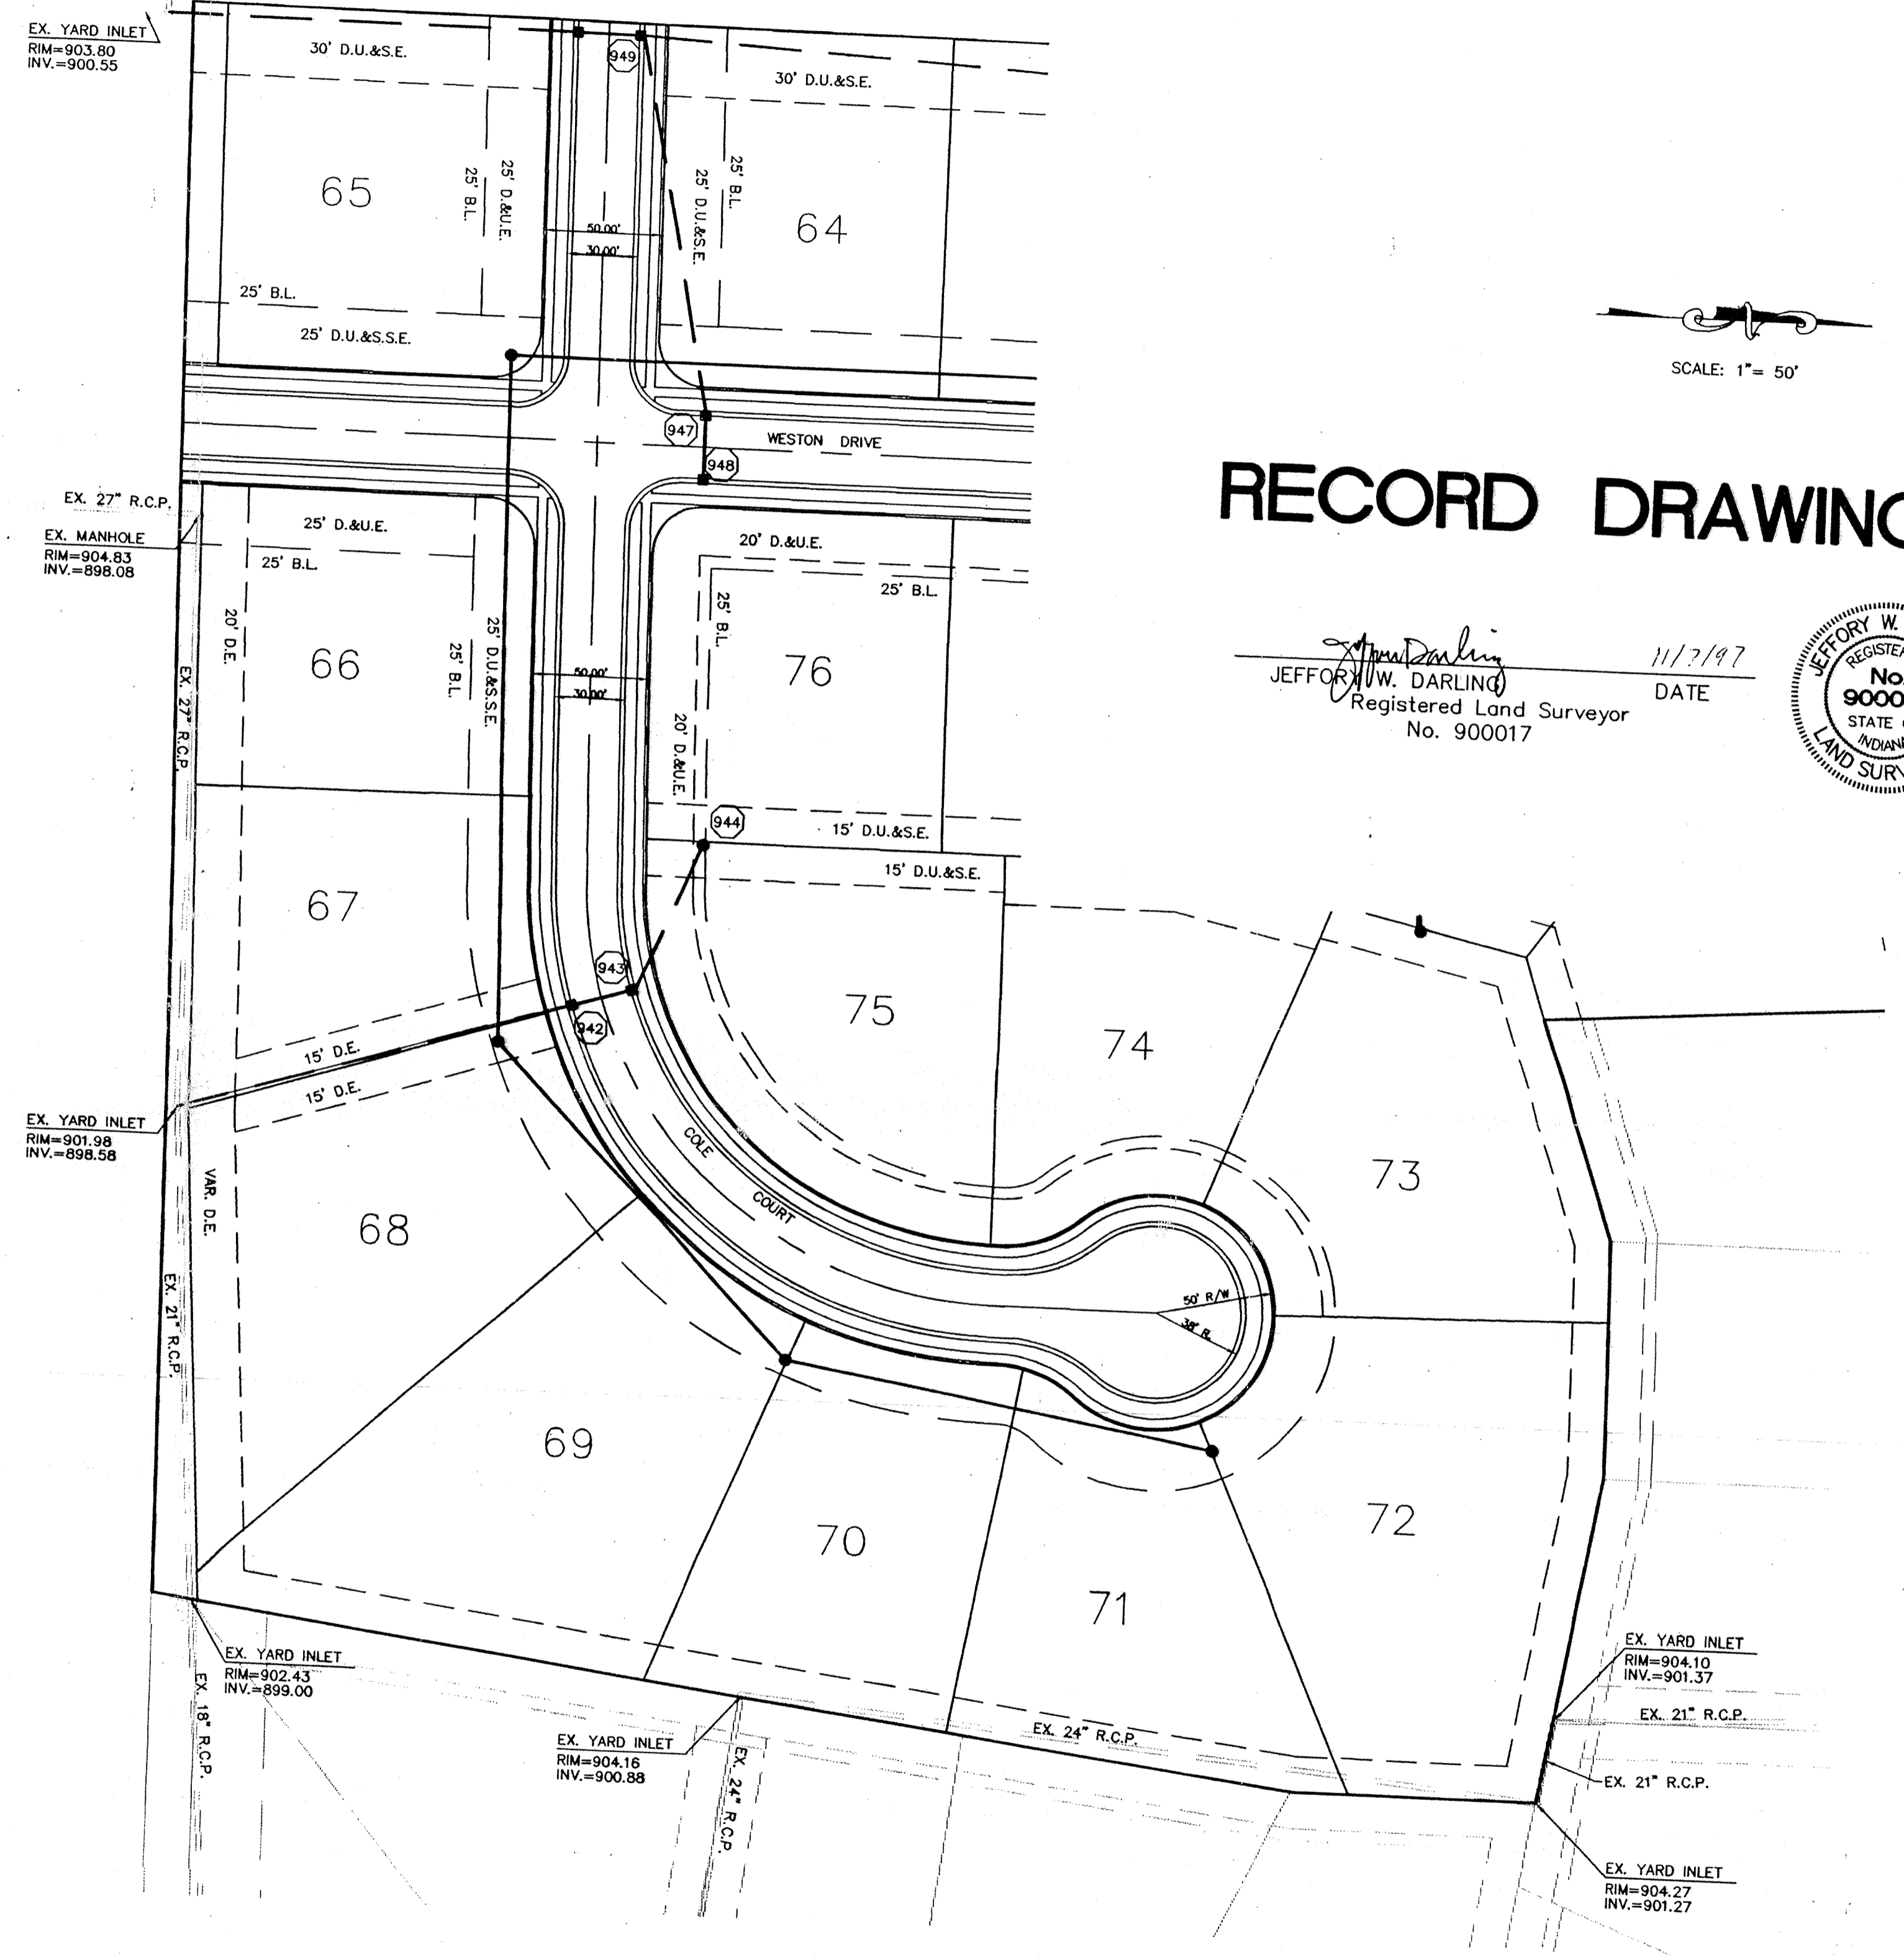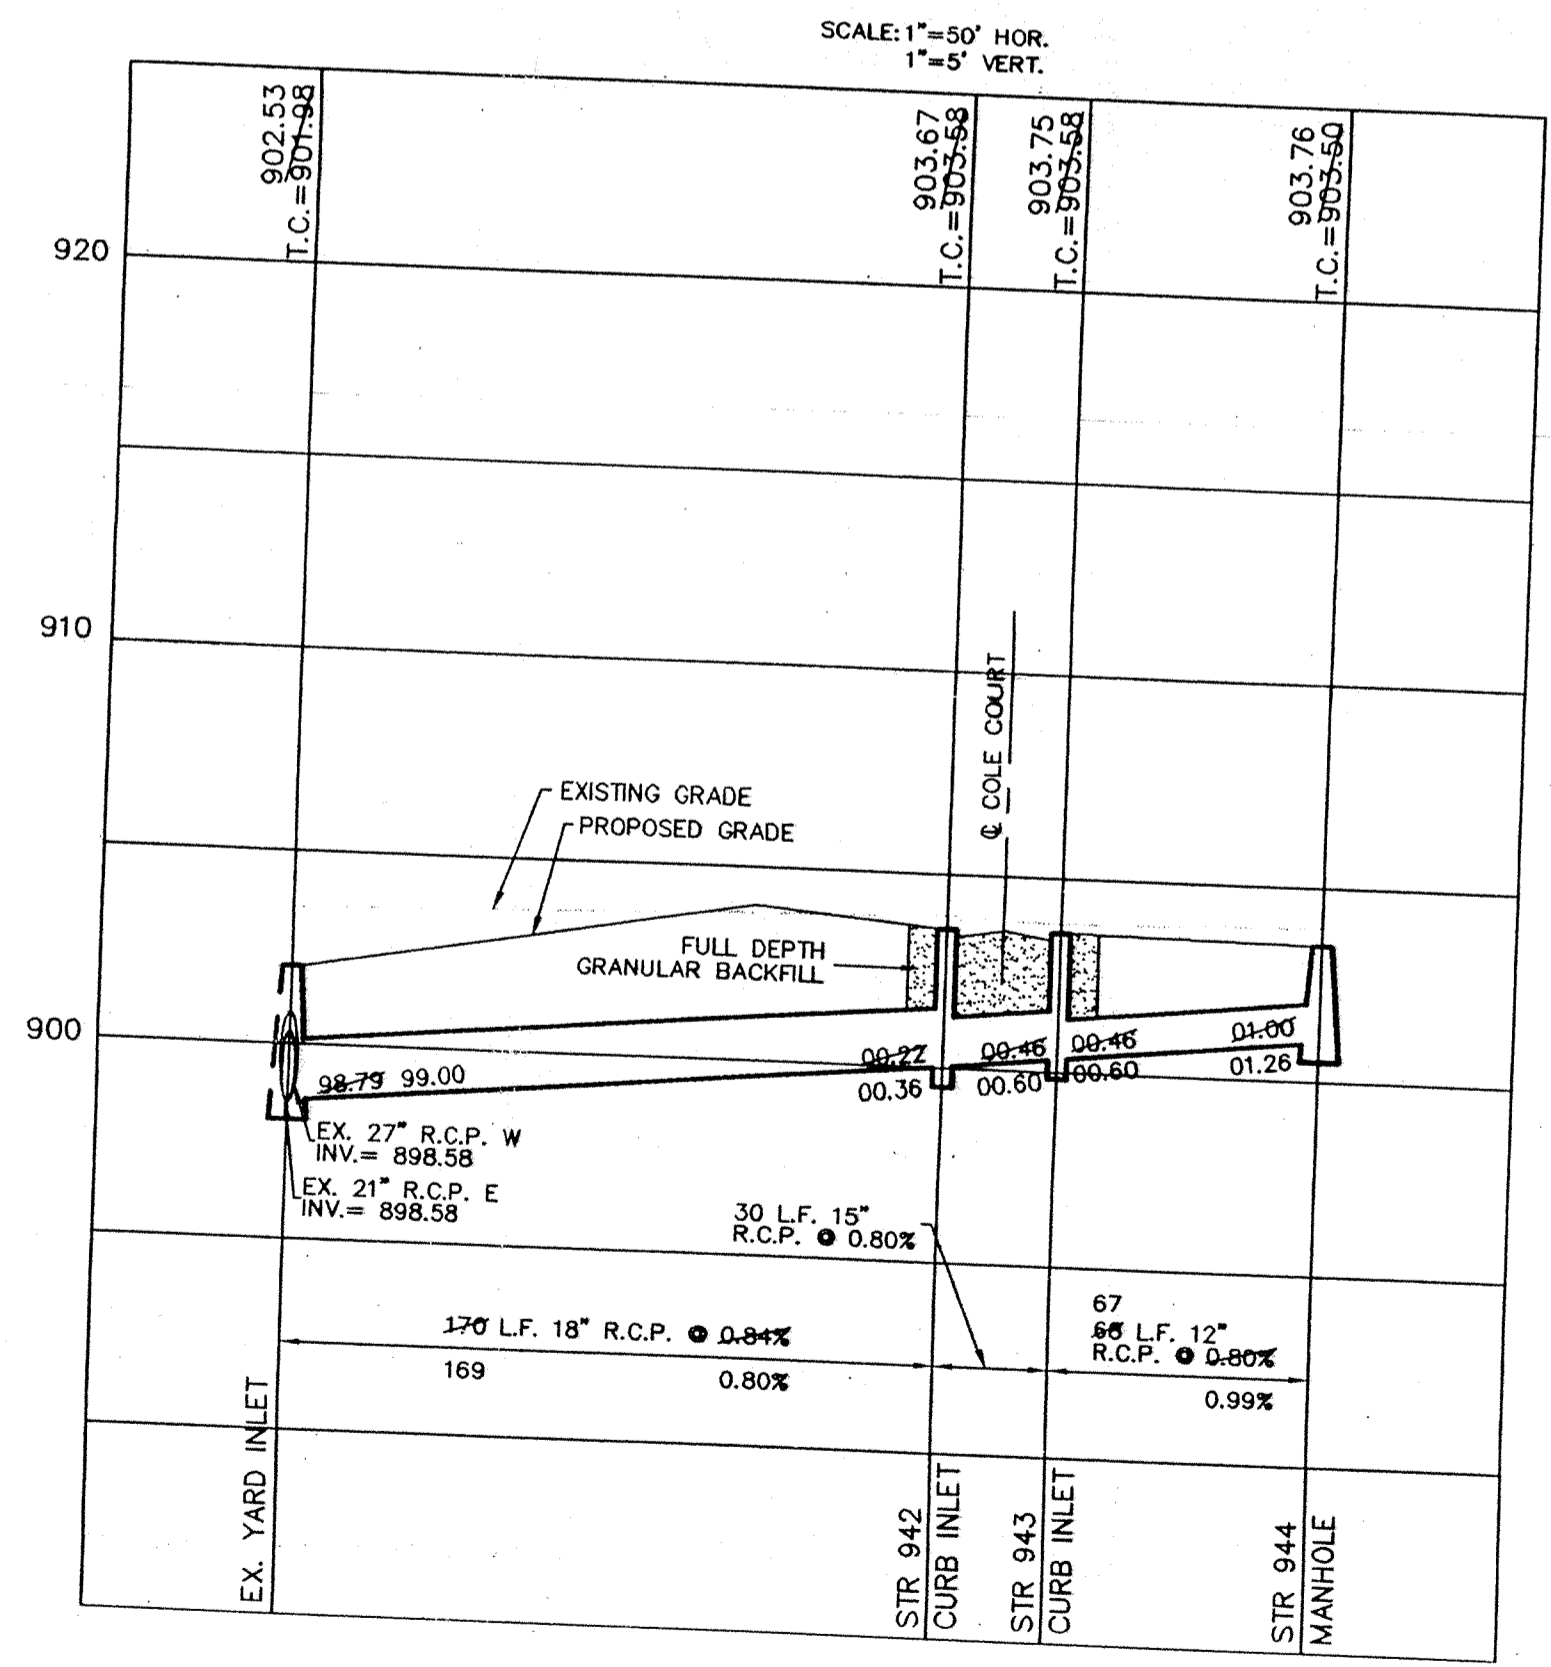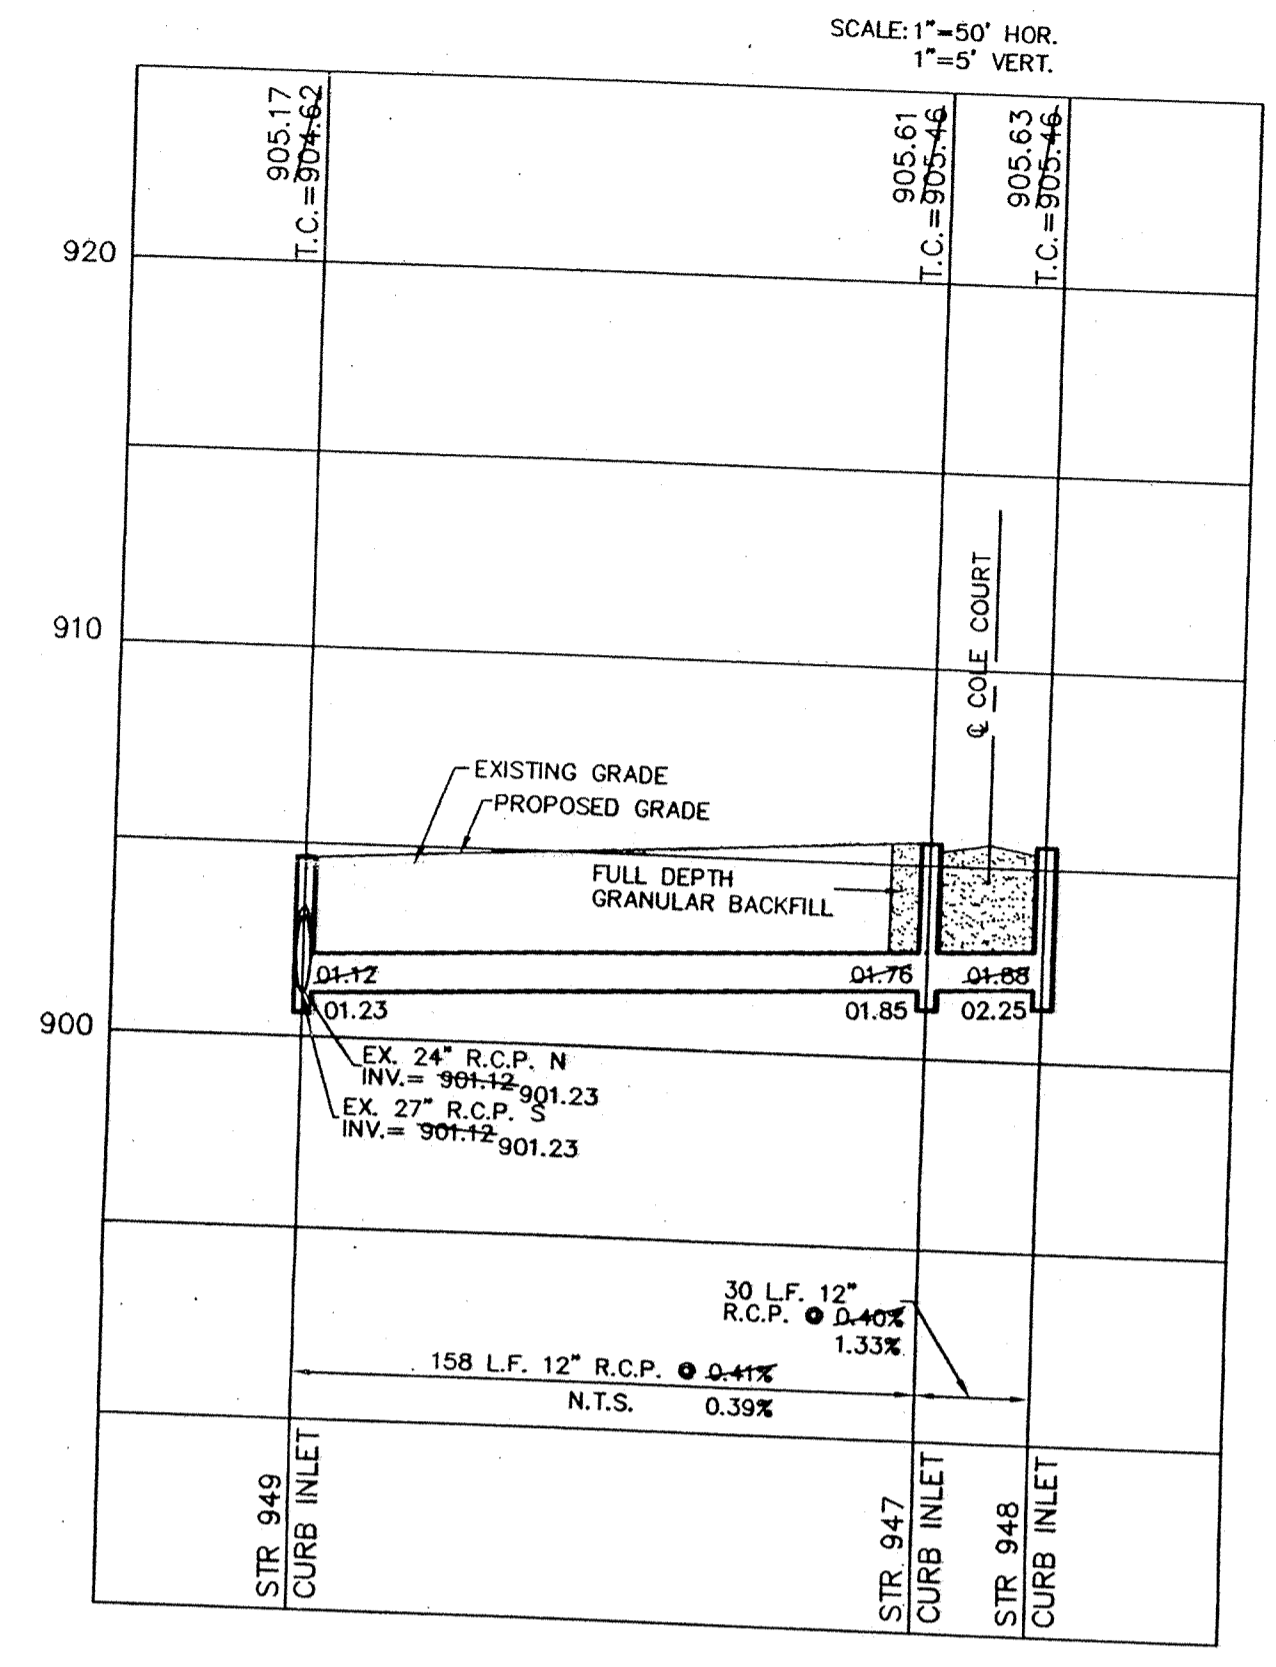

SCALE: 1"= 50'

RECORD DRAWING

Jeffery W. Darling
JEFFERY W. DARLING
Registered Land Surveyor
No. 900017

11/2/97
DATE




DATE	BY	REVISIONS
2/12/97	DAVID J. STAPPELER	AS-BUILT
2/12/97	DAVID J. STAPPELER	REV. PER REV. & TAC COMMENTS
2/12/97	DAVID J. STAPPELER	SOS
2/12/97	DAVID J. STAPPELER	SOS
2/12/97	DAVID J. STAPPELER	BY

CERTIFIED: 2/12/97
David J. Stappeler

CONSULTING ENGINEERS - LAND SURVEYORS
(317) 849-5835 1-800-728-6917 FAX: (317) 849-5942
INDIANAPOLIS INDIANA



STORM SEWER PLAN & PROFILE
WESTON RIDGE SECTION TWO
CARMEL INDIANA

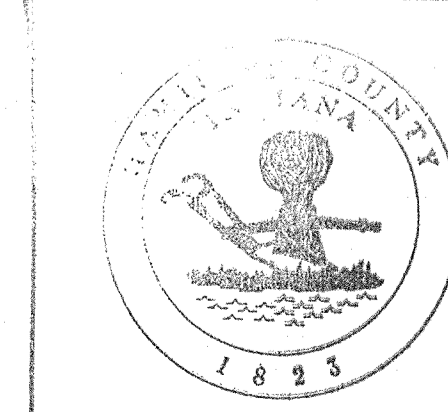

This information was gathered for input into the Hamilton County Geographical Information System. This document is considered an official record of the GIS.
Entry Date: 12-3-03
Entered by: JDH