

**Drain:** JACOB EHMANN      **Drain #:** 98  
**Improvement/Arm:** RELOCATION  
**Operator:** J. LIVINGSTON      **Date:** 12-9-03  
**Drain Classification:** Urban/Rural      **Year Installed:** 1998

### GIS Drain Input Checklist

- Pull Source Documents for Scanning Jung
- Digitize & Attribute Tile Drains SLM
- Digitize & Attribute Storm Drains n/a
- Digitize & Attribute SSD n/a
- Digitize & Attribute Open Ditch n/a
- Stamp Plans SLM
- Sum drain lengths & Validate Jung
- Enter Improvements into Posse Jung/SLM
- Enter Drain Age into Posse n/a
- Sum drain length for Watershed in Posse n/a
- Check Database entries for errors Jung

**Gasb 34 Footages for Historical Cost  
Drain Length Log**

Drain-Improvement: JACOB EHMANN - RELOCATION

Drain Type:	Size:	Length ( )	Length (DB Query)	Length Reconcile	If Applicable	
					Price:	Cost:
rccp	12"	402'				10,000. <sup>00</sup>

Sum: 402' 402' 10,000.<sup>00</sup>

Final Report: 402'

Comments:

---



---



SURVEYOR'S OFFICE  
**Hamilton County**

Kenton C. Ward, Surveyor

Phone (317) 776-8495

Fax (317) 776-9628

Suite 146

One Hamilton County Square

Noblesville, Indiana 46060-2230

May 27, 1997


To: Hamilton County Drainage Board

Re: Jacob Ehman Drain

Attached is a petition for Partial relocation of the Jacob Ehman Drain. This petition was filed by Dave Dodd for the relocation of the tile drain on Parcel Number 01-01-12-00-00-006.008.003. This is to be done on the Petitioners property at the Petitioners expense.

The relocation will consists of rerouting approximately 310 feet of the Arm #1 to Arm #1 of the Jacob Ehman Drain. This is to be done per attached plan as prepared by Miller Surveying. The relocation will consist of 384 feet of 12" concrete tile with risers at both ends of the new tile , where it intersects with the original. This will add approximately seventy-four (74') feet to the drain. Petitioner has submitted a bond for this work.

Because this work is being done on the petitioner's property at his expense and abutting properties will not be adversely affected by construction nor additional easement I believe the project falls under the provisions of IC 36-9-27-52.5. I therefore recommend approval of this petition.

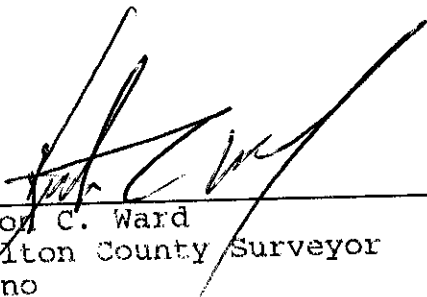  
Kenton C. Ward  
Hamilton County Surveyor  
KCW/no

STATE OF INDIANA )  
 ) SS:  
COUNTY OF HAMILTON)

BEFORE THE HAMILTON COUNTY  
DRAINAGE BOARD

NOBLESVILLE, INDIANA

IN THE MATTER OF THE )  
RECONSTRUCTION OF THE )  
Jacob Ehman DRAIN)

FINDINGS AND ORDER

The matter of the proposed Reconstruction of the \_\_\_\_\_  
Jacob Ehman Drain came before the Hamilton County Drainage  
Board for hearing on May 27 1997, on the  
Reconstruction report and on the Schedule of Damages and Assesse-  
ments. The Board also found that this reconstruction conforms to  
the statutory procedure set out in INDIANA CODE 36-9-27-52.5.


Evidence was heard on the Reconstruction report. There were  
no objections.

The Board having considered the evidence has upon motion  
made, seconded and unanimously carried, found and determined that  
the costs, damages and expenses of the proposed Reconstruction  
will be less than the benefits to the landowners and issued this  
order declaring that this Reconstruction fund be established.

DATED THIS 27th DAY OF May 1997.

HAMILTON COUNTY DRAINAGE BOARD

  
\_\_\_\_\_  
President

  
\_\_\_\_\_  
Member

\_\_\_\_\_  
Member

ATTEST:   
Administrative Secretary

ATTEST:   
HAMILTON COUNTY AUDITOR

Revised 12/95



LICENSE OR PERMIT BOND

THE AETNA CASUALTY AND SURETY COMPANY  
Hartford, Connecticut 06156

KNOW ALL MEN BY THESE PRESENTS:



THAT WE, David Dodd, DBA Dodd Custom Carpentry, Atlanta, Indiana, as Principal, and THE AETNA CASUALTY AND SURETY COMPANY, a corporation duly incorporated under the laws of the State of Connecticut, and authorized to do business in the State of Indiana, as Surety, are held and firmly bound unto the Hamilton County Commissioners, Noblesville, IN, in the penal sum of Ten Thousand dollars and no/100---- (\$ 10,000.00) Dollars, for the payment of which we hereby bind ourselves, our heirs, executors and administrators, jointly and severally by these presents.

THE CONDITIONS OF THIS BOND ARE SUCH, that the said Principal has applied for a license as/for Underground Drainage Tile/Jacob Elmer Drain in accordance with the requirements of the ordinance of said Hamilton County Commissioners, and has agreed to hold said Hamilton County Commissioners harmless from any damage by reason of his/her engaging in said business.

NOW, THEREFORE, if said Principal shall faithfully perform all the duties of Underground Drainage Tile according to the requirements of the ordinance of said Hamilton County Commissioners, and protect said Hamilton County Commissioners from any damage as hereinbefore stated, then this obligation shall be null and void; otherwise to remain in full force and effect.

Provided, However, that this bond may be continued at the option of the Surety by the issuance of a non-cumulative Continuation Certificate.

This bond becomes effective on the 14th day of May, 19 97, for a period ending on the 14th day of May, 19 98.

DATED: May 14, 1997

BOARD OF COMMISSIONERS OF THE COUNTY OF HAMILTON

David Dodd DBA Dodd Custom Carpentry  
Principal

By David Dodd / Owner  
Title

THE AETNA CASUALTY AND SURETY COMPANY.  
By Michael Elmer  
Attorney-in-Fact

DATE \_\_\_\_\_

ATTEST: \_\_\_\_\_  
HAMILTON COUNTY AUDITOR

S-2151-A (1-93)

BOND REPORT FORM			
Bond Number	27S1Q1120399BCM	Field Office	Indianapolis
		Producer	Sorg/Ehrman Code 8220
PRINCIPAL'S Address	28579 Dunbar Road, Atlanta, IN 46031		
Occupation	Net Worth \$	Years of experience in this business	
Papers attached	<input type="checkbox"/> Principal's Financial Statement	<input type="checkbox"/> Indemnity Agreements	<input type="checkbox"/> Copy of Ordinance
We have personally known principal for _____ years and recommend him/her unqualifiedly.			
Signed _____			Producer

Company Copy - Green; Agent's Copy - Pink; Principal's Copy - Canary

POWER OF ATTORNEY AND CERTIFICATE OF AUTHORITY OF ATTORNEY(S)-IN-FACT

KNOW ALL MEN BY THESE PRESENTS, THAT AETNA CASUALTY & SURETY COMPANY OF AMERICA, a corporation duly organized under the laws of the State of Connecticut, and having its principal office in the City of Hartford, County of Hartford, State of Connecticut, hath made, constituted and appointed, and does by these presents make, constitute and appoint James D. Sorg or Michael C. Ehrman - -

of Indianapolis, IN, its true and lawful Attorneys-in-Fact, with full power and authority hereby conferred to sign, execute and acknowledge, at any place within the United States, or, if the following line be filled in, within the area there designated, the following instrument(s); by his sole signature and act, any and all bonds, recognizances, contracts of indemnity, and other writings obligatory in the nature of a bond, recognizance, or conditional undertaking, and any and all consents incident thereto

not exceeding the sum of TWO HUNDRED FIFTY THOUSAND (\$250,000.00) DOLLARS -

and to bind AETNA CASUALTY & SURETY COMPANY OF AMERICA, thereby as fully and to the same extent as if the same were signed by the duly authorized officers of AETNA CASUALTY & SURETY COMPANY OF AMERICA, and all the acts of said Attorneys-in-Fact, pursuant to the authority herein given, are hereby ratified and confirmed.

This appointment is made under and by authority of the following Standing Resolutions of said Company which Resolutions are now in full force and effect: VOTED: That each of the following officers: President, Any Executive Vice President, Any Senior Vice President, Any Vice President, Any Assistant Vice President, Any Secretary, Any Assistant Secretary, may from time to time appoint Resident Vice Presidents, Resident Assistant Secretaries, Attorneys-in-Fact, and Agents to act for and on behalf of the Company and may give any such appointee such authority as his or her certificate of authority may prescribe to sign with the Company's name and seal with the Company's seal bonds, recognizances, contracts of indemnity, and other writings obligatory in the nature of a bond, recognizance, or conditional undertaking, and any of said officers or the Board of Directors may at any time remove any such appointee and revoke the power and authority given him or her.

VOTED: That any bond, recognizance, contract of indemnity, or writing obligatory in the nature of a bond, recognizance, or conditional undertaking shall be valid and binding upon the Company when (a) signed by the President, an Executive Vice President, a Senior Vice President, a Vice President, an Assistant Vice President or by a Resident Vice President, pursuant to the power prescribed in the certificate of authority of such Resident Vice President, and duly attested and sealed with the Company's seal by a Secretary or Assistant Secretary or by a Resident Assistant Secretary, pursuant to the power prescribed in the certificate of authority of such Resident Assistant Secretary; or (b) duly executed (under seal, if required) by one or more Attorneys-in-Fact pursuant to the power prescribed in his or her certificate or their certificates of authority.

This Power of Attorney and Certificate of Authority is signed and sealed by facsimile under and by authority of the following Standing Resolution voted by the Board of Directors of AETNA CASUALTY & SURETY COMPANY OF AMERICA which Resolution is now in full force and effect:

VOTED: That the signature of each of the following officers: President, Any Executive Vice President, Any Senior Vice President, Any Vice President, Any Assistant Vice President, Any Secretary, Any Assistant Secretary, and the seal of the Company may be affixed by facsimile to any power of attorney or to any certificate relating thereto appointing Resident Vice Presidents, Resident Assistant Secretaries or Attorneys-in-Fact for purposes only of executing and attesting bonds and undertakings and other writings obligatory in the nature thereof, and any such power of attorney or certificate bearing such facsimile signature or facsimile seal shall be valid and binding upon the Company and any such power so executed and certified by such facsimile signature and facsimile seal shall be valid and binding upon the Company in the future with respect to any bond or undertaking to which it is attached.

IN WITNESS WHEREOF, AETNA CASUALTY & SURETY COMPANY OF AMERICA has caused this instrument to be signed by its Vice President, and its corporate seal to be hereto affixed this 27th day of October, 1995

AETNA CASUALTY & SURETY COMPANY OF AMERICA



By Terry F. Lukow  
Terry F. Lukow  
Vice President

State of Connecticut }  
County of Hartford } ss. Hartford

On this 27th day of October, 1995, before me personally came TERRY F. LUKOW to me known, who, being by me duly sworn, did depose and say: that he/she is Vice President of AETNA CASUALTY & SURETY COMPANY OF AMERICA, the corporation described in and which executed the above instrument; that he/she knows the seal of said corporation; that the seal affixed to the said instrument is such corporate seal; and that he/she executed the said instrument on behalf of the corporation by authority of his/her office under the Standing Resolutions thereof.



Dorothy L. Marti  
My commission expires August 31, 1998  
Dorothy L. Marti  
Notary Public

CERTIFICATE

I, the undersigned, Assistant Secretary of AETNA CASUALTY & SURETY COMPANY OF AMERICA, a stock corporation of the State of Connecticut, DO HEREBY CERTIFY that the foregoing and attached Power of Attorney and Certificate of Authority remains in full force and has not been revoked; and furthermore, that the Standing Resolutions of the Board of Directors, as set forth in the Certificate of Authority, are now in force.

Signed and Sealed at the Home Office of the Company, in the City of Hartford, State of Connecticut. Dated this

May 1997

14th day of



By Rose Gonsoulin  
Rose Gonsoulin  
Assistant Secretary

# ACORD. CERTIFICATE OF INSURANCE

ISSUE DATE (MM/DD/YY)

CUSTOMER # 13178  05/14/97

**PRODUCER**  
 SORG/EHRMAN INSURANCE  
 1709 NORTH SHADELAND AVE  
 INDIANAPOLIS, IN 46219

THIS CERTIFICATE IS ISSUED AS A MATTER OF INFORMATION ONLY AND CONFERS NO RIGHTS UPON THE CERTIFICATE HOLDER. THIS CERTIFICATE DOES NOT AMEND, EXTEND OR ALTER THE COVERAGE AFFORDED BY THE POLICIES BELOW.

## COMPANIES AFFORDING COVERAGE

COMPANY LETTER **A** GENERAL CASUALTY

COMPANY LETTER **B** AETNA CAS & SURETY

COMPANY LETTER **C**

COMPANY LETTER **D**

COMPANY LETTER **E**

**INSURED**  
 DAVID DODD DBA  
 DODD CUSTOM CARPENTRY  
 28579 DUNBAR ROAD  
 ATLANTA, IN  
 46031

## COVERAGES

THIS IS TO CERTIFY THAT THE POLICIES OF INSURANCE LISTED BELOW HAVE BEEN ISSUED TO THE INSURED NAMED ABOVE FOR THE POLICY PERIOD INDICATED, NOTWITHSTANDING ANY REQUIREMENT, TERM OR CONDITION OF ANY CONTRACT OR OTHER DOCUMENT WITH RESPECT TO WHICH THIS CERTIFICATE MAY BE ISSUED OR MAY PERTAIN. THE INSURANCE AFFORDED BY THE POLICIES DESCRIBED HEREIN IS SUBJECT TO ALL THE TERMS, EXCLUSIONS AND CONDITIONS OF SUCH POLICIES. LIMITS SHOWN MAY HAVE BEEN REDUCED BY PAID CLAIMS.

CO LTR	TYPE OF INSURANCE	POLICY NUMBER	POLICY EFFECTIVE DATE (MM/DD/YY)	POLICY EXPIRATION DATE (MM/DD/YY)	LIMITS
A	<b>GENERAL LIABILITY</b> <input checked="" type="checkbox"/> COMMERCIAL GENERAL LIABILITY <input type="checkbox"/> CLAIMS MADE <input checked="" type="checkbox"/> OCCUR. <input type="checkbox"/> OWNER'S & CONTRACTOR'S PROT.	CCX 0174364	12/03/96	12/03/97	GENERAL AGGREGATE \$ 500,000 PRODUCTS-COMP/OP AGG. \$ 500,000 PERSONAL & ADV. INJURY \$ 500,000 EACH OCCURRENCE \$ 500,000 FIRE DAMAGE (Any one fire) \$ 50,000 MED. EXPENSE (Any one person) \$ 5,000
	<b>AUTOMOBILE LIABILITY</b> <input type="checkbox"/> ANY AUTO <input type="checkbox"/> ALL OWNED AUTOS <input type="checkbox"/> SCHEDULED AUTOS <input type="checkbox"/> HIRED AUTOS <input type="checkbox"/> NON-OWNED AUTOS <input type="checkbox"/> GARAGE LIABILITY				COMBINED SINGLE LIMIT \$ BODILY INJURY (Per person) \$ BODILY INJURY (Per accident) \$ PROPERTY DAMAGE \$
	<b>EXCESS LIABILITY</b> <input type="checkbox"/> UMBRELLA FORM <input type="checkbox"/> OTHER THAN UMBRELLA FORM				EACH OCCURRENCE \$ AGGREGATE \$
	<b>WORKER'S COMPENSATION AND EMPLOYERS' LIABILITY</b>				STATUTORY LIMITS EACH ACCIDENT \$ DISEASE-POLICY LIMIT \$ DISEASE-EACH EMPLOYEE \$
	<b>OTHER</b> BSURETY BOND	27S101120399	05/14/97	05/14/98	\$10,000

## DESCRIPTION OF OPERATIONS/LOCATIONS/VEHICLES/SPECIAL ITEMS

UNDERGROUND DRAINAGE TILE FOR 28579 DUNBAR ROAD, ATLANTA, IN 46031

## CERTIFICATE HOLDER

HAMILTON COUNTY COMMISSIONERS  
 HAMILTON CTY COURTHOUSE  
 NOBLESVILLE, IN

46060

## CANCELLATION

SHOULD ANY OF THE ABOVE DESCRIBED POLICIES BE CANCELLED BEFORE THE EXPIRATION DATE THEREOF, THE ISSUING COMPANY WILL ENDEAVOR TO MAIL 30 DAYS WRITTEN NOTICE TO THE CERTIFICATE HOLDER NAMED TO THE LEFT, BUT FAILURE TO MAIL SUCH NOTICE SHALL IMPOSE NO OBLIGATION OR LIABILITY OF ANY KIND UPON THE COMPANY, ITS AGENTS OR REPRESENTATIVES.

AUTHORIZED REPRESENTATIVE



CERTIFICATE OF COMPLETION AND COMPLIANCE

To: Hamilton County Surveyor

Re: JACOB EHMAN DRAIN - DODD RELOCATION

I hereby certify that:

1. I am a Registered Land Surveyor or Engineer in the State of Indiana .
2. I am familiar with the plans and specifications for the above referenced subdivision .
3. I have personally observed and supervised the completion of the drainage facilities for the above referenced subdivision .
4. The drainage facilities within the above referenced subdivision to the best of my knowledge , information and belief have been installed and completed in comformity with all plans and specifications .

Signature: Leland D Miller Jr Date: 12/29/97

Type or Print Name: LELAND D. MILLER JR.

Business Address: 948 CONNER ST

NOBLESVILLE IN 46060

Telephone Number: 773-2644


SEAL



INDIANA REGISTRATION NUMBER

S0083



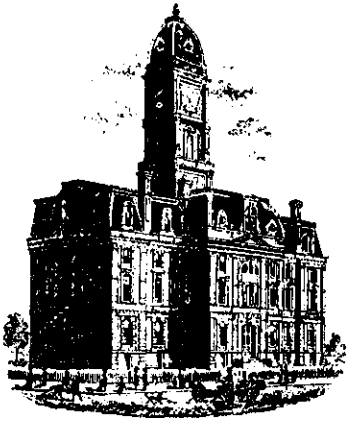

SURVEYOR'S OFFICE

# Hamilton County

*Kenton C. Ward, Surveyor*

*Phone (317) 776-8495*

*Fax (317) 776-9628*

*Suite 146*

*One Hamilton County Square*

*Noblesville, Indiana 46060-2230*

To: Hamilton County Drainage Board

January 28, 1998

**Re: Jacob Ehman Drain Relocation**

Attached are as-builts, certificate of completion & compliance, and other information for the Jacob Ehman Drain Relocation. An inspection of the drainage facilities for this section has been made and the facilities were found to be complete and acceptable.

During construction, changes were made to the drain which will alter the plans submitted with my report for this drain dated May 27, 1997. The changes are as follows:  
Str1-2 12" Concrete Tile lengthened from 384' feet to 402' feet.


The additional length of the drain due to the changes described above is now **92' feet**.

No additional easement was necessary for the relocation of the drain and the petitioner did not request a non-enforcement.

The bond or letter of credit from Aetna Casualty and Surety Company, number 27S101120399BCM; dated May 14, 1997; in the amount of \$10,000.00; was released January 12, 1998.

I recommend the Board approve the drains construction as complete and acceptable.

Sincerely,

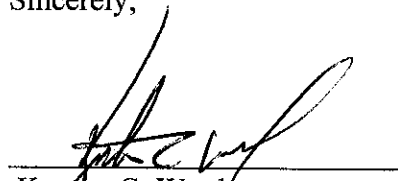

---

Kenton C. Ward,  
Hamilton County Surveyor

KCW/slm

# Asbuilt Structures

Project: JACOB ELMAN DRAIN

Structure: T.C.: I.E.: Pipe: Length: Original Plans: Difference:

RISER #1	101.23	96.64				
Riser #2	101.11	96.10	12"CT	402.0'	FRM 304'	+18'

6" SSD Streets:


Total: \_\_\_\_\_




6" SSD Lots:


Total: \_\_\_\_\_

RCP Pipe Totals:


Other Drain:



Total Length of Drain: \_\_\_\_\_

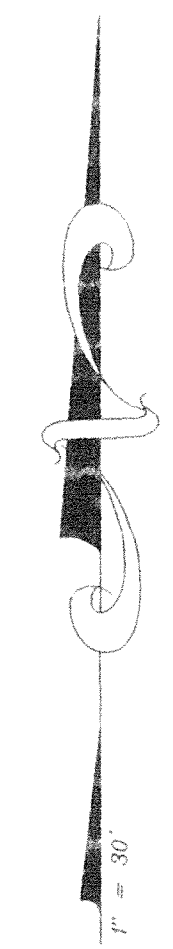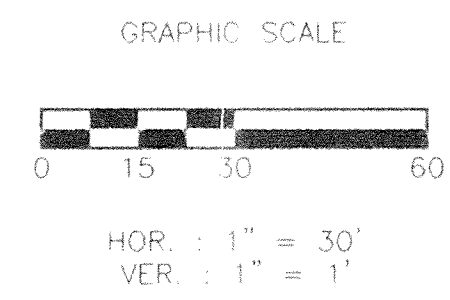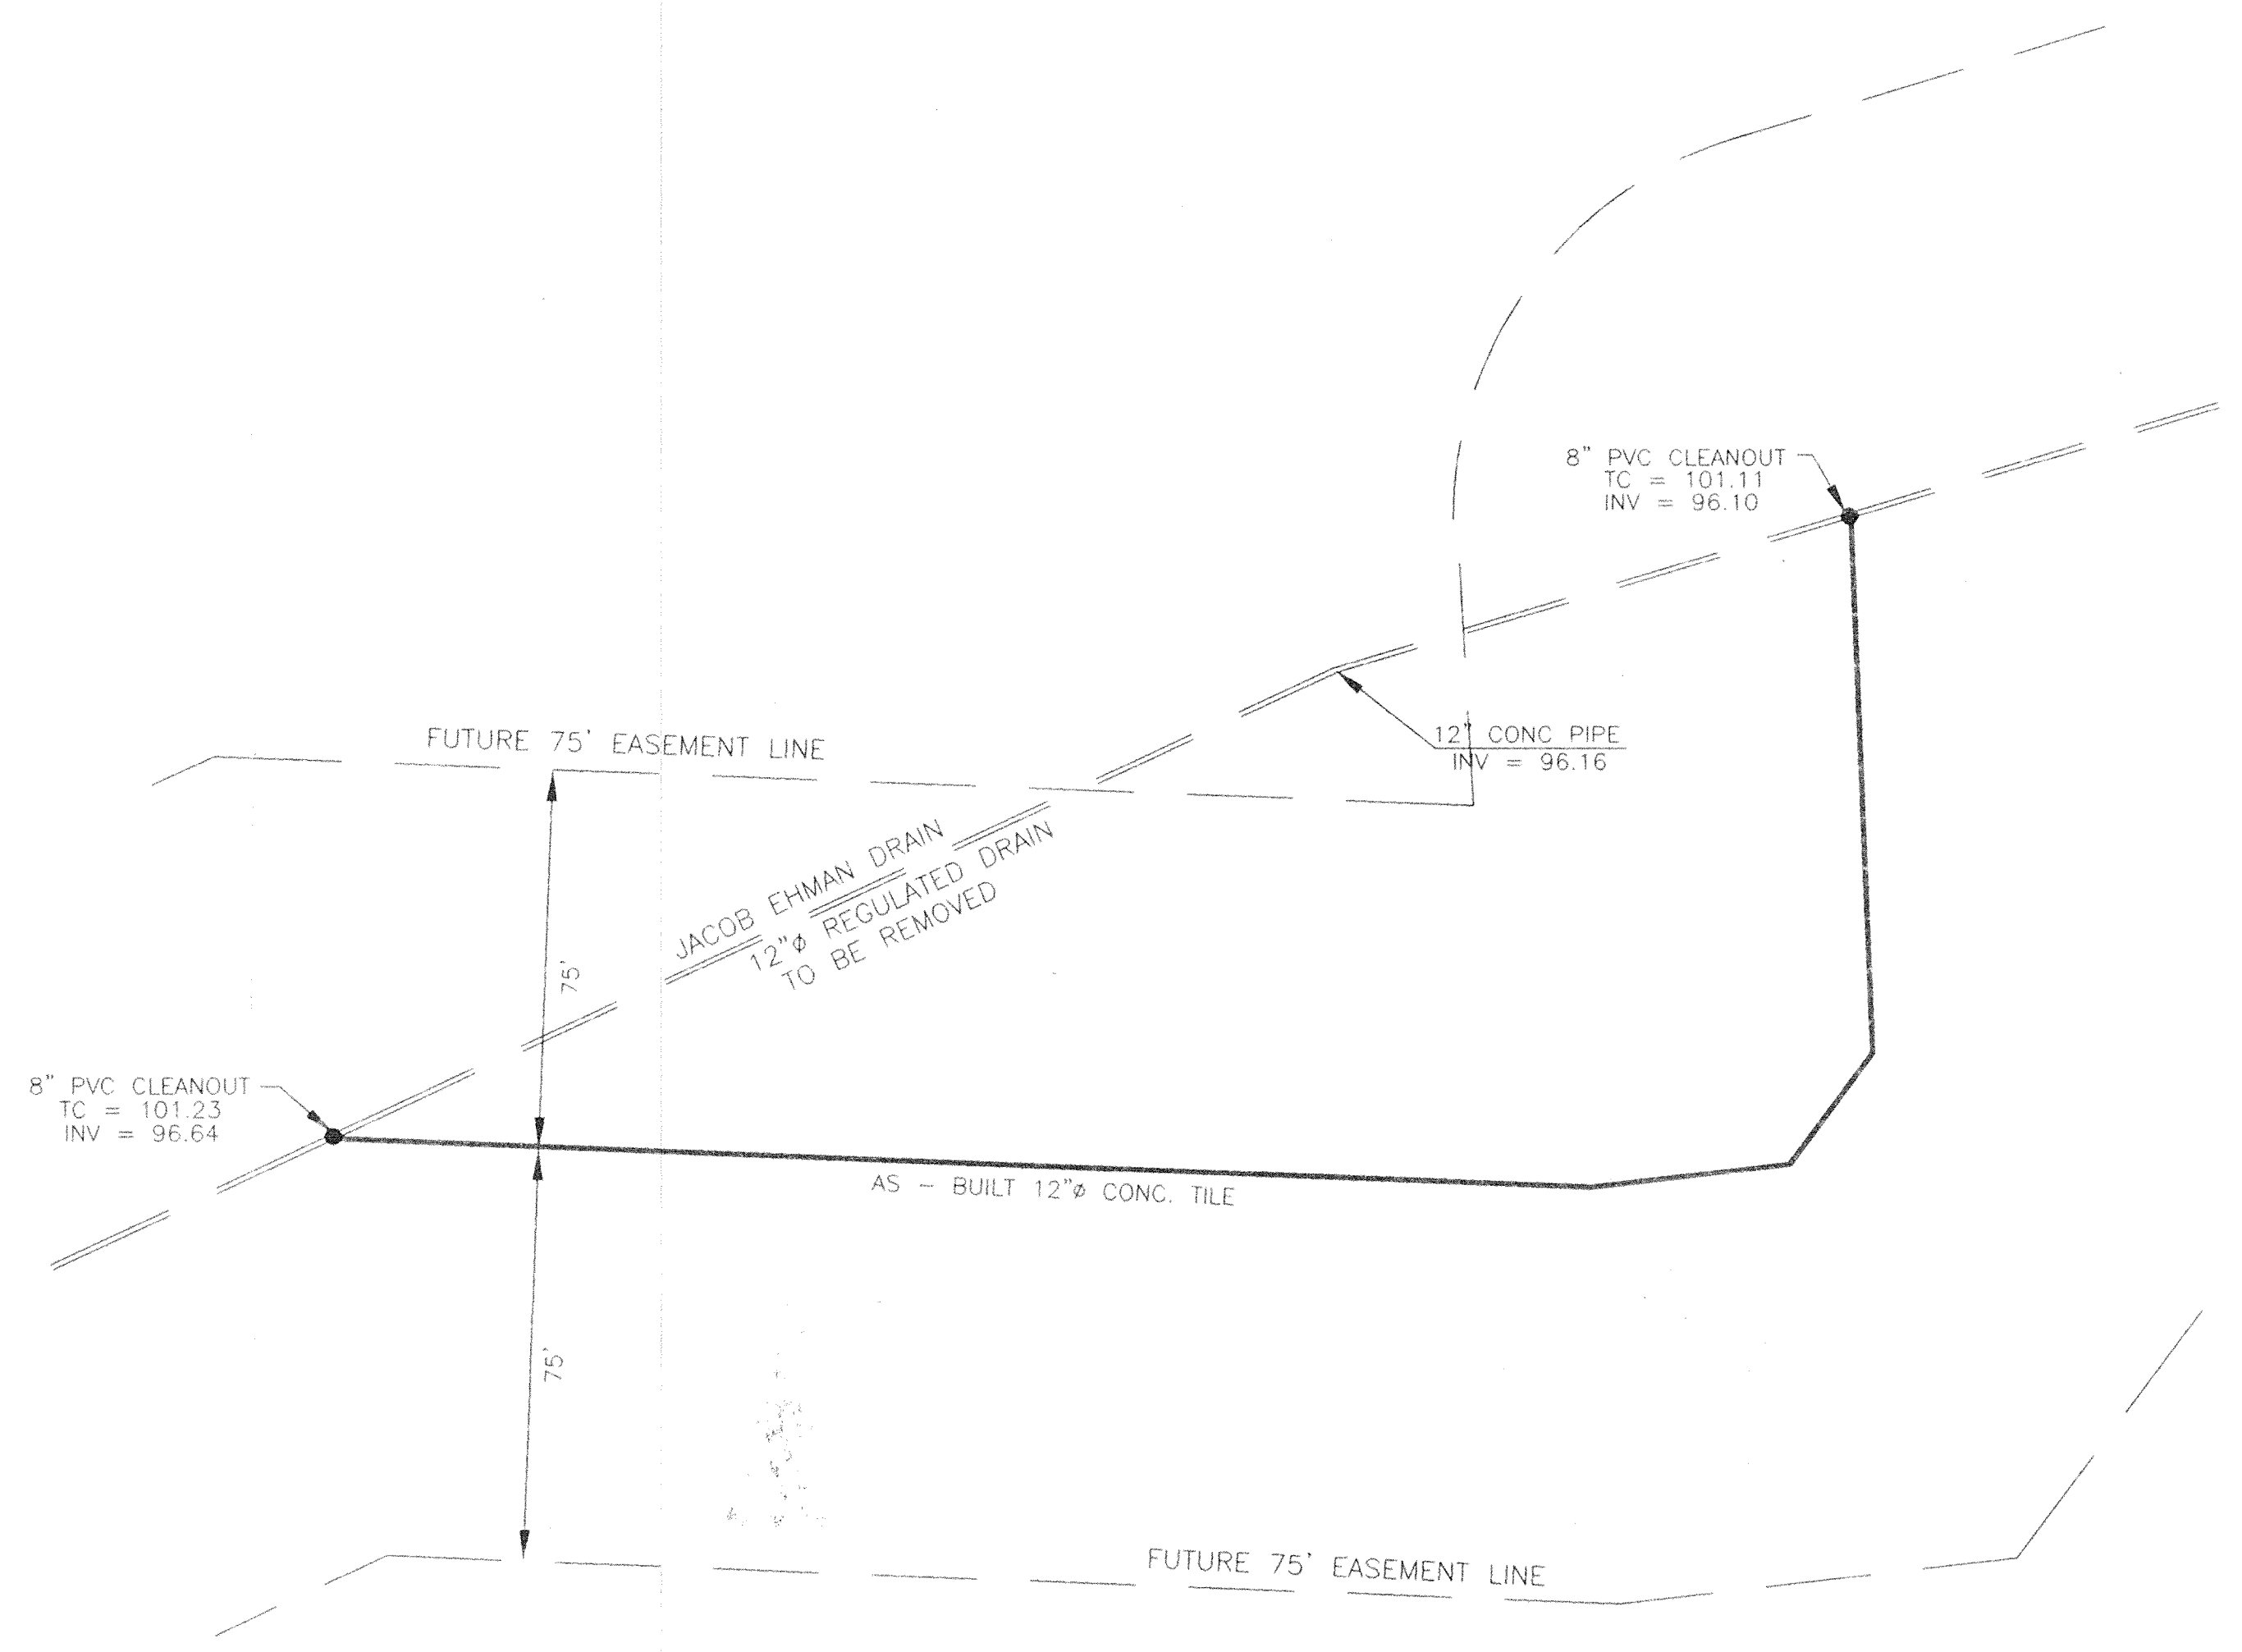

This information was gathered for input into the Hamilton County Geographical Information System. This document is considered an official record of the GIS.

Entry Date: 08/15/01

Entered by: SLM

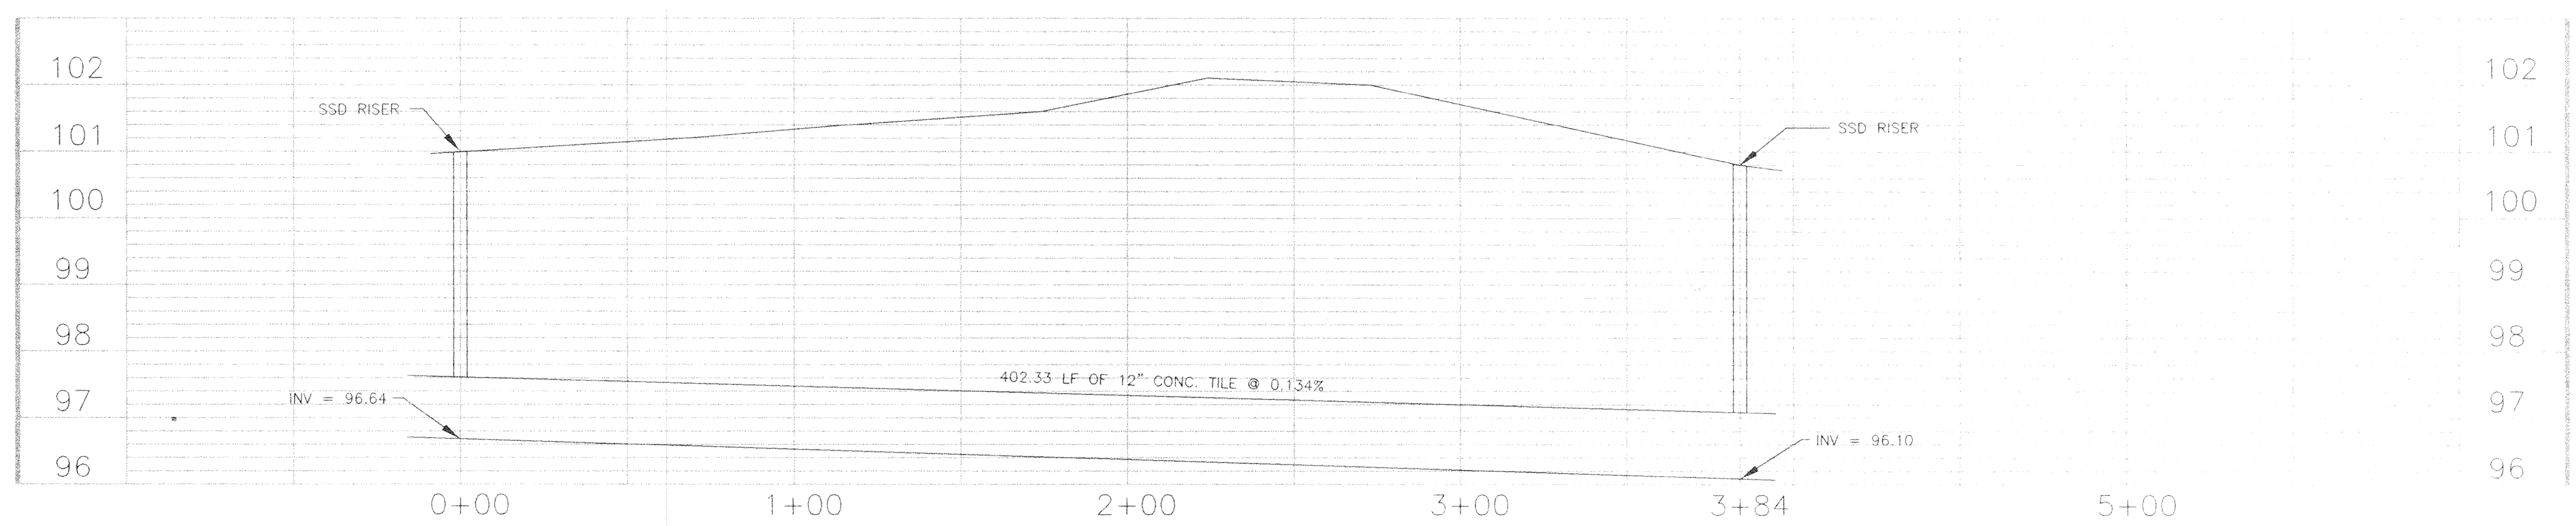

**FILED**  
DEC 22 1997  
OFFICE OF HAMILTON COUNTY SURVEYOR

**FILED**  
DEC 22 1997  
OFFICE OF HAMILTON COUNTY SURVEYOR

JOB No. B24261  
DRAWN By: AC DATE 7-29-97  
FOR: DAVE DODD  
FIELD BOOK: \_\_\_\_\_ PAGE \_\_\_\_\_

JACOB EHMAN DRAIN  
RELOCATION  
ADAMS TWP. SEC. 12-20-3

**AS - BUILT  
PLAN & PROFILE SHEET**

**MILLER SURVEYING**  
948 CONNER STREET  
NOBLESVILLE INDIANA 46060  
Ph. # (317) 773-2644

PAGE  
2 of 2

C:\mg\st1e\B24261c.dwg Wed Dec 10 07:25:41 1997 Plotted by: Mate


AS - BUILT ADDED BY N.H.

# AS - BUILT

## PART OF THE N.E. 1/4, SEC. 12-20-3

### TRACT 2


## 286th. STREET

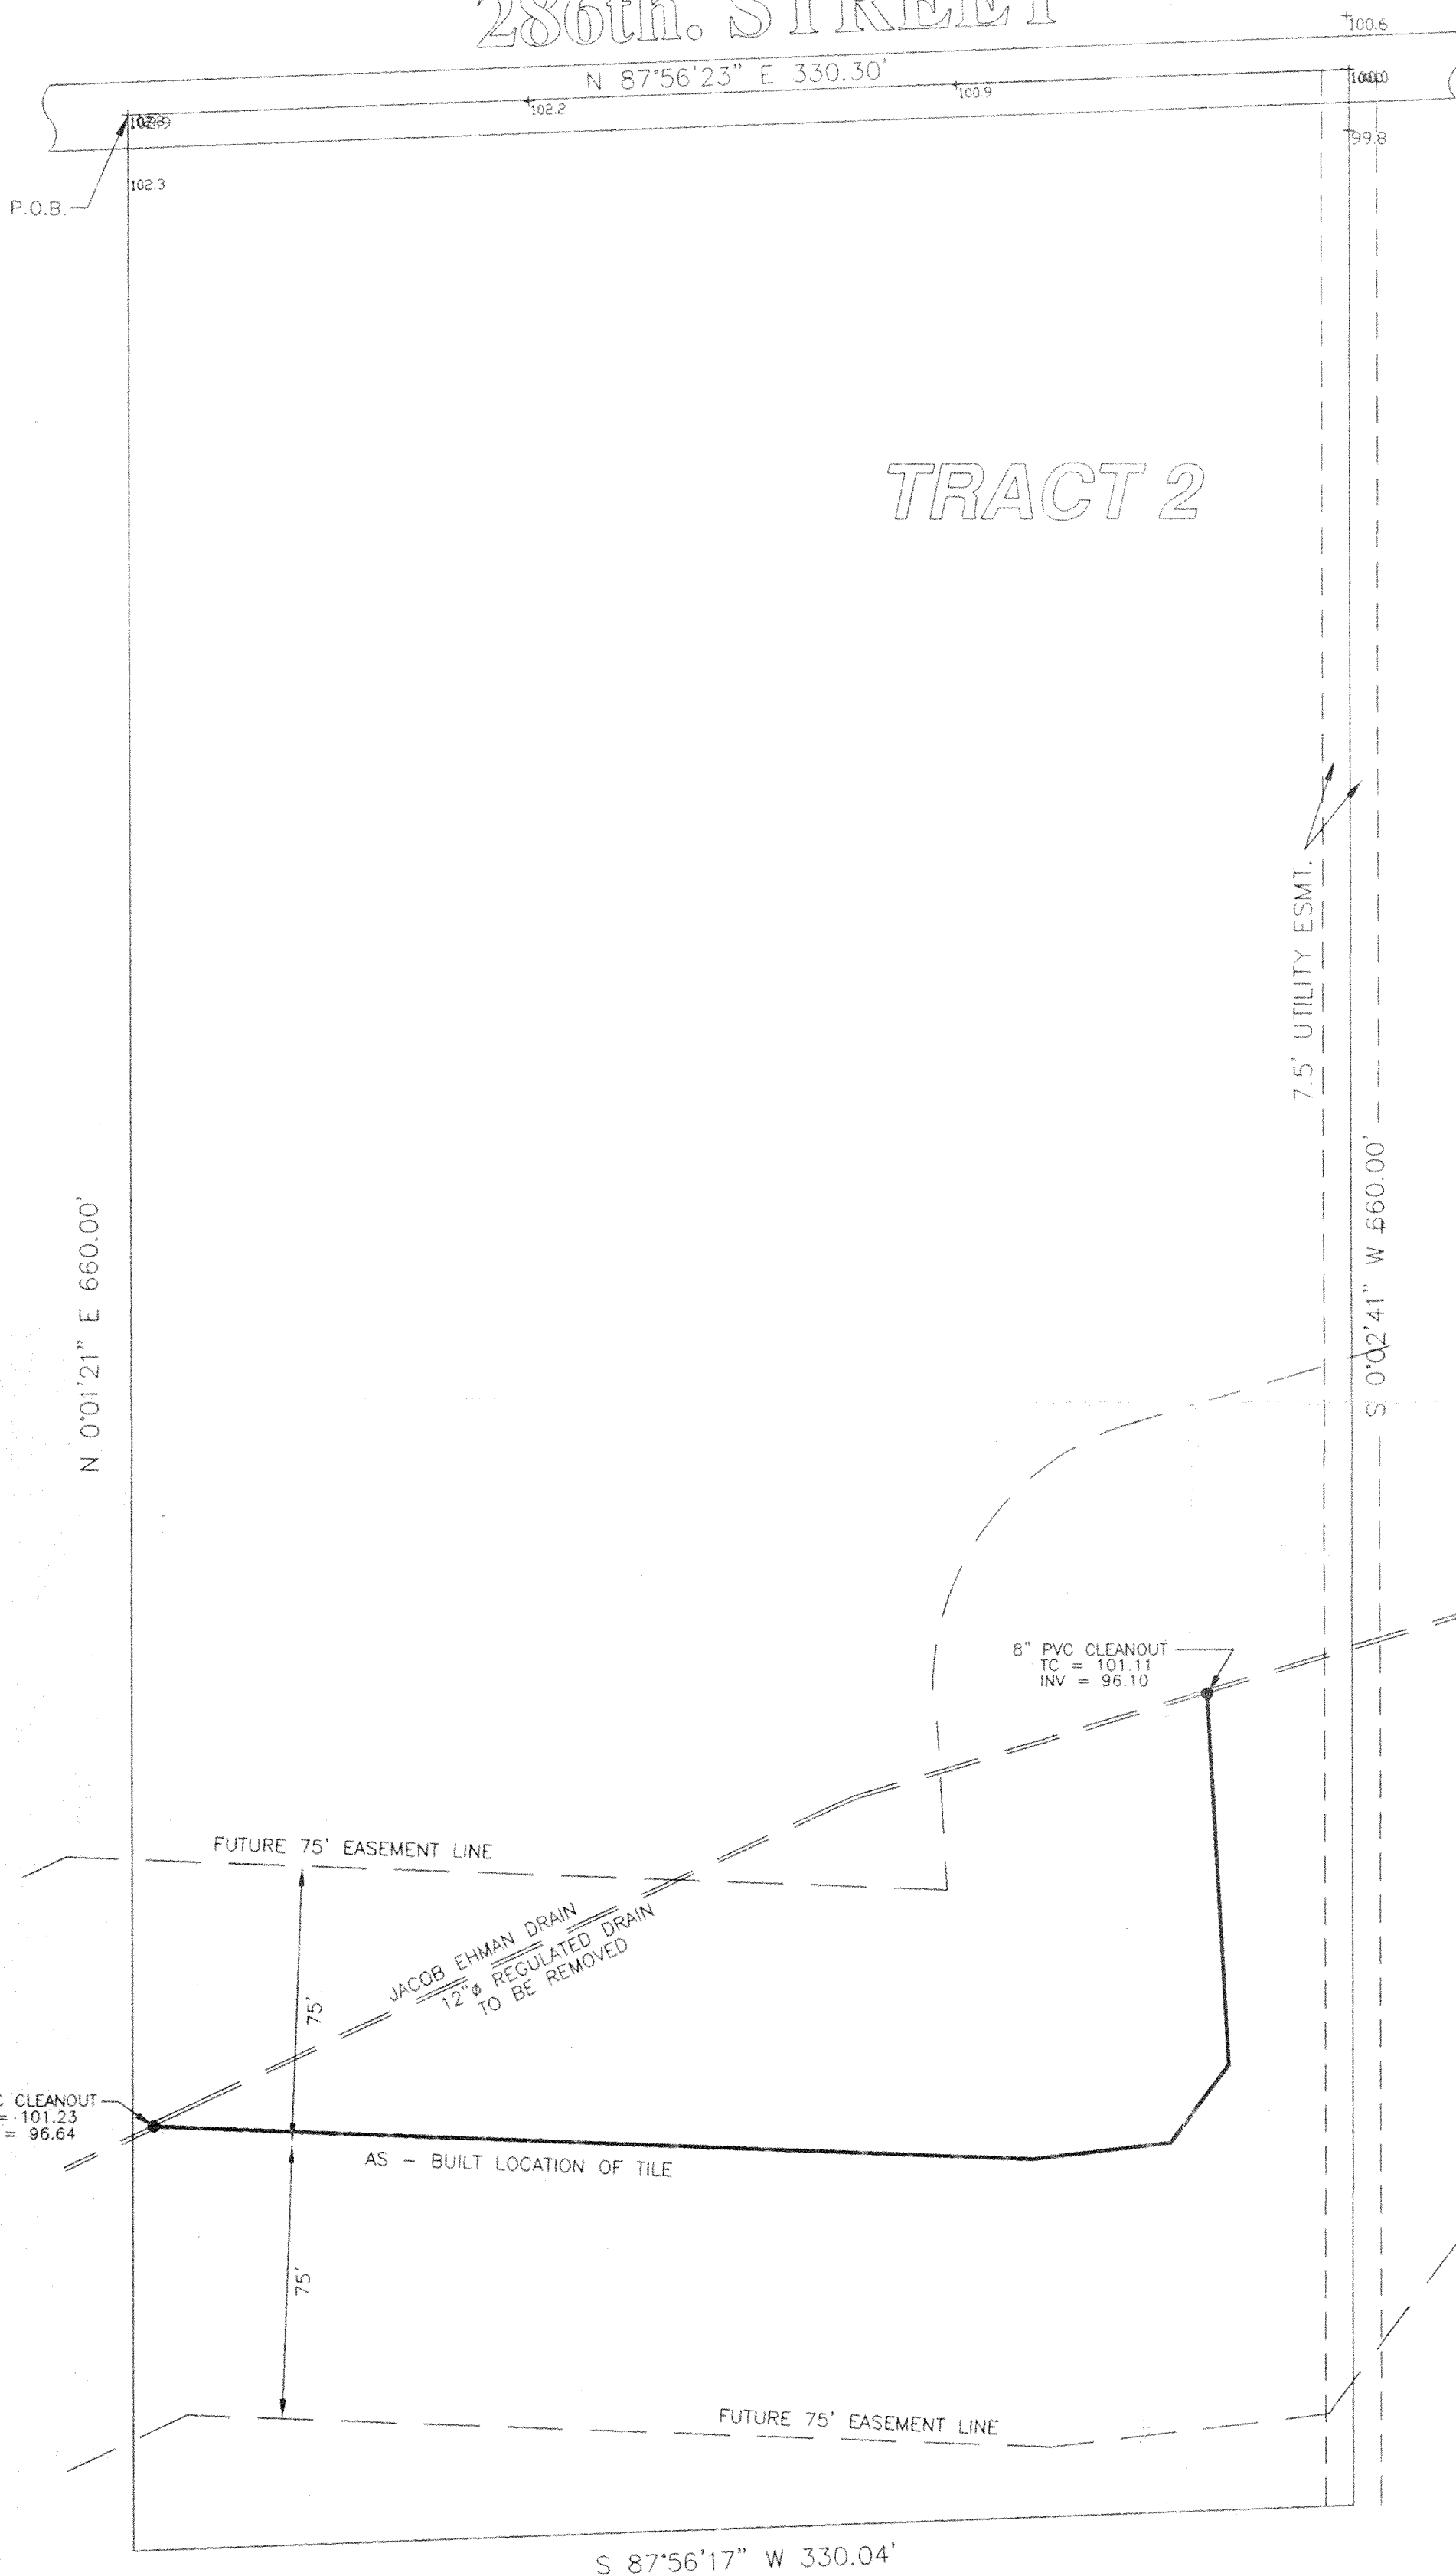

**TRACT II**

Beginning at a point on the north line of the west half of the Northeast Quarter of Section 12, township 20 North, Range 3 East, said point being North 87 degrees 56 minutes 23 seconds East (assumed bearing) 330.30 feet from a cornerstone marking the northwest corner of the Northeast Quarter of Section 12; thence continuing North 87 degrees 56 minutes 23 seconds East along the north line of the west half of the said Quarter Section; a distance of 330.3 feet; thence South 00 degrees 02 minutes 41 seconds West a distance of 660.0 feet; thence South 87 degrees 56 minutes 17 seconds West a distance of 330.04 feet; thence North 00 degrees 01 minute 21 seconds East a distance of 660.0 feet to the place of beginning.

Being a part of the west half of the Northeast Quarter of Section 12, Township 20 North, Range 3 East.

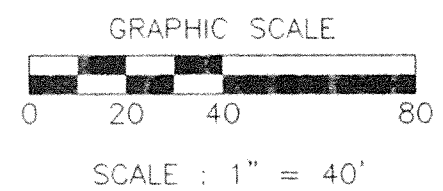

This information was gathered for input into the Hamilton County Geographical Information System. This document is considered an official record of the GIS.

Entry Date: 8/15/01

Entered by: SLK

**FILED**

DEC 22 1997  
OFFICE OF HAMILTON COUNTY SURVEYOR



*Leland D. Miller, Jr.*  
R.L.S. S0083 DATE: \_\_\_\_\_

<b>MILLER SURVEYING</b>		
948 CONNER STREET NOBLESVILLE INDIANA 46060 Ph. # (317) 773-2644 FAX 773-2694		
LOCATION: PART OF THE N.E. 1/4 OF SECTION 12-20-3 ADAMS TOWNSHIP, HAMILTON COUNTY, INDIANA	DRAWN BY: AC	CHK'D BY:
FIELD WORK COMPLETED: 4-18-97	SCALE: 1" = 40'	FIELD BOOK: 426
CLIENT: DAVE DODD	DATE: 7-29-97	PAGE: 2
DESCRIPTION: AS - BUILT	JOB NUMBER: B24261	SURVEY 4 FILE: