

Kenton C. Ward, Surveyor

Phone (317) 776-8495

Fax (317) 776-9628

Suite 188

One Hamilton County Square
Noblesville, Indiana 46060-2230

Map Correction-Field Verification

Drain Number: #176

Drain Length: N/A

Drain Name: WR Fertig

Change +/-: N/A

Date: 6-6-05

New Length: N/A


Verified By: Mike Kole

Notes & Sketch:

WR Fertig drain is being affected by Carmel Road Improvements at 122nd & Hancock ST. These plans revealed that the Fertig between str. 544 & 543 was 60" RCP. This was investigated by Mike Kole & was determined to be accurate. The asbuilts for this pipe had reflected it as a 54". Therefore the GIS will be changed to reflect a 60" RCP.

Suzanne L. Mills
GIS Specialist

PLAN
 DATE: 10/1/2000
 DRAWN BY: J. H. HAMILTON
 CHECKED BY: J. H. HAMILTON

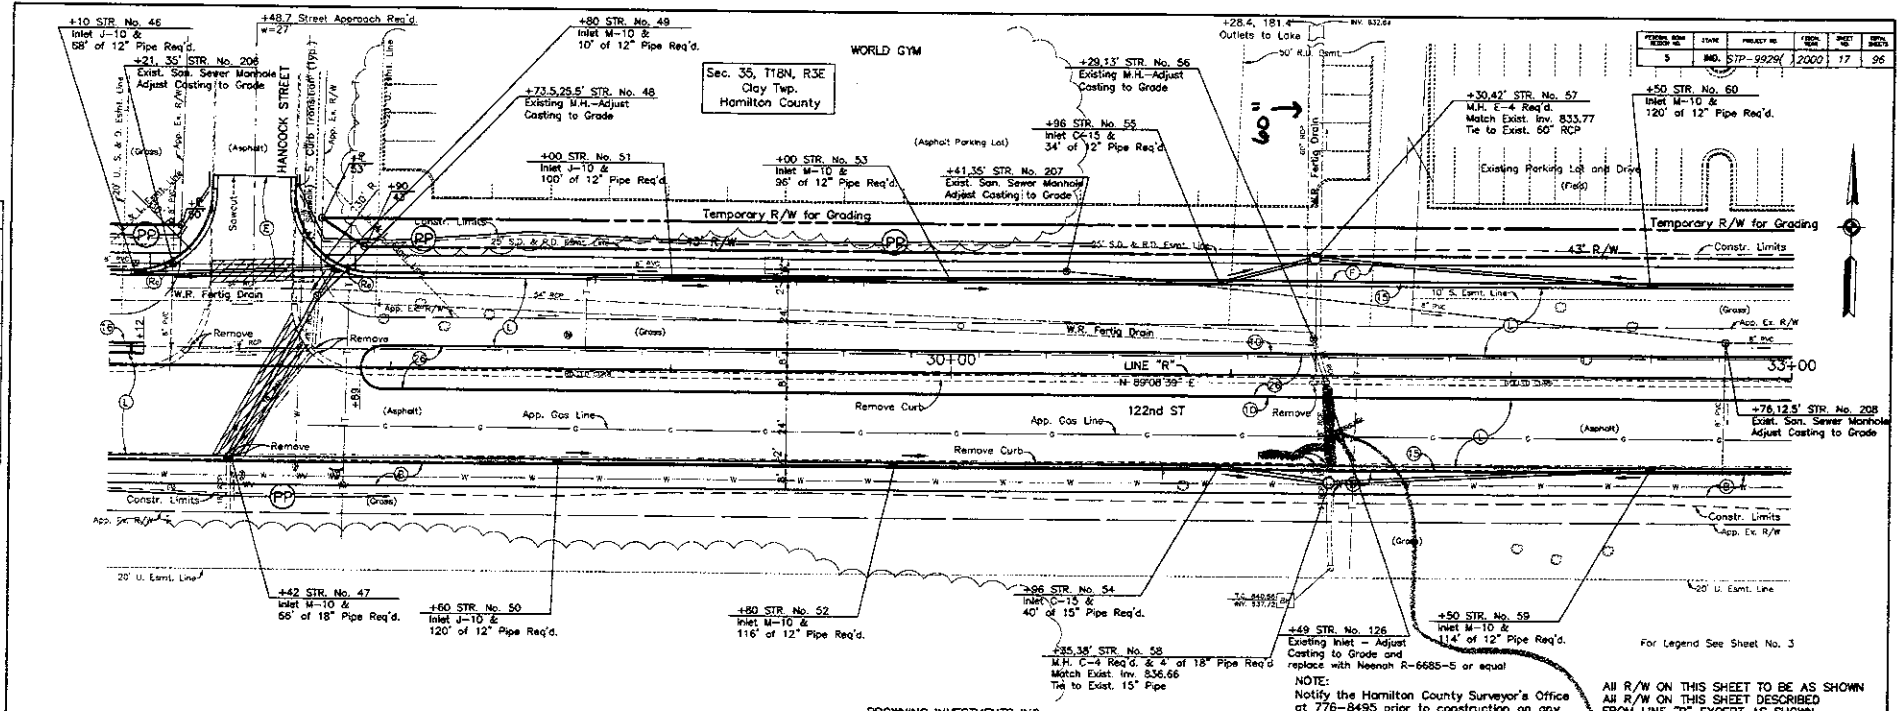

PROJECT NO.	DATE	PROJECT NO.	DATE	PROJECT NO.	DATE
5	MD, STP-9929	2000	17	96	

PROFILE
 DATE: 10/1/2000
 DRAWN BY: J. H. HAMILTON
 CHECKED BY: J. H. HAMILTON

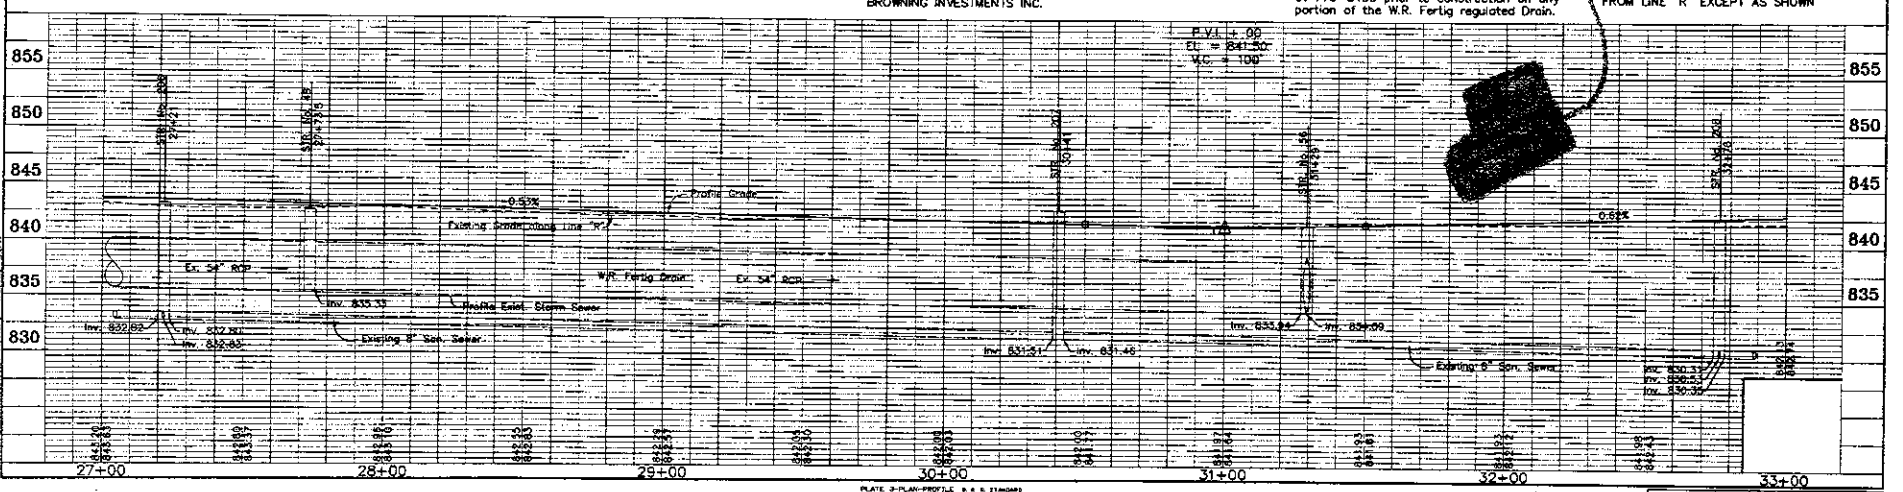


PLATE 3-PLAN-PROFILE & R/W STANDARDS
 1975

PROJECT NO.	DATE	PROJECT NO.	DATE	PROJECT NO.	DATE
STP-9929	R	17	96		