

Kenton C. Ward, CFM
Surveyor of Hamilton County
Phone (317) 776-8495
Fax (317) 776-9628

Suite 188
One Hamilton County Square
Noblesville, Indiana 46060-2230

Map Correction-Field Verification

Drain Number: #165

Drain Length: N/A

Drain Name: Highland Springs Drain

Change + / - : N/A

Date: 02-14-2020


New Length: N/A

Verified By: SAB, SLM

Notes & Sketch: SEE ATTACHED MAP

The drain was recently inspected by Steve Baitz. The purpose of the inspection was to verify pipe material type for each run of pipe in this subdivision. The attached map outlines where the pipe is CMP, RCP, or a Lined CMP.


Suzanne L. Mills
GIS Specialist

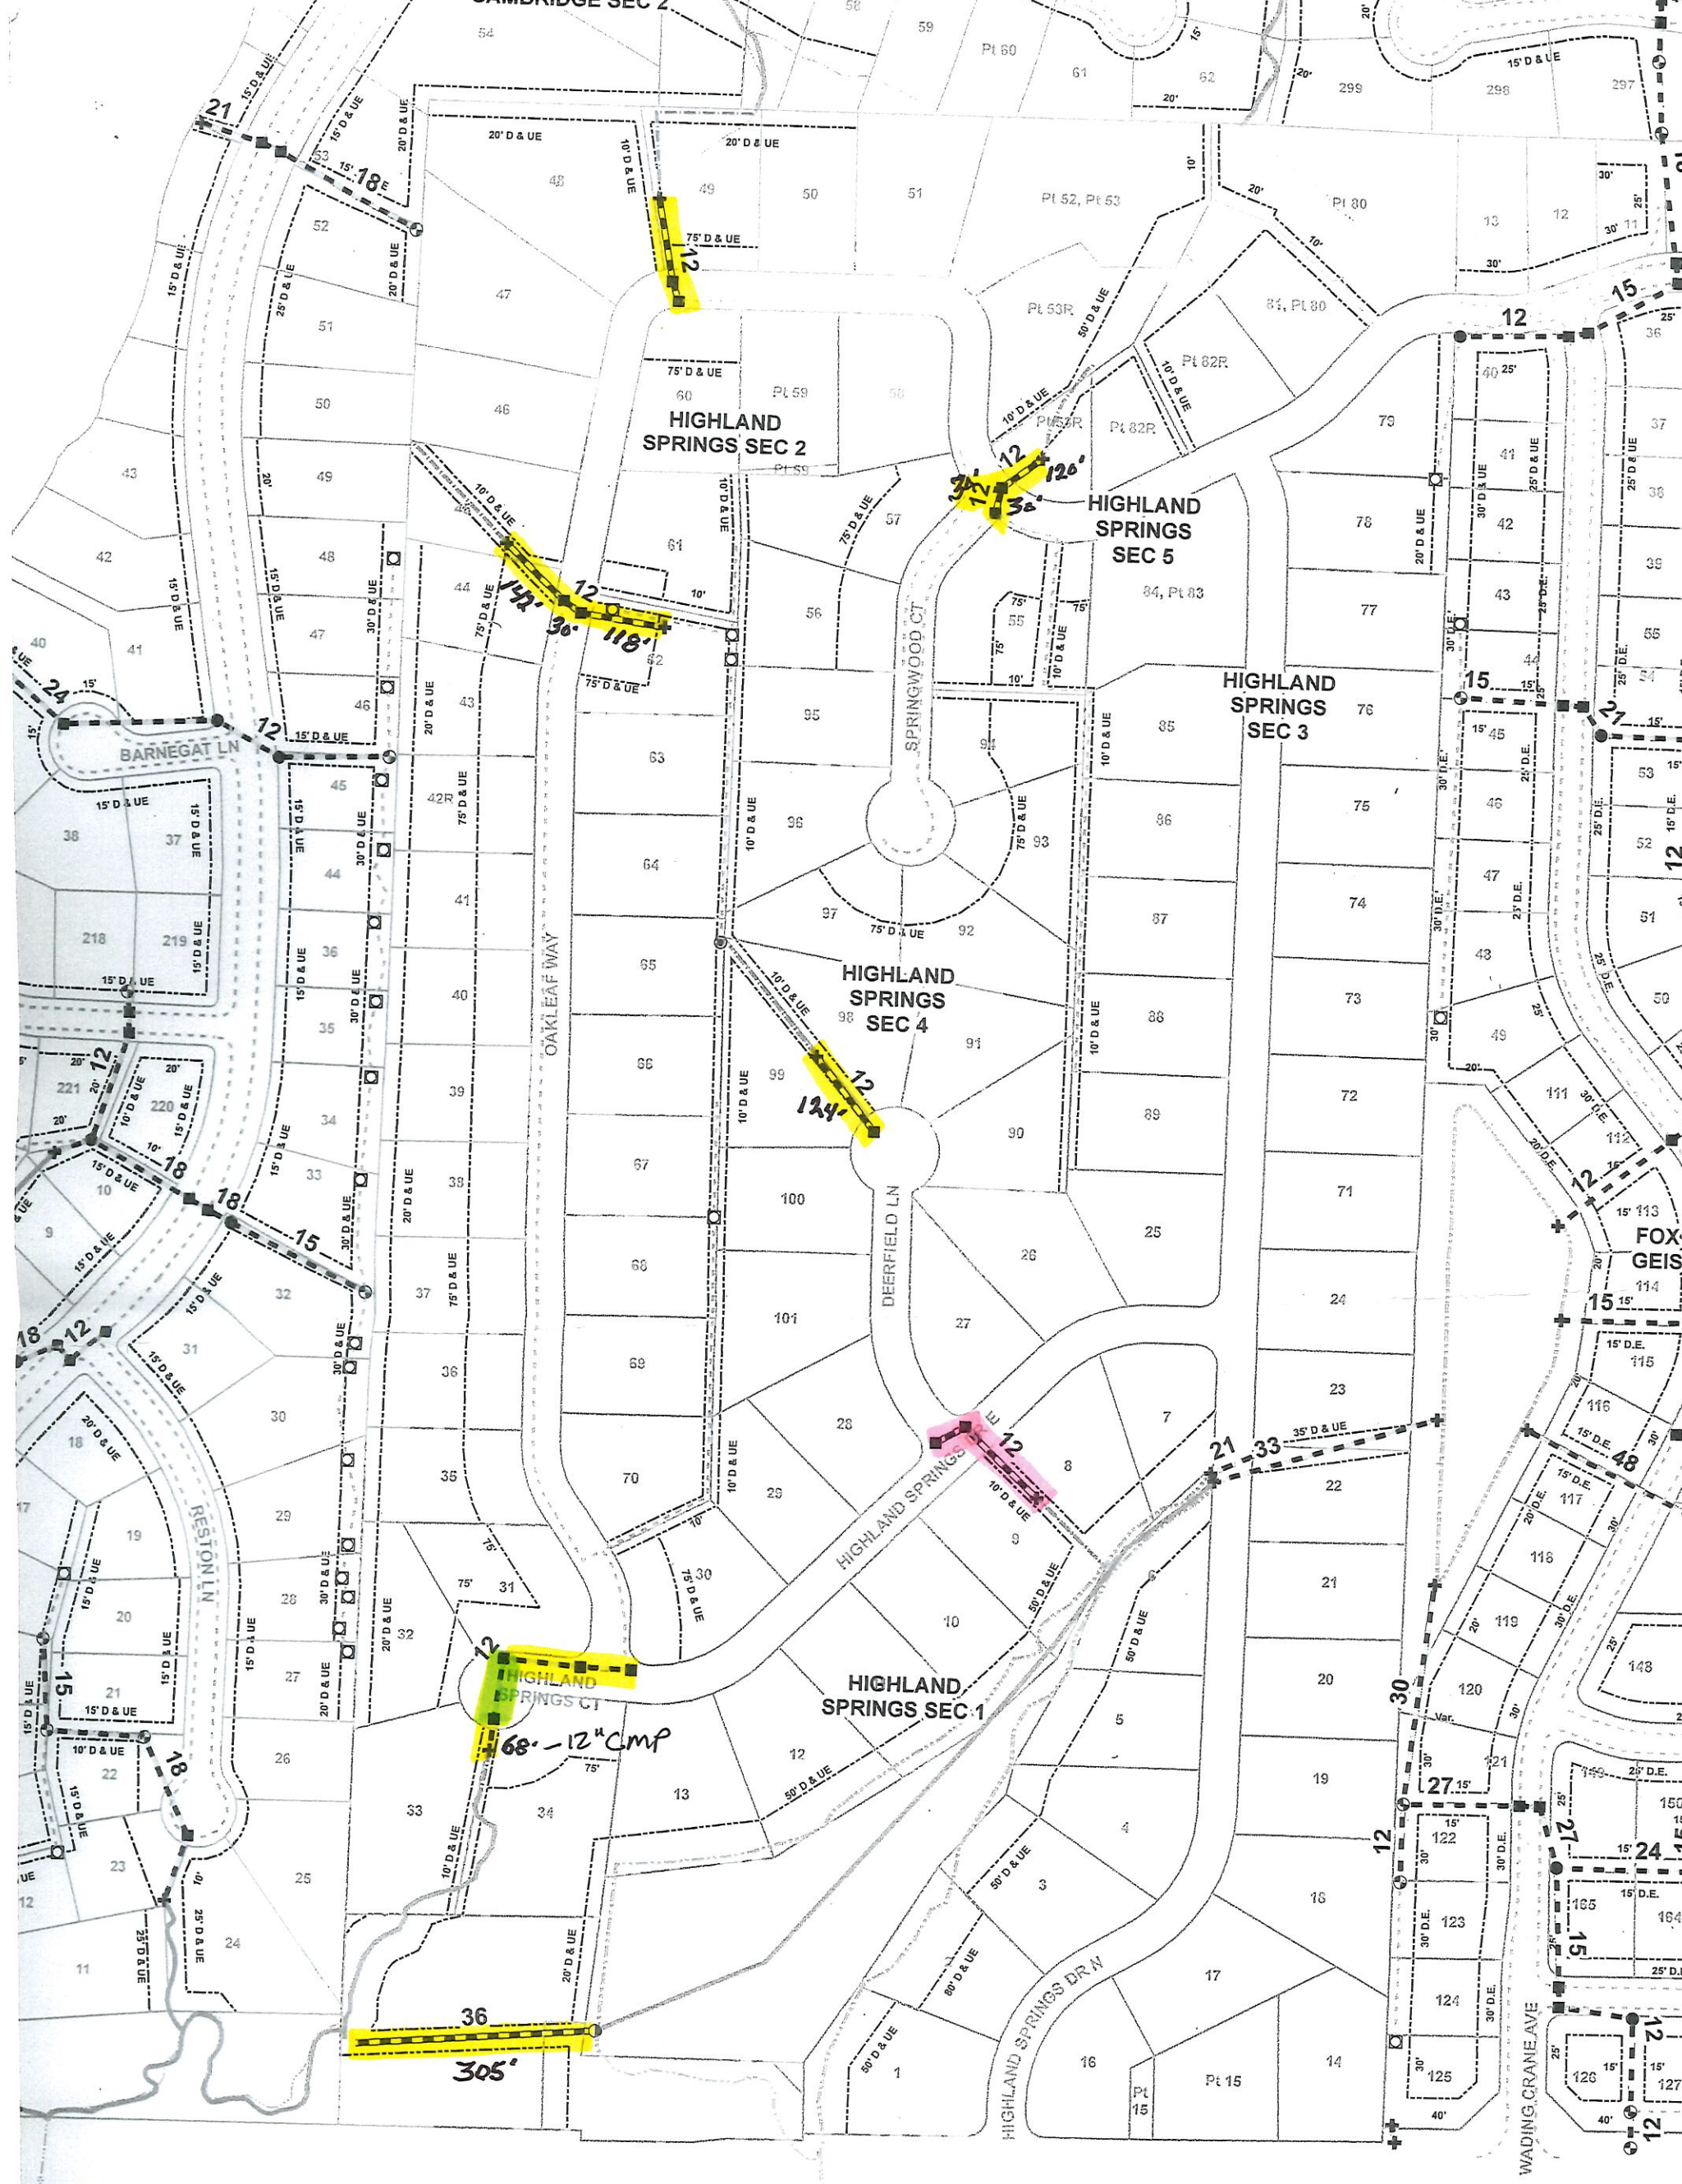

CMP
lined

RCP

#165

HIGHLAND SPRINGS DRAIN

Kenton C. Ward, Surveyor

Hamilton County, Indiana