



Kenton C. Ward, CFM
Surveyor of Hamilton County
Phone (317) 776-8495
Fax (317) 776-9628

Suite 188
One Hamilton County Square
Noblesville, Indiana 46060-2230

Map Correction-Field Verification

Drain Number: 21

Drain Length: n/a

Drain Name: AF Ingerman ; Arm 2

Change + / - : n/a


Date: August 15, 2012


New Length: n/a

Verified By: SAB, SLM

Notes & Sketch: (See attached Map)

The tile was located by the Drainage Board Contractor and then GPS'd by Steve Baitz. See work order (WO-2012-00127). The tile was found to be further east than originally outlined in the historical description.

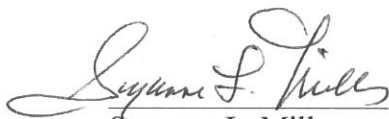
Suzanne L. Mills
GIS Specialist

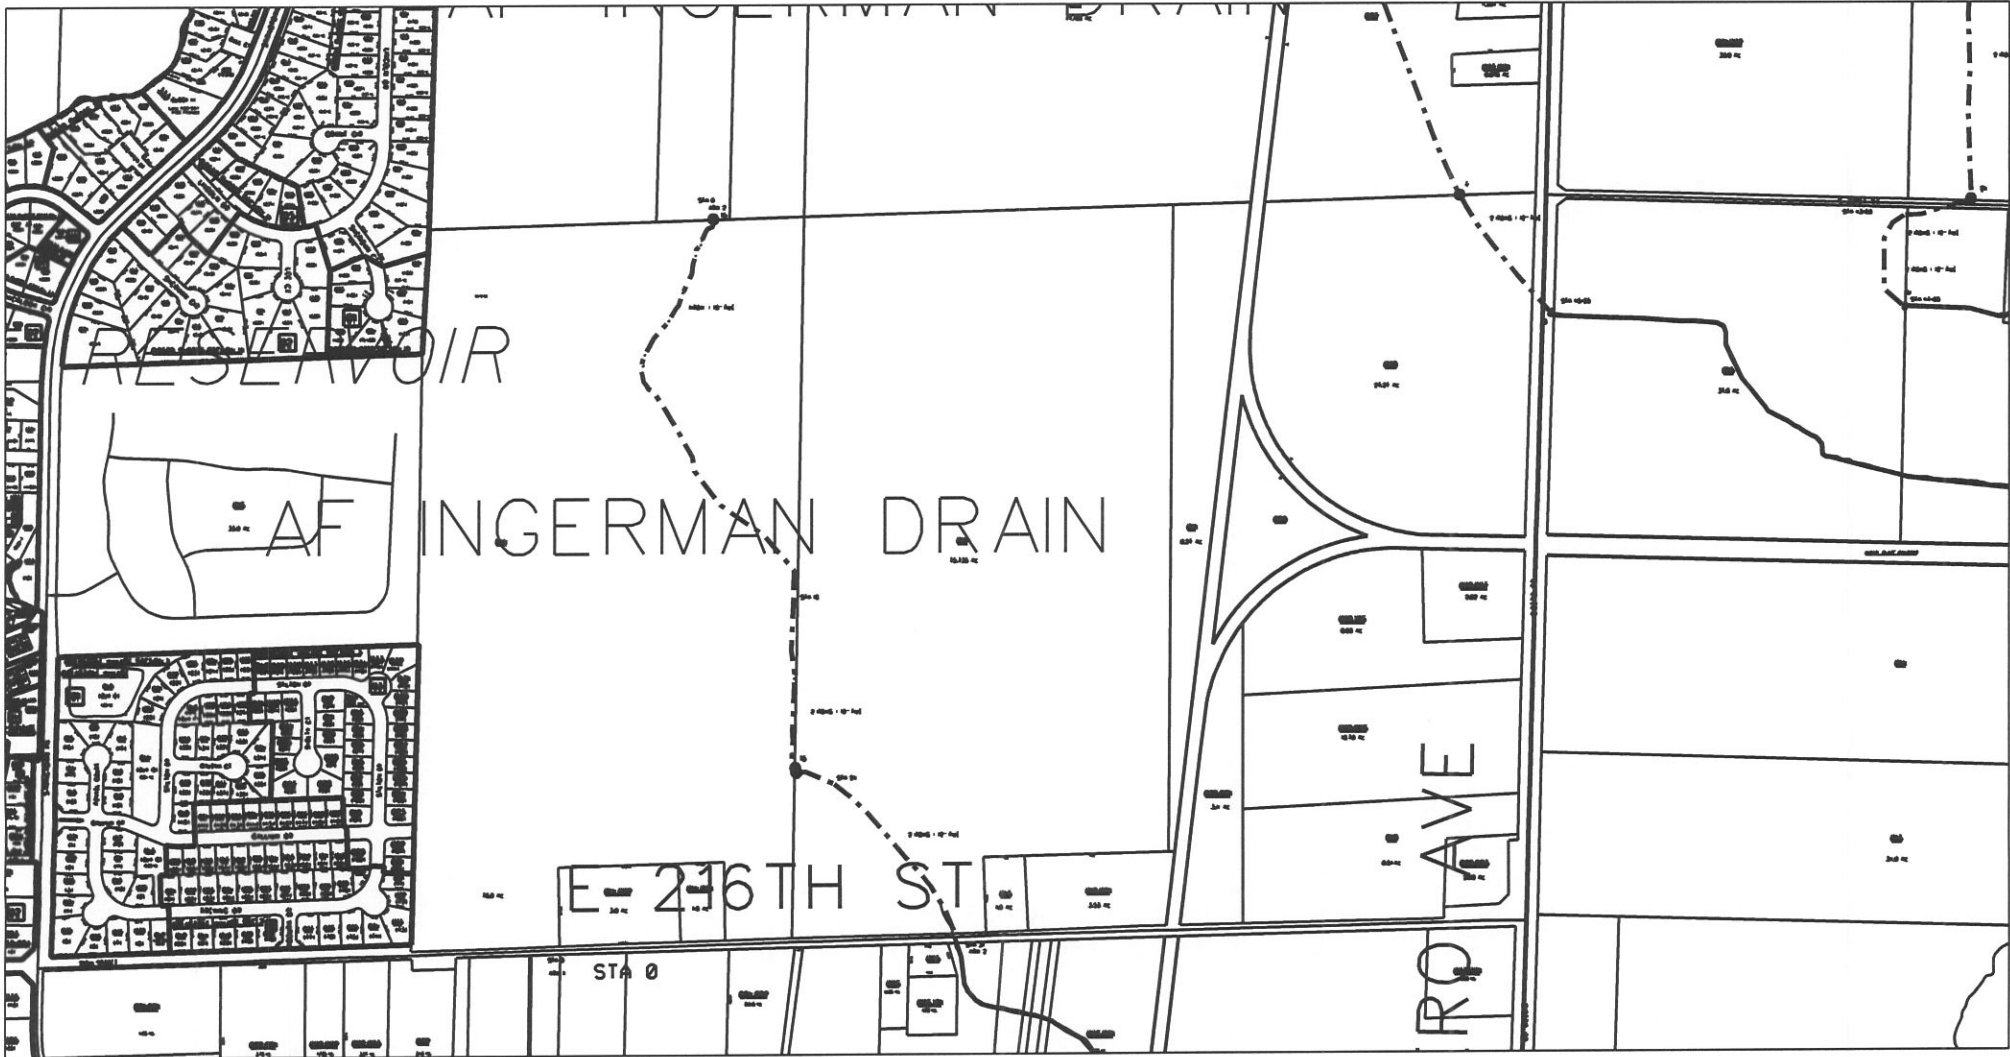

reg_drain_hc.dgn 8/15/2012 12:08:32 PM