

Kenton C. Ward, CFM  
Surveyor of Hamilton County  
Phone (317) 776-8495  
Fax (317) 776-9628

Suite 188  
One Hamilton County Square  
Noblesville, Indiana 46060-2230

### *Map Correction-Field Verification*

Drain Number: # 21

Drain Length: N/A

Drain Name: James Lockewood

Change +/-: N/A

Date: 7-12-2013

New Length: N/A

Verified By: SHM, SAB


---

#### Notes & Sketch:

Based upon the field investigation of Steve Beitz and the GPS location of structures. The drain alignment was adjusted from Sta. 87+54 to Sta. 118+57. There was no change in drain length. A Breather was located & mapped (Str. 900).

\* See attached map.

Suzanne L. Mills  
GIS Specialist

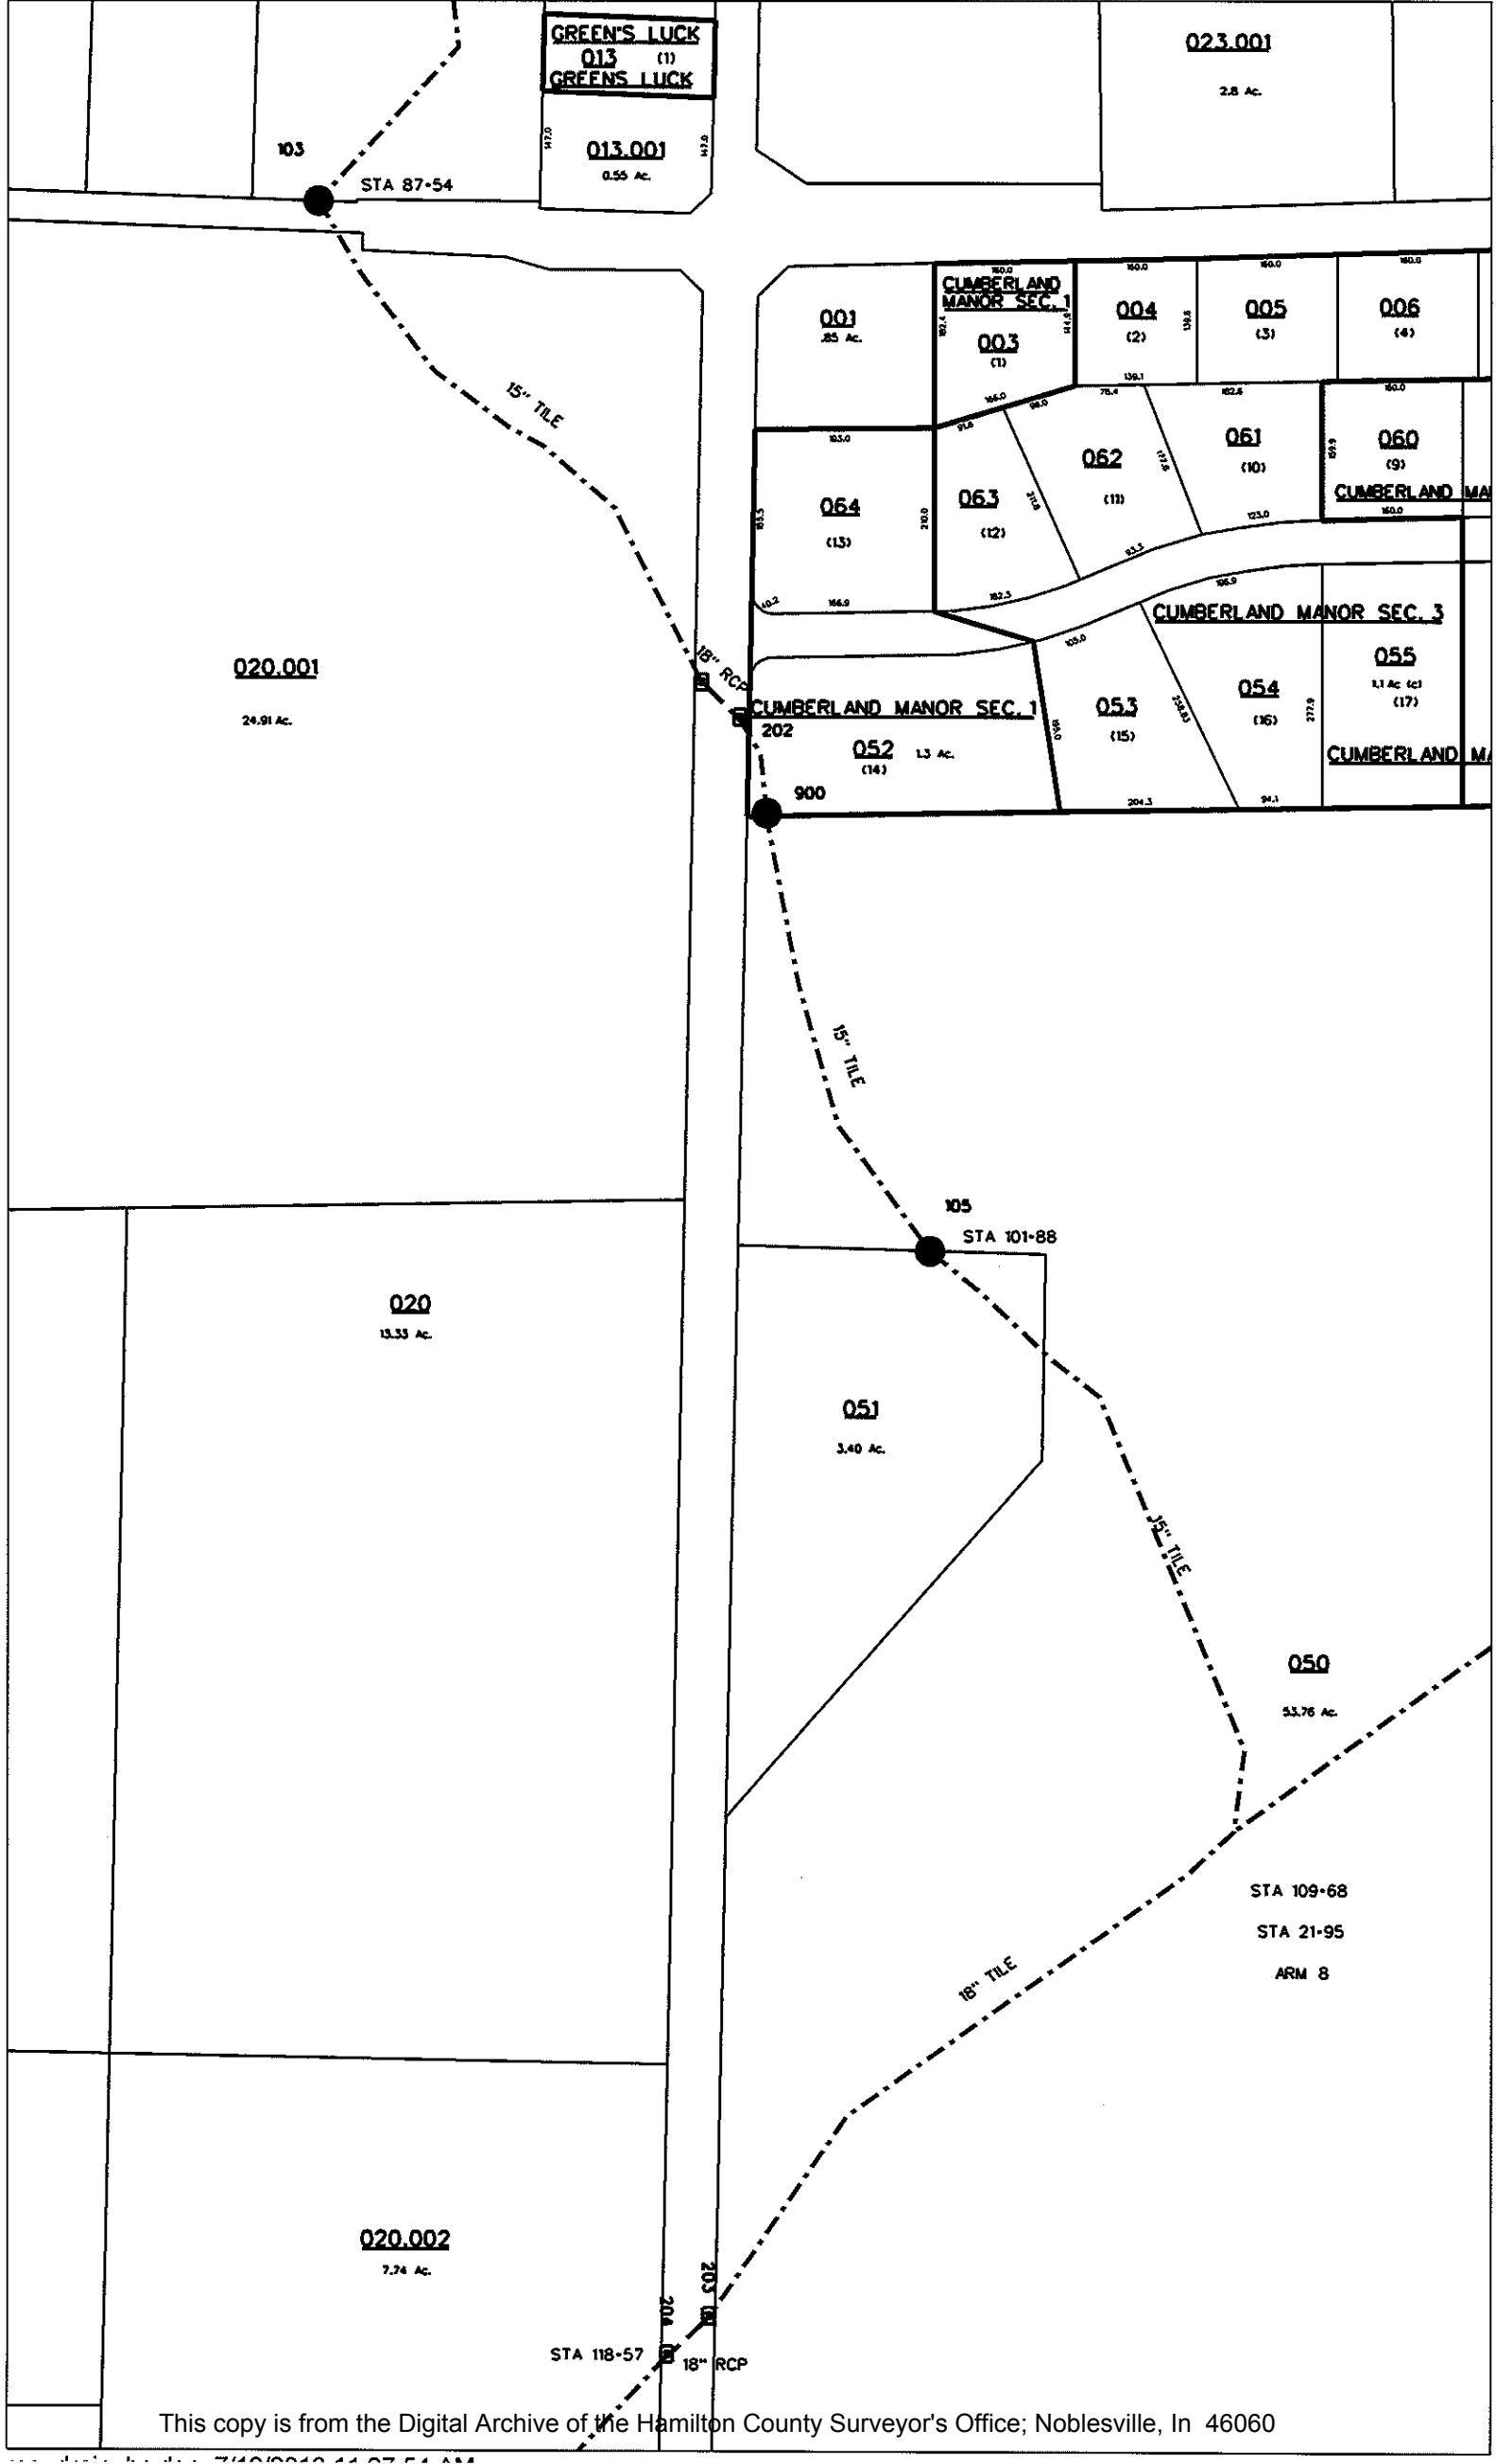

**GREEN'S LUCK**  
**013 (1)**  
**GREENS LUCK**

**013.001**  
 0.55 Ac.

**023.001**  
 2.8 Ac.

**103**  
 STA 87-54

**020.001**  
 24.91 Ac.

**020**  
 13.33 Ac.

**020.002**  
 7.74 Ac.

STA 118-57  
 18" RCP

**105**  
 STA 101-88

STA 109-68  
 STA 21-95  
 ARM 8