

Kenton C. Ward, CFM
Surveyor of Hamilton County
Phone (317) 776-8495
Fax (317) 776-9628

Suite 188
One Hamilton County Square
Noblesville, Indiana 46060-2230

Map Correction-Field Verification

Drain Number: # 355

Drain Length: ϕ

Drain Name: Johnson & Gardner Drainage Area
HR Johnson - Arm 1

Change +/- : ϕ

Date: 5-13-2010


New Length: ϕ

Verified By: SAB (W0-2009-00118)

Notes & Sketch: See attached map.

This tile was geot'd by Steve Baitz as repairs were being made. So the location the tile was adjusted but there was no change in footage. It should be noted that the two catch basins installed along SR32 in 1922 are no longer there. This work order installed 2 breathers & 2 catch basins.

Suzanne L. Mills
GIS Specialist

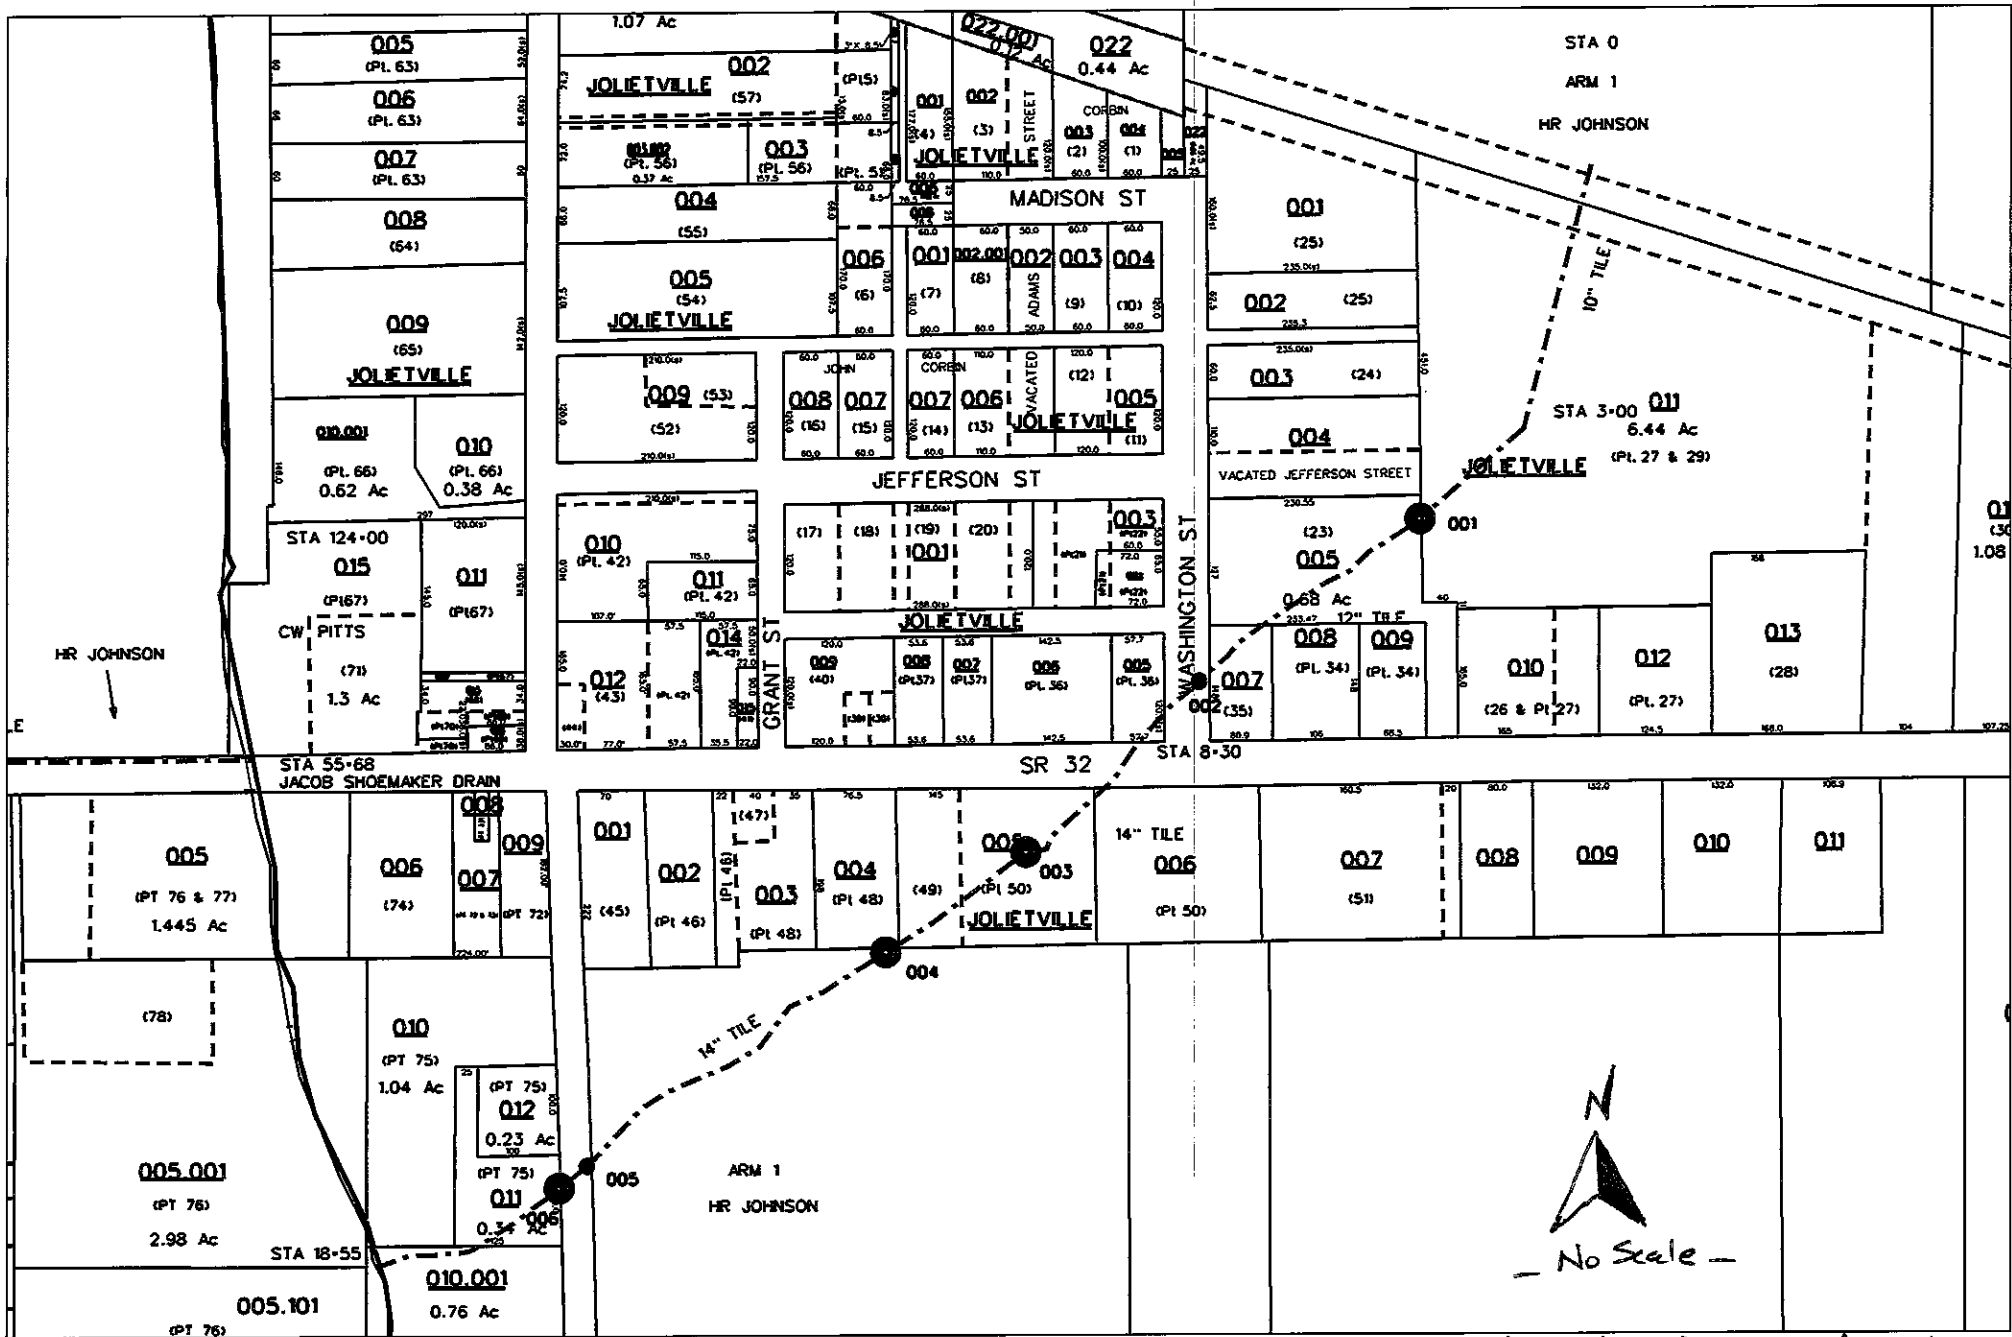

reg_drain_hc.dgn 5/13/2010 10:45:15 AM

Johnson & Gardner Drainage Area # 355