



Kenton C. Ward, CFM Surveyor of Hamilton County Phone (317) 776-8495 Fax (317) 776-9628

Suite 188 One Hamilton County Square Noblesville, Indiana 46060-2230

Map Correction-Field Verification

Drain Number: #10

Drain Length: n/a

Drain Name: Henry Plew

Change +/-: n/a

Date: 05-13-2010


New Length: n/a

Verified By: SAB (wo - 2009-00242)

Notes & Sketch: (See attached Map)

Breather was set just north of Station 26+00 with this work order. Tile location was modified based upon inspectors field observations.

Suzanne L. Mills GIS Specialist

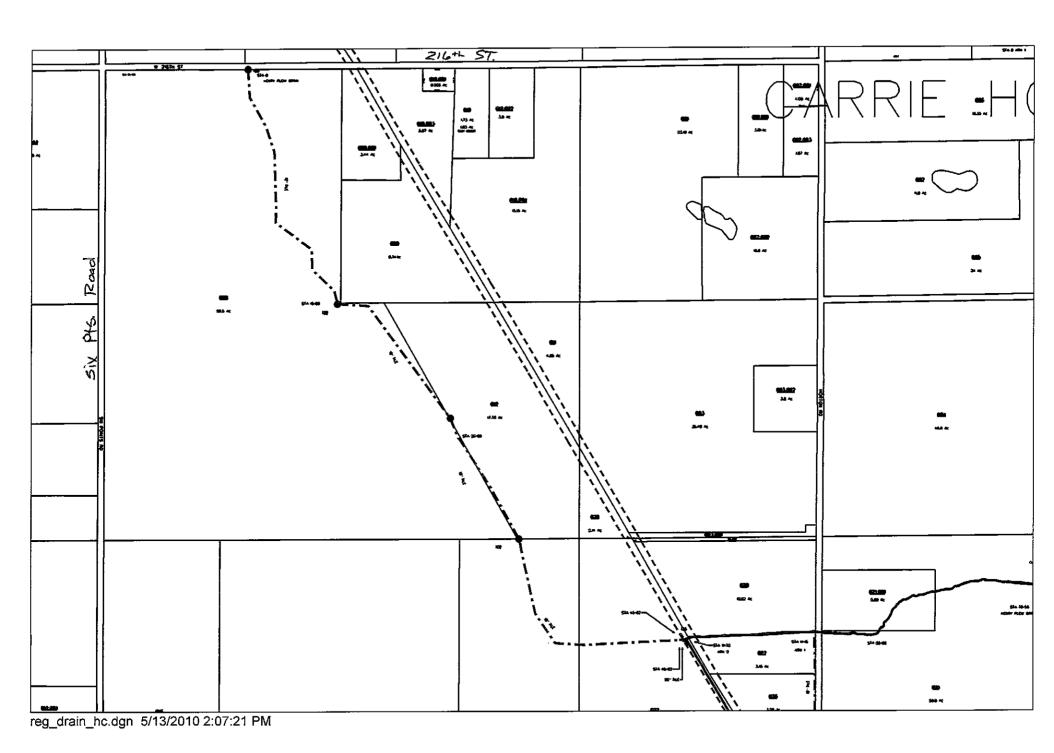

This copy is from the Digital Archive of the Hamilton County Surveyor's Office; Noblesville, In 46060