

*Kenton C. Ward, CFM*  
Surveyor of Hamilton County  
Phone (317) 776-8495  
Fax (317) 776-9628

Suite 188  
One Hamilton County Square  
Noblesville, Indiana 46060-2230

### ***Map Correction-Field Verification***

**Drain Number:** 210

**Drain Length:** 1013

**Drain Name:** Clara Knotts: 1991 US 31 Improv.    **Change +/- :** -6

**Date:** 12-16-2011

**New Length:** 1007


**Verified By:** SLM, GRH

---

**Notes & Sketch:** (See attached Map)

The intersection was widened in 2004-2005. The changes were done by the City of Carmel (See plans with project number PWW 301-002 done by A&F engineering). This project removed existing structures, 11, 15, & 18 along with 6 feet of 12" RCP.

Suzanne L. Mills  
GIS Specialist

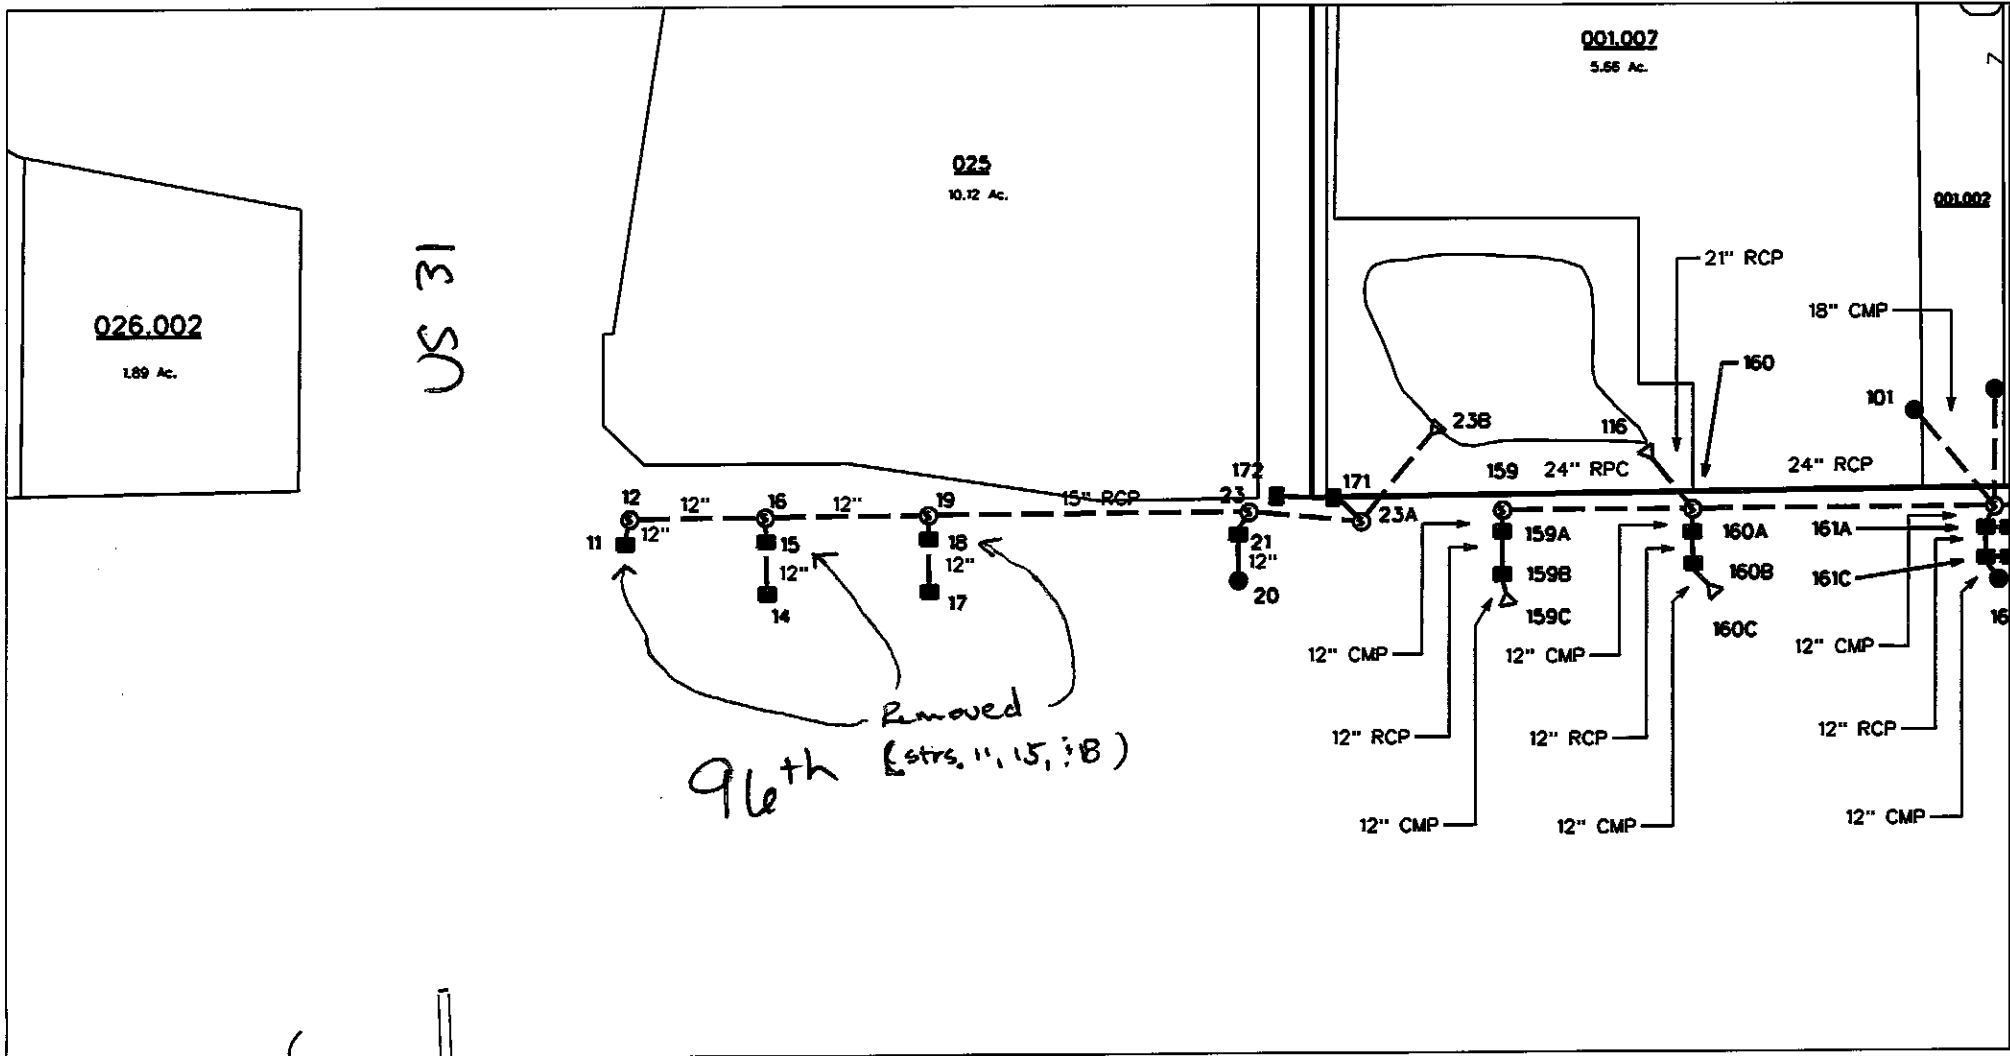

reg\_drain\_hc.dgn 12/15/2011 4:16:46 PM