

*Kenton C. Ward, CFM*  
*Surveyor of Hamilton County*  
*Phone (317) 776-8495*  
*Fax (317) 776-9628*

*Suite 188*  
*One Hamilton County Square*  
*Noblesville, Indiana 46060-2230*

### *Map Correction-Field Verification*

**Drain Number:** 350

**Drain Length:** N/A

**Drain Name:** Orris Brendell

**Change + / - :** N/A

**Date:** 08-10-2020

**New Length:** N/A


**Verified By:** SLM, SAB

---

**Notes & Sketch:** WO-2020-00205 SEE ATTACHED MAP

Tile was repaired through the above listed work order. Breathers were set. Tile was then mapped with GPS.

**Suzanne L. Mills**  
**GIS Specialist**

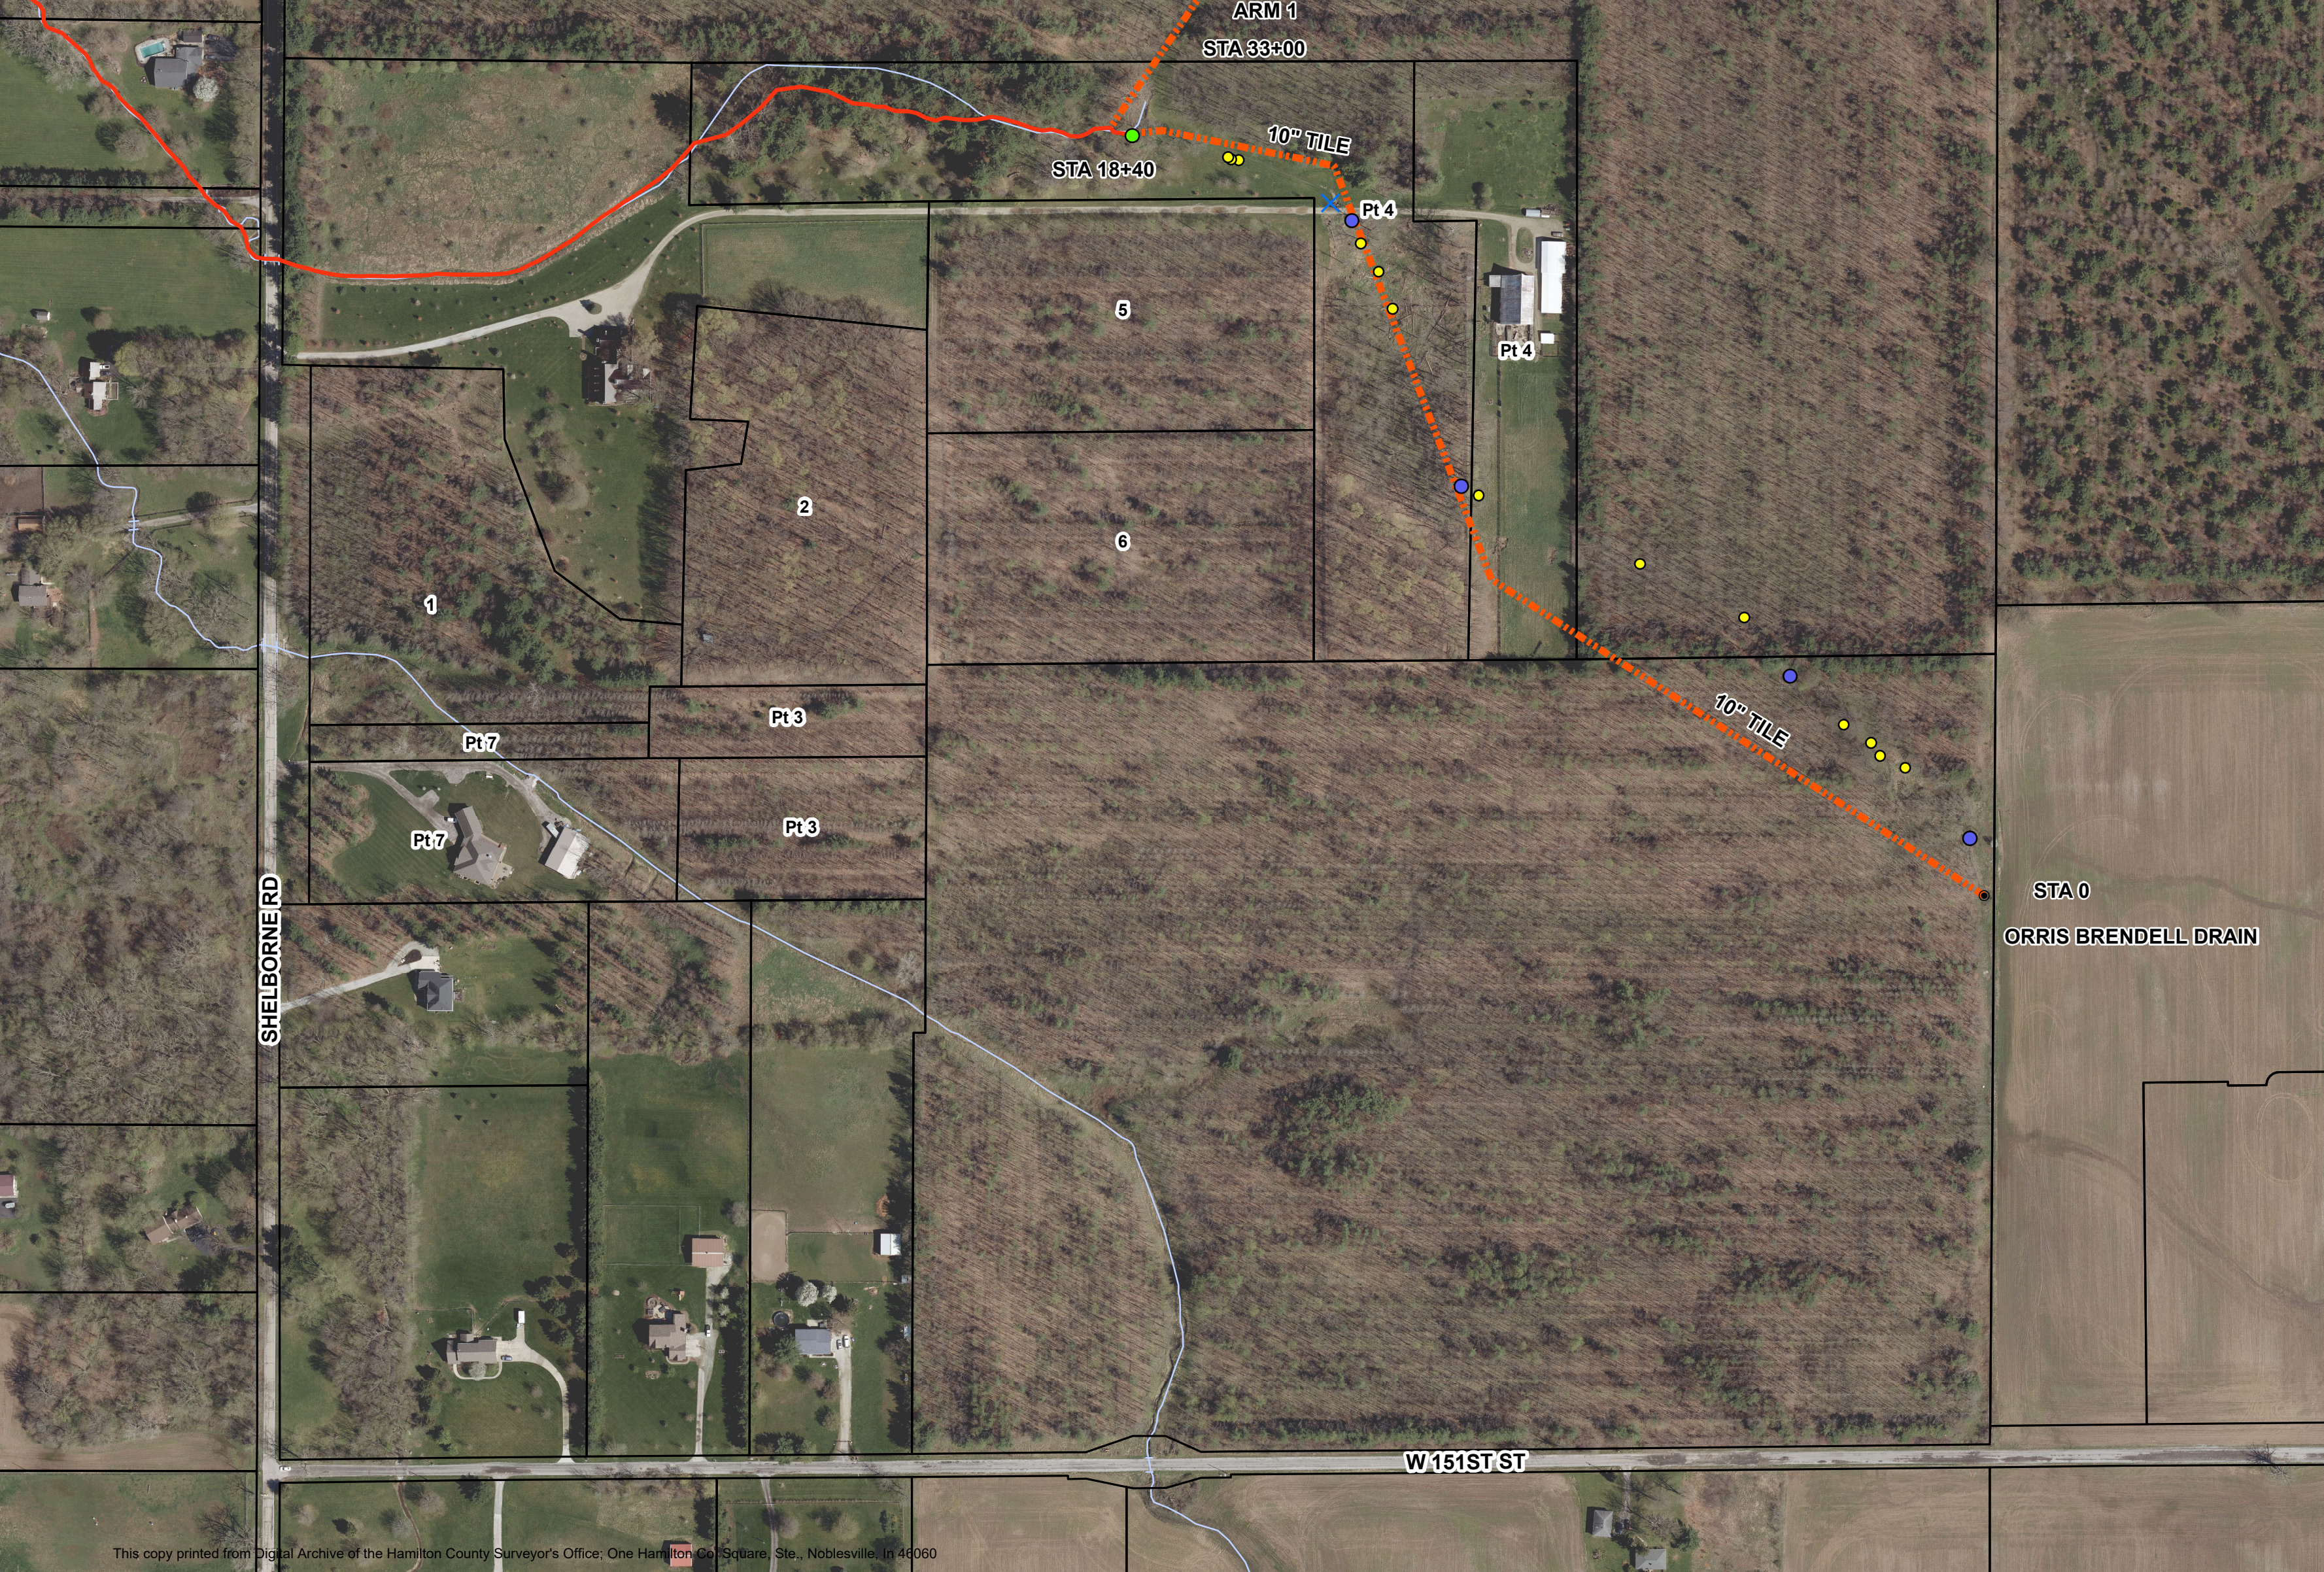

ARM 1  
STA 33+00

STA 18+40

10" TILE

Pt 4

Pt 4

5

2

6

1

Pt 7

Pt 3

Pt 7

Pt 3

SHELBORNE RD

10" TILE

STA 0

ORRIS BRENDELL DRAIN

W 151ST ST