

SURVEYOR'S OFFICE

Hamilton County

Kenton C. Ward, Surveyor

Phone (317) 776-8495

Fax (317) 776-9628

Suite 188

One Hamilton County Square

Noblesville, Indiana 46060-2230

October 14, 2005

TO: Hamilton County Drainage Board

RE: S.M. Smith Drain, Maple Village Section 1 Arm

Attached is a petition filed by Platinum Properties, LLC along with a non-enforcement request, plans, calculations, quantity summary and assessment roll for the Maple Village Section 1 Arm, S.M. Smith Drain to be located in Washington Township. I have reviewed the submittals and petition and have found each to be in proper form.

I have made a personal inspection of the land described in the petition. Upon doing so, I believe that the drain is practicable, will improve the public health, benefit a public highway, and be of public utility and that the costs, damages and expenses of the proposed drain will probably be less than the benefits accruing to the owners of land likely to be benefited. The drain will consist of the following:

| | | | |
|---------|------------|---------|---------|
| 6" SSD | 13,107 ft. | 21" RCP | 446 ft. |
| 6" HDPE | 2,266 ft. | 24" RCP | 393 ft. |
| 12" RCP | 1,079 ft. | 27" RCP | 164 ft. |
| 15" RCP | 1,071 ft. | 30" RCP | 124 ft. |
| 18" RCP | 630 ft. | 36" RCP | 391 ft. |

The total length of the drain will be 19,671 feet.

The water quality swales (dry detention basins) located in Common Areas #1, #2, and #8 are not to be considered part of the regulated drain. Only the inlet, outlet and 6" HDPE sub-surface pipe will be maintained as part of the regulated drain. The maintenance of the water quality swales will be the responsibility of the Homeowners Association or the Town of Westfield as part of their Stormwater Phase II Program. The Board however, will retain jurisdiction for ensuring the storage volume for which the water quality swales (dry detention basins) were designed will be retained, thereby, allowing no fill or easement encroachments, other than the water quality plantings.

The subsurface drains (SSD) to be part of the regulated drain are those located under the curbs. Only the main SSD lines which are located within the right of way are to be maintained as regulated drain. Laterals for individual lots will not be considered part of the regulated drain. The portion of the SSD which will be regulated other than those under curbs are as follows:

The 6" SSD located down the center of the frontage road for Kingsbridge Boulevard. This will serve as the SSD lateral outlet for Lots 42 to 55.

The subsurface drain (SSD) located under the private alley ways in the rear yards of lots 59 to 103 are not to be considered part of the regulated drain. The maintenance responsibility of these SSD will be that of the property owners or the Homeowners Association, who ever maintains the private alley ways.

I have reviewed the plans and believe the drain will benefit each lot equally. Therefore, I recommend each lot be assessed equally. I also believe that no damages will result to landowners by the construction of this drain. I recommend a maintenance assessment of \$10.00 per acre for common areas and platted lots, \$2.00 per acre for roadways, with a \$65.00 minimum. With this assessment the total annual assessment for this drain/this section will be \$7,906.58.

The petitioner has submitted surety for the proposed drain at this time. Surety shall be submitted prior to the approval of the Hamilton County Board of Commissioners/commencement of construction. The sureties which are in the form of a Performance Bond are as follows:

Agent: Bond Safeguard Insurance Company
Date: June 23, 2005
Number: 5017298
For: Storm Sewers & Erosion Control
Amount: \$380,784.00

Parcels assessed for this drain may be assessed for the Little Eagle Creek Drain at sometime in the future

I believe this proposed drain meets the requirements for Urban Drain Classification as set out in IC 36-9-27-67 to 69. Therefore, this drain shall be designated as an Urban Drain.

I recommend that upon approval of the above proposed drain that the Board also approve the attached non-enforcement request. The request is for the reduction of the regulated drain easement to those easement widths as shown on the secondary plat for Maple Village Section 1 as recorded in the office of the Hamilton County Recorder.

I recommend the Board set a hearing for this proposed drain for January 23, 2006.



Kenton C. Ward
Hamilton County Surveyor

KCW/pll

STATE OF INDIANA)
)
COUNTY OF HAMILTON)

TO: HAMILTON COUNTY DRAINAGE BOARD
% Hamilton County Surveyor
One Hamilton County Square, Suite 188
Noblesville, IN. 46060-2230

In the matter of Maple Village Subdivision, Section
One Drain Petition.

Petitioner is the owner of all lots in the land affected by the proposed new regulated drain. The drainage will affect various lots in Maple Village, Section One, a subdivision in Hamilton County, Indiana. The general route of such drainage shall be in existing easements and along public roads as shown in the plans on file in the Surveyor's Office.

Petitioner believes that the cost, damages and expenses of the proposed improvement will be less than the benefits which will result to the owners of the land likely to be benefited thereby. Petitioner believes the proposed improvements will:

- (a) improve public health
- (b) benefit a public street
- (c) be of public utility


Petitioner agrees to pay the cost of construction of the drainage system and requests periodic maintenance assessments by the Board thereafter

The Petitioner also agrees to the following:

1. To provide the Drainage Board a Performance Bond or Non-Revocable Letter of Credit for the portion of the drainage system which will be made a regulated drain. The bond will be in the amount of 120% of the Engineer's estimate. The bond will be in effect until construction of 100% of the system is completed and so certified by the Engineer.
2. The Petitioner shall retain an Engineer throughout the construction phase. At completion of the project the Petitioner's Engineer shall certify that the drainage system which is to be maintained as a regulated drain has been constructed as per construction plans.
3. The Petitioner agrees to request in writing to the County Surveyor any changes from the approved plan and must receive written authorization from the County Surveyor prior to implementation of the change. All changes shall be documented and given to the Surveyor to be placed in the Drain file.
4. The Petitioner shall instruct his Engineer to provide a reproducible print on a 24" x 36" Mylar of the final design of the Drainage System. This shall be submitted to the County Surveyor prior to the release of the Performance Bond.
5. The Petitioner shall comply with the Erosion Control Plan as specified on the construction plans. Failure to comply with the Erosion Control Plan shall be determined by the Board as being an obstruction to the drainage system. The County Surveyor shall immediately install or repair the needed measures at Petitioners cost as per IC 36-9-27-46.

The Petitioner further requests that the Drain be classified as an Urban Drain as per IC 36-9-27-69(d).

RECORDED OWNER(S) OF LAND INVOLVED

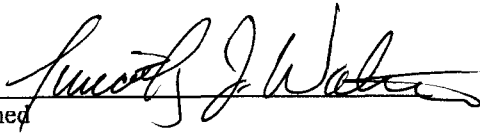
Signed

Timothy J. Walter
Printed Name

March 16, 2005
Date

Signed

Printed Name

Date

Signed

Printed Name

Date

Signed

Printed Name

Date

BEFORE THE HAMILTON COUNTY DRAINAGE BOARD
IN THE MATTER OF

S. M. Smith Drain, Maple Village Section 1 Arm

NOTICE

To Whom It May Concern and: _____

Notice is hereby given of the hearing of the Hamilton County Drainage Board concerning the reconstruction of the **S. M. Smith Drain, Maple Village Section 1 Arm** on **January 23, 2006, at 9:20 A.M.** in Commissioners Court, Hamilton County Judicial Center, One Hamilton County Square, Noblesville, Indiana. Construction and maintenance reports of the Surveyor and the Schedule of Assessments proposed by the Drainage Board have been filed and are available for public inspection in the office of the Hamilton County Surveyor.

Hamilton County Drainage Board

Attest: Lynette Mosbaugh

ONE TIME ONLY

BEFORE THE HAMILTON COUNTY DRAINAGE BOARD
IN THE MATTER OF THE

S. M. Smith Drain, Maple Village Section 1 Arm

NOTICE

Notice is hereby given pursuant to Section 405 of the 1965 Indiana Drainage Code that this Board, prior to final adjournment on **January 23, 2006** has issued an order adopting the Schedule of Assessments, filed the same and made public announcement thereof at the hearing and ordered publication. If judicial review of the findings and order of the Board is not requested pursuant to Article Eight of this code within twenty (20) days from the date of this publication, the order shall be conclusive.

Hamilton County Drainage Board

Attest: Lynette Mosbaugh

ONE TIME ONLY

FINDINGS AND ORDER


CONCERNING THE MAINTENANCE OF THE

S. M. Smith Drain, Maple Village Section 1 Arm


On this **23rd day of January 2006**, the Hamilton County Drainage Board has held a hearing on the Maintenance Report and Schedule of Assessments of the **S. M. Smith Drain, Maple Village Section 1 Arm**.

Evidence has been heard. Objections were presented and considered. The Board then adopted the original/amended Schedule of Assessments. The Board now finds that the annual maintenance assessment will be less than the benefits to the landowners and issues this order declaring that this Maintenance Fund be established.

HAMILTON COUNTY DRAINAGE BOARD

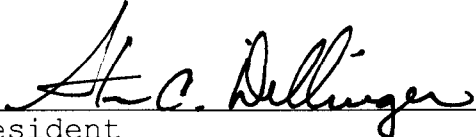


President

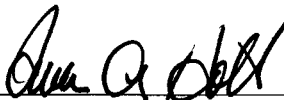

Member



Member

Attest: 

CERTIFICATE OF COMPLETION AND COMPLIANCE

To: Hamilton County Surveyor

Re: Maple Village, Section 1

I hereby certify that:

1. I am a Registered Land Surveyor or Engineer in the State of Indiana.
2. I am familiar with the plans and specifications for the above referenced subdivision.
3. I have personally observed and supervised the completion of the drainage facilities for the
4. The drainage facilities within the above referenced subdivision to the best of my knowledge, information and belief have been installed and completed in conformity with all plans and specifications.

Signature: Jeffery W. Darling Date: September 12, 2006

Type or Print Name: Jeffery W. Darling

Business Address: Stoepelwerth & Associates, Inc.

9940 Allisonville Road, Fishers, Indiana 46038


Telephone Number: (317) 849-5935

SEAL

INDIANA REGISTRATION NUMBER

900017



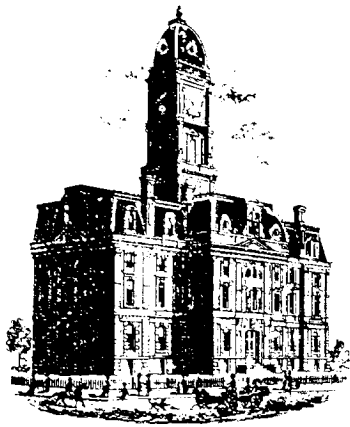

SURVEYOR'S OFFICE

Hamilton County

Kenton C. Ward, CFM
 Surveyor of Hamilton County
 Phone (317) 776-8495
 Fax (317) 776-9628

Suite 188
 One Hamilton County Square
 Noblesville, Indiana 46060-2230

To: Hamilton County Drainage Board

April 8, 2008

Re: Little Eagle Creek Drain: Maple Village Section 1

Attached are as-builts, certificate of completion & compliance, and other information for Maple Village Section 1. An inspection of the drainage facilities for this section has been made and the facilities were found to be complete and acceptable.

During construction, changes were made to the drain, which will alter the plans submitted with my report for this drain-dated October 14, 2005. The report was approved by the Board at the hearing held January 23, 2006. (See Drainage Board Minutes Book 9, Pages 15-17)
 The changes are as follows:

| Structure: | Length: | Size | Material: | Up Invert: | Dn_Invert | Grade: | Changes(ft): |
|------------|---------|------|-----------|---------------|-----------|--------|--------------|
| 559A-559 | 100 | 15 | RCP | 922.86 | 922.19 | 0.67 | |
| 559-558 | 23 | 15 | RCP | 922.19 | 921.86 | 2.09 | -1 |
| 558-557A | 102 | 18 | RCP | 921.71 | 920.12 | 1.56 | 1 |
| 557A-557 | 101 | 21 | RCP | 920.12 | 918.95 | 1.16 | 1 |
| 557-556 | 22 | 24 | RCP | 918.95 | 918.69 | 1.18 | -2 |
| 556-555 | 101 | 27 | RCP | 918.69 | 918.25 | 0.44 | 1 |
| 555-554 | 100 | 30 | RCP | 918.25 | 917.87 | 0.38 | |
| 554-553 | 23 | 30 | RCP | 917.87 | 917.67 | 0.39 | -1 |
| 553-552 | 101 | 36 | RCP | 917.67 | 917.25 | 0.42 | |
| 552-551A | 100 | 36 | RCP | 917.25 | 916.92 | 0.33 | |
| 551A-551 | 23 | 36 | RCP | 916.92 | 916.78 | 0.61 | -1 |
| 551-549 | 128 | 36 | RCP | 916.78 | 916.5 | 0.22 | 2 |
| 549-549A | 38 | 36 | RCP | 916.5 | 916.45 | 0.13 | -2 |
| 512-509 | 197 | 15 | RCP | 917.55 | 916.53 | 0.52 | 2 |
| 509-508 | 76 | 21 | RCP | 916.53 | 916.08 | 0.59 | 3 |
| 511-510 | 31 | 15 | RCP | 917.29 | 917.02 | 0.87 | |
| 510-509 | 131 | 18 | RCP | 917.02 | 916.53 | 0.37 | |
| 508-507 | 132 | 24 | RCP | 916.08 | 915.4 | 0.51 | 2 |
| 507-506 | 29 | 24 | RCP | 915.4 | 915.18 | 0.75 | |
| 506-505 | 45 | 24 | RCP | 915.18 | 915 | 0.4 | -9 |
| 513-514 | 132 | 18 | RCP | 916.02 | 915.53 | 0.37 | -1 |
| 514-515 | 28 | 21 | RCP | 915.53 | 915.47 | 0.21 | |
| 515-516 | 49 | 24 | RCP | 915.47 | 914.93 | 1.1 | -2 |

| | | | | | | | |
|----------|-----|----|-----|--------|--------|------|-----|
| 522-521 | 24 | 12 | RCP | 920.28 | 919.93 | 1.45 | |
| 521-519 | 36 | 12 | RCP | 919.93 | 918.84 | 3.02 | |
| 519-518 | 50 | 18 | RCP | 918.25 | 917.47 | 1.56 | |
| 518-517 | 40 | 18 | RCP | 917.47 | 917.07 | 1 | -1 |
| 517-514 | 139 | 21 | RCP | 917.07 | 915.53 | 1.11 | 1 |
| 502-501 | 28 | 15 | RCP | 918.33 | 918.18 | 0.53 | |
| 501-500 | 50 | 18 | RCP | 918.18 | 918.04 | 0.28 | |
| 529A-529 | 102 | 12 | RCP | 921.53 | 920.26 | 1.25 | 1 |
| 533B-529 | 24 | 12 | RCP | 921.53 | 920.26 | 1.25 | |
| 529-526 | 134 | 15 | RCP | 920.26 | 919.62 | 0.48 | |
| 527-526 | 50 | 12 | RCP | 921.06 | 922.05 | 1.98 | |
| 526-525 | 181 | 15 | RCP | 919.62 | 918.9 | 0.4 | |
| 525-524 | 24 | 15 | RCP | 918.9 | 918.76 | 0.58 | |
| 524-519 | 175 | 15 | RCP | 918.76 | 918.25 | 0.3 | -1 |
| 541-542 | 28 | 12 | RCP | 919.46 | 919.18 | 1 | |
| 542-544 | 46 | 12 | RCP | 919.18 | 919.05 | 0.28 | -1 |
| 534-546A | 101 | 21 | RCP | 918.59 | 918.29 | 0.3 | |
| 546A-546 | 101 | 24 | RCP | 918.29 | 918.09 | 0.2 | -8 |
| 546-547 | 24 | 27 | RCP | 918.09 | 917.99 | 0.41 | |
| 547-548 | 37 | 27 | RCP | 917.99 | 917.82 | 0.41 | -3 |
| 540-535 | 100 | 15 | RCP | 919.59 | 919.29 | 0.3 | 2 |
| 538-535 | 36 | 12 | RCP | 919.48 | 919.29 | 0.53 | |
| 535-534 | 123 | 18 | RCP | 919.29 | 918.59 | 0.57 | -1 |
| 533A-533 | 100 | 12 | RCP | 919.48 | 918.67 | 0.81 | |
| 534-533 | 24 | 12 | RCP | 918.67 | 918.67 | 0.33 | |
| 545-544 | 50 | 12 | RCP | 919.62 | 919.05 | 1.14 | |
| 544-543 | 75 | 15 | RCP | 919.05 | 918.73 | 0.43 | -5 |
| 532-531 | 165 | 12 | RCP | 920.15 | 918.37 | 1.07 | |
| 531-530 | 40 | 12 | RCP | 918.37 | 917.85 | 1.3 | -2 |
| 561-597 | 75 | 12 | RCP | 914.09 | 913.39 | 0.93 | 1 |
| 563-562 | 48 | 12 | RCP | 916.09 | 915.44 | 1.35 | -2 |
| 523A-523 | 80 | 12 | RCP | 922.69 | 922.15 | 0.68 | -34 |
| 523-521 | 113 | 12 | RCP | 922.15 | 919.93 | 1.96 | -1 |

6" SSD

Streets:

| | |
|------------------|--------|
| Southhall | 2053.5 |
| Brigg | 770 |
| Knottingly | 173 |
| Warrington | 530 |
| Madstone | 518 |
| Kimberly Ave | 509 |
| Helston | 507 |
| Kingsbridge Blvd | 950 |
| x2 | |

Total: 12021

Other Drain:

| | |
|---------|------|
| 6" HDPE | 1945 |
|---------|------|

Total: 1945

RCP Pipe Totals:

| | |
|----|------|
| 12 | 1041 |
| 15 | 1068 |
| 18 | 628 |
| 21 | 445 |
| 24 | 378 |
| 27 | 162 |
| 30 | 123 |
| 36 | 390 |

Total: 4235

The length of the drain due to the changes described above is now **18,201 feet**.

The non-enforcement was approved by the Board at its meeting on January 23, 2006 and recorded under instrument #20060004904.

The following sureties were guaranteed by Bond Safeguard Insurance Company and released by the Board on its May 29, 2007 meeting.

Bond-LC No: 5017298


Insured For: Storm Sewers, Erosion Control

Amount: \$380,784

Issue Date: June 23, 2005

I recommend the Board approve the drain's construction as complete and acceptable.

Sincerely,

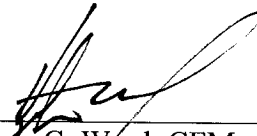


Kenton C. Ward, CFM
Hamilton County Surveyor


KCW/slm

MAPLE VILLAGE SECTION ONE

Developed by:
 PLATINUM PROPERTIES L.L.C.
 9551 DELEGATES ROW
 INDIANAPOLIS, INDIANA 46240
 PHONE: (317) 818-2900
 FAX: (317) 818-2910
 CONTACT PERSON: TIM WALTER

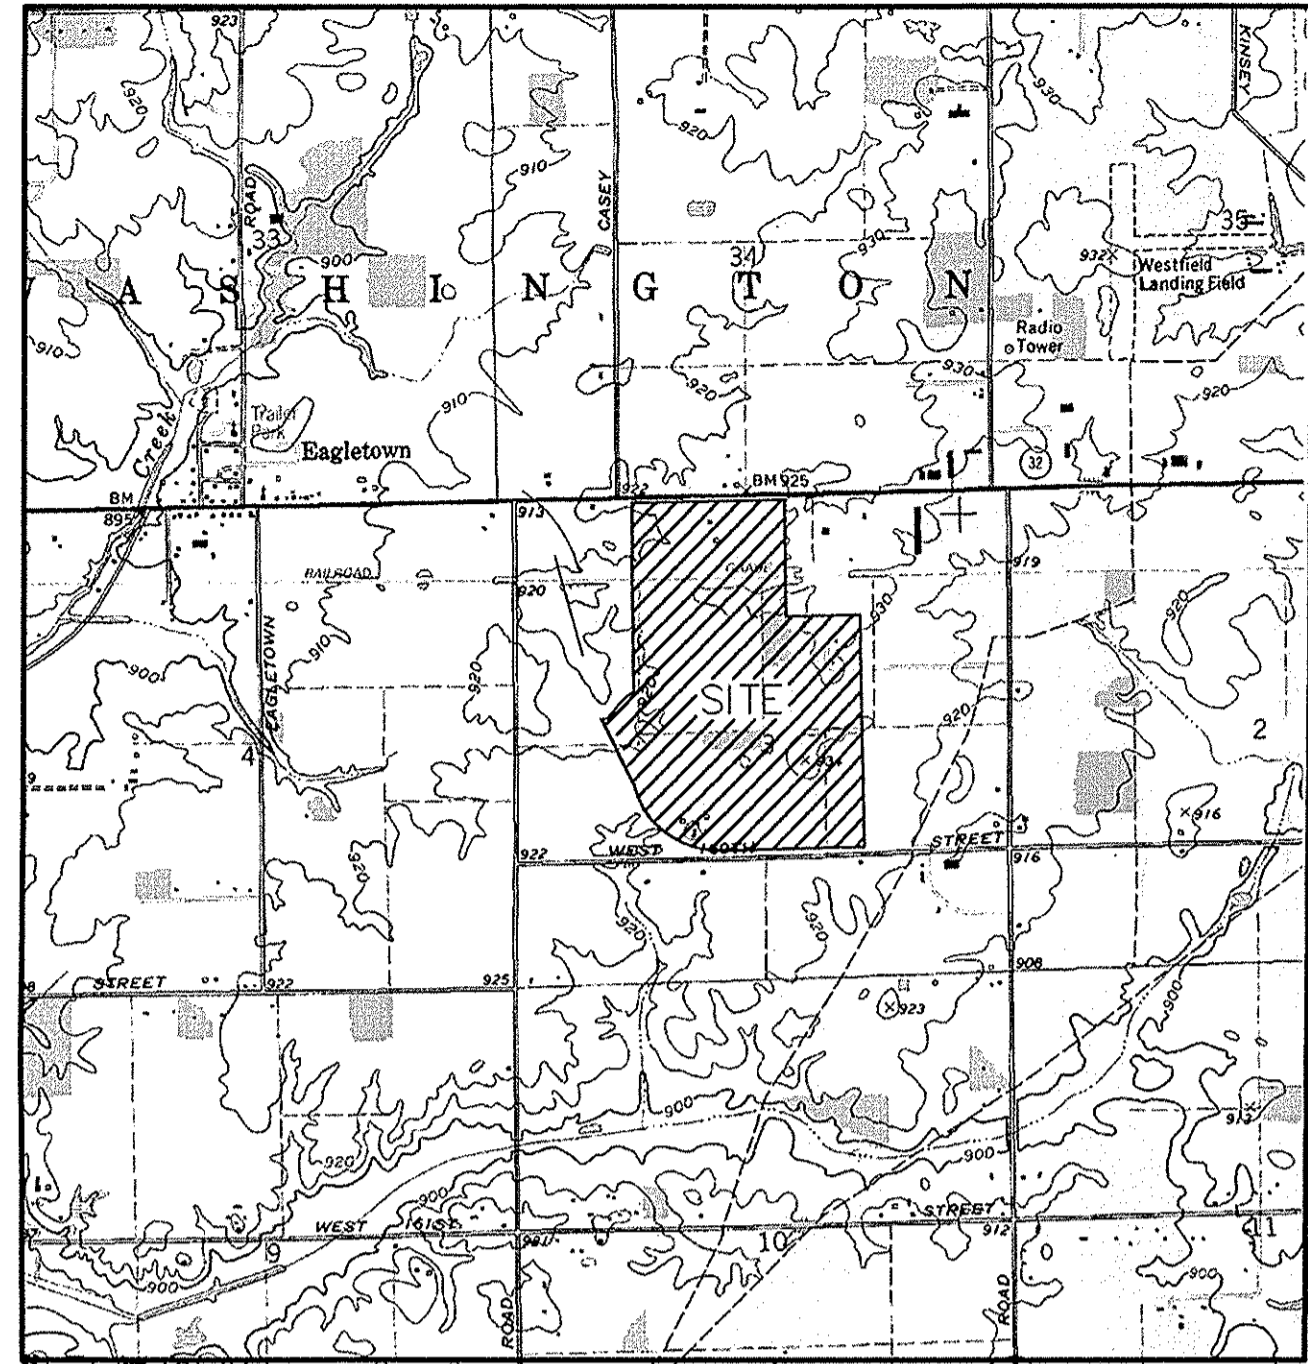

LOCATION MAP

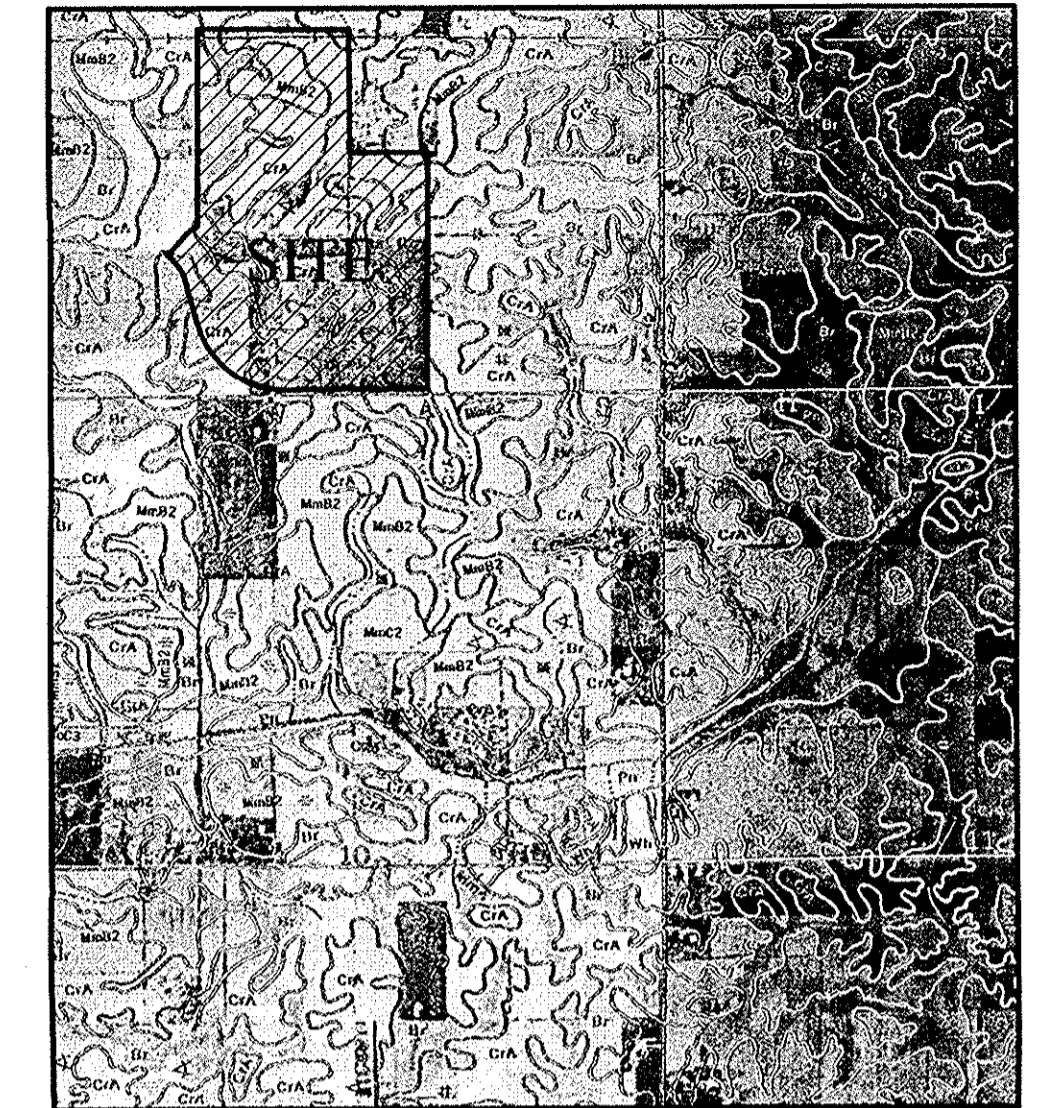


SOILS MAP

Br BROOKSTON
 CrA CROSBY
 MmB2 MIAMI (2 TO 6% SLOPE)
 Pn PATTON

RECORD DRAWING

Jeffery W. Darling
 JEFFERY W. DARLING
 Registered Land Surveyor
 No. 900017

9/11/06
 DATE

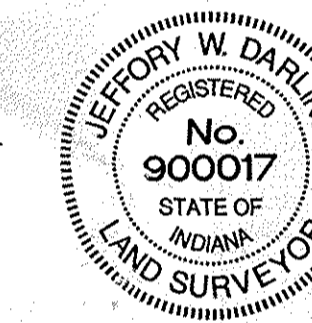

SPEED LIMIT: 25 M.P.H.

DESIGN DATA

111 LOTS = 3.39 LOTS/ACRE
 32.753 AC.


| | |
|-----------------------|----------------------|
| KINGSBRIDGE BOULEVARD | 1,083.32 L.F. |
| SOUTHALL DRIVE | 2,120.01 L.F. |
| BRIGG COURT | 785.48 L.F. |
| HELSTON AVENUE | 933.16 L.F. |
| KIMBERLY AVENUE | 936.72 L.F. |
| MAIDSTONE AVENUE | 940.29 L.F. |
| WARRINGTON AVENUE | 624.60 L.F. |
| KNOTTINGLY WAY | 343.16 L.F. |
| TOTAL | 7,766.74 L.F. |

PLANS PREPARED BY:

STOEPPELWERTH & ASSOCIATES, INC.
 CONSULTING ENGINEERS & LAND SURVEYORS
 9940 ALLISONVILLE ROAD
 FISHERS, INDIANA 46038
 PHONE: (317)-849-5935
 FAX: (317)-849-5942
 CONTACT PERSON: EDWARD E. FLEMING

PLANS CERTIFIED BY:

David J. Stoepfelwerth
 DAVID J. STOEPPELWERTH
 PROFESSIONAL ENGINEER
 NO. 19358

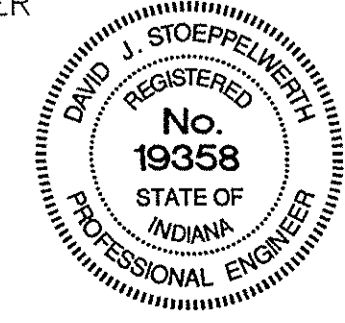


SCALE: 1"=250'

| SHT. | INDEX DESCRIPTION |
|-----------|--|
| C001 | COVER SHEET |
| C100 | TOPOGRAPHICAL SURVEY |
| C200-C202 | SITE DEVELOPMENT PLANS |
| C300-C301 | EROSION CONTROL PLANS & SPECIFICATIONS |
| C400-C409 | STREET PLAN & PROFILES / INTERSECTION DETAILS / TRAFFIC PLAN |
| C500-C503 | SANITARY SEWER PLAN & PROFILES |
| C600-C602 | STORM SEWER PLAN & PROFILES |
| C700-C701 | WATER PLANS / WATER DETAILS |
| C800-C806 | CONSTRUCTION DETAILS SANITARY STORM STREET |

| SHT. | REVISIONS DESCRIPTION |
|------|---|
| ALL | REVISED PLANS PER DEVELOPER CHANGES 3/16/05 BAH |
| ALL | REVISED PLANS PER TAC COMMENTS 4/15/05 BAH |
| ALL | REVISED SANITARY PER DEVELOPER 5/4/05 BAH |
| ALL | REVISED PER DEVELOPER 6/22/05 BAH |
| C500 | REVISED PER DEVELOPER 6/26/06 JDH |
| C501 | AS BUILTS 9/11/06 BAH & DLL |


This information was gathered for input into the Hamilton County Geographic Information System (GIS). This document is considered an official record of the GIS.
 Entry Date: 3-26-08
 Entered By: SLM

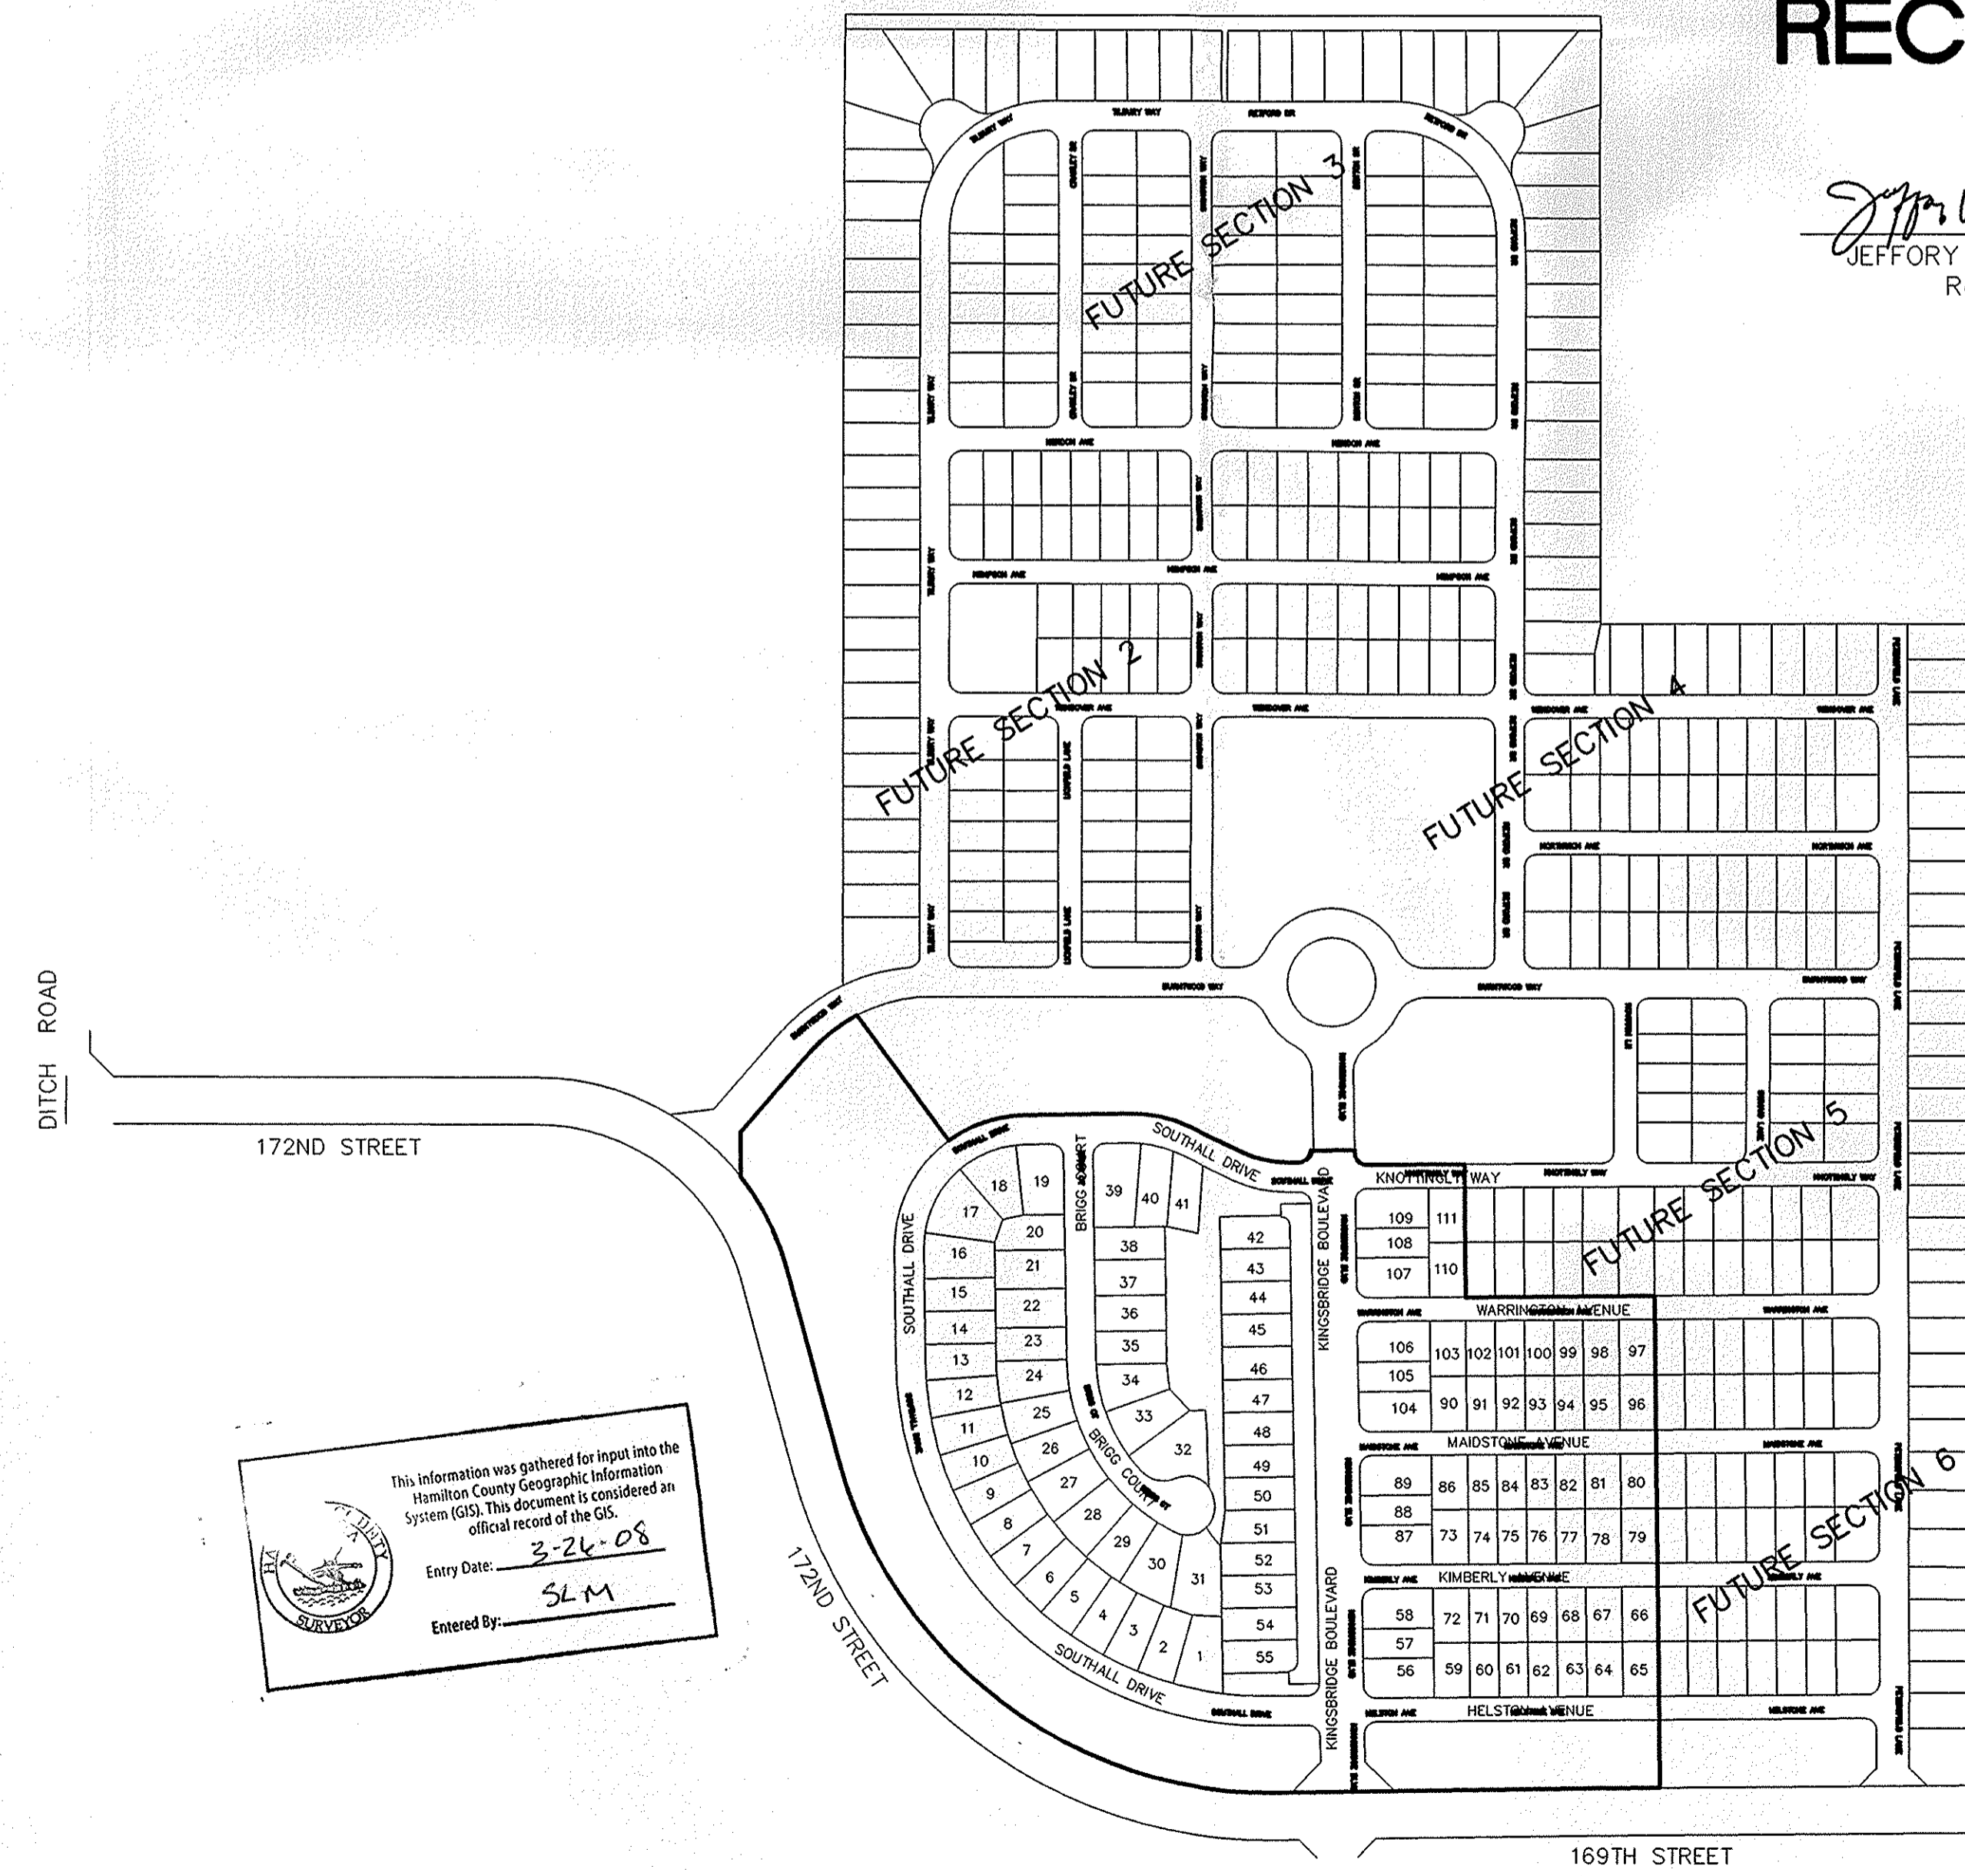

RECORD DRAWING

Jeffery W. Darling
 JEFFERY W. DARLING
 Registered Land Surveyor
 No. 900017

9/11/06
 DATE

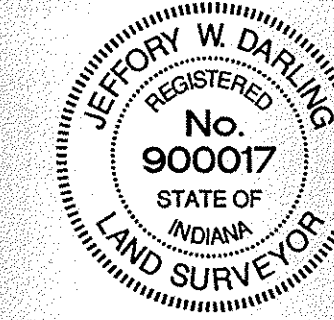

SCALE: 1" = 50'


- LEGEND**
- 848 — EXISTING CONTOUR
 - 848 — EXISTING SANITARY SEWER
 - 848 — EXISTING STORM SEWER
 - 828.0 PROPOSED GRADE
 - 848 PROPOSED CONTOUR
 - 848 — PROPOSED SANITARY SEWER
 - 848 — PROPOSED STORM SEWER
 - 848 — PROPOSED SWALE
 - 848 — PROPOSED 5' SIDEWALK (BY HOME BUILDER)
 - ▨ PROPOSED 5' SIDEWALK TO BE INSTALLED BY DEVELOPER

700 LOT NUMBER
897.4 PAD ELEVATION
 PAD SIZE 37'x37' LOTS 56 THRU 111
 PAD SIZE 45'x60' LOTS 1 THRU 55
 (UNLESS OTHERWISE NOTED)

ALL PADS SHOULD BE TESTED TO ASSURE A COMPACTION OF AT LEAST 95 PERCENT OF THE MAXIMUM DRY DENSITY USING THE STANDARD PROCTOR TEST METHOD.

- 4" — PROPOSED 6" UNDERDRAINS
- 4" — 4" S.S.D. LATERALS

NOTE: ALL SSD IN DRY DETENTION BASINS TO BE DOUBLE WALL SMOOTH BORE PERFORATED HDPE PIPE.

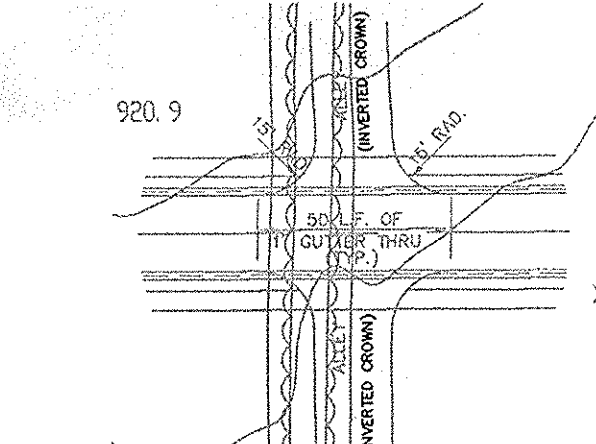

TYPICAL ALLEY / STREET INTERSECTION DETAIL


SCALE: 1" = 50'

GENERAL NOTES:

- 1.) ALL INVERTED CROWN PRIVATE DRIVES AND ALLEYS TO HAVE A 6" S.S.D. DOWN CENTER OF STREET.
- 2.) BLUE REFLECTORS SHALL BE INSTALLED IN THE CENTER LINE OF THE PAVEMENT TO MARK FIRE HYDRANTS PER THE TOWN OF WESTFIELD'S UTILITY AND INFRASTRUCTURE CONSTRUCTION STANDARDS.
- 3.) LOTS 56-111 TO BE SLAB CONSTRUCTED. NO SSD LATERALS REQUIRED.

NOTE: DECORATIVE SIGNS, SPRINKLER SYSTEMS, TREES, LANDSCAPING MOUNDS, LIGHT POLES, OR OTHER SUCH AMENITIES ARE NOT PERMITTED IN THE RIGHT OF WAY.


"HOLEY MOLEY" SAYS:

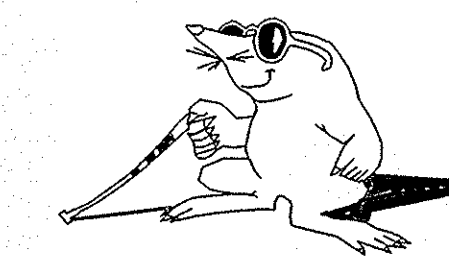

CAUTION

LOCATION OF ALL EXISTING UNDERGROUND UTILITIES SHOWN ON THIS PLAN ARE BASED UPON ABOVE GROUND EVIDENCE, (including, but not limited to, manholes, inlets, valves, & marks made upon the ground by others,) AND ARE SPECULATIVE IN NATURE. THERE MAY ALSO BE OTHER EXISTING UNDERGROUND UTILITIES FOR WHICH THERE IS NO ABOVE GROUND EVIDENCE OR FOR WHICH NO ABOVE GROUND EVIDENCE WAS OBSERVED. THE EXACT LOCATIONS OF SAID EXISTING UNDERGROUND UTILITIES SHOULD BE VERIFIED BY THE CONTRACTOR PRIOR TO ANY AND ALL CONSTRUCTION.

1-800-382-5544
 CALL TOLL FREE
 1-800-428-5200
 FOR CALLS OUTSIDE OF INDIANA

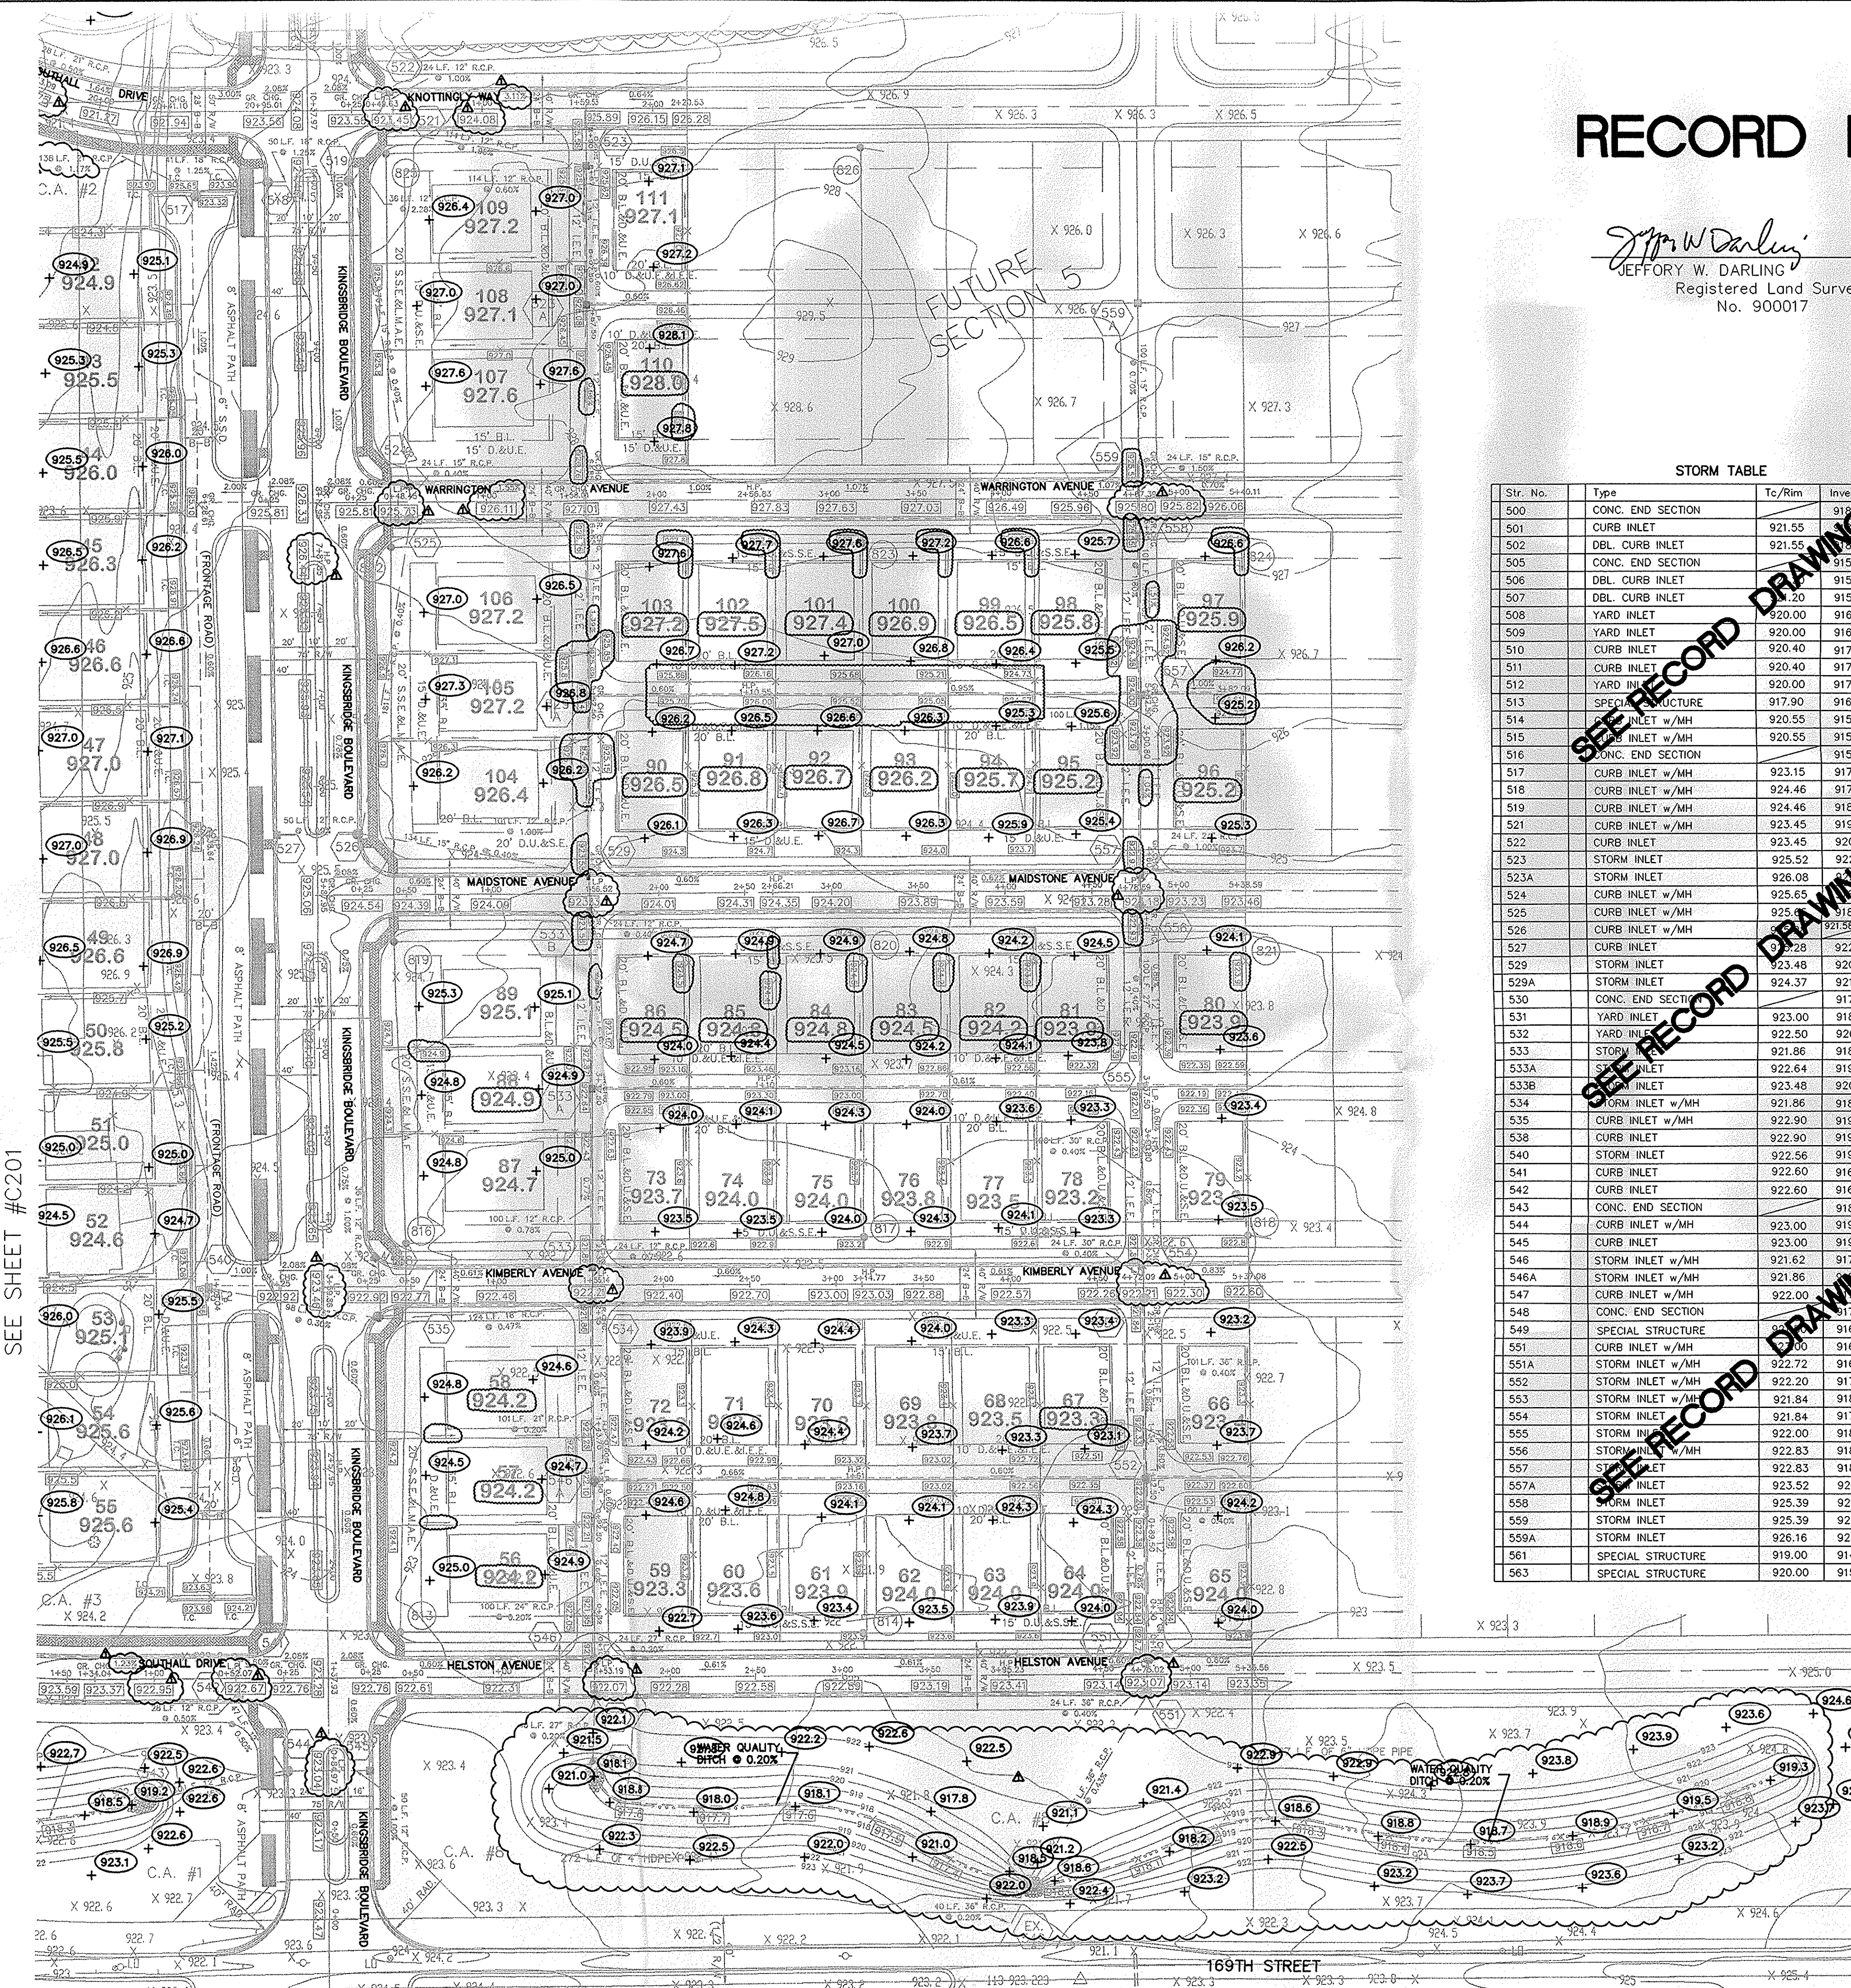

STORM TABLE

| Str. No. | Type | To/Rim | Inverts | Dir. |
|----------|-------------------|--------|---------|------------|
| 500 | CONC. END SECTION | | 917.52 | (SW) |
| 501 | CURB INLET | 921.55 | 915.00 | (SW,NE) |
| 502 | DBL. CURB INLET | 921.55 | 915.00 | (SW,NE) |
| 505 | CONC. END SECTION | | 915.00 | (SE) |
| 506 | DBL. CURB INLET | 920.00 | 915.24 | (NW,SE) |
| 507 | DBL. CURB INLET | 920.00 | 915.38 | (W,E) |
| 508 | YARD INLET | 920.00 | 916.03 | (W,S) |
| 509 | YARD INLET | 920.00 | 916.42 | (N,E,S) |
| 510 | CURB INLET | 920.40 | 917.08 | (SE,W) |
| 511 | CURB INLET | 920.40 | 917.23 | (NW) |
| 512 | YARD INLET | 920.00 | 917.40 | (N) |
| 513 | SPECIAL STRUCTURE | 917.90 | 916.06 | (NE) |
| 514 | INLET w/MH | 920.55 | 915.40 | (SW,NE,SE) |
| 515 | INLET w/MH | 920.55 | 915.26 | (SW,NE) |
| 516 | CONC. END SECTION | | 915.00 | (SE) |
| 517 | CURB INLET w/MH | 923.15 | 917.02 | (NW,E) |
| 518 | CURB INLET w/MH | 924.46 | 917.53 | (W,E) |
| 519 | CURB INLET w/MH | 924.46 | 918.15 | (W,NE,SE) |
| 521 | CURB INLET w/MH | 923.45 | 919.96 | (N,SW,SE) |
| 522 | CURB INLET | 923.45 | 920.20 | (S) |
| 523 | STORM INLET | 925.52 | 922.00 | (NW,S) |
| 523A | STORM INLET | 926.08 | 922.00 | (N) |
| 524 | CURB INLET w/MH | 925.65 | 918.25 | (N,S) |
| 525 | CURB INLET w/MH | 925.18 | 918.95 | (SW,N) |
| 526 | CURB INLET w/MH | 924.37 | 919.67 | (W,SE,NE) |
| 527 | CURB INLET | 922.28 | 922.08 | (E) |
| 529 | STORM INLET | 923.48 | 920.21 | (N,S,NW) |
| 529A | STORM INLET | 924.37 | 921.22 | (S) |
| 530 | CONC. END SECTION | | 917.93 | (SE) |
| 531 | YARD INLET | 923.00 | 918.35 | (NW,S) |
| 532 | YARD INLET | 922.50 | 920.00 | (N) |
| 533 | STORM INLET | 921.86 | 918.66 | (N,S) |
| 533A | STORM INLET | 922.64 | 919.44 | (N,S) |
| 533B | STORM INLET | 923.48 | 920.31 | (N,S) |
| 534 | STORM INLET w/MH | 921.86 | 918.48 | (N,W,S) |
| 535 | CURB INLET w/MH | 922.90 | 919.07 | (N,NW,E) |
| 538 | CURB INLET | 922.90 | 919.43 | (S) |
| 540 | STORM INLET | 922.56 | 919.36 | (SE) |
| 541 | CURB INLET | 922.60 | 916.40 | (S) |
| 542 | CURB INLET | 922.60 | 916.26 | (N,SE) |
| 543 | CONC. END SECTION | | 918.67 | (NE) |
| 544 | CURB INLET w/MH | 923.00 | 919.03 | (NW,E,SE) |
| 545 | CURB INLET | 923.00 | 919.53 | (W) |
| 546 | STORM INLET w/MH | 921.62 | 917.93 | (N,S) |
| 546A | STORM INLET w/MH | 921.86 | 918.00 | (N,S) |
| 547 | CURB INLET w/MH | 922.00 | 917.83 | (N,S) |
| 548 | CONC. END SECTION | | 917.85 | (N) |
| 549 | SPECIAL STRUCTURE | 916.30 | 916.30 | (SW,NE) |
| 551 | CURB INLET w/MH | 922.00 | 916.84 | (N,SW) |
| 551A | STORM INLET w/MH | 922.72 | 916.94 | (N,S) |
| 552 | STORM INLET w/MH | 922.20 | 917.34 | (N,S) |
| 553 | STORM INLET w/MH | 921.84 | 918.74 | (N,S) |
| 554 | STORM INLET w/MH | 921.84 | 918.84 | (N,S) |
| 555 | STORM INLET | 922.00 | 918.24 | (N,S) |
| 556 | STORM INLET w/MH | 922.83 | 918.64 | (N,S) |
| 557 | STORM INLET | 922.83 | 918.88 | (N,S) |
| 557A | STORM INLET | 923.52 | 920.03 | (N,S) |
| 558 | STORM INLET | 925.39 | 921.83 | (N,S) |
| 559 | STORM INLET | 925.39 | 922.19 | (S,N) |
| 559A | STORM INLET | 926.16 | 922.89 | (S) |
| 561 | SPECIAL STRUCTURE | 919.00 | 914.00 | (W) |
| 563 | SPECIAL STRUCTURE | 920.00 | 915.93 | (S) |

This information was gathered for input into the Hamilton County Geographic Information System (GIS). This document is considered an official record of the GIS.
 Entry Date: 3-26-08
 Entered By: SLM

REGISTERED PROFESSIONAL ENGINEER
 No. 19358
 STATE OF INDIANA

CONSULTING ENGINEERS - LAND SURVEYORS
 (317) 849-5935 1-800-728-6917 FAX: (317) 849-5942
 INDIANAPOLIS INDIANA

SITE DEVELOPMENT PLAN
 MAPLE VILLAGE SECTION ONE
 WESTFIELD INDIANA

SHEET NO. C200
 JOB NO. 50690PLA-S


DATE: 3/16/05

MARK: David J. Stappert

REVISIONS:

| NO. | DATE | DESCRIPTION |
|-----|---------|-------------------------------|
| 1 | 3/16/05 | ISSUED FOR PERMITS |
| 2 | 3/16/05 | REVISED PER TAC COMMENTS |
| 3 | 3/16/05 | REVISED PER DEVELOPER CHANGES |


S:\50690PLA-S1\dwg\C201-GRD.dwg, Layout1, 9/11/2006 4:20:25 PM, bhuff, 1:1

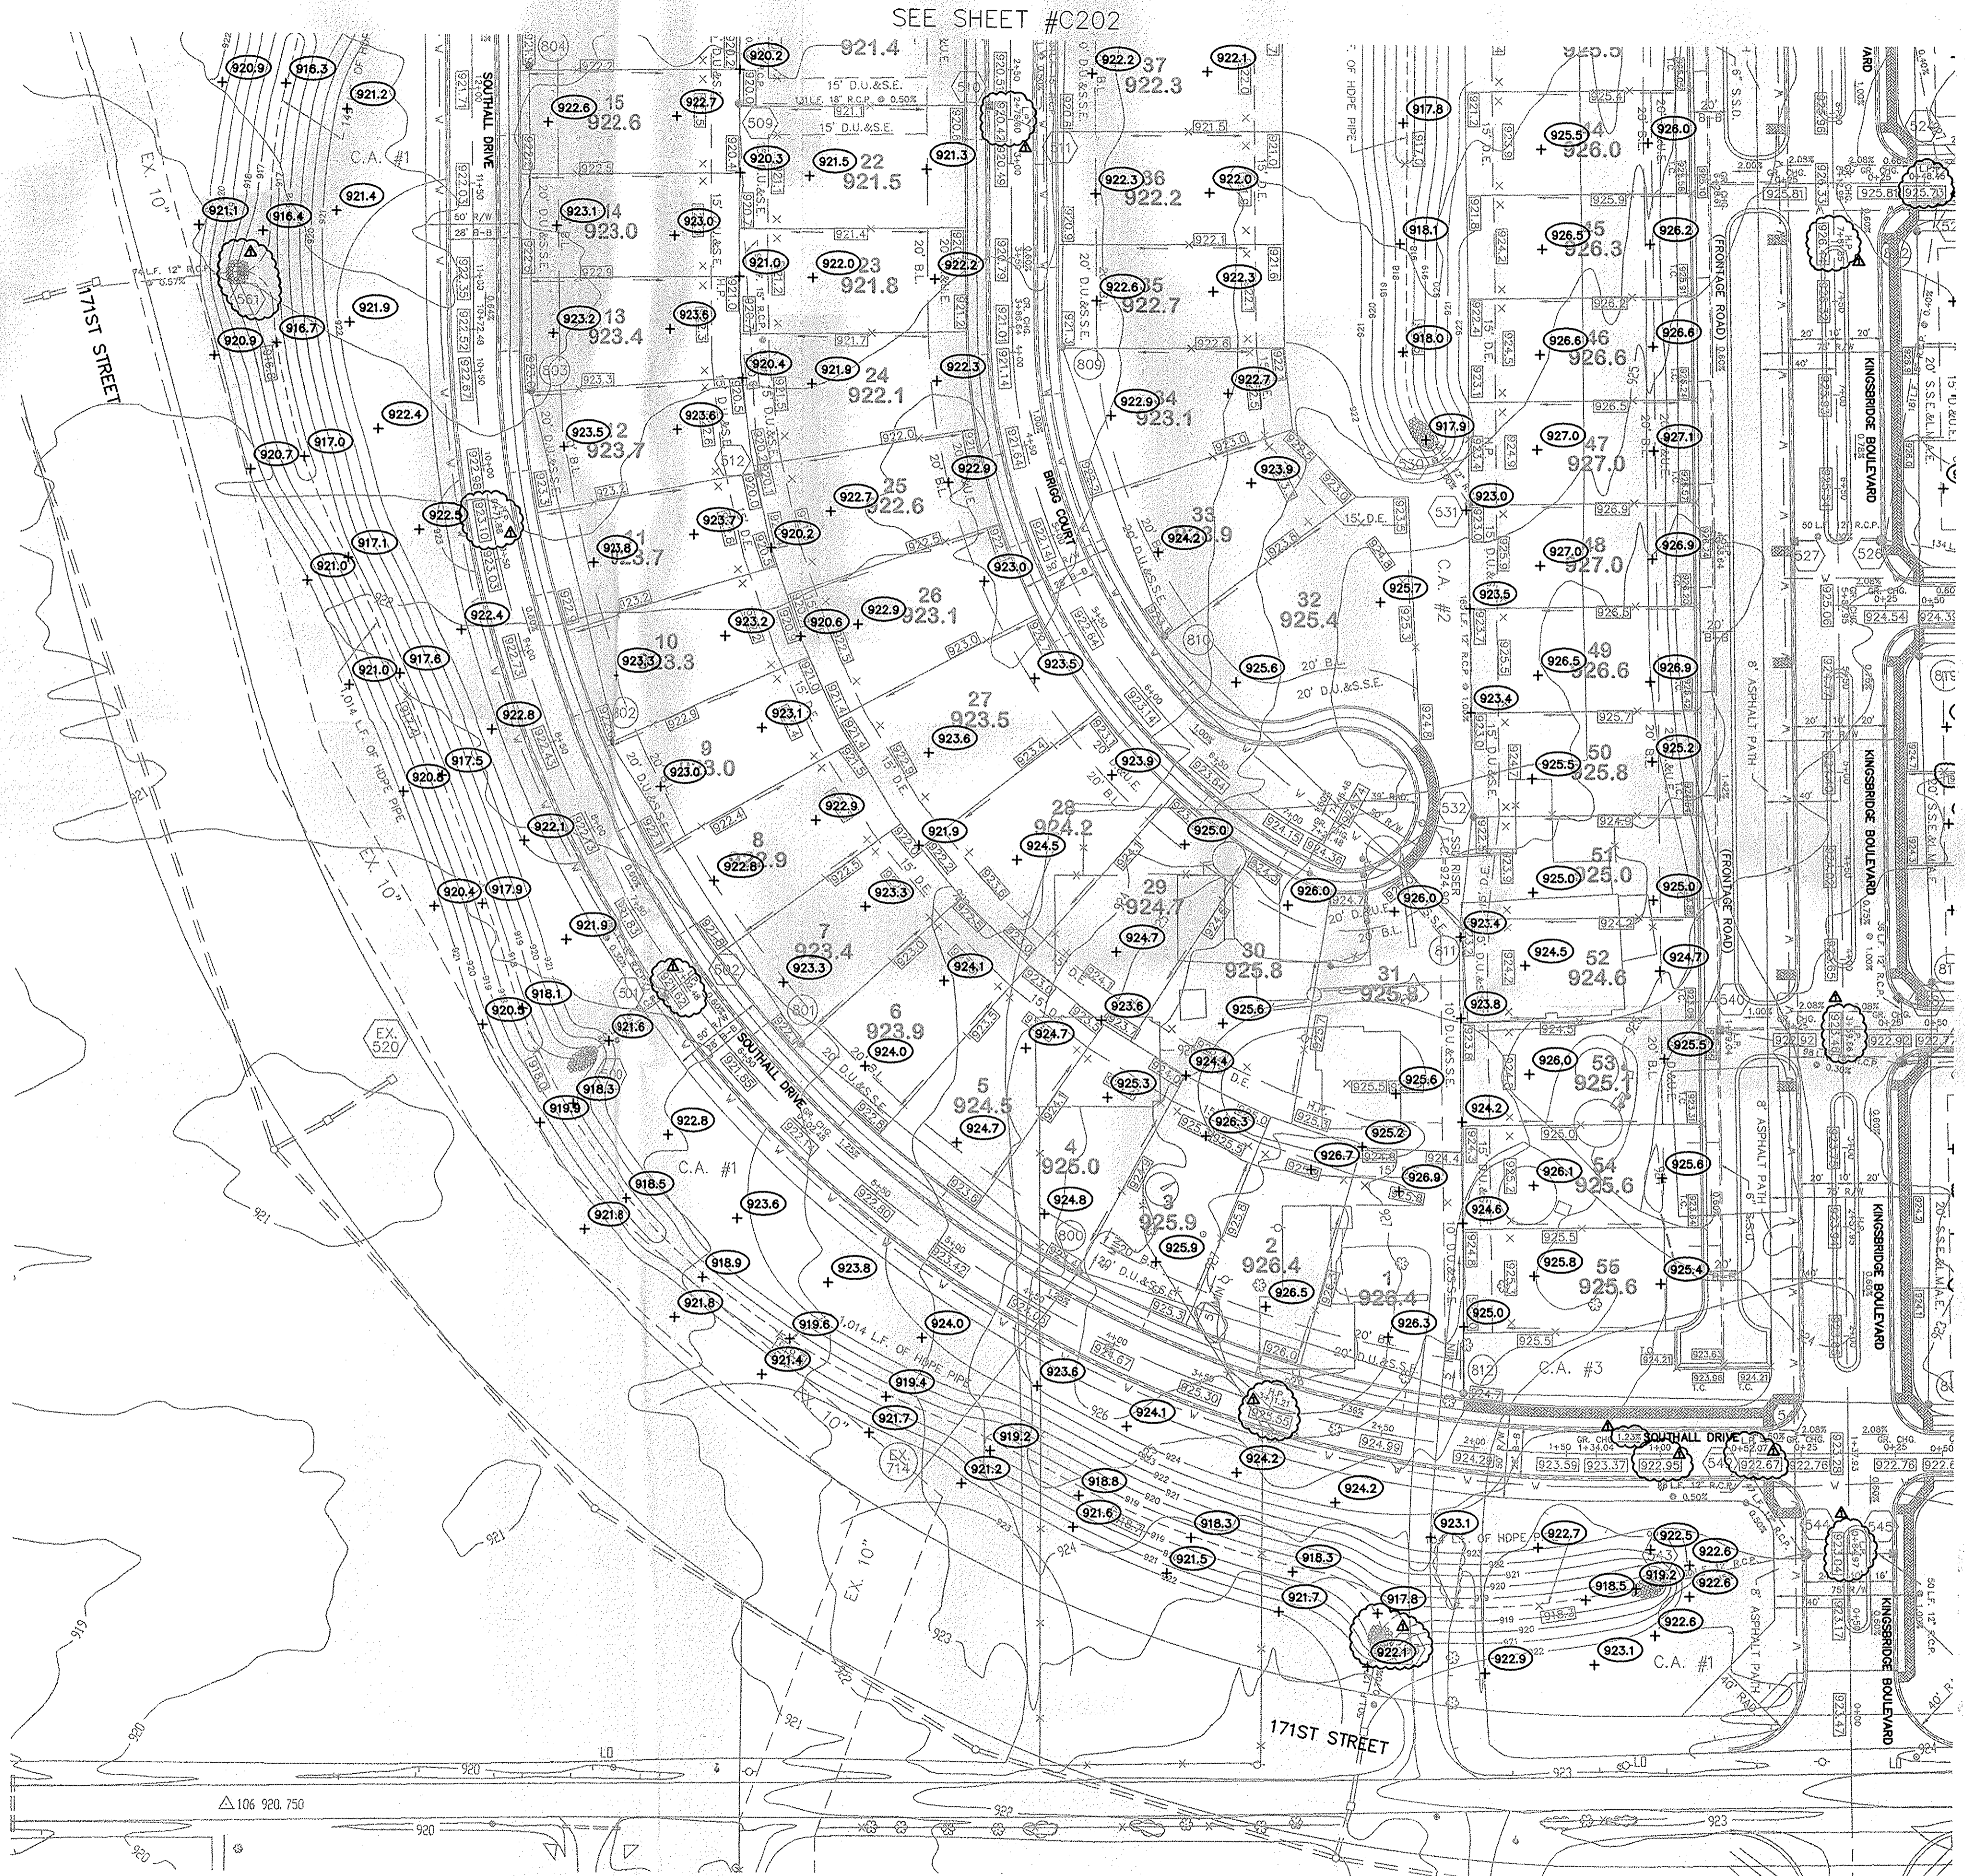

SEE SHEET #C202

SEE SHEET #C200

- LEGEND**
- 648 — EXISTING CONTOUR
 - 648 — EXISTING SANITARY SEWER
 - 648 — EXISTING STORM SEWER
 - 828.0 PROPOSED GRADE
 - 648 — PROPOSED CONTOUR
 - 648 — PROPOSED SANITARY SEWER
 - 648 — PROPOSED STORM SEWER
 - 648 — PROPOSED SWALE
 - 648 — PROPOSED 5' SIDEWALK (BY HOME BUILDER)

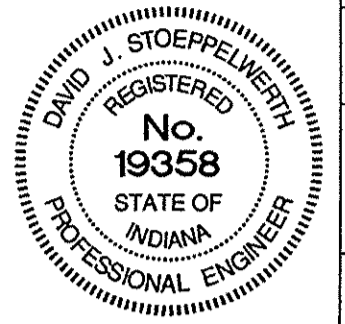

PROPOSED 5' SIDEWALK TO BE INSTALLED BY DEVELOPER

700 LOT NUMBER
897.4 PAD ELEVATION
 PAD SIZE 37'x77' LOTS 56 THRU 111
 PAD SIZE 45'x60' LOTS 1 THRU 55
 (UNLESS OTHERWISE NOTED)

ALL PADS SHOULD BE TESTED TO ASSURE A COMPACTION OF AT LEAST 95 PERCENT OF THE MAXIMUM DRY DENSITY USING THE STANDARD PROCTOR TEST METHOD.

— 648 — PROPOSED 6" UNDERDRAINS
 | 4" S.S.D. LATERALS

NOTE: ALL SSD IN DRY DETENTION BASINS TO BE DOUBLE WALL SMOOTH BORE PERFORATED HDPE PIPE.

SCALE: 1" = 50'

RECORD DRAWING


Jeffery W. Darling
 JEFFERY W. DARLING 9/11/06 DATE
 Registered Land Surveyor
 No. 900017



- GENERAL NOTES:**
- 1.) ALL INVERTED CROWN PRIVATE DRIVES AND ALLEYS TO HAVE A 6" S.S.D. DOWN CENTER OF STREET.
 - 2.) BLUE REFLECTORS SHALL BE INSTALLED IN THE CENTER LINE OF THE PAVEMENT TO MARK FIRE HYDRANTS PER THE TOWN OF WESTFIELD'S UTILITY AND INFRASTRUCTURE CONSTRUCTION STANDARDS.
 - 3.) LOTS 56-111 TO BE SLAB CONSTRUCTED. NO SSD LATERALS REQUIRED.

NOTE: DECORATIVE SIGNS, SPRINKLER SYSTEMS, TREES, LANDSCAPING MOUNDS, LIGHT POLES, OR OTHER SUCH AMENITIES ARE NOT PERMITTED IN THE RIGHT OF WAY.

This information was gathered for input into the Hamilton County Geographic Information System (GIS). This document is considered an official record of the GIS.
 Entry Date: 3-26-08
 Entered By: SLM

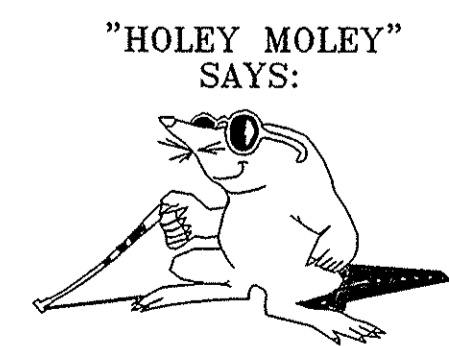

"HOLEY MOLEY" SAYS:
 1-800-382-5544
 CALL TOLL FREE
 1-800-428-5200
 FOR CALLS OUTSIDE OF INDIANA

CAUTION
 LOCATION OF ALL EXISTING UNDERGROUND UTILITIES SHOWN ON THIS PLAN ARE BASED UPON ABOVE GROUND EVIDENCE (including, but not limited to, manholes, inlets, valves, & marks made upon the ground by others) AND ARE SPECULATIVE IN NATURE. THERE MAY ALSO BE OTHER EXISTING UNDERGROUND UTILITIES FOR WHICH THERE IS NO ABOVE GROUND EVIDENCE OR FOR WHICH NO ABOVE GROUND EVIDENCE WAS OBSERVED. THE EXACT LOCATIONS OF SAID EXISTING UNDERGROUND UTILITIES SHOULD BE VERIFIED BY THE CONTRACTOR PRIOR TO ANY AND ALL CONSTRUCTION.

| | | | | |
|-------------------------------|---------|------|---------|-----------|
| AS BUILT | 9/11/06 | DATE | 3/16/05 | REVISIONS |
| REVISED PER DEVELOPER | 8/23/05 | DATE | | |
| ADD TO ALL PADS | 5/21/05 | DATE | | |
| REV. SHEET FOR DEVELOPER | 5/4/05 | DATE | | |
| REVISED PER DEV COMMENTS | 4/13/05 | DATE | | |
| REVISED PER DEVELOPER CHANGES | 3/16/05 | DATE | | |
| BY | | MARK | | |


CERTIFIED: 3/16/05
David J. Stappert
 David J. Stappert
 REGISTERED PROFESSIONAL ENGINEER
 No. 19358
 STATE OF INDIANA

CONSULTING ENGINEERS - LAND SURVEYORS
 (317) 849-5935 1-800-728-6917 FAX: (317) 849-5942
 INDIANAPOLIS INDIANA

SITE DEVELOPMENT PLAN
 MAPLE VILLAGE SECTION ONE
 WESTFIELD INDIANA

SHEET NO.
C201
 JOB NO. 50690PLA-S1

S:\50690PLA-51\dwg\C202-GRD.dwg, Layout, 9/11/2006 4:27:21 PM, bhuff, 1:1

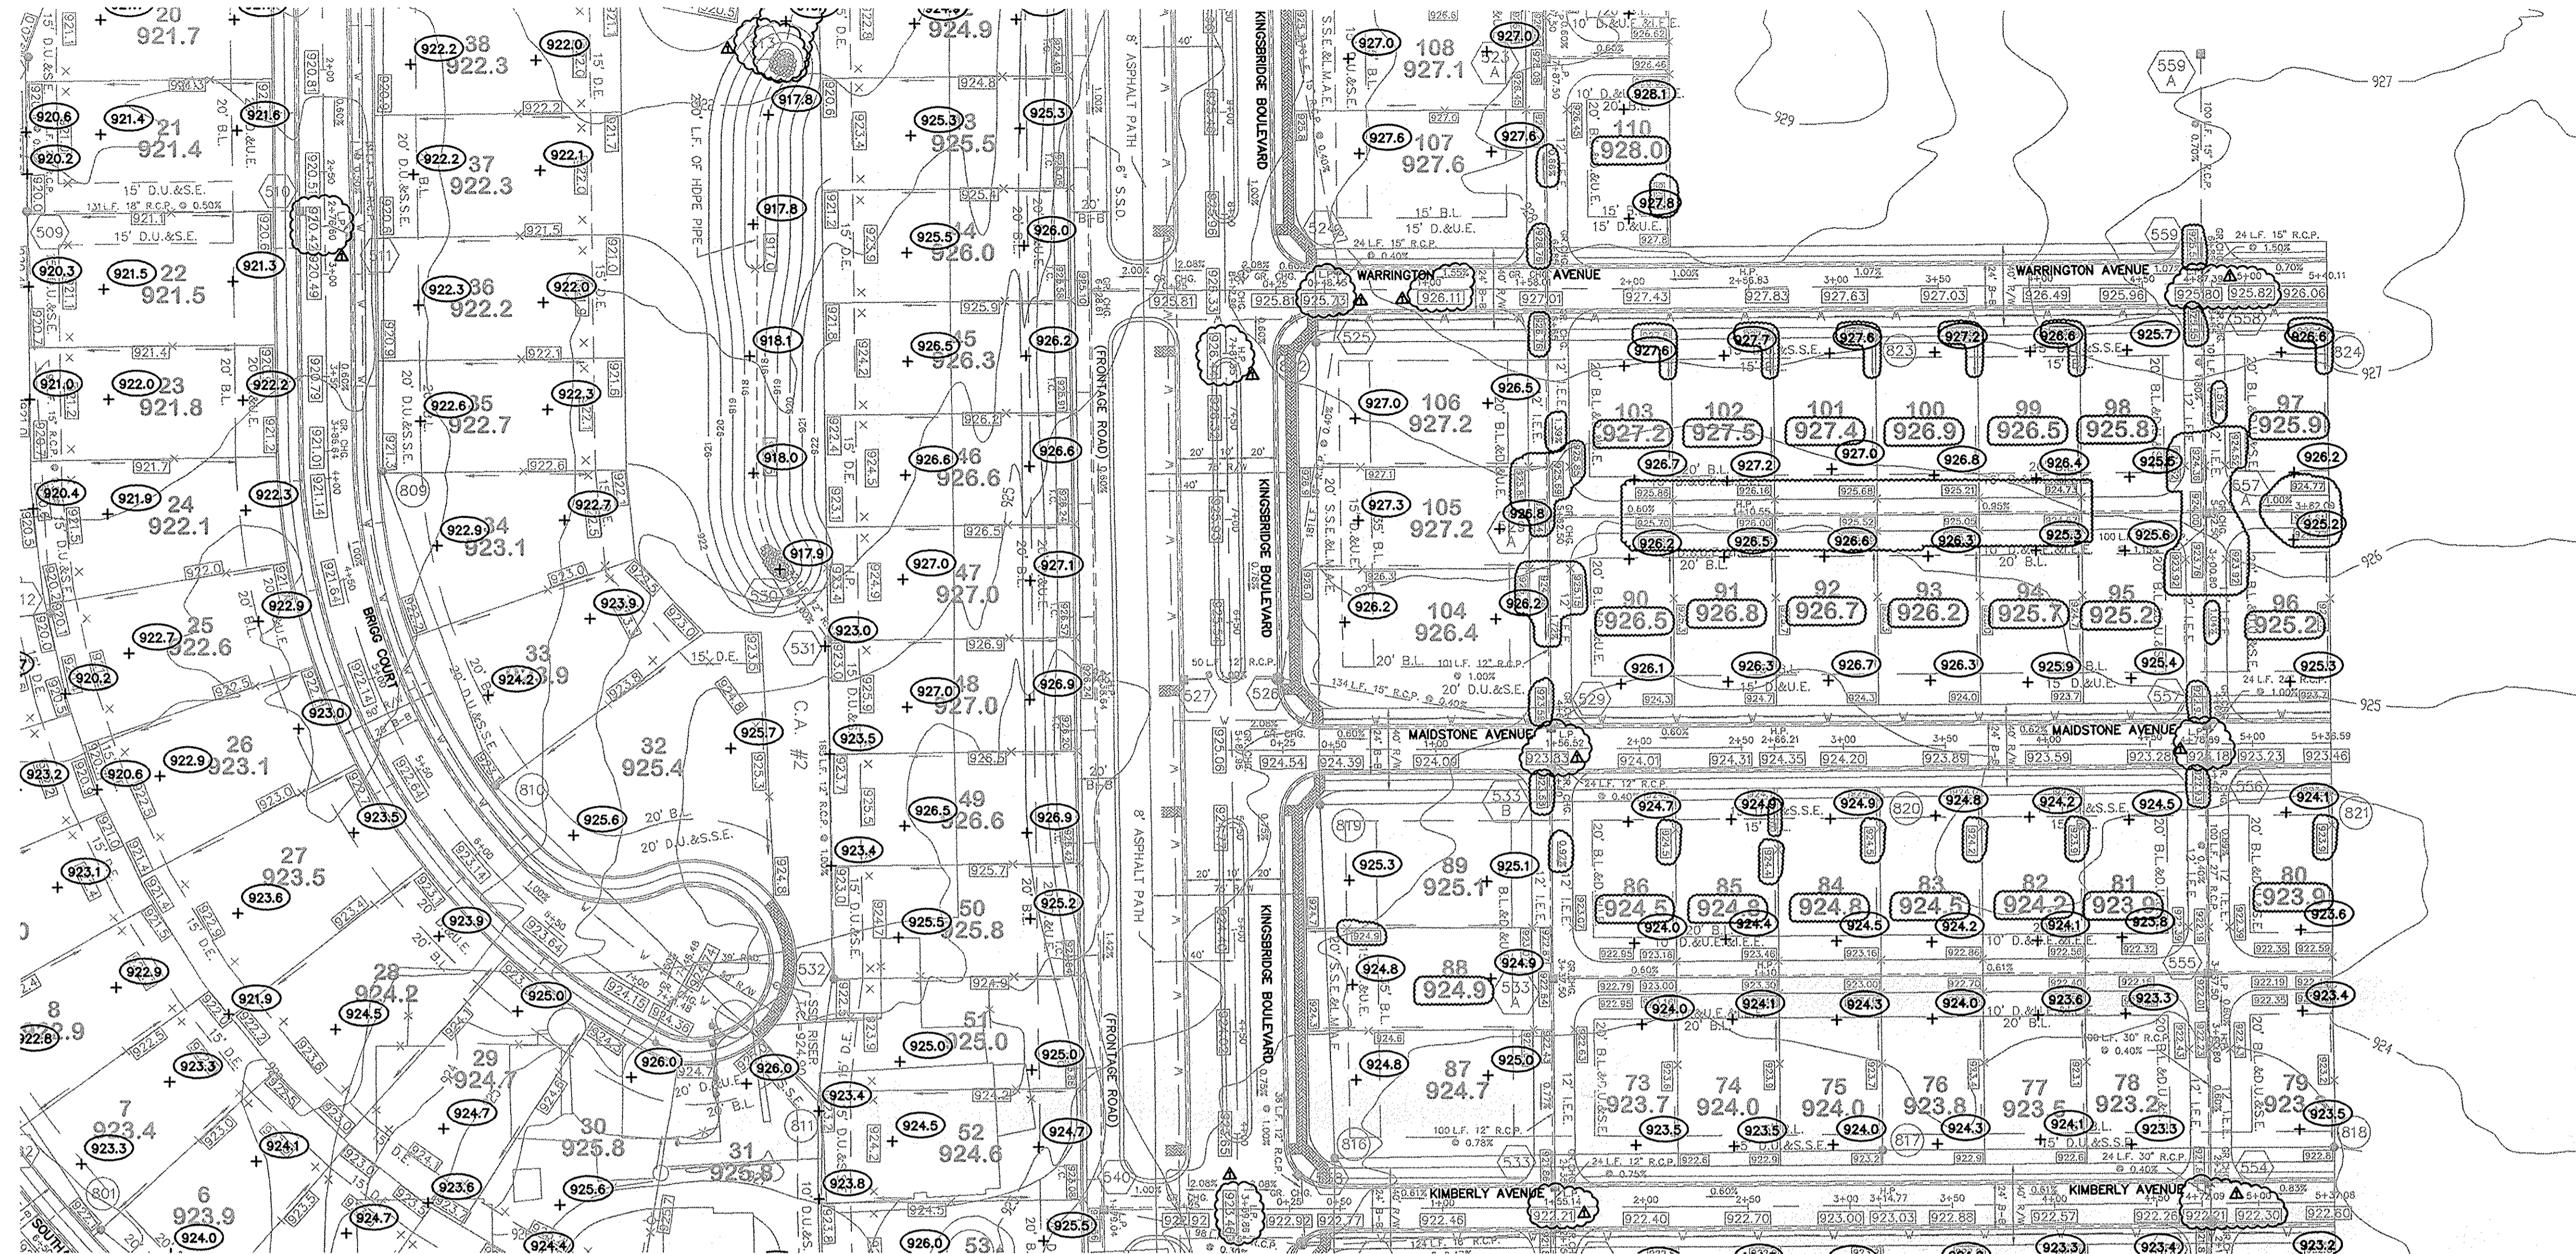

SCALE: 1" = 50'

LEGEND

- Existing Contour
- Existing Sanitary Sewer
- Existing Storm Sewer
- Proposed Grade
- Proposed Contour
- Proposed Sanitary Sewer
- Proposed Storm Sewer
- Proposed Swale
- Proposed 5' Sidewalk (By Home Builder)
- [Hatched Box] Proposed 5' Sidewalk to be Installed by Developer

700
897.4

LOT NUMBER
PAD ELEVATION
PAD SIZE 37'x57' LOTS 56 THRU 111
PAD SIZE 45'x60' LOTS 1 THRU 55
(UNLESS OTHERWISE NOTED)

ALL PADS SHOULD BE TESTED TO ASSURE A COMPACTION OF AT LEAST 95 PERCENT OF THE MAXIMUM DRY DENSITY USING THE STANDARD PROCTOR TEST METHOD.

PROPOSED 6" UNDERDRAINS
4" S.S.D. LATERALS

NOTE: ALL SSD IN DRY DETENTION BASINS TO BE DOUBLE WALL SMOOTH BORE PERFORATED HOPE PIPE.

- GENERAL NOTES:
- ALL INVERTED CROWN PRIVATE DRIVES AND ALLEYS TO HAVE A 6" S.S.D. DOWN CENTER OF STREET.
 - BLUE REFLECTORS SHALL BE INSTALLED IN THE CENTER LINE OF THE PAVEMENT TO MARK FIRE HYDRANTS PER THE TOWN OF WESTFIELD'S UTILITY AND INFRASTRUCTURE CONSTRUCTION STANDARDS.
 - LOTS 56-111 TO BE SLAB CONSTRUCTED. NO SSD LATERALS REQUIRED.

NOTE: DECORATIVE SIGNS, SPRINKLER SYSTEMS, TREES, LANDSCAPING MOUNDS, LIGHT POLES, OR OTHER SUCH AMENITIES ARE NOT PERMITTED IN THE RIGHT OF WAY.

"HOLEY MOLEY" SAYS:

CAUTION
LOCATION OF ALL EXISTING UNDERGROUND UTILITIES SHOWN ON THIS PLAN ARE BASED UPON ABOVE GROUND EVIDENCE, (including, but not limited to, manholes, inlets, valves, & marks made upon the ground by others.) AND ARE SPECULATIVE IN NATURE. THERE MAY ALSO BE OTHER EXISTING UNDERGROUND UTILITIES FOR WHICH THERE IS NO ABOVE GROUND EVIDENCE OR FOR WHICH NO ABOVE GROUND EVIDENCE WAS OBSERVED. THE EXACT LOCATIONS OF SAID EXISTING UNDERGROUND UTILITIES SHOULD BE VERIFIED BY THE CONTRACTOR PRIOR TO ANY AND ALL CONSTRUCTION.

1-800-382-5544
CALL TOLL FREE

1-800-428-5200
FOR CALLS OUTSIDE OF INDIANA

RECORD DRAWING

Jeffery W. Darling
JEFFORY W. DARLING
Registered Land Surveyor
No. 900017

9/11/06
DATE



This information was gathered for input into the Hamilton County Geographic Information System (GIS). This document is considered an official record of the GIS.




Entry Date: 3-22-08
Entered By: SLH

SEE SHEET #C201



| | | | |
|--|----------------------|---------------|---------------------------------|
| CONSULTING ENGINEERS - LAND SURVEYORS (317) 849-5835 1-800-728-6917 FAX: (317) 849-5942 INDIANAPOLIS INDIANA | CERTIFIED: 3/16/05 | DATE: 3/16/05 | REVISIONS BY DATE MARK |
| | DAVID J. STAPPAWORTH | DATE: 3/16/05 | |
| | DAVID J. STAPPAWORTH | DATE: 3/16/05 | |
| | DAVID J. STAPPAWORTH | DATE: 3/16/05 | |

SITE DEVELOPMENT PLAN
MAPLE VILLAGE SECTION ONE
WESTFIELD INDIANA
SHEET NO.
C202
JOB NO 50690PLA-S

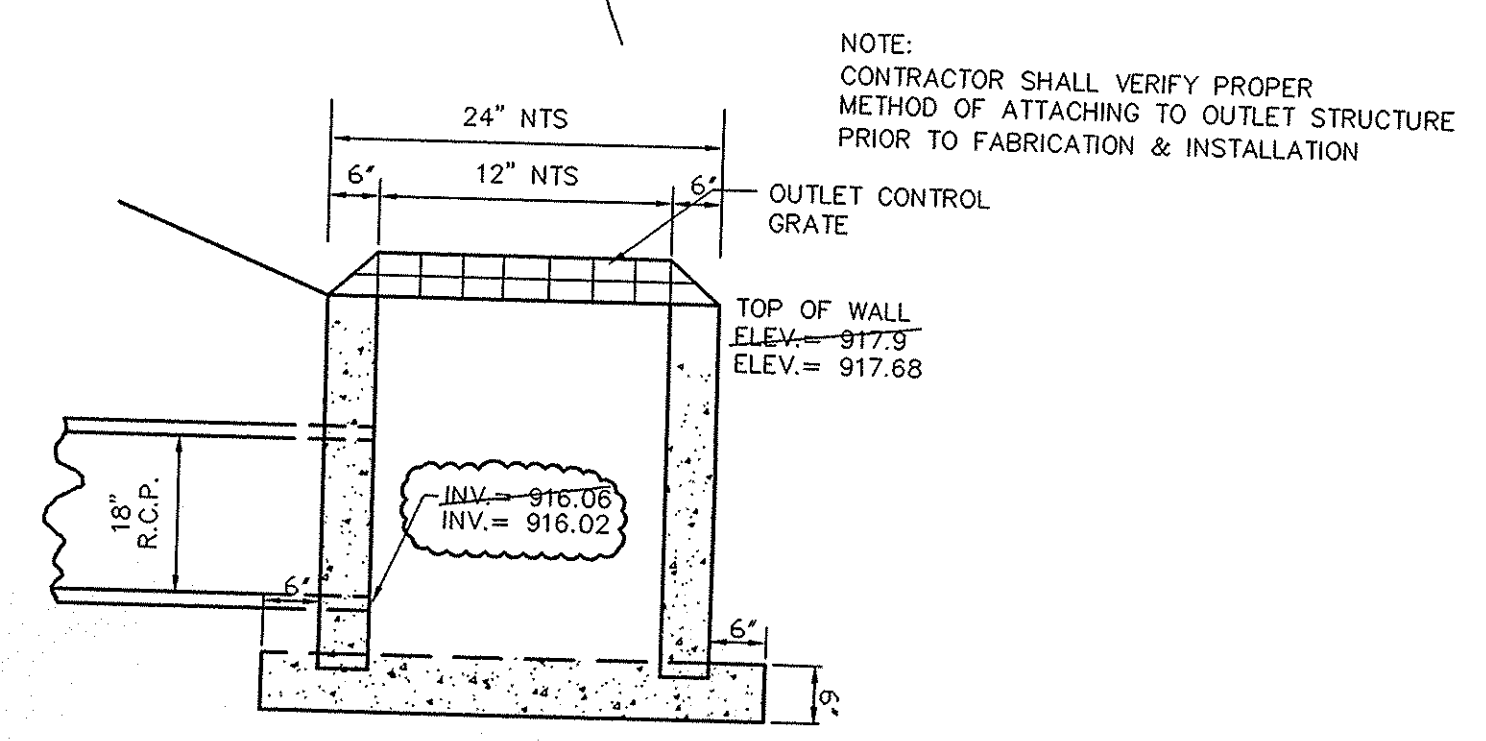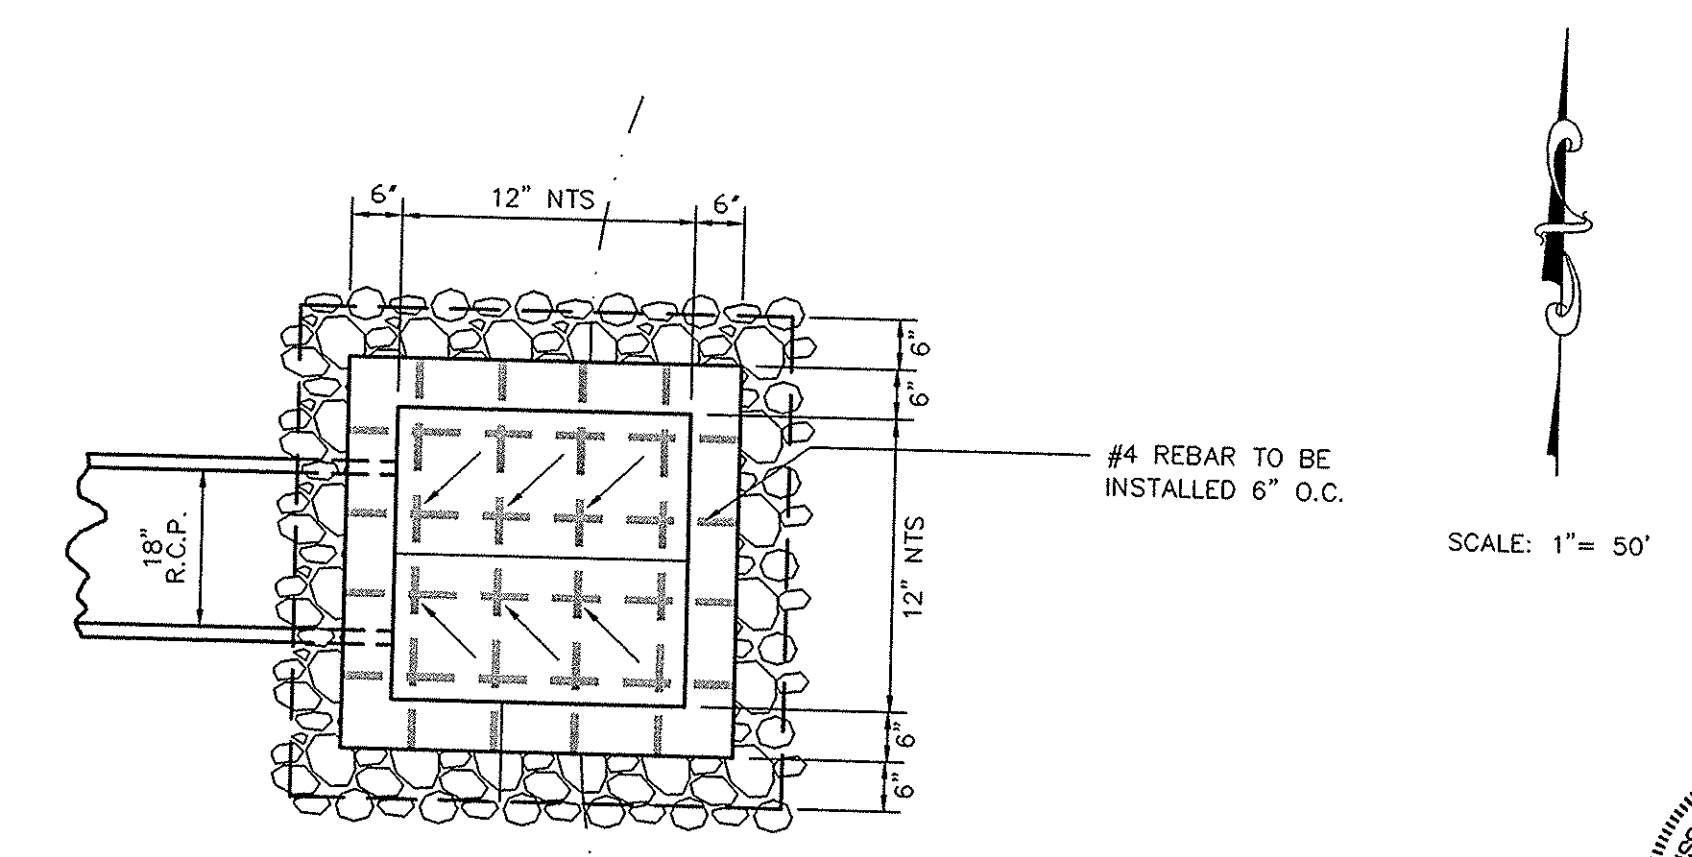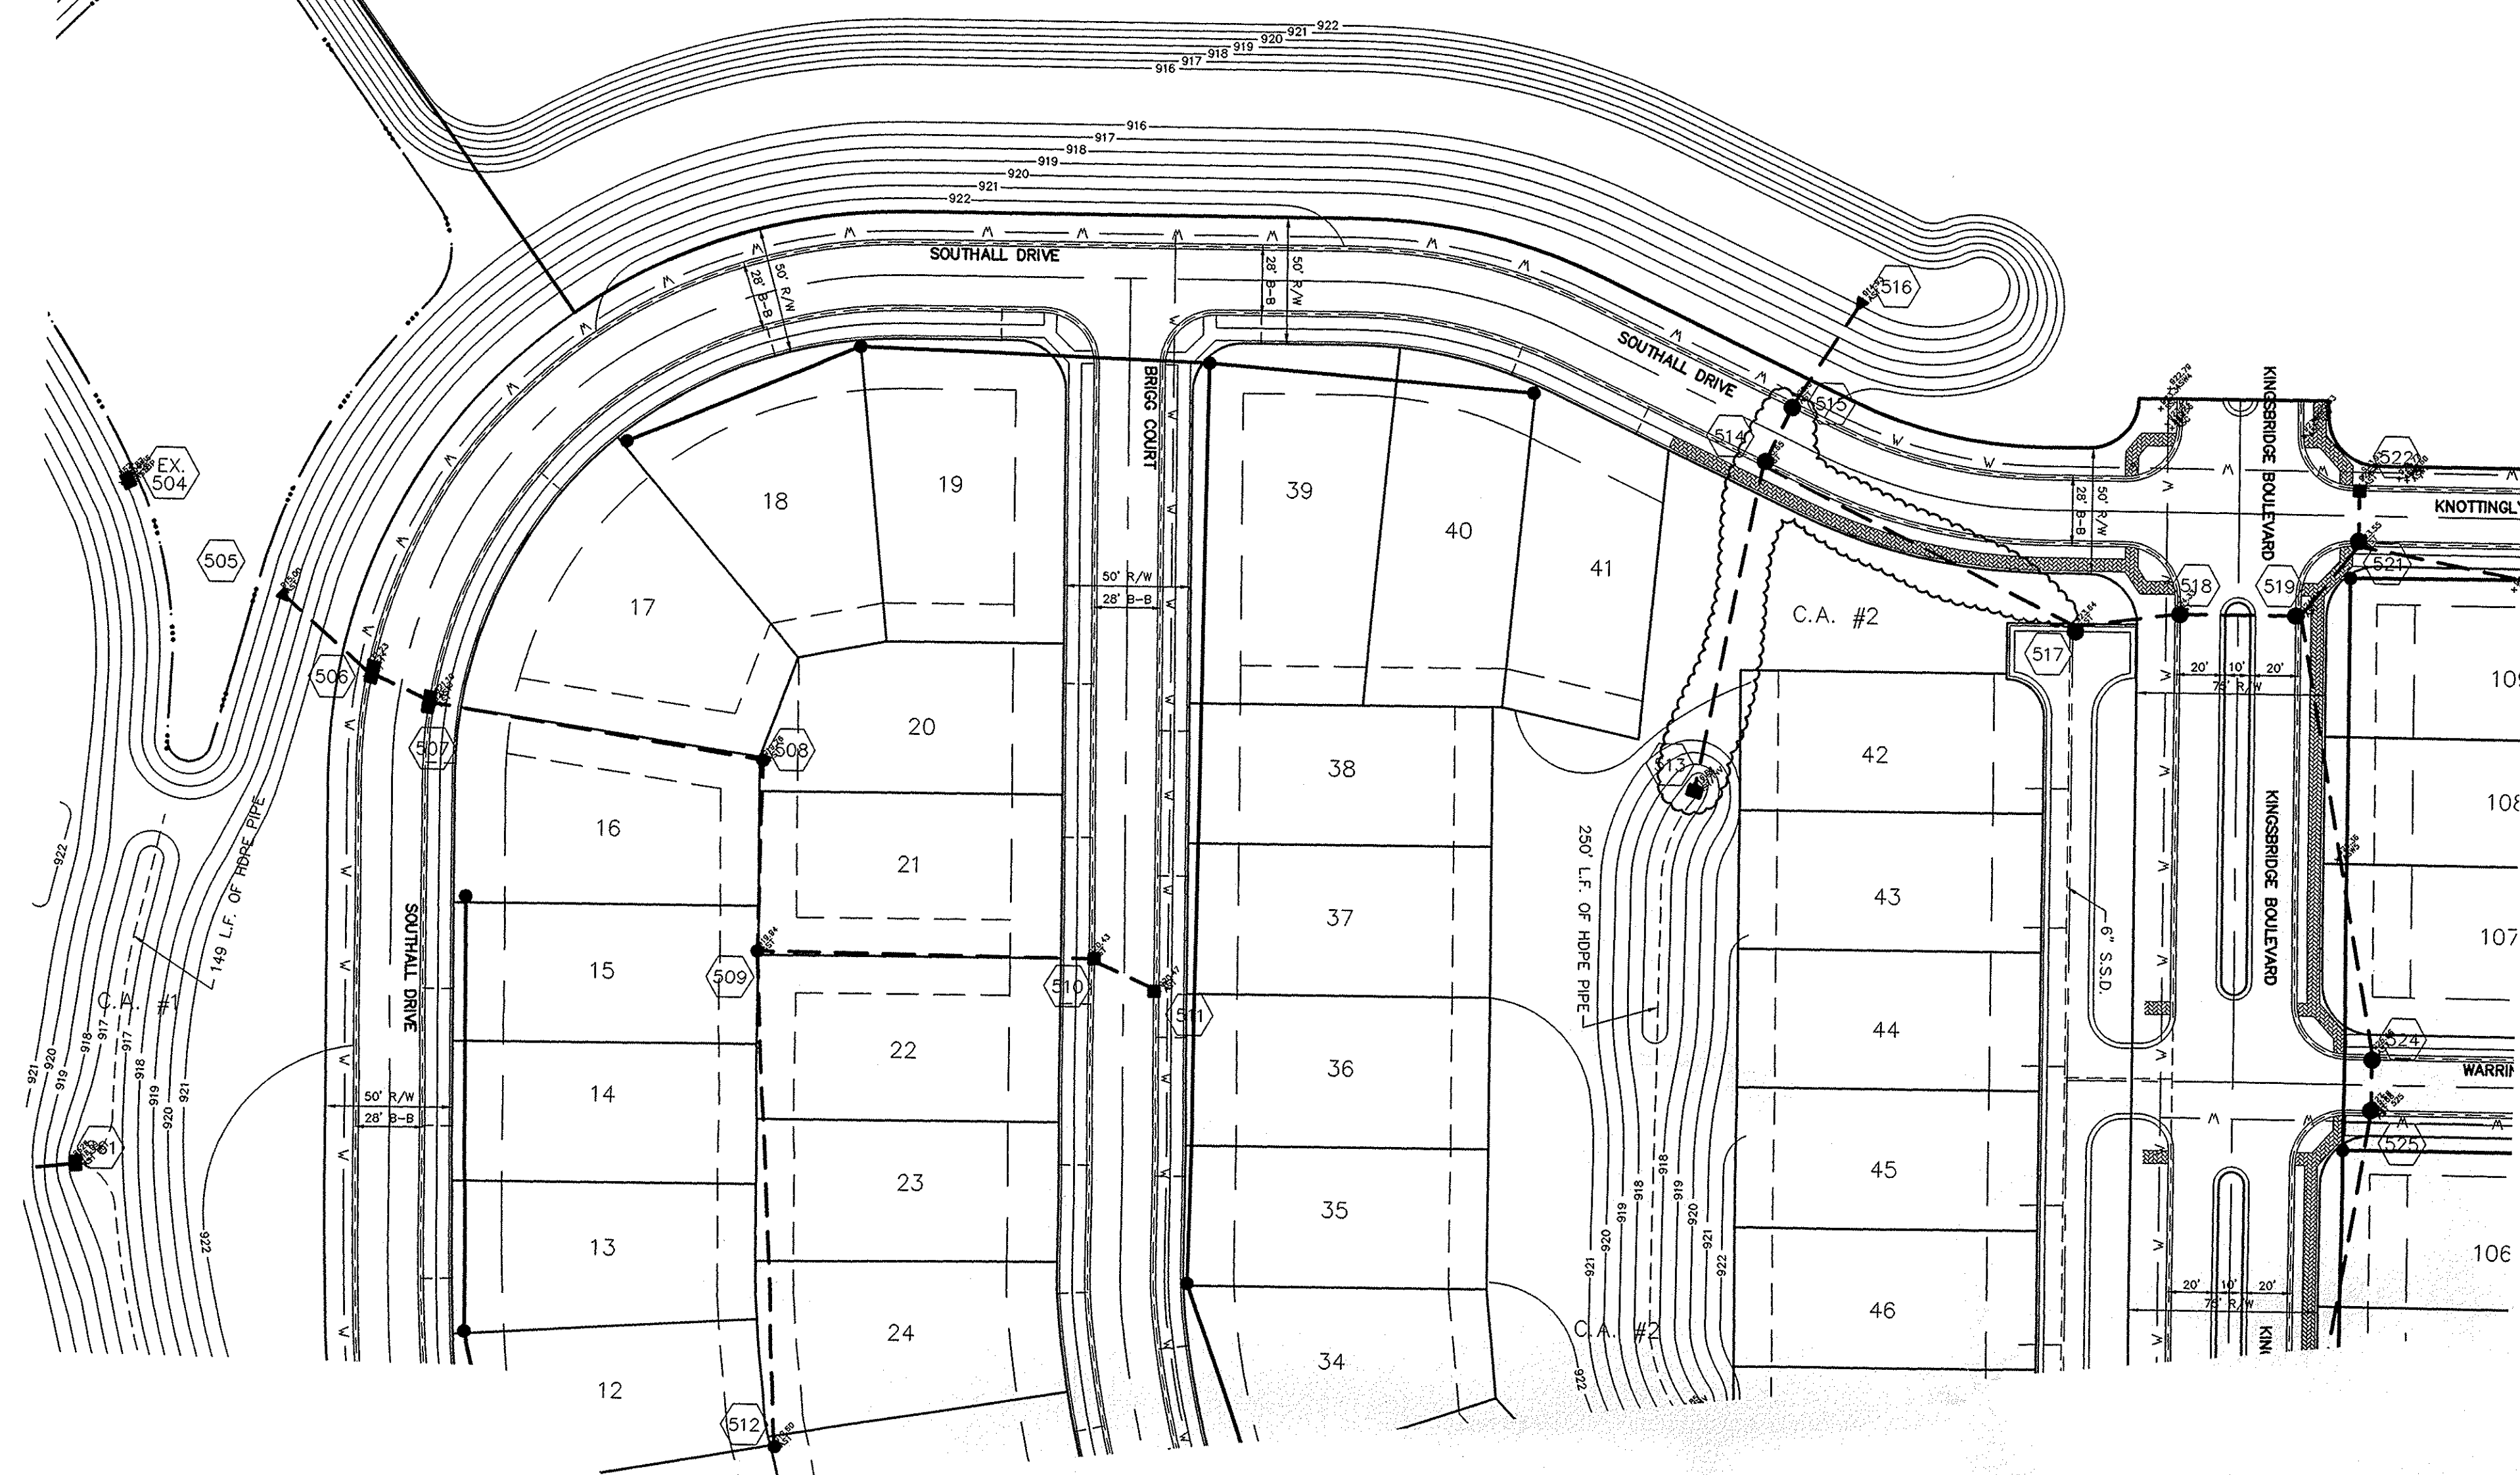

SPECIAL STRUCTURE NO. 513 DETAIL
NOT TO SCALE


| PIPE SIZE | STRUCTURES LESS THAN 48" FROM T/C TO INVERT | STRUCTURES GREATER THAN 48" FROM T/C TO INVERT | ANGLE AND QUALITY OF PIPES WILL REQUIRE SPECIAL DESIGN | STEPS REQUIRED | CURB CASTING *R-3501 N | CASTING *3501 TL & TR |
|---------------|---|--|--|----------------|------------------------|-----------------------|
| 12" to 18" | 24"x24" | | | No | Yes | Yes |
| 12" to 21" | 30"x30" | | | No | Yes | Yes |
| 18" to 21" | | MH/BOX | | Yes | Yes | Yes |
| 21" to 27" | 24"x36" | | | No | No | Yes |
| 12" to 24" | 36"x36" | | | No | Yes | Yes |
| 24" OR LARGER | | | | No | No | Yes |
| 24" or LARGER | | MH/BOX | | Yes** | Yes | Yes |

* PIPES NO LARGER THAN 18" CAN BE USED IN THE 2' SIDE OF THIS BOX
** INCHING AND OUT GOING PIPES EFFECT STEPS IN THIS STRUCTURE

SPECIAL NOTE: STRUCTURES DEEPER THAN 48" FROM T/C TO INVERT WILL BE A MIN. OF A BOX WITH STEPS UNLESS SPECIAL DESIGN IS APPROVED.

SPECIAL NOTE: STRUCTURES WILL BE DESIGNED FOR MAXIMUM FLOW IN PIPES

SPECIAL NOTE: COUNTY MAY REQUIRE STEPS TO BE INSTALLED AFTER STRUCTURE IS SET TO IMPROVE ACCESS.

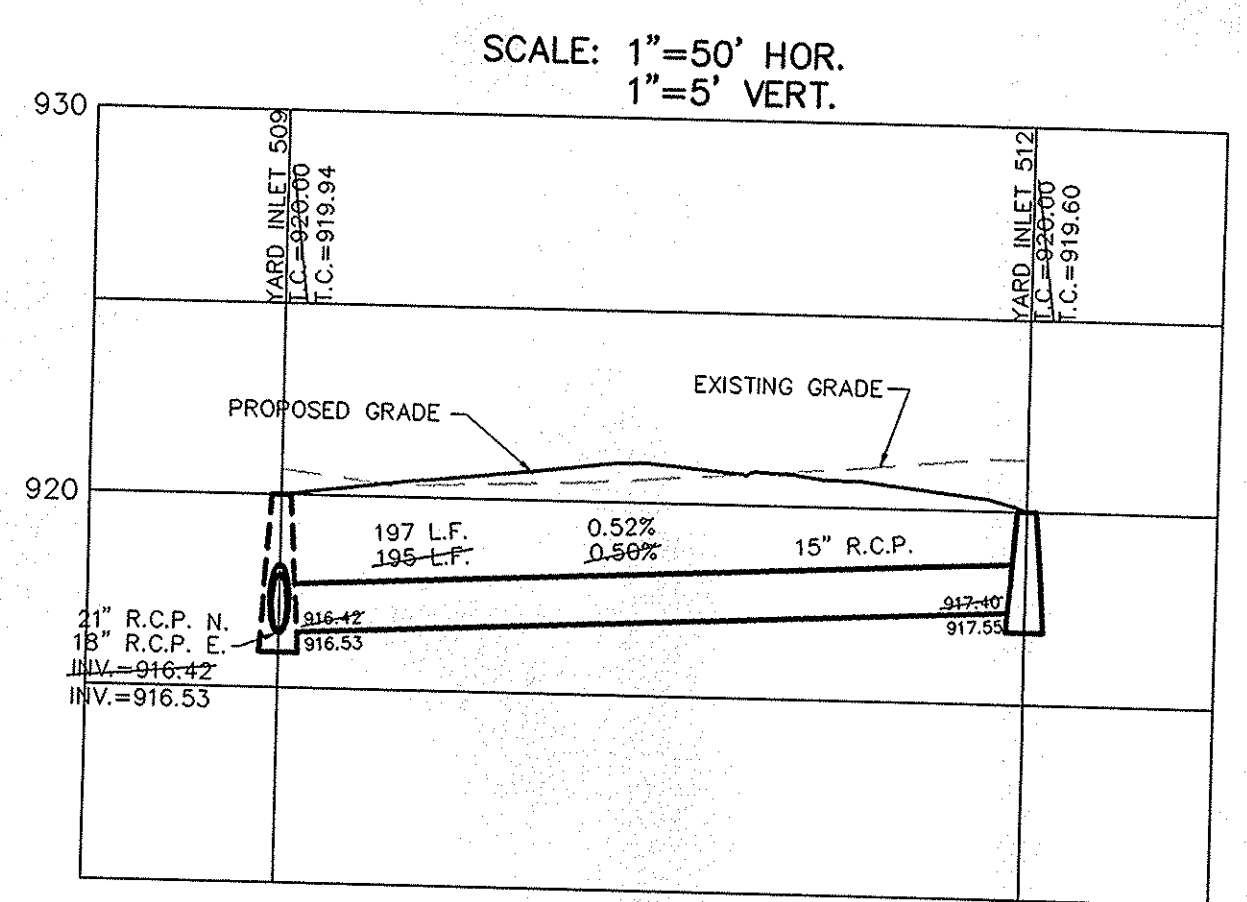




NOTE: ALL STORM STRUCTURES TO RECEIVE SOLID LID CASTINGS ARE TO BE CONSTRUCTED TO PROVIDE 1"-4" RISER RING TO ACHIEVE PLAN RIM GRADE.

ALL YARD INLETS ARE TO BE CONSTRUCTED AT A TOLERANCE OF +0.00' TO 0.20' OF PLAN GRADE.

ALL STORM SEWER CASTINGS SHALL BE LABELED "DUMP NO WASTE-DRAINS TO WATERWAY"

This information was gathered for input into the Hamilton County Geographic Information System (GIS). This document is considered an official record of the GIS.



Entry Date: 3-26-08
Entered by: SLM

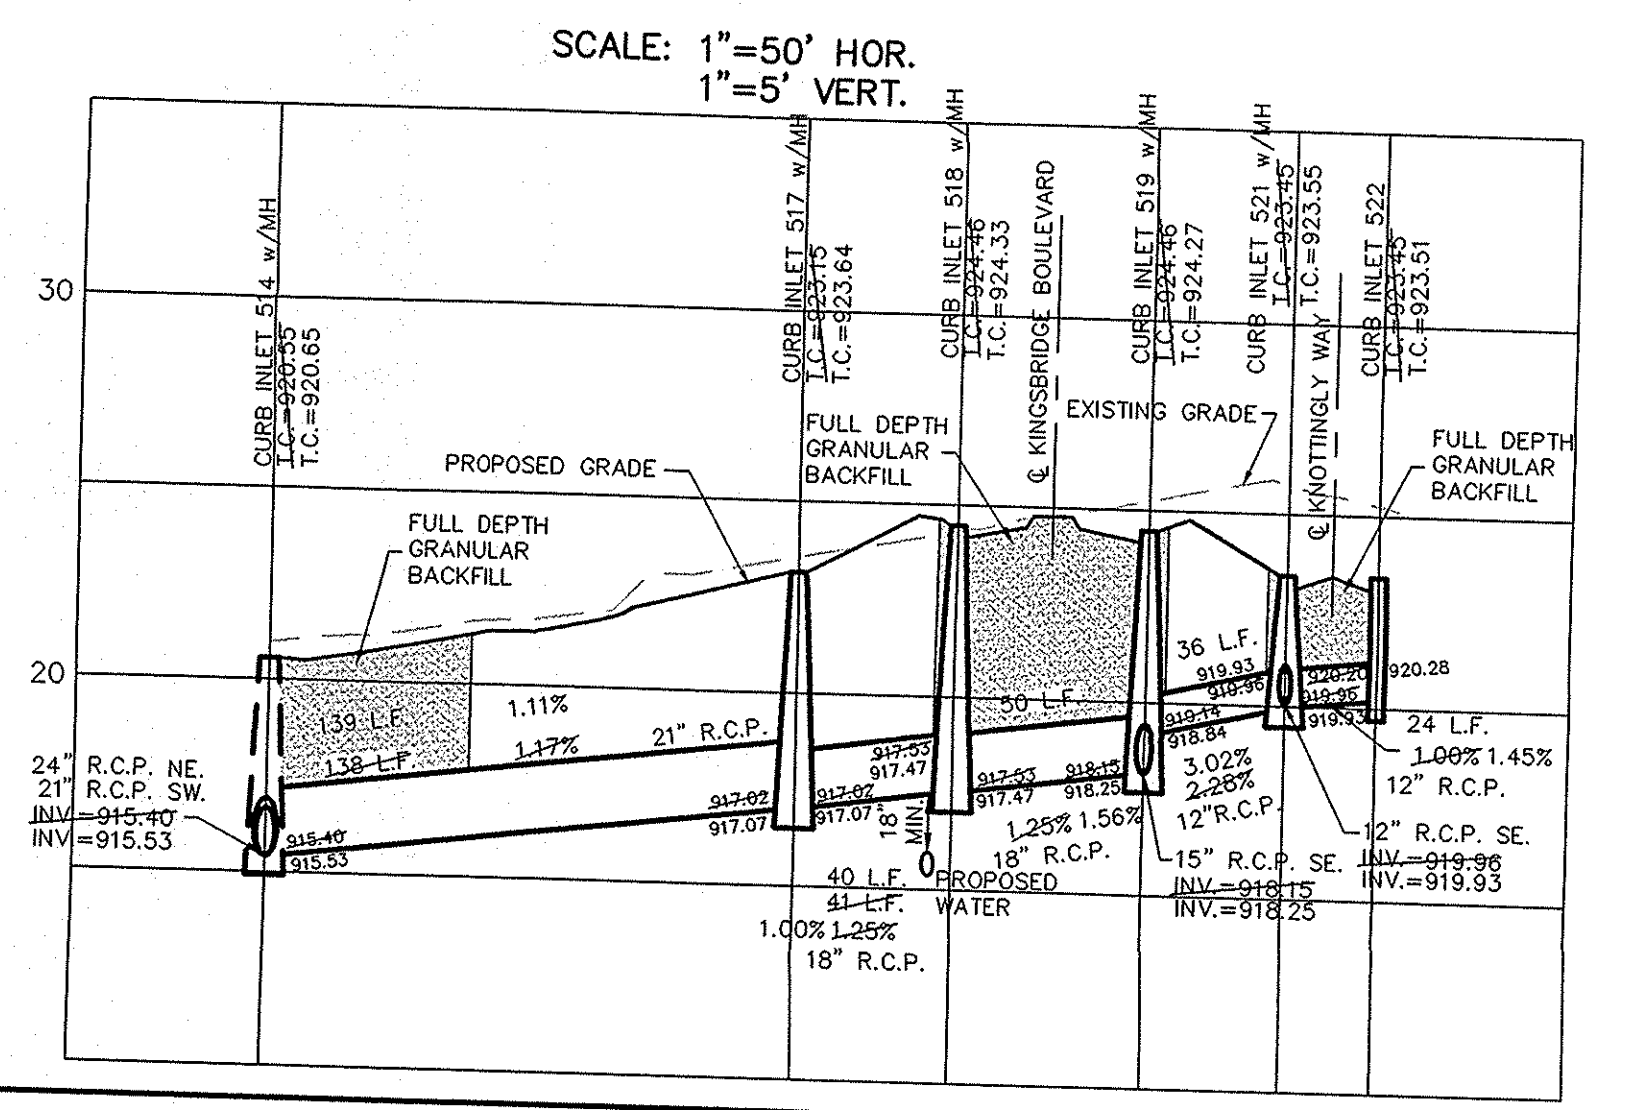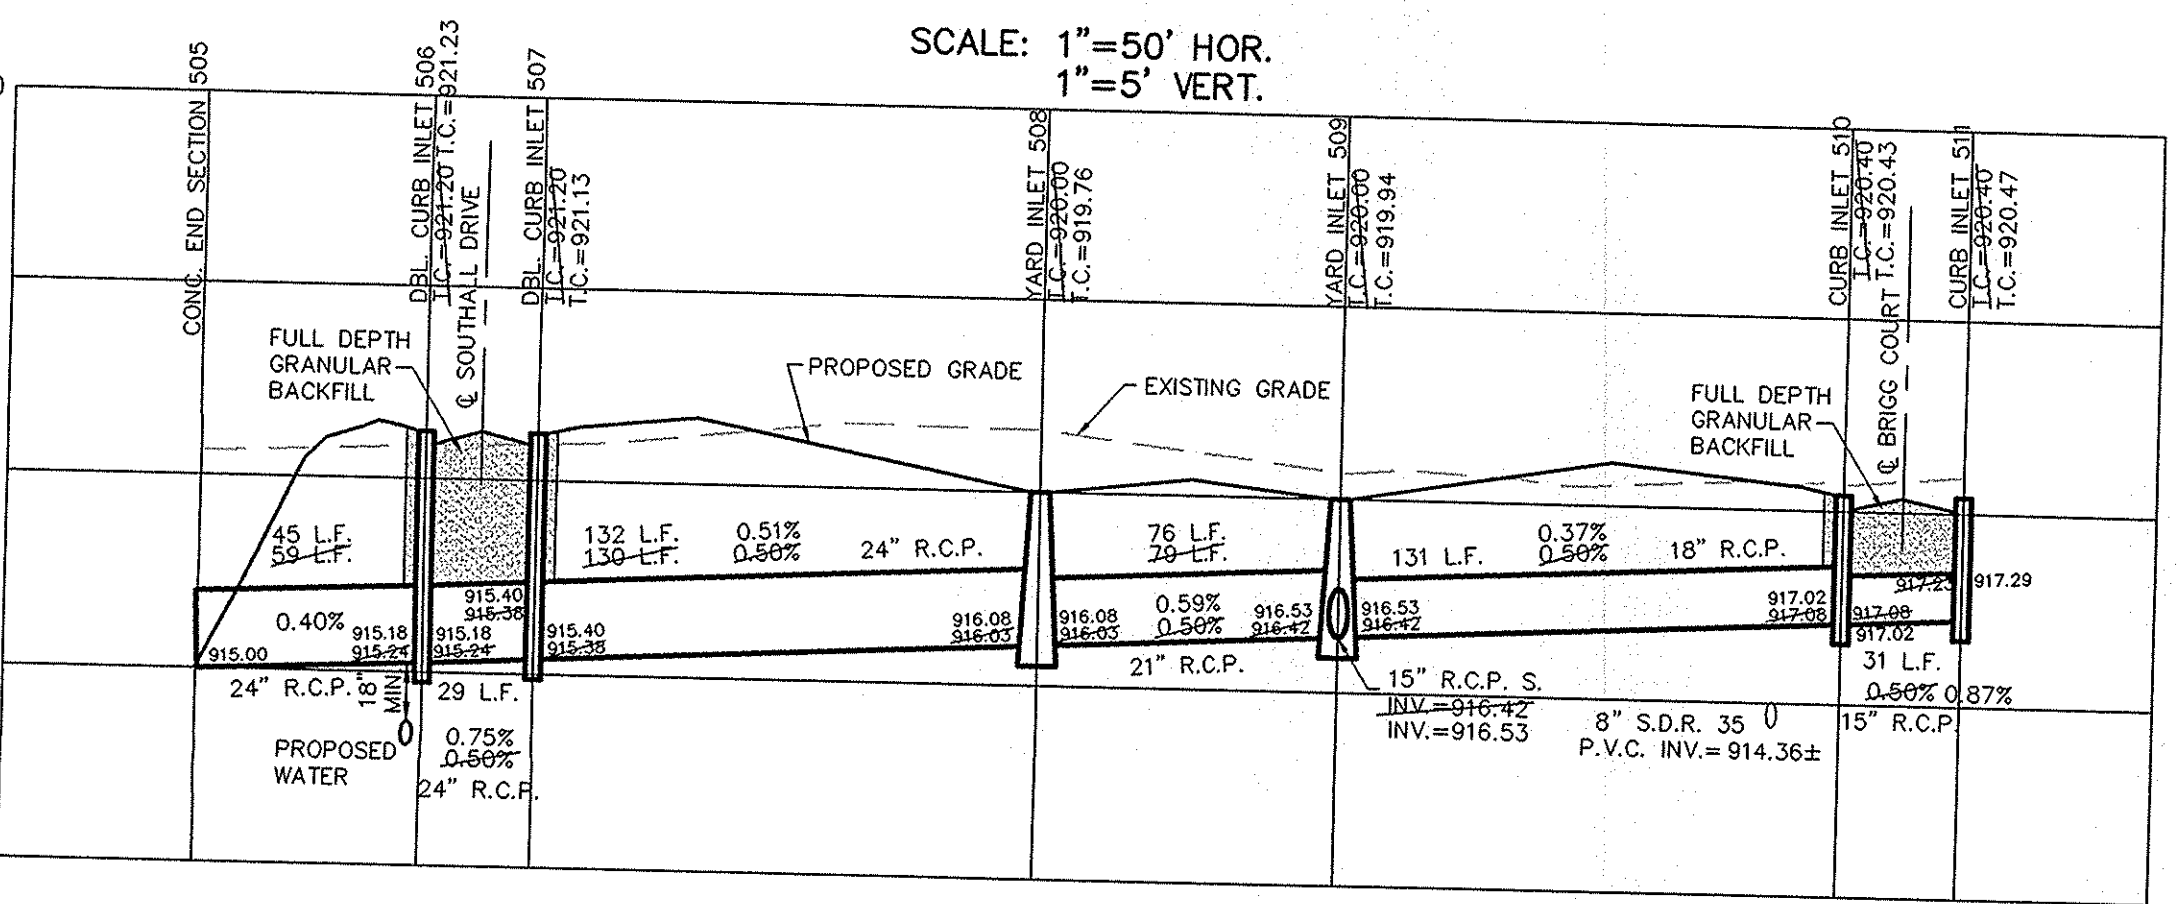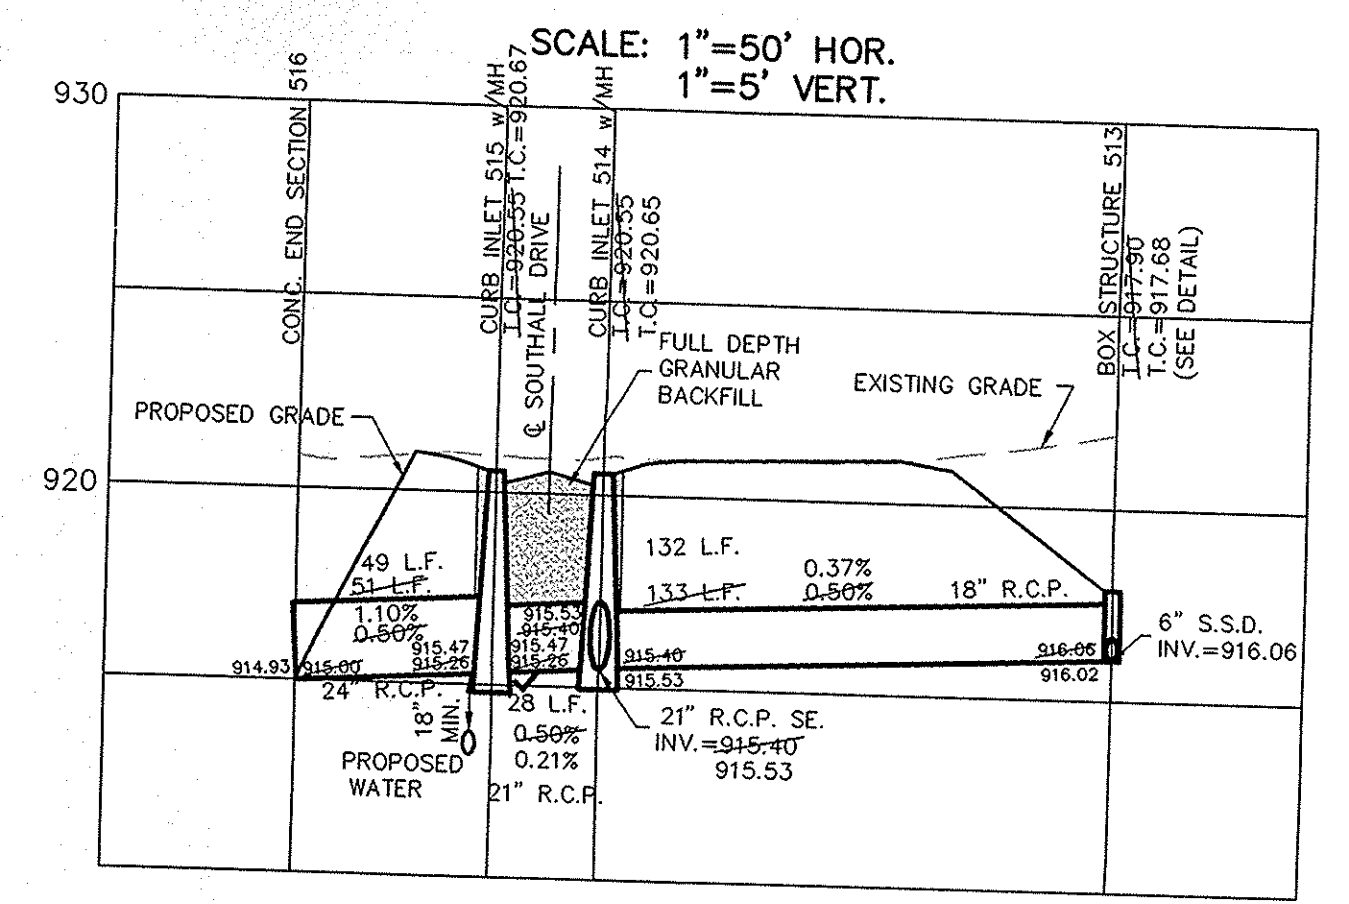

RECORD DRAWING

JEFFERY W. DARLING
Registered Land Surveyor
No. 900017

7/17/06
DATE

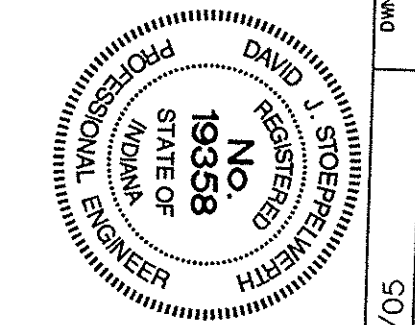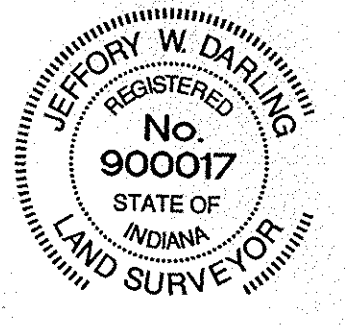

CONSULTING ENGINEERS - LAND SURVEYORS
(317) 849-5935 1-800-728-6917 FAX: (317) 849-5942
FISHERS INDIANA

STORM PLAN & PROFILES
MAPLE VILLAGE SECTION ONE
WESTFIELD INDIANA


SHEET NO.
C600
JOB NO. 50690PLA-S1

| OWN BY | DATE | REVISIONS |
|--------|---------|-----------|
| BAH | 3/16/05 | |
| CC BY | | |
| EFF | | |
| SCALE | 1"=50' | |
| DATE | 3/16/05 | |
| MARK | | |
| BY | | |





RECORD DRAWING

JEFFERY W. DARLING
 Registered Land Surveyor
 No. 900017

7/17/06
 DATE








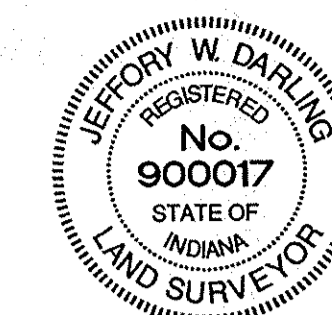


NOTE: ALL STORM STRUCTURES TO RECEIVE SOLID LID CASTINGS ARE TO BE CONSTRUCTED TO PROVIDE 1'-4" RISER RING TO ACHIEVE PLAN RIM GRADE.
 ALL YARD INLETS ARE TO BE CONSTRUCTED AT A TOLERANCE OF +0.00' TO 0.20' OF PLAN GRADE.
 ALL STORM SEWER CASTINGS SHALL BE LABELED "DUMP NO WASTE-DRAINS TO WATERWAY"

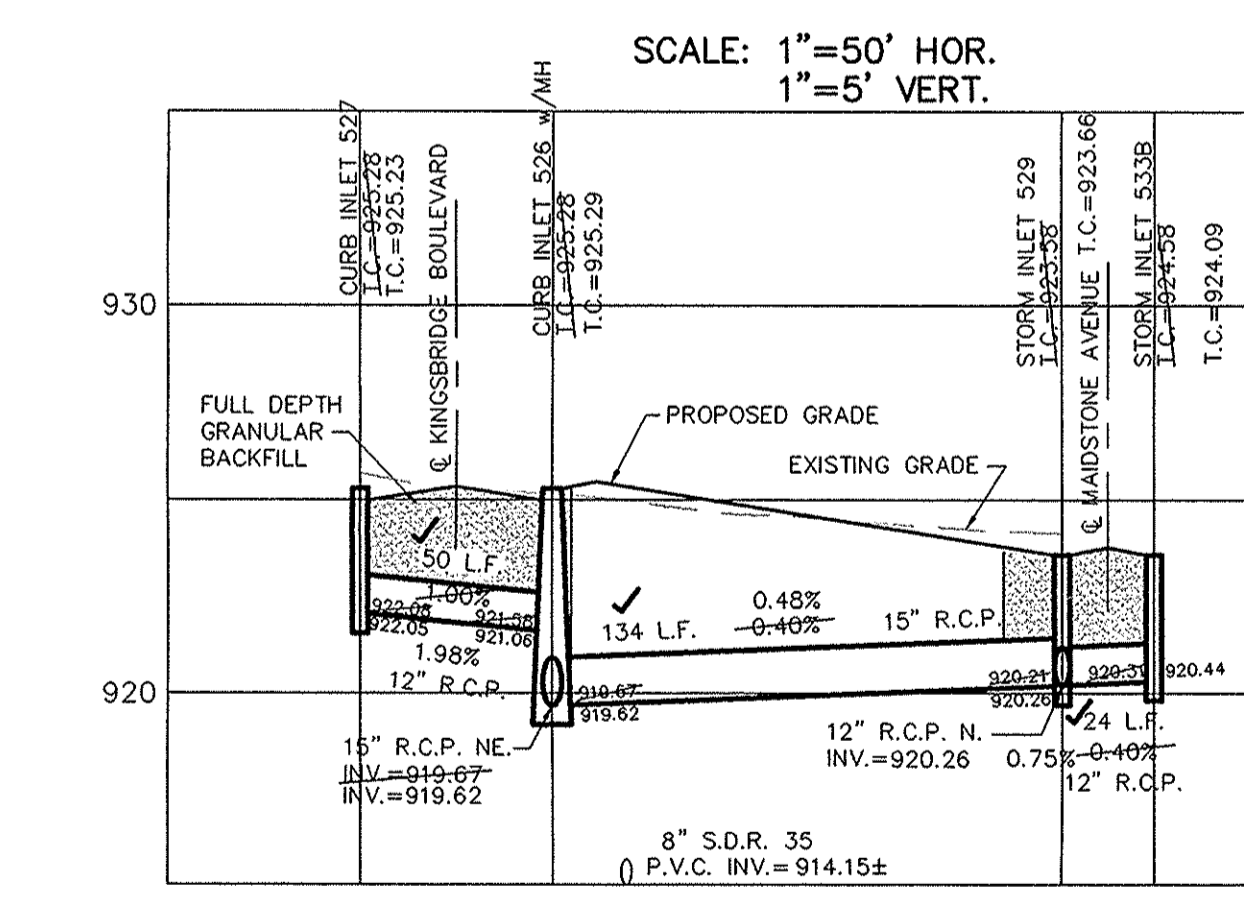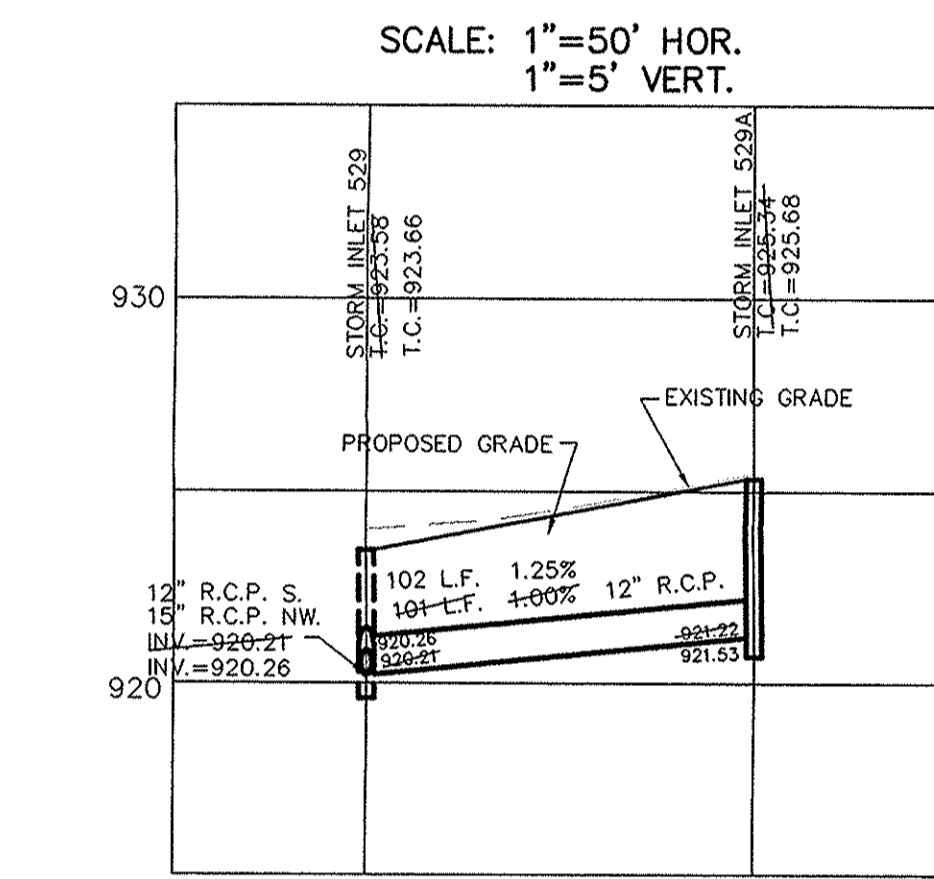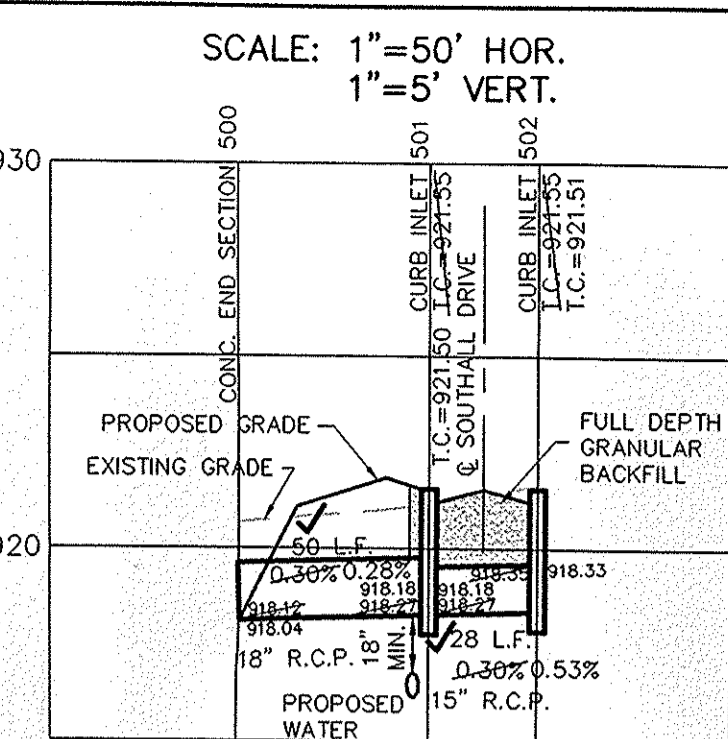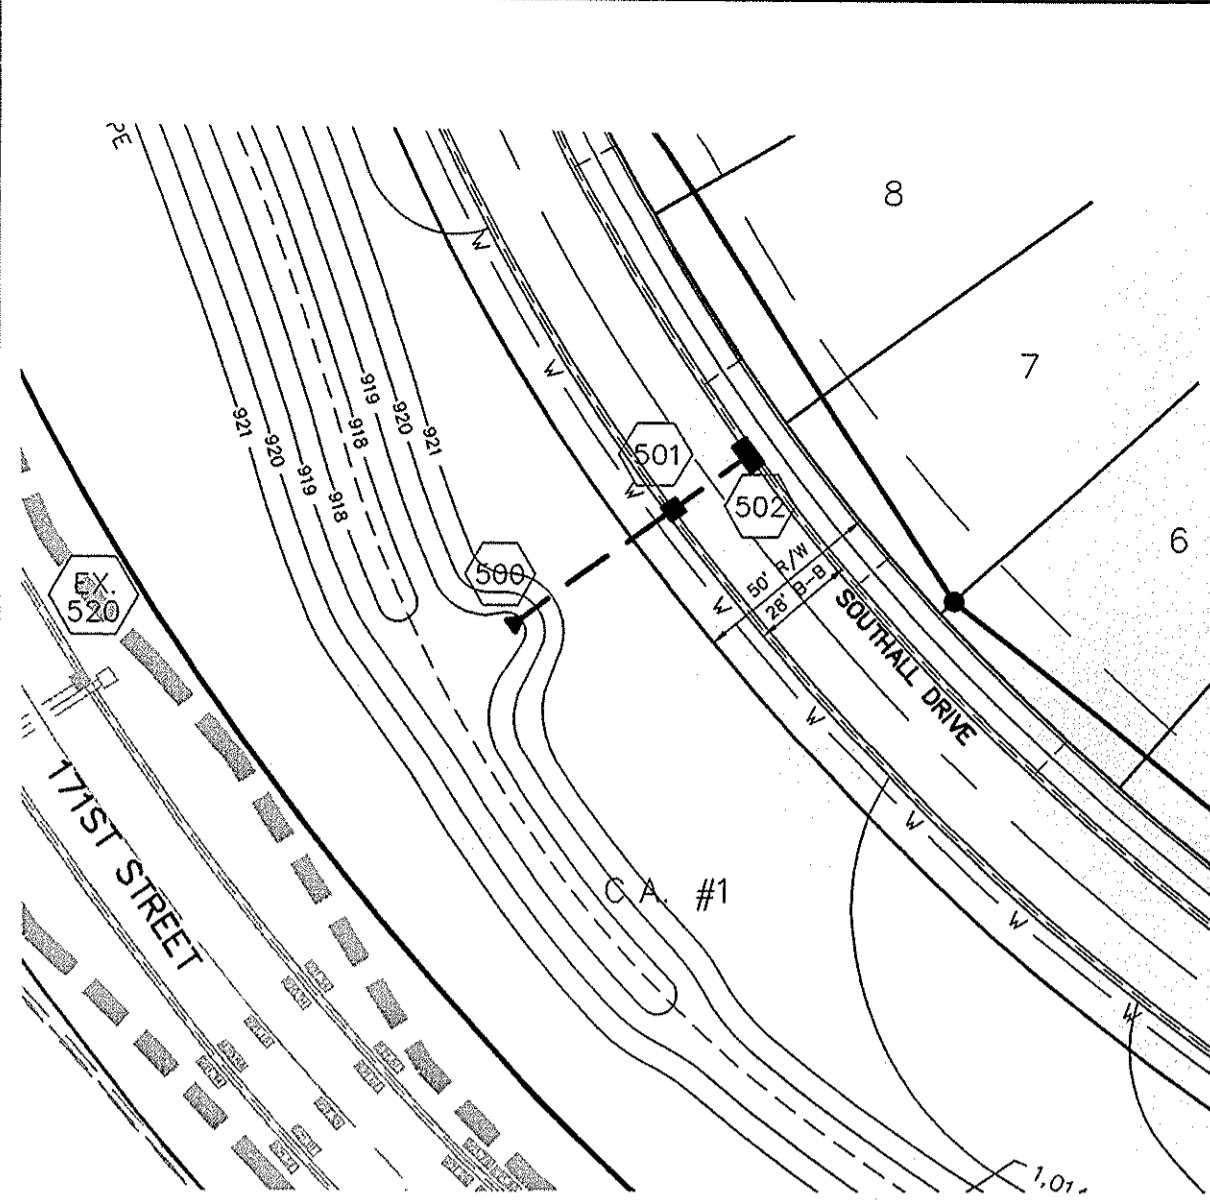

| PIPE SIZE | STRUCTURES LESS THAN 48" FROM T/C TO INVERT | STRUCTURES GREATER THAN 48" FROM T/C TO INVERT | ANGLE AND QUALITY OF PIPES WILL REQUIRE SPECIAL DESIGN | STEPS REQUIRED | CURB CASTING *R-3501 N | CASTING *3501 TL & TR |
|---------------|---|--|--|----------------|------------------------|-----------------------|
| 12" to 18" | 24"x24" | | DESIGN APPROVAL | No | Yes | Yes |
| 12" to 21" | 30"x30" | | DESIGN APPROVAL | No | Yes | Yes |
| 18" to 21" | | MH/BOX | DESIGN APPROVAL | Yes | Yes | Yes |
| 21" to 27" | 24"x36" | | DESIGN APPROVAL | No | Yes | Yes |
| 12" to 24" | 36"x36" | | DESIGN APPROVAL | No | Yes | Yes |
| 24" OR LARGER | DESIGN APPROVAL | | DESIGN APPROVAL | No | No | Yes |
| 24" OR LARGER | | MH/BOX | DESIGN APPROVAL | Yes** | Yes | Yes |

* PIPES NO LARGER THAN 18" CAN BE USED IN THE T/SIDE OF THIS BOX
 ** INCOMING AND OUT GOING PIPES EFFECT STEPS IN THIS STRUCTURE
 SPECIAL NOTE: STRUCTURES DEEPER THAN 48" FROM T/C TO INVERT WILL BE A M.H. OR A BOX WITH STEPS UNLESS SPECIAL DESIGN IS APPROVED.
 SPECIAL NOTE: STRUCTURES WILL BE DESIGNED FOR MAXIMUM FLOW IN PIPES
 SPECIAL NOTE: COUNTY MAY REQUIRE STEPS TO BE INSTALLED AFTER STRUCTURE IS SET TO IMPROVE ACCESS.

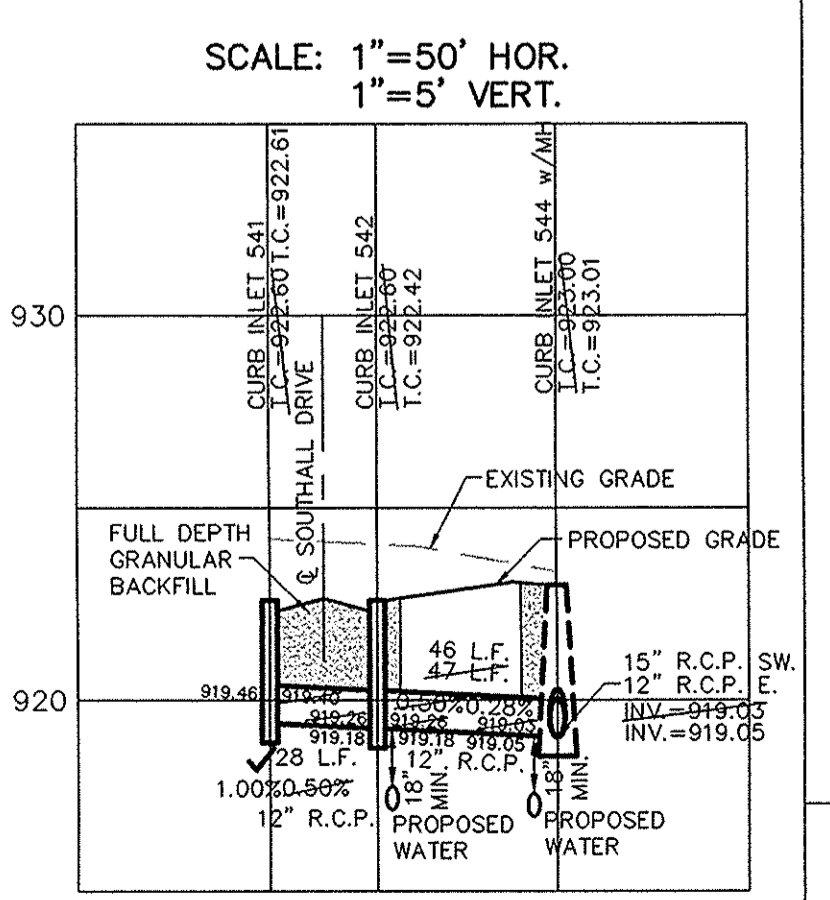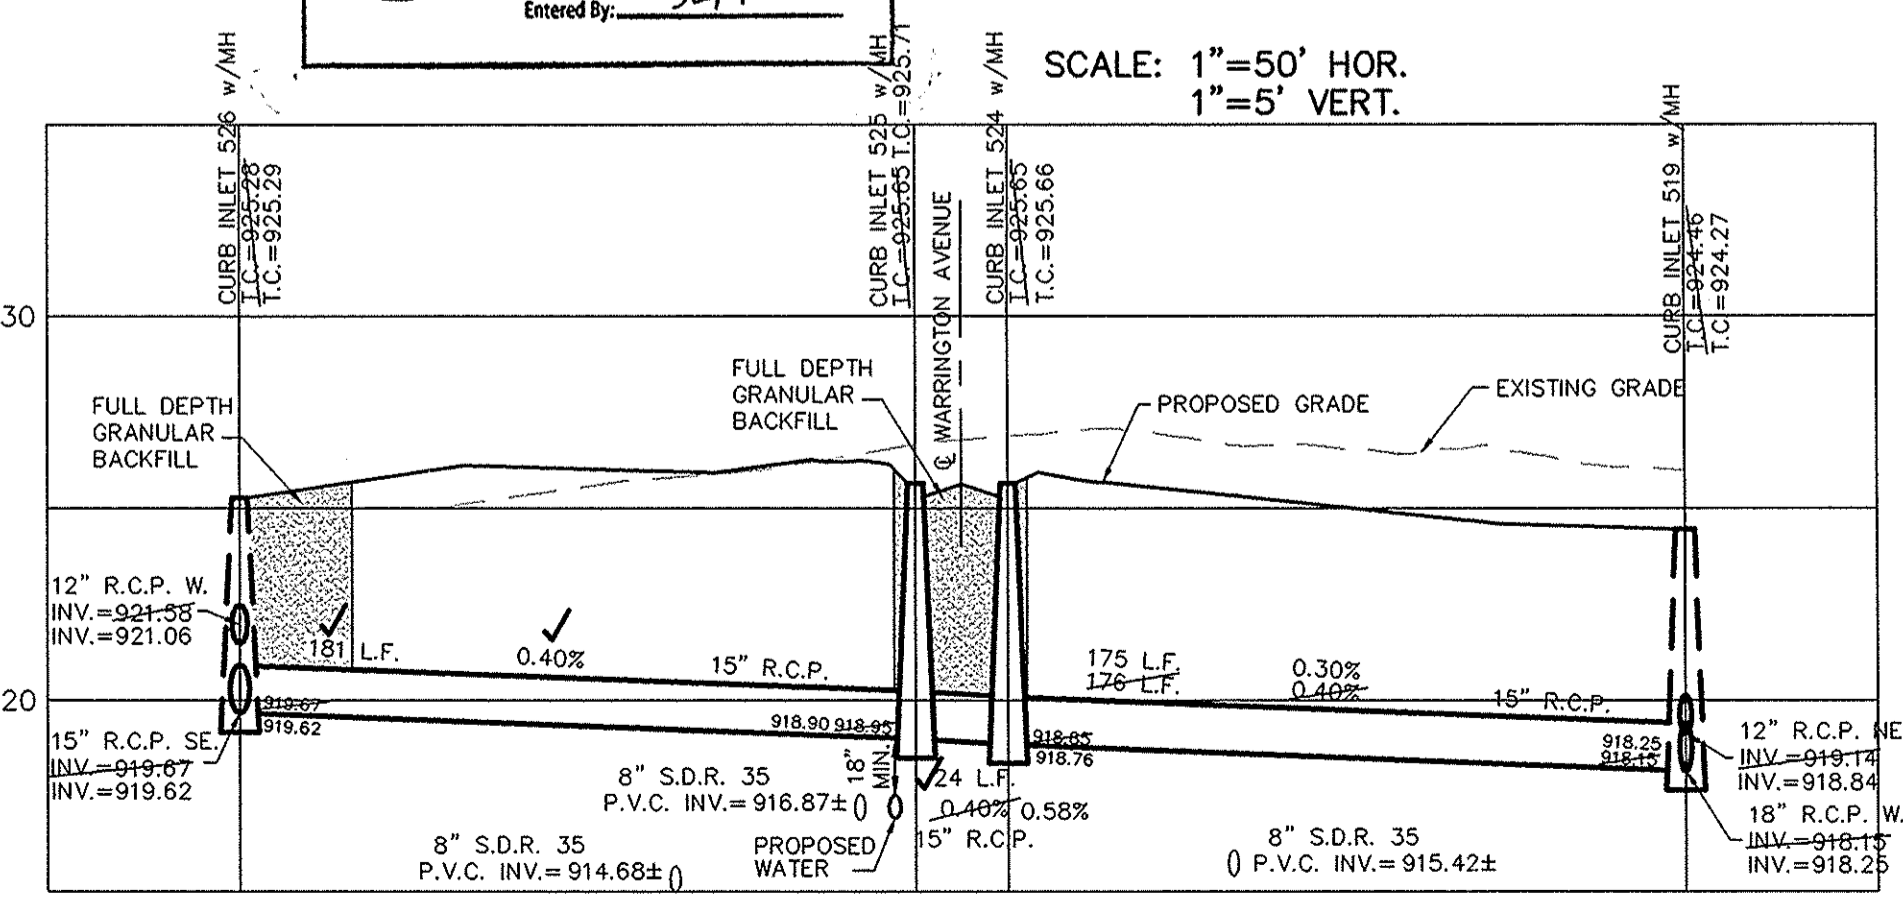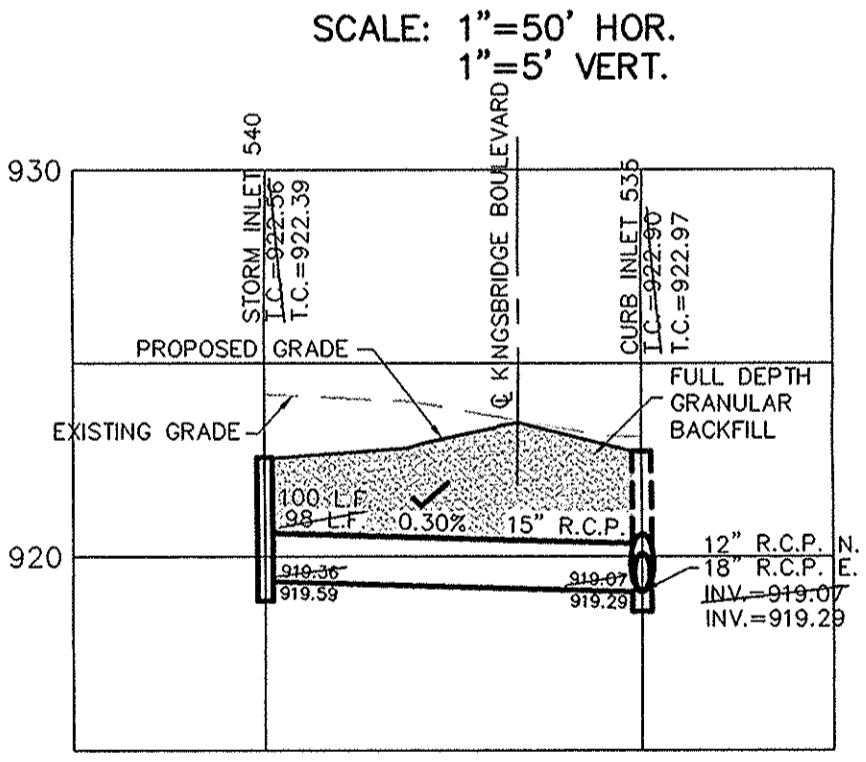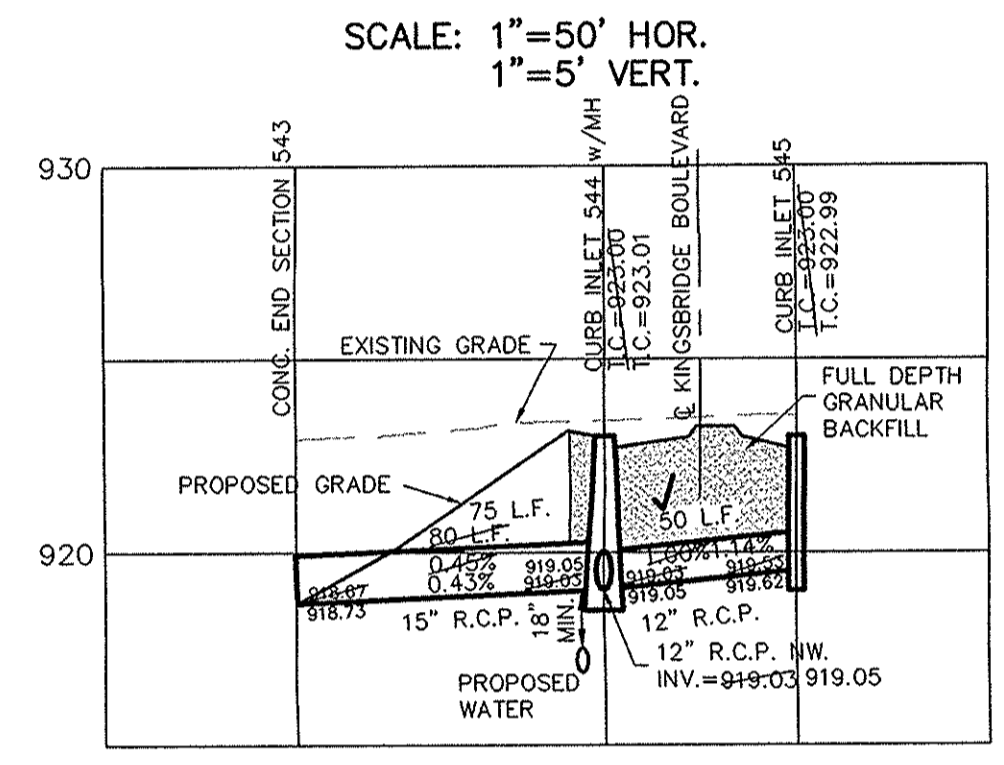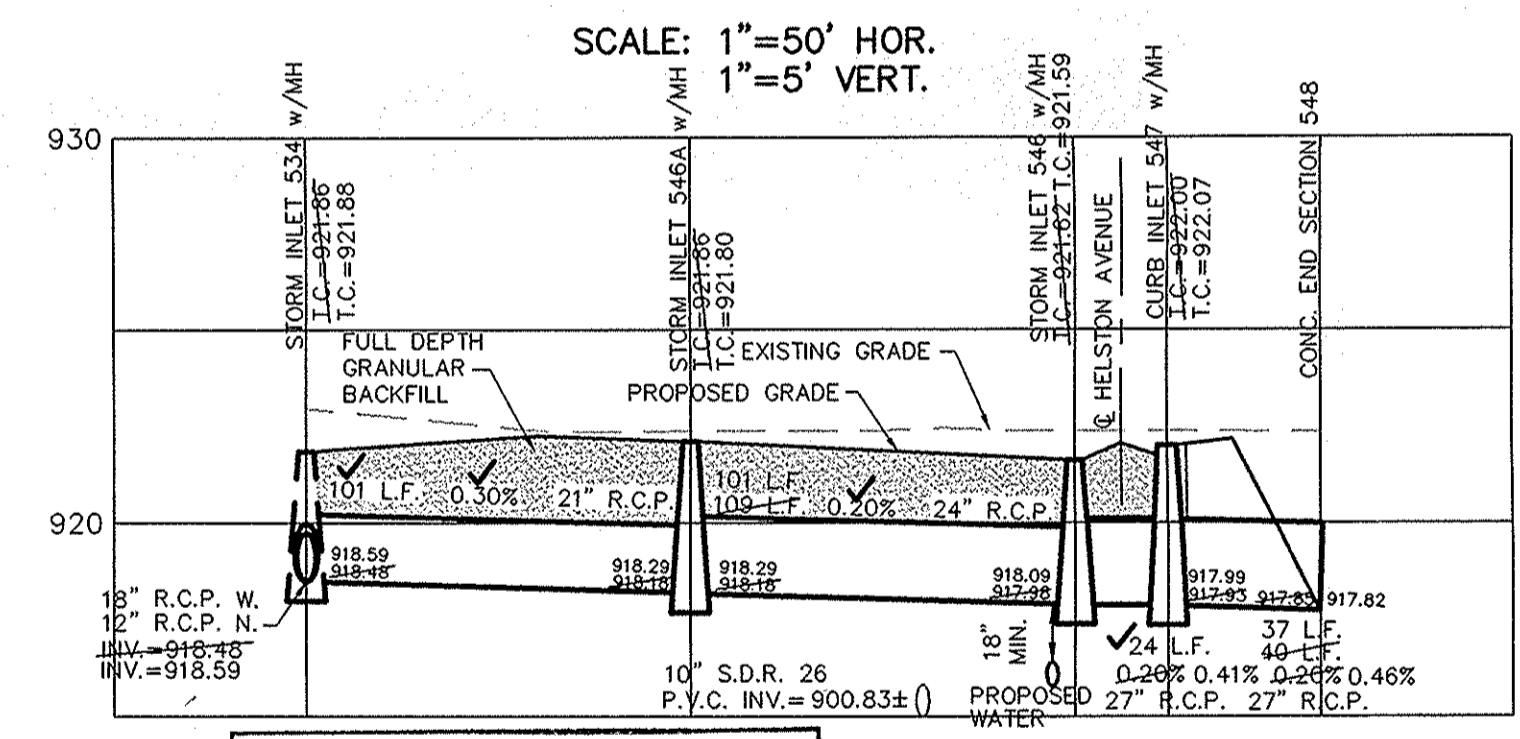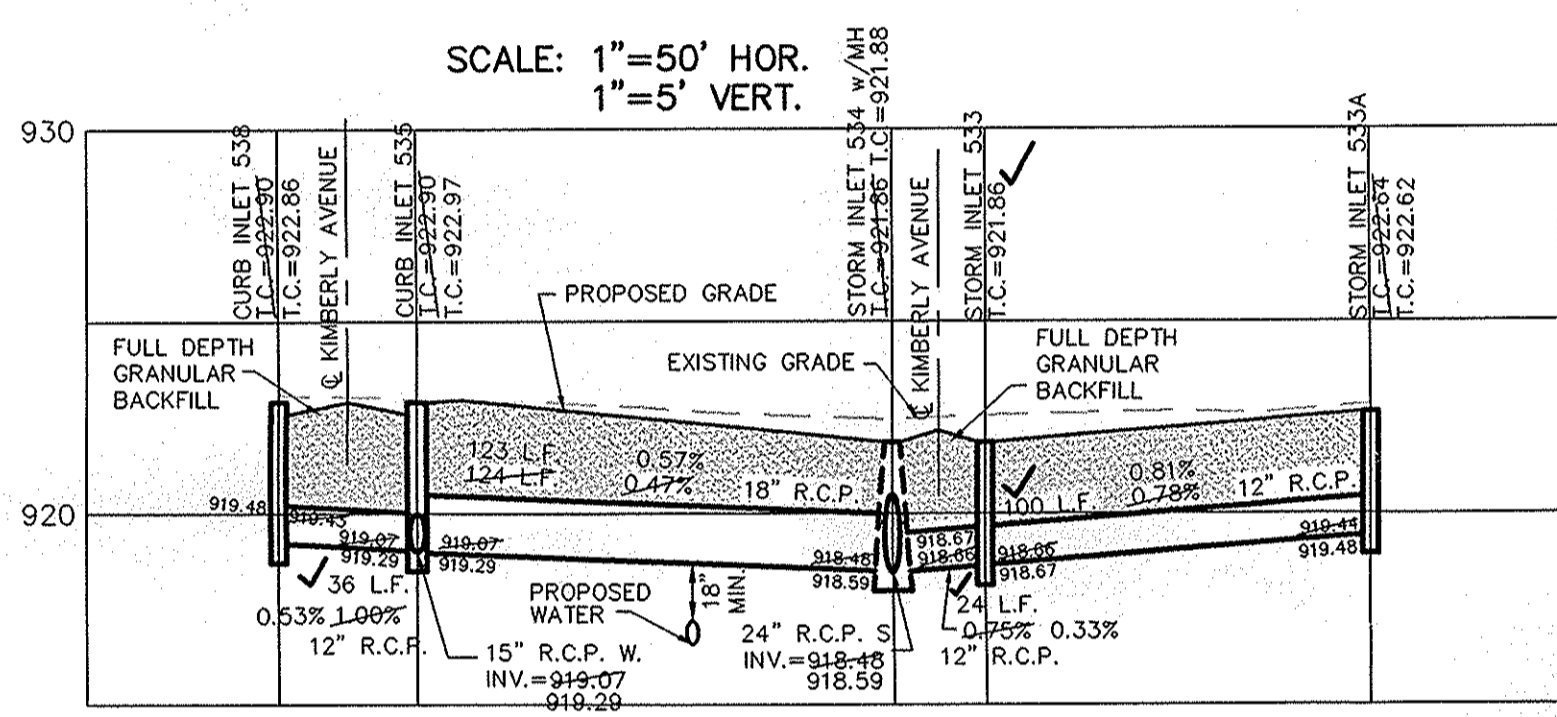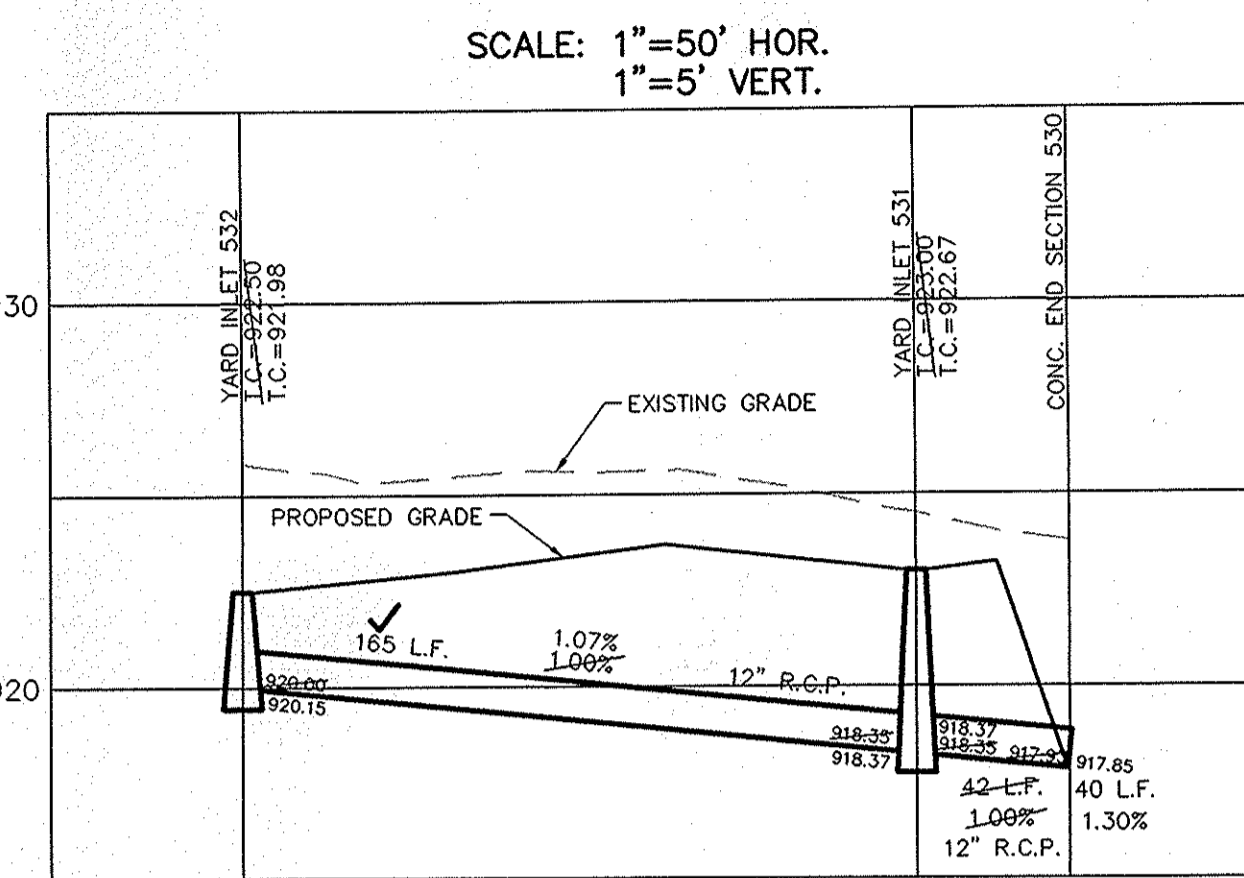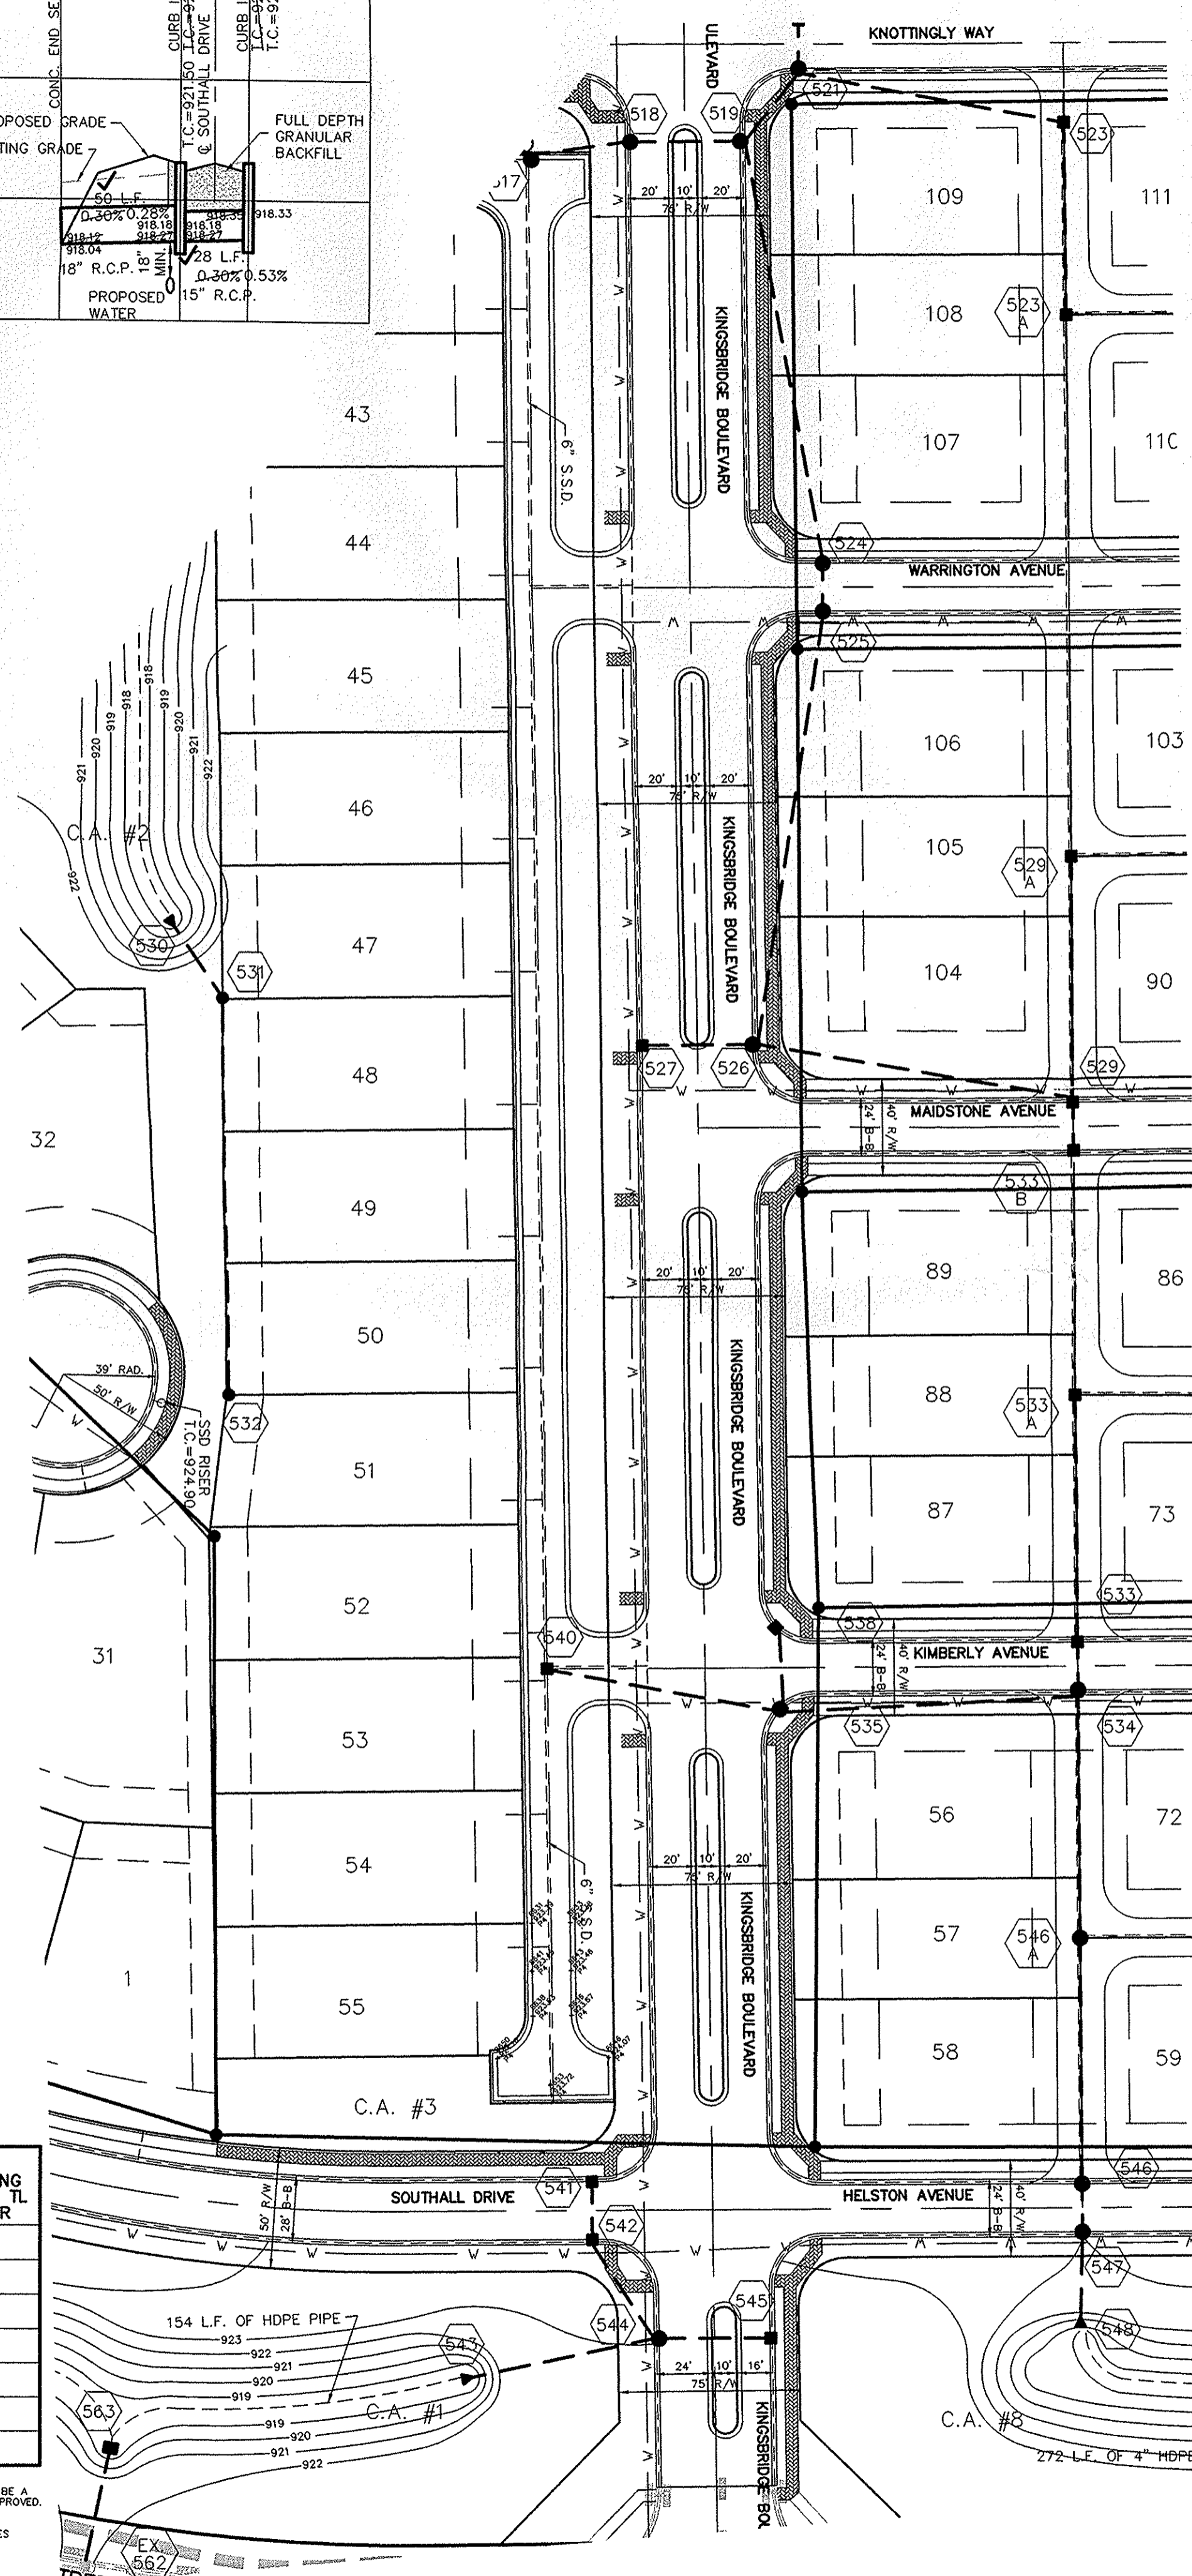

This information was gathered for input into the Hamilton County Geographic Information System (GIS). This document is considered an official record of the GIS.
 Entry Date: 8-26-08
 Entered By: SLN

CERTIFIED: 3/16/05

CONSULTING ENGINEERS - LAND SURVEYORS
 (317) 849-5935 1-800-728-6917 FAX: (317) 849-5942

INDIANA

DAVID J. STEPHENSON
 REGISTERED PROFESSIONAL ENGINEER
 No. 19338
 STATE OF INDIANA

STORM PLAN & PROFILES
 MAPLE VILLAGE SECTION ONE

INDIANA
 WESTFIELD

SHEET NO.
C601


JOB NO. 50690PLA-S

| OWN BY | DATE | MARK | REVISIONS |
|--------|---------|------|-----------|
| BAH | 7/17/06 | | |
| CK BY | 3/22/05 | | |
| EFF | 3/16/05 | | |
| SCALE | 1"=50' | | |
| DATE | 3/16/05 | | |

RECORD DRAWING

JEFFERY W. DARLING
 Registered Land Surveyor
 No. 900017

DATE 7/17/06

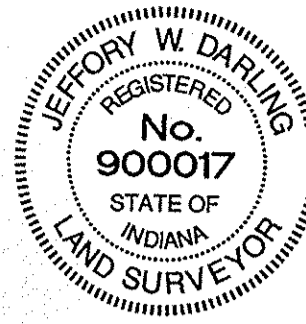

| CURB INLET TABLE | | | | | | |
|------------------|---|--|--|----------------|------------------------|-----------------------|
| PIPE SIZE | STRUCTURES LESS THAN 48" FROM T/C TO INVERT | STRUCTURES GREATER THAN 48" FROM T/C TO INVERT | ANGLE AND QUALITY OF PIPES WILL REQUIRE SPECIAL DESIGN | STEPS REQUIRED | CURB CASTING *R-3501 N | CASTING *3501 TL & TR |
| 12" to 18" | 24"x24" | | DESIGN APPROVAL | No | Yes | Yes |
| 12" to 21" | 30"x30" | | DESIGN APPROVAL | No | Yes | Yes |
| 18" to 21" | | MH/BOX | DESIGN APPROVAL | Yes | Yes | Yes |
| 21" to 27" | 24"x36" | | DESIGN APPROVAL | No | No | Yes |
| 12" to 24" | 36"x36" | | DESIGN APPROVAL | No | Yes | Yes |
| 24" OR LARGER | DESIGN APPROVAL | MH/BOX | DESIGN APPROVAL | No | No | Yes |
| | | | DESIGN APPROVAL | Yes** | Yes | Yes |

* PIPES NO LARGER THAN 18" CAN BE USED IN THE 2' SIDE OF THIS BOX
 ** INCOMING AND OUT GOING PIPES EFFECT STEPS IN THIS STRUCTURE

SPECIAL NOTE:
 STRUCTURES DEEPER THAN 48" FROM T/C TO INVERT WILL BE A MH OR A BOX WITH STEPS UNLESS SPECIAL DESIGN IS APPROVED.


SPECIAL NOTE:
 STRUCTURES WILL BE DESIGNED FOR MAXIMUM FLOW IN PIPES

SPECIAL NOTE:
 COUNTY MAY REQUIRE STEPS TO BE INSTALLED AFTER STRUCTURE IS SET, TO IMPROVE ACCESS.


NOTE:
 ALL STORM STRUCTURES TO RECEIVE SOLID LID CASTINGS ARE TO BE CONSTRUCTED TO PROVIDE 1"-4" RISER RING TO ACHIEVE PLAN RIM GRADE.

ALL YARD INLETS ARE TO BE CONSTRUCTED AT A TOLERANCE OF +0.00' TO 0.20' OF PLAN GRADE.



ALL STORM SEWER CASTINGS SHALL BE LABELED "DUMP NO WASTE-DRAINS TO WATERWAY"

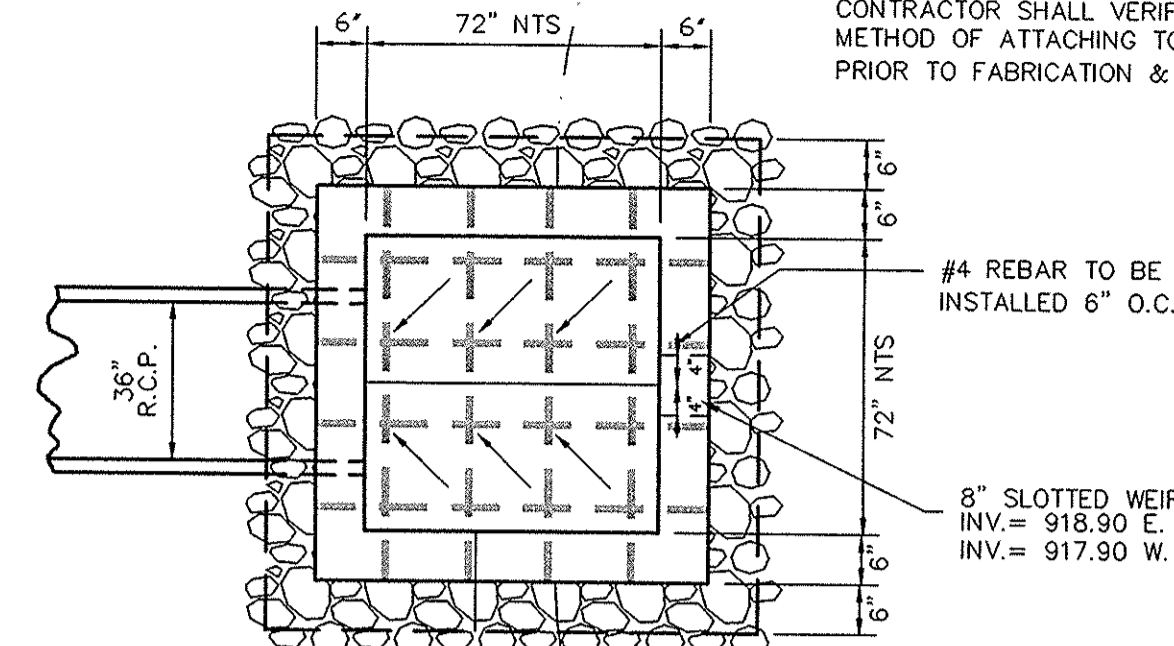


SPECIAL STRUCTURE NO. 549 DETAIL
 NOT TO SCALE

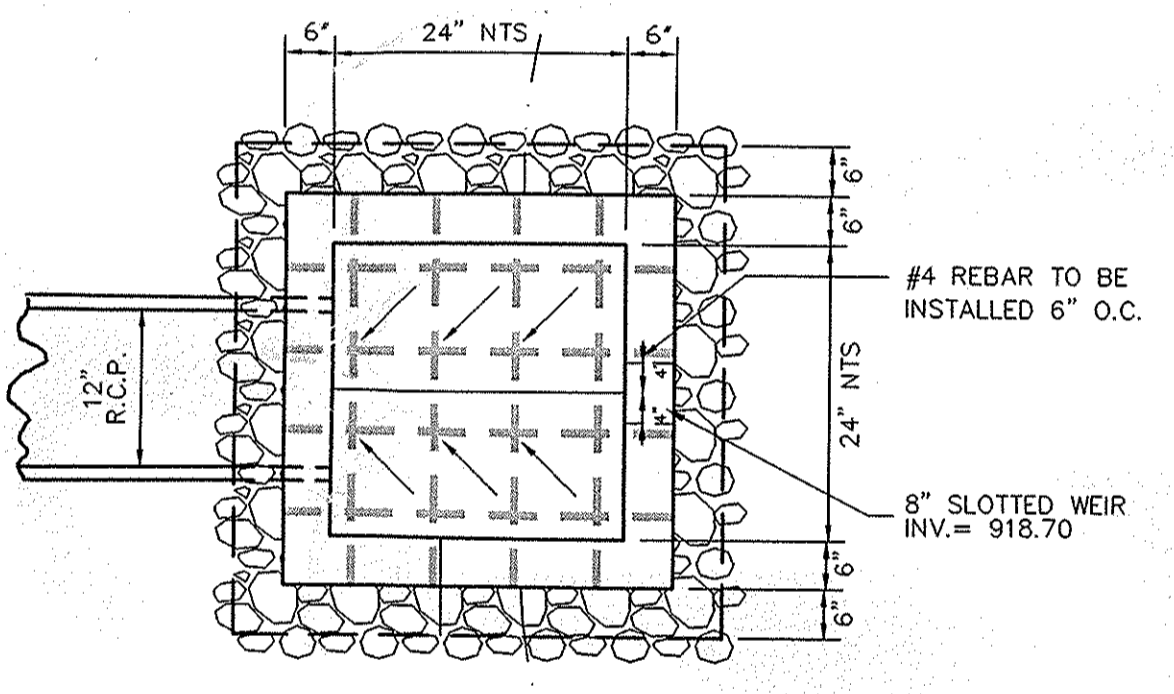


SPECIAL STRUCTURE NO. 563 DETAIL
 NOT TO SCALE

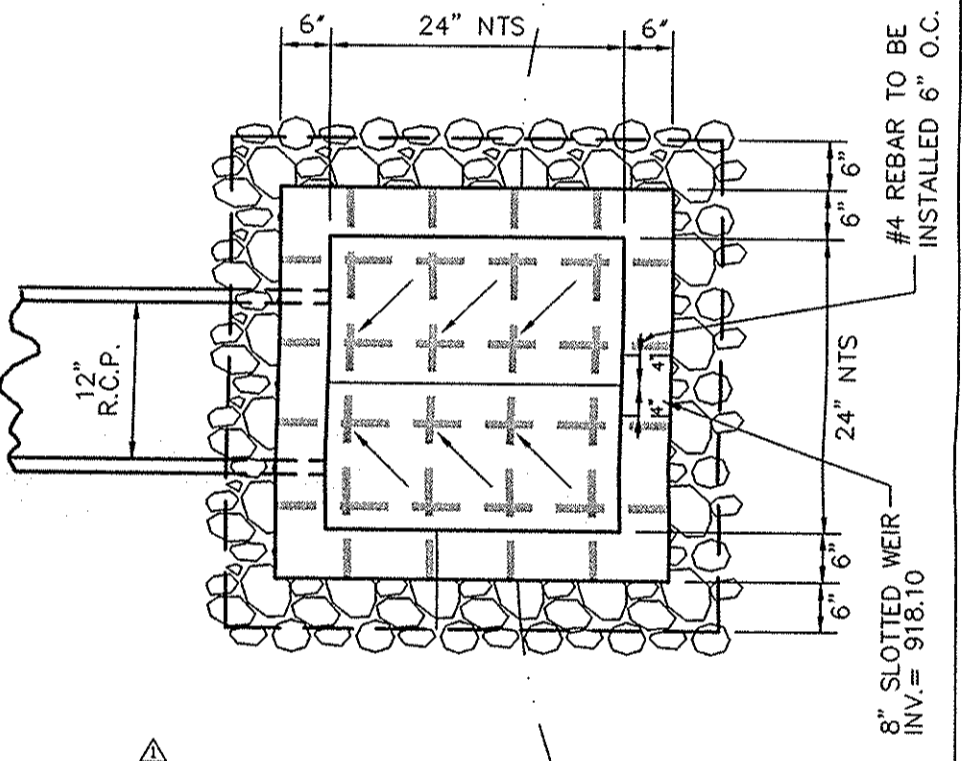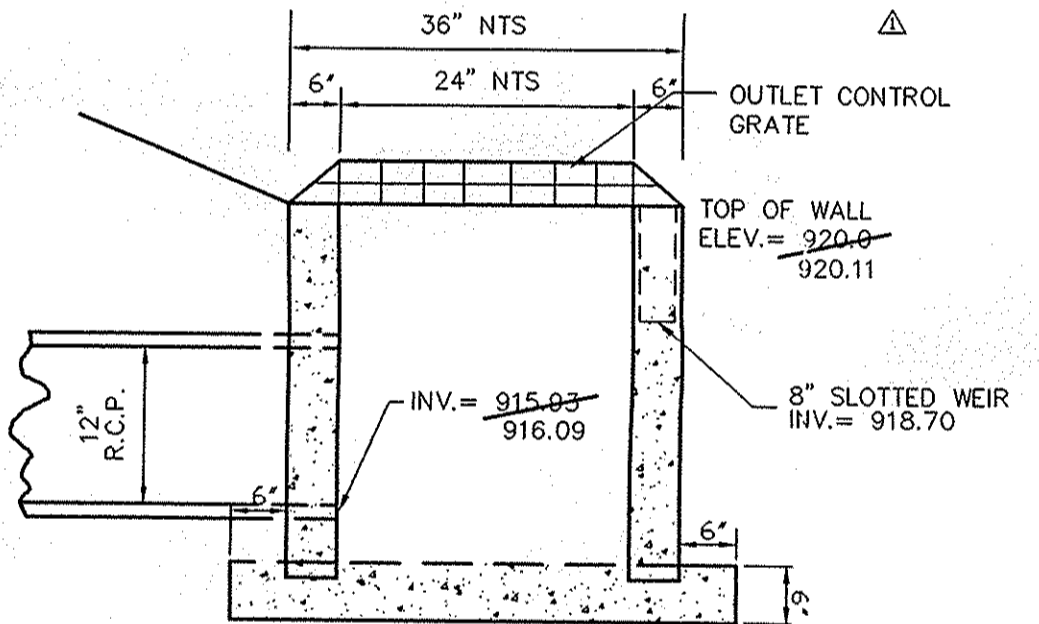


SPECIAL STRUCTURE NO. 561 DETAIL
 NOT TO SCALE

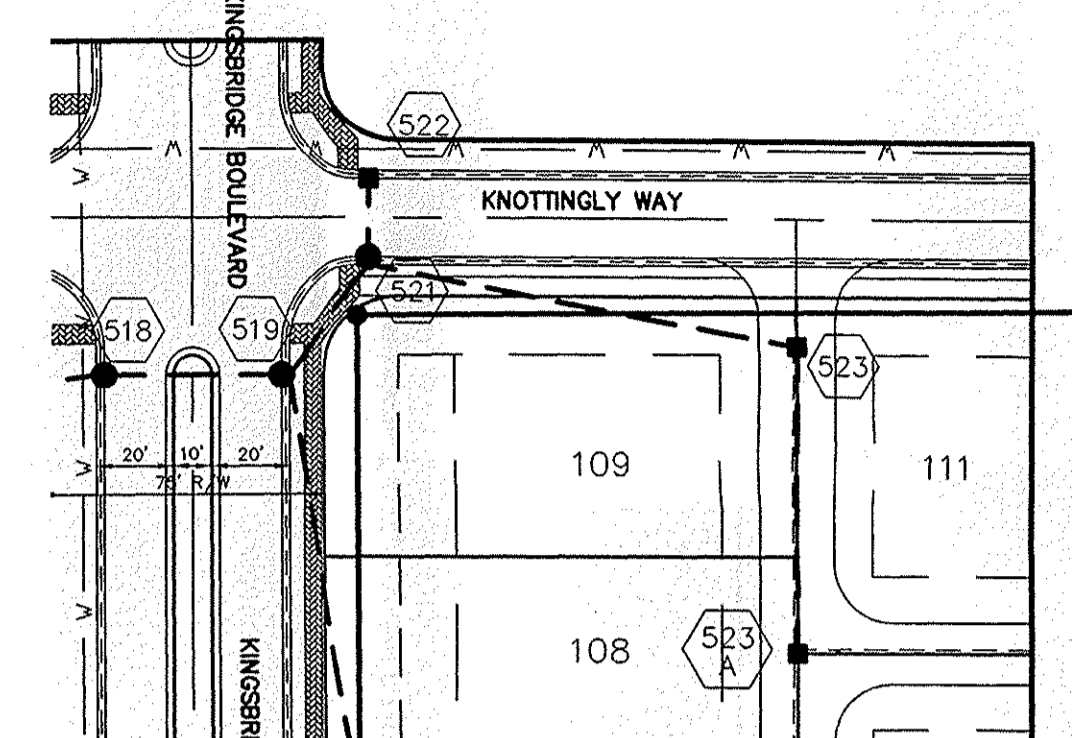


SCALE: 1"=50' HOR.
 1"=5' VERT.

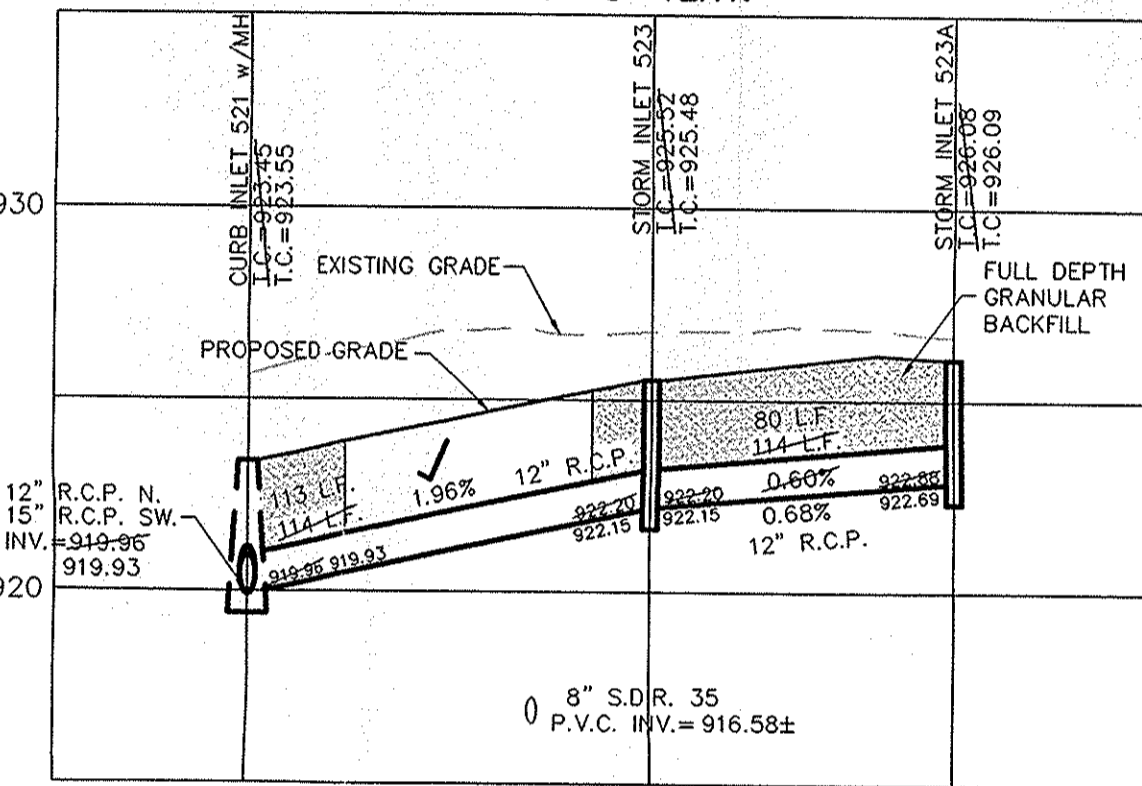


SCALE: 1"=50' HOR.
 1"=5' VERT.

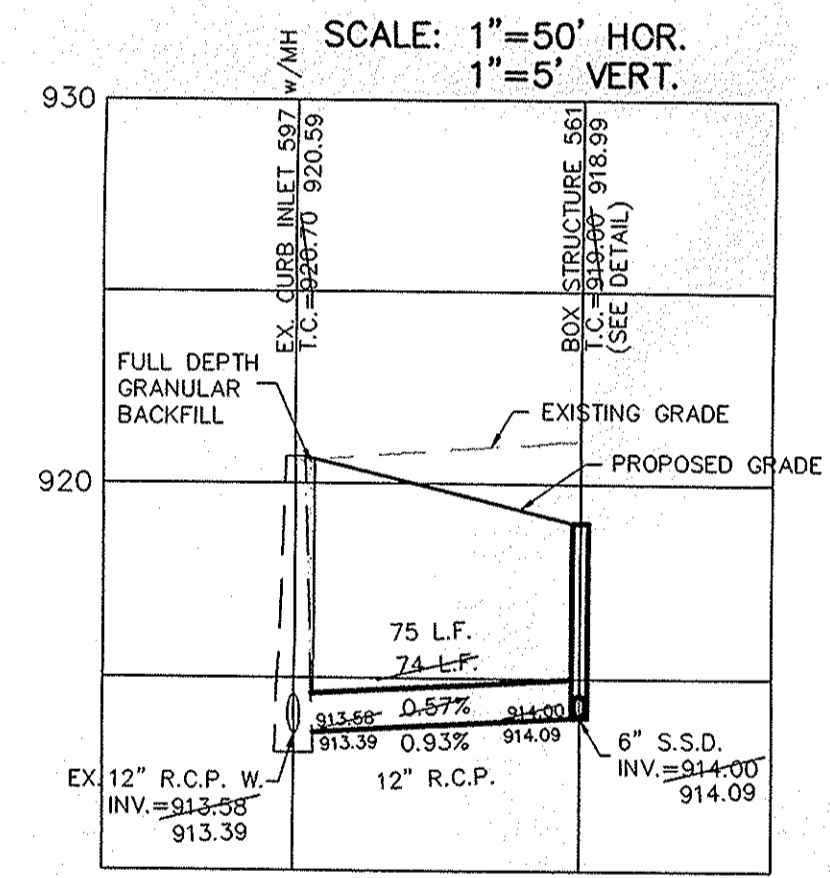

SCALE: 1"=50' HOR.
 1"=5' VERT.

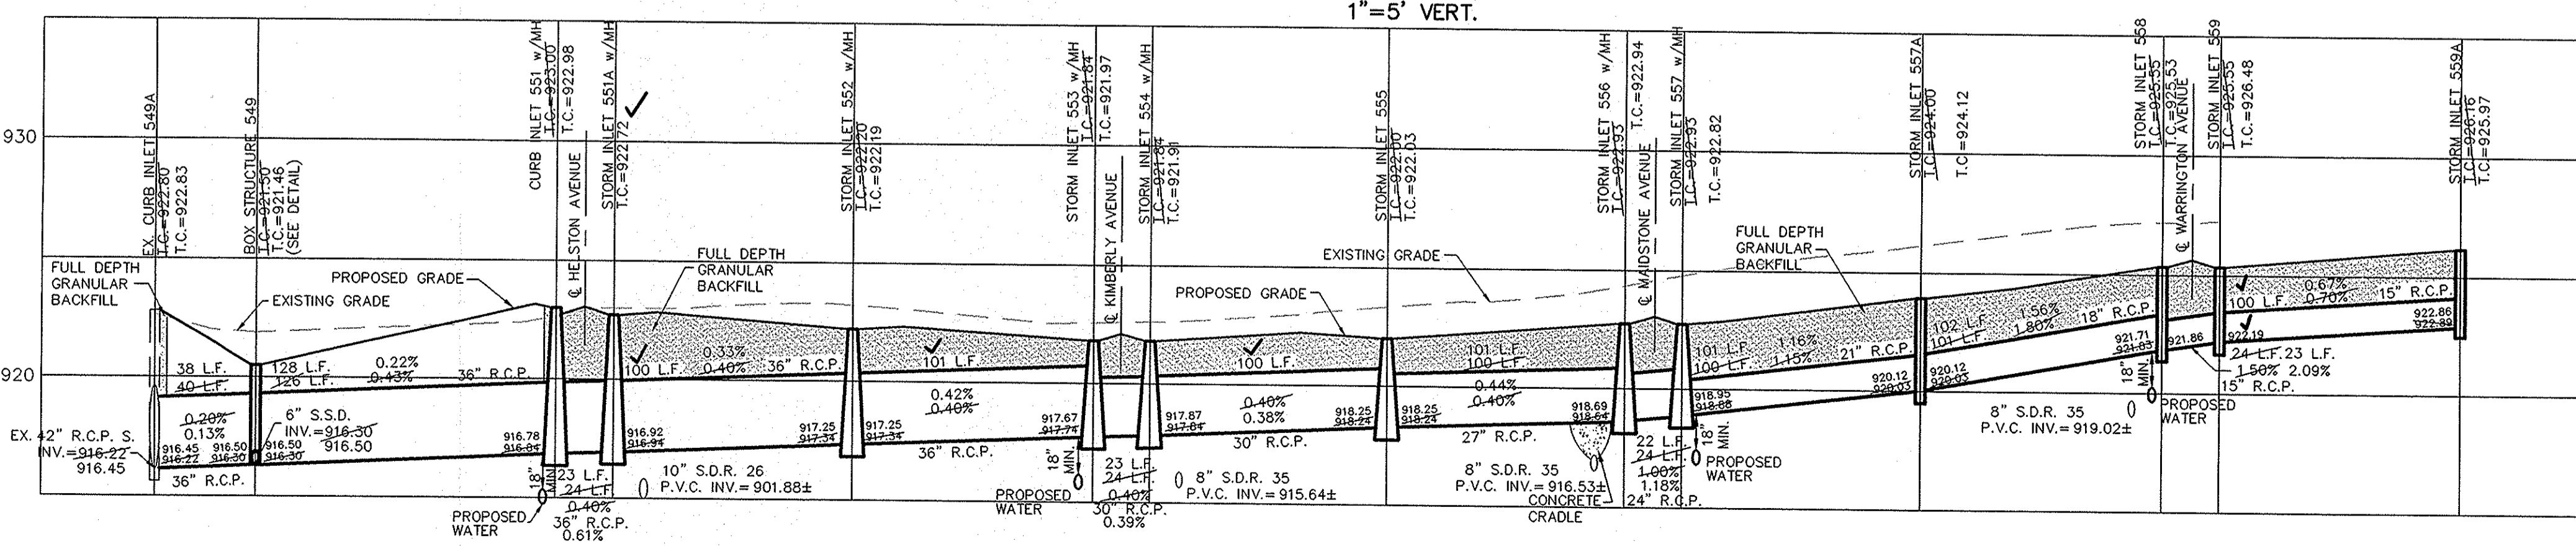


SCALE: 1"=50' HOR.
 1"=5' VERT.

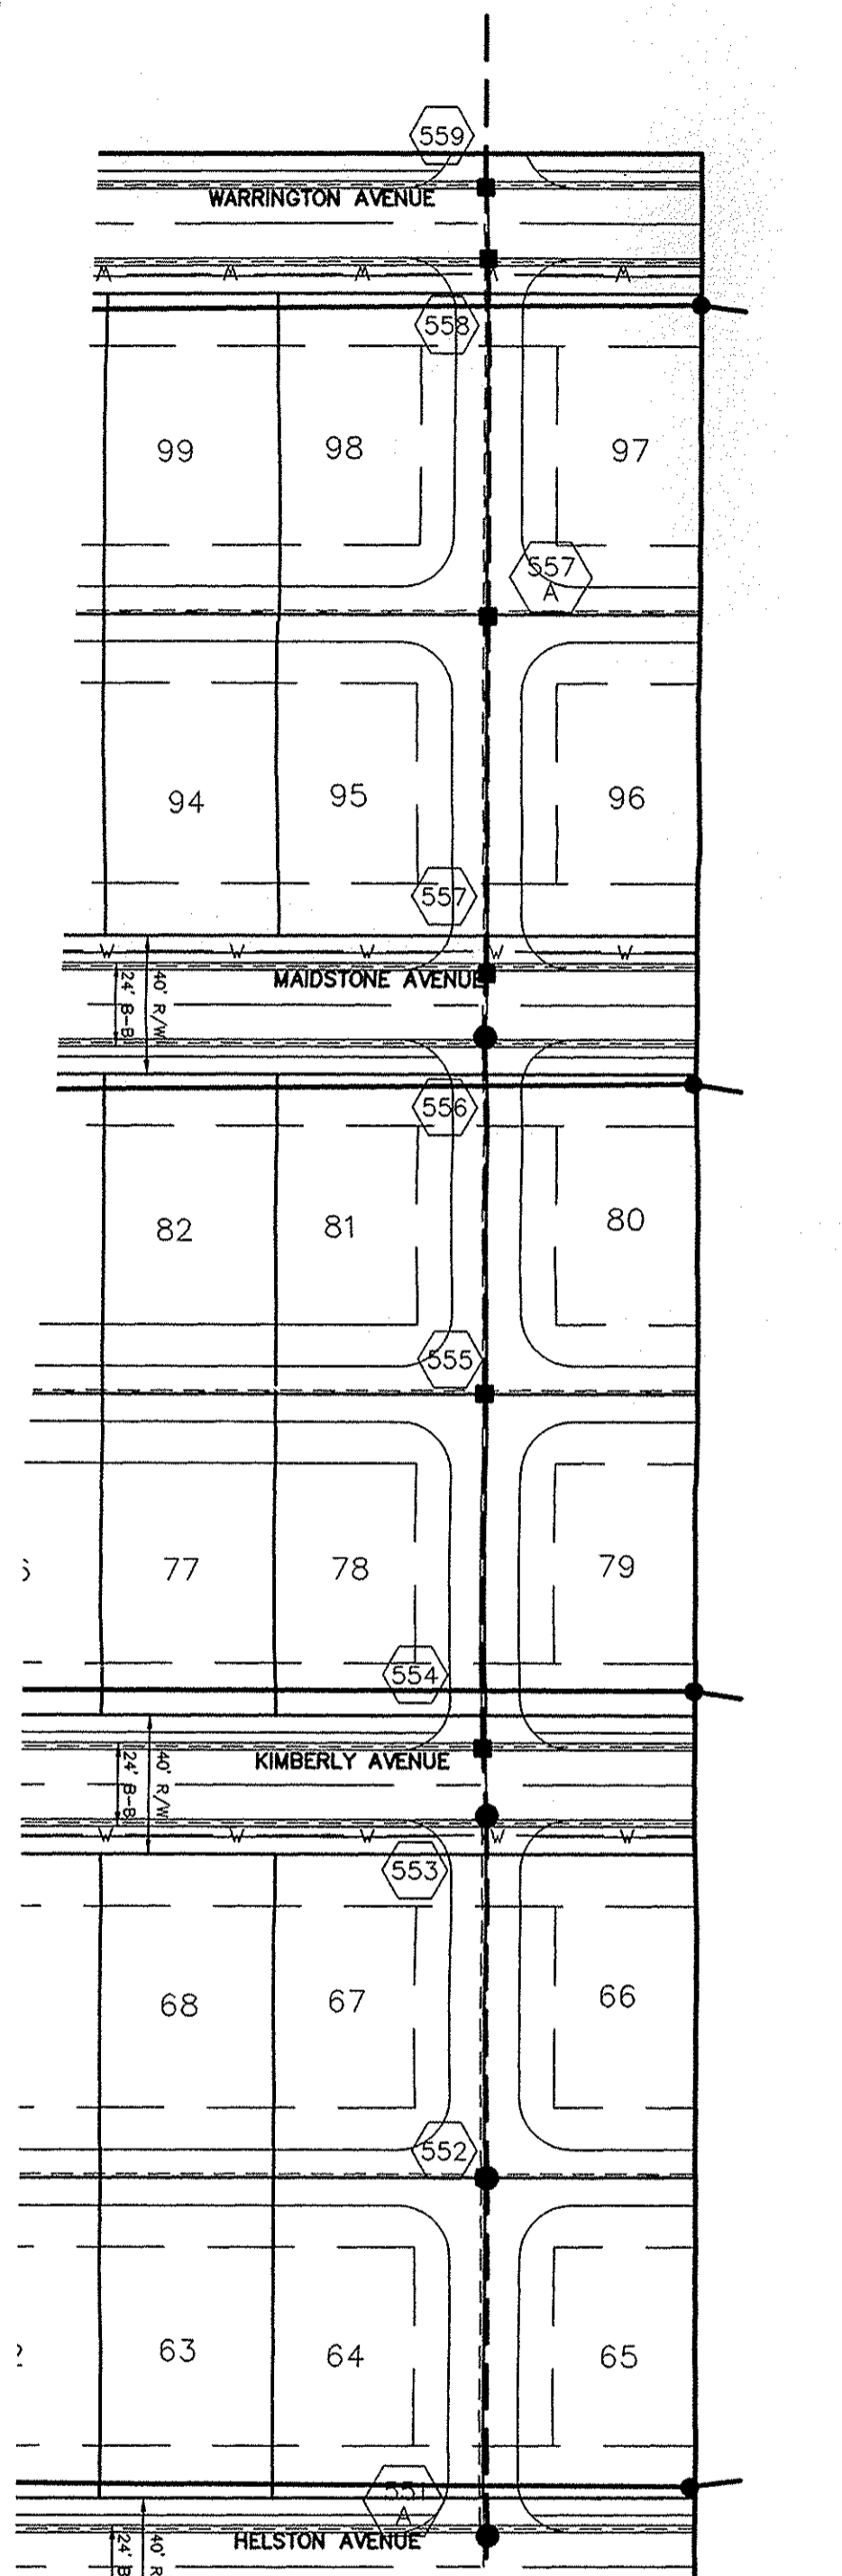


169TH STREET

SCALE: 1"= 50'

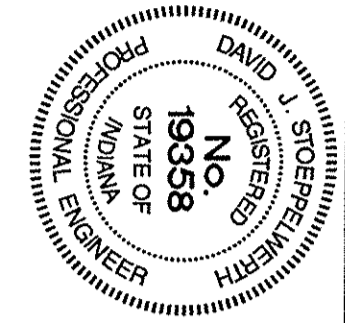

| DATE | BY | REVISIONS |
|---------|-----|-------------------------------|
| 3/15/05 | DAH | REVISED FOR DEVELOPER CHANGES |
| 3/28/05 | ELP | REVISED FOR DEVELOPER CHANGES |
| 7/17/06 | ELP | REVISED FOR DEVELOPER CHANGES |

CERTIFIED: 3/16/05
 David J. Stapp
 CONSULTING ENGINEERS - LAND SURVEYORS
 (317) 849-5935 1-800-728-6917 FAX: (317) 849-5942
 INDIANA

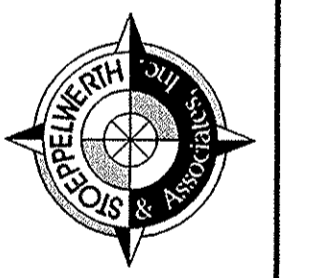

STORM PLAN & PROFILES
 MAPLE VILLAGE SECTION ONE
 WESTFIELD, INDIANA
 SHEET NO. C602
 JOB NO. 50690PLA-S1