

Drain: MASTHEAD DRAIN Drain #: 203
 Improvement/Arm: MASTHEAD - SECTION 10 RECONSTRUCTION
 Operator: JDH Date: 1-22-04
 Drain Classification: Urban/Rural Year Installed: 1991

GIS Drain Input Checklist

- Pull Source Documents for Scanning JDH 1-22
- Digitize & Attribute Tile Drains N/A
- Digitize & Attribute Storm Drains JDH
- Digitize & Attribute SSD N/A
- Digitize & Attribute Open Ditch N/A
- Stamp Plans JDH 1-22
- Sum drain lengths & Validate JDH 1-22
- Enter Improvements into Posse JDH 1-22
- Enter Drain Age into Posse _____
- Sum drain length for Watershed in Posse _____
- Check Database entries for errors JDH 1-22

Gasb 34 Footages for Historical Cost
Drain Length Log


Drain-Improvement: MASTHEAD DRAIN - MASTHEAD - SECTION 10 RECONSTRUCTION

Drain Type:	Size:	Length/ <i>SURVEYOR'S</i> <i>REPORT</i> ()	Length (DB Query)	Length Reconcile	If Applicable	
					Price:	Cost:
RCP	15"	114'	114'	Ø	9.50	1,083.00

Sum: 114' 114' Ø 1,083.00

Final Report: _____

Comments:

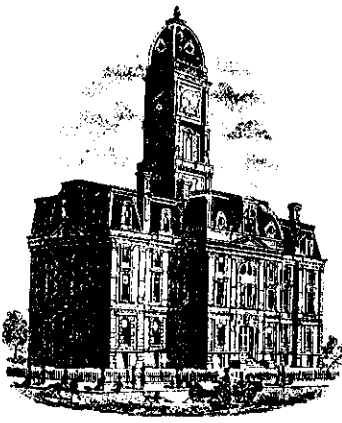

SURVEYOR'S OFFICE
Hamilton County

Kenton C. Ward, Surveyor

776-9626

942 Maple Avenue

Noblesville, Indiana 46060

December 13, 1990


TO: Hamilton County Drainage Board

RE: Masthead Drain

Attached is a petition and plan for reconstruction of the Masthead, Section 10 Drain.

The proposal by Thomas D. Rush is to fill an existing open ditch by placing a fifteen (15") inches RCP between Structures 404 and 407. The length of the regulated drain will not be affected. Costs of the work shall be borne by Mr. Rush. Upon review I believe the proposal will not be detrimental to the drainage system.

I recommend a hearing be set for February 1991. If approved at the hearing I recommend that the petition be given one (1) year from date of approval for completion and submit a performance bond or letter of credit for 100% of the estimate within thirty (30) days of approval. Said surety to run for a two (2) year period. The surety is to be released upon final inspection by the Surveyor and submittal of "As Built" Drawings.

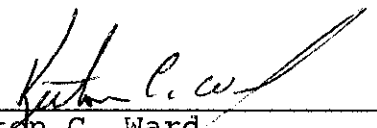
Kenton C. Ward
Hamilton County Surveyor

KCW/no

Feb 19, 1991
9:00am

HAMILTON COUNTY DRAINAGE BOARD
942 Maple Street
Noblesville, Indiana

IN RE: Masthead Section Ten)
Regulated Drain)
Hamilton County, Indiana)

PETITION FOR RECONSTRUCTION

THOMAS D. RUSH (hereinafter

"Petitioner"), hereby petitions the Hamilton County Drainage Board for authority to improve a section of the Masthead Section Ten Drain, and in support of said petition advises the Board that:

1. Petitioner owns real estate through which a portion of the Masthead Section Ten Drain runs.

2. Petitioner plans to improve its real estate with a storm drain and appropriate structures.

3. Petitioner's proposed development of its real estate will require reconstruction of a portion of the Masthead Section Ten Drain, as conceptually shown on the engineering reconstruction plans and preliminary stormwater management calculations filed with the Hamilton County Surveyor.

4. Final construction plans and specifications will be filed with Hamilton County Surveyor for approval before construction commences.

5. The work necessary for the proposed relocation and reconstruction will be undertaken at the sole expense of the Petitioner and such work will result in substantial improvement to the Masthead Section Ten Drain, without cost to other property owners on the watershed of the Masthead Section Ten Drain.

WHEREFORE, Petitioner requests that an Order issue from the Hamilton County Drainage Board authorizing reconstruction of the Masthead Section Ten Drain, in conformance with applicable law and plans and specifications on file with the Hamilton County Surveyor.

By



THOMAS D. RUSH

BEFORE THE HAMILTON COUNTY DRAINAGE BOARD

IN THE MATTER OF THE

Masthead Drain-Section 10

NOTICE


To whom it may concern

and _____

Notice is hereby given of the hearing of the Hamilton County Drainage Board on the Masthead Drain-Section 10 on February 19, 1991 at 9:00 A.M. in Commissioners Court in the Hamilton County Court House, Noblesville, Indiana, and which reconstruction and maintenance reports of the Surveyor and the Schedule of Assessments made by the Drainage Board have been filed and are available for public inspection in the office of the Hamilton County Surveyor.

Hamilton County Drainage Board

ATTEST:

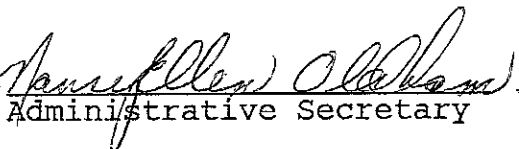
Administrative Secretary

STATE OF INDIANA)
) SS: BEFORE THE HAMILTON COUNTY DRAINAGE BOARD
COUNTY OF HAMILTON)

IN THE MATTER OF Masthead DRAIN-Section 10

NOTICE

Notice is hereby given that the Hamilton County Drainage Board at its regular meeting February 19, 1991 adopted the reconstruction report of the Surveyor and the Amended Schedule of damages and assessments including annual assessment for periodic maintenance, finding that the costs, damages and expense of the proposed improvement would be less than the benefits which will result to the owner of lands benefited thereby.

The Board issued an order declaring the proposed improvement established. Such findings and order were marked filed and are available for inspection in the Office of the Hamilton County Surveyor.

If judicial review of the findings and order of the Board is not requested pursuant to Article VIII of the 1965 Indiana Drainage Code as amended within twenty (20) days from the date of publication of this notice, the findings and order shall become conclusive.

HAMILTON COUNTY DRAINAGE BOARD

BY William R. Kamm
CHAIRPERSON

Manuel O. O'Brien
Secretary

CERTIFICATE OF COMPLETION AND COMPLIANCE

TO: COUNTY SURVEYOR'S OFFICE, HAMILTON COUNTY
ATTN: Mr. Kenton Ward
FROM: Paul I. Cripe, Inc., Engineers
SUBJECT: Storm Sewer Addition at ~~_____~~ Subdivision, Section Ten, Lot 206

I hereby certify that

- 1) I am familiar with the plans and specifications for the above referenced project,
- 2) I have personally observed the completion of the above referenced project, and
- 3) To the best of my knowledge, information and belief, the above referenced project has been performed and completed in conformity with all plans and specifications, except as noted on "Record Drawings"

Signature Joseph A. Sharp Date April 11, 1991
Type or Printed Name Joseph A. Sharp
Business Address 7172 Graham Road
Indianapolis, IN 46250
Telephone (317) 842-6777

Seal



Indiana Registration Number

15179

FILED

APR 15 1991

OFFICE OF HAMILTON COUNTY SURVEYOR

ADM:t1
1/13/84



SURVEYOR'S OFFICE
Hamilton County

Kenton C. Ward, Surveyor

776-9626

942 Maple Avenue

Noblesville, Indiana 46060 May 16, 1991


To: Shorewood Corp.
Attn: Dave Coverdale

Re: Masthead Drain Sec. 10
Storm Sewer Imp. - Lot 295-296

On May 17, 1991 the storm sewer improvements across lots 295-296 in Masthead Section 10 were inspected. The improvements were found to be installed satisfactorily by Shorewoods Contractor and therefore accepted as constructed.

If you have any questions contact the Surveyors Office at 776-9626.

Sincerely

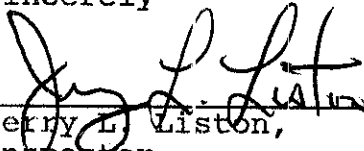

Jerry L. Liston,
Inspector

JLL/jh

cc: Harold Harvey
Cripe
Huntley
file copy

CONSTRUCTION PLANS FOR MASTHEAD - SECTION TEN

INDEX

SHT.	DESCRIPTION
1	Cover Sheet
2	Site Development Plan
3	Street / Plan & Profile & Detail
4	Street / Details
5	Street / Details
6	Sanitary Sewer / Plan & Profile
7	Sanitary Sewer / Plan & Profile
8	Sanitary Sewer / Plan & Profile
9	Storm Sewer / Plan & Profile
10	Storm Sewer / Plan & Profile
11	Details & Specifications
12	Details & Specifications
13	Clearing Limits

BENCH MARKS

REVISIONS




10-12-84 REV PER NOBLESVILLE TAC
4-4-91 ADDED AS-BUILTS SHT. 9

This information was gathered for input into the Hamilton County Geographical Information System. This document is considered an official record of the GIS.
Entry Date: 1-22-04
Entered by: JQH

FILED

APR 5 1991


OFFICE OF HAMILTON COUNTY SURVEYOR

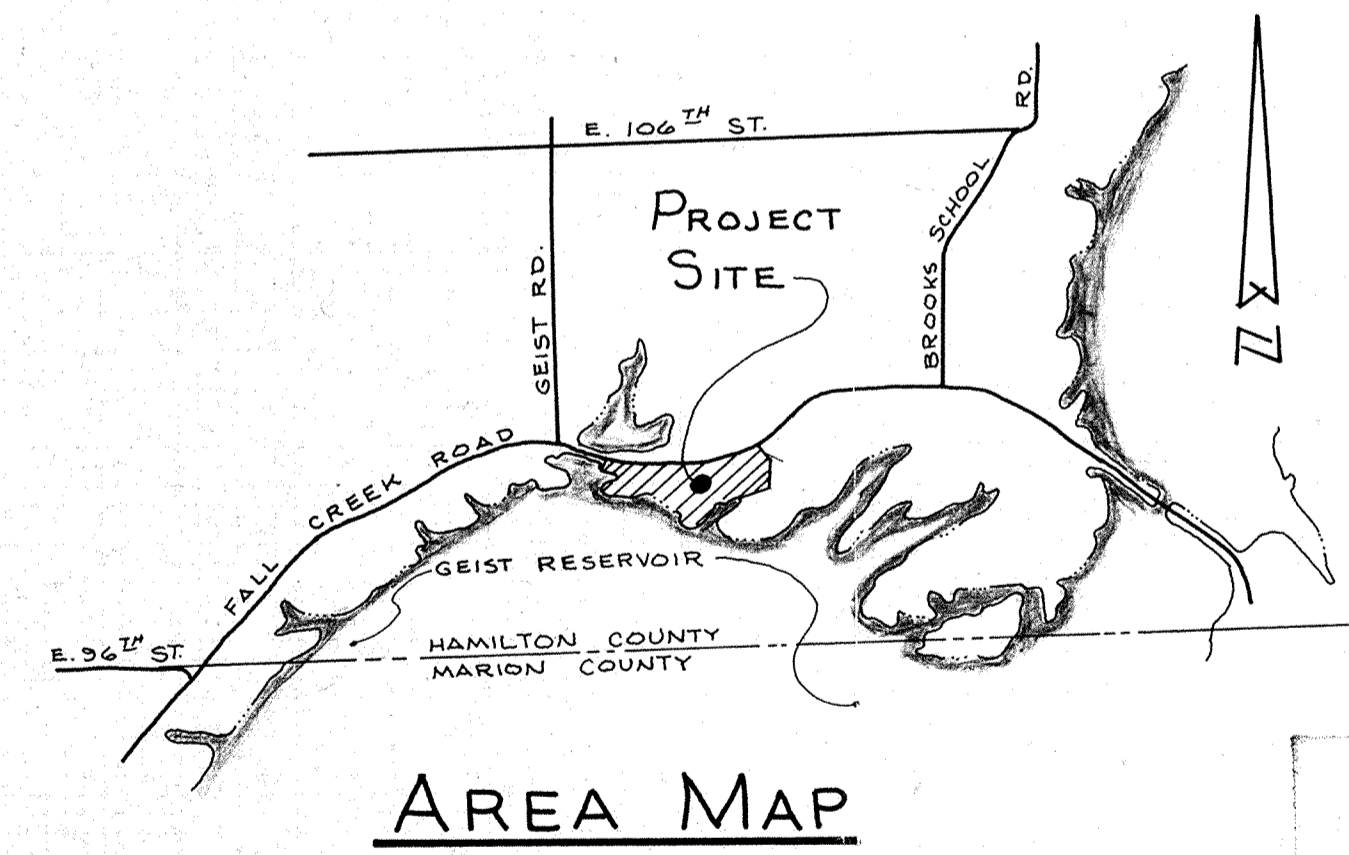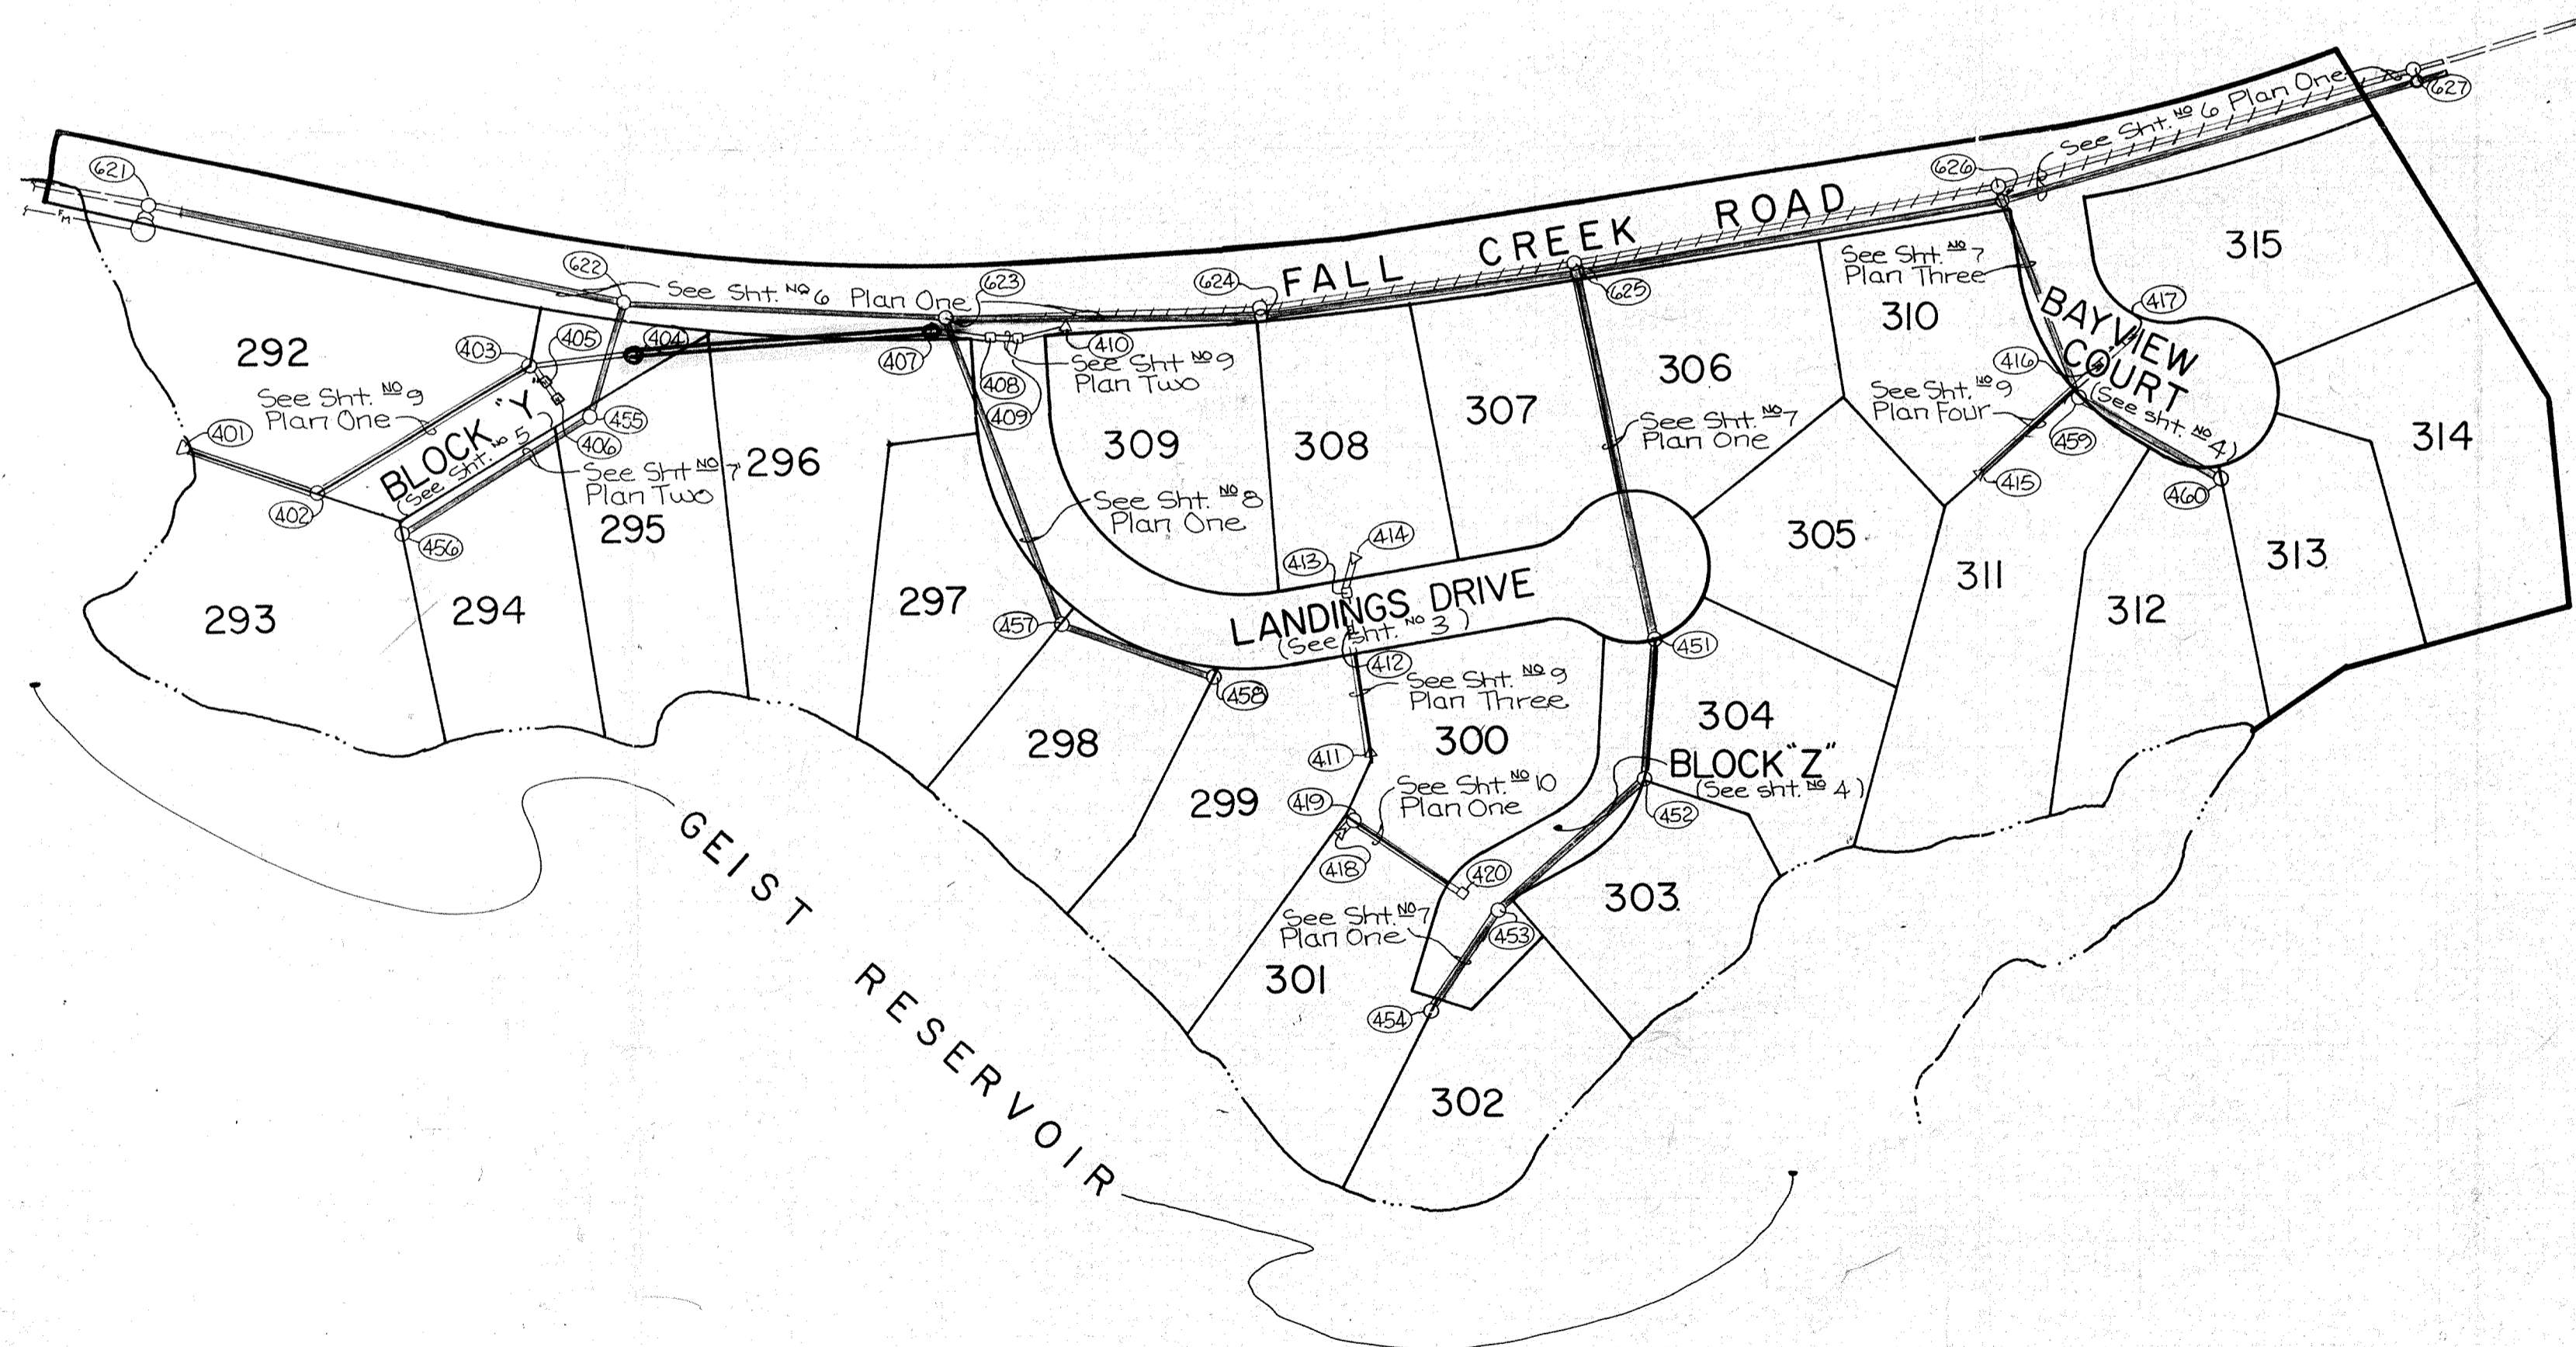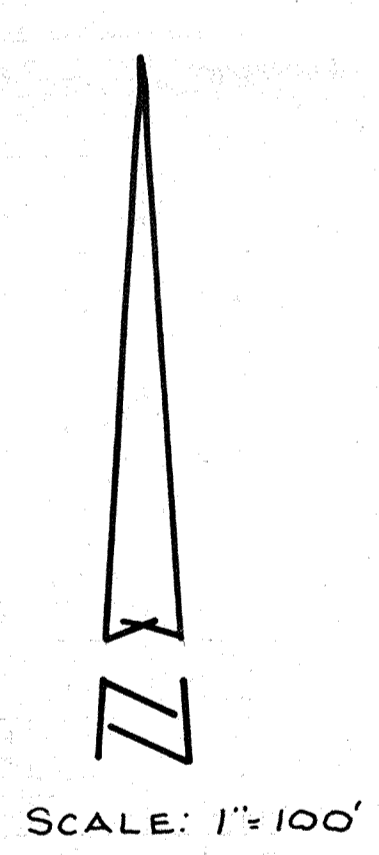

AS BUILT
SANITARY SEWER
date 3-25-85
Storm Sewer (Lots 295-296)
4.4.91
MASTHEAD SEC 10

CERTIFIED BY
Joseph A. Shay
4.4.91 DATE

REVISIONS

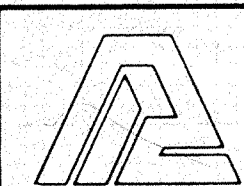

PAUL I. CRIFE, INC.
7172 GRAHAM ROAD
INDIANAPOLIS, INDIANA 46250
(317) 842-6777


- CIVIL ENGINEERING
- LAND SURVEYING
- ARCHITECTURE
- LAND PLANNING

TECH. CHK.
DRAWN BY
SCALE NOTED
DATE 1-30-84
CLIENT THE SHOREWOOD CORP.

DFTNG. CHK.
DRAWING TITLE
COVER SHEET

DWG. TYPE
FILE NUMBER
JOB NUMBER
791100-110010

SHEET 1 OF 13

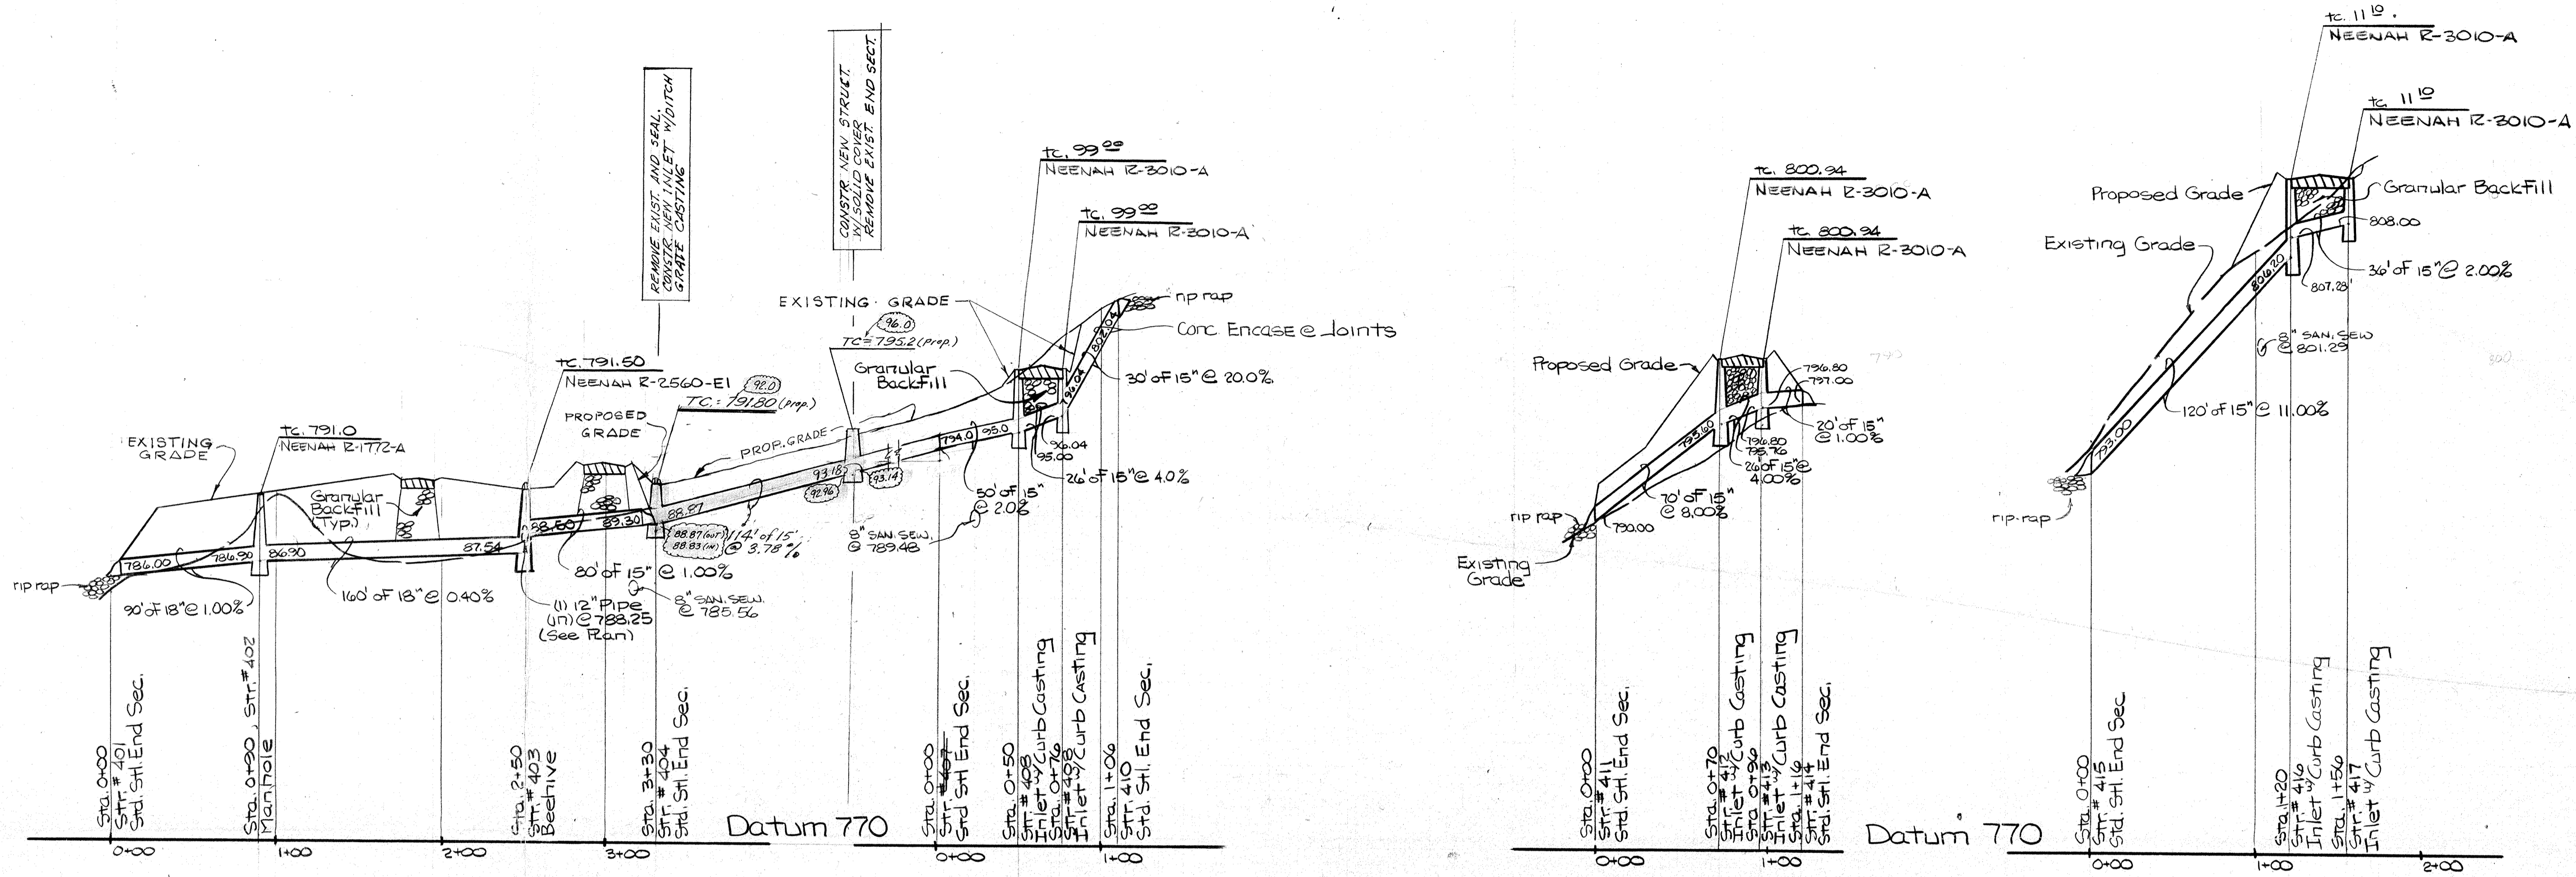


Profile One
Scale 1" = 5' V
1" = 50' H

Profile Two
Scale 1" = 5' V
1" = 50' H

Profile Three
Scale 1" = 5' V
1" = 50' H

Profile Four
Scale 1" = 5' V
1" = 50' H

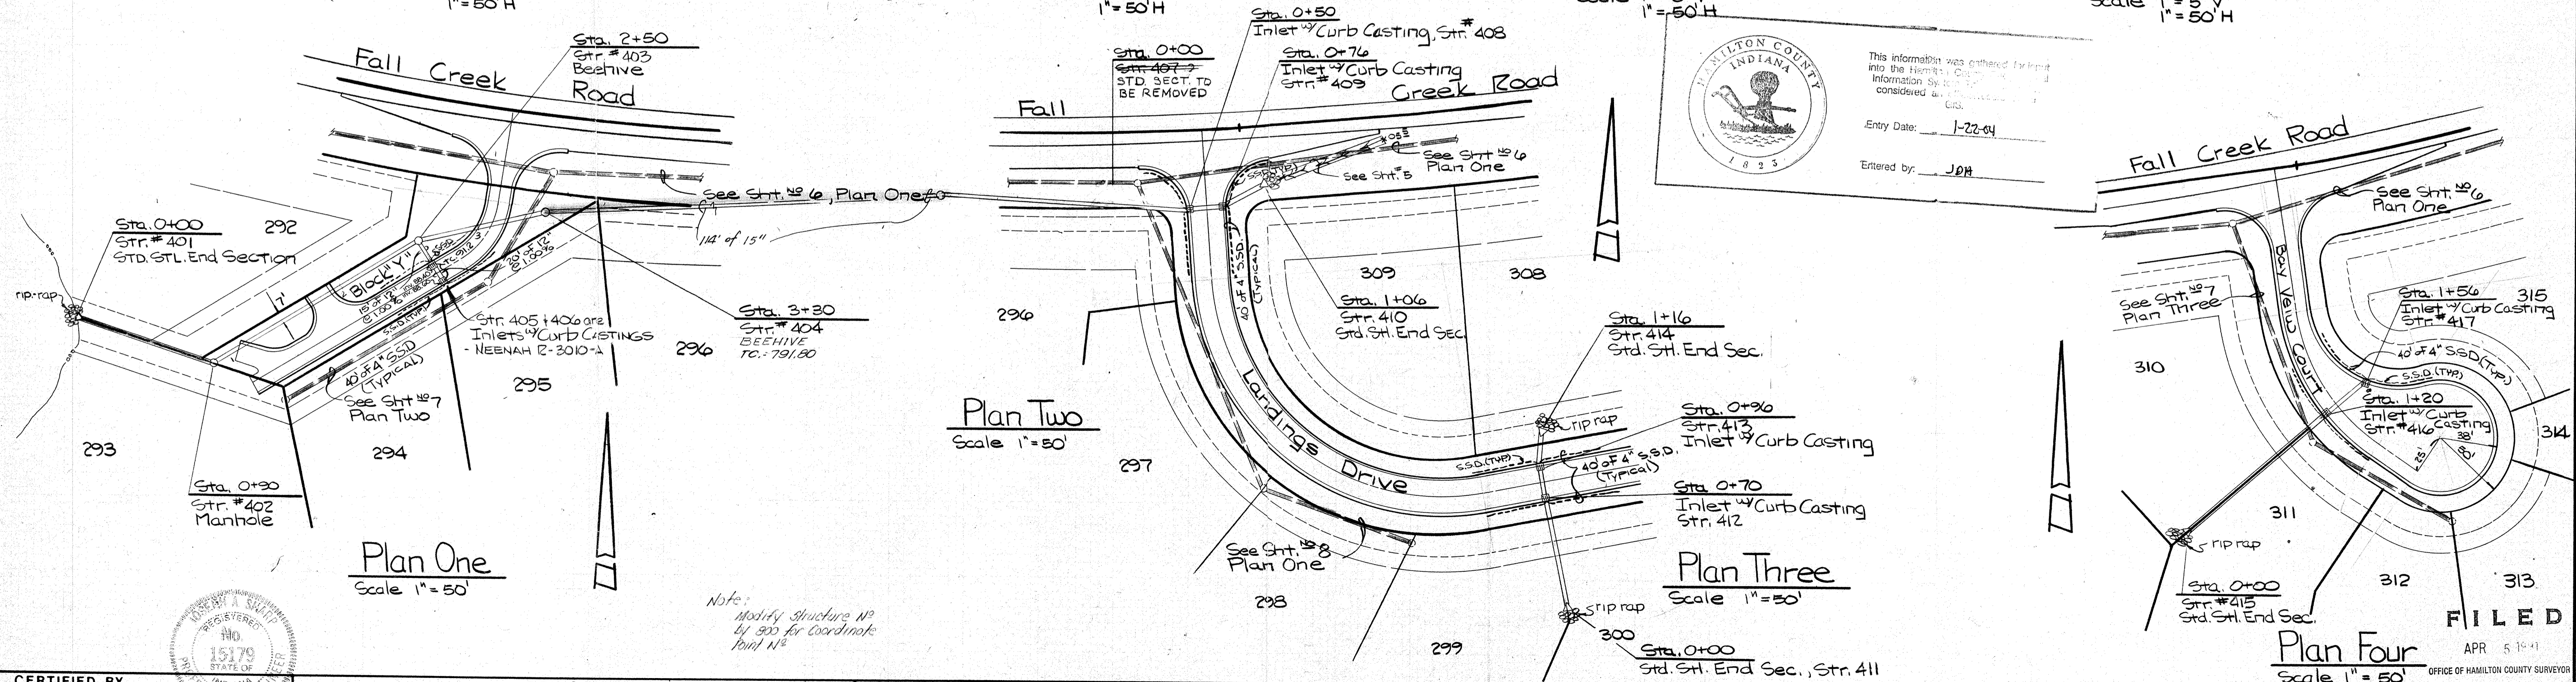


Plan One
Scale 1" = 50'

Plan Two
Scale 1" = 50'

Plan Three
Scale 1" = 50'

Plan Four
Scale 1" = 50'

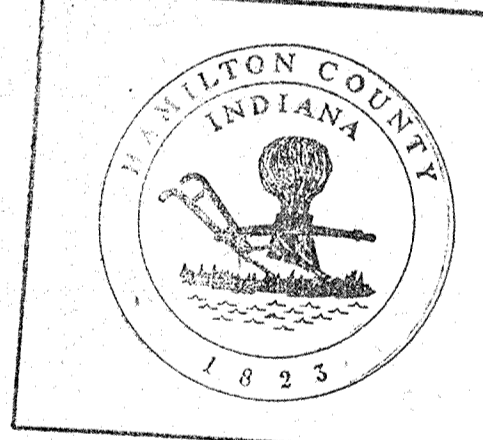


This information was gathered for and into the Hamilton County Information System and is considered an official record.
Entry Date: 1-22-04
Entered by: JDA

Note:
Modify Structure No. 41 900 for coordinate point N²

FILED
APR 5 10 41
OFFICE OF HAMILTON COUNTY SURVEYOR

CERTIFIED BY
Joseph A. Shays
4.7.91 DATE

REVISIONS
11-15-90 Added 175' of 15" RCP between Sta. 0+00 and Sta. 0+30 TO BE REMOVED #407
11-17-90 Added New Street to Lot 292
4.7-91 ADDED AS-BUILT INFO FOR ABOVE CHANGES

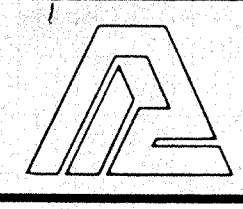


PAUL I. CRIFE, INC.
7172 GRAHAM ROAD
INDIANAPOLIS, INDIANA 46250
(317) 842-6777


CIVIL ENGINEERING
LAND SURVEYING
ARCHITECTURE
LAND PLANNING

TECH. CHK. G.S.D.
DRAWN BY G.S.D.
SCALE As Noted
DATE 1-30-84
CLIENT Masthead Section 10
DRAWING TITLE Storm Sewer ~ Plan ~ Profile


DWG. TYPE FILE NUMBER SHEET
JOB NUMBER
791100-10010 OF 13

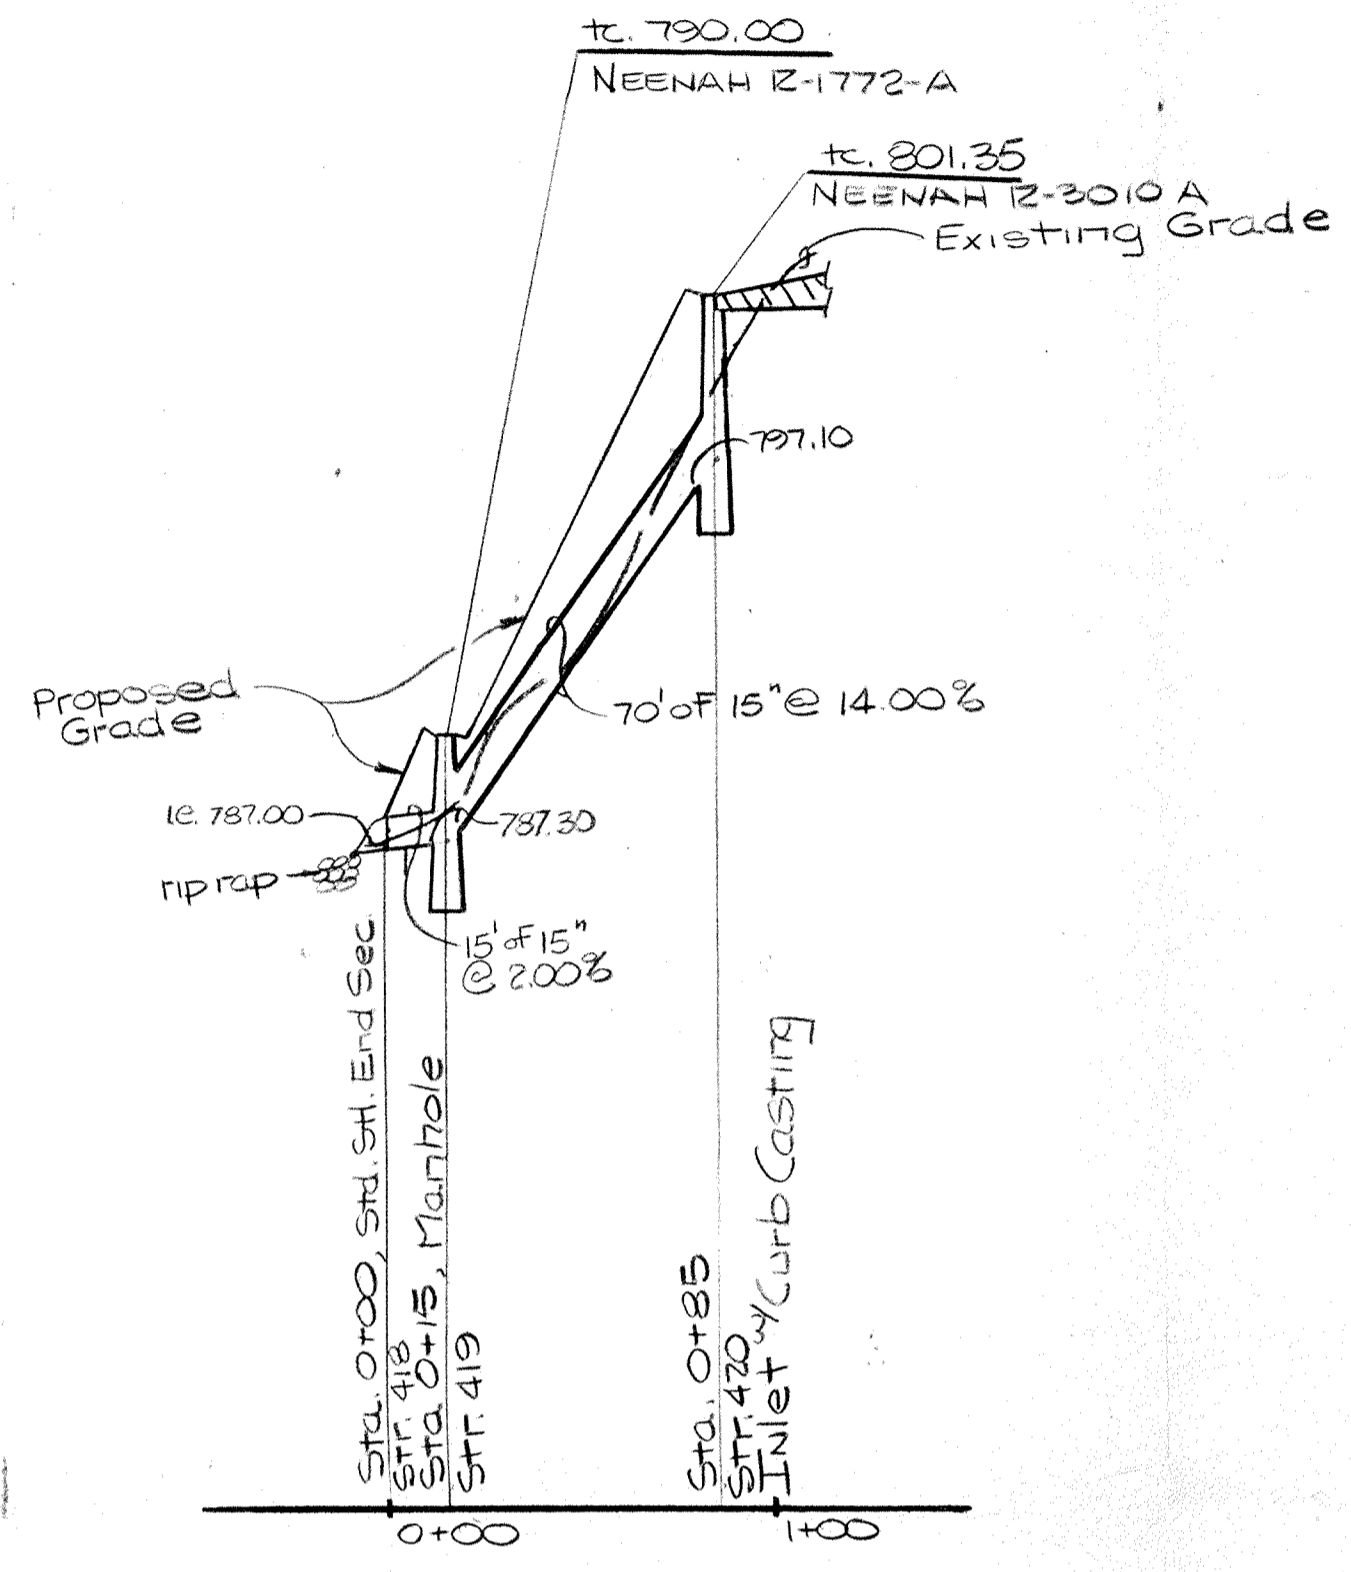

Profile One
Scale 1" = 5' V
1" = 50' H

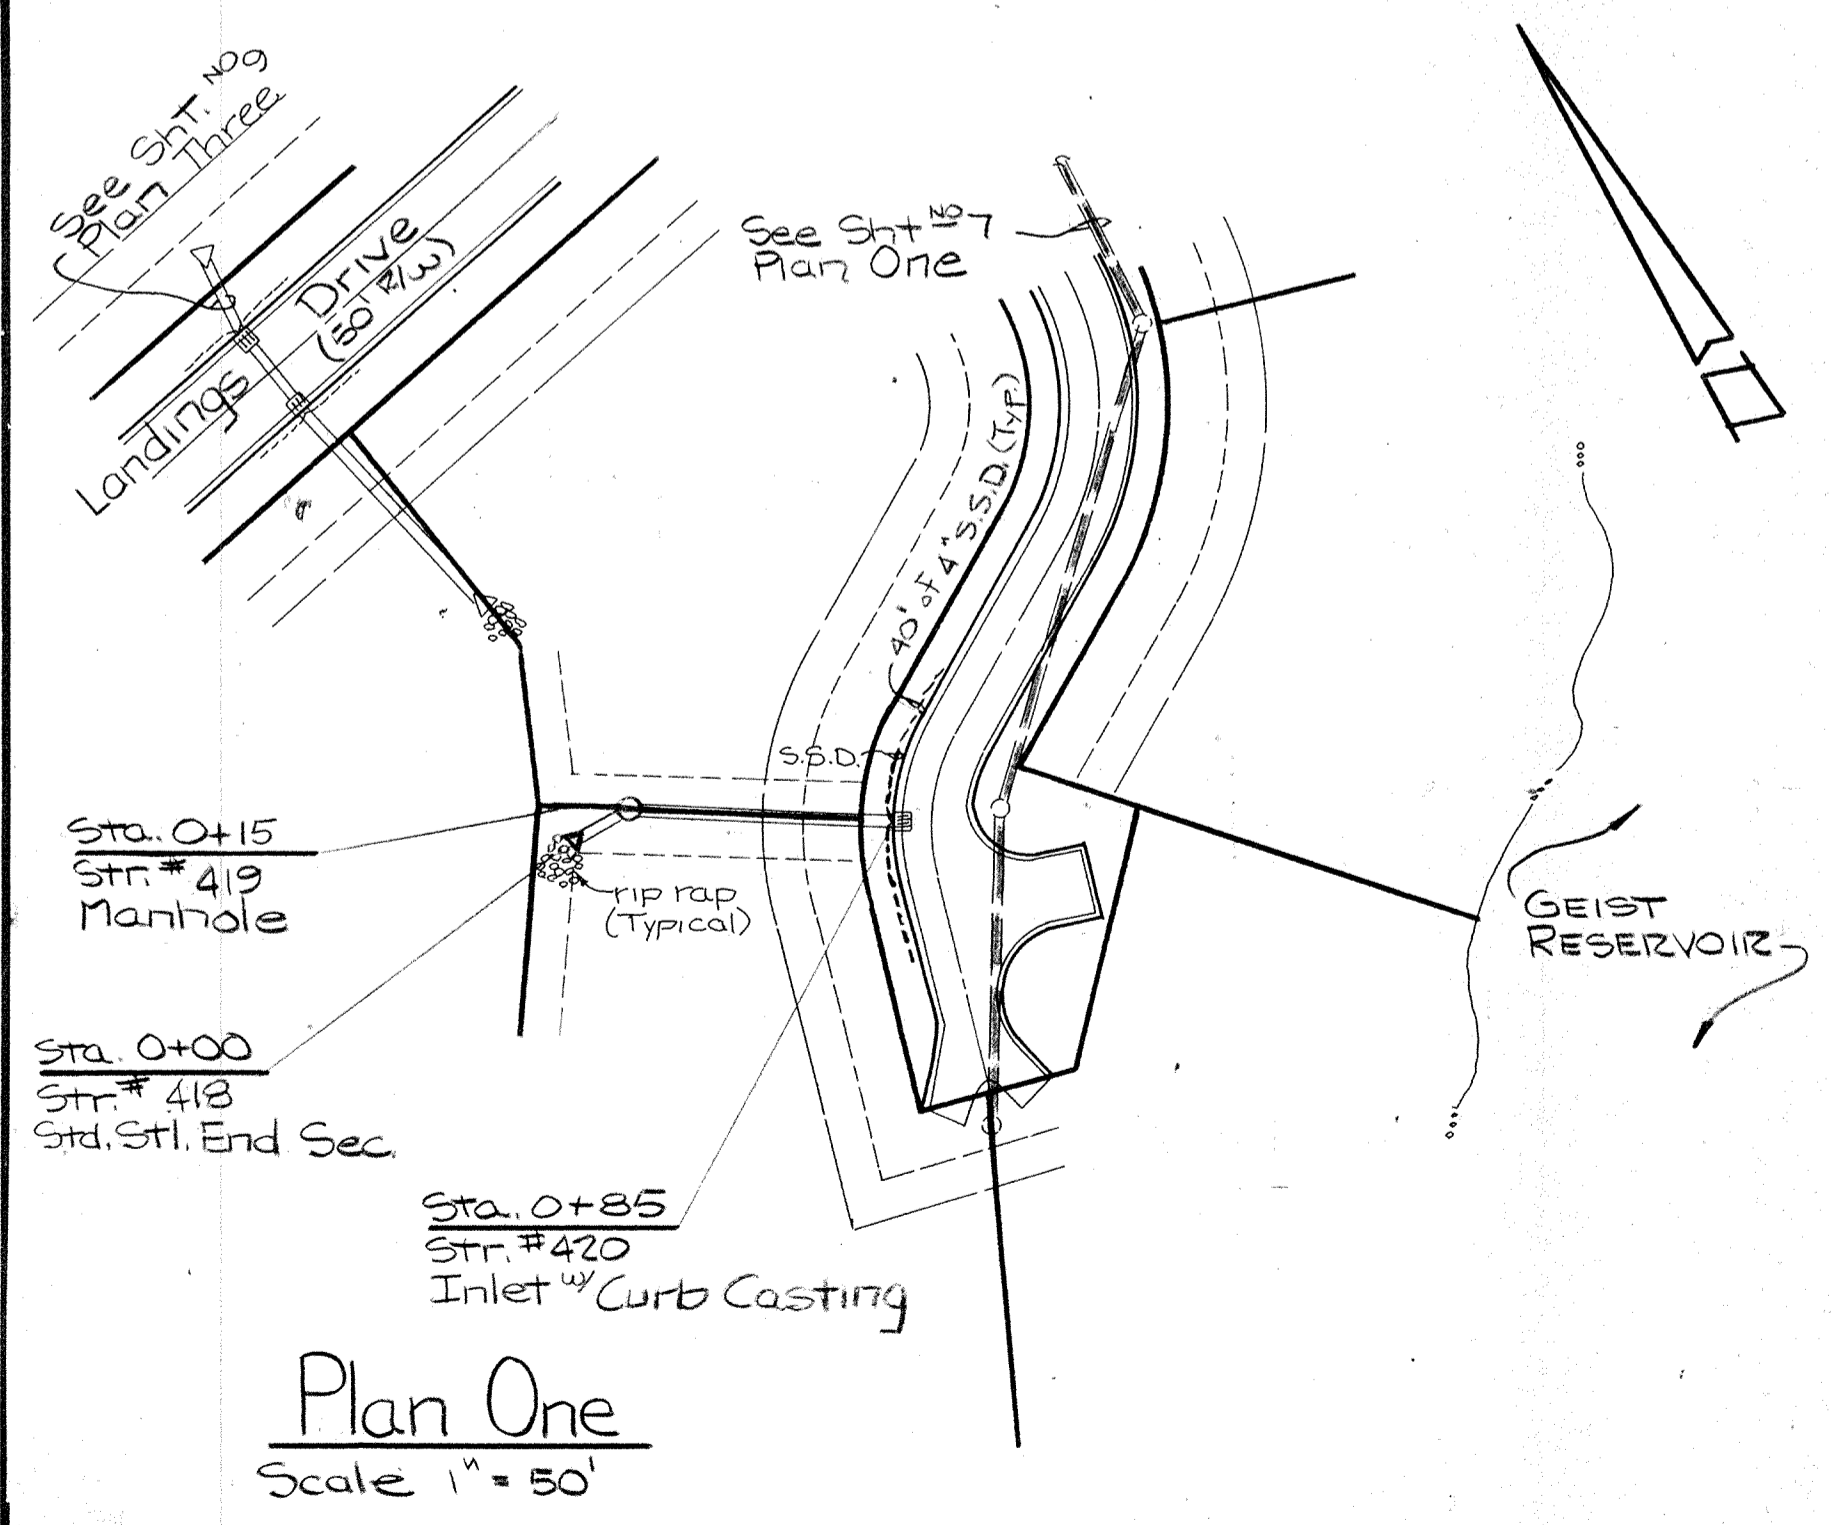


Plan One
Scale 1" = 50'



This information was gathered for input into the Hamilton County Geographical Information System. This document is considered an official record of the GIS.

Entry Date: 1-22-04

Entered by: JOH

CERTIFIED BY	REVISIONS	 PAUL I. CRIFE, INC. 7172 GRAHAM ROAD INDIANAPOLIS, INDIANA 46250 (317) 842-6777	TECH. CHK.	DRAWN BY GSD.	SCALE As Noted	DATE 1-30-04	CLIENT Masthead - Section 10	DWG. TYPE	FILE NUMBER	SHEET
DATE			• CIVIL ENGINEERING • LAND SURVEYING • ARCHITECTURE • LAND PLANNING	DFTNG. CHK.	DRAWING TITLE Storm Sewer ~ Plan & Profile				JOB NUMBER	10
								791000-110010	OF 13	