



SURVEYOR'S OFFICE
Hamilton County

Kenton C. Ward, CFM
Surveyor of Hamilton County
Phone (317) 776-8495
Fax (317) 776-9628

Suite 188
One Hamilton County Square
Noblesville, Indiana 46060-2230

Map Correction-Field Verification

Drain Number: 60

Drain Length: 5710'

Drain Name: County-McMahon
Ind. Amer. Filler Arm.

Change +/-: -330'

Date: 0-7-2-2015

New Length: 5380'

Verified By: SAB, SLM

Notes & Sketch: WO-2014-00410

American Filler Tile – Arm 1 was located and repaired, north of 206th street. Breather was set in 1991. I went and used GPS to map the breather.

It should also be noted that a portion of the ^{Ind.} American Filler Tile – main drain- was replaced in with open ditch. This occurred around 1976. This can be seen on the historical photography.

Suzanne L. Mills
GIS Specialist




This map was compiled by the Hamilton County Surveyor's Office. Although strict accuracy standards have been employed in the compilation of this map, Hamilton County does not warrant or guarantee the accuracy of the information contained herein and disclaims any and all liability resulting from any error or omission in this map.

#60 County McMahan Indiana Filler Arm

Printing Date: 06/24/2015
 Prepared By: Suzanne Mills, GISP
 Hamilton County Surveyor's Office
 One Hamilton County Square, Ste 188
 Noblesville, IN 46060
 317-776-8495




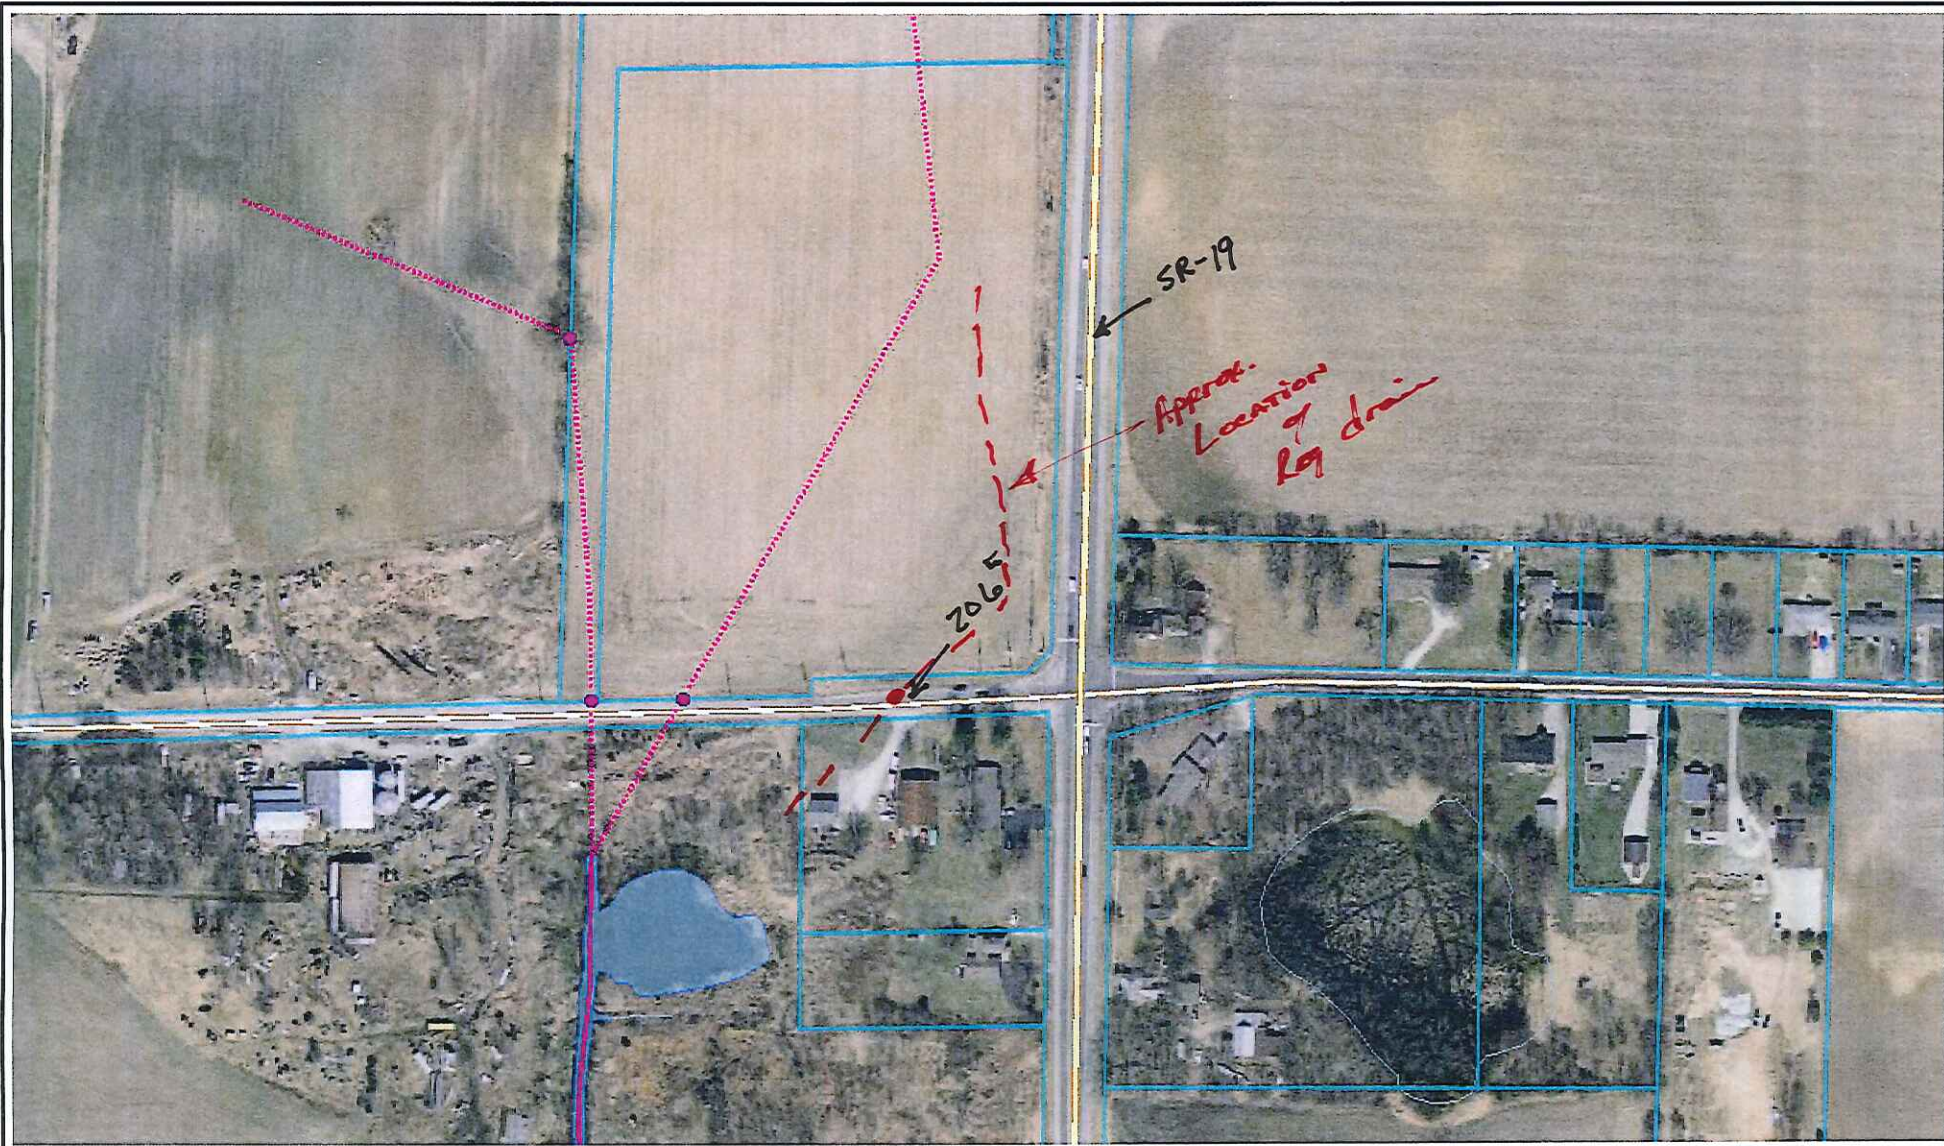

County McMahan Standing water in field

WO-2014-00410

Printed: Jun 15, 2015 - Steve Baitz

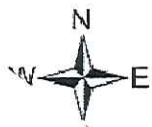

400

The information on this web site is provided and hosted by Hamilton County, Indiana. Continued use of this web site is conditional upon your explicit acceptance of the terms and conditions set forth in this disclaimer document. The data provided herein may be inaccurate and/or out of date. Any person or entity who relies on this data for any purpose whatsoever does so solely at their own risk. Neither Hamilton County Indiana nor its employees or officers warrant the accuracy, reliability, or timeliness of any of the data provided herein. This data is provided "as is" without warranty of any kind. Hamilton County may elect to discontinue this service without notice at any point in the future.

County of
Hamilton
Indiana
www.hamiltoncounty.in.gov

1976 Photo

S.R. 19

206th Street

1974 Photo

SR 19

206th Street