

Kenton C. Ward, CFM
Surveyor of Hamilton County
Phone (317) 776-8495
Fax (317) 776-9628

Suite 188
One Hamilton County Square
Noblesville, Indiana 46060-2230

Map Correction-Field Verification

Drain Number: #197

Drain Length: N/A

Drain Name: miller-Gustin & Ora Gustin Change +/-: N/A

Date: 5-16-2014

New Length: N/A

Verified By: SLM, LUTHER Gline

Notes & Sketch: See attached map & photos.

Structure on North side of 296th verified to be set on Regulated drain. Location of tile verified to be running on the east side of Rulon Rd. The outlet of the tile was also GPS'd & verified.

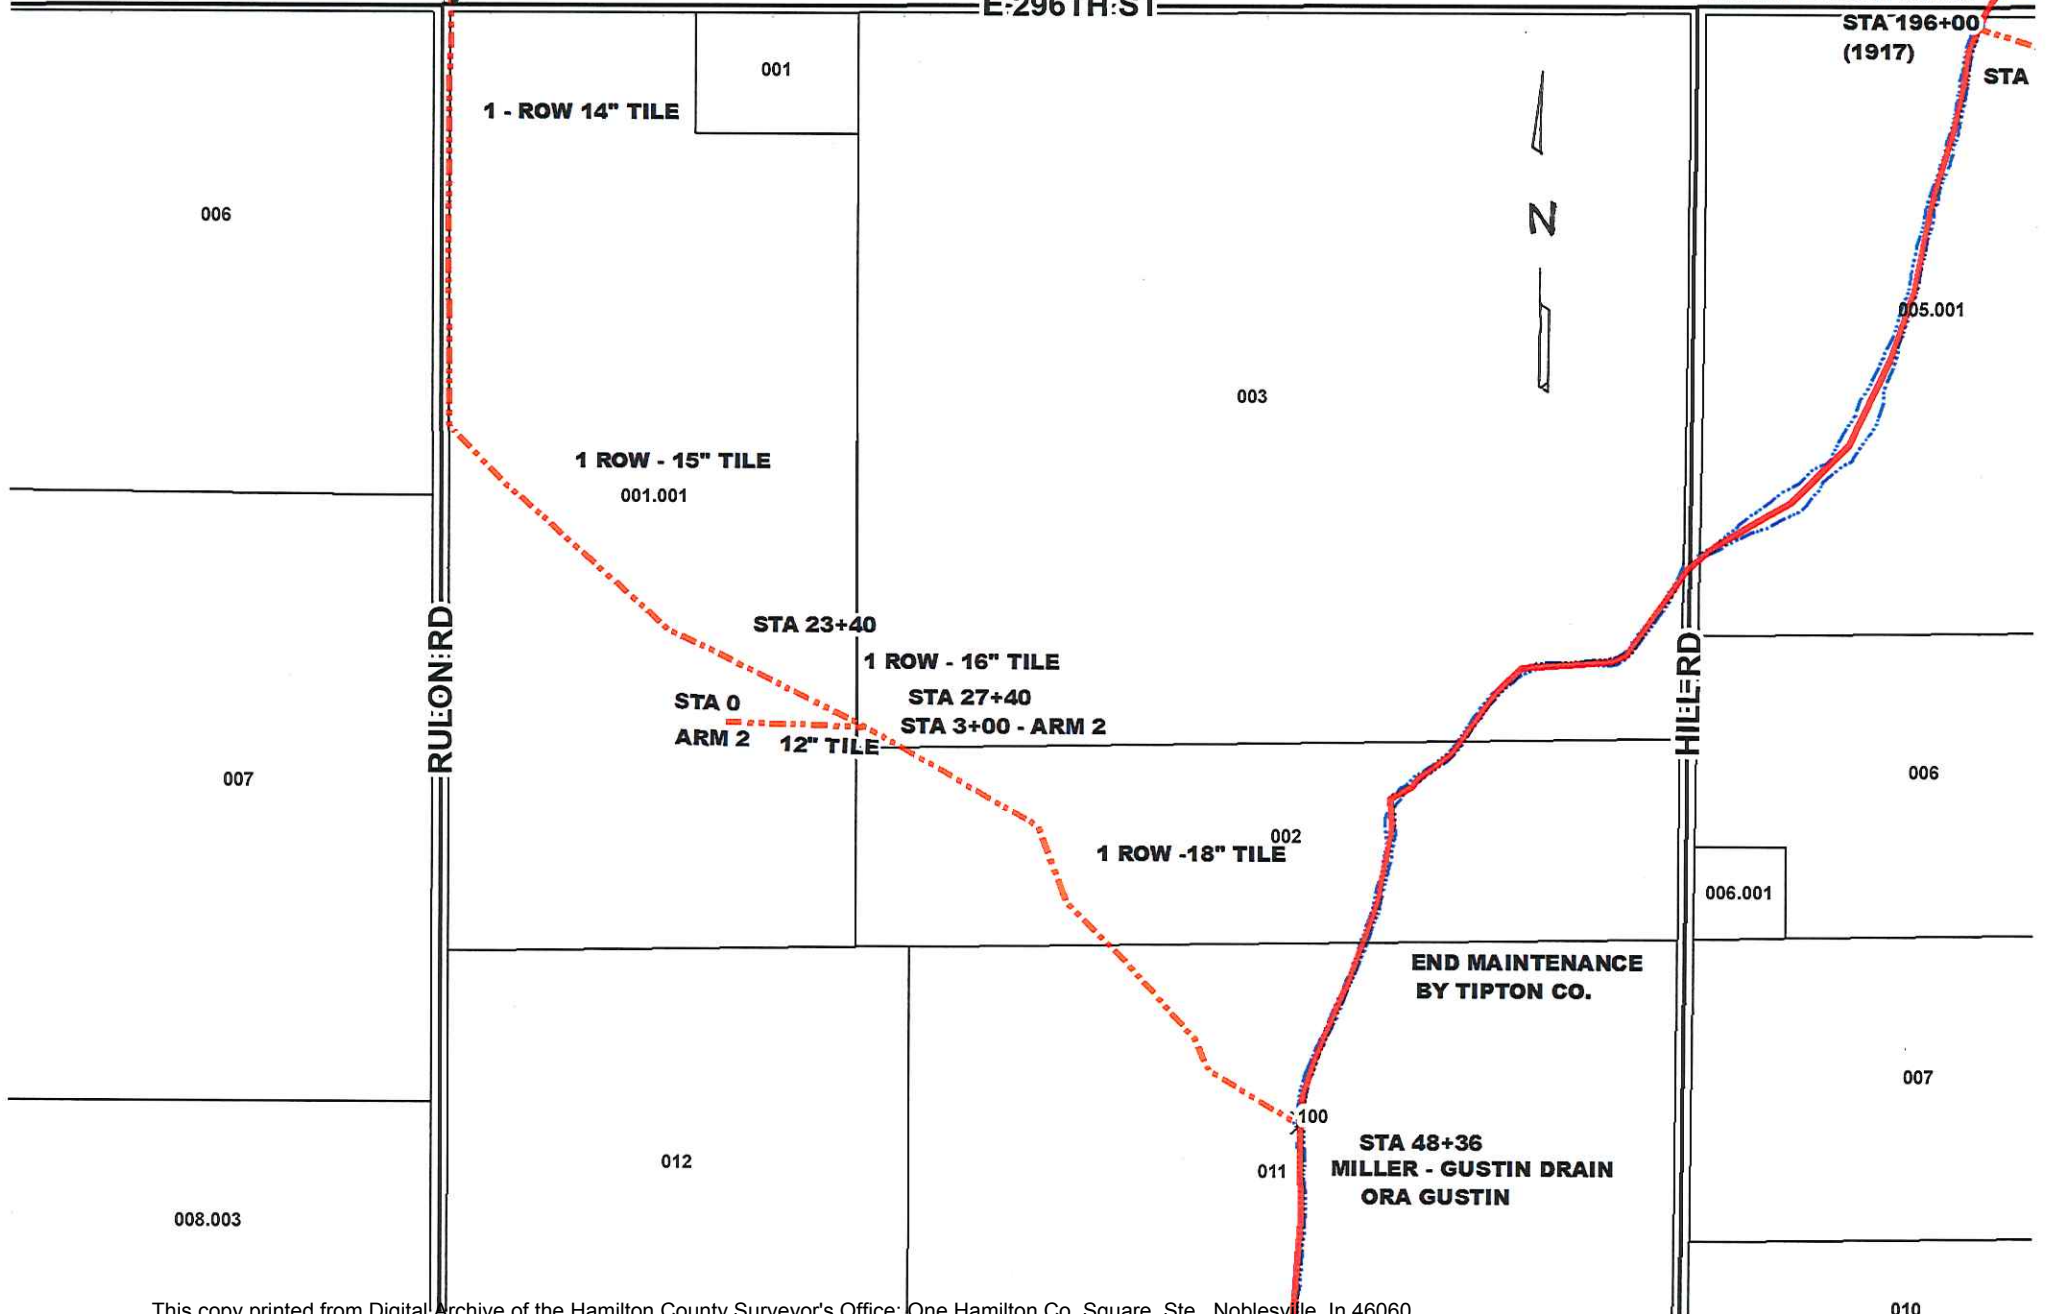

Suzanne L. Mills
GIS Specialist

5-16-2014
SLM

MILLER - GUSTIN DRAIN
ORA GUSTIN
STA 14+00

E-296TH-ST

HENRY BRIGHT DRAIN
STA 196+00
(1917)
STA



END MAINTENANCE
BY TIPTON CO.

STA 48+36
MILLER - GUSTIN DRAIN
ORA GUSTIN



Looking South AT Junction Str. & CMP under Co. Line



JUNCTION STR



Tile Outlet