

SURVEYOR'S OFFICE
Hamilton County

Kenton C. Ward, Surveyor

776-9626


Noblesville, Ind. 46060 August 12, 1985

To: Hamilton County Drainage Board

Re: U.G. Mitchner Drain


Attached is a outlet request from the Carmel-Clay Schools to outlet a storm sewer into the U.G. Mitchner Drain. Upon review of the request, I believe that the outlet will not overload the drain nor introduce harmful pollutants into it. Therefore, I recommend approval of the outlet.

I recommend inclusion of this system into the regulated drain system as an arm to the Mitchner when the Mitchner Drain is reconstructed. At this time the Mitchner Drain is number 33 on the reconstruction classification list.

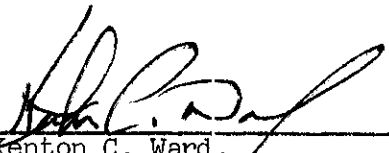

Kenton C. Ward,
Hamilton County Surveyor


KCW/jh

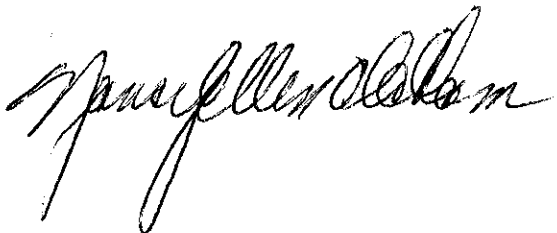

DATE	
HRS.	
MIN.	

DATE	
HRS.	
MIN.	
COMPOSITE SHT. NO'S	
INDIVIDUAL OVERLAY	
% SCREEN	

TRIM LINE

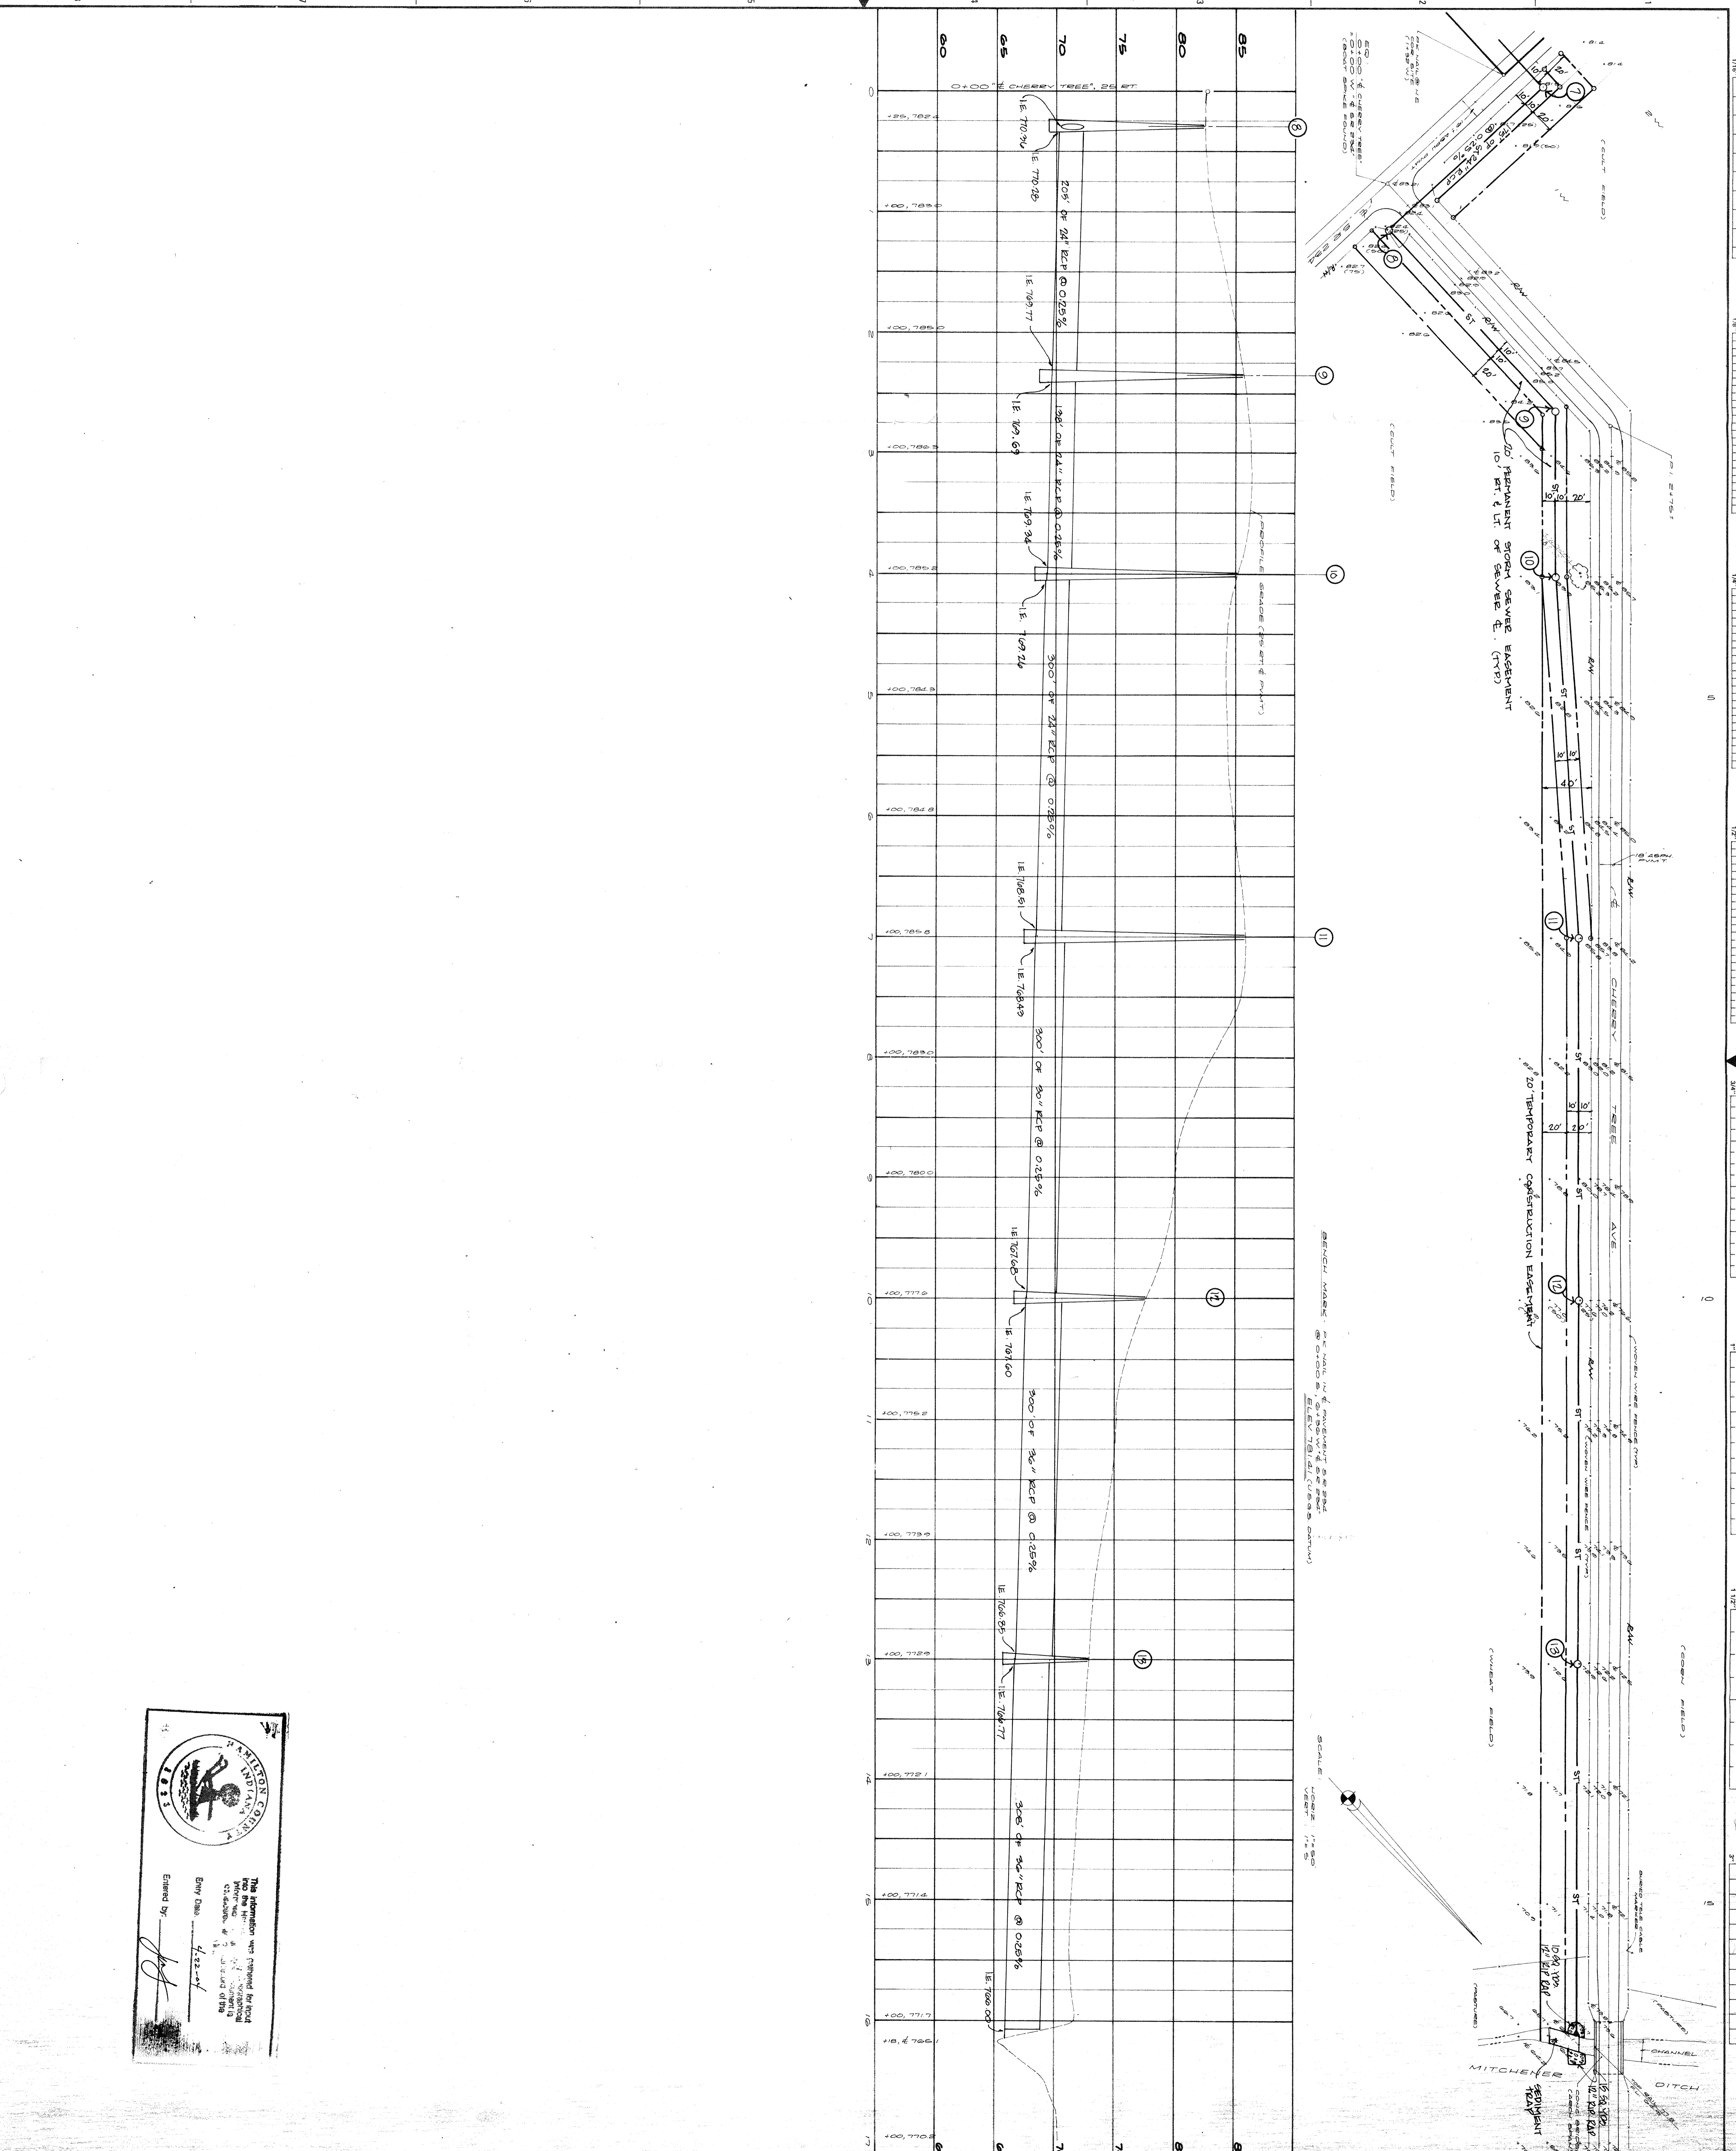

HAMILTON COUNTY
 1833
 The information was prepared for your use and is not to be construed as a warranty of the work of the engineer.

Drawn Date: 4-22-21
 Entered by: [Signature]