

Kenton C. Ward, Surveyor

Phone (317) 776-8495

Fax (317) 776-9628

Suite 188

One Hamilton County Square

Noblesville, Indiana 46060-2230

Map Correction-Field Verification

Drain Number: #129

Drain Length: N/A

Drain Name: Booth-Snead

Change +/-: N/A

Date: 4-4-05

New Length: N/A


Verified By: Steve Baitz & Jerry Liston

Notes & Sketch: See attached map.

Upon doing the final Report for the Waltrond Rd Sec. 4 drain, it was reflected on the asbuilts the location of the Booth-Snead Drain. The map was changed based upon this asbuilt & the field verifications of the above listed inspectors.

Suzanne L. Mills

Suzanne L. Mills
GIS Specialist

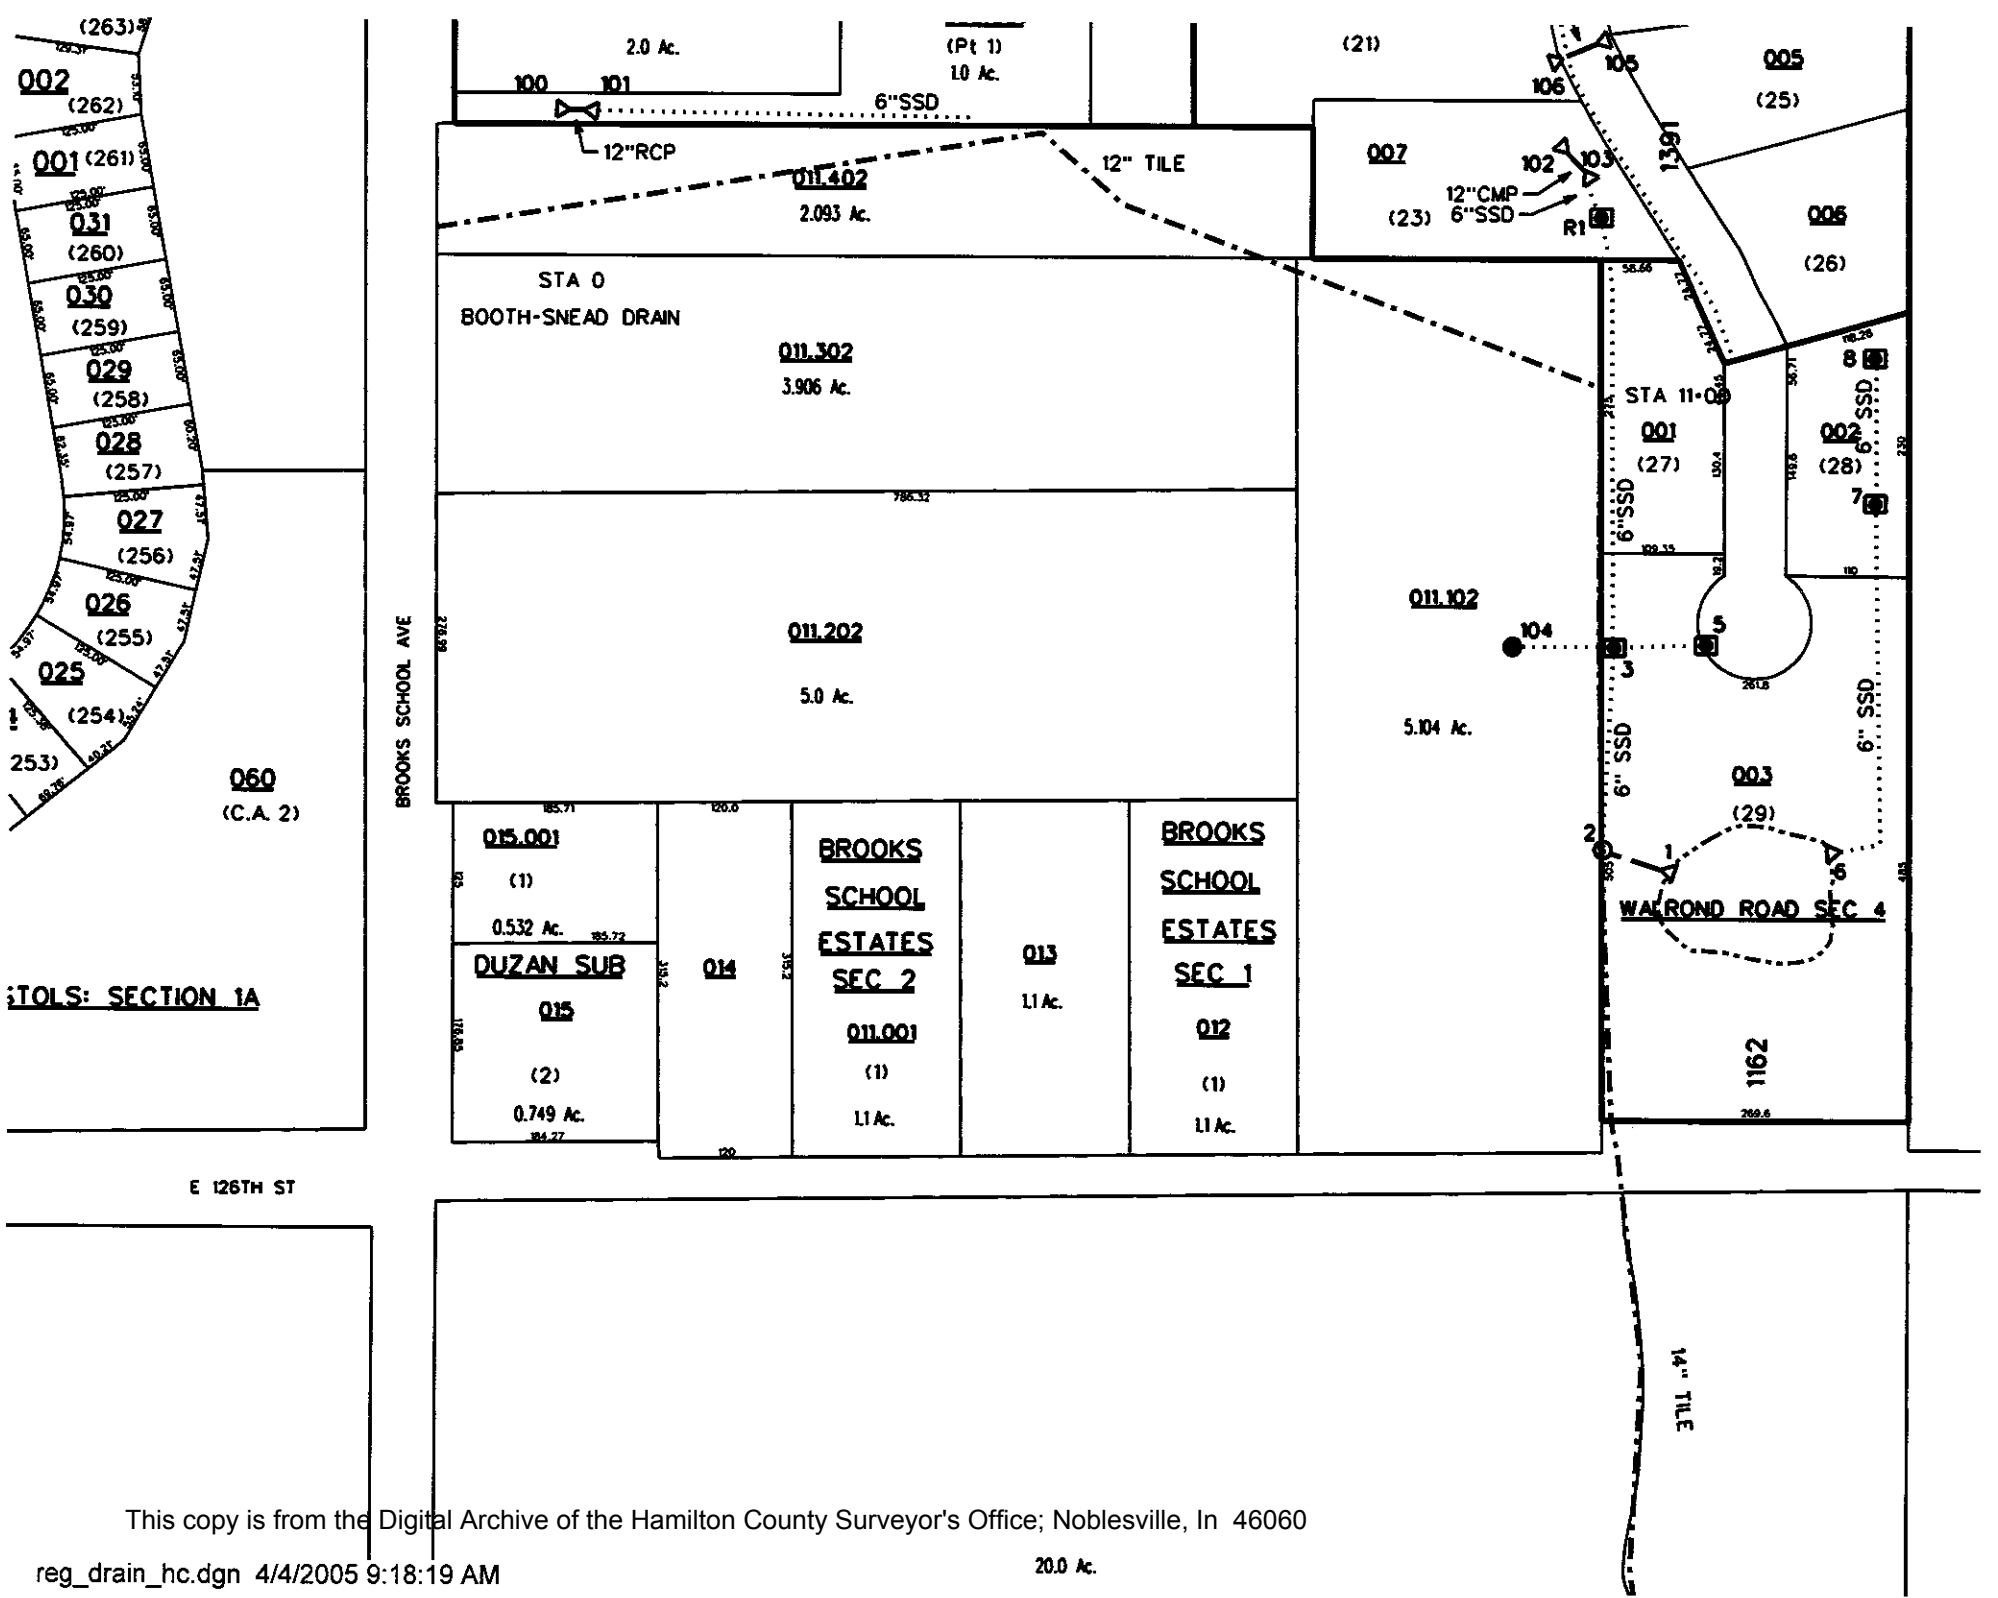

TOOLS: SECTION 1A

E 126TH ST

This copy is from the Digital Archive of the Hamilton County Surveyor's Office; Noblesville, In 46060

reg_drain_hc.dgn 4/4/2005 9:18:19 AM

20.0 Ac.

reg_drain_hc.dgn 4/4/2005 9:17:45 AM

