

Kenton C. Ward, CFM Surveyor of Hamilton County Phone (317) 776-8495 Fax (317) 776-9628 Suite 188 One Hamilton County Square Noblesville, Indiana 46060-2230

Map Correction-Field Verification

Drain Number: #347 Drain Length: 9920

Drain Name: EE Bennett Drain **Change + / - : -320**

Date: 07-22-2020 **New Length:** 9600


Verified By: SLM, SAB; WO-2019-00179; WO-2020-00082

Notes & Sketch:

This tile was repaired and located by the above listed work orders. The attached map shows where the two rows of 7" tile was connected to the 12" tile with a blue dot. This is noted in the legal description as station 35+00. (See McCarty & Wiseman Arm) The yellow dots show the GPS locations collected. The GPS locate and repair at Station 35 brought to light the transcription error within the legal description. Thus, the previous mapping erroneously represented the location of the two rows of 7".

Through this process, it was discovered there was a mathematical error on the downstream stationing of the tile. The station was calculated to show 320 feet more than what is there. However, the correct amount of tile was removed from the GASB 34 inventory. This error was made in the 2007 Noblesville Corporate Campus final report. The outlet of the tile is not 99+20 but should be Station 96+00.

Suzanne L. Mills GIS Specialist

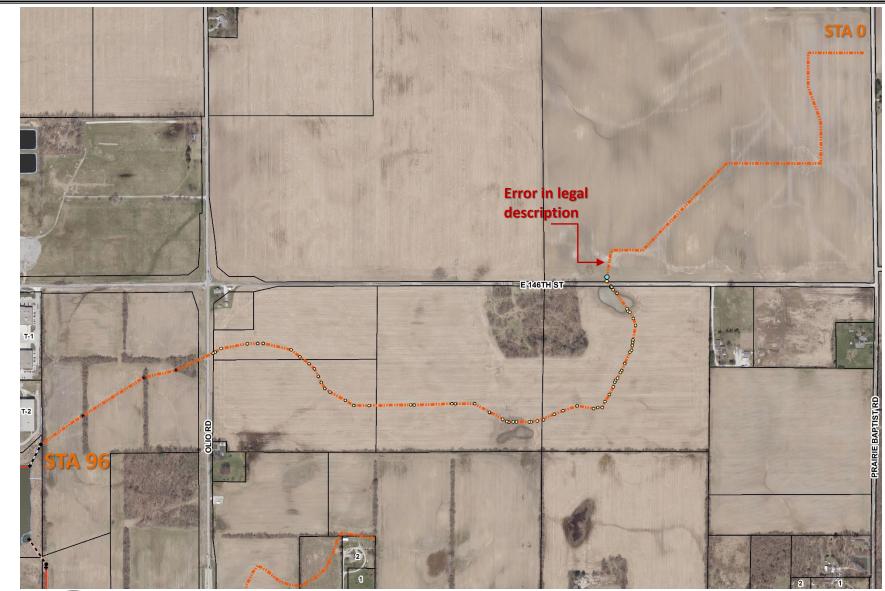



This map was compiled by the Hamilton County Surveyor's Office. Although strict accuracy standards have been employed in the compilation of this map, Hamilton County does not warrant or guarantee the accuracy of the information contained herein and disclaims any and all liability resulting from any error or omission in this map.

E.E. Bennett #347

GPS Locate
Tie in of 2 -7" Tiles

Printing Date: 05/19/2020 Prepared By: Suzanne Mills, GISP Hamilton County Surveyor's Office One Hamilton County Square, Ste 188 Noblesville, IN 46060 317-776-8495



to be coffection therein and all and adjusted to be confitted the lands to be deflicted thereby and after coursing the meaning tures and examinations the made they determined that the best Dana Chapest methow of drainage should be as follows, towit: By the construction of a ditch commencery 45 rous Souto of the both Court courses of the South East quarter Dection 13 7/18/25 theme south 330 feel themen West 75 o feet themen & 44° W. 930 feet themen & 44° W. 930 feet themen & 44° W. 930 feet themen and sun thence West 4,40 fect thence south 270 feet thener S. 20 6 500 Med 250 feet then a 90 W. 220 feet then en & 42 2 % 300 feet them en d. 116. 100 fut, there & 18th Bookers there & Igh have fit there &. 572 W loooful then & N. 642 W. 400 fett. then what lott of the When w of 69 h 260 fol then No. 2 M 500 feet there But 500 feet there Doute south the 0.65 M. 200 for the e dy 7 2 \$ 5200 there 0552 W 550 feet should then & 8 30 M. 300 feet the Next 500. feet them & 30° M 500 feet thenes douth 300 for theme & 66'N. 200 feet there A. 800 M. worfeet 59° W there to green, 500. Union A. 41 h 400 fort thought 74th 530 fet there A. 41 M. 350 feet them & 80° M. 400 feet there A 80° M. 400 fut them West goodut them I. 83' h. 300 fut and temmetry in Sund crute Ditch near the both but comer of du touch tout quick of the North Court quarte of section 22 % 18 1. 5.

Gasb 34 Calculations Asset Removal

Drain:	#347 EE Ben	nett Drain			_	
Improvement:	Main Ditch	& Kinnam	on Arm	=	_	
Sta/Strs:	Sta 99+20 t	to Sta 163+	-20, Sta 23+0	01 to Sta 30	<u>+01</u>	
					Calculat	ion
Drain Type:	Size:	Length Reported	Length (GIS Query)	Price:		Cost:
TILE	24"	660		\$11.00LF	· ·	\$7,260.00
TILE	18"	4820		\$6.50LF	\$	31,330.00
TILE	15"	1240		\$5.00LF	\$	6,200.00
ARM						
TILE	12"	700	-700	\$4.00 LF	\$	2,800.00
					-	
Sum:						\$47,590.00
Historical Cost or Improvement Value:						\$97,014.00
Value Removed:					\$	(47,590.00
New Value or New Historical Value:					E	\$49,424.00
Old Graduated Value:					\$	5,820.84
New Graduated Value:						\$2,965.44
Comments:	- 4b d 1		Janvilla Ocean	Communication of the Communica		
Removed due t	o the developi	nent of Nob	ilesville Corp (Jampus	Manager	

* Math Error