



Kenton C. Ward, CFM Surveyor of Hamilton County Phone (317) 776-9628 Fax (317) 776-9628

Suite 188 One Hamilton County Square Noblesville, Indiana 46060-2230

Map Correction-Field Verification

Drain Number: #347 (Mud Creek-Sand Creek)

Drain Length: n/a

Drain Name: Springdale Est. Ext

Change +/-: n/a

Date: 05-12-2010


New Length: n/a

Verified By: SAB & GRH

Notes & Sketch: (see attached map)

Manholes between Structures 14-10 were located in the field and the drain was mapped per field location. It should be noted that the shift did not affect the overall length of drain.

Suzanne L. Mills GIS Specialist

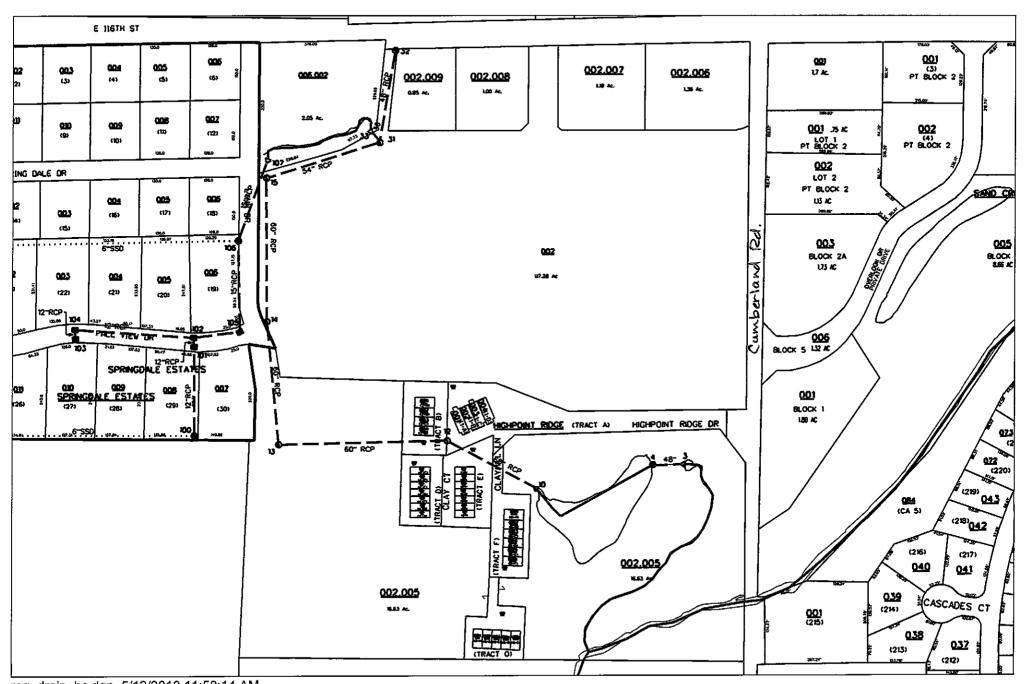

reg_drain_hc.dgn 5/12/2010 11:58:14 AM