

Drain: F M Musselman

Drain #: 234

Improvement/Arm: ~~Ridgebrush Woods - Peterson Arm Ext.~~

Operator: J. LIVINGSTON

Date: 4-27-04

Drain Classification: Urban/Rural **Year Installed:** 1999

GIS Drain Input Checklist

- Pull Source Documents for Scanning
- Digitize & Attribute Tile Drains
- Digitize & Attribute Storm Drains
- Digitize & Attribute SSD
- Digitize & Attribute Open Ditch
- Stamp Plans
- Sum drain lengths & Validate
- Enter Improvements into Posse
- Enter Drain Age into Posse
- Sum drain length for Watershed in Posse
- Check Database entries for errors

fjf

N/A

Sam / jfj

N/A

N/A

Sam / jfj

jfj

Sam

jfj

jfj

jfj

Gasb 34 Footages for Historical Cost Drain Length Log

Drain-Improvement: F M MUSSELMAN - ROUGEBUSH WOODS - PETERSON AVE. EXT.

Sum: 1320' 1320' _____ \$116,135.25

Final Report: 1326

Comments:



SURVEYOR'S OFFICE
Hamilton County

Kenton C. Ward, Surveyor

Phone (317) 776-8495

Fax (317) 776-9628

Suite 146
One Hamilton County Square
Noblesville, Indiana 46060-2230

To: Hamilton County Drainage Board

July 30, 1999

Re: F. M. Musselman Drain, Peterson Arm Extension

Attached is a petition, non-enforcement request, plans, calculations, quantity summary and assessment roll for the extension of the Peterson Arm, F. M. Musselman Drain. I have reviewed the submittals and petition and have found each to be in proper form.

I have made a personal inspection of the land described in the petition. Upon doing so, I believe that the drain is practicable; will improve public health; benefit a public highway and be of public utility; and that the costs, damages and expenses of the proposed drain will probably be less than the benefits accruing to the owners of land likely to be benefited. The drain will consist of 1,313 feet of 42" RCP. The sections of storm sewer involved are those portions of the 42" RCP between 191st Street and the structure located at the South end of the 66" RCP installed in The Meadows subdivision.


This extension is as per the agreement set out in the resolution by the Board at its meeting on October 27, 1997 (Drainage Board Minutes Book 4, Pages 454-455). This agreement is the basis of my drain report which was approved at hearing on January 26, 1998 (Book 4, Pages 496-499) and the final agreement which was signed by the Board on August 24, 1998 (Book 4, Page 582).

I believe this proposed drain meets the requirements for Urban Drain Classification as set out in IC 36-9-27-67 - 69. Therefore, this drain shall be designated as an Urban Drain.

I recommend that upon approval of the above proposed drain that the Board also approve the attached non-enforcement request. This request is for the reduction of the regulated drain easement to those easement widths as shown on the secondary plat for

Roudebush Woods, Section 1 as recorded in the office of the Hamilton County Recorder.

I recommend the Board set a hearing for this proposed drain for September 27, 1999.

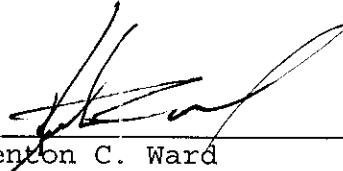

Kenton C. Ward
Hamilton County Surveyor

KCW/lm

STATE OF INDIANA)
)
COUNTY OF HAMILTON)

TO: HAMILTON COUNTY DRAINAGE BOARD
 % Hamilton County Surveyor, Courthouse, Noblesville, IN 46060

In the matter of Roudebush Woods Subdivision,
Section One Drain Petition.

Petitioner is the owner of all lots in the land affected by the proposed new regulated drain. The drainage will affect various lots in Roudebush Woods, a subdivision in Hamilton County, Indiana. The general route of such drainage shall be in existing easements and along public roads as shown in the plans on file in the Surveyor's Office.

Petitioner believes that the cost, damages and expenses of the proposed improvement will be less than the benefits which will result to the owners of the land likely to be benefited thereby. Petitioner believes the proposed improvements will:

- (a) improve public health
- (b) benefit a public street
- (c) be of public utility

Petitioner agrees to pay the cost of construction of the drainage system and requests periodic maintenance assessments by the Board thereafter.

The Petitioner also agrees to the following:

1. To provide the Drainage Board a Performance Bond for the portion of the drainage system which will be made a regulated drain. The bond will be in the amount of 100% of the Engineers estimate. The bond will be in effect until construction of 100% of the system is completed and so certified by the Engineer.
2. The Petitioner shall retain an Engineer throughout the construction phase. At completion of the project the Petitioner's Engineer shall certify that the drainage system which is to be maintained as a regulated drain has been constructed as per construction plans.

JUL 17 1998

SURVEYOR

3. The Petitioner agrees to request in writing to the County Surveyor any changes from the approved plan and must receive written authorization from the County Surveyor prior to implementation of the change. All changes shall be documented and given to the Surveyor to be placed in the Drain File.
4. The Petitioner shall instruct his Engineer to provide a reproducible print on a 24" x 36" mylar of the final design of the Drainage System. This shall be submitted to the County Surveyor prior to the release of the Performance Bond.
5. The Petitioner shall comply with the Erosion Control Plan as specified on the construction plans. Failure to comply with the Erosion Control Plan shall be determined by the Board as being an obstruction to the drainage system. The County Surveyor shall immediately install or repair the needed measures at Petitioners cost as per IC 36-9-27-46.

The Petitioner further requests that the Drain be classified as an Urban Drain.


Signed

Corby D. Thompson, C.D.O.
Printed Name

Corby D. Thompson, C.D.O.
Signed

Printed Name

RECORDED OWNER(S) OF LAND INVOLVED

DATE 6/17/93

APPROVED
JUL 17 1993
Hamilton County Surveyor's Office
SHERIFF

FINDINGS AND ORDER
CONCERNING THE MAINTENANCE OF THE
F. M. Musselman, Peterson Arm, Roudebush Woods Section 1

On this **27th day of September 1999**, the Hamilton County Drainage Board has held a hearing on the Maintenance Report and Schedule of Assessments of the **F. M. Musselman, Peterson Arm, Roudebush Woods Section 1**.

Evidence has been heard. Objections were presented and considered. The Board then adopted the original/amended Schedule of Assessments. The Board now finds that the annual maintenance assessment will be less than the benefits to the landowners and issues this order declaring that this Maintenance Fund be established.

HAMILTON COUNTY DRAINAGE BOARD



President



Member



Member

Attest:



CERTIFICATE OF COMPLETION AND COMPLIANCE

To: Hamilton County Surveyor

Re: ROUDEBUSH WOODS, SECTION 1

I hereby certify that:

1. I am a Registered Land Surveyor or Engineer in the State of Indiana .
2. I am familiar with the plans and specifications for the above referenced subdivision .
3. I have personally observed and supervised the completion of the drainage facilities for the above referenced subdivision .
4. The drainage facilities within the above referenced subdivision to the best of my knowledge , information and belief have been installed and completed in conformity with all plans and specifications .

Signature: J. Cort Crosby Date: 6/21/00

Type or Print Name: J. CORT CROSBY P.E., THE SCHNEIDER CORP

Business Address: 3020 N. POST ROAD

INDIANAPOLIS, IN 46226

Telephone Number: (317) 898-8282


SEAL



INDIANA REGISTRATION NUMBER

920350

Revised 10/95

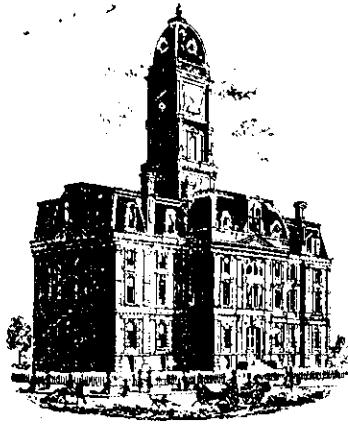

Kenton C. Ward, Surveyor

Phone (317) 776-8495

Fax (317) 776-9628

Suite 188

One Hamilton County Square

Noblesville, Indiana 46060-2230

To: Hamilton County Drainage Board

October 9, 2000

Re: F.M. Musselman Drain: Roudebush Woods
Peterson Arm Extension

Attached are as-builts, certificate of completion & compliance, and other information for Roudebush Woods – Peterson Arm Extension. An inspection of the drainage facilities for this section has been made and the facilities were found to be complete and acceptable.

During construction, changes were made to the drain that will alter the plans submitted with my report for this drain-dated July 30, 1999. The changes are as follows:

Structure: T.C.: I.E.: Pipe: Length: Original Plans: Difference:

Structure:	T.C.:	I.E.:	Pipe:	Length:	Original Plans:	Difference:
101E	786.54	774.94				
101	788.46	778.16	42	26		
101	788.46	776.76				
103	791.6	781.2	42	261		
103	791.6	777.85				
104	794.38	778.58	42	222	217	5
104	794.38	778.58				
105	794.45	778.65	42	30		
105	794.45	778.65				
106	794.53	780.73	42	148	150	-2
106	794.53	778.83				
112	795.68	779.06	42	152	150	2
112	795.68	779.06				
113	765.68	779.12	42	30		
113	765.68	779.12				
114	793.92	781.32	42	195	199	-4
114	793.92	779.62				
121	794.13	785.33	42	256	250	6


The length of the drain due to the changes described above is now **1320 feet**.

The non-enforcement was approved by the Board at its meeting on October 11, 1999 and recorded under instrument #2000-00004047.

The bond or letter of credit from Frontier Insurance Company number 143547; in the amount of \$116,135.000; was released September 25, 2000.

I recommend the Board approve the drain's construction as complete and acceptable.

Sincerely,

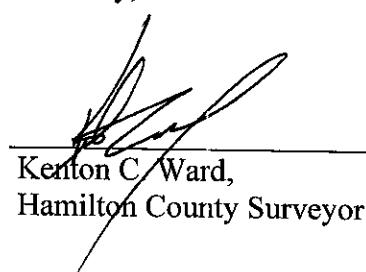


Kenton C. Ward,
Hamilton County Surveyor

KCW/slm

GENERAL NOTES

- ALL GRADES AT BOUNDARY SHALL MEET EXISTING GRADES.
- IT SHALL BE THE RESPONSIBILITY OF EACH SUBCONTRACTOR TO VERIFY ALL EXISTING UTILITIES AND CONDITIONS PERTAINING TO HIS PHASE OF WORK. IT SHALL ALSO BE THE SUBCONTRACTOR'S RESPONSIBILITY TO CONTACT THE OWNERS OF THE VARIOUS UTILITIES FOR PROPER STAKE LOCATION OF EACH UTILITY BEFORE WORK IS STARTED. THE SUBCONTRACTOR SHALL NOTIFY IN WRITING THE OWNER AND THE ENGINEER OF ANY CHANGES, OMISSIONS, OR ERRORS FOUND ON THESE PLANS OR IN FIELD BEFORE WORK IS STARTED OR RESUMED.
- STANDARD SPECIFICATIONS FOR THE CITY OF NOBLESVILLE, INDIANA SHALL APPLY FOR ALL SANITARY AND STORM SEWERS.
- ANY PART OF THE SANITARY OR STORM SEWER TRENCHES RUNNING UNDER PAVED AREAS TO BE BACKFILLED WITH GRANULAR MATERIAL.
- THE SIZE AND LOCATION OF EXISTING UTILITIES SHOWN ARE PER INFORMATION PROVIDED BY THE RESPECTIVE UTILITY COMPANIES. ALL UTILITY COMPANIES SHOULD BE NOTIFIED PRIOR TO ANY EXCAVATION FOR FIELD LOCATION OF SERVICES.
- SERVICE WALKS SHALL BE NON-REINFORCED CONCRETE 4" THICK AND 4' IN WIDTH.
- 4' CONCRETE SERVICE WALK ACROSS FRONTAGE OF EACH LOT TO BE CONSTRUCTED BY OTHERS.
- EXPANSION JOINTS ARE TO BE PLACED AT ALL WALK INTERSECTION AND BETWEEN WALKS AND PLATFORMS. SIDEWALK SPACES ARE TO BE EQUALLY SPACED BETWEEN EXPANSION JOINTS. CONTRACTION JOINTS AND PERPENDICULAR SIDEWALKS AT 5' INTERVALS OR LESS WITH A CONTRACTION JOINT EVERY 20' OR LESS.
- TEMPORARY TRAFFIC CONTROL DURING CONSTRUCTION TO CONFORM TO APPLICABLE LOCAL AND STATE STANDARDS.
- ALL CONSTRUCTION ACTIVITY ON THIS SITE TO BE PERFORMED IN COMPLIANCE WITH APPLICABLE O.S.H.A. STANDARDS FOR WORKER SAFETY.
- CONTRACTOR SHALL MINIMIZE DAMAGE TO EXISTING TREES.

ASSUMED NORTH
SCALE: 1"=50'

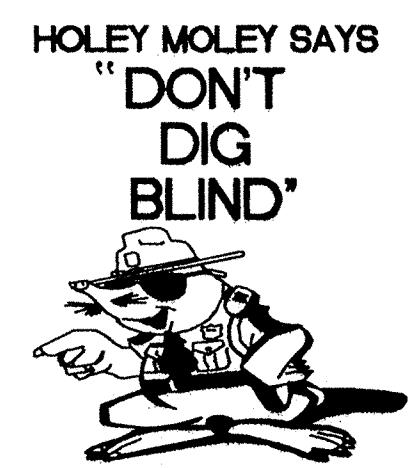

"IT'S THE LAW"
CALL 2 WORKING DAYS BEFORE YOU DIG
1-800-382-5544

CALL TOLL FREE
PER INDIANA STATE LAW IS-69-1991.
IT IS AGAINST THE LAW TO EXCAVATE
WITHOUT NOTIFYING THE UNDERGROUND
LOCATION SERVICE TWO (2) WORKING
DAYS BEFORE COMMENCING WORK.

UTILITIES - NOBLESVILLE

Gas

Indiana Gas
16000 Millcreek Road
Noblesville, Indiana 46060
(317) 776-5531
Attn: Jim Reuck

Electric

Cinergy
100 South Mill Creek Road

Noblesville, Indiana 46060

(317) 776-5327

Attn: Rick Griffin

Sanitary Sewer

Indiana-American Water

Company, Inc.

835 Wayne Street

Noblesville, Indiana 46060-1987

(317) 773-2497

Attn: Tim Lee

Telephone

Americitech

5658 North College Ave.

Indianapolis, Indiana 46220

(317) 256-3330

Attn: Greg Commark

Cable Television

Insight Communications

15220 Stoney Creek Way

Noblesville, Indiana 46060

(317) 776-6330

Attn: Engineering

Streets

City of Noblesville

16 South 10th Street

Noblesville, Indiana 46060

(317) 776-6330

Attn: Engineering

Utility Hotline: within Indiana 1-800-382-5544

outside Indiana 1-800-428-5200

NOTE
The size and location of utilities are per plans and locations provided by the respective utility companies. All utility companies shall be notified prior to any excavation for field location of services.

LEGEND

- Existing Storm Sewer
- New Storm Sewer
- Existing Sanitary Sewer
- New Sanitary Sewer
- Existing Contour
- New Pavement Grade
- All Other Finish Grades
- Storm Structure Number
- Sanitary Structure Number
- Flow Arrow
- Denotes Elevation and Approximate Pad Size



CERTIFIED BY
10/14/99
THIS DRAWING AND THE IDEAS, DESIGNS AND CONCEPTS CONTAINED HEREIN ARE THE EXCLUSIVE PROPERTY OF THE SCHNEIDER CORPORATION AND MAY NOT BE USED OR COPIED IN WHOLE OR IN PART, WITHOUT THE WRITTEN CONSENT OF THE SCHNEIDER CORPORATION.

1999, The Schneider Corporation



The
Schneider
Corporation

3020 North Post Road
Indianapolis, Indiana 46226-6518
317-898-8282
317-899-8010 Fax
Engineering
Surveying
Landscape Architecture
GIS / LIS
Geology


Formerly Schneider Engineering Corp. / Bohlen, Meyer, Gibson & Assoc.

THOMPSON LAND COMPANY, INC.
ROUDEBUSH WOODS SECTION 1
NOBLESVILLE, INDIANA

DEVELOPMENT PLAN

Date	Project No.	Drawn	Approved
5/04/99	1025.11	PRC	

Computer Files
J:\1025\DWGS\11\1C101
XREF: 11BS
XREF: J:\1025\DWGS\12\12BS
XREF: J:\1025\DWGS\1025TOP0
FILED C101 5/04/99
OFFICE OF HAMILTON COUNTY SURVEYOR

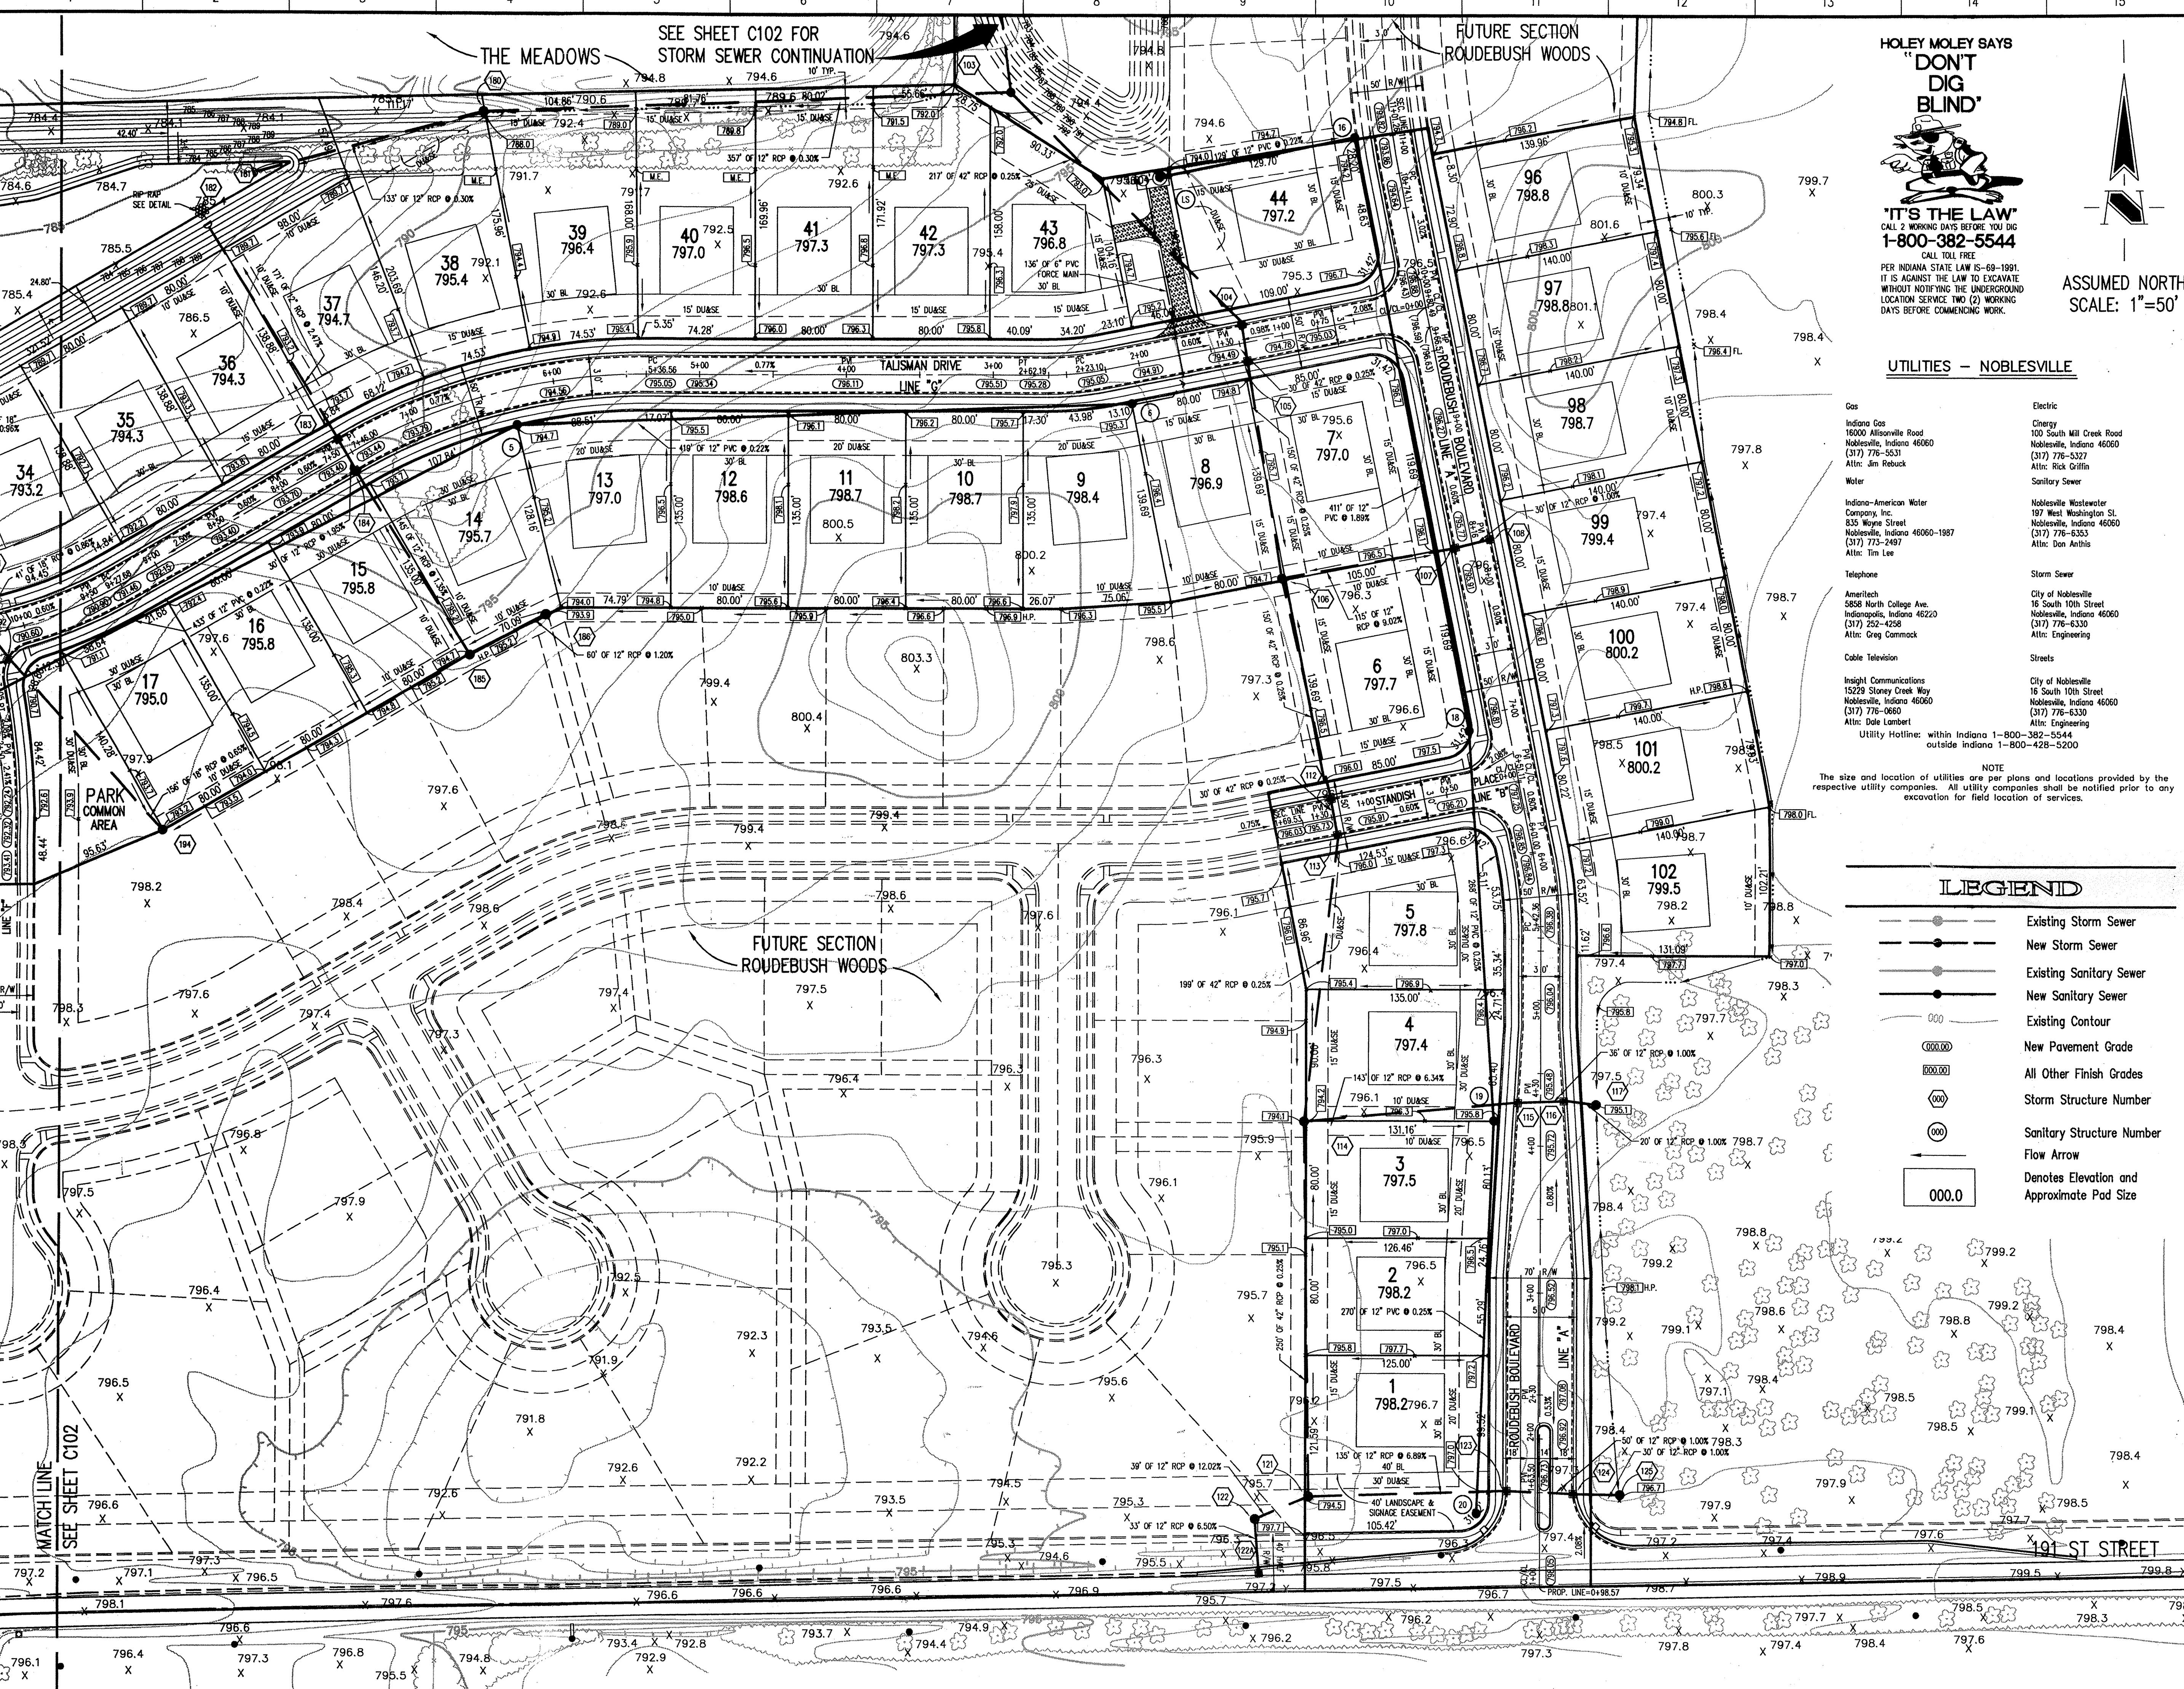

GENERAL NOTES

- ALL GRADES AT BOUNDARY SHALL MEET EXISTING GRADES.
- IT SHALL BE THE RESPONSIBILITY OF EACH SUBCONTRACTOR TO VERIFY ALL EXISTING UTILITIES AND CONDITIONS PERTAINING TO HIS PHASE OF WORK. IT SHALL ALSO BE THE SUBCONTRACTOR'S RESPONSIBILITY TO CONTACT THE OWNERS OF THE VARIOUS UTILITIES FOR PROPER STAKE LOCATION EACH UTILITY BEFORE WORK IS STARTED. THE SUBCONTRACTOR SHALL NOTIFY IN WRITING THE OWNER AND THE ENGINEER OF ANY CHANGES, OMISSIONS, OR ERRORS FOUND ON THESE PLANS OR IN FIELD BEFORE WORK IS STARTED OR RESUMED.
- STANDARD SPECIFICATIONS FOR THE CITY OF NOBLESVILLE, INDIANA SHALL APPLY FOR ALL SANITARY AND STORM SEWERS.
- ANY PART OF THE SANITARY OR STORM SEWER TRENCHES RUNNING UNDER PAVED AREAS TO BE BACKFILLED WITH GRANULAR MATERIAL.
- THE SIZE AND LOCATION OF EXISTING UTILITIES SHOWN ARE PER INFORMATION PROVIDED BY THE RESPECTIVE UTILITY COMPANIES. ALL UTILITY COMPANIES SHOULD BE NOTIFIED PRIOR TO ANY EXCAVATION FOR FIELD LOCATION OF SERVICES.
- SERVICE WALKS SHALL BE NON-REINFORCED CONCRETE 4" THICK AND 4' IN WIDTH.
- 4' CONCRETE SERVICE WALK ACROSS FRONTAGE OF EACH LOT TO BE CONSTRUCTED BY OTHERS.
- EXPANSION JOINTS ARE TO BE PLACED AT ALL WALK INTERSECTION AND BETWEEN WALKS AND PLATEWAYS. SIDEWALK SPACES ARE TO BE EQUALLY SPACED BETWEEN EXPANSION JOINTS. CONTRACTION JOINTS AND PERPENDICULAR SIDEWALKS AT 5' INTERVALS OR LESS WITH A CONTRACTION JOINT EVERY 20' OR LESS.
- TEMPORARY TRAFFIC CONTROL DURING CONSTRUCTION TO CONFORM TO APPLICABLE LOCAL AND STATE STANDARDS.
- ALL CONSTRUCTION ACTIVITY ON THIS SITE TO BE PERFORMED IN COMPLIANCE WITH APPLICABLE O.S.H.A. STANDARDS FOR WORKER SAFETY.
- CONTRACTOR SHALL MINIMIZE DAMAGE TO EXISTING TREES.

BENCHMARK

- TBM "104" - TOP OF HARRISON MONUMENT MARKING THE S.E. CORNER W. 1/2 N.W. 1/4 SEC. 28-T19N-R5E AT THE CENTERLINE OF 191 ST. STREET AND PROMISE ROAD.
ELEVATION = 803.16
- TBM "105" - TOP OF HARRISON MONUMENT MARKING THE S.E. CORNER W.N.W. 1/4 SEC. 28-T19N-R5E AT THE CENTERLINE OF 191 ST. STREET 1/4 MILE EAST OF PROMISE ROAD.
ELEVATION = 806.71

Revisions

RECORD DRAWING



CERTIFIED BY
J. Clegg, C.E.
10/13/99

THIS DRAWING AND THE IDEAS, DESIGN AND CONCEPTS CONTAINED HEREIN ARE THE EXCLUSIVE INTELLECTUAL PROPERTY OF THE SCHNEIDER CORPORATION AND ARE NOT TO BE USED OR REPRODUCED IN WHOLE OR IN PART, WITHOUT THE WRITTEN CONSENT OF THE SCHNEIDER CORPORATION.

1999, The Schneider Corporation



The
Schneider
Corporation

3020 North Post Road
Indianapolis, Indiana
46226-6518
Engineering
Surveying
Landscape Architecture
GIS • LIS
Geology


Formerly Schneider Engineering Corp. / Bohlen, Meyer, Gibson & Assoc.

THOMPSON LAND COMPANY, INC.
ROUDEBUSH WOODS SECTION 1
NOBLESVILLE, INDIANA

DEVELOPMENT PLAN

Date	Project No.	Drawn	PRC	Approved
5/04/99	1025.11			
Computer Files J:\1025\DWGS\11\C102 XREF: J:\1025\DWGS\11\10BS XREF: J:\1025\DWGS\12\12BS XREF: J:\1025\DWGS\12\12BS	Sheet No. C102 JUN 9 2000 OFFICE OF HAMILTON COUNTY SURVEYOR			

UTILITIES - NOBLESVILLE

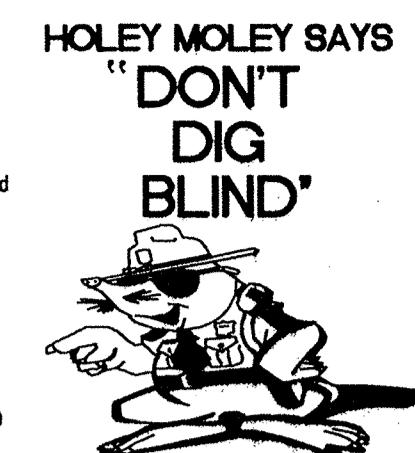

"IT'S THE LAW"
CALL 2 WORKING DAYS BEFORE YOU DIG
1-800-382-5544

CALL TOLL FREE
PER INDIANA STATE LAW IS 69-1991.
IT IS AGAINST THE LAW TO EXCAVATE
WITHOUT NOTIFYING THE UNDERGROUND
LOCATION SERVICE TWO (2) WORKING
DAYS BEFORE COMMENCING WORK.

Gas	
Indiana Gas	16000 Allisonville Road
	Noblesville, Indiana 46060
(317) 776-5331	Attn: Jim Rebuck
	Water
Indiana-American Water	Company Inc.
	333 North Street
	Noblesville, Indiana 46060-1987
(317) 773-2497	Attn: Tim Lee
	Telephone
Ameritech	16 South 10th Street
	Noblesville, Indiana 46060
(317) 252-4258	Attn: Greg Commock
	Telephone
City of Noblesville	16 South 10th Street
	Noblesville, Indiana 46060
(317) 776-6330	Attn: Engineering
	Cable Television
Indiana Communications	1529 Stony Creek Way
	Noblesville, Indiana 46060
(317) 776-0660	Attn: Dale Lambert
	Utility Hotline: within Indiana 1-800-382-5544 outside Indiana 1-800-428-5200

Storm Sewer

City of Noblesville
16 South 10th Street
Noblesville, Indiana 46060
(317) 776-6330
Attn: Engineering

Streets

City of Noblesville
16 South 10th Street
Noblesville, Indiana 46060
(317) 776-6330
Attn: Engineering

NOTE
The size and location of utilities are for plane and locations provided by the respective utility companies. All utility companies shall be notified prior to any excavation for field location of services.


ASSUMED NORTH
SCALE: 1"=50'

STORM SEWER CONTINUED
FROM SEE SHEET C101

STR #	STA BASELINE	OFFSET LT/RT	TYPE	TC	INVERTS
E101	-----		INLET	786.54	776.96 (E), 774.92 (SW), 773.91 (N)
101	3+18.02 "G"	448.52' RT	STORM MANHOLE	789.00	778.38 (T), 777.22 (S&W)
102	2+87.02 "	448.57' RT	BOX INLET	782.20	778.70 (W)
103	2+69.86 "G"	189.19' RT	STORM MANHOLE	792.50	781.43 (W), 777.67 (S&W)
104	1+30.00 "G"	15.00' RT	CURB INLET	794.49	778.41 (SAN)
105	1+30.00 "G"	15.00' LT	CURB INLET	794.49	778.48 (SAN)
106	8+16.59 "A"	15.00' LT	BEETHIVE INLET	794.70	781.35 (E), 778.85 (S&N)
107	8+16.00 "A"	15.00' LT	CURB INLET	795.77	791.72 (E&W)
108	8+16.00 "A"	15.00' RT	CURB INLET	795.77	792.02 (W)
112	1+30.00 "B"	15.00' RT	CURB INLET	795.73	779.22 (SAN)
113	1+30.00 "B"	15.00' LT	CURB INLET	795.73	779.29 (E&W)
114	4+11.38" A"	160.00' LT	BEETHIVE INLET	794.70	782.29 (E&W), 779.79 (S&N)
115	4+30.00 "A"	18.06' LT	CURB INLET	794.46	779.77 (E&W)
116	4+30.00 "A"	18.06' RT	CURB INLET	795.48	791.75 (E&W)
117	4+30.00 "A"	38.05' RT	BEETHIVE INLET	795.10	781.93 (W)
121	1+69.92 "A"	160.00' LT	STORM MANHOLE	784.50	786.70 (W), 782.90 (E), 780.40 (N)
122	1+44.75 "A"	195.00' LT	BEETHIVE INLET	795.40	791.33 (W&E)
122A	1+12.38 "A"	191.68' LT	BEETHIVE INLET	797.00	793.45 (N)
123	1+65.50 "A"	25.00' LT	CURB INLET	796.73	792.20 (E&W)
124	1+63.50 "A"	25.22' LT	MANHOLE	796.73	792.70 (E&W)
125	1+58.37 "A"	54.53' LT	BEETHIVE INLET	796.70	793.00 (W)
180	6+11.74 "G"	190.83' RT	BEETHIVE INLET	788.50	782.50 (W&E)
181	7+00.46 "G"	194.83' RT	END SECTION	782.90	
182	7+53.28 "G"	185.89' RT	END SECTION	782.90	
184	7+50.00 "G"	15.00' LT	CURB INLET	793.40	787.12 (S&N)
185	7+46.00 "G"	16.00' LT	BEETHIVE INLET	794.70	789.66 (E&N)
186	6+47.00 "G"	158.38' LT	BEETHIVE INLET	793.90	790.38 (S), 790.38 (W)
190	10+30.00 "G"	179.17' RT	END SECTION	782.90	
191	10+32.40 "G"	15.00' RT	CURB INLET	790.41	784.48 (S&E)
192	3+45.00 "G"	19.49' RT	CURB INLET	790.19	785.33 (W), 784.83 (S&N)
193	3+45.00 "G"	19.49' LT	CURB INLET	790.19	786.25 (E)
194	9+65.51 "G"	163.68' LT	BEETHIVE INLET	793.20	785.84 (S&N)
209	13+62.35 "G"	177.00' RT	END SECTION	782.97	
210	13+55.00 "G"	15.00' RT	CURB INLET	789.29	783.51 (S&W)
211	13+55.00 "G"	15.00' LT	CURB INLET	788.92	783.59 (S&W)
212	13+47.64 "G"	167.31' LT	BEETHIVE INLET	788.20	783.89 (S&W)
213	12+58.29 "G"	187.45' LT	BEETHIVE INLET	788.80	784.13 (S), 784.13 (NW)
217	13+62.05 "G"	165.55' LT	BEETHIVE INLET	788.20	784.48 (W), 784.18 (SW), 783.98 (E)
221	13+78.28 "G"	163.95' LT	END SECTION	782.98	
222	13+97.68 "G"	185.22' RT	END SECTION	785.90	

SANITARY SEWER TABLE

STR #	STA BASELINE	OFFSET LT/RT	TYPE	TC	INVERTS
E1	-----		EXIST. MANHOLE	792.65	779.55 (W), EX-778 (N)
1A	13+55.68 "G"	682.82' LT	MANHOLE	780.08 (NE), 780.98 (S)	
1	13+65.90 "G"	590.37' LT	MANHOLE	780.38 (NE), 780.38 (SW)	
2	13+00.11 "G"	358.23' LT	MANHOLE	789.30 (S)	
3	12+61.49 "G"	780.30' LT	MANHOLE	780.00 (NW), 781.94 (SE), 781.74 (SW)	
4	10+55.59 "G"	50.00' LT	MANHOLE	780.90 (C), 782.44 (W)	
5	6+30.97 "G"	27.00' LT	MANHOLE	784.59 (C), 783.49 (W)	
6	2+10.00 "G"	27.00' LT	MANHOLE	785.50 (C-E), 784.51 (E-W)	
LIFT STATION	10+96.83 "A"	156.00' LT	STATION	794.50	783.49 (S), 783.77 (W), BOTTOM=763.00
16	11+01.26 "G				

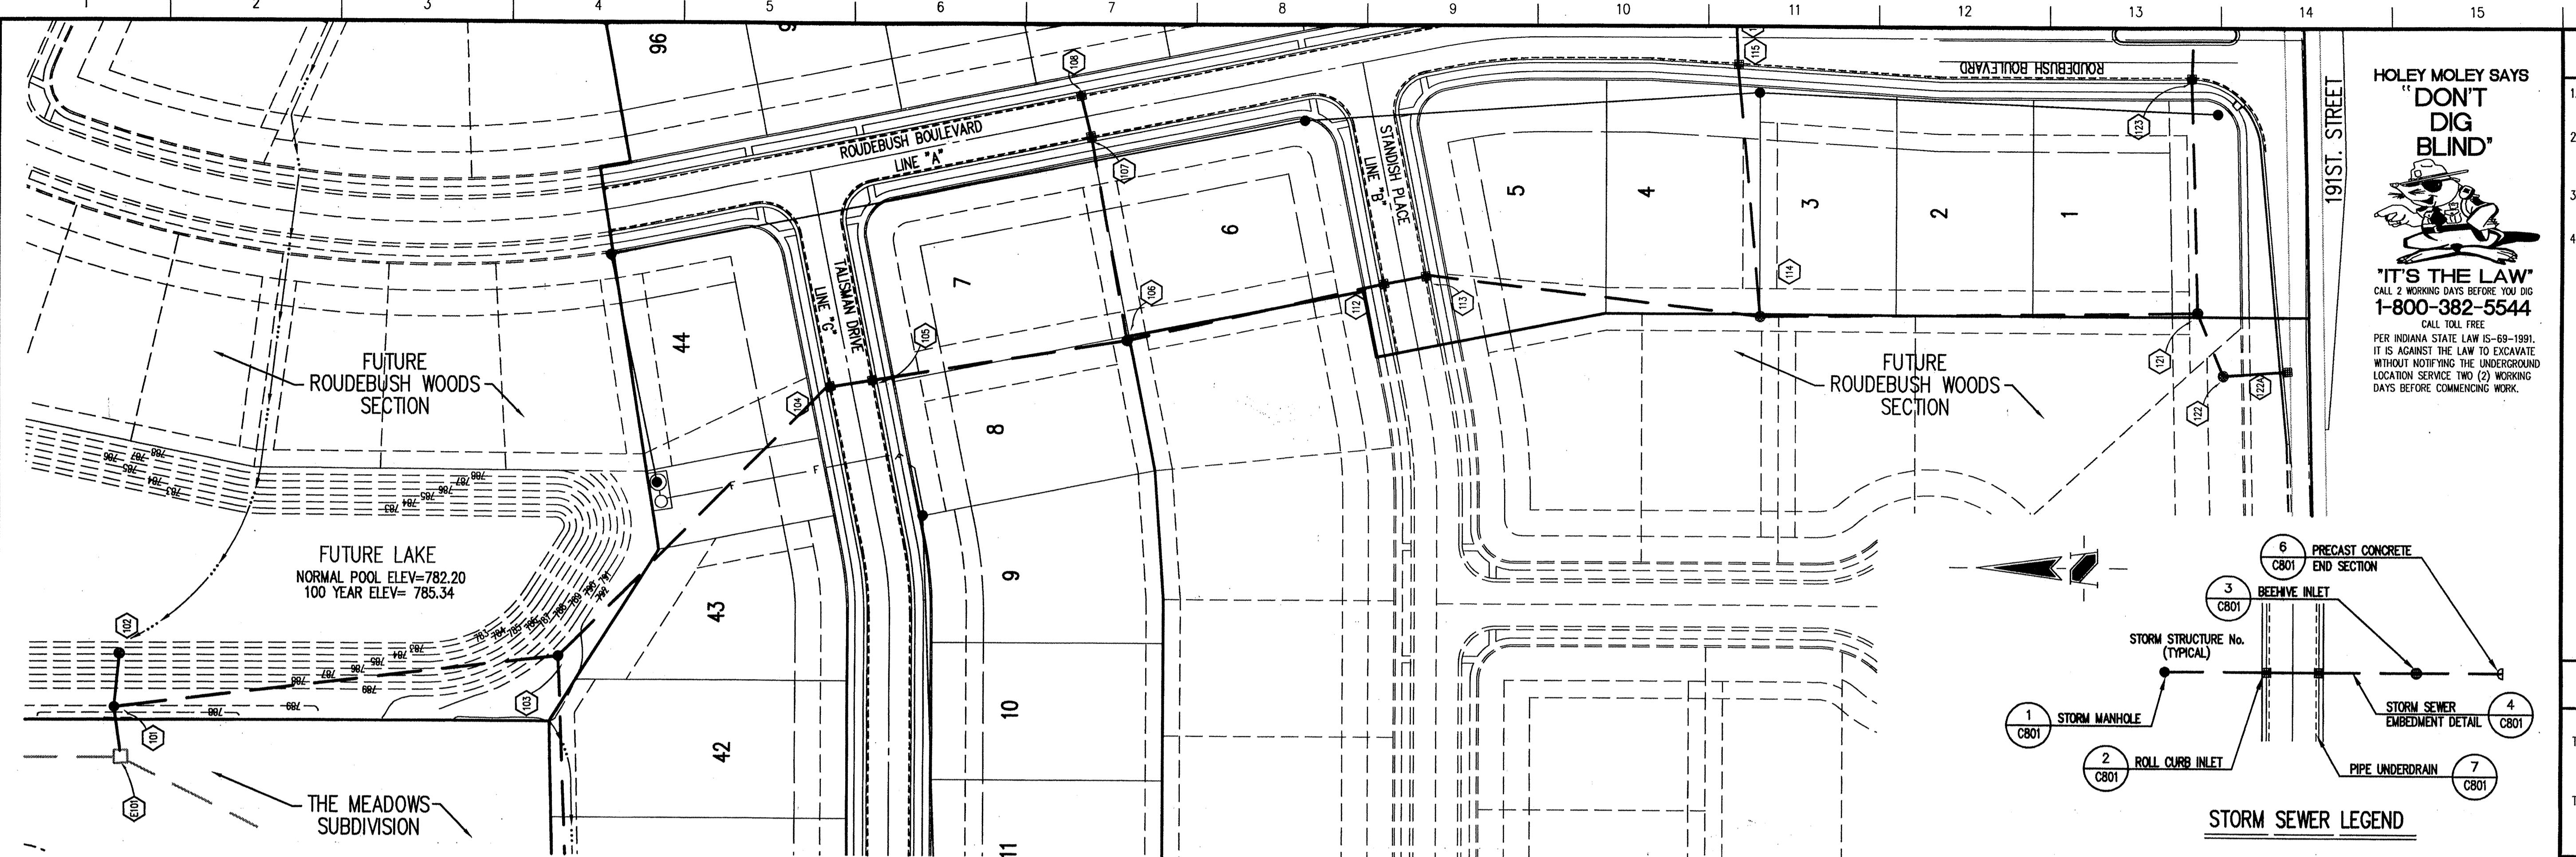

GENERAL NOTES


- TEMPORARY TRAFFIC CONTROL DURING CONSTRUCTION TO CONFORM TO APPLICABLE LOCAL AND STATE STANDARDS.
- ALL CONSTRUCTION ACTIVITY ON THIS SITE TO BE PERFORMED IN COMPLIANCE WITH APPLICABLE O.S.H.A. STANDARDS FOR WORKER SAFETY.
- IT SHALL BE THE CONTRACTORS RESPONSIBILITY TO FIELD VERIFY ALL UTILITY LOCATIONS BEFORE CONSTRUCTION BEGINS.
- CONTRACTORS SHALL MINIMIZE DAMAGE TO EXISTING TREES.

BENCHMARK

TBM *104* - TOP OF HARRISON MONUMENT MARKING THE S.E. CORNER W. 1/2 N.W. 1/4 SEC. 28-T19N-R5E AT THE CENTERLINE OF 191 ST. STREET AND PROMISE ROAD.
ELEVATION = 803.16
TBM *105* - TOP OF HARRISON MONUMENT MARKING THE S.E. CORNER N.W. 1/4 SECTION 28-T19N-R5E AT THE CENTERLINE OF 191 ST. STREET 1/4 MILE EAST OF PROMISE ROAD.
ELEVATION = 806.71

Revisions
1. TJ - 12 OCT 99 - STORM SEWER RECORD DRAWING

STORM SEWER PLAN

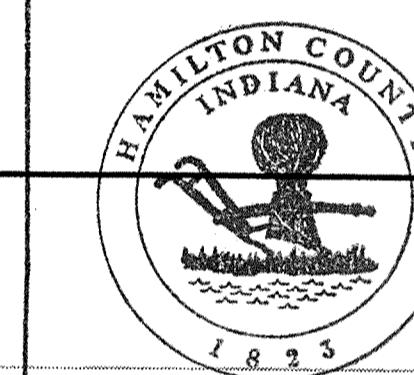

SCALE: 1"=50'

This information was gathered for input into the Hamilton County Geographical Information System. This document is considered an official record of the G.I.S.

Entry Date: 1/1/00 4-28-00

Entered by: SCM JAY

CERTIFICATION FOR "RECORD DRAWING"

NOTE:
Record drawing certification for top of casting, invert elevations, and lengths of pipe only. Slope percentage represents a calculated figure and is for general information only.



DATE:

CERTIFIED BY
J.C. Port Crossby
1/12/99
THIS DRAWING AND THE IDEAS, DESIGNS AND CONCEPTS CONTAINED HEREIN ARE THE EXCLUSIVE INTELLECTUAL PROPERTY OF THE SCHNEIDER CORPORATION AND ARE NOT TO BE USED OR REPRODUCED IN WHOLE OR IN PART, WITHOUT THE WRITTEN CONSENT OF THE SCHNEIDER CORPORATION.

1999, The Schneider Corporation



The Schneider Corporation

3020 North Post Road
Indianapolis, Indiana
46226-6518
317-899-8282
317-899-8010 Fax
Engineering
Surveying
Landscape Architecture
GIS • LIS
Geology

Formerly Schneider Engineering Corp. / Bohlen, Meyer, Gibson & Assoc.

THOMPSON LAND COMPANY, INC.
ROUDEBUSH WOODS SECTION 1
NOBLESVILLE, INDIANA

STORM SEWER PLAN

Date	Project No.	Drawn	Approved
------	-------------	-------	----------

5/04/99 1025.11 DRP

Computer Files
J:\1025\DWGS\11\C801
XREF: J:\1025\DWGS\11\1BS
XREF: J:\1025\DWGS\11\STORM
XREF: J:\1025\DWGS\12\1BS

Sheet No.
C801
JUN 04 2000

STORM SEWER RECORD DRAWING

SCALE: HORIZ.: 1"=50'
VERT.: 1"=5'

STORM SEWER PROFILE

LEGEND		
Existing Grade	New Grade	Gravel Backfill

GENERAL NOTES

- TEMPORARY TRAFFIC CONTROL DURING CONSTRUCTION TO CONFORM TO APPLICABLE LOCAL AND STATE STANDARDS.
- ALL CONSTRUCTION ACTIVITY ON THIS SITE TO BE PERFORMED IN COMPLIANCE WITH APPLICABLE O.S.H.A. STANDARDS FOR WORKER SAFETY.
- IT SHALL BE THE CONTRACTORS RESPONSIBILITY TO FIELD VERIFY ALL UTILITY LOCATIONS BEFORE CONSTRUCTION BEGINS.
- CONTRACTORS SHALL MINIMIZE DAMAGE TO EXISTING TREES.



"IT'S THE LAW"
CALL 2 WORKING DAYS BEFORE YOU DIG
1-800-382-5544

CALL TOLL FREE
PER INDIANA STATE LAW IS 69-1991.
IT IS AGAINST THE LAW TO EXCAVATE
WITHOUT NOTIFYING THE UNDERGROUND
LOCATION SERVICE TWO (2) WORKING
DAYS BEFORE COMMENCING WORK.

BENCHMARK

TBM "104" - TOP OF HARRISON MONUMENT MARKING THE S.E. CORNER
W 1/2 N.W. 1/4 SEC. 28-T19N-R5E AT THE CENTERLINE
OF 191 ST. STREET AND PROMISE ROAD.
ELEVATION = 803.16

TBM "105" - TOP OF HARRISON MONUMENT MARKING THE S.E. CORNER
N.W. 1/4 SECTION 28-T19N-R5E AT THE CENTERLINE
OF 191 ST. STREET 1/4 MILE EAST OF PROMISE ROAD.
ELEVATION = 806.71

Revisions
1. TJ - 12 OCT 99 - STORM SEWER RECORD DRAWING.

CERTIFICATION FOR "RECORD DRAWING"

NOTE:
Record drawing certification for top of casting, invert elevations, and lengths of pipe only. Slope percentage
represents a calculated figure and is for general
information only.



DATE:

CERTIFIED BY
10/12/99
THIS DRAWING AND THE IDEAS, DESIGNS AND CONCEPTS CONTAINED
HEREIN ARE THE EXCLUSIVE INTELLECTUAL PROPERTY OF THE SCHNEIDER
CORPORATION. THEY MAY NOT BE COPIED OR USED IN WHOLE OR
PART, WITHOUT THE WRITTEN CONSENT OF THE SCHNEIDER CORPORATION.

1999, The Schneider Corporation



3020 North Post Road
Indianapolis, Indiana
46226-0518
317-898-8282
317-898-8210 Fax
Engineering
Surveying
Landscape Architecture
GIS • LIS
Geology

Formerly Schneider Engineering Corp. / Bohlen, Meyer, Gibson & Assoc.

THOMPSON LAND COMPANY, INC.
ROUDEBUSH WOODS SECTION 1
NOBLESVILLE, INDIANA

STORM SEWER PLAN

Date 5/04/99 Project No. 1025.11 Drawn DRP Approv.

Computer Files J:\1025\DWGS\11\102502

XREF: J:\1025\DWGS\11\102502

XREF: J:\1025\DWGS\11\102502

XREF: J:\1025\DWGS\11\102502

Sheet No. FILED C602

JUN 3 2000

OFFICE OF HAMILTON COUNTY SURVEYOR


STORM SEWER RECORD DRAWING


SCALE: HORZ.: 1"=50'
VERT.: 1"=5'

STORM SEWER PROFILE

This copy printed from the Digital Archive of the Hamilton County Surveyor's Office: One Hamilton Co. Square, Ste. 188, Noblesville, Indiana.

Existing Grade	New Grade	Granular Backfill
----------------	-----------	-------------------

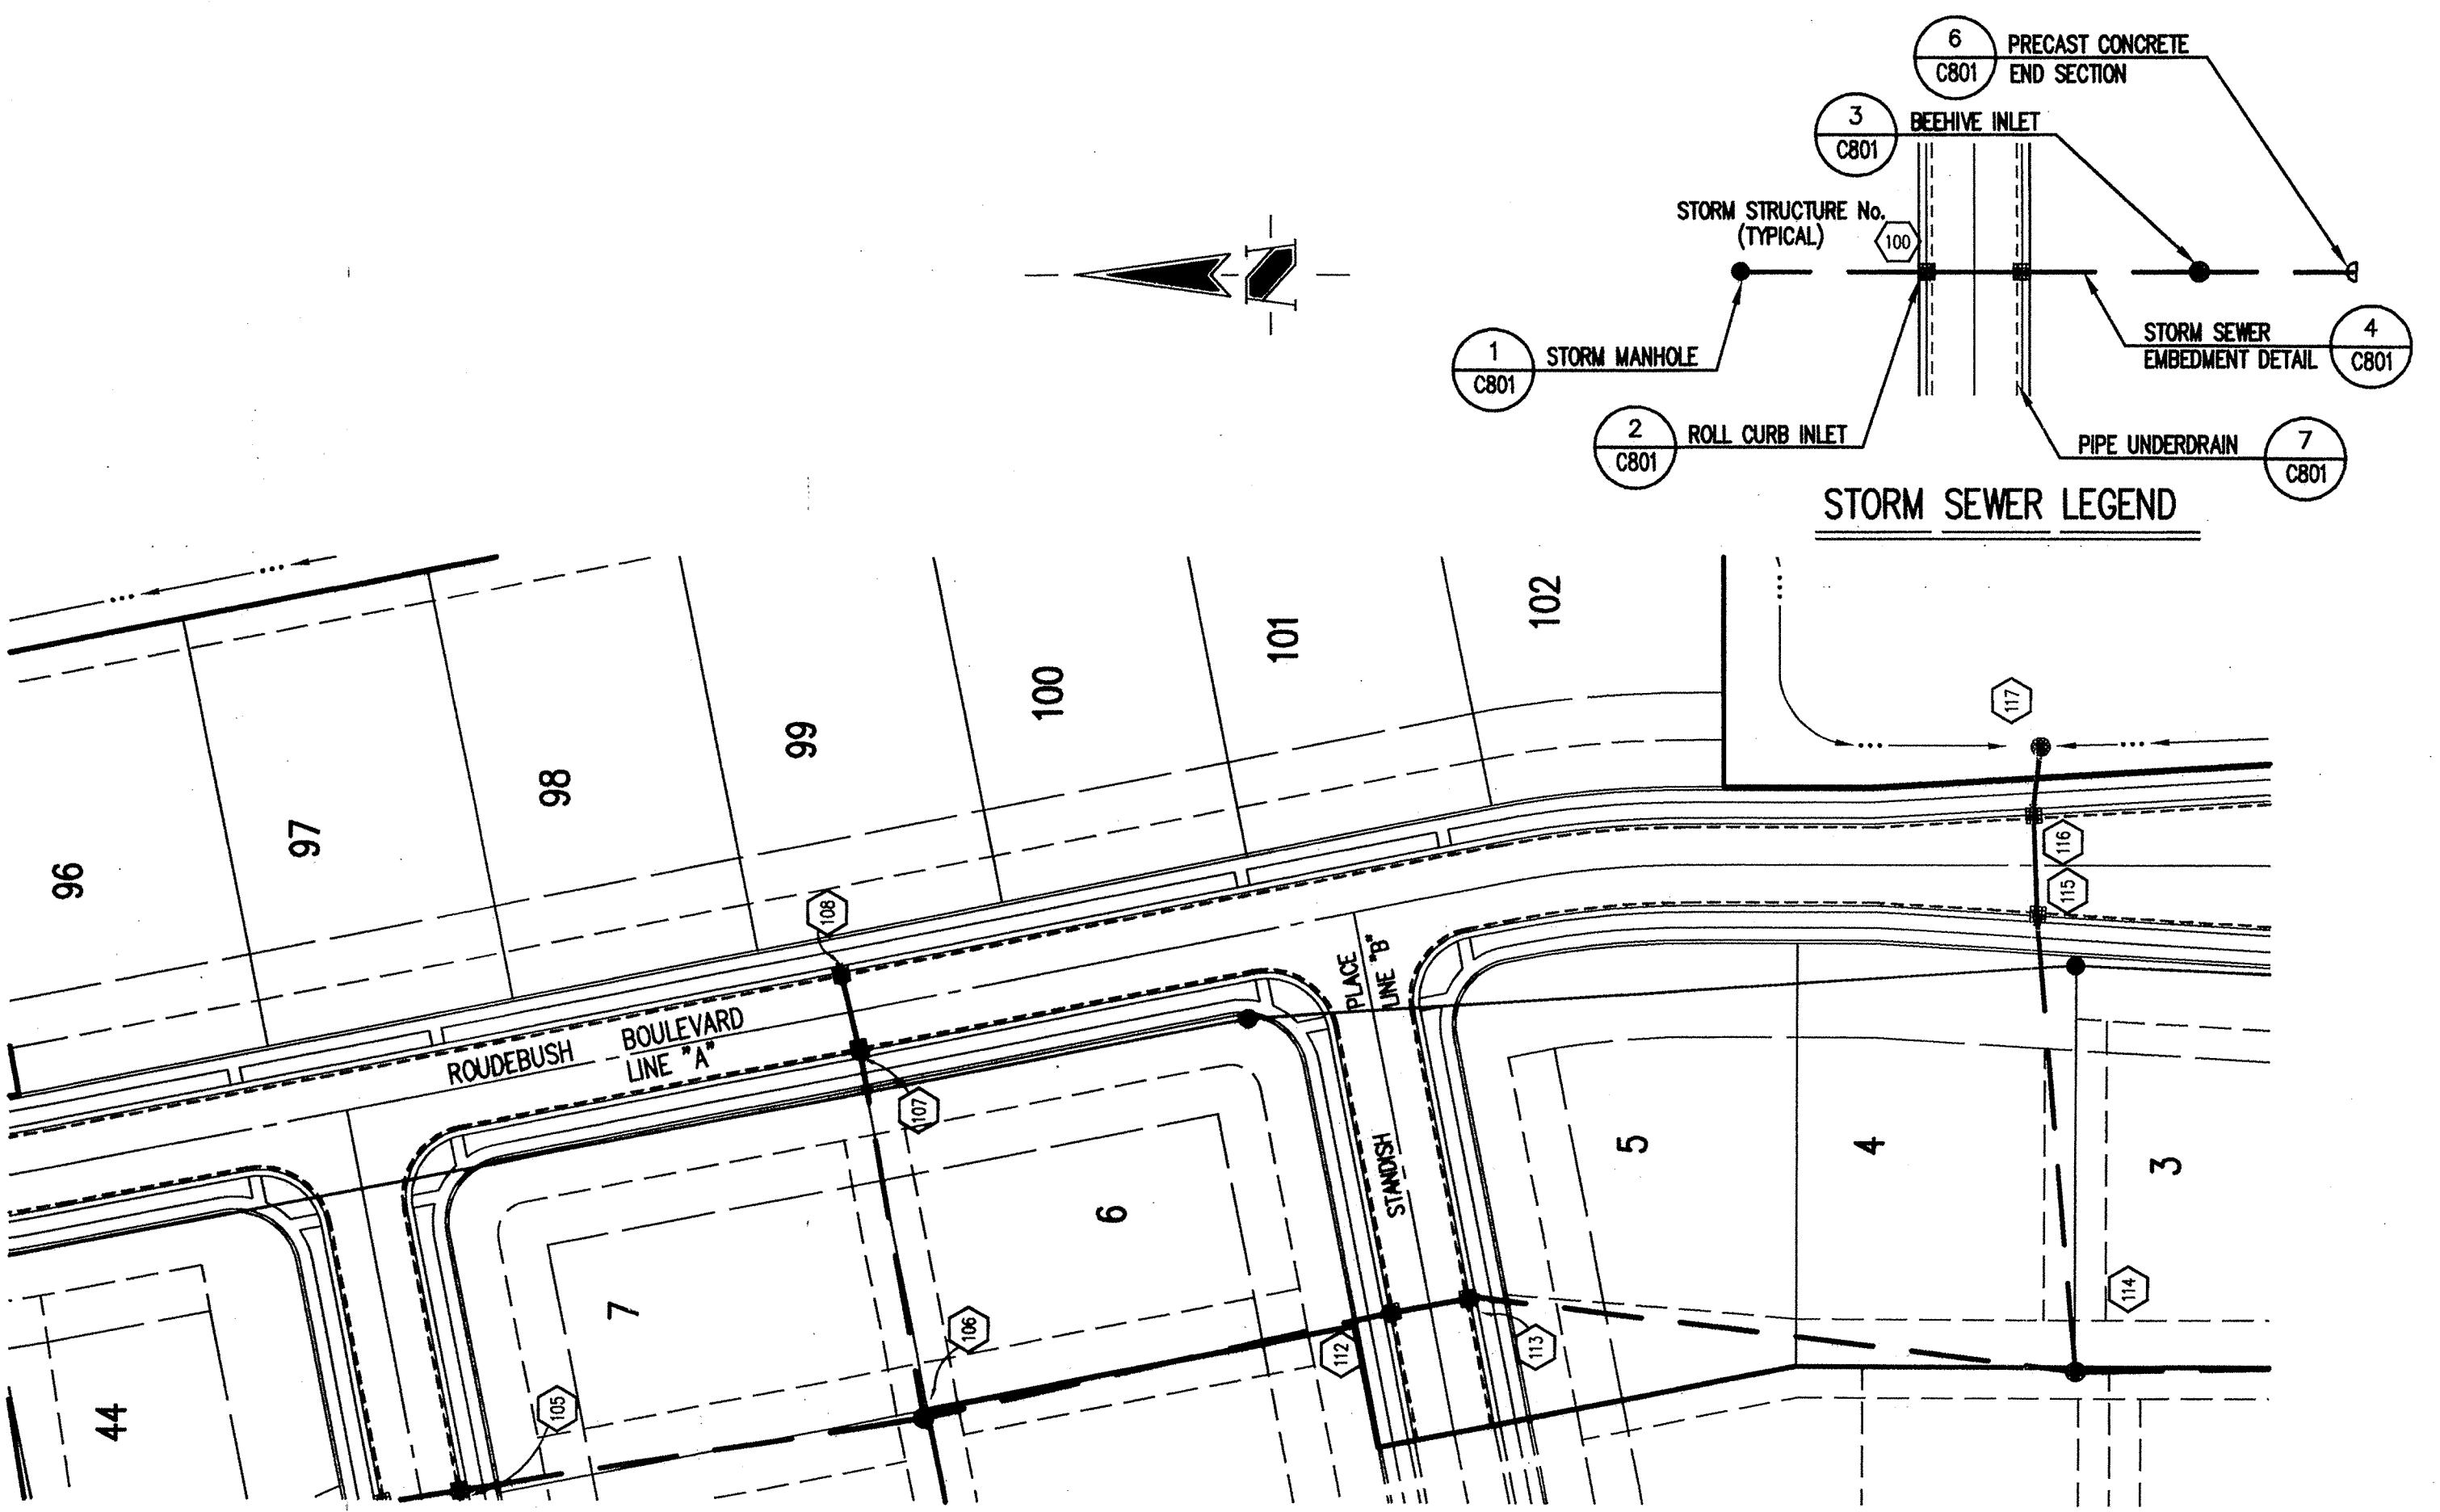

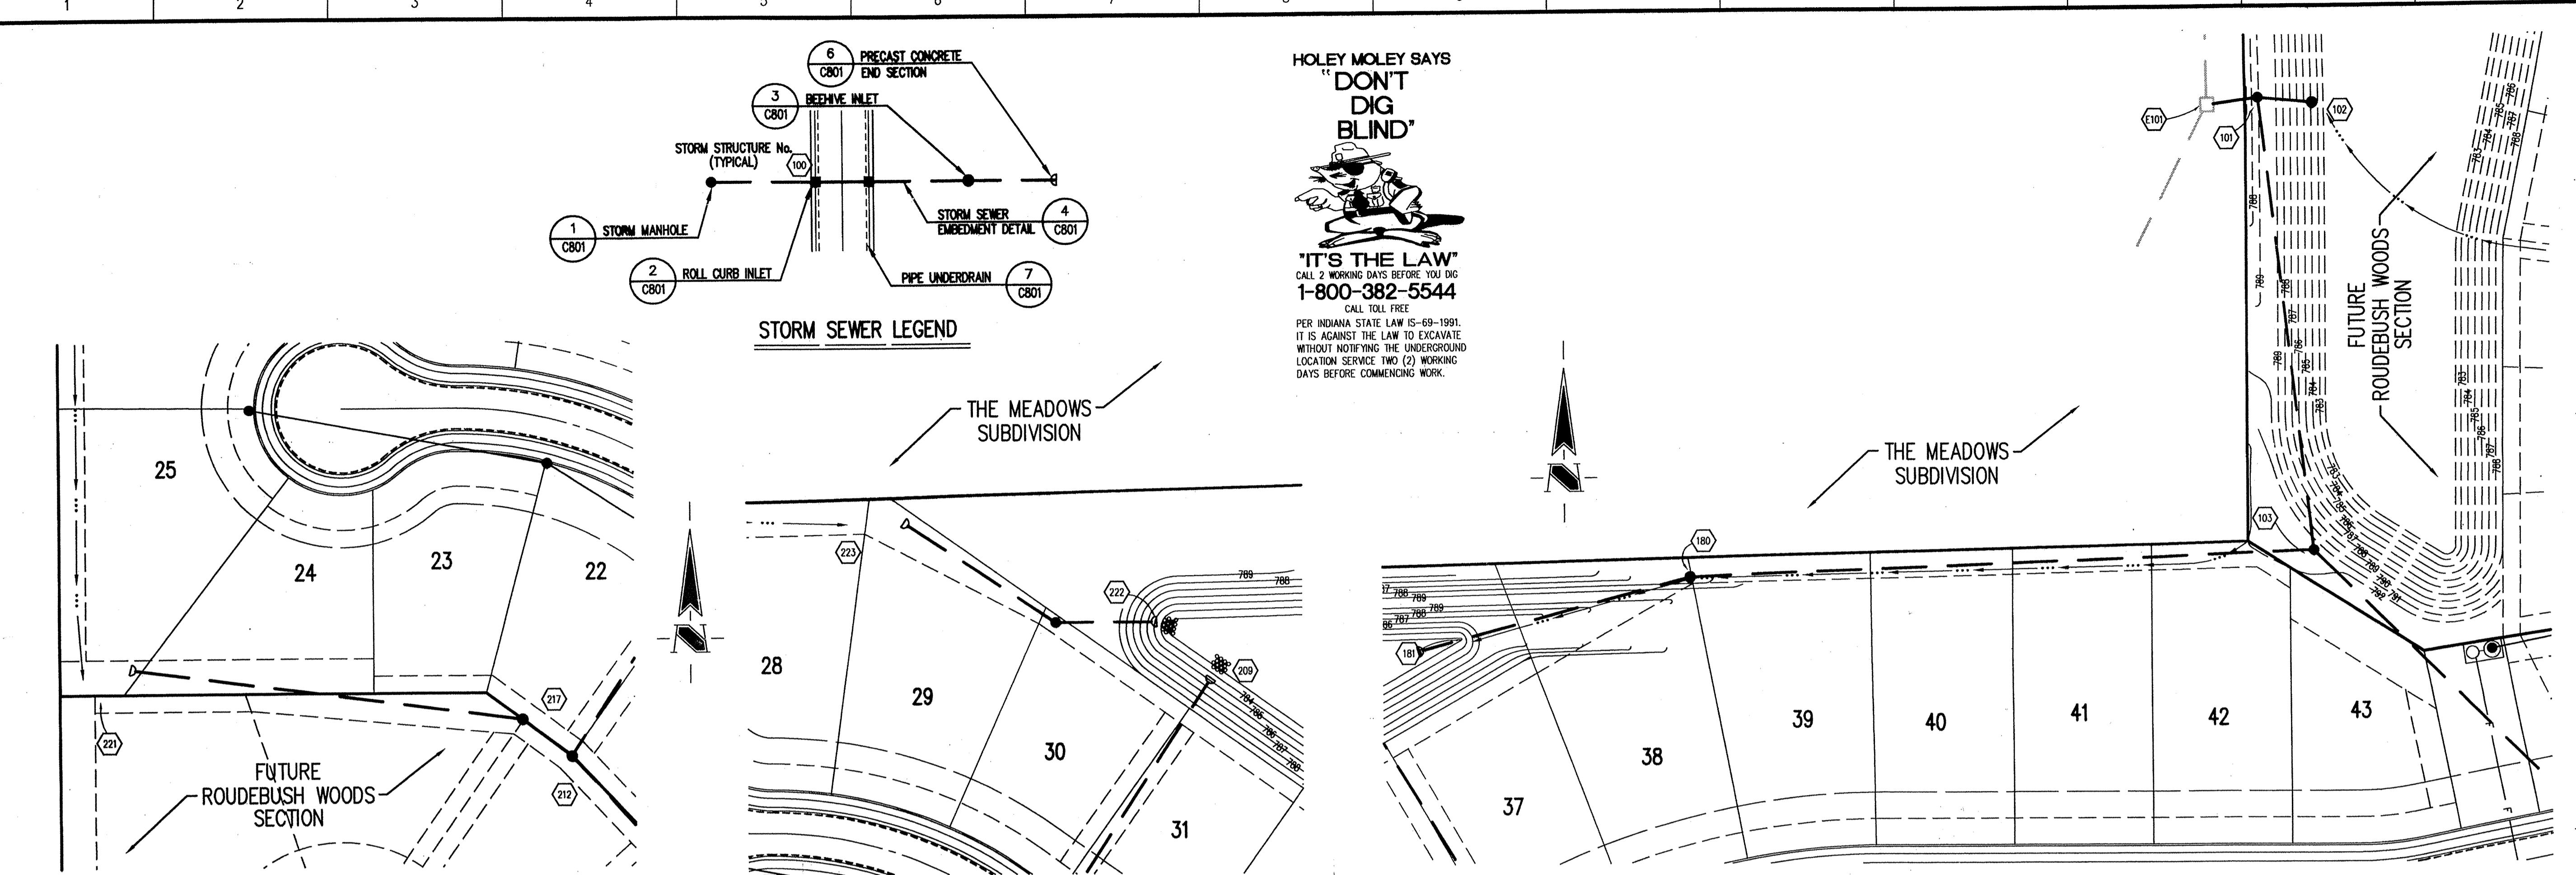

STORM SEWER PLAN

SCALE: 1"=50'

STR. 221 END SECTION
INV. OUT -786.50-(12° E) 786.57

STR. 217 BEEHIVE INLET
TC -788.20-787.86
INV. IN 784.48 (12° W)
INV. IN 784.48 (15° STUB SW) NOT BUILT
INV. OUT 783.98 (18° E) 784.66

STR. 212 BEEHIVE INLET
TC -788.20-787.64
INV. IN 783.89 (18° W)
INV. IN 783.89 (18° SE) 784.24
INV. OUT 783.89 (24° N) 784.24

STR. 223 END SECTION
INV. OUT -785.90-(12° E) 785.60

STR. 222A MANHOLE
TC 790.68
INV. IN 784.08 (12° W)
INV. OUT 784.03 (12° E)

STR. 222 END SECTION
INV. IN -782.90-(12° W) 783.08

STR. 181 END SECTION
INV. OUT -782.90-(12° E) 783.09

STR. 180 BEEHIVE INLET
TC -788.50-788.44
INV. IN 782.50 (12° W) 782.24
INV. OUT -782.50 (12° E) 782.24

STR. 103 MANHOLE
TC -792.50-791.60
INV. IN 777.22 (42° SE) 776.76
INV. IN 781.43 (24° E) 781.16
INV. OUT 777.22 (42° W) 776.76

STR. 102 BOX INLET
TC -782.20-782.20
INV. OUT -782.20 (24° W) 782.55


LAKE #2
N.P. 782.9

LAKE #2
N.P. 782.9

ELEV. 782.2

775 780 785 790 795 800 805 810 815 775 780 785 790 795 800 805 810 815 775 780 785 790 795 800 805 810 815

STORM SEWER PROFILE

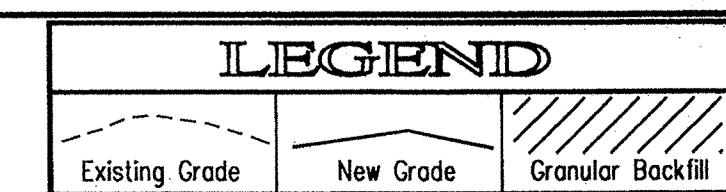

STORM SEWER RECORD DRAWING

SCALE: HORZ.: 1"=50'
VERT.: 1"=5'

FEDERAL NOTES

1. TEMPORARY TRAFFIC CONTROL DURING CONSTRUCTION TO CONFORM TO APPLICABLE LOCAL AND STATE STANDARDS.
 2. ALL CONSTRUCTION ACTIVITY ON THIS SITE TO BE PERFORMED IN COMPLIANCE WITH APPLICABLE O.S.H.A. STANDARDS FOR WORKER SAFETY.
 3. IT SHALL BE THE CONTRACTORS RESPONSIBILITY TO FIELD VERIFY ALL UTILITY LOCATIONS BEFORE CONSTRUCTION BEGINS.
 4. CONTRACTORS SHALL MINIMIZE DAMAGE TO EXISTING TREES.

BENCHMARK


TBM "104" - TOP OF HARRISON MONUMENT MARKING THE S.E. CORNER
W. 1/2 N.W. 1/4 SEC. 28-T19N-R5E AT THE CENTERLINE
OF 191 ST. STREET AND PROMISE ROAD.
ELEVATION = 803.16

TBM "105" - TOP OF HARRISON MONUMENT MARKING THE S.E. CORNER
N.W. 1/4 SECTION 28-T19N-R5E AT THE CENTERLINE
OF 191 ST. STREET 1/4 MILE EAST OF PROMISE ROAD.
ELEVATION = 806.71

Revisions

CERTIFICATION FOR "RECORD DRAWING"

NOTE:
Record drawing certification for top of casting, invert elevations, and lengths of pipe only. Slope percentage represents a calculated figure and is for general information only.

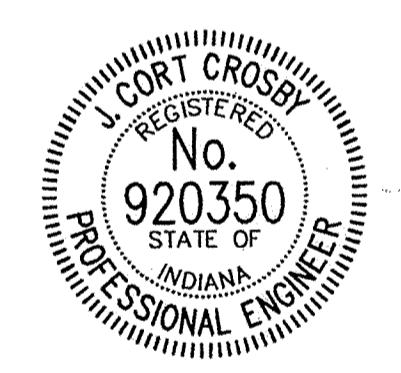

10/12/99

The Schneider Corporation

**3020 North Post Road
Indianapolis, Indiana
46226-6518
317-898-8282
317-899-8010 Fax**

**Engineering
Surveying
Landscape Architecture
GIS • LIS
Geology**

THOMPSON LAND COMPANY, INC.
UDEBUSH WOODS SECTION 1

STORM SEWER PLAN

Date 5/04/99	Project No. 1025.11	Drawn DRP	Approv.
Computer Files J:\1025\DWGS\11\C603 XREF: J:\1025\DWGS\11\11BS XREF: J:\1025\DWGS\11\STORM XREF: J:\1025\DWGS\12\12BS		Sheet No. C603 JUN 03 2000	

GENERAL NOTES

- TEMPORARY TRAFFIC CONTROL DURING CONSTRUCTION TO CONFORM TO APPLICABLE LOCAL AND STATE STANDARDS.
- ALL CONSTRUCTION ACTIVITY ON THIS SITE TO BE PERFORMED IN COMPLIANCE WITH APPLICABLE O.S.H.A. STANDARDS FOR WORKER SAFETY.
- IT SHALL BE THE CONTRACTORS RESPONSIBILITY TO FIELD VERIFY ALL UTILITY LOCATIONS BEFORE CONSTRUCTION BEGINS.
- CONTRACTORS SHALL MINIMIZE DAMAGE TO EXISTING TREES.



PER INDIANA STATE LAW IS-60-1891.
IT IS AGAINST THE LAW TO EXCAVATE
WITHOUT NOTIFYING THE UNDERGROUND
LOCATION SERVICE TWO (2) WORKING
DAYS BEFORE COMMENCING WORK.

BENCHMARK

TBM "104" - TOP OF HARRISON MONUMENT MARKING THE S.E. CORNER
W. 1/2 N.W. 1/4 SEC. 2B-T19N-R5E AT THE CENTERLINE
OF 191 ST. STREET AND PROMISE ROAD.
ELEVATION = 803.16

TBM "105" - TOP OF HARRISON MONUMENT MARKING THE S.E. CORNER
N.W. 1/4 SECTION 2B-T19N-R5E AT THE CENTERLINE
OF 191 ST. STREET 1/4 MILE EAST OF PROMISE ROAD.
ELEVATION = 806.71

Revisions
1. TJ - 12 Oct 99 - STORM SEWER RECORD DRAWING.

CERTIFICATION FOR "RECORD DRAWING"

NOTE:
Record drawing certification for top of casting, invert elevations, and lengths of pipe only. Slope percentage represents a calculated figure and is for general information only.



CERTIFIED BY
J. C. G. L.
10/12/99
THIS DRAWING AND THE IDEAS, DESIGN AND CONCEPTS CONTAINED
HEREIN ARE THE EXCLUSIVE INTELLECTUAL PROPERTY OF THE SCHNEIDER
CORPORATION AND ARE NOT TO BE USED OR REPRODUCED IN WHOLE OR IN
PART, WITHOUT THE WRITTEN CONSENT OF THE SCHNEIDER CORPORATION.

1999, The Schneider Corporation



3020 North Post Road
Indianapolis, Indiana
46226-6510
317-699-9282
317-699-8010 Fax

Engineering
Surveying
Landscape Architecture
GIS • LIS
Geology



Formerly Schneider Engineering Corp. / Bohlen, Meyer, Gibson & Assoc.

THOMPSON LAND COMPANY, INC.
ROUDEBUSH WOODS SECTION 1
NOBLESVILLE, INDIANA


STORM SEWER PLAN

SCALE: 1"=50'

STORM SEWER PLAN

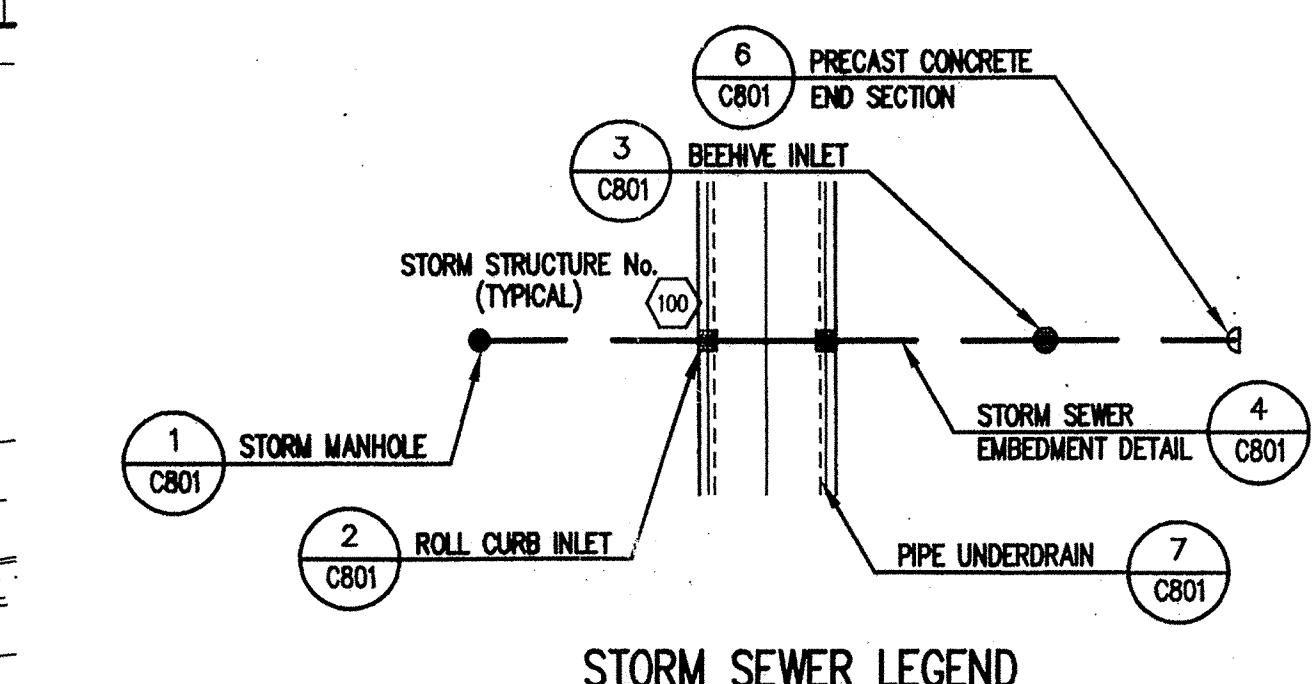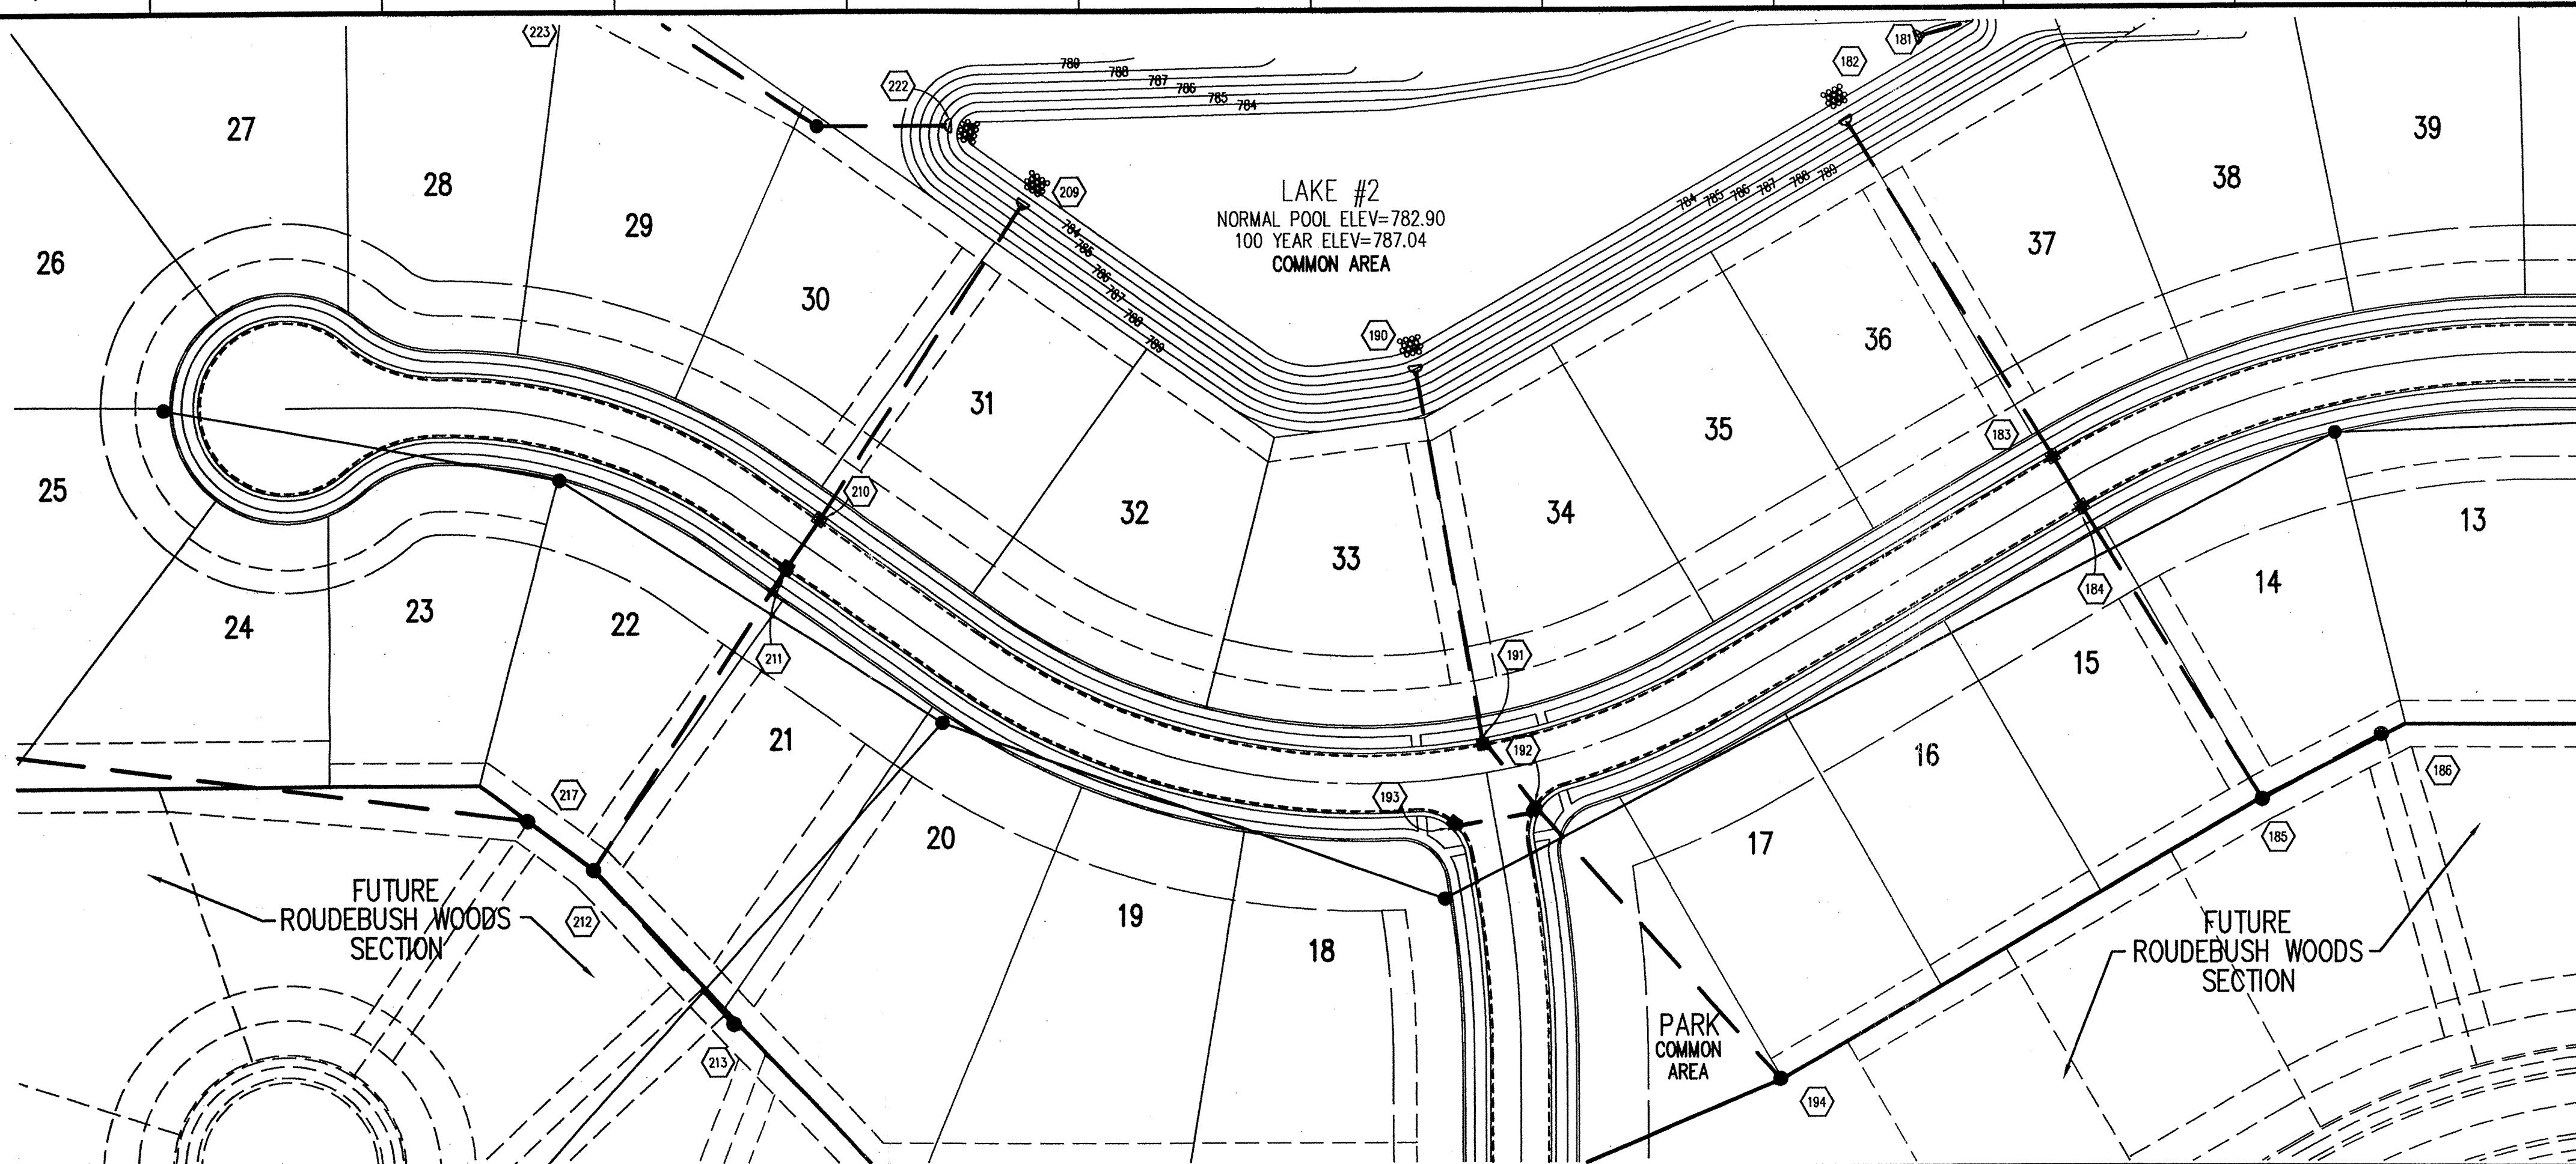

STORM SEWER LEGEND

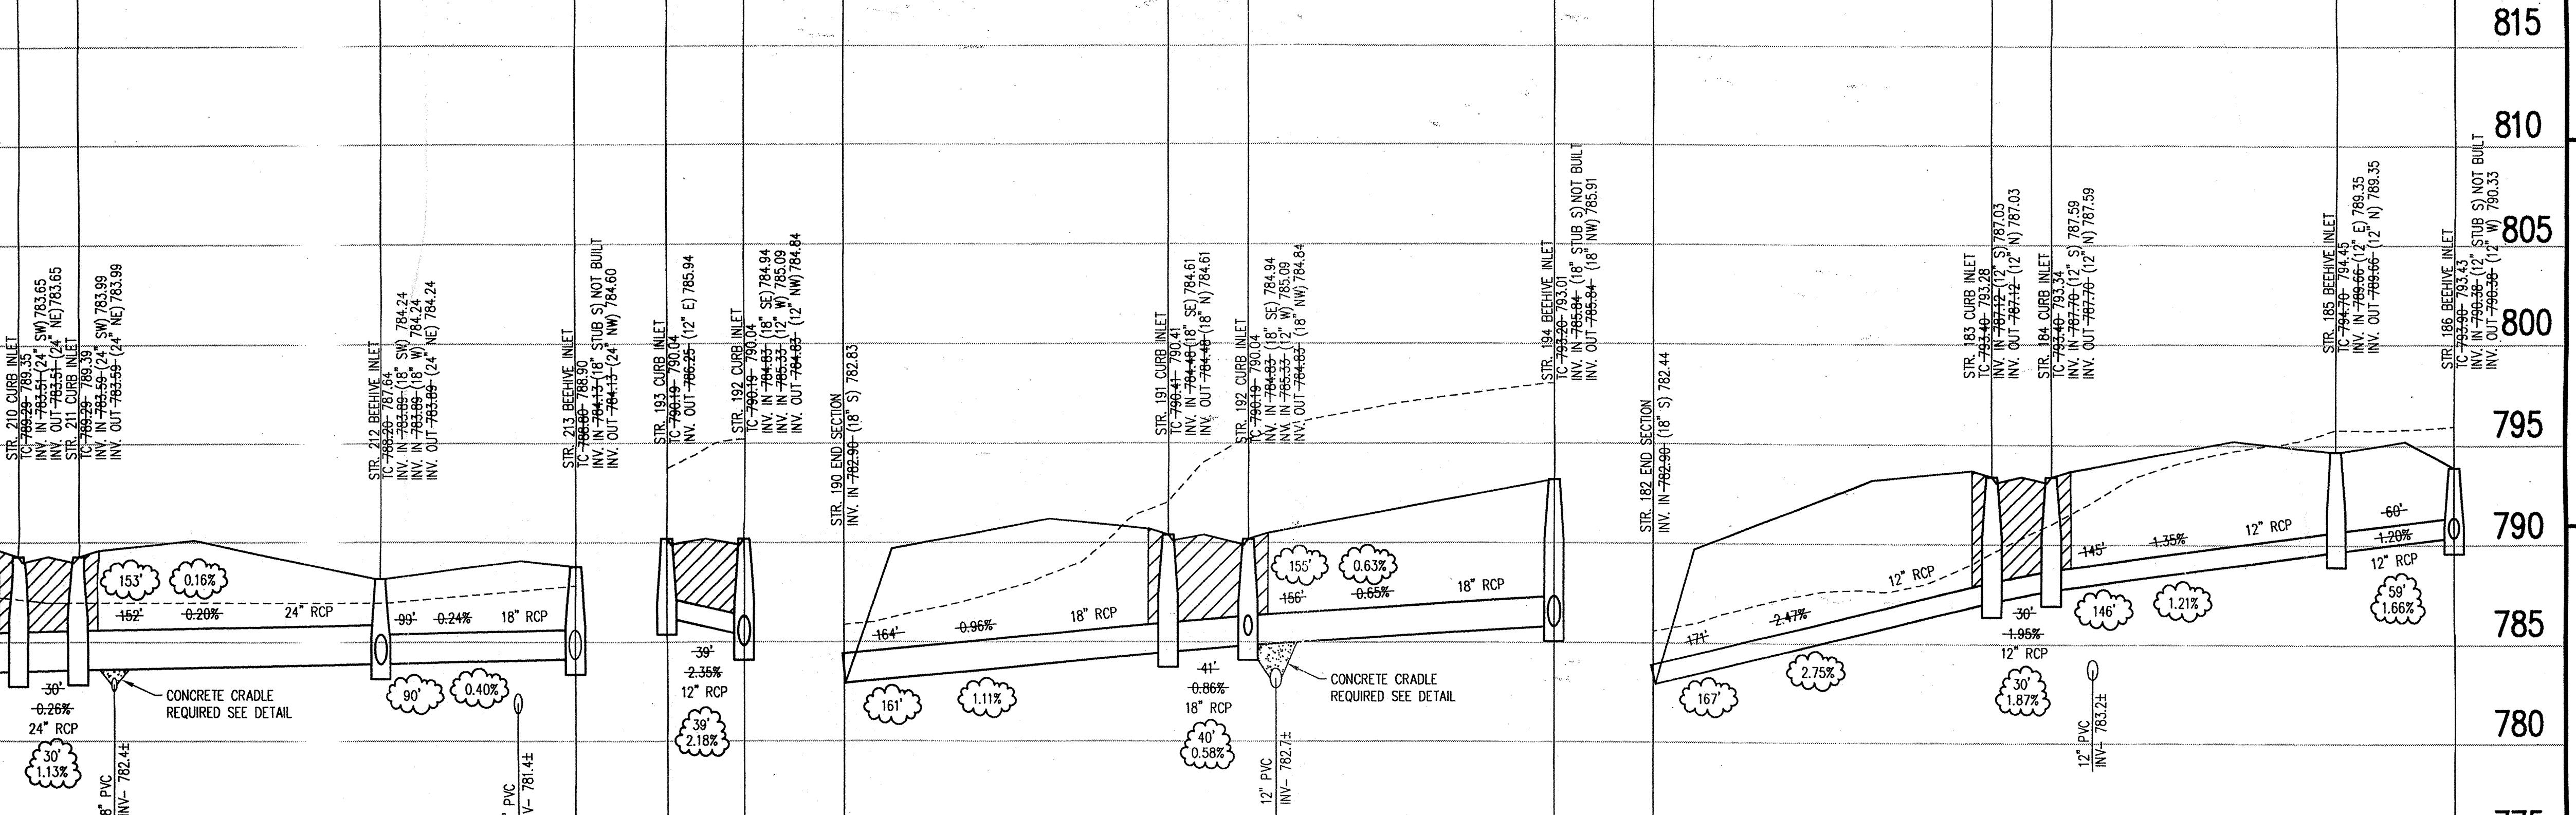

STORM SEWER RECORD DRAWING

STORM SEWER PROFILE

LEGEND

Existing Grade New Grade Granular Backfill

SCALE: HORIZ.: 1"=50'
VERT.: 1"=5'

This copy printed from the Digital Archive of the Hamilton County Surveyor's Office, One Hamilton Co. Square, Ste. 188, Noblesville, Indiana.

Date 5/04/99 Project No. 1025.11 Drawn DRP Approv. Sheeted C604
Computer Files J:\1025\DWGS\11\C604
XREF: J:\1025\DWGS\11\BBS
XREF: J:\1025\DWGS\11\STORM
XREF: J:\1025\DWGS\12\V2BS
Office of Hamilton County Surveyor