Drain: MANGANET O'BRIEL Drain #: 124
Improvement/Arm: OUTLET RECONSTRUCTION
Operator: J. LIVINGSTON Date: 5-10-04
Drain Classification: Urban/Rural Year Installed: 1980

## **GIS Drain Input Checklist**

- Pull Source Documents for Scanning
- Digitize & Attribute Tile Drains
- Digitize & Attribute Storm Drains
- Digitize & Attribute SSD
- Digitize & Attribute Open Ditch
- Stamp Plans
- Sum drain lengths & Validate
- Enter Improvements into Posse
- Enter Drain Age into Posse
- Sum drain length for Watershed in Posse
- Check Database entries for errors



## Gasb 34 Footages for Historical Cost <u>Drain Length Log</u>

Drain-Improvement: MARGARET O'BRIEL - OUTLET RECONSTRUCTION

	PITCH R	ECONSTRUCTE	ED WITH C	2055 Poi	F. Busine	0.5 TBA 2.4
nal Report:	/A					
,	Sum:	<u>~150</u>	80′	-70	•	\$ 3,925.2
					<del></del>	
TILE OUTLET RELOCATION		0'				
SILT TRAP						
DINEOGIAG 58'		0'				
		/85	80	-70		
OPEN DITCH		~ 150'	80'			
Drain Type:	Size:		Length (DB Query)	Length Reconcile	Price:	Cost:





Kenton C. Ward, Surveyor

773-6110 Ext. 19

Noblesville, Ind. 46060 December 16 1980

TO: Hamilton County Drainage Board

RE: Margaret O' Brien Drain

Attached is a claim from J & W Excavating in the amount of \$529.15 for the Margaret O'Brien Drain. Thus reperesents the 15% retainer on the project. I have checked the work and found it to be satisfactory. I believe that the banks will need to be reseeded in the Spring. This can be done under maintenance. I recommend that the claim be approved.

I have spoke to Mr. Thomas of N & W Rail Road today. He has informed me that under the Rail Road is a 12" cast Iron Pipe 36' in length. It It is located approximatley 36 feet North of the surface water pipe. In view of this I believe that the pipe under the RailRoad can be cleaned out and the tile replaced as required by the maintenance contractor. Mr. Thomas did request that a RailRoad representative be present while working in the RailRoad R/W.

KCW/no

Kenton C. Ward-County Surveyor





Kenton C. Ward, Surveyor

773-6110 Ext. 19

Noblesville, Ind. 46060 November 5, 1980

To: Hamilton County Drainage Board

Re: Margaret O'Brien Drain

Today I made the final inspection on the above named drain and found the project to be complete. I recommend to the Board that the attached claim for J & W Excavating in the amount of \$3,000.00 be allowed. balance of the contract price should be paid in 60 days.

KCW/jg

## CONSTRUCTION NOTES

1. Benchmarks

TBM #1 - Nail in tree, 75' South of West crossing - El. 50.0 TBM #2 - Nail in telegraph pole, 50' South of Railroad culvert, East side El. 46.25

- 2. Construct a stilling basin on the west side of crossing #1 and line it with 7" graded riprap. Approximately 20 Ton
- Start dredging the ditch 150' downstream from crossing #2. End dredging at the stilling basin.


Channel Dimensions
Bottom width - 4'
Side slopes - 2:1
Grade - 0.0016

- 4. Change the present outlet of the 12' tile to a position just down-stream from the stilling basin. A 20' section of CMP and animal guard placed at the end of the tile will protect the outlet. A section of 12" plastic tile may be used to direct the tile towards the ditch.
- 5. Remove crossing #2 and replace it with 30' of 36" CMP. Backfill the pipe with sand. Set the pipe 6" below the ditch bottom.

6. Repair blow holes on the east side of the railroad tracks Cosy reserves work

7. Seed all disturbed acres with - (at the end of each construction day)
30#/acre of Fescue
10#/acre of Rye grass
600#/acre 12-12-12 fertilizer

LOCATION P	LAN			
	· · · · · · · · · · · · · · · · · · ·			
	106th Street			
<b> </b>	: 11 ;			
Ebi: // : : :	:			
EI:	^ ^ ~ ~ ~			
	1			
F  : : // : : : : : : : : : : : : : : : :	5/4			
E I				
Hom	e			
Start				
F Start / 3	11 4 7			
	ing Tile 12"			
t /: //				
	New Outlet			
1/2	wear Couter			
and the state of t	=			
	68			
F :       : : : : : : : : : : : : : : :	E			
	$:\int \int \int \int_{\mathcal{S}'} \int \int \int \int_{\mathcal{S}'} \int $			
100'	Colvert =			
	· · · · · · · · · · · · · · · · · · ·			
	Stilling Basin			
F : : : : : : : : : : : : : : : : : : :				
- Not to Scale	······ij······ij/·····ij/			
— <u> </u>				
Farm Boundary	SECTION Delaware - Sec. 12			
Permanent Fence X X X  Existing Tile Line O	TOWNSHIP RANGE			
Proposed Tile Line	COUNTY Hamilton STATE IN			
New Tile Installed	COOPERATOR M. OBERN LEGEL Drain			
Proposed Deep Ditch	COOPERATING WITH Deginge Posed			
Proposed Shallow Ditch	SURVEYED BY Ward + Hartin			
	SOUNTIED BY TANKET THEY THEY			
CONSTRUCTION REPORT 23				
Date installed	DRAINAGE PLAN			
Staked By	M. O'Brien Drain			
Amount	U. S. DEPARTMENT OF AGRICULTURE SOIL CONSERVATION SERVICE			
Pemarko:	Oesigned J. Solla 5/80 Approved by T. Schellenbe gar			
Remarks:	Designed 7 50 / 11/2 5/80 Approved by La Series Series			
	Drawn Title Traced Sheet Drawing No			
SIGNATURE DATE	Onecled Of			
USDA-SCS-MILWAUKEE, WIS. 1960 ORDER THIS	BLANK DATA SHEET BY DRAWING NUMBER 3-L-45875			

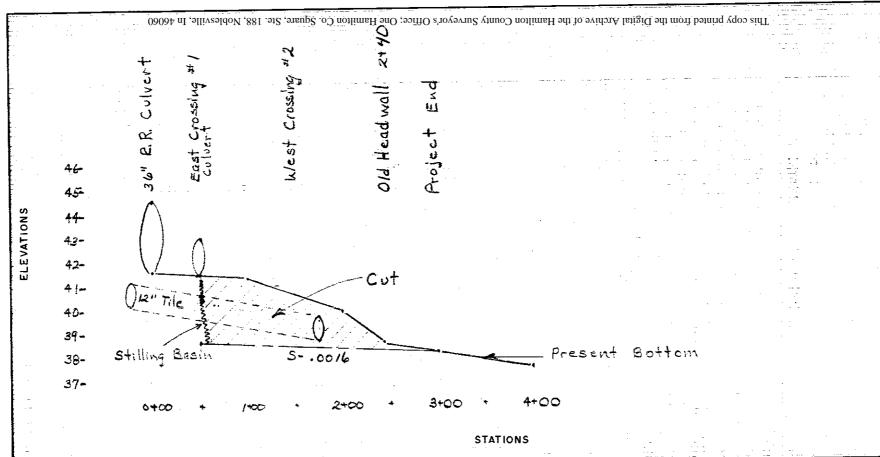

DESIGN DETAILS										Bench Mark Description:			
		DRAIN DIT		DITCH DIMENSIONS		ONS			DRAIN V				BM "   Nail in tree, 75' South of West Crossing El-50
LINE	STATIONS	AREA	DEPTH	TOP	воттом	SIDE	SHZE	GRADE	COE . OH		1 -	AVAIL.	BM=2 Nail in telegraph pole,
-	1	ACRES	FEET	FEET	FEET	SLOPE	HICHES	%	CURVE	Ft/Sec.		c.f.s	
Mode	0+50 to 3+00	300	4	-	4	2:1		.16	B	2.7	45	45	South of R.R. colvert, Ensisted Materials: El. 46.25
										<u> </u>		<u> </u>	materiols. En re, 25
						 					<del> </del>	ļ <del></del>	
								<u> </u>	<del>  -</del> -			<del>                                     </del>	<del>-</del>
							<u> </u>		<del> </del> _	<u> </u>	<del>                                     </del>	1	4
			<u> </u>				-		-	ļ		<del> </del>	1
		<u> </u>	<u> </u>	ļ <u> </u>				├	<del> </del>	<del> </del>	<del> </del>	<del> </del>	1 .
REGULA	AR INSPECTIO	N OF	THE DE	RAIN S	YSTEM	IS ES	SENTIA	AL. PR	ROMPT	REPA	R OF	ANY	
FAIL LIR	E WILL KEEP	THE	SYSTE	M IN N	<b>NORKIN</b>	G ORE	ER AN	ID MAI	INTENA	NCE C	COSTS	LOW.	

E1-500