



SURVEYOR'S OFFICE
Hamilton County

Kenton C. Ward, CFM
Surveyor of Hamilton County
Phone (317) 776-8495
Fax (317) 776-9628


Suite 188
One Hamilton County Square
Noblesville, Indiana 46060-2230


Map Correction-Field Verification

Drain Number: # 32 Overman-Harvey	Drain Length: 4102'
Drain Name: Village Farms Sec. 8	Change +/-: 342'
Date: 11-18-08	New Length: 4444'
Verified By: SAB, GRH	

Notes & Sketch:

SEE attached map. 6"SSD was actually installed on the West SIDE of 36" RCP between STRS. 113 & 116. This was installed with Section 8 but never reported.

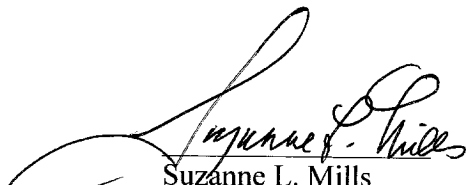
Suzanne L. Mills
GIS Specialist

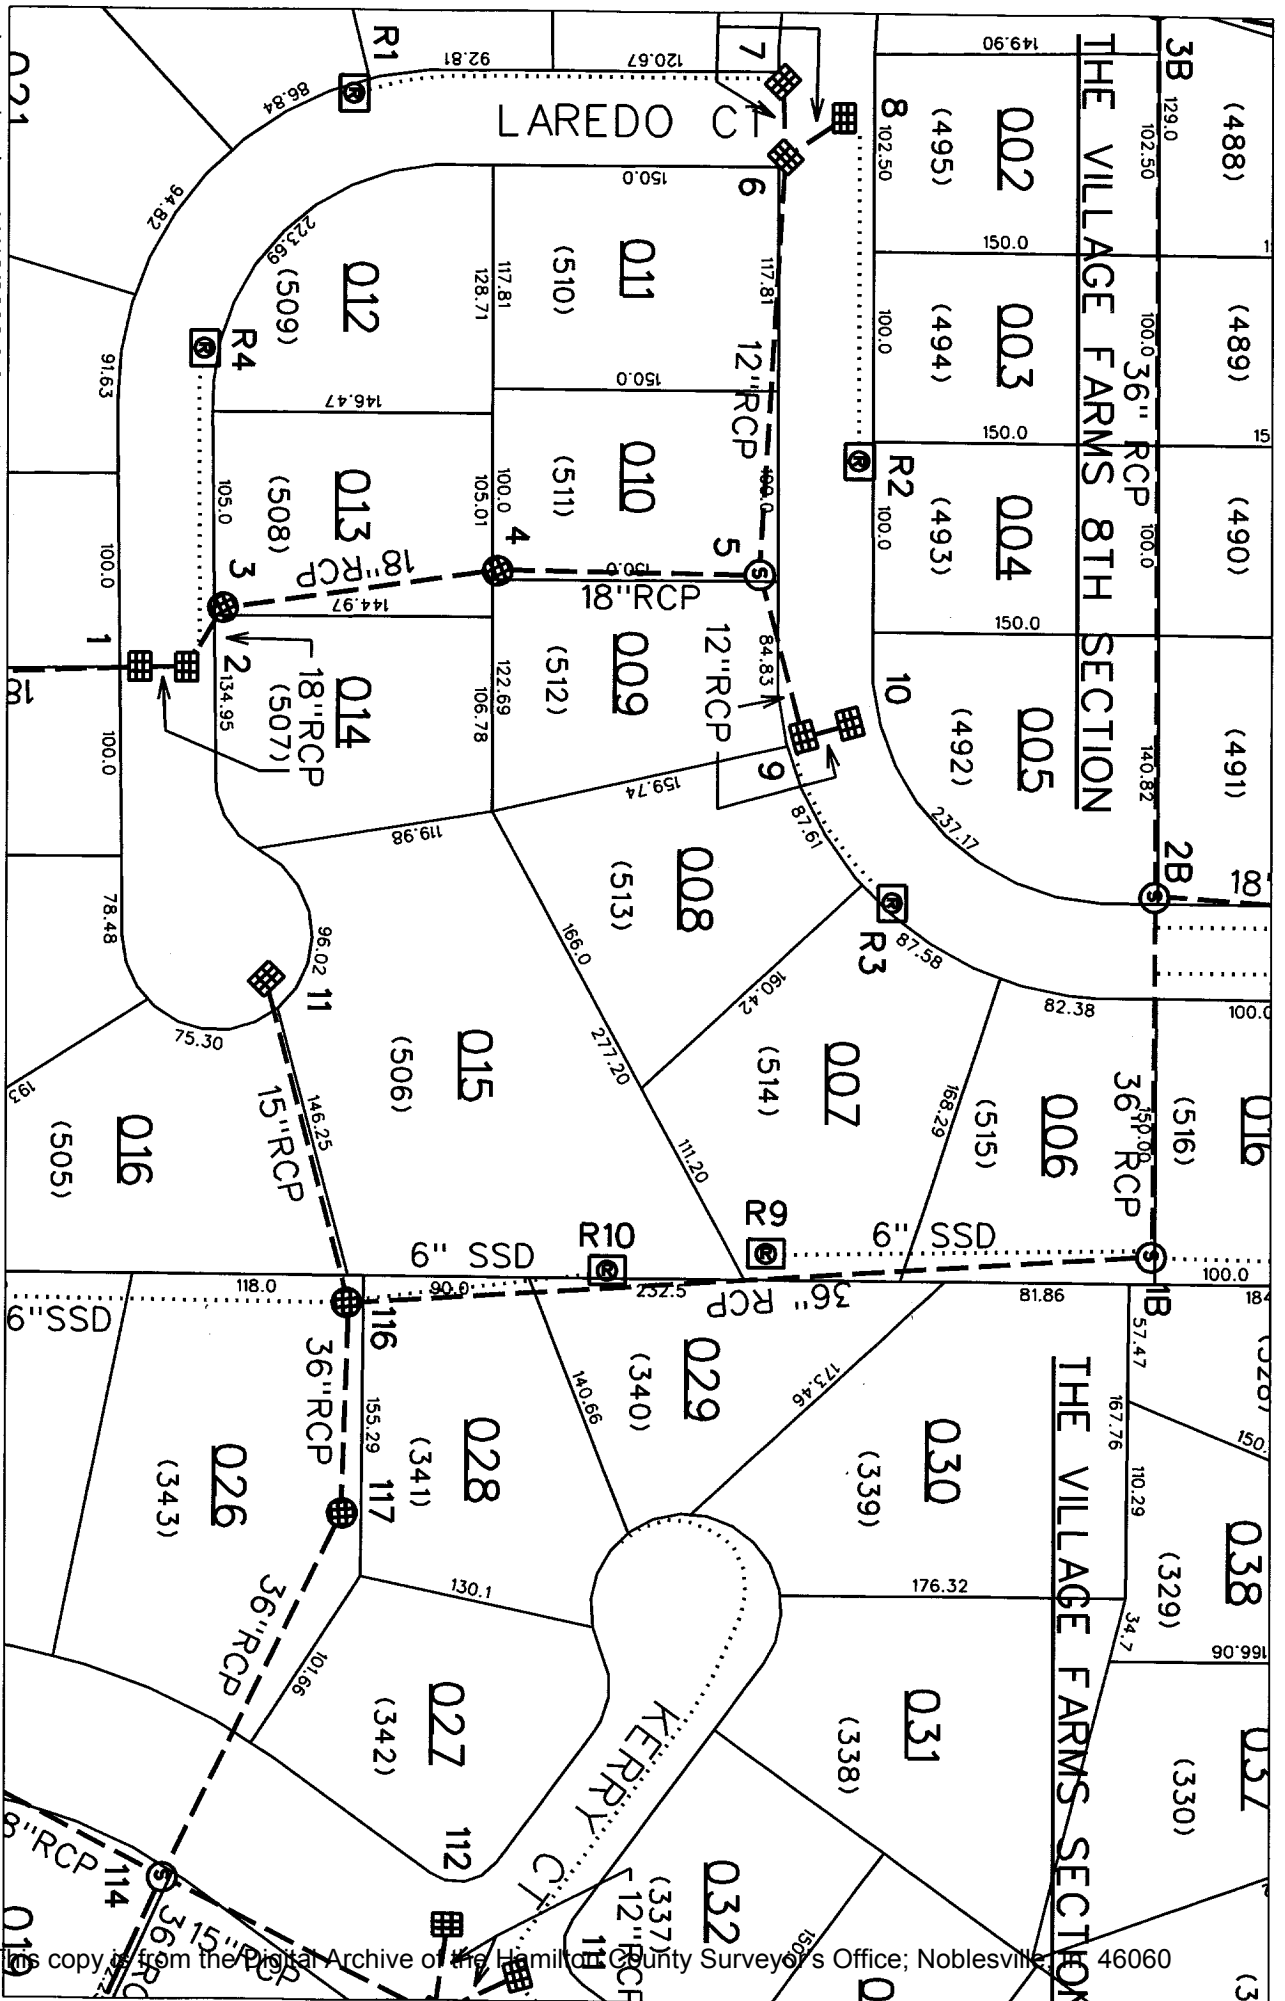

sub_rg_drm.dgn 11/18/2008 3:04:54 PM