

Drain: OVERMAN-HARVEY DRAIN Drain #: 32
 Improvement/Arm: VILLAGE FARMS - SECTION 10
 Operator: JDH Date: 5-26-04
 Drain Classification: Urban/Rural Year Installed: 1991

GIS Drain Input Checklist

- Pull Source Documents for Scanning JDH
- Digitize & Attribute Tile Drains N/A
- Digitize & Attribute Storm Drains JDH
- Digitize & Attribute SSD JDH
- Digitize & Attribute Open Ditch N/A
- Stamp Plans JDH
- Sum drain lengths & Validate JDH
- Enter Improvements into Posse JDH
- Enter Drain Age into Posse JDH
- Sum drain length for Watershed in Posse JDH
- Check Database entries for errors JDH

~~XXXXXX~~
~~XXXXXX~~

UNION STATE BANK

21 Jefferson Square • P. O. Box ~~388~~ • Carmel, Indiana 46032
1710

TELEPHONE
AREA CODE 317
846-7381

IRREVOCABLE
LETTER OF CREDIT NO. 2916

DATE May 24, 1991

BENEFICIARY

Hamilton County Drainage Board
942 Maple Street
Noblesville, Indiana 46060

FOR ACCOUNT OF

Village Farms South Sect. 10
1350 Greyhound Court
Carmel, Indiana 46032

GENTLEMEN:

WE HEREBY ESTABLISH OUR CREDIT IN YOUR FAVOR, FOR THE ACCOUNT INDICATED ABOVE, FOR A SUM OR SUMS NOT EXCEEDING AN AGGREGATE AMOUNT OF Fourteen Thousand, Two Hundred Fifteen and no/100 Dollars (\$14,215.00)

FUNDS ARE AVAILABLE BY YOUR DRAFT(S) AT Carmel, Indiana
UNION STATE BANK P. O. Box 1710, Carmel, Indiana 46032

DRAWN ON UNION STATE BANK

Drafts are to be accompanied by:

Original Letter of Credit

ALL DRAFTS DRAWN UNDER THIS LETTER OF CREDIT ARE TO BE ENDORSED HEREON AND SHALL BEAR THE CLAUSE "DRAWN UNDER UNION STATE BANK LETTER OF CREDIT No. (AS INDICATED ABOVE)," and must be drawn and presented on or before May 24, 1992

WE HEREBY AGREE WITH YOU THAT ALL DRAFTS DRAWN UNDER AND IN COMPLIANCE WITH THE TERMS OF THIS LETTER OF CREDIT WILL BE DULY HONORED UPON PROPER PRESENTATION.

Except as otherwise expressly stated herein this Credit is subject to the Uniform Customs and Practice for Documentary Credits ¹⁹⁸³ ~~1974~~ Revision), International Chamber of Commerce, Publication ~~250~~ 400.

VERY TRULY YOURS,

AUTHORIZED SIGNATURE

Robert Steinhart, Vice President

TITLE

CERTIFICATE OF COMPLETION AND COMPLIANCE

TO: HAMILTON COUNTY SURVEYOR

RE:

RE: VILLAGE FARMS SECTION TEN

I hereby certify that:

- 1.) I am a Registered Land Surveyor in the State of Indiana,
- 2.) I am familiar with the plans and specifications for the above referenced subdivision,
- 3.) I have personally observed and supervised the completion of the Drainage Facilities for the above referenced subdivision, and
- 4.) To the best of my knowledge, information and belief, the Drainage Facilities within the subdivision has been installed and completed in conformity with all plans and specifications.

Signature: *Allan H. Weihe* Date: Nov 12, 1993

Type or Printed Name: Allan H. Weihe

Business Address: 10505 N. College Avenue, Indianapolis, Indiana 46280

Telephone: 846-6611

INDIANA REGISTRATION NUMBER

#8827

SEAL





SURVEYOR'S OFFICE
Hamilton County

Kenton C. Ward, Surveyor

Suite 146

776-8495

One Hamilton County Square

Noblesville, Indiana 46060-2230

July 27, 1995

TO: Hamilton County Drainage Board

RE: Overman-Harvey Drain
Village Farms - Section 10

Attached are the As Builts, Certificate of Completion and Compliance, and other information for the Village Farms, Section 10 Arm of the Overman-Harvey Drain. An inspection of the drainage facilities for this section has been made and the facilities have been found to be complete and acceptable. The system as constructed consists of the following:

6" SSD	1610 feet
15" RCP	159 feet
18" RCP	268 feet


The total length of this Section is 2037 feet.



The system as constructed corresponds to the preliminary system set out in my report dated October 15, 1979. The Board held a hearing in this matter on November 19, 1979, at which time the Board approved all proposed sections from Section 4 through Section 12 for construction.

The subsurface drains shown on the As Builts are those which will be maintained. All are in the road Right-of-Way. The portions to be maintained are those portions of the main lines which are within R/W or drainage easement. Laterals from the main line shall not be part of the regulated drain.

The bond or letter of credit from Union State Bank, number 2916 dated 5-24-91, in the amount of \$14,250.00, has been released.

The drainage facilities for this section intercept the Overman-Harvey legal drain at Village Farms Section 9. Section 10 ties into Section 9 at the southeast corner of Lot 552 of Section 10 and the southwest corner of Lot 549 also of Section 10. I recommend the Board accept the drainage facilities in this section.


 This information was gathered for input into the Hamilton County Geographical Information System. This document is considered an official record of the GIS.
 Entry Date: 5-26-04
 Entered by: JDM

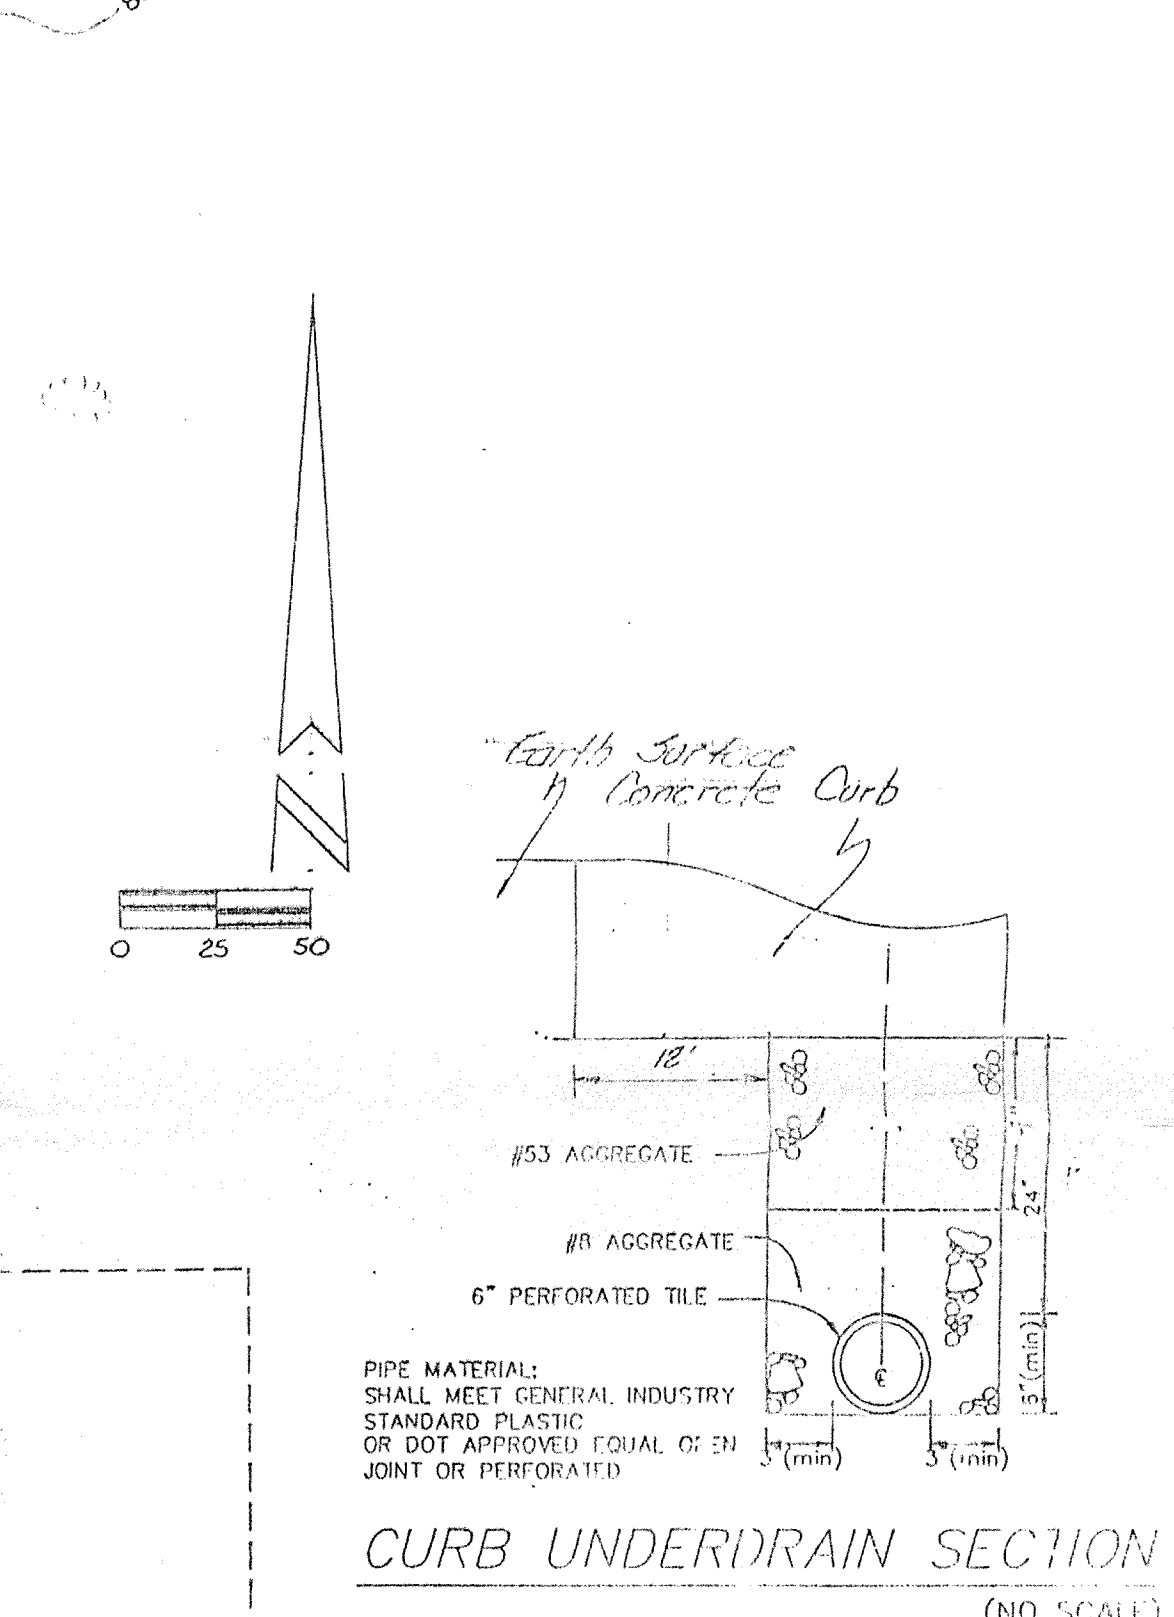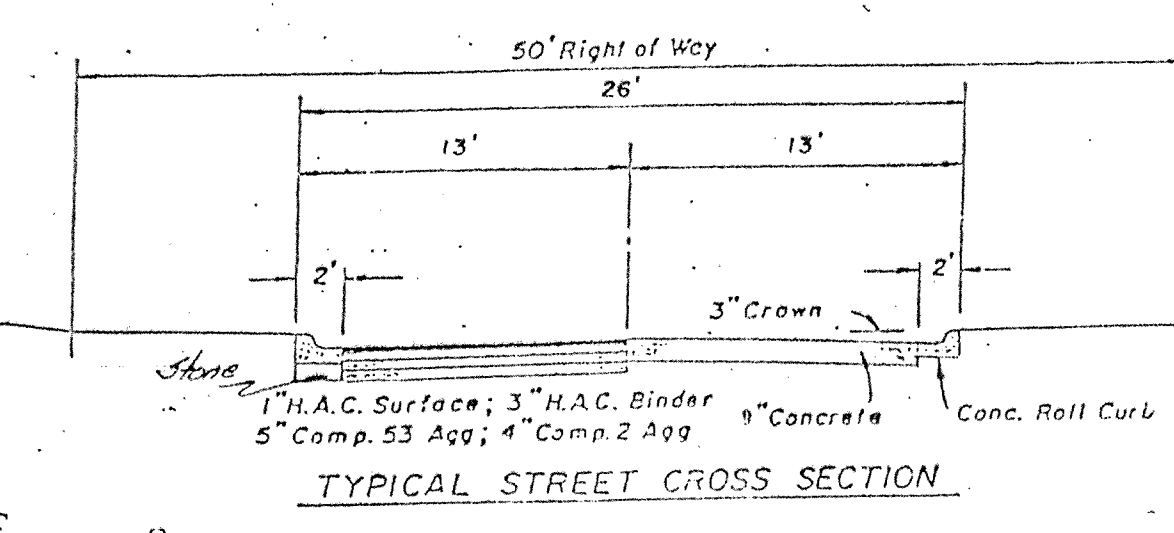

Village Farms Sections 8, 9, 10 & 11
STREET SIGN SUMMARY

TYPE SIGN	QUANTITY
STOP SIGN	SIX (6)
STREET SIGN	FIVE (5)

■ Steel Signs
 ■ Sign 51973

Note: Final placement of all highway signs to be determined by Hamilton County Highway Department.
 Posted Speed Limit within Village Farms Subdivision to be 25 miles per hour.



ALLAN H. WEIHE
 REGISTERED
 NO. 8827
 STATE OF INDIANA
 PROFESSIONAL ENGINEER

"RECORD DRAWING" ~ VILLAGE FARMS SECTION 10
 Storm sewers = TC's, inverts and grades Jan. 10, 1993

ALLAN H. WEIHE
 REGISTERED
 NO. 8827
 STATE OF INDIANA
 PROFESSIONAL ENGINEER

VILLAGE FARMS SEC. 10
 "RECORD DRAWING" Storm Sewer T.C.'s, Inv. grade

ALLAN H. WEIHE
 REGISTERED
 NO. 8827
 STATE OF INDIANA
 PROFESSIONAL ENGINEER

Entry Date: 4-17-04
 Entered by: JDM

PREPARED FOR: **ASBUILT SEC. 10**
R. L. Willifong
 Carmel, Indiana
 DEVELOPMENT PLAN - Village Farms

SHEET NO. **2**