

Kenton C. Ward, CFM
Surveyor of Hamilton County
Phone (317) 776-8495
Fax (317) 776-9628

Suite 188
One Hamilton County Square
Noblesville, Indiana 46060-2230

Map Correction-Field Verification

Drain Number: 84

Drain Length: 12,934

Drain Name: Jonas Rogers

Change + / - : 9,135

Date: 08-25-2010

New Length: 22,069

Verified By: SAB, SLM

Notes & Sketch:

Recently it was determined that the whole of the Jonas Rogers Drain was being maintained by Hamilton Co., even those portions in Tipton County. Therefore, the footage of drain listed for Watershed & GASB 34 purposes should be modified. They are as follows:


Jonas Rogers – 4300 feet of tile; 10,100 feet of open ditch

Eli Houser – 2500 feet of tile; 600 feet of tile

AC Hobbs – 2314 feet of tile

George Carpenter – 2255 feet of tile

Suzanne L. Mills
GIS Specialist

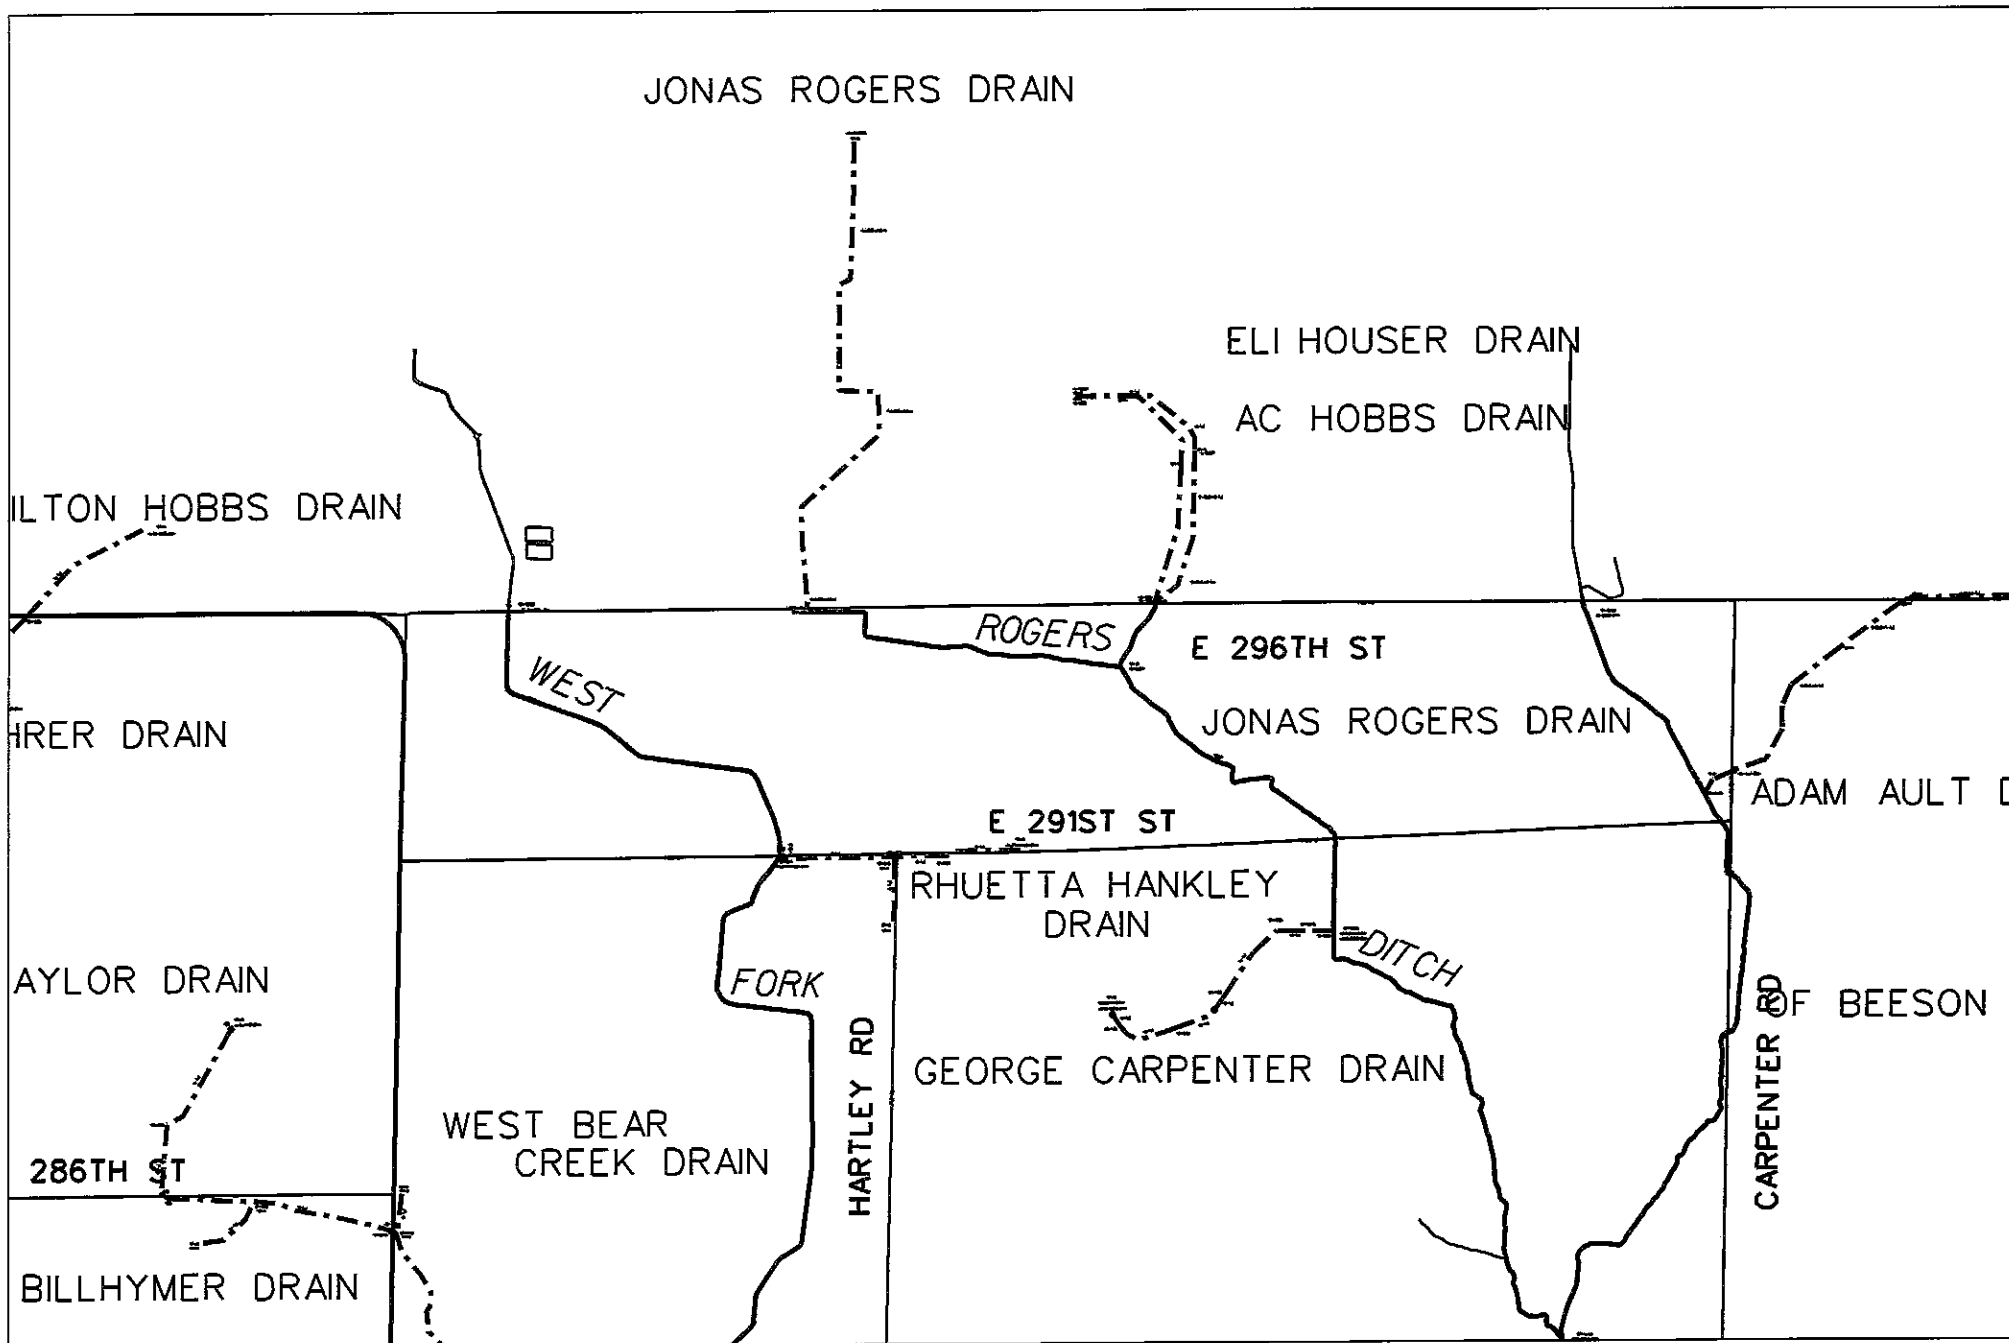

reg_drain_hc.dgn 8/25/2010 12:03:03 PM