



SURVEYOR'S OFFICE  
**Hamilton County**

Kenton C. Ward, CFM  
Surveyor of Hamilton County  
Phone (317) 776-8495  
Fax (317) 776-9628


Suite 188  
One Hamilton County Square  
Noblesville, Indiana 46060-2230

**Map Correction-Field Verification**

Drain Number: # 42	Drain Length: 25,584
Drain Name: Oliver Shoemaker: 141 <sup>st</sup> St Roundabout	Change +/-: + 19
Date: 04-3-09	New Length: 25,603
Verified By: JLL	

**Notes & Sketch:**

See attached Asbuilt. STR. 055 was Revised and 19' feet of 12" RCP & an inlet set. This was tied into STR. 055. These changes were made for the 141<sup>st</sup> St. Roundabout installed by the town of Fishers.

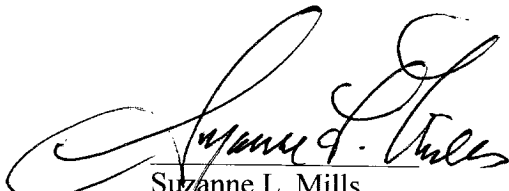  
Suzanne L. Mills  
GIS Specialist

CERTIFICATE OF COMPLETION AND COMPLIANCE

To: Hamilton County Surveyor

Re: Oliver Shoemaker Drain  
141<sup>st</sup> & Cumberland Road Reconstruction

I hereby certify that:

1. I am a Registered Land Surveyor or Engineer in the State of Indiana.
2. I am familiar with the plans and specifications for the above referenced subdivision.
3. I have personally observed and supervised the completion of the drainage facilities for the above referenced subdivision.
4. The drainage facilities within the above referenced subdivision to the best of my knowledge, information and belief have been installed and completed in conformity with all plans and specifications.

Signature:  Date: 1/5/09

Type or Print Name: Lyle D. Branson

Business Address: 7172 North Keystone #J  
Indianapolis IN 46240



Telephone Number: (317) 255-9339

SEAL



INDIANA REGISTRATION NUMBER

PLS 930007

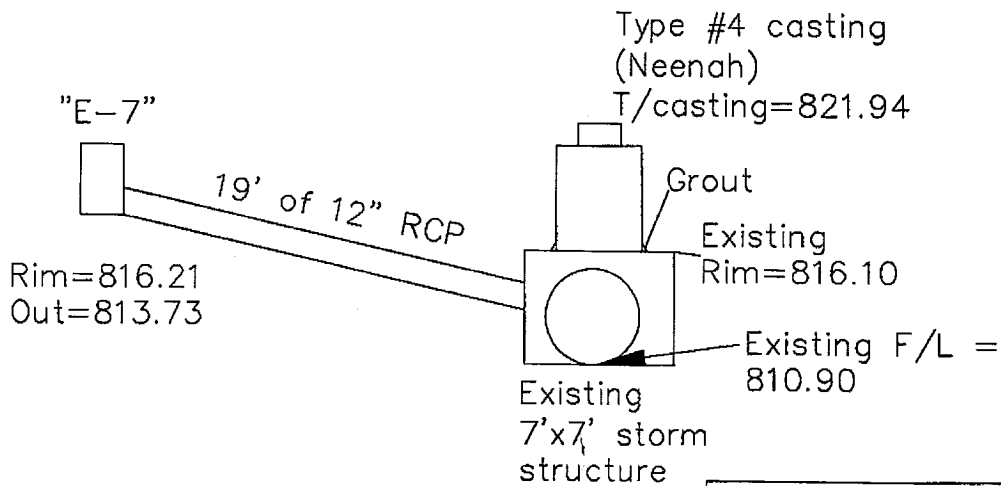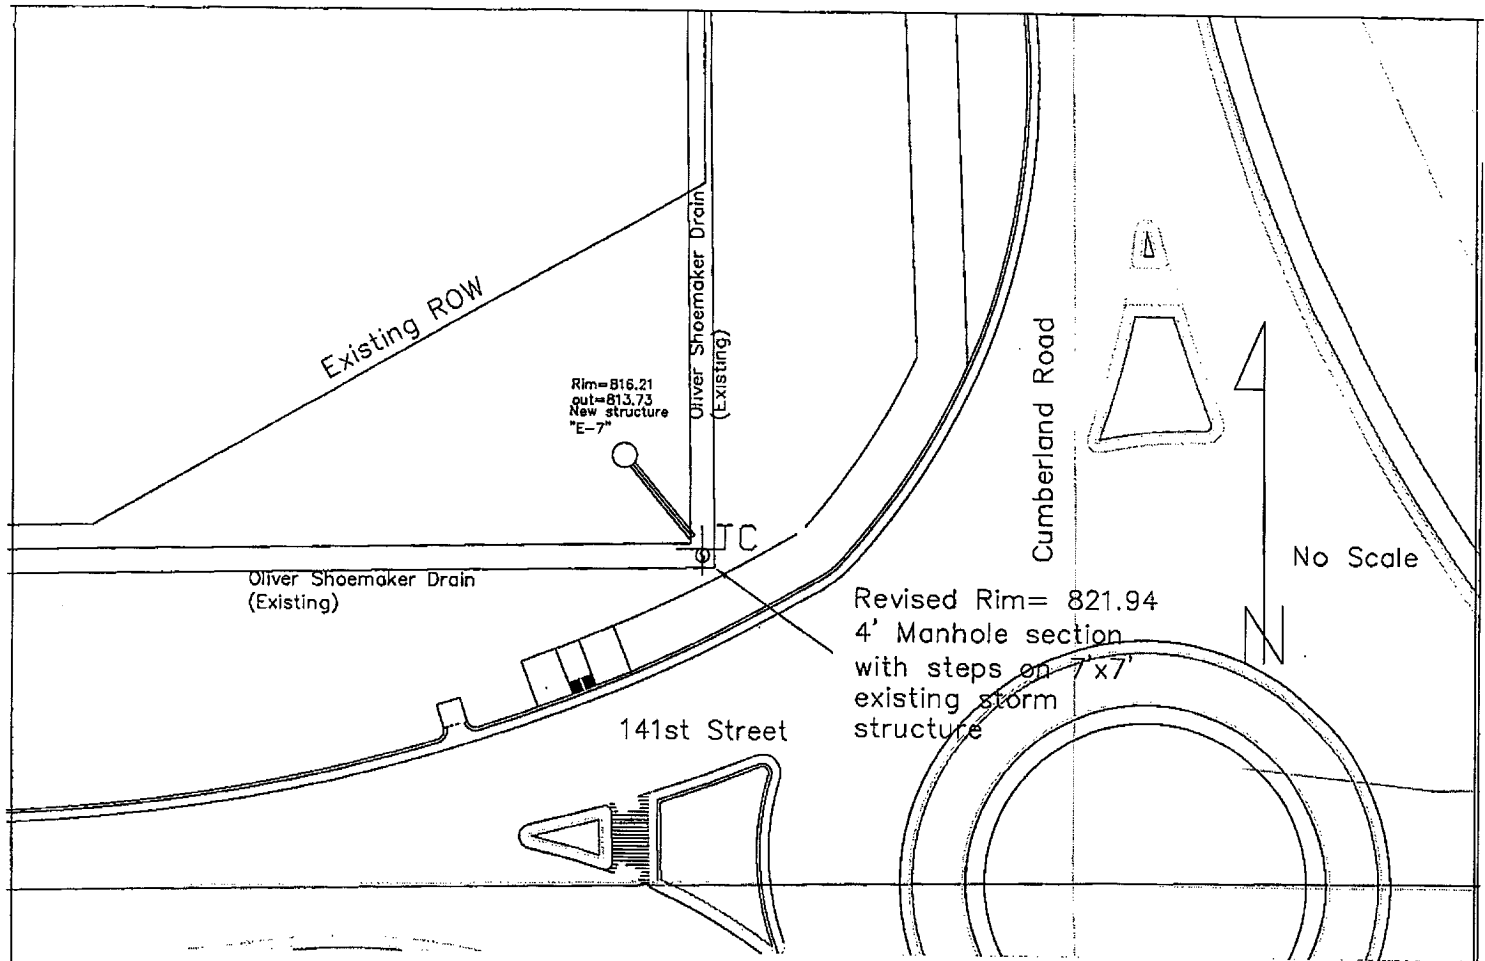

POST CONSTRUCTION SURVEY

This represents a survey completed under my direct supervision.

*Lyle D. Branson*  
 Lyle D. Branson  
 Surveytech  
 7172 N. Keystone Ave #J  
 Indianapolis, IN 46240  
 Job #28-037

*9/26/08*  
 Sept. 26, 2008  
 State of Indiana  
 Professional Land  
 Surveyor  
 PLS 9300007

