

Kenton C. Ward, CFM
Surveyor of Hamilton County
Phone (317) 776-8495
Fax (317) 776-9628

Suite 188
One Hamilton County Square
Noblesville, Indiana 46060-2230

Map Correction-Field Verification

Drain Number: 71

Drain Length: n/a

Drain Name: Ida Teter

Change + / - : n/a

Date: 07-13-2011



New Length: n/a

Verified By: SLM/SAB

Notes & Sketch:

The Ida Teter Drain was flagged and GPS'd between Station 20+42 and Station 30+80. Repairs were made and two breathers were set. Thus, the location of the tile was verified and adjusted in the GIS. However, the length of the drain was not changed. Notes on the repair can be found under the work order (WO-2011-00077).

Suzanne L. Mills
GIS Specialist

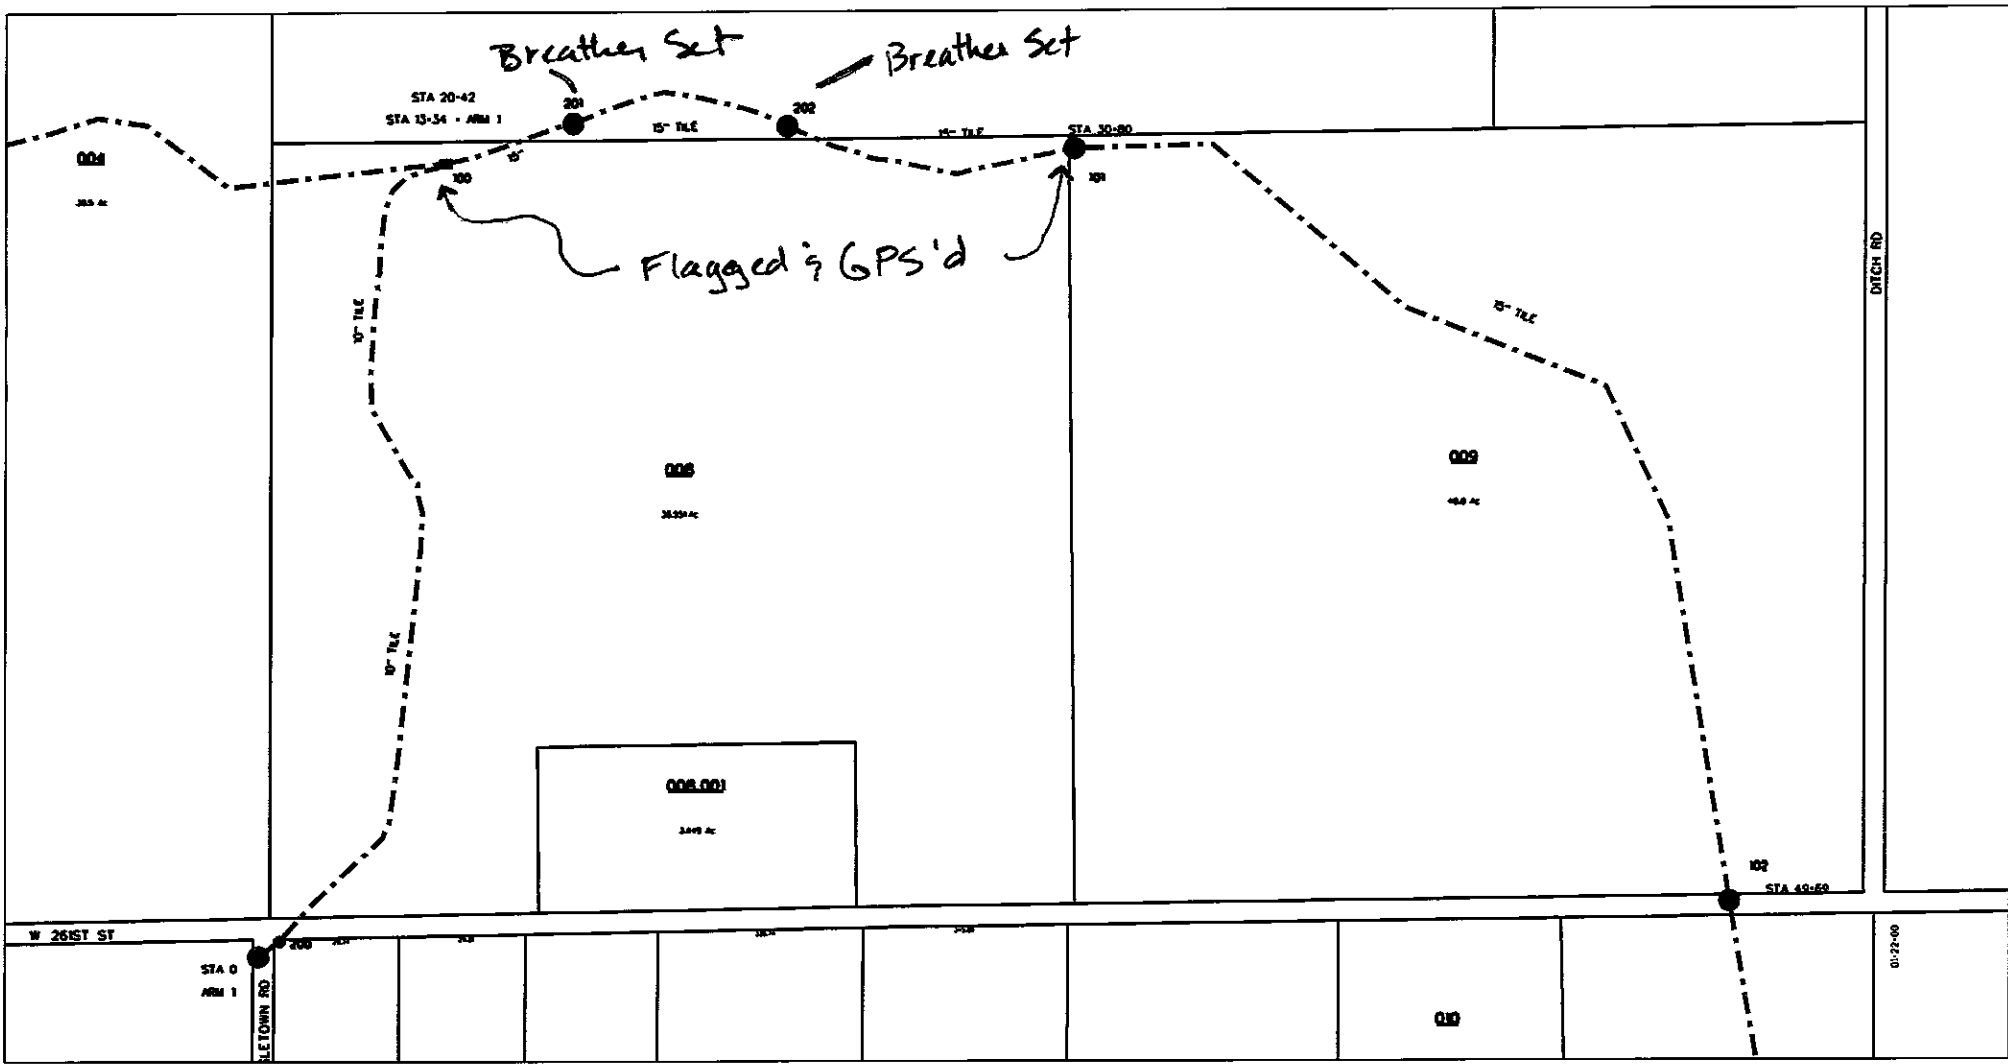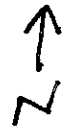

reg_drain_hc.dgn 7/13/2011 10:13:52 AM