


Kenton C. Ward, CFM
Surveyor of Hamilton County
Phone (317) 776-8495
Fax (317) 776-9628


Suite 188
One Hamilton County Square
Noblesville, Indiana 46060-2230

Map Correction-Field Verification



Drain Number: #189 Drain Length: 465'
Drain Name: Thistlewood; Thistlewood Extension Change +/-: -355'
Date: 3-16-2011 New Length: 110'
Verified By: SLM, LMC, JLL

Notes & Sketch: The City of Carmel widened 136th St. from Spring Mill Rd. to approximately 5000' east. The plans for this project were done by Schneider under project number 06-07. (Sheet 10)
This project removed str. 101-100 which consisted of 60' of 10" PVC. Also, the open ditch running to this section of pipe was also removed. Thus, 355' of drain was removed.


Suzanne L. Mills
GIS Specialist

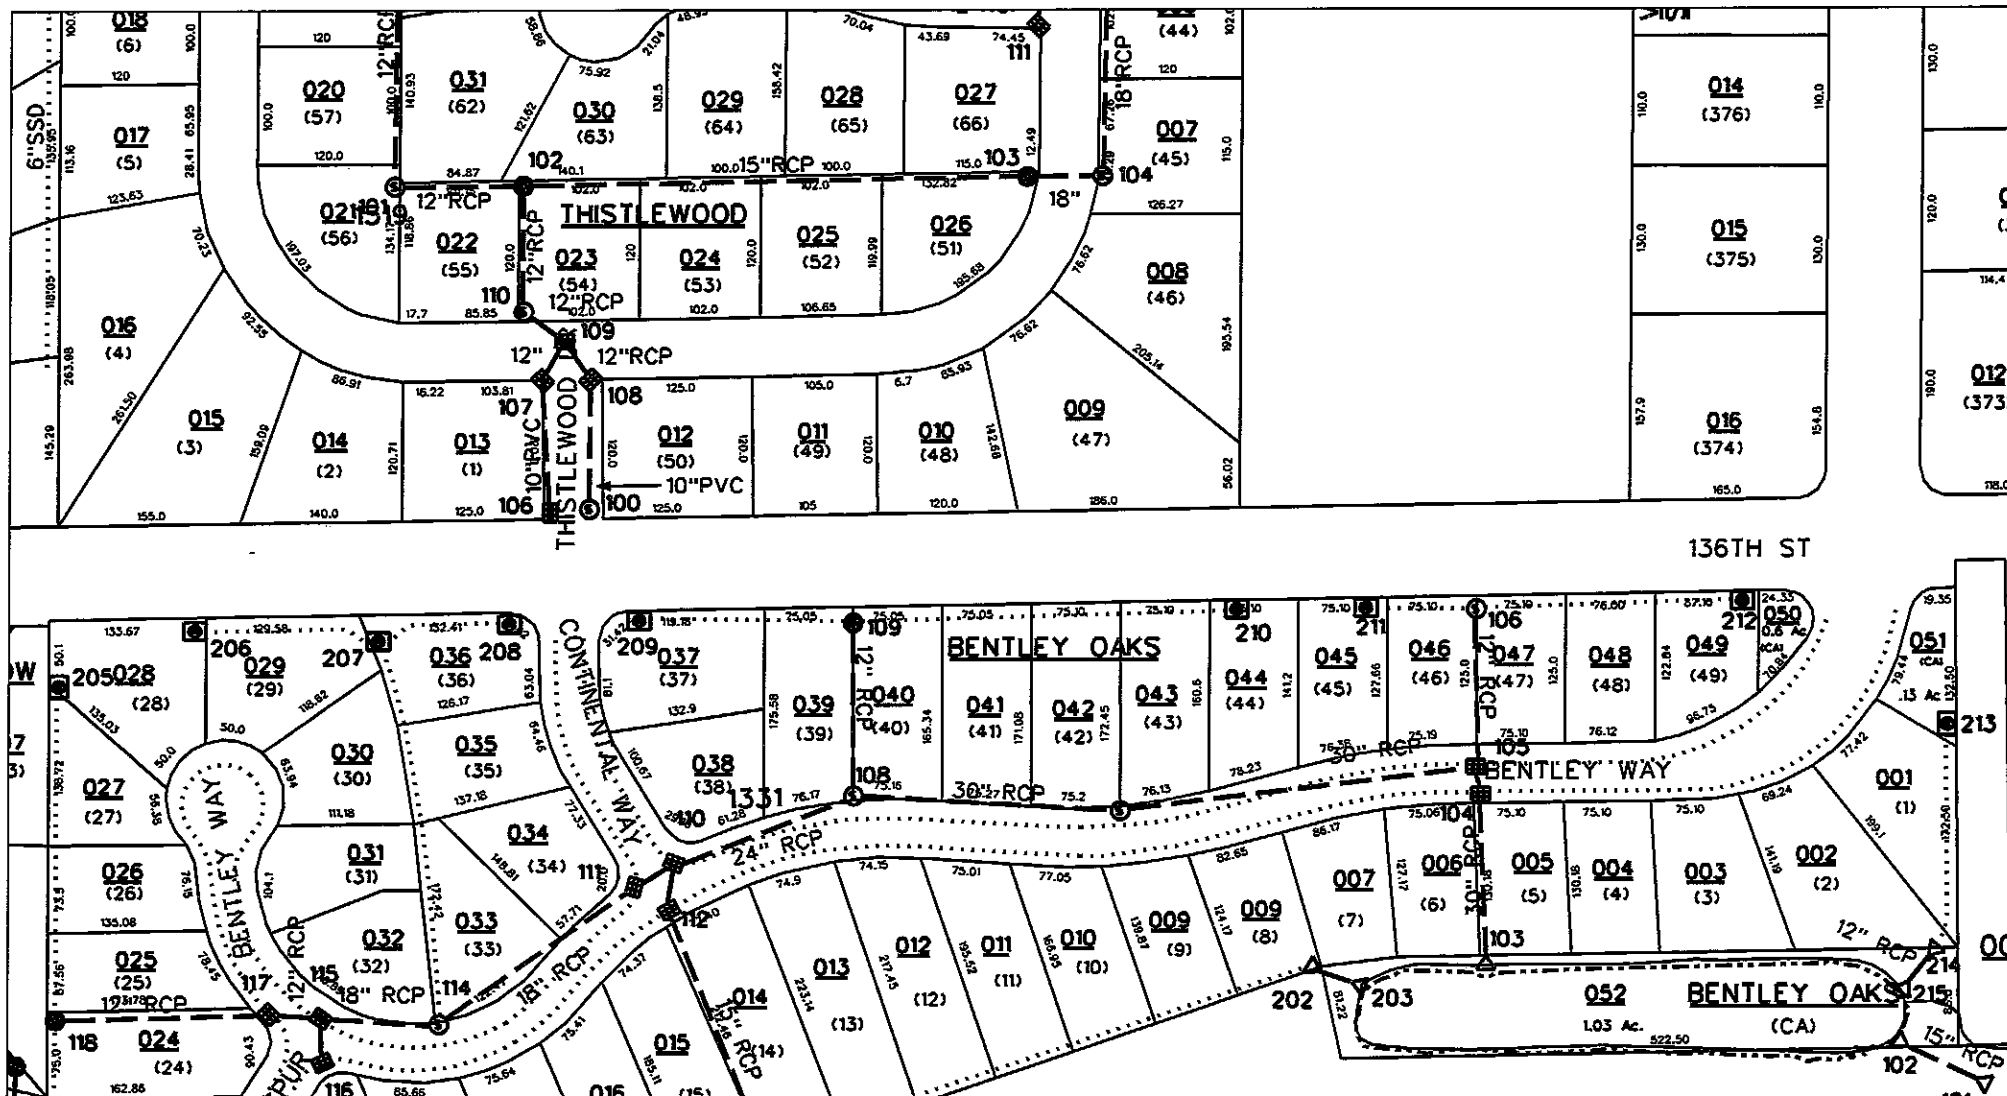

sub_rg_drm.dgn 3/16/2011 3:53:54 PM

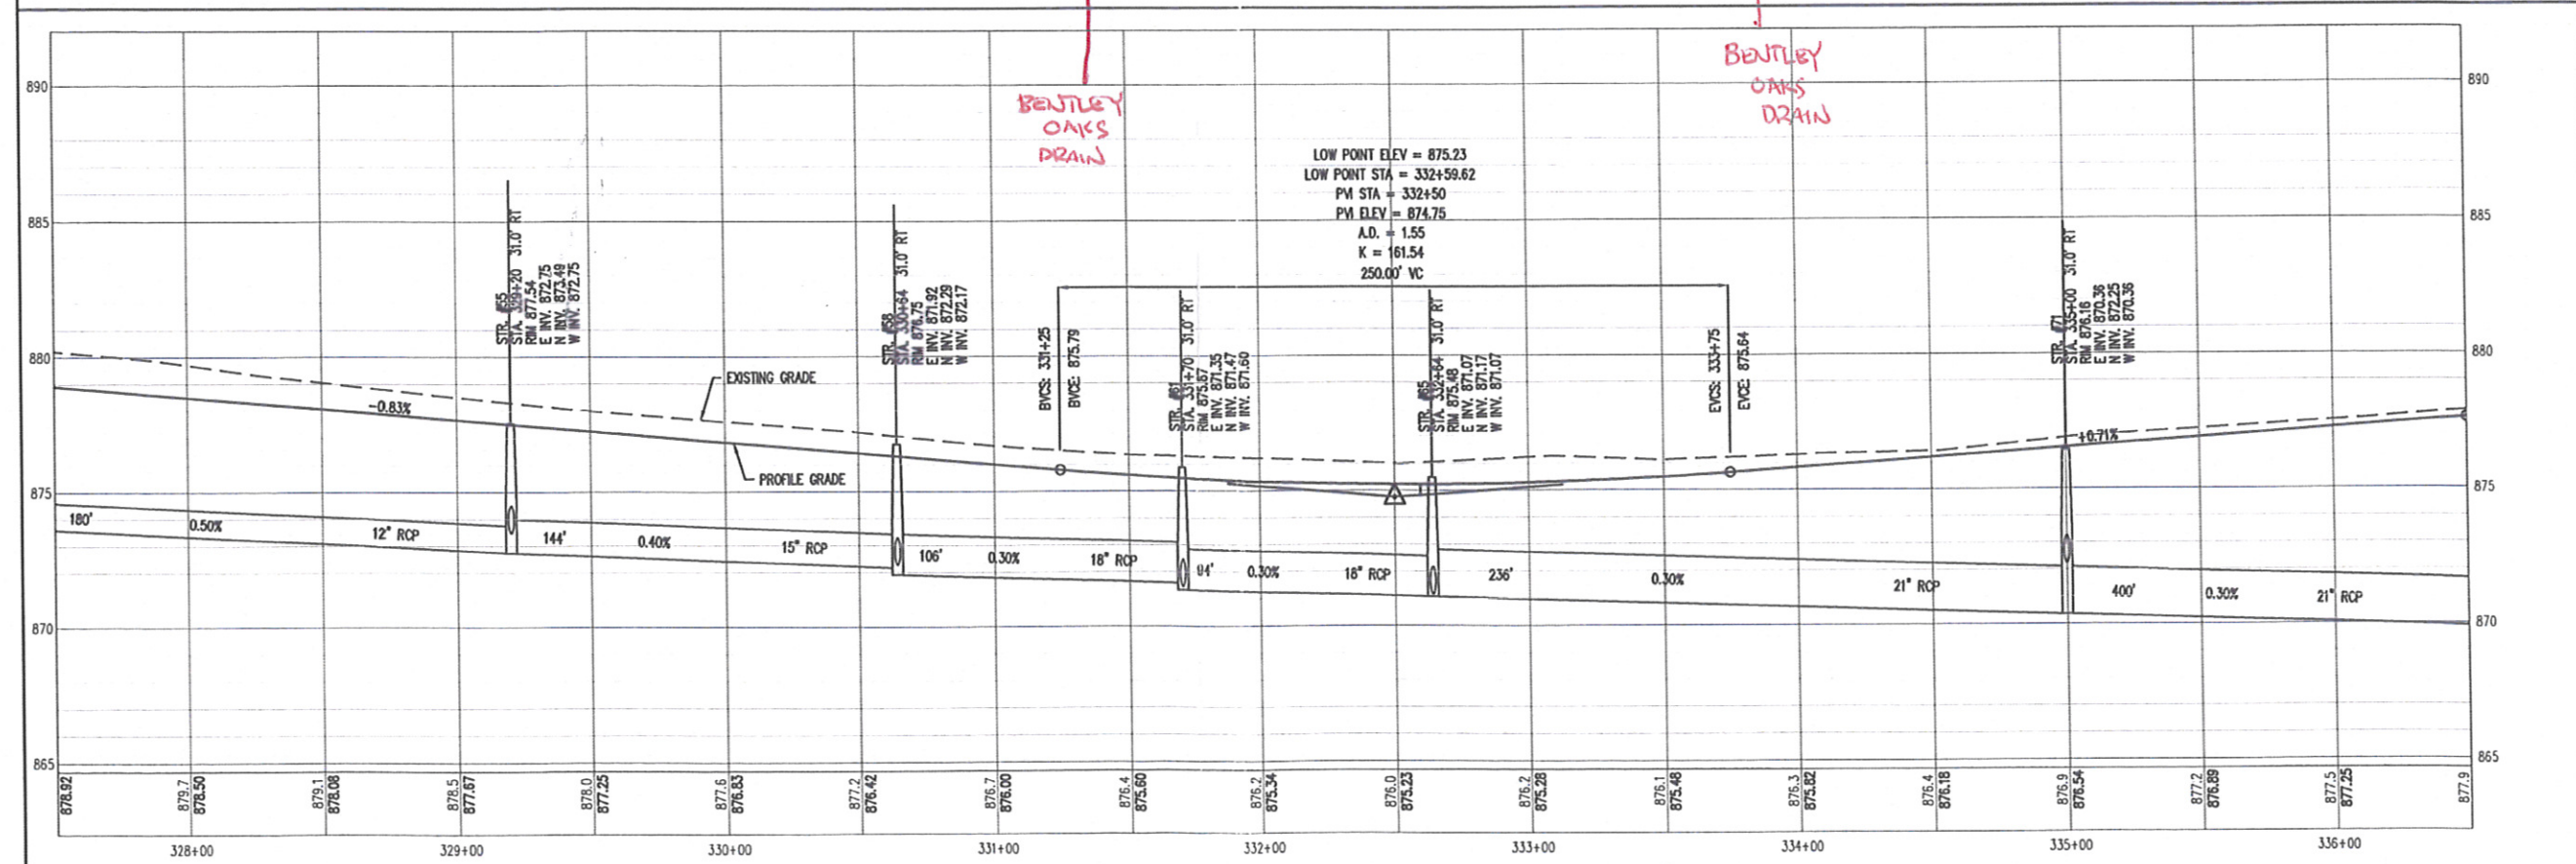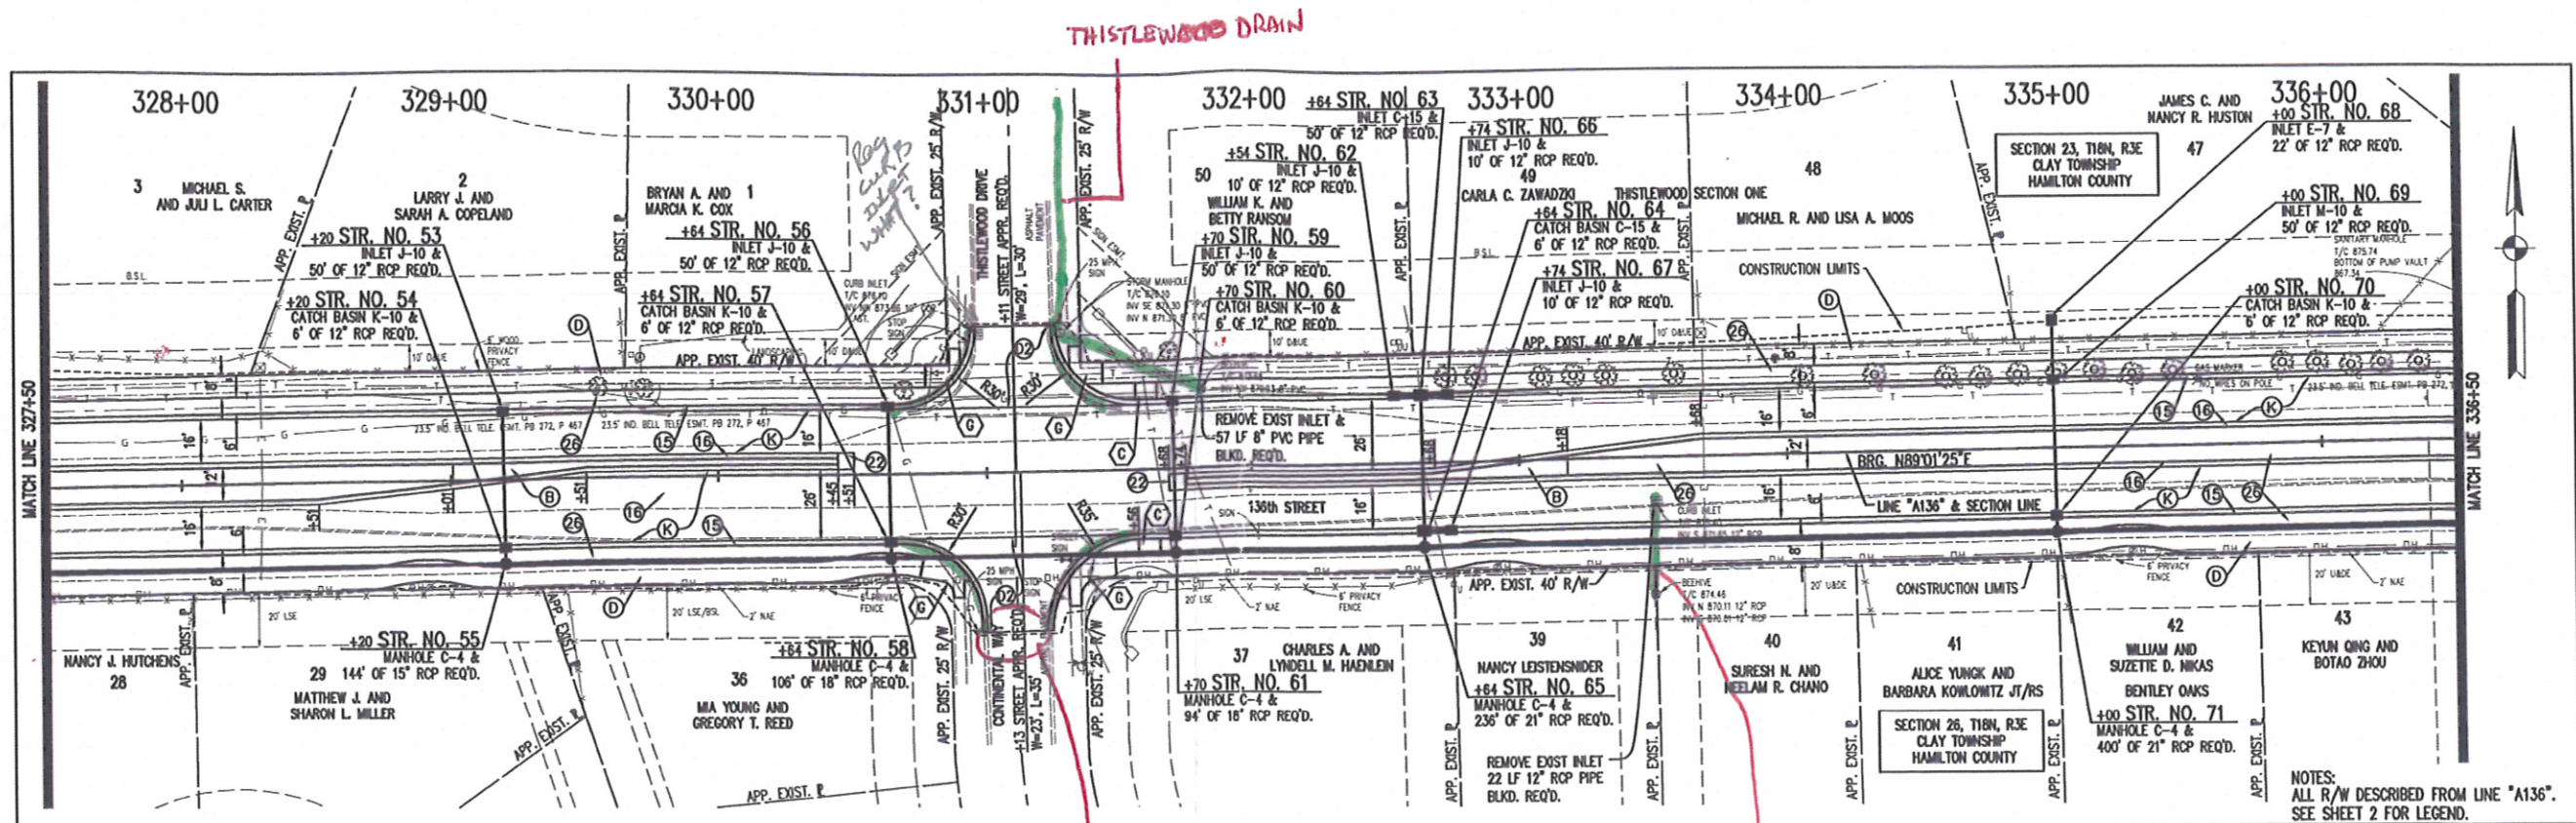

<p>Historic Fort Harrison 8901 Otis Avenue Indianapolis, Indiana 46216-1037 1-800-898-0332 317-828-7100</p> <p>Formerly Schneider Engineering Corp. / Bohlen, Meyer, Gibson & Assoc</p>	<p>RECOMMENDED FOR APPROVAL Preliminary - Not For Construction</p> <p>DESIGN ENGINEER DATE</p>	<p>CITY OF CARMEL</p> <p>136th STREET PLAN & PROFILE- LINE "A136"</p>	<p>HORIZONTAL SCALE 1"=30'</p> <p>VERTICAL SCALE 1"=3'</p>	<p>BRIDGE FILE DESIGNATION</p>
	<p>DESIGNED: SSB DRAWN: SSB</p> <p>CHECKED: ACD CHECKED: ACD</p>		<p>SURVEY BOOK SHEETS</p> <p>CONTRACT 10 of 44</p> <p>PROJECT 06-07</p>	