



Kenton C. Ward, CFM
Surveyor of Hamilton County
Phone (317) 776-8495
Fax (317) 776-9628

Suite 188
One Hamilton County Square
Noblesville, Indiana 46060-2230

To: Hamilton County Drainage Board

July 1, 2015

Re: Thor Run Drain, Reserve at Steeplechase, Sec. 1 Arm

Attached are plans for the proposed extension of the Thor Run Drain, Reserve at Steeplechase, Sec. 1 Arm. The proposal is to regulate the existing open drain currently on parcel 13-16-07-00-00-006.002 owned by MI Homes of Indiana LP and pipes under the Stretch Run Drive right-of-way, owned by the City of Fishers per the 'Reserve at Steeplechase, Sec. 1' project plans by Stoeppelwerth and Associates, Job No. 50060MI-S1, dated 7/10/2014. The upstream end of this extension will begin near the east property line at the downstream end of the existing pipe draining the Boulders Subdivision pond. The downstream end of this extension will end that the east right-of-way of Georgia Road.

This extension will consist of the following:

1255' of open drain 100' of 60" RCP

This proposal will add 1355 feet to the drain's total length.

The 100' of 60" RCP noted above consists of the culvert pipe under Stretch Run Drive.

It should be noted that the City of Fishers required the installation of a new temporary culvert pipe to be installed under Georgia Road parallel to an existing culvert. These culvert pipes are intended to be replaced by a single box culvert as part of the proposed roundabout project for 104th & Georgia Road. These temporary pipes are not part of this petition at this time. It is anticipated that the drain may be extended through the proposed box culvert in the future.

The Thor Run drain was previously referenced in my report dated May 20, 1998 For Thor Run Drain, Brooks Landing Sec. 1 Arm that was approved at hearing by the Board on June 29th, 1998 as recorded in Drainage Board Minutes Book 4 page 555-556. My other


previous reports for Thor Run drain also include the Brooks Landing, Sec. 2 Arm dated Oct. 24, 2002; Brooks Manor Arm dated July 16, 2001; Canal Place, Sec. 4 Arm dated Sept. 18, 2001; Valleys at Geist, Sec. 2 Arm dated May 18, 1999; and Valleys at Geist, Sec. 4 Arm dated Aug. 14, 2000. These reports were approved by the Board on Jan. 27, 2003, Aug. 27, 2001, Oct. 22, 2001, June 28, 1999, and Sept. 25, 2000 respectively.

The cost of the project is to be paid by the developer. Because this extension is a petition to regulate the existing open ditch, surety was not required. Surety was provided to the City of Fishers for the storm sewers installed with this subdivision, which includes the culvert pipe under Stretch Run Drive. This culvert pipe has been installed and inspected. The other storm sewers in the Reserve at Steeplechase, Sec. 1 are not part of this petition.

The easement for the new extension shall be 30' measured from each top of bank of the open drain as shown on the secondary plat for The Reserve at Steeplechase, Sec. 1. At this time, this plat is pending recording.

I recommend the Board set a hearing date for August 24, 2015.

Sincerely,

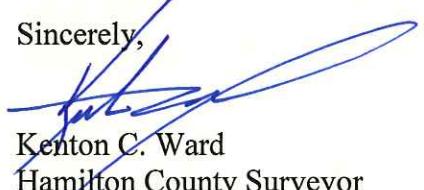
Kenton C. Ward
Hamilton County Surveyor

KCW/stc

Gasb 34 Asset Price & Drain Length Log

Drain-Improvement: Reserve at Steeplechase Sec. I Arm

Sum:

\$34,420 25

Final Report: _____

Comments:

STATE OF INDIANA)
) ss:
COUNTY OF HAMILTON)

BEFORE THE HAMILTON COUNTY
DRAINAGE BOARD
NOBLESVILLE, INDIANA

IN THE MATTER OF THE
RECONSTRUCTION OF THE
Thor Run Drain, Reserve at Steeplechase Section 1 Arm

FINDINGS AND ORDER FOR RECONSTRUCTION

The matter of the proposed Reconstruction of the *Thor Run Drain, Reserve at Steeplechase Section 1 Arm* came before the Hamilton County Drainage Board for hearing on August 24, 2015, on the Reconstruction Report consisting of the report and the Schedule of Damages and Assessments. The Board also received and considered the written objection of an owner of certain lands affected by the proposed Reconstruction, said owner being:

Evidence was heard on the Reconstruction Report and on the aforementioned objections.


The Board, having considered the evidence and objections, and, upon motion duly made, seconded and unanimously carried, did find and determine that the costs, damages and expenses of the proposed Reconstruction will be less than the benefits accruing to the owners of all land benefited by the Reconstruction.

The Board having considered the evidence and objections, upon motion duly made, seconded and unanimously carried, did adopt the Schedule of Assessments as proposed, subject to amendment after inspection of the subject drain as it relates to the lands of any owners which may have been erroneously included or omitted from the Schedule of Assessments.

The Board further finds that it has jurisdiction of these proceedings and that all required notices have been duly given or published as required by law.

Wherefore, it is ORDERED, that the proposed Reconstruction of the *Thor Run Drain, Reserve at Steeplechase Section 1 Arm* be and is hereby declared established.

Thereafter, the Board made inspection for the purpose of determining whether or not the lands of any owners had been erroneously included or excluded from the Schedule of Assessments. The Board finds on the basis of the reports and findings at this hearing as follows:

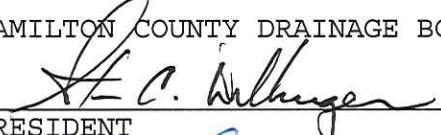HAMILTON COUNTY DRAINAGE BOARD

PRESIDENT

Member


Member

ATTEST: 
Executive Secretary

FILED

To: Hamilton County Drainage Board

JUN 17 2014

Date: June 17, 2014

Re: Thor Run Legal

Drain
OFFICE OF HAMILTON COUNTY SURVEYOR

M/I Homes

(Here-in-after "Petitioner"),

hereby petitions the Hamilton County Drainage Board under IC 36-9-27-66 for an arm to be installed to the Thor Run Legal Drain in order to serve the property of the petitioner. The petitioner, in support of said petition, advises the Board that:

1. The Thor Run Legal Drain is presently on a maintenance program and that land of the petitioner is assessed as benefited by the maintenance of the regulated drain;
2. There is no known adequate open or tiled drain connecting the land of the petitioner with the regulated drain;
3. The waters from the petitioner's land flow over or through land owned by others to reach the regulated drain;
4. The legal description of lands through which the new regulated drain will run along with the parcel numbers, name and address of each owner of that land is shown on Exhibit "A" which is attached;
5. The general route of the proposed new regulated drain and method of construction is shown on Exhibit "B" which is attached.
6. Petitioner agrees to pay all legal and construction costs involved with the construction of the proposed new regulated drain.

Signed



Printed

Mark Connor - M/I Homes

BEFORE THE HAMILTON COUNTY DRAINAGE BOARD
IN THE MATTER OF

Thor Run Drain, Reserve at Steeplechase Section 1 Arm

NOTICE

To Whom It May Concern and: _____

Notice is hereby given of the hearing of the Hamilton County Drainage Board concerning the reconstruction of the **Thor Run Drain, Reserve at Steeplechase Section 1 Arm** on **August 24, 2015** at **9:05 A.M.** in Commissioners Court, Hamilton County Judicial Center, One Hamilton County Square, Noblesville, Indiana. Construction and maintenance reports of the Surveyor and the Schedule of Assessments proposed by the Drainage Board have been filed and are available for public inspection in the office of the Hamilton County Surveyor.

Hamilton County Drainage Board

Attest:Lynette Mosbaugh

ONE TIME ONLY

STATE OF INDIANA)
)
) SS BEFORE THE HAMILTON
)
COUNTY OF HAMILTON) DRAINAGE BOARD

**IN THE MATTER OF Thor Run Drain, Reserve at Steeplechase
Section 1 Arm**

NOTICE

Notice is hereby given that the Hamilton County Drainage Board at its regular meeting **August 24, 2015** adopted the reconstruction report of the Surveyor and the Amended Schedule of damages and assessments including annual assessment for periodic maintenance, finding that the costs, damages and expense of the proposed improvement would be less than the benefits which will result to the owner of lands benefited thereby.



The Board issued an order declaring the proposed improvement established. Such findings and order were marked filed and are available for inspection in the Office of the Hamilton County Surveyor.

If judicial review of the findings and order of the Board is not requested pursuant to Article VIII of the 1965 Indiana Drainage Code as amended within twenty (20) days from the date of publication of this notice, the findings and order shall become conclusive.

HAMILTON COUNTY DRAINAGE BOARD

BY: Steven C. Dillinger
PRESIDENT

ATTEST: Lynette Mosbaugh
SECRETARY

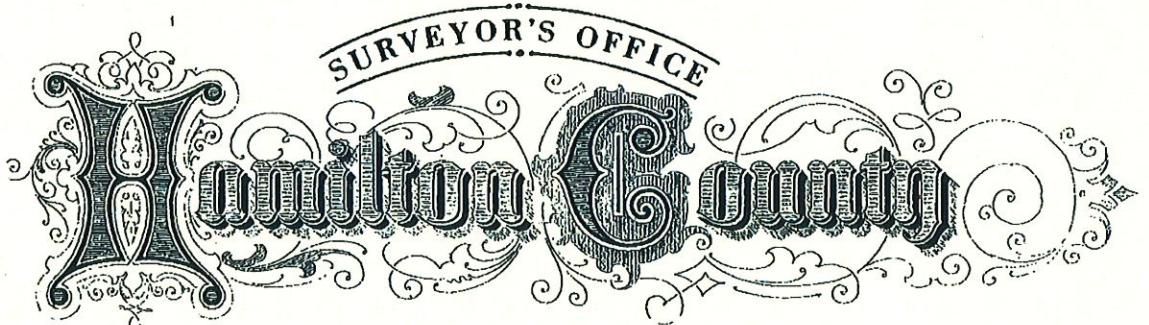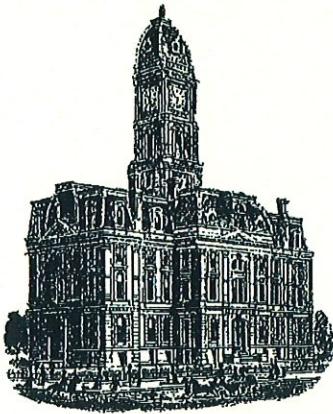

Kenton C. Ward, CFM
Surveyor of Hamilton County
Phone (317) 776-8495
Fax (317) 776-9628

Suite 188
One Hamilton County Square
Noblesville, Indiana 46060-2230

To: Hamilton County Drainage Board

September 5, 2018

Re: Thor Run Drain: Reserve at Steeplechase Sec. 1


Attached are as-built, certificate of completion & compliance, and other information for Reserve at Steeplechase Sec. 1. An inspection of the drainage facilities for this section has been made and the facilities were found to be complete and acceptable.

During construction, changes were made to the drain, which will alter the plans submitted with my report for this drain-dated July 1, 2015. The report was approved by the Board at the hearing held August 24, 2015. (See Drainage Board Minutes Book 16, Pages 273-275) The changes are as follows: the open ditch was shortened from 1255 feet to 1247 feet. The 100 feet of 60" RCP was replaced with 100 feet of 84" x 60" Box Culvert. The length of the drain due to the changes described above is now **1347 feet**.

The drainage easement was outlined in my report to the board dated July 1, 2015 as 30 feet from the top of bank. The nonenforcement the plat is recorded under instrument #2018040919. The project was paid for by the developer and sureties were provided to the City of Fishers for this project.

I recommend the Board approve the drain's construction as complete and acceptable.

Sincerely,

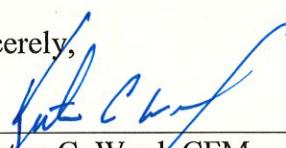
Kenton C. Ward, CFM
Hamilton County Surveyor

CERTIFICATE OF COMPLETION AND COMPLIANCE

FILED

To: Hamilton County Surveyor

Re: The Reserve at Steeplechase, Section 1

AUG 08 2018

OFFICE OF HAMILTON COUNTY SURVEYOR

I hereby certify that:

1. I am a Registered Land Surveyor or Engineer in the State of Indiana.
2. I am familiar with the plans and specifications for the above referenced subdivision.
3. I have personally observed and supervised the completion of the drainage facilities for the above referenced subdivision.
4. The drainage facilities within the above referenced subdivision to the best of my knowledge, information and belief have been installed and completed in conformity with all plans and specifications.

Signature:



Date: August 6, 2018

Type or Print Name: Dennis D. Olmstead

Business Address: Stoeppelwerth & Associates, Inc.

7965 East 106th Street, Fishers, Indiana 46038


Telephone Number: (317) 849-5935

SEAL

INDIANA REGISTRATION NUMBER


900012



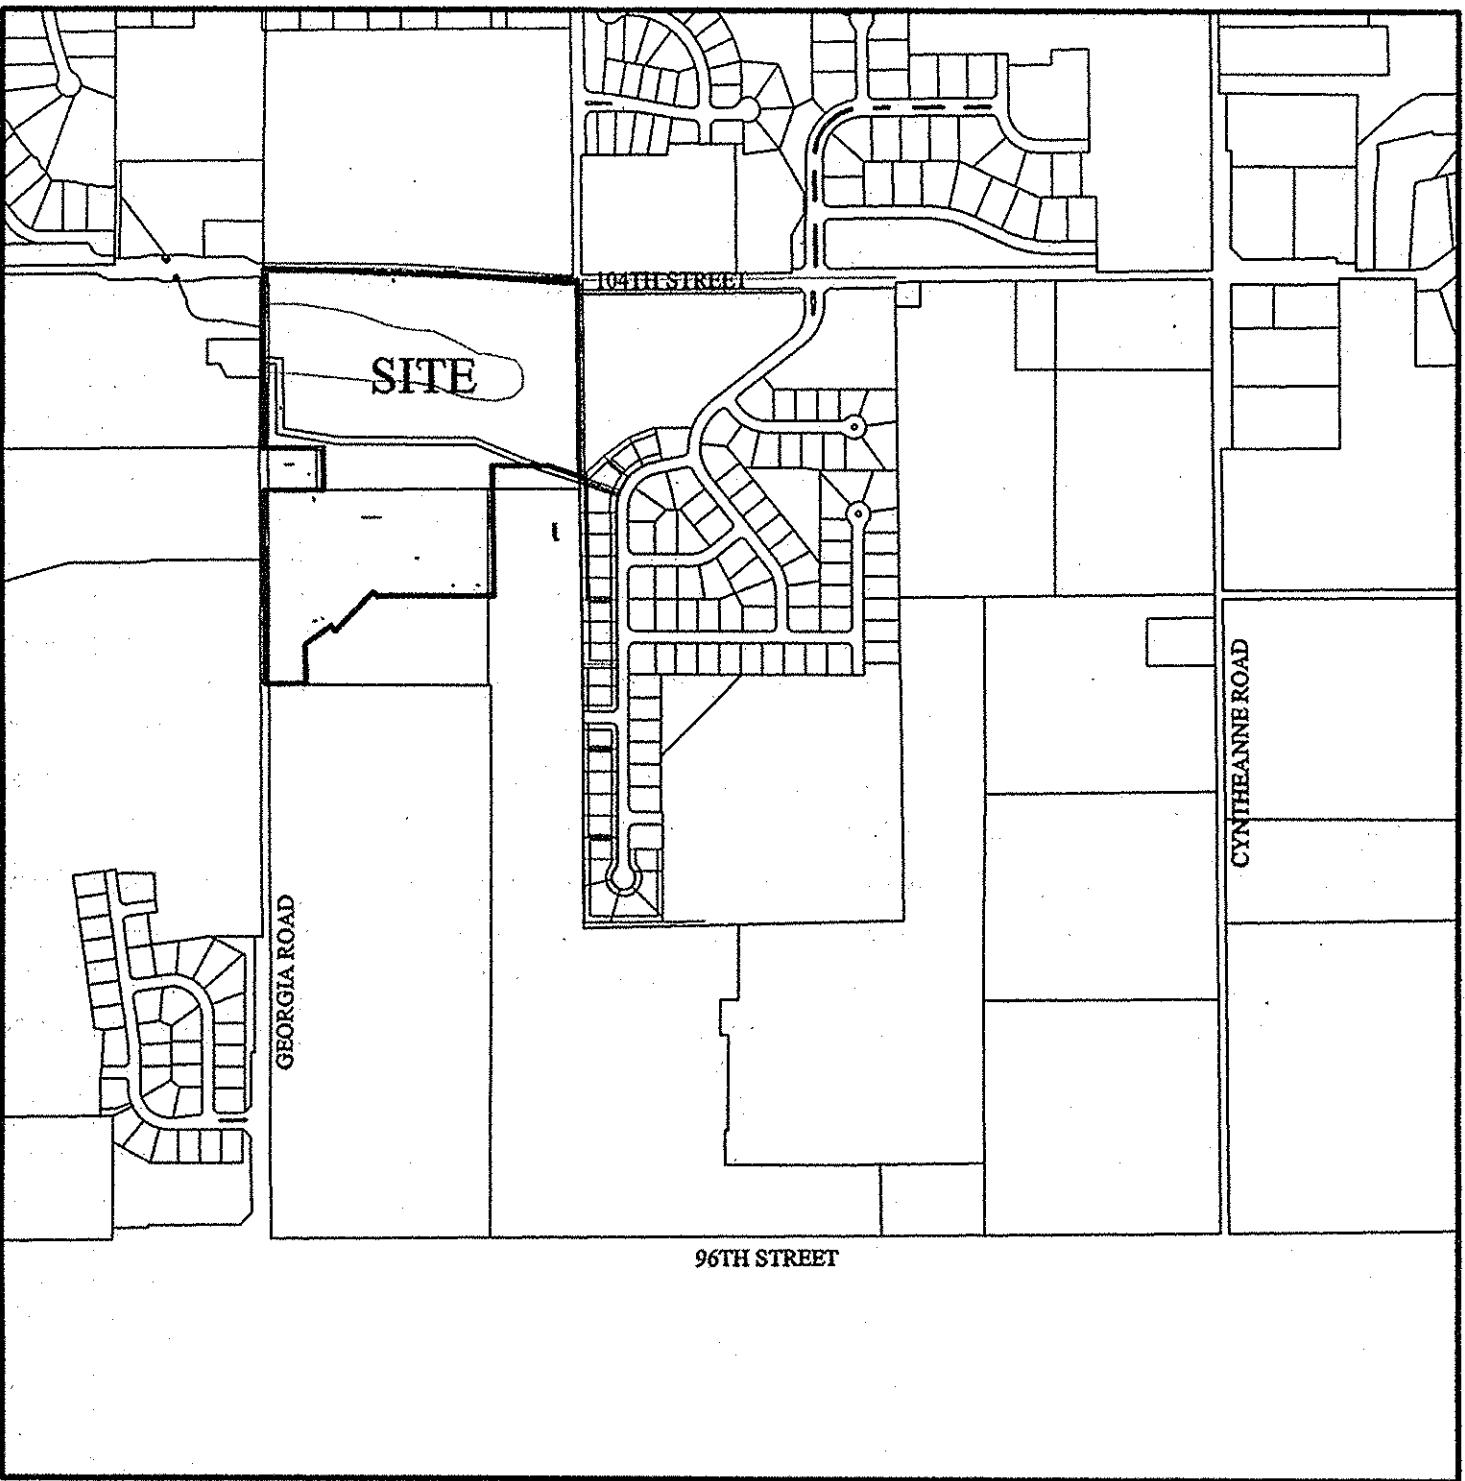

LOCATION MAP

SCALE: 1"=800'

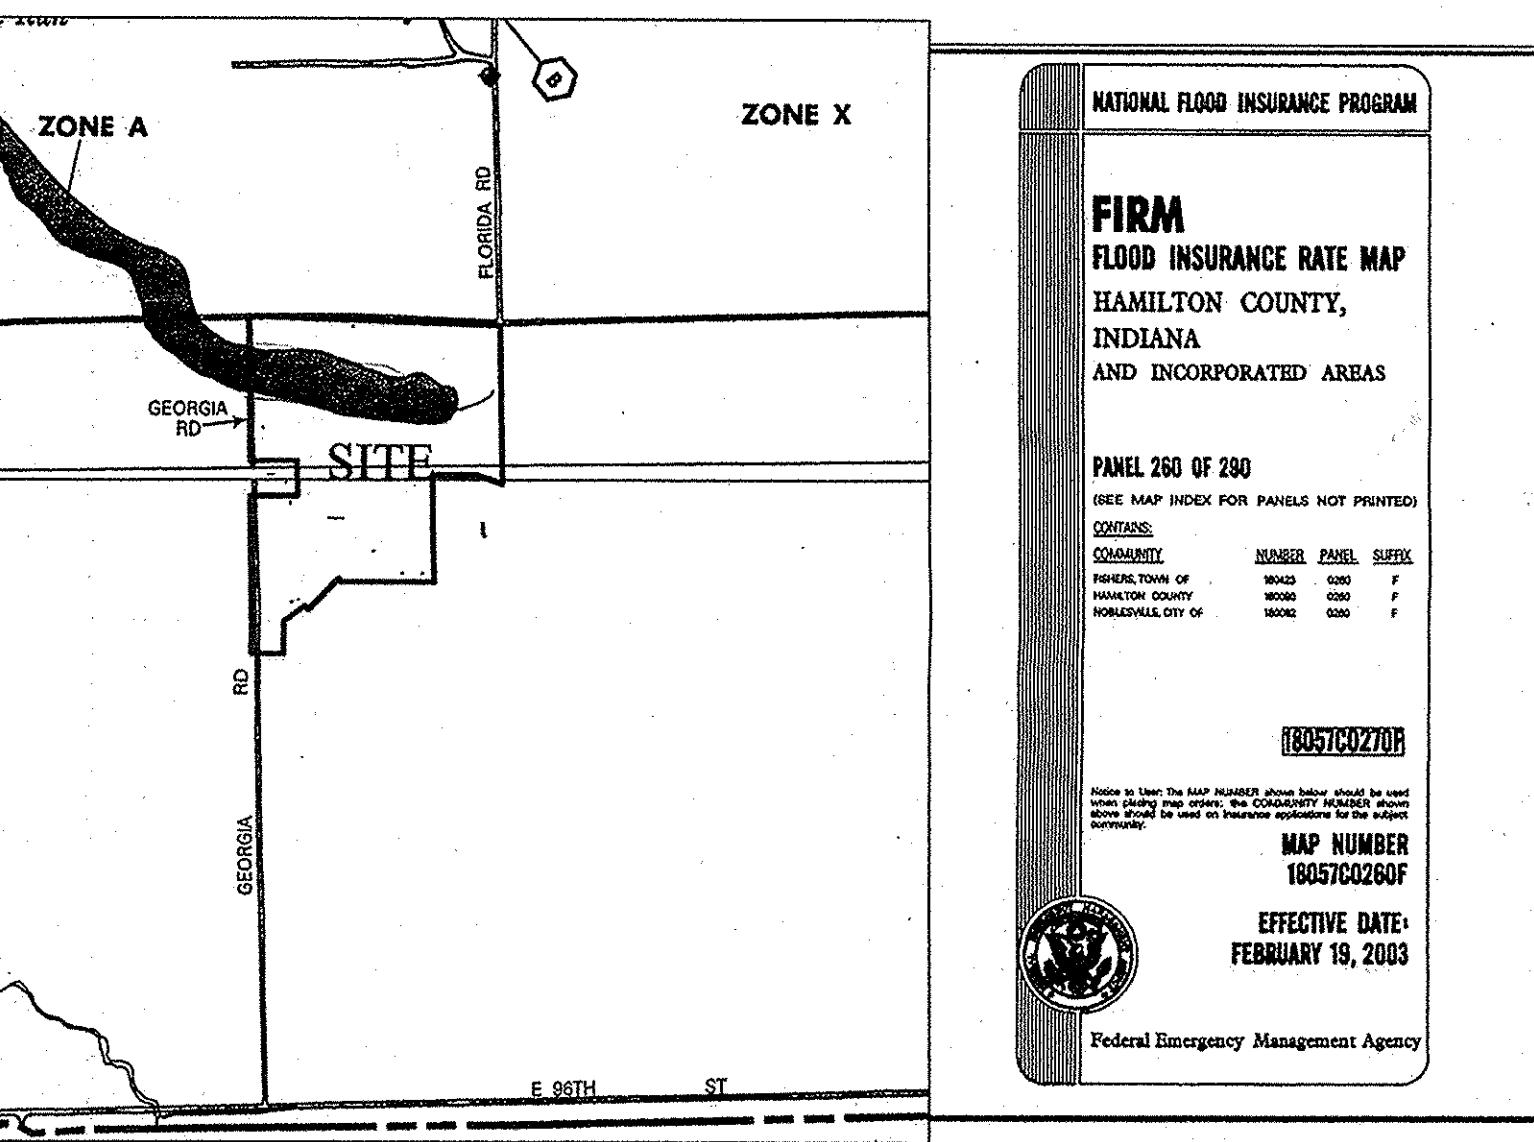

FLOOD MAP

SCALE: 1"=1000'
INDEX

SHT.	DESCRIPTION
C001	COVER SHEET
C100-C101	TOPOGRAPHICAL SURVEY
C200-C202	SITE DEVELOPMENT PLAN
C203	STORM TABLE
C204-C205	EMERGENCY FLOOD ROUTE
C300-C312	EROSION CONTROL PLAN & SPECIFICATIONS
C400-C405	STREET PLAN & PROFILES/TRAFFIC CONTROL PLAN/MAINTENANCE OF TRAFFIC
C406-C407	ENTRANCE PLAN & INTERSECTION DETAIL
C500-C504	SANITARY SEWER PLAN & PROFILES / GRAVITY SANITARY SEWER DETAILS
C600-C604	STORM PLAN & PROFILES
C700-C701	WATER PLAN
C800-C802	CONSTRUCTION DETAILS
C900	STREET TREE PLAN
L1-L2	LANDSCAPE PLAN

REVISIONS


SHT.	DESCRIPTION
ALL	REVISED PER TAC COMMENTS 01/14/2014 DCM
ALL	REVISED PER FISHERS COMMENTS 04/01/2014 KJHM
C200, C600, C802	REVISED PER STREAM STUDY 05/22/2014 DCM
C200, C500, C801	REVISED PER FISHERS COMMENTS 07/10/2014 CWW
ALL	REVISED PER SAMCO COMMENTS 08/26/2014 DCM
C500, L1, L2	REVISED PER SAMCO COMMENTS 10/31/2014 DCM
ALL	REVISED PER FISHERS COMMENTS 11/04/2014 DCM
ALL	REVISED STREET NAMES 11/14/2014 DCM
C700-C701	REVISED PER CITIZENS COMMENTS 02/17/2015 KJHM
C700-C701	REVISED PER CITIZENS COMMENTS 02/25/2015 KJHM
C701	REVISED PER CITIZENS COMMENTS 02/26/2015 KJHM
C403-C404	REVISED STREET LIGHT LOCATIONS 06/09/2015 DCM
ALL	ASBUILT 08/04/15 ARW

The Reserve at Steeplechase

Section 1

Section 1 & Section 2 Mass Grading P.U.D-R Zoning

Developed by:
MI Homes
8500 Keystone Crossing, Suite 590
Indianapolis, Indiana 46240
Phone: (317)-255-9900
Contact Person: Mark Connor

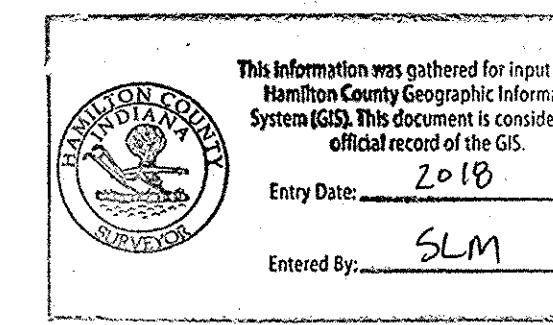


NOTES:


1. THIS SITE IS WITHIN A FLOODPLAIN PER FIRM MAP NO. 18057C0260 F & 18057C0270 F DATED FEB. 19, 2003.
2. THE DESIGN AND CONSTRUCTION SHALL COMPLY WITH THE CURRENT TOWN OF FISHERS CONSTRUCTION SPECIFICATIONS AND STANDARD CONSTRUCTION DETAILS. THE OMISSION OF ANY CURRENT STANDARD DETAIL DOES NOT RELIEVE THE CONTRACTOR FROM THIS REQUIREMENT. THIS SUBDIVISION MEETS THE REQUIREMENTS OF THE TOWN OF FISHERS UDO & TOWN STANDARDS CONSTRUCTION SPECIFICATIONS & ADA REQUIREMENTS.
3. LOCAL SANITARY SEWER UTILITY: HAMILTON SOUTHEASTERN UTILITIES 11901 LAKESIDE DRIVE FISHERS, IN 46038 TELEPHONE: (317)-577-2300
4. MINIMUM DISTANCE BETWEEN A DRIVEWAY AND A PARALLELING ADJACENT STREET 25 FEET. MEASURED FROM EDGE OF RIGHT-OF-WAY TO THE NEAREST EDGE OF DRIVEWAY AT THE RIGHT-OF-WAY LINE.
5. UTILITY CONFLICTS (INCLUDING UTILITY POLES) MUST BE COMPLETELY RESOLVED PRIOR TO THE CONSTRUCTION OF ACCELERATION/DECELERATION, PASSING BLISTER LANES AND/OR LEFT TURN LANES. CONSTRUCTION OF THESE LANES INCLUDES BUT IS NOT LIMITED TO EXCAVATION, EMBANKMENT, PAVING, AND SUB-GRADE PREPARATION, ETC.
6. THE CONTRACTOR SHALL SCHEDULE A STORMWATER INFRASTRUCTURE PRE-CONSTRUCTION MEETING WITH THE TOWN OF FISHERS DEPARTMENT OF ENGINEERING PRIOR TO ANY CONSTRUCTION ON THE SITE BEING STARTED.
7. THE FINAL STORMWATER INFRASTRUCTURE INSPECTION WILL NOT BE PERFORMED BY THE TOWN OF FISHERS DEPARTMENT OF ENGINEERING INSPECTOR UNTIL ALL UTILITIES ARE COMPLETED AND FINAL SITE STABILIZATION IS COMPLETED.

SHT.	DESCRIPTION
1	DIRECTIONS FOR USE, & GENERAL NOTES
2	SANITARY SEWER PIPE BEDDING & CROSSING DETAILS & NOTES
3	SANITARY SEWER STRUCTURE DETAILS & NOTES
4	SANITARY LATERAL CONNECTION, CLEAN OUT, & MISC. NOTES
5	SANITARY SEWER FORCEMAIN DETAILS & NOTES
6	SANITARY SEWER DUPLEX PUMP STATION DETAILS & NOTES
7	PAVEMENT, PATH, CURB & SIDEWALK DETAILS AND NOTES
8	COMMERCIAL, INDUSTRIAL, & ALTERNATIVE RESIDENTIAL STREET SECTIONS
9	CURB UNIT PAVER AND JOINT DETAILS AND NOTES
10	MISC. TRANSPORTATION DETAILS, SIGNS, PAVEMENT MARKERS, CUL-DE-SAC
11	STORM SEWER BEDDING, UNDERDRAIN & EXCAVATION DETAILS & NOTES
12	STORM SEWER STRUCTURE & DETAIL NOTES
13	DETENTION BASIN, END SECTION, MISCH DETAILS & NOTES

SHT.	DESCRIPTION
ALL	REVISED PER TAC COMMENTS 01/14/2014 DCM
ALL	REVISED PER FISHERS COMMENTS 04/01/2014 KJHM
C200, C600, C802	REVISED PER STREAM STUDY 05/22/2014 DCM
C200, C500, C801	REVISED PER FISHERS COMMENTS 07/10/2014 CWW
ALL	REVISED PER SAMCO COMMENTS 08/26/2014 DCM
C500, L1, L2	REVISED PER SAMCO COMMENTS 10/31/2014 DCM
ALL	REVISED PER FISHERS COMMENTS 11/04/2014 DCM
ALL	REVISED STREET NAMES 11/14/2014 DCM
C700-C701	REVISED PER CITIZENS COMMENTS 02/17/2015 KJHM
C700-C701	REVISED PER CITIZENS COMMENTS 02/25/2015 KJHM
C701	REVISED PER CITIZENS COMMENTS 02/26/2015 KJHM
C403-C404	REVISED STREET LIGHT LOCATIONS 06/09/2015 DCM
ALL	ASBUILT 08/04/15 ARW

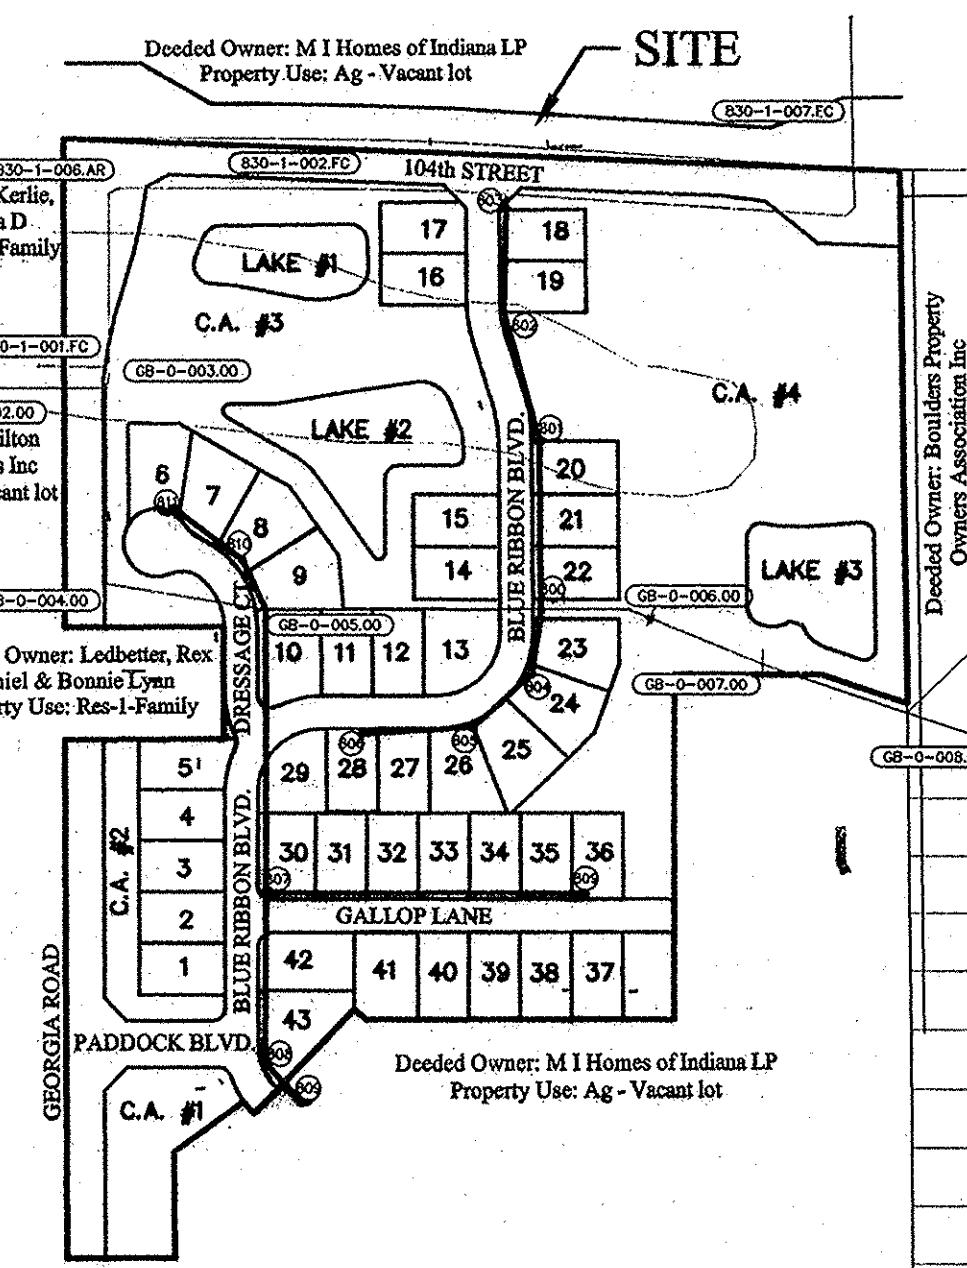

SITE MAP
PROPERTY ADDRESS:
GEORGIA ROAD

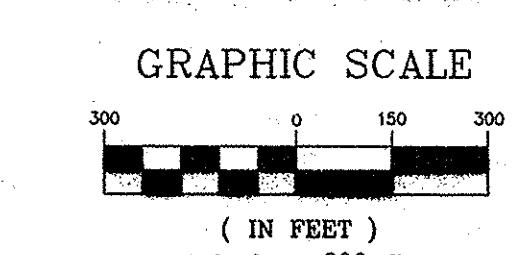


DESIGN DATA 3	
36.89 AC.	
43 LOTS =	0.86 LOTS/ACRE
PADDOCK BOULEVARD	275.006 L.F.
BLUE RIBBON BOULEVARD	1814.010 L.F.
GALLOP LANE	675.131 L.F.
DRESSAGE COURT	396.801 L.F.
TOTAL L.F.	3160.948 L.F.

DESIGN SPEED LIMIT: 25 MPH

SIDEWALK	15,804.74 sq. ft.
STREET	101,150.336 sq. ft.
DWELLINGS	153,240.00 sq. ft.

SIDEWALK	15,804.74 sq. ft.
STREET	101,150.336 sq. ft.
DWELLINGS	153,240.00 sq. ft.

SIDEWALK	15,804.74 sq. ft.
STREET	101,150.336 sq. ft.
DWELLINGS	153,240.00 sq. ft.

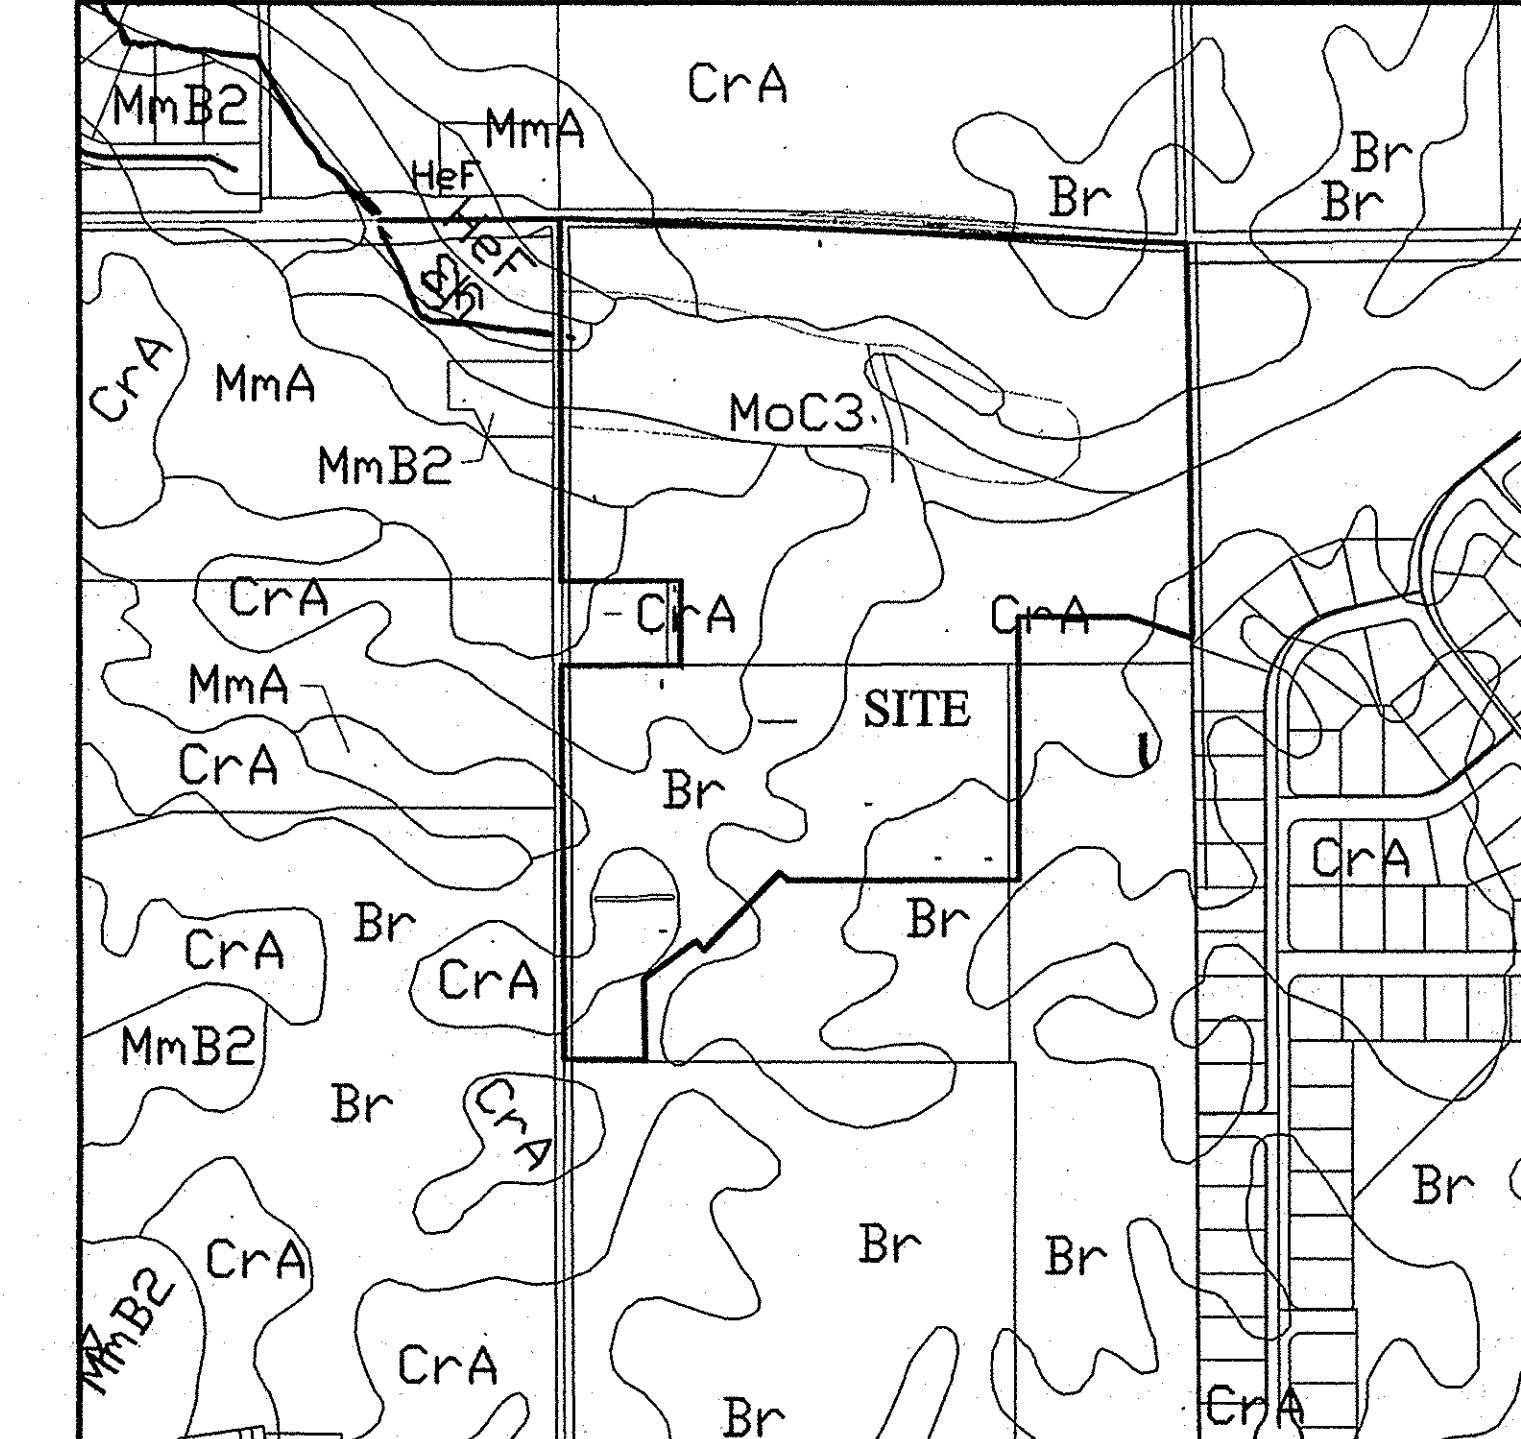

SOILS MAP

SCALE: 1"=400'

Map Unit: Br - Brookston silty clay loam

Map Unit: MmB2 - Miami silt loam, 2 to 6 percent slopes, eroded

This poorly drained soil has a seasonal high water table above the surface or within 12 inches. It is moderately deep. Slopes are 0 to 2 percent. The native vegetation is hardwoods. The surface layer is silt loam and has moderate organic matter content (0.2 to 0.6 percent). Permeability is low (0.06 to 0.10 inches per hour). The soil is very slow (<0.06 inches per hour) to move water through it. Available water capacity is low (5.9 inches in the upper 60 inches). The pH of the surface layer in non-limed areas is 6.1 to 6.3. This soil is hydric. Wetness is a management concern for crop production. This soil responds well to tile drainage.

Map Unit: CrA - Crosby silt loam, 0 to 2 percent slopes

This poorly drained soil has a seasonal high water table above the surface or within 12 inches. It is moderately deep. Slopes are 0 to 2 percent. The native vegetation is hardwoods. The surface layer is silt loam and has moderate organic matter content (0.1 to 0.4 percent). Permeability is slow (0.06 to 0.10 inches per hour). The soil is very slow (<0.06 inches per hour) to move water through it. Available water capacity is low (5.5 inches in the upper 60 inches). The pH of the surface layer in non-limed areas is 5.1 to 6.0. Droughtiness and wetness are management concerns for crop production. This soil responds well to tile drainage.

Map Unit: Sh - Shoals silt loam

This nearly level, deep, and somewhat poorly drained soil is on floodplains. It is subject to frequent flooding. Permeability is moderate. Available water capacity is high. Content of organic matter in the surface layer is moderate. The water table is commonly at a depth of 1 to 3 feet in winter and spring. Surface runoff is slow. The surface layer of this soil is friable and is easy to till within a wide range of moisture content. In many areas this soil is drained with subsurface tile and used for hay and pasture.

Map Unit: HeF - Hennepin loam, 25 to 50 percent slopes

This well drained soil has a water table at a depth greater than 40 inches and is on uplands. Slopes are 0 to 25 percent. The native vegetation is hardwoods. The surface layer is loam and has moderate organic matter content (1.0 to 4.0 percent). Permeability is slow (0.06 to 0.10 inches per hour). The soil is very slow (<0.06 inches per hour) to move water through it. Available water capacity is low (5.5 inches in the upper 60 inches). The pH of the surface layer in non-limed areas is 6.1 to 8.4. Droughtiness and wetness are management concerns for crop production.

Map Unit: MmA - Miami silt loam, 0 to 2 percent slopes, gravelly substratum

This well drained soil has a water table at a depth greater than 40 inches and is on uplands. Slopes are 0 to 2 percent. The native vegetation is hardwoods. The surface layer is loam and has moderate organic matter content (1.0 to 3.0 percent). Permeability is moderate (0.06 to 0.10 inches per hour). The soil is very slow (<0.06 inches per hour) to move water through it. Available water capacity is moderate (7.7 inches in the upper 60 inches). The pH of the surface layer in non-limed areas is 5.1 to 6.0. Droughtiness is a management concern for crop production.

Map Unit: MoC3 - Miami clay loam, 6 to 18 percent slopes


This soil has a somewhat poorly drained soil has a seasonal high water table or within 12 inches. It is moderately deep. Slopes are 0 to 18 percent. The native vegetation is hardwoods. The surface layer is loam and has moderate organic matter content (1.0 to 3.0 percent). Permeability is moderate (0.06 to 0.10 inches per hour). The soil is very slow (<0.06 inches per hour) to move water through it. Available water capacity is moderate (7.7 inches in the upper 60 inches). The pH of the surface layer in non-limed areas is 5.1 to 6.0. Droughtiness and wetness are management concerns for crop production.

Map Unit: Sh - Shoals silt loam


This nearly level, deep, and somewhat poorly drained soil is on floodplains. It is subject to frequent flooding. Permeability is moderate. Available water capacity is high. Content of organic matter in the surface layer is moderate. The water table is commonly at a depth of 1 to 3 feet in winter and spring. Surface runoff is slow. The surface layer of this soil is friable and is easy to till within a wide range of moisture content. In many areas this soil is drained with subsurface tile and used for hay and pasture.

Map Unit: HeF - Hennepin loam, 25 to 50 percent slopes

This well drained soil has a water table at a depth greater than 40 inches and is on uplands. Slopes are 0 to 25 percent. The native vegetation is hardwoods. The surface layer is loam and has moderate organic matter content (1.0 to 4.0 percent). Permeability is slow (0.06 to 0.10 inches per hour). The soil is very slow (<0.06 inches per hour) to move water through it. Available water capacity is low (5.5 inches in the upper 60 inches). The pH of the surface layer in non-limed areas is 6.1 to 8.4. Droughtiness and wetness are management concerns

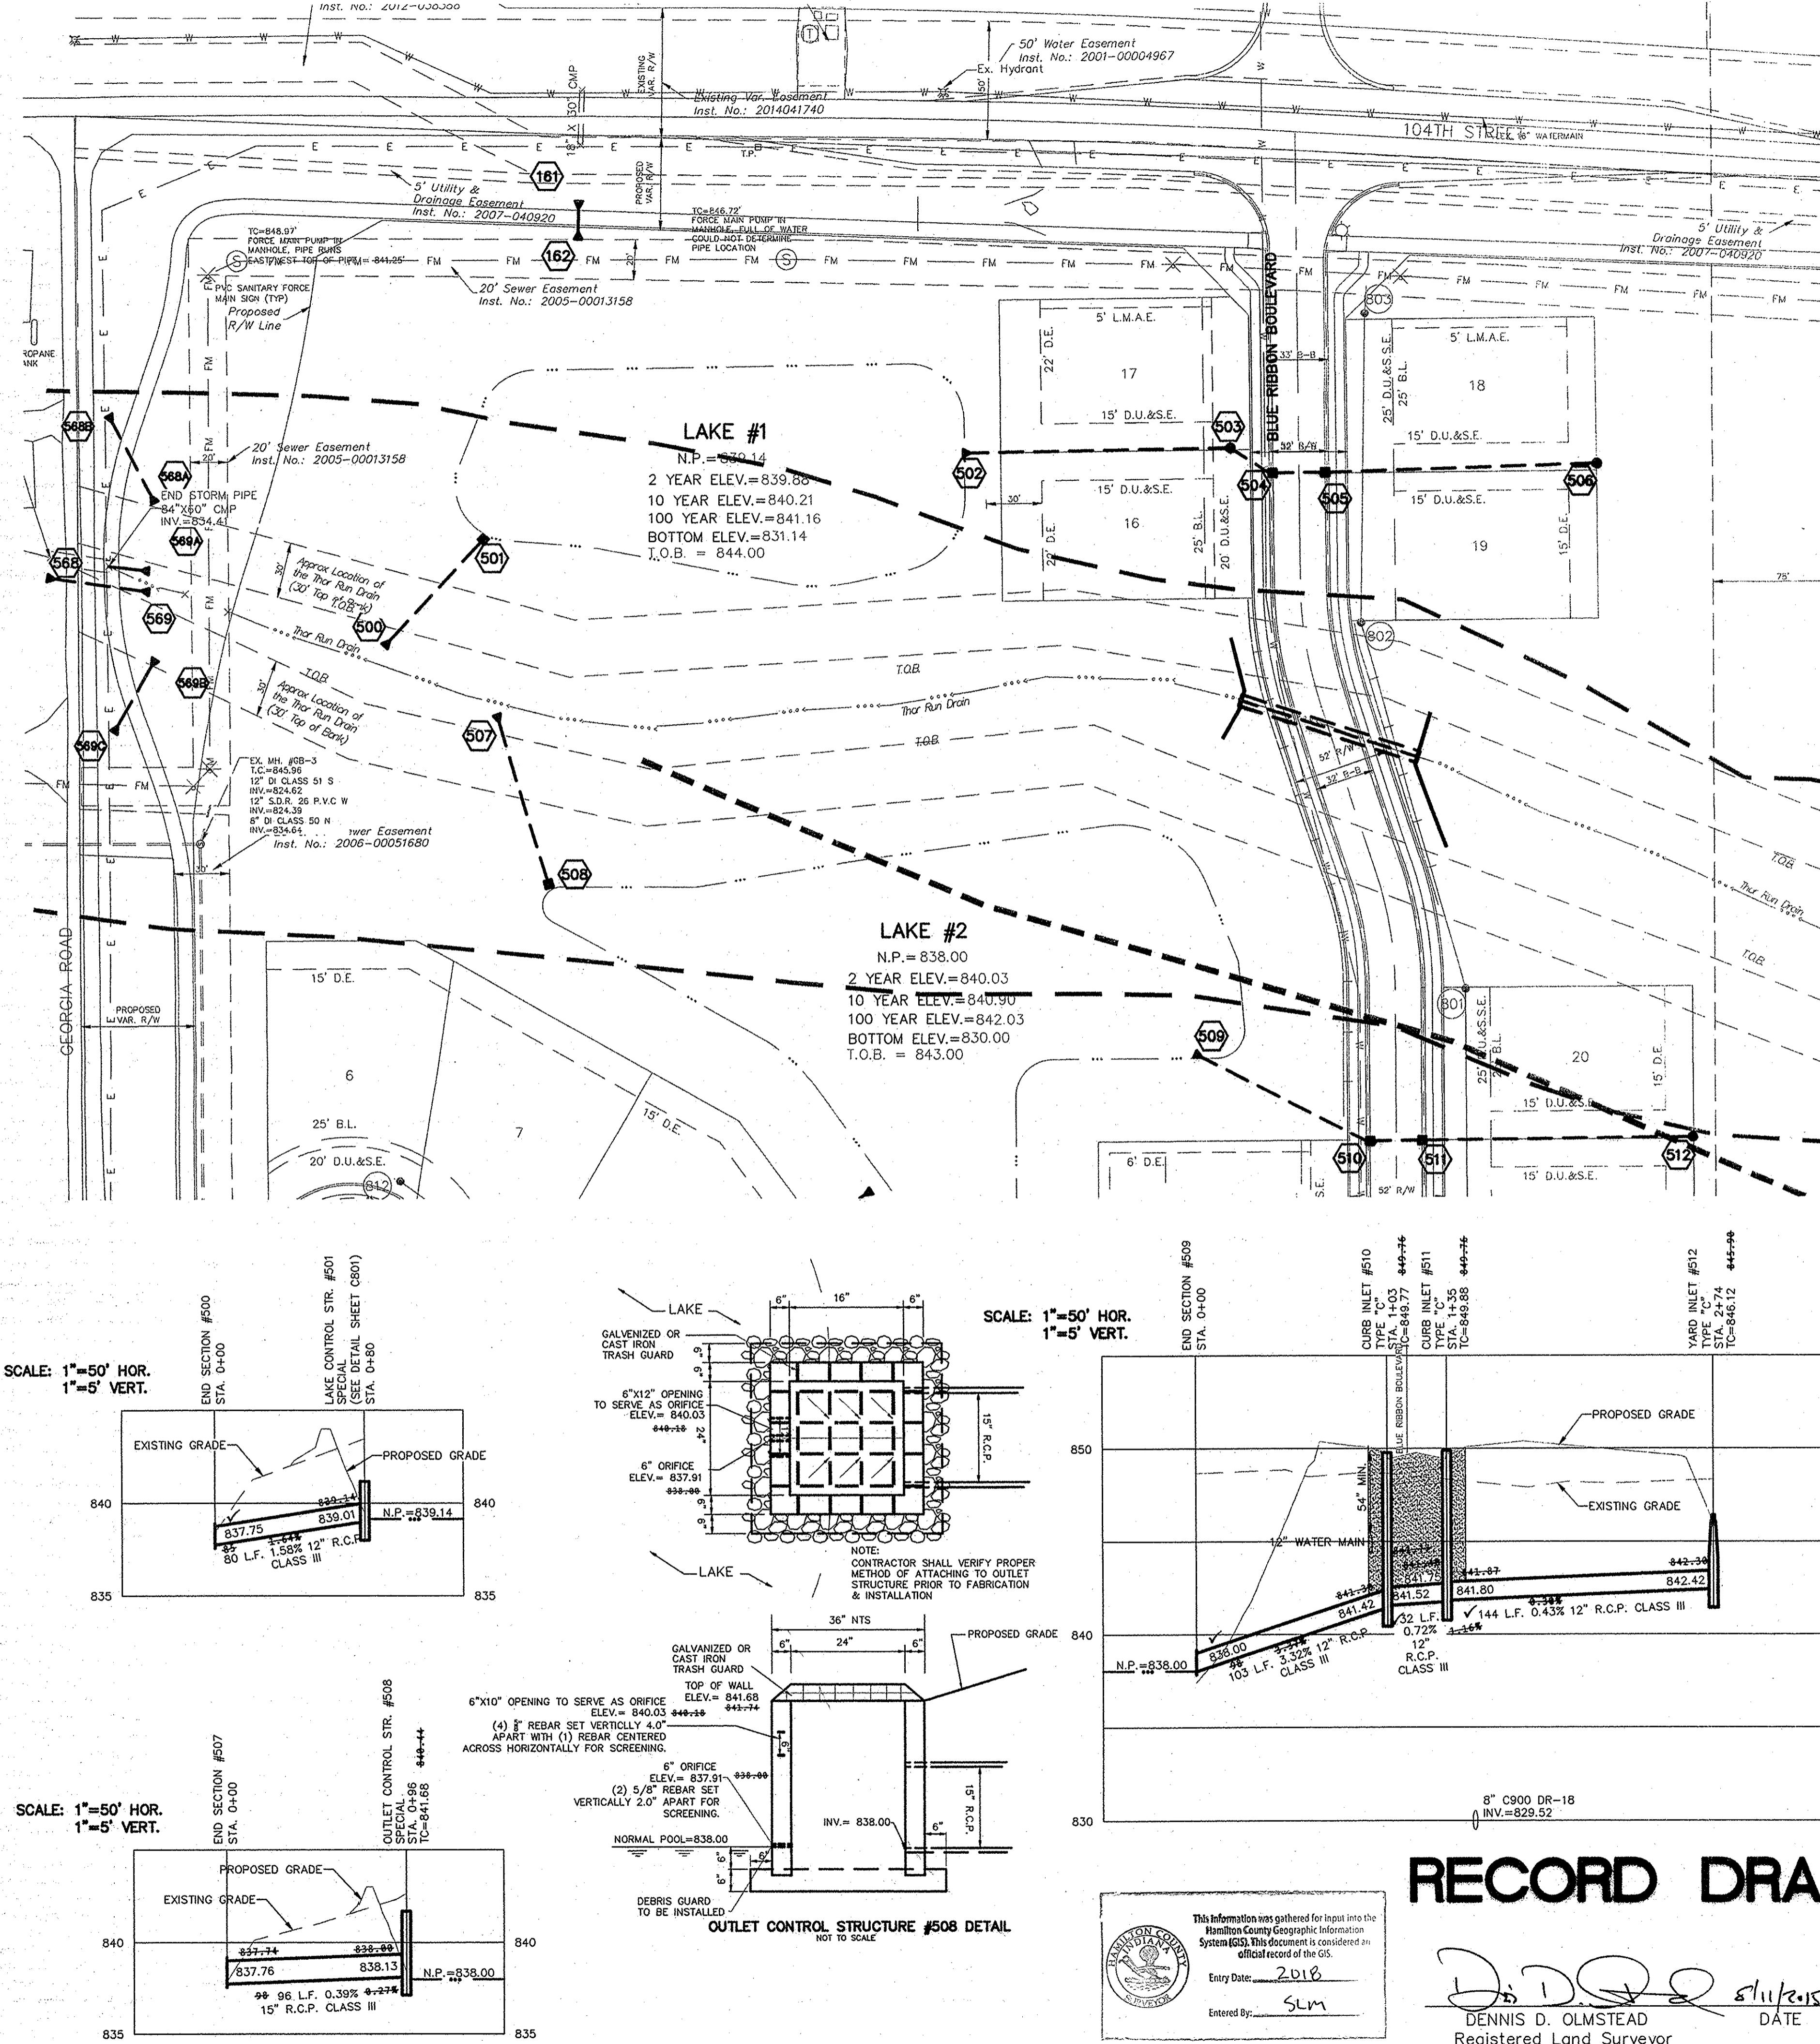

RECORD DRAWING

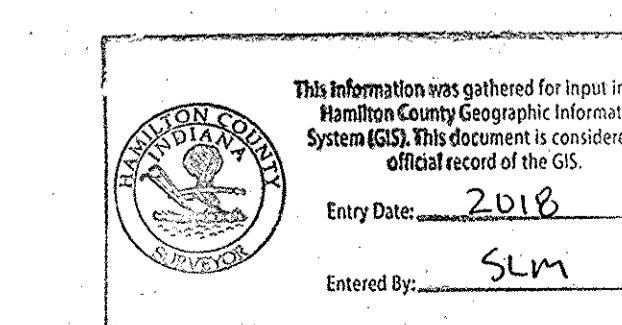

This information was gathered for input into the Hamilton County Geographic Information System (GIS). This document is considered an official record of the GIS.
 Entry Date: 2018
 Entered By: SLM
 DENNIS D. OLMSTEAD
 Registered Land Surveyor
 No. 900012
 DATE: 8/11/2015



JUPPS Dig It Safely.
 Indiana Underground Plant Protection Service





Know what's below.
 Call before you dig.

STORM PLAN & PROFILES

THE RESERVE AT STEEPLECHASE SECTION 1

HAMILTON COUNTY, INDIANA

THIS DRAWING IS NOT INTENDED TO BE	REVISED PER FISHERS COMMENTS
ORIGINAL BOUNDARY SURVEY, A ROUTINE	REVISED PER SAMCO COMMENTS
SURVEY OR A SURVEYOR LOCATION	REVISED PER FISHERS COMMENTS
REPORT.	REVISED PER STREAM STUDY
CERTIFIED: 12/02/13	REVISED PER FISHERS COMMENTS
David J. Steppelwirth	REVISED PER TAC COMMENTS
7915 East 10th Street, Fishers, IN 46038-5916	DATE MARK
phone: 317/492-9325 fax: 317/349-5942	REVISIONS

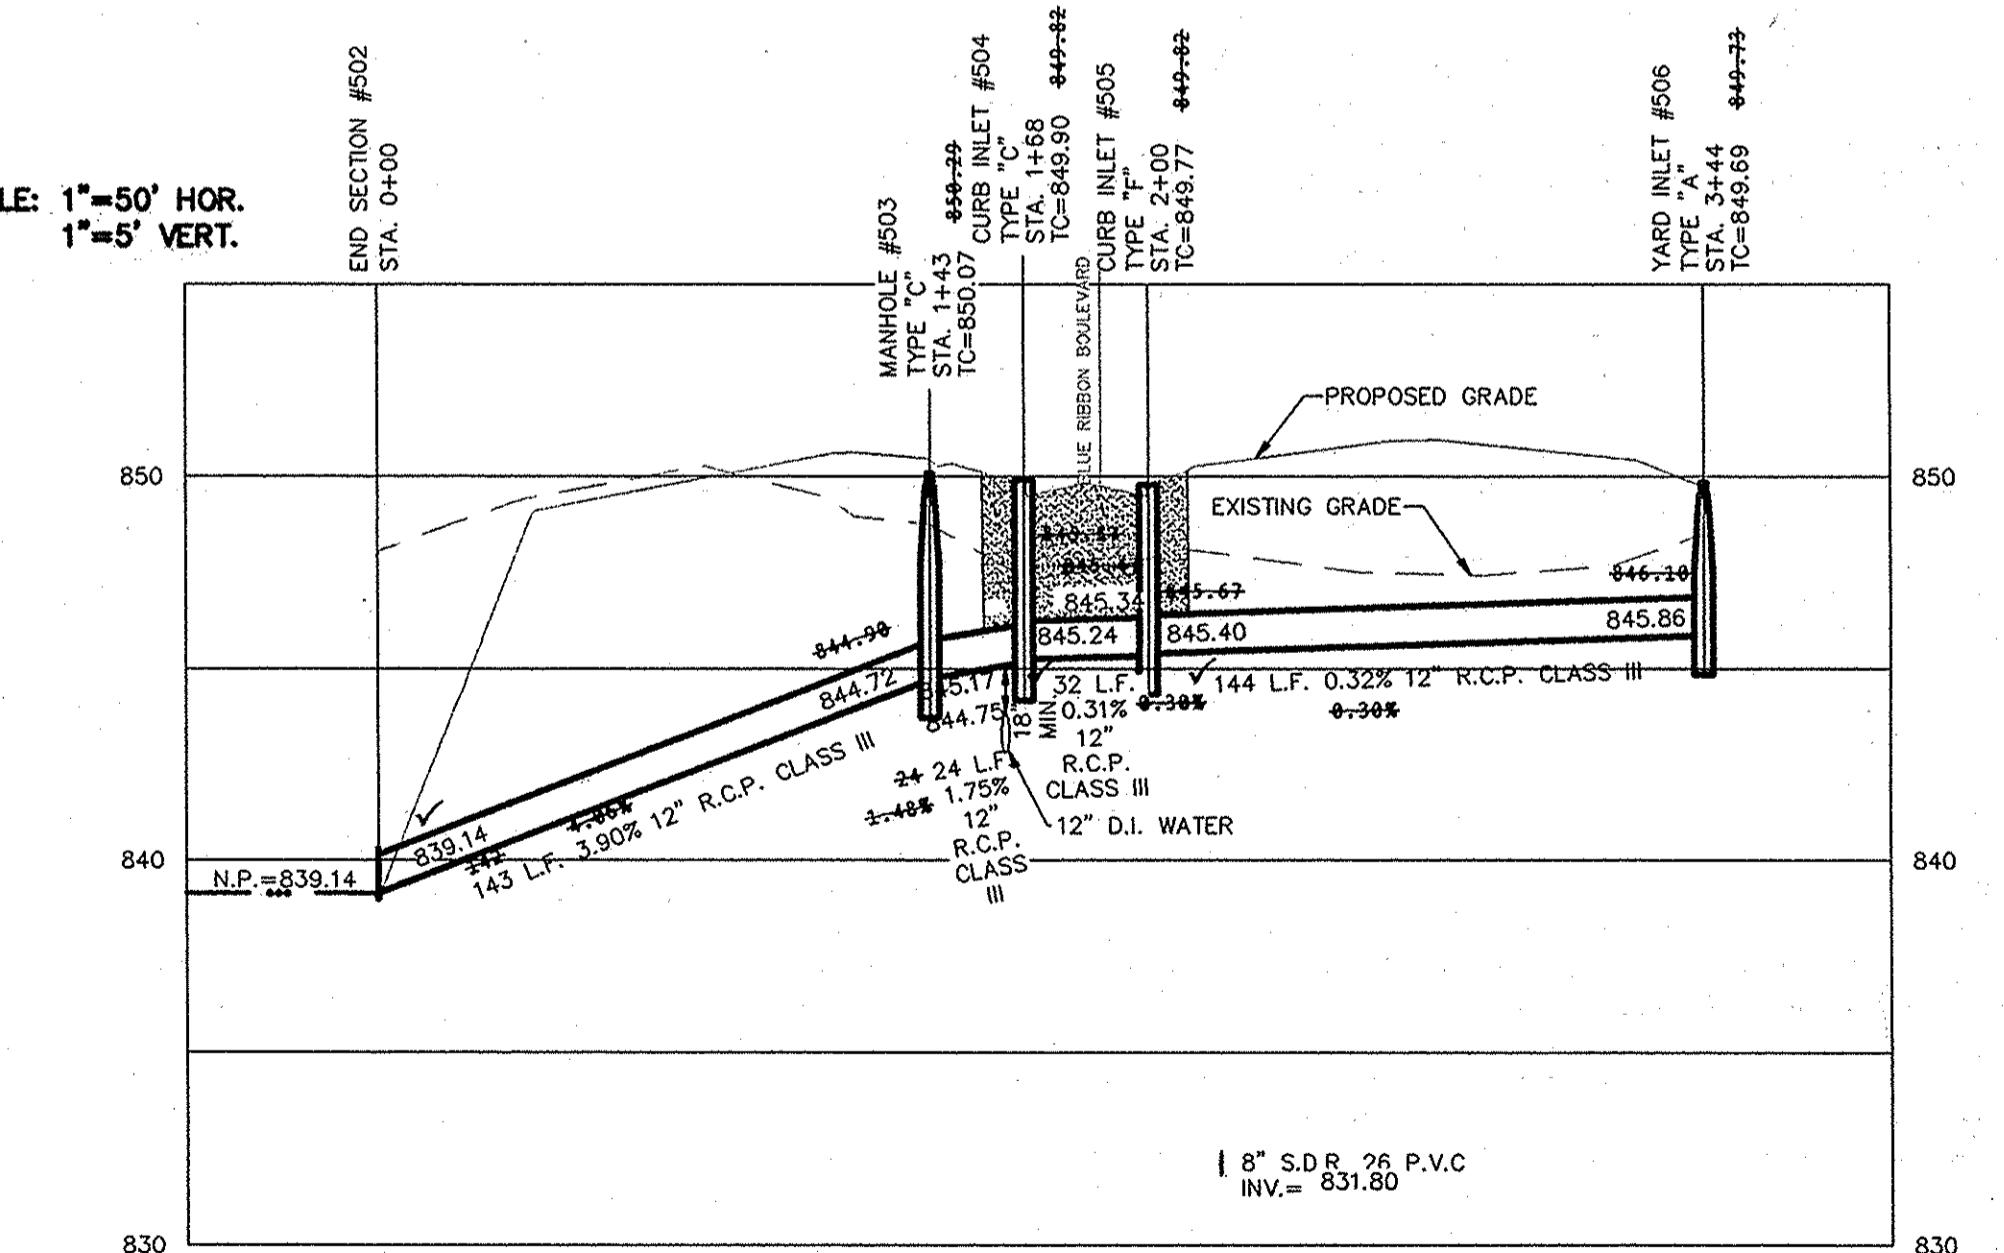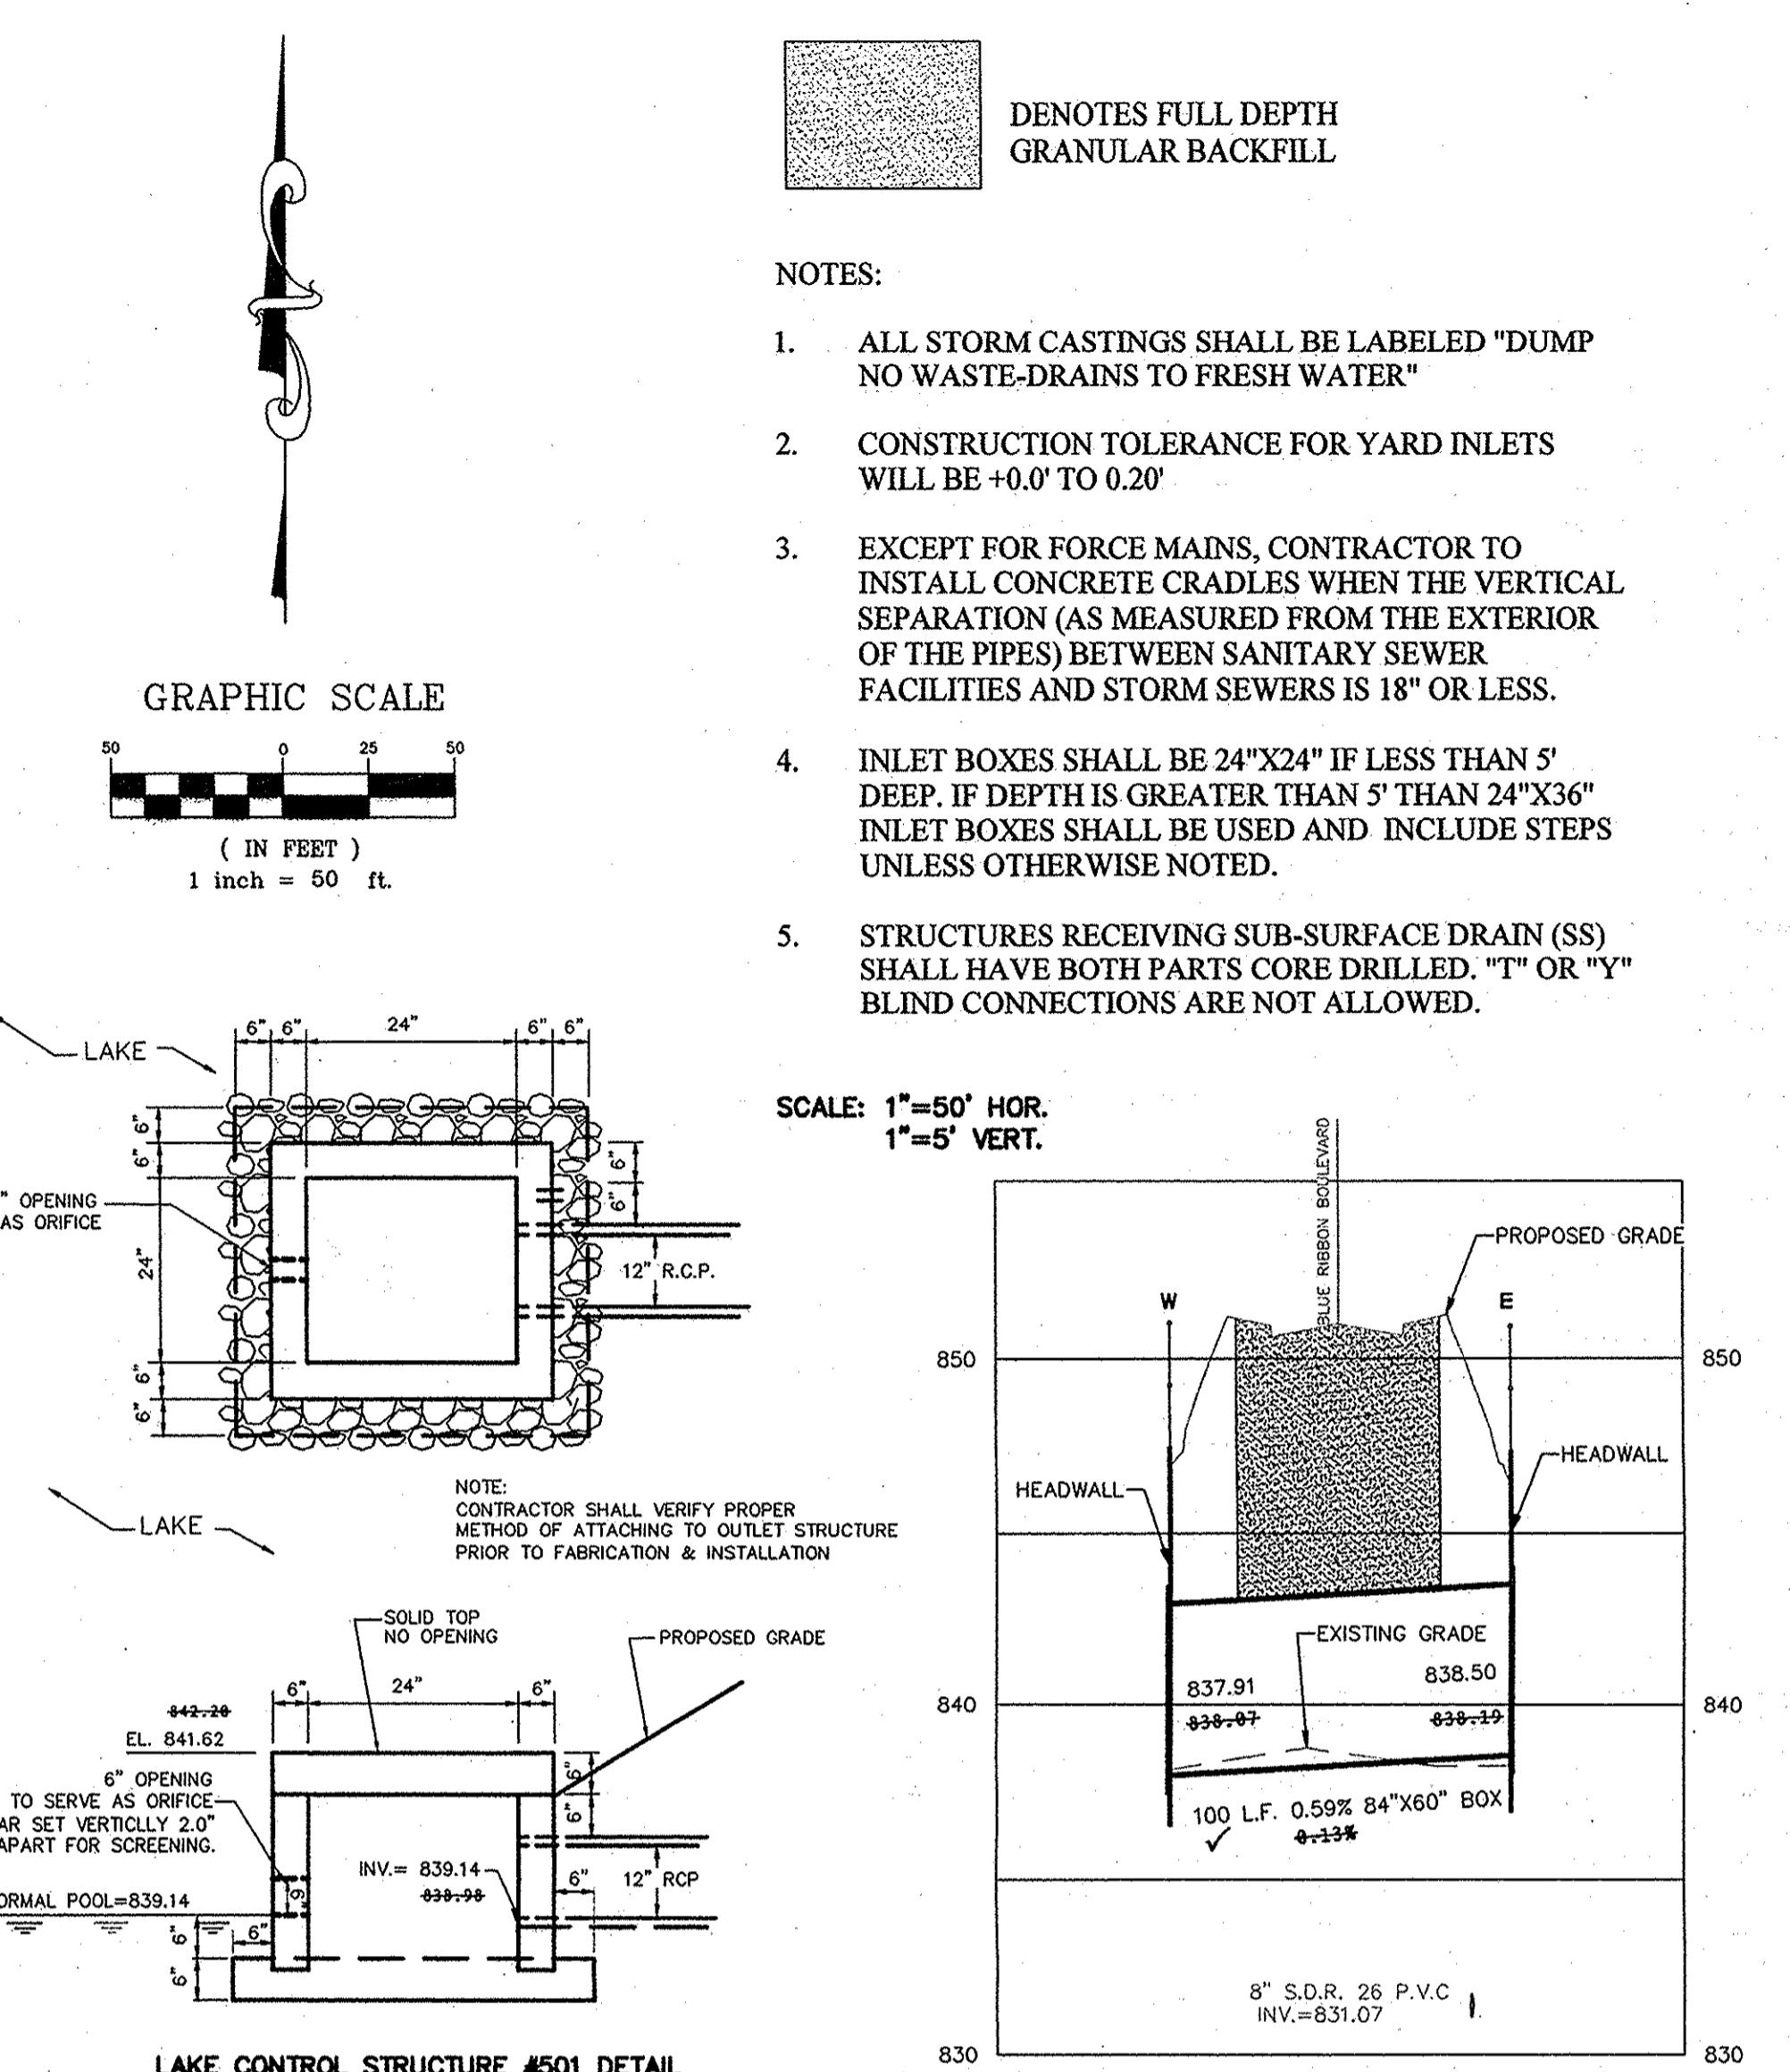


ARW	ASBUILT
DCM	REVISED PER FISHERS COMMENTS
DGM	REVISED PER SAMCO COMMENTS
CHW	REVISED PER FISHERS COMMENTS
DCM	REVISED PER STREAM STUDY
KUM	REVISED PER FISHERS COMMENTS
DCM	REVISED PER TAC COMMENTS
DCM	REVISED PER BY

DENOTES FULL DEPTH
 GRANULAR BACKFILL

NOTES:

1. ALL STORM CASTINGS SHALL BE LABELED "DUMP NO WASTE-DRAINS TO FRESH WATER"
2. CONSTRUCTION TOLERANCE FOR YARD INLETS WILL BE +0.0' TO 0.20'
3. EXCEPT FOR FORCE MAINS, CONTRACTOR TO INSTALL CONCRETE CRADLES WHEN THE VERTICAL SEPARATION (AS MEASURED FROM THE EXTERIOR OF THE PIPES) BETWEEN SANITARY SEWER FACILITIES AND STORM SEWERS IS 18" OR LESS.
4. INLET BOXES SHALL BE 24"X24" IF LESS THAN 5' DEEP, IF DEPTH IS GREATER THAN 5' THAN 24"X36" INLET BOXES SHALL BE USED AND INCLUDE STEPS UNLESS OTHERWISE NOTED.
5. STRUCTURES RECEIVING SUB-SURFACE DRAIN (SS) SHALL HAVE BOTH PARTS CORE DRILLED, "T" OR "Y" BLIND CONNECTIONS ARE NOT ALLOWED.

SCALE: 1"=50' HOR.
 1"=5' VERT.

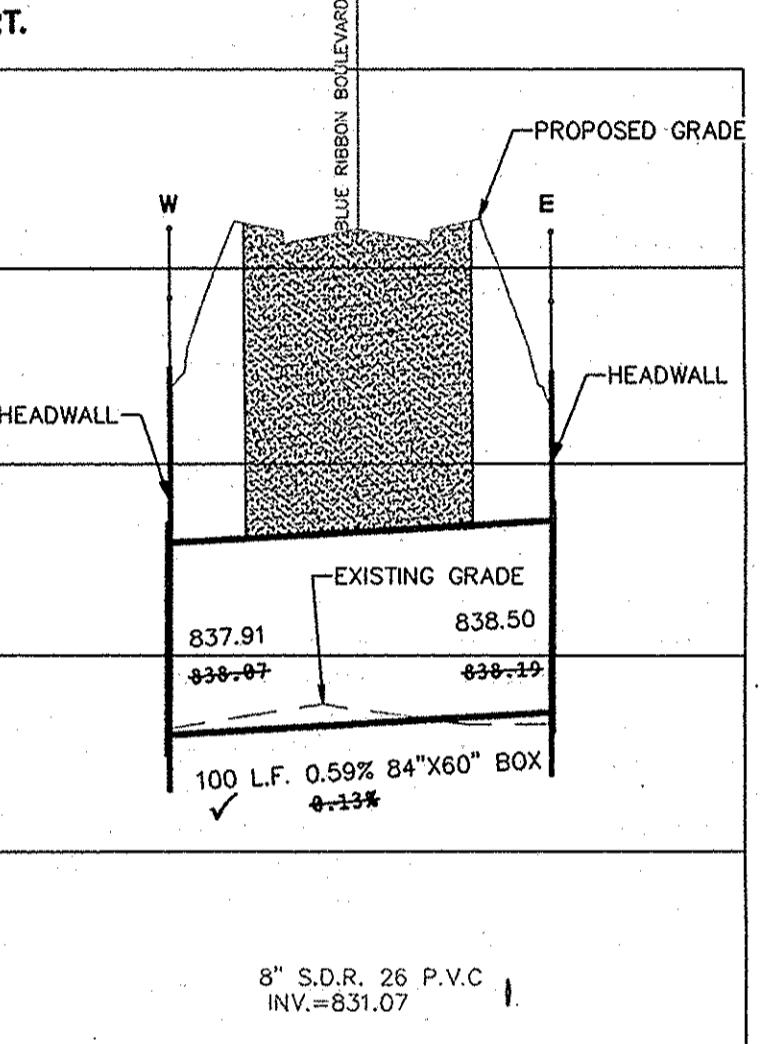

ARW	ASBUILT
DCM	REVISED PER FISHERS COMMENTS
DGM	REVISED PER SAMCO COMMENTS
CHW	REVISED PER FISHERS COMMENTS
DCM	REVISED PER STREAM STUDY
KUM	REVISED PER FISHERS COMMENTS
DCM	REVISED PER TAC COMMENTS
DCM	REVISED PER BY

ARW	ASBUILT


</

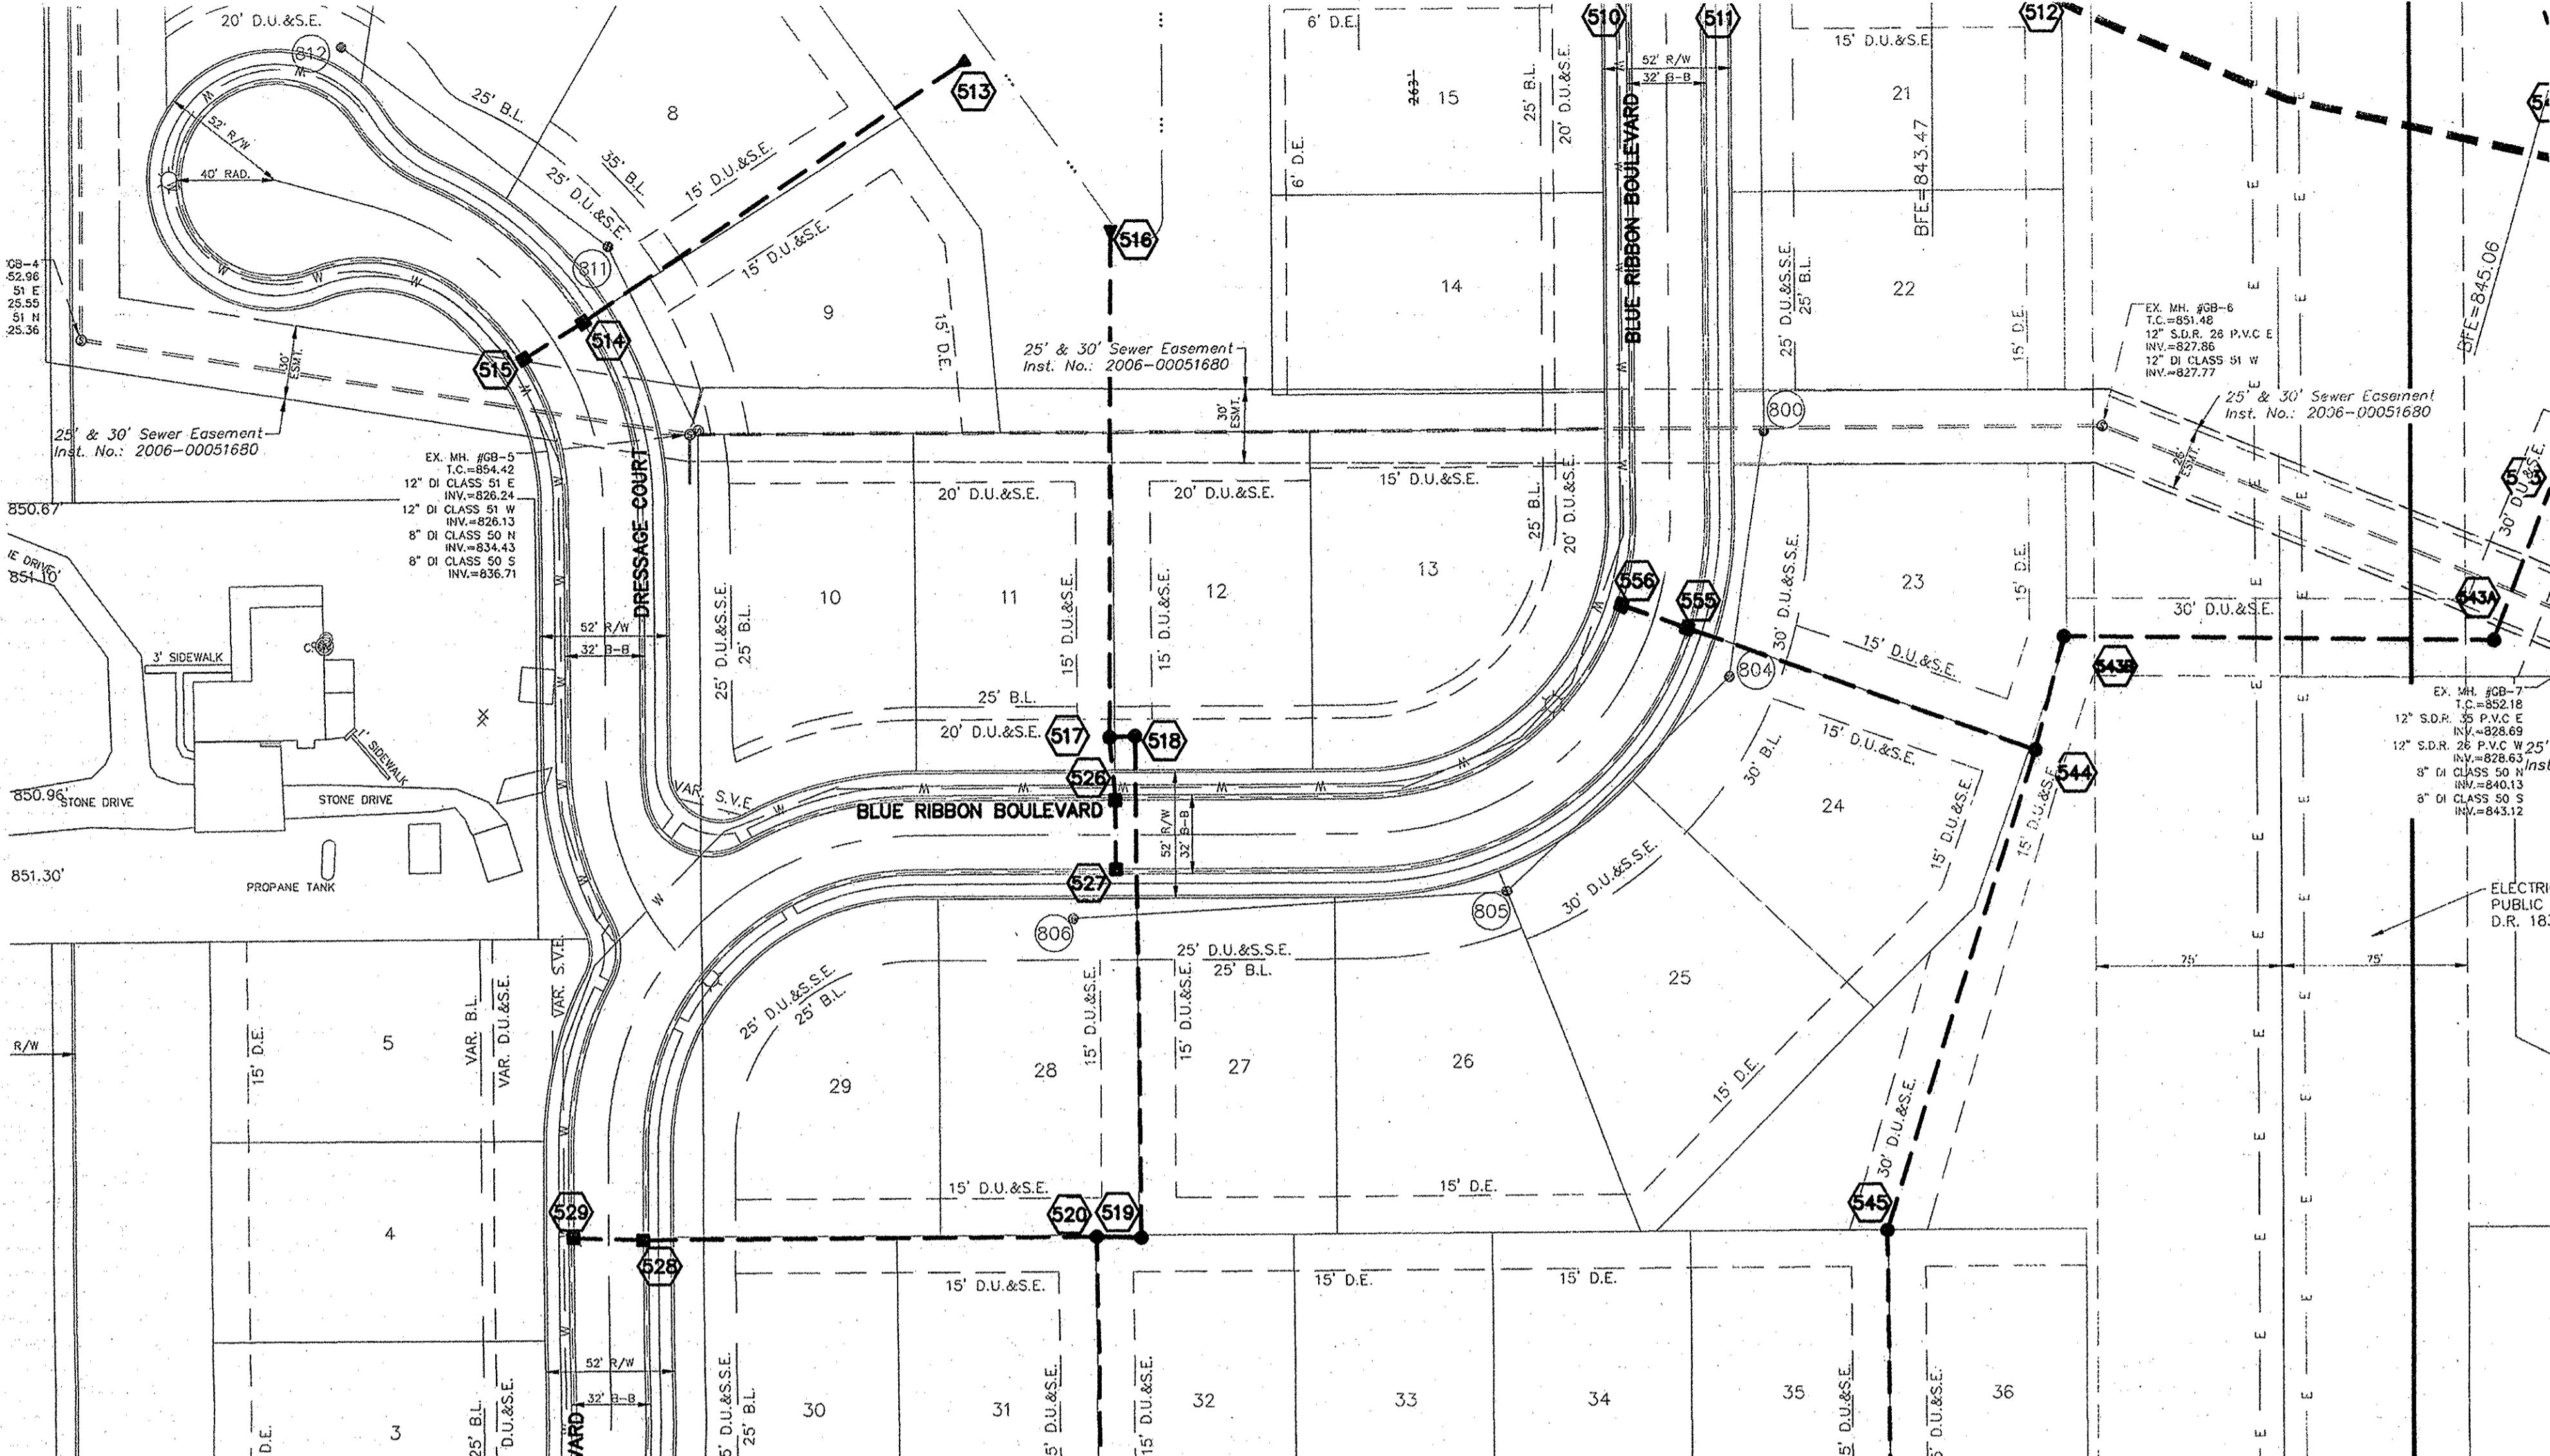

SCALE: 1" = 50' HOR.
1" = 5' VERT.


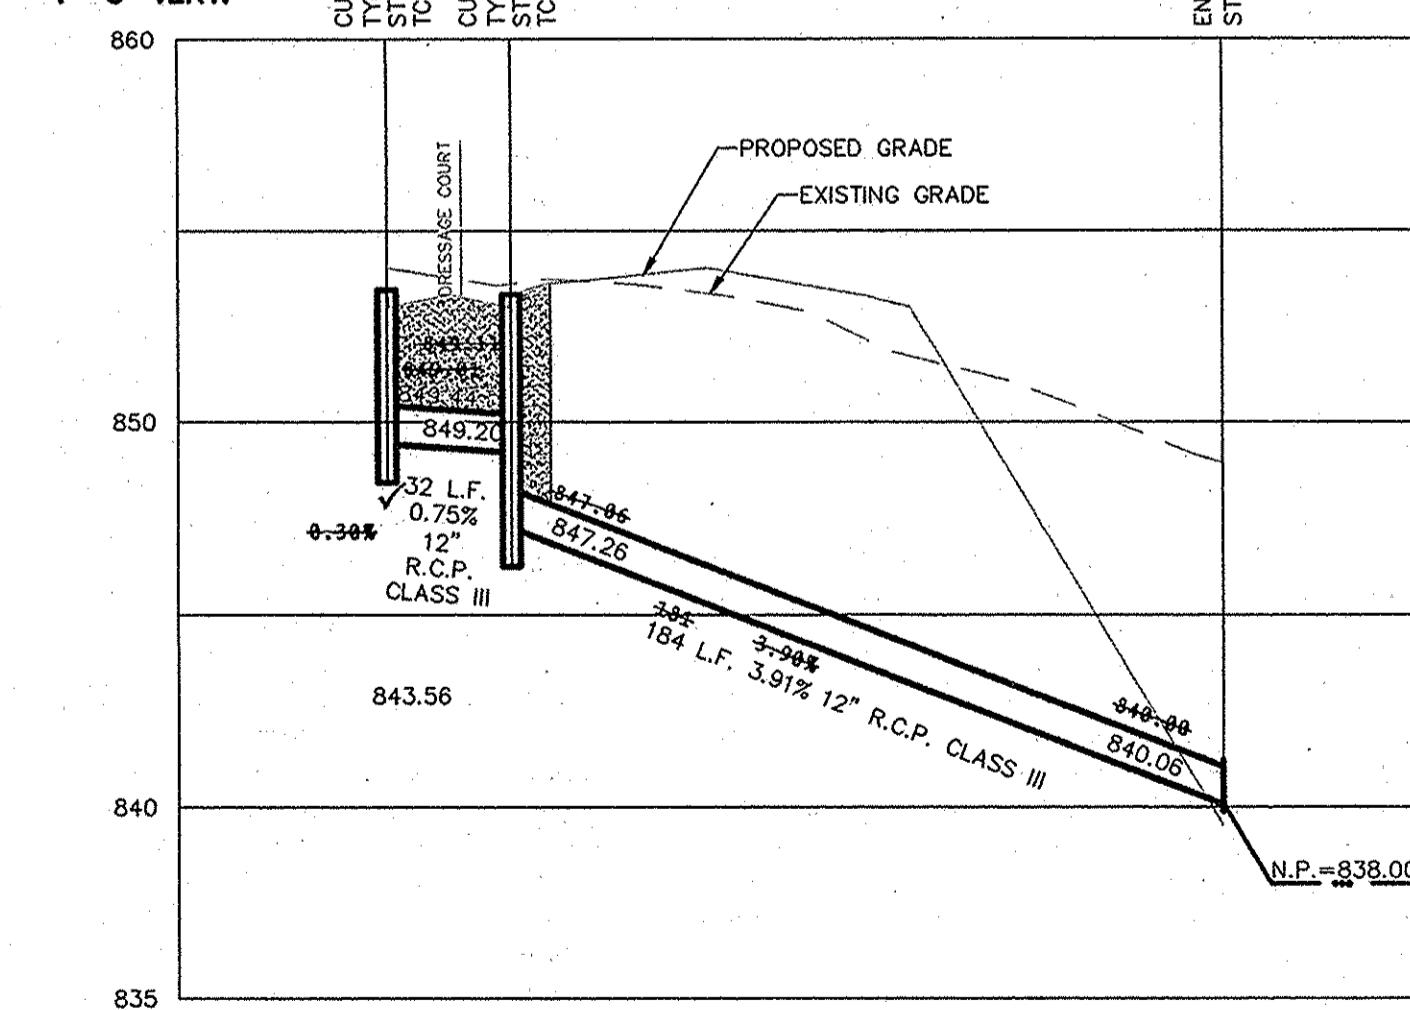


SCALE: 1"=50' H
1"=5' V

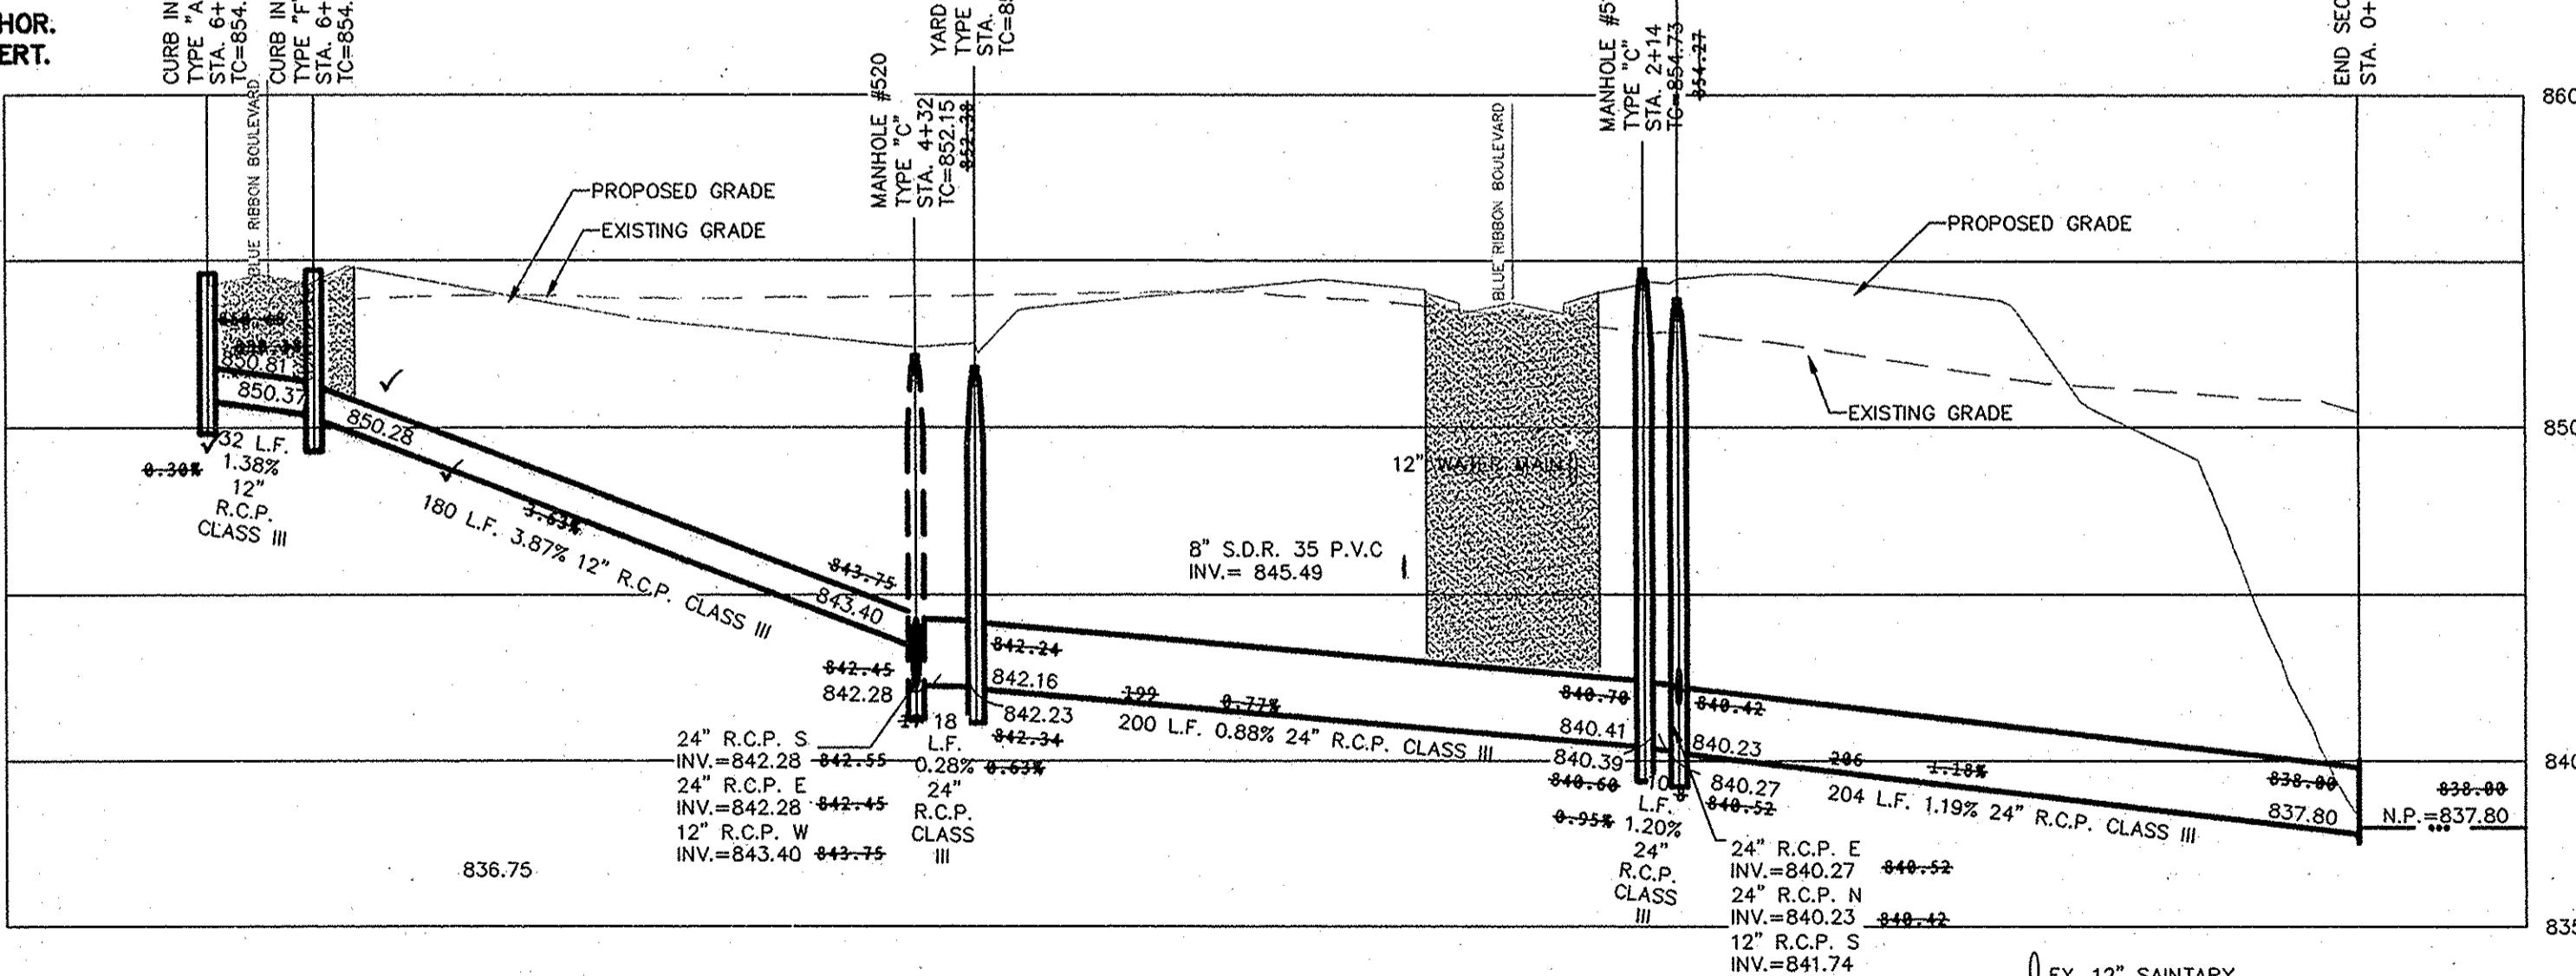


RECORD DRAWING

DENNIS D. OLMSTEAD
Registered Land Surveyor
No. 900012
DATE
8/11/2015

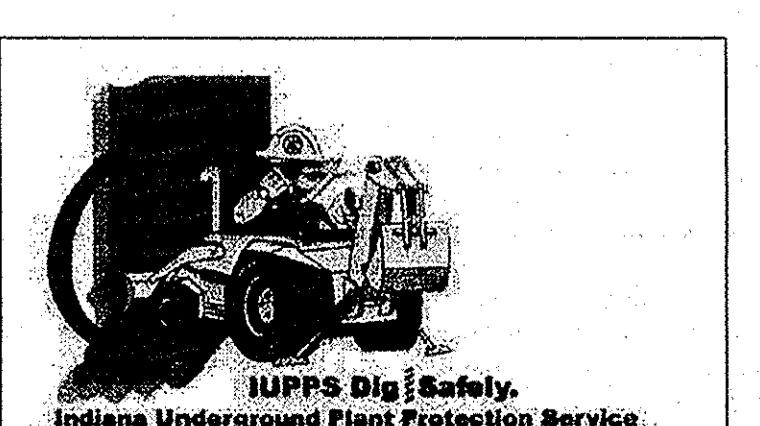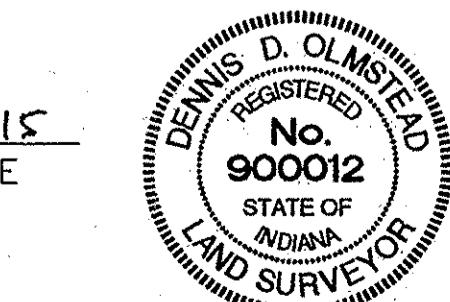

The image features the 811 logo, which consists of the numbers "811" in a large, bold, black font. The "1" has a registered trademark symbol (®) to its upper right. Below the numbers is a stylized, dark, undulating shape resembling a wave or a plowed field. At the bottom of the image, the text "Know what's below." is written in a bold, black, sans-serif font. Directly beneath it, the words "Call before you dig." are also in a bold, black, sans-serif font.

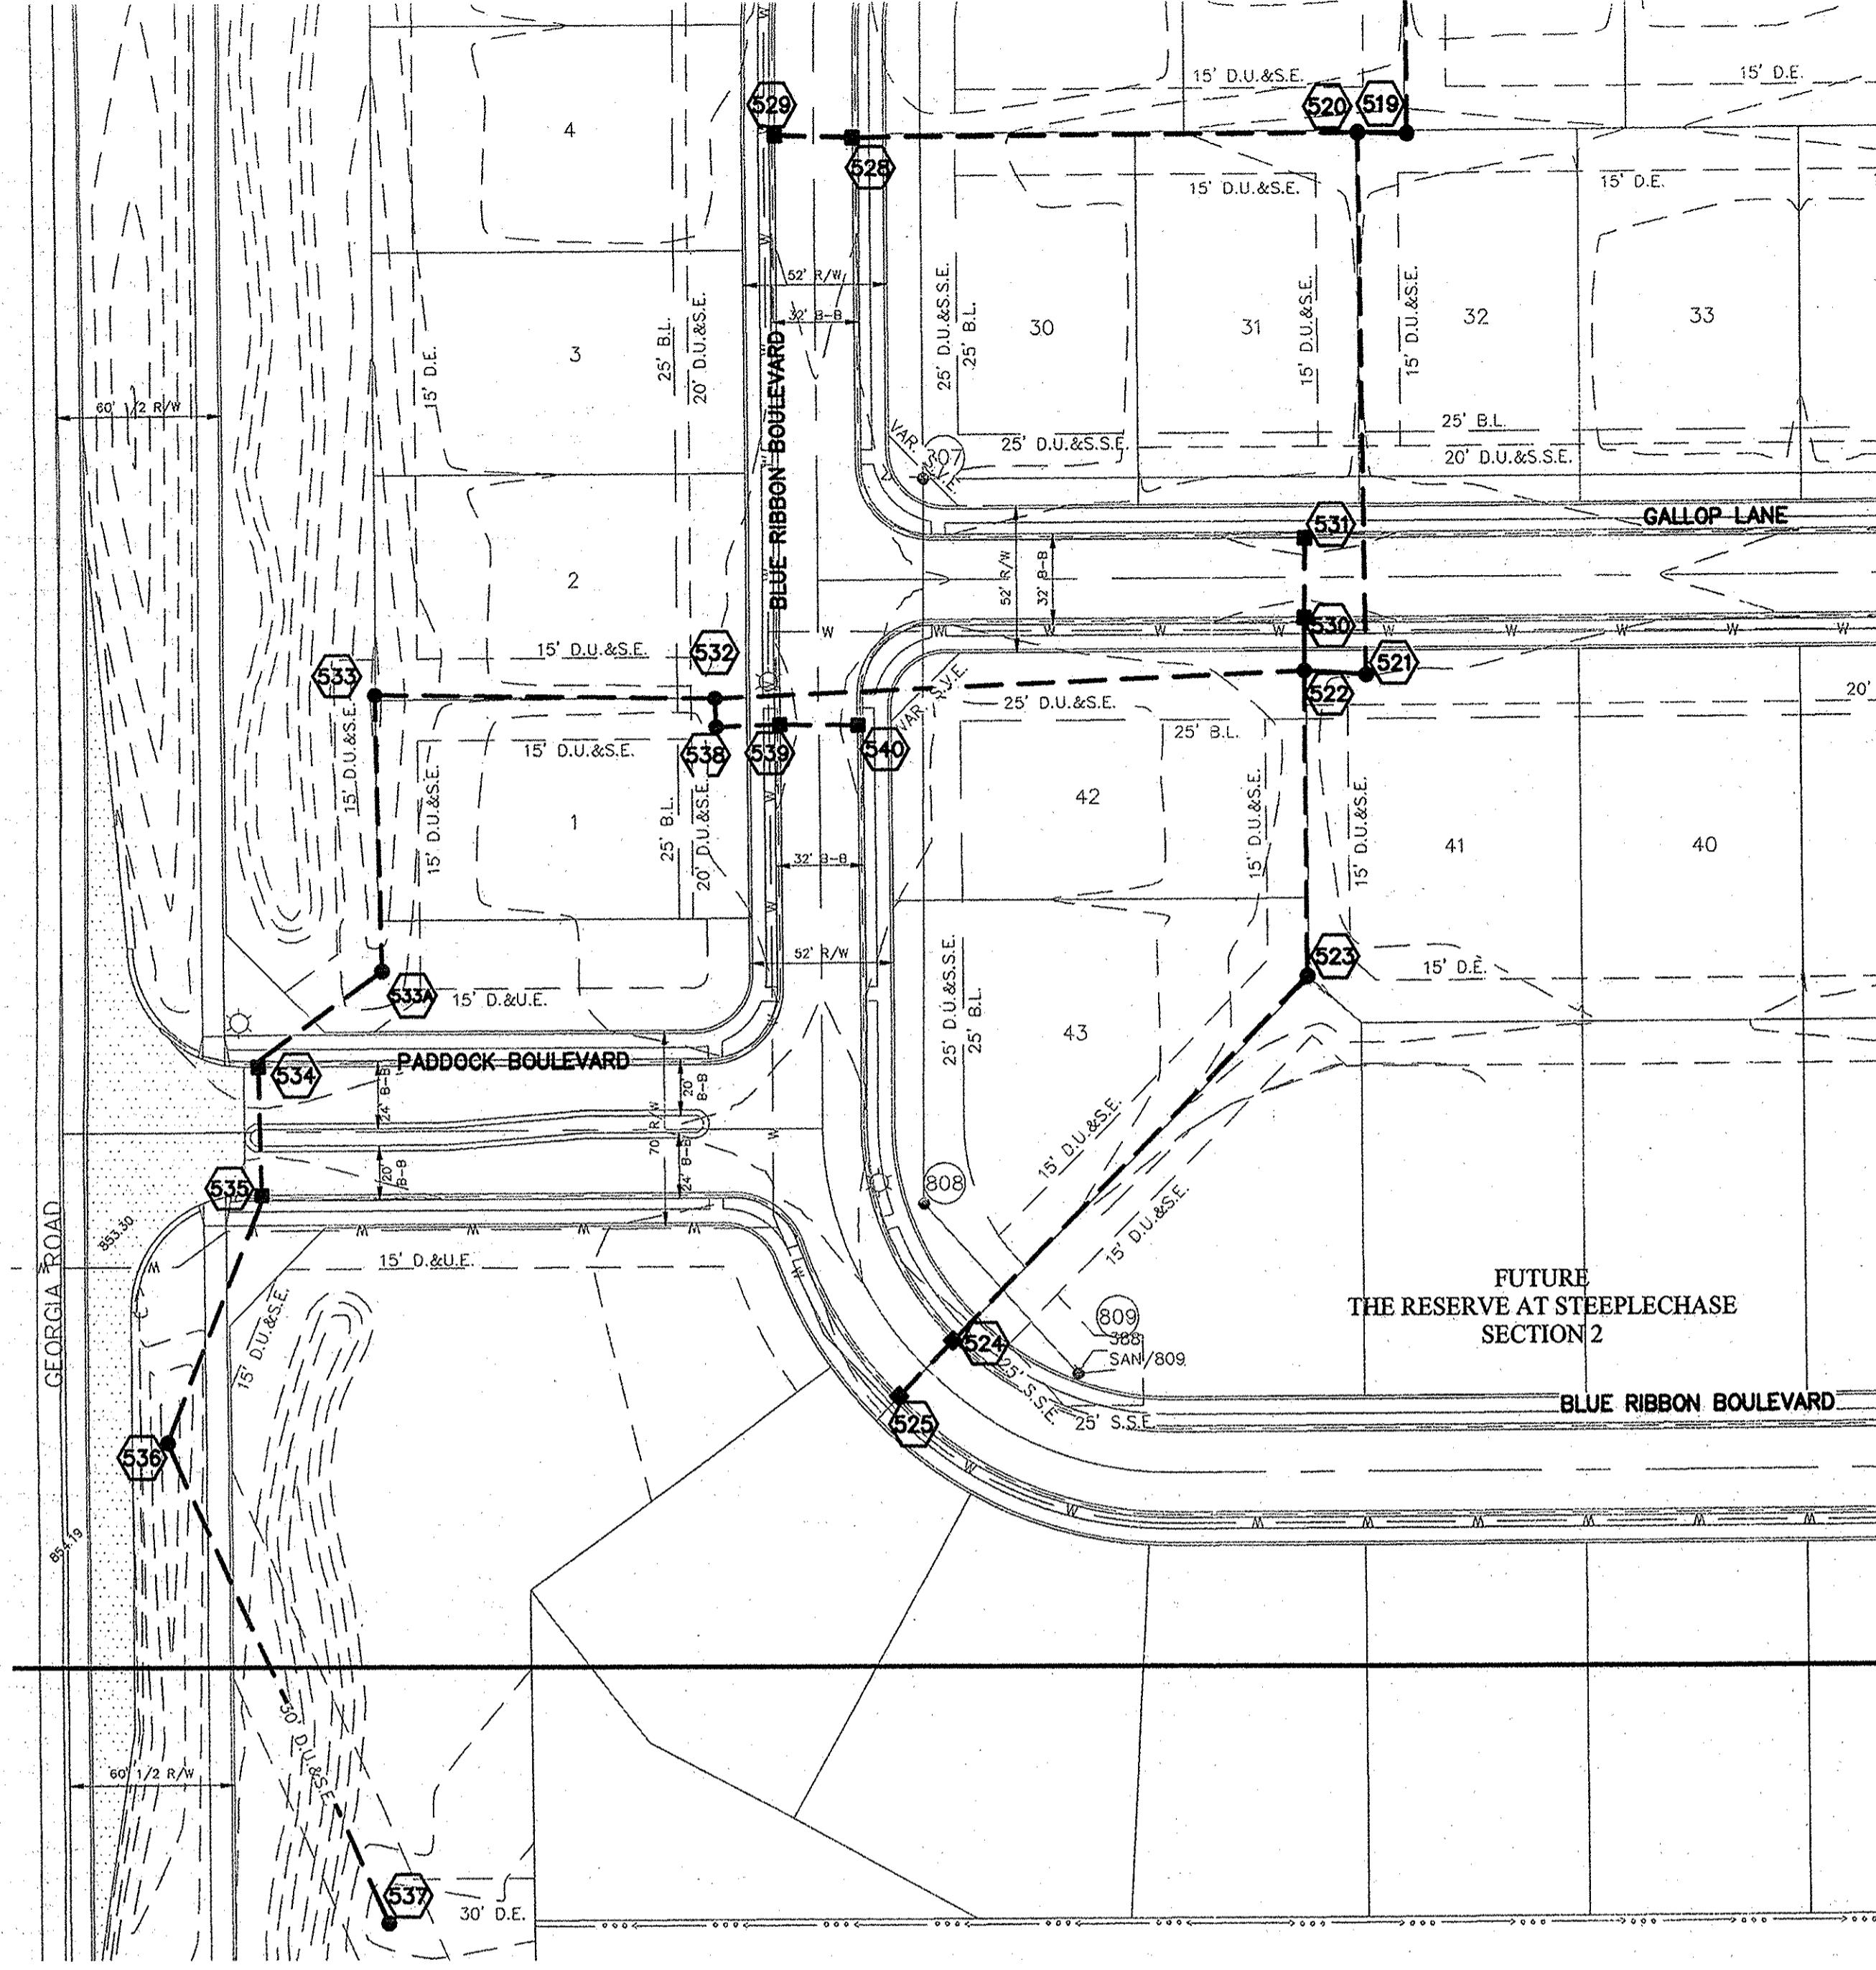

Name: _____
Identified / By: _____

File
Mo
Plot

File Modes

**SCALE: 1"=50' HOR
1"=5' VERT.**

YARD INLET #537
TYPE "A"
STA. 10+41
TC=850.92

YARD INLET #536
TYPE "C"
STA. 8+51
TC=850.27

PROPOSED GRADE

EXISTING GRADE

847.50

846.95

846.77 193 0.29' 846.20

190 L.F. 0.30% 15" R.C.P. CLASS III

840

835

YARD INLET #533
TYPE "C"
STA. 5+52
TC=850.80 850-76

MANHOLE #532
TYPE "C"
STA. 4+30
TC=853.60 ✓

MANHOLE #521
TYPE "C"
STA. 1+94
TC=852.79 852-89

MANHOLE #520
TYPE "C"
STA. 0+00
TC=852.15 852-38

EXISTING GRADE
PROPOSED GRADE
SUE RIBBON BOULEVARD
GALLOP LANE

845.13 845.03 844.55 844.42 844.41 844.42 212 844.42 844.41 844.40 843.75 843.54 844.00 843.56 842.55
845.05 844.93 844.52 844.42 844.41 844.40 213 844.42 844.41 844.40 843.94 843.88 843.90 843.49 ✓ 842.28
8" R.C.P. 123 L.F. 0.33% 18" R.C.P. CLASS III 324 0.39% 212 0.21% 213 L.F. 0.23% 24" R.C.P. CLASS III 22 L.F. 0.75% 194 L.F. 0.62% 24" R.C.P. CLASS III 842.06
18" R.C.P. W INV.=844.52 844.55 24" R.C.P. E INV.=844.42 844.45 12" R.C.P. S INV.=846.33 846.45 24" R.C.P. S INV.=842.28 24" R.C.P. E INV.=842.28 12" R.C.P. W INV.=843.40
12" R.C.P. S INV.=844.59 24" R.C.P. E INV.=843.88 843.90 1.55% 24" R.C.P. S INV.=843.96 12" R.C.P. N INV.=845.96 24" R.C.P. W INV.=843.94 844.00
8" S.D.R. 26 P.V.C INV.= 837.72

This block contains the Hamilton County Surveyor's seal and two lines of handwritten text: "Entry Date: 2018" and "Entered By: SLM".

The seal is circular with the words "HAMILTON COUNTY INDIANA SURVEYOR" around the perimeter and a central figure holding a compass.

This information was gathered for input into the Hamilton County Geographic Information System (GIS). This document is considered an official record of the GIS.

Entry Date: 2018

Entered By: SLM

RECORD DRAWING

DENNIS D. OLMSTEAD
Registered Land Surveyor
No. 000012

811

**Know what's below.
Call before you dig.**

**Know what's below.
Call before you dig.**

卷之三



10. The following table shows the number of hours worked by each employee.

SCALE: 1"=50' HOR.
1"=5' VERT.

860

PROPOSED GRADE

EXISTING GRADE

8"

WATER MAIN

847.50 847.22

846.85 846.71

846.45 846.33

848.01
849.05

848.97

848.14
849.24

849.14

32 L.F.
0.34%
3.76% 3.20%

18" MINI
12" R.C.P.
CLASS III

18" R.C.P. W
INV.=844.52 844.55

24" R.C.P. E
INV.=844.42 844.45

12" R.C.P. S
INV.=846.33 846.45 4.00% 3.80% CLASS

21 L.F.
10 12" L.F. R.C.P.
12" III R.C.P. CLASS

850

840

MANHOLE #538
TYPE "C"
STA. 0+10
TC=853.69

CURB INLET #539
TYPE "M"
STA. 0+32
TC=853.20

CURB INLET #540
TYPE "A"
STA. 0+64
TC=853.26

850

840

SCALE: 1"=50' HOR.
1"=5' VERT.

CURB INLET #
TYPE "A"
STA. 3+23
TC=853.80

CURB INLET #
TYPE "F"
STA. 2+91
TC=853.76

YARD INLET #
TYPE "C"
STA. 1+10
TC=852.29

MANHOLE #52
TYPE "C"
STA. 0+00
TC=852.19

860

PROPOSED GRADE

EXISTING GRADE

BLUE RIBBON BOULEVARD

849.87

849.77

849.67

32 L.F.
0.30%
12"
R.C.P.
CLASS III

181 L.F. 0.76% 12" R.C.P. CLASS III

848.29

848.19

110 L.F. 3.27% 12" R.C.P. CLASS III

844.59

840

I. 8" S.D.R. 26 P.V.C
INV.= 838.84

12" R.C.P. S
INV.=844.59
24" R.C.P. E
INV.=843.88
12" R.C.P. N
INV.=845.96
24" R.C.P. W
INV.=843.94

835

SCALE: 1"=50' HOR.
1"=5' VERT.

860

CURB IN TYPE "M" STA. 0+ TC=852.

850

GALLOP LANE

MANHOLE #522 TYPE "C" STA. 0+00 TC=852.19 852.50

EXISTING GRADE

PROPOSED GRADE

848.28

848.35

32 L.F.

0.59% 1.34%

12"

R.C.P.

CLASS III

846.41 \$46.35

845.96 \$46.00

840

16 17 12" R.C.P. S
L.F. INV.=844.59 844

1.92% 2.65% 24" R.C.P. E
12" INV.=843.88 843

R.C.P.

CLASS III 12" R.C.P. N
INV.=845.96 846

24" R.C.P. W
INV.=843.94 844

YARD INLET #523
TYPE "C"
STA. 1+10
TC=852.29

MANHOLE #522
TYPE "C"
STA. 0+00
TC=852.19

PROPOSED GRADE

EXISTING GRADE

848.29

181 L.F. 0.76% 12" R.C.P. CLASS III

848.19

110 L.F. 3.27% 12" R.C.P. CLASS III

844.59

12" R.C.P. S
INV.=844.59

24" R.C.P. E
INV.=843.88

12" R.C.P. N
INV.=845.96

24" R.C.P. W
INV.=843.94

8" S.D.R. 26 P.V.C
INV.= 838.84

STORM PLAN & PROFILES

E RESERVE AT STEEPLECHA SECTION 1

STEPPWERTH

RELEASER

N & PROFIT STEEPLE
ATION 1

FORM PLAN
RESERVE A
SEC

STORY
THE R

DRAWN BY
KRG
SHEET NO.
C60
S & A JOB NO.
50060MI-S

THIS DRAWING IS NOT INTENDED TO BE
ORIGINAL, BOUNDARY, SURVEY, A ROUTE
SURVEY, OR A SURVEY FOR LOCATION
CERTIFIED: 12/02/13
David J. Stoppelwirth
DAVID J. STOEPPELWERTH
REGISTERED PROFESSIONAL ENGINEER
STATE OF INDIANA
NO. 19358
KJAM
DCM
DCM
FISHERS
REVISIONS

ALWAYS ON
745 East 16th Street, Fishers, IN 46038-2926
phone: 317.849.9355 fax: 317.849.5942

THIS DRAWING IS NOT INTENDED TO BE
ORIGINAL, BOUNDARY, SURVEY, A ROUTE
SURVEY, OR A SURVEY FOR LOCATION
CERTIFIED: 12/02/13
David J. Stoppelwirth
DAVID J. STOEPPELWERTH
REGISTERED PROFESSIONAL ENGINEER
STATE OF INDIANA
NO. 19358
KJAM
DCM
DCM
FISHERS
REVISIONS

This information was gathered for input into the
Hamilton County Geographic Information
System (GIS). This document is considered an
official record of the GIS.
Entry Date: 2018
Entered By: *SLM*





STORM PLAN & PROFILES
THE RESERVE AT STEEPLECHASE
SECTION 1
HAMILTON COUNTY, INDIANA


DRAWN BY: KRG
CHECKED BY: BKR
SHEET NO. C603
FISHERS
S & A JOB NO. 50060MI-S1

81

Know what's below.
Call before you dig.


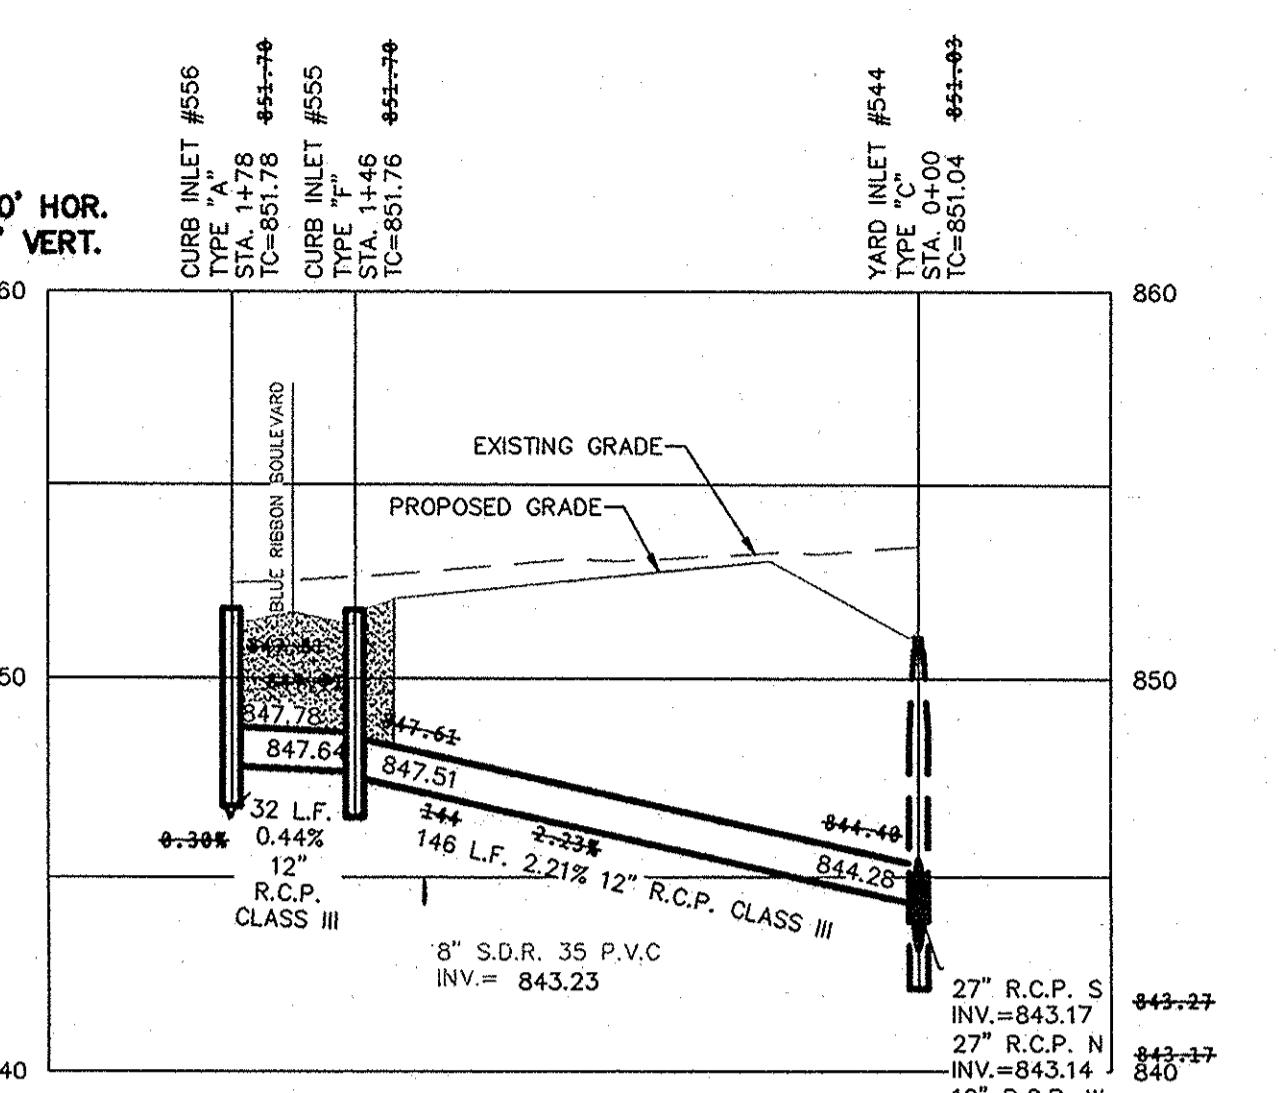
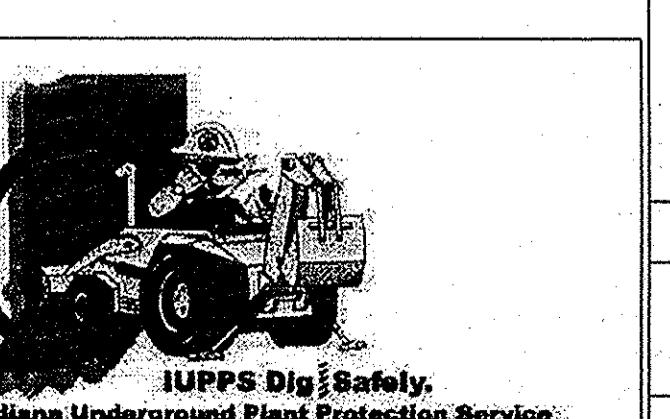


RECORD DRAWING

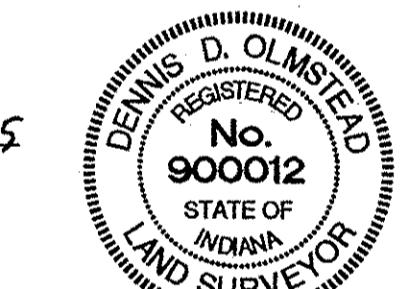

8/11/2015

DENNIS D. OLMSTEAD
Registered Land Surveyor
No. 900012

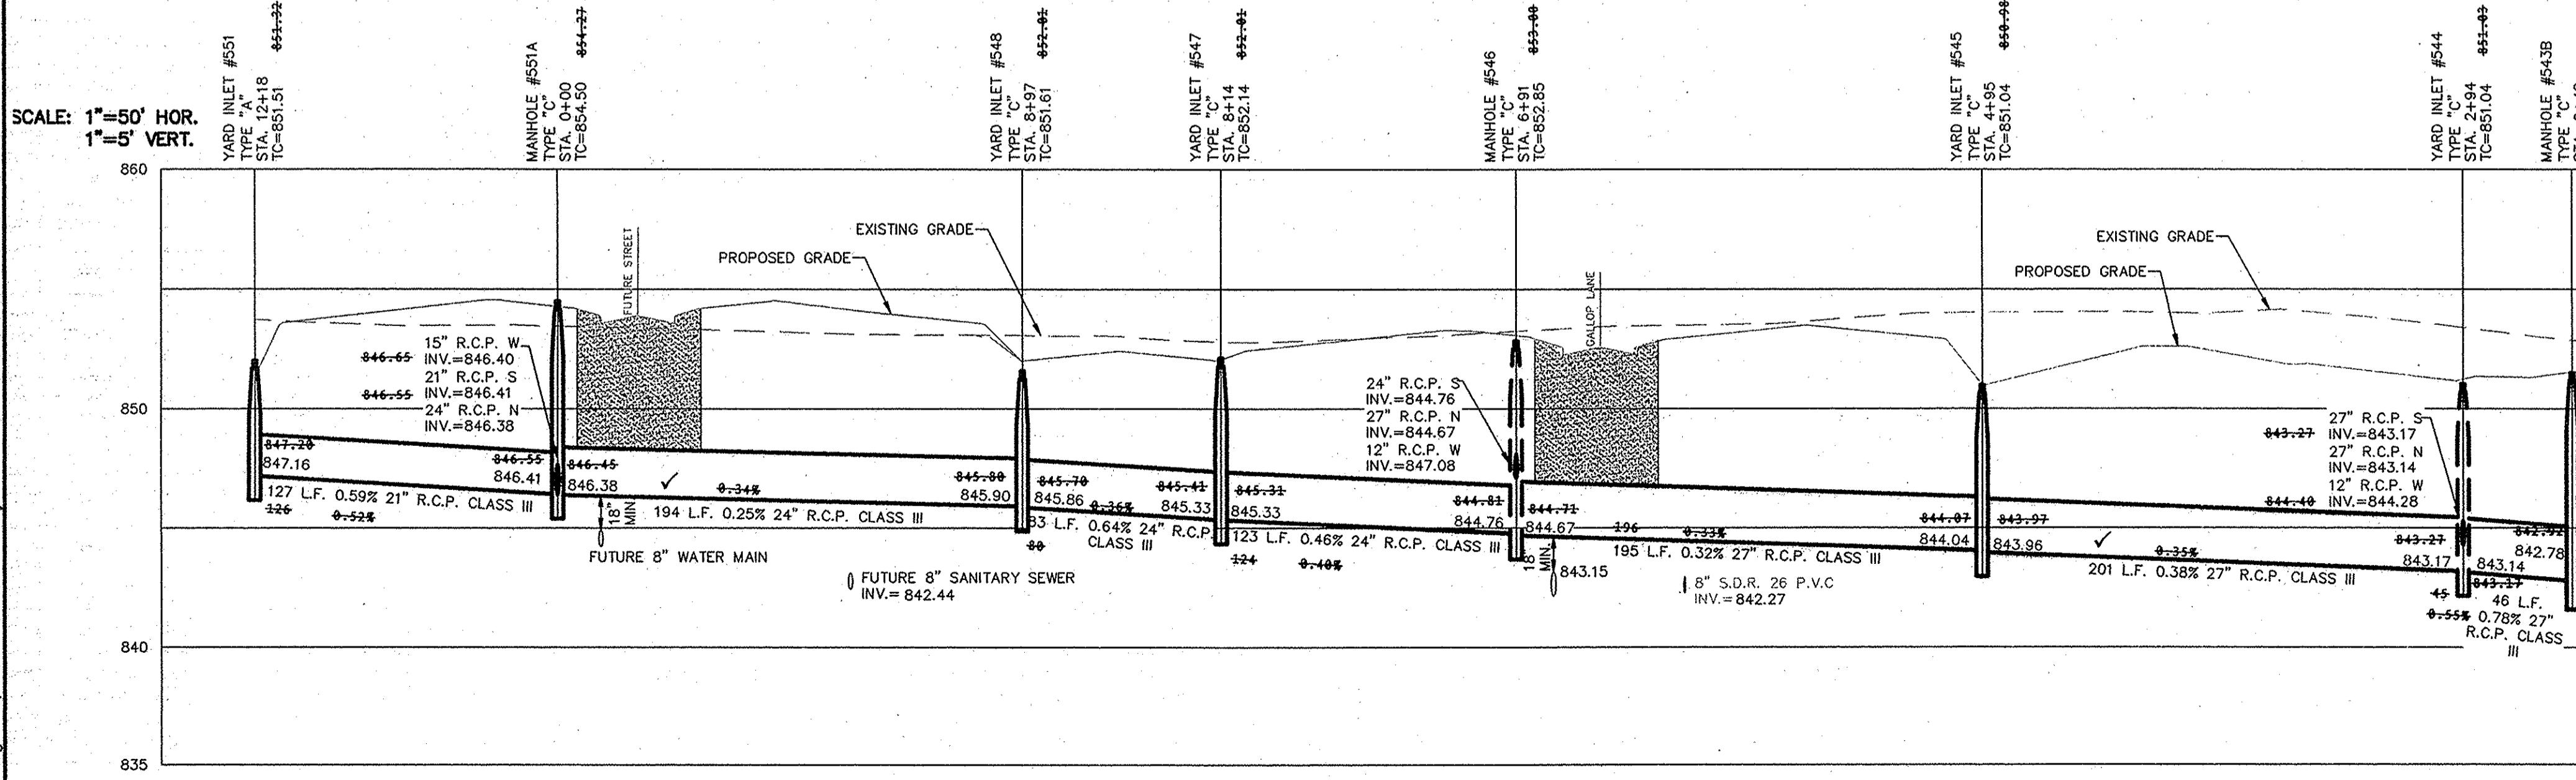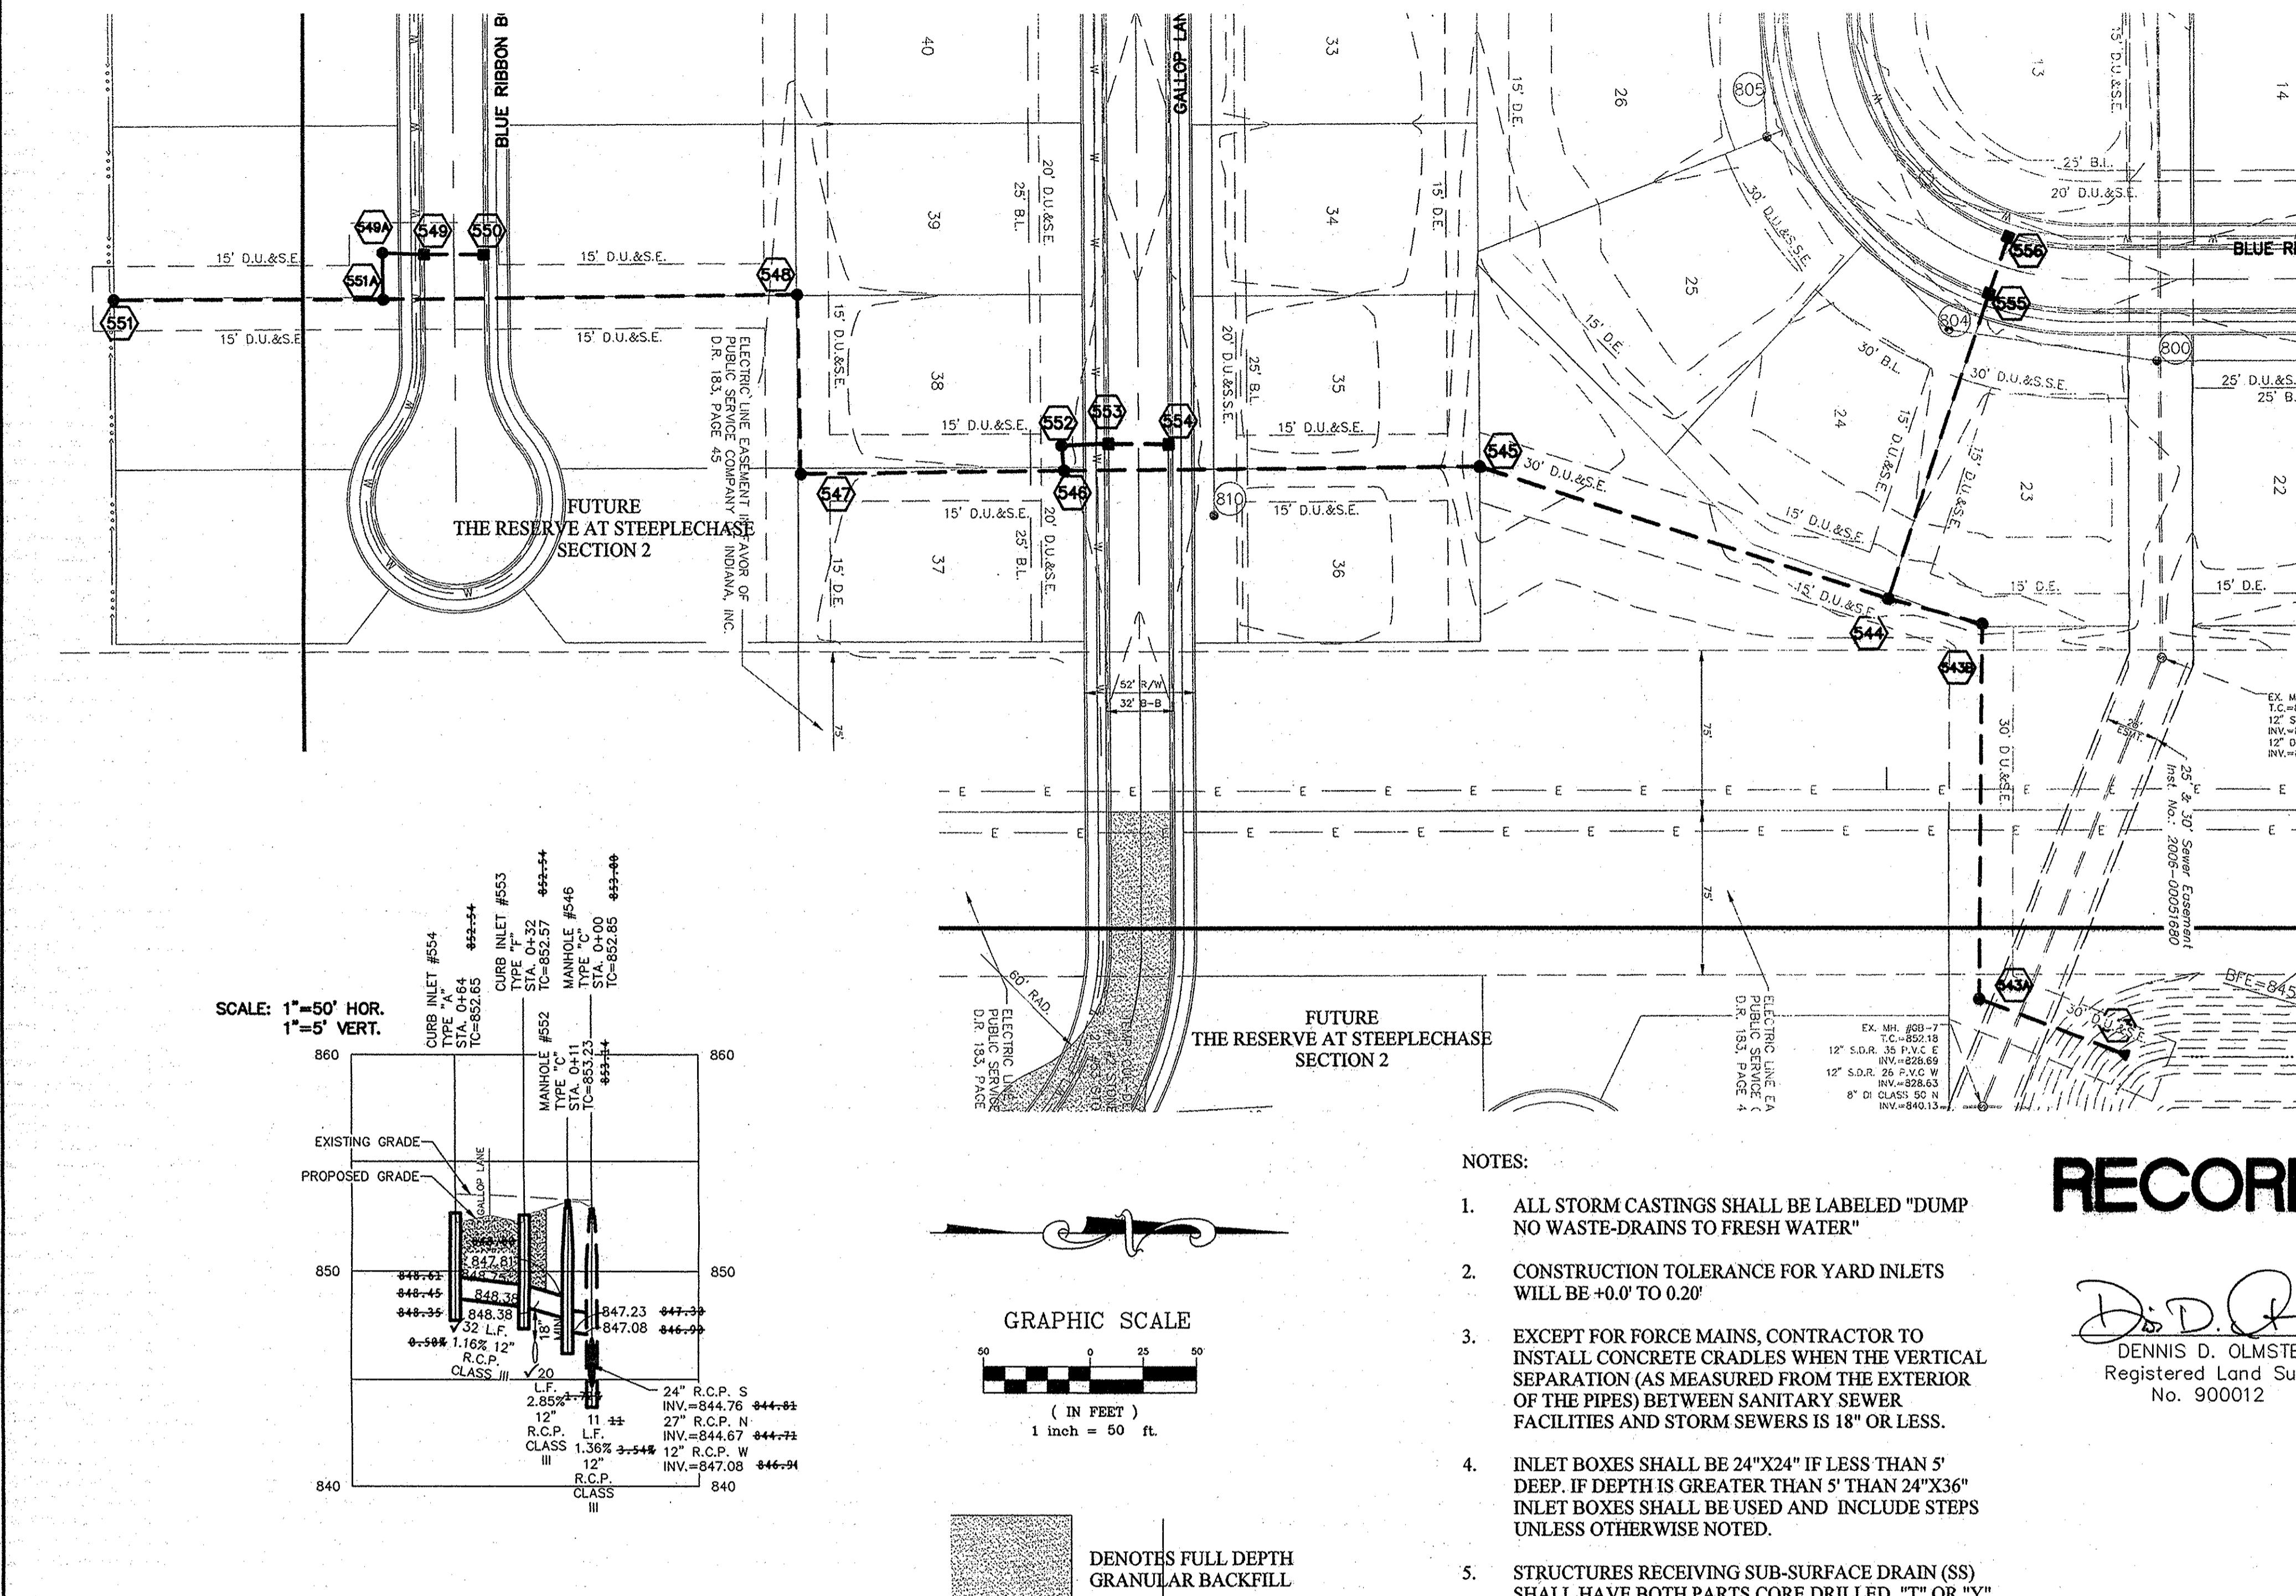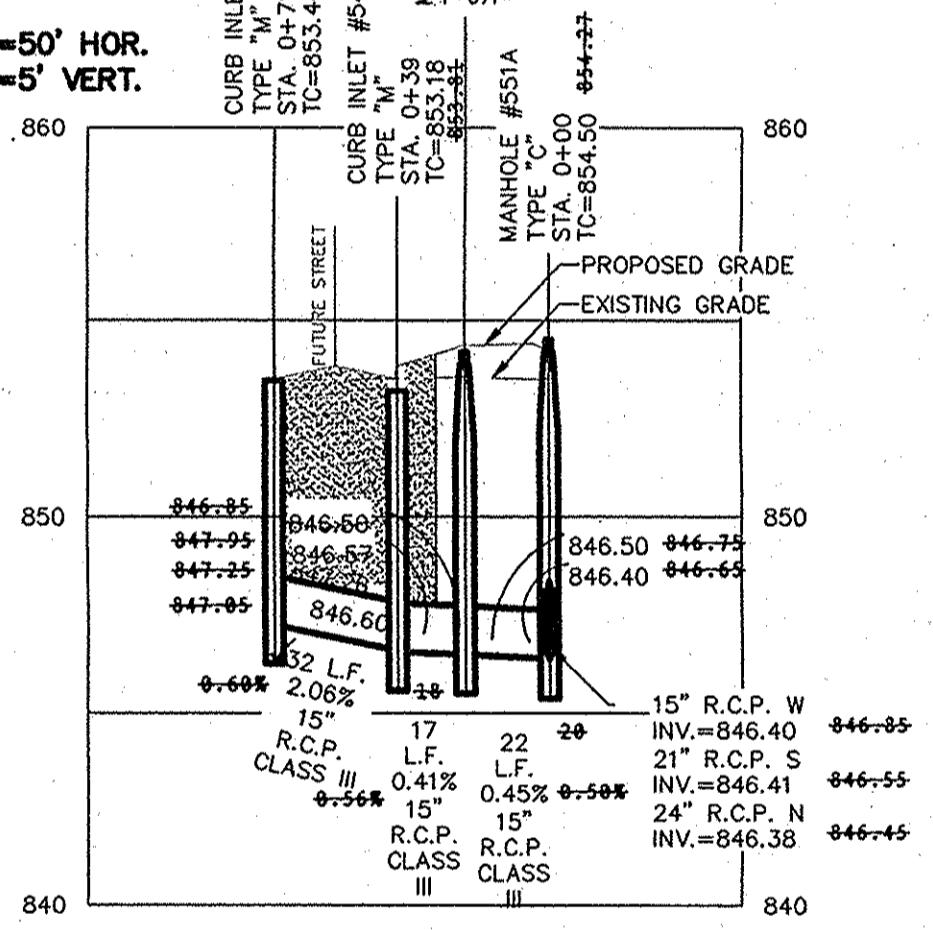

RECORD DRAWING

DENOTES FULL DEPTH
GRANULAR BACKFILL






DENNIS D. OLSTEAD
Registered Land Surveyor
No. 900012



8/11/2015

DATE

THIS DRAWING IS NOT INTENDED TO BE REPRESENTED AS A RETRACEMENT OR ORIGINAL BOUNDARY SURVEY, A ROUTE SURVEY, OR A SURVEY FOR LOCATION REPORT.	
CERTIFIED: 12/02/13	
<i>David J. Stoeppelwirth</i>	
ALWAYS ON 765 East 10th Street, Noblesville, IN 46060-2505 Phone: 317.845.5935, fax: 317.845.5912	
STOEPPELWIRTH REGISTERED PROFESSIONAL ENGINEER NO. 19358 STATE OF INDIANA D.C.M.	
8/11/15 AS BUILT REVISED PER FISHERS COMMENTS 8/8/2014 REVISED PER SAMCO COMMENTS 04/14/04 REVISED PER FISHERS COMMENTS 01/14/04 REVISED TAC COMMENTS DATE	MARK REVISIONS BY

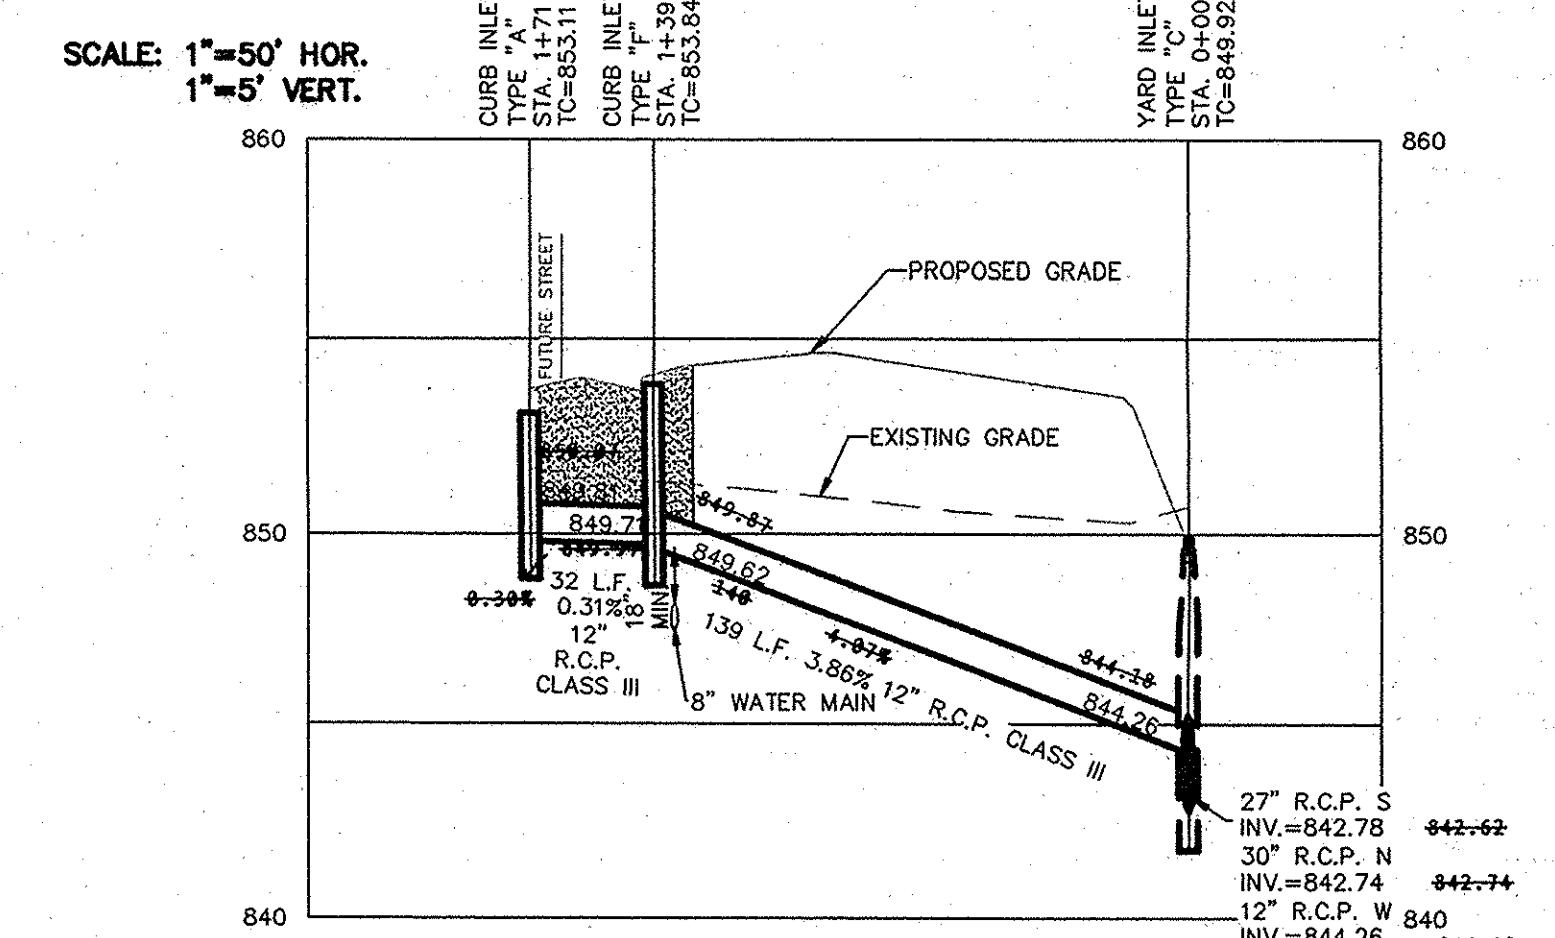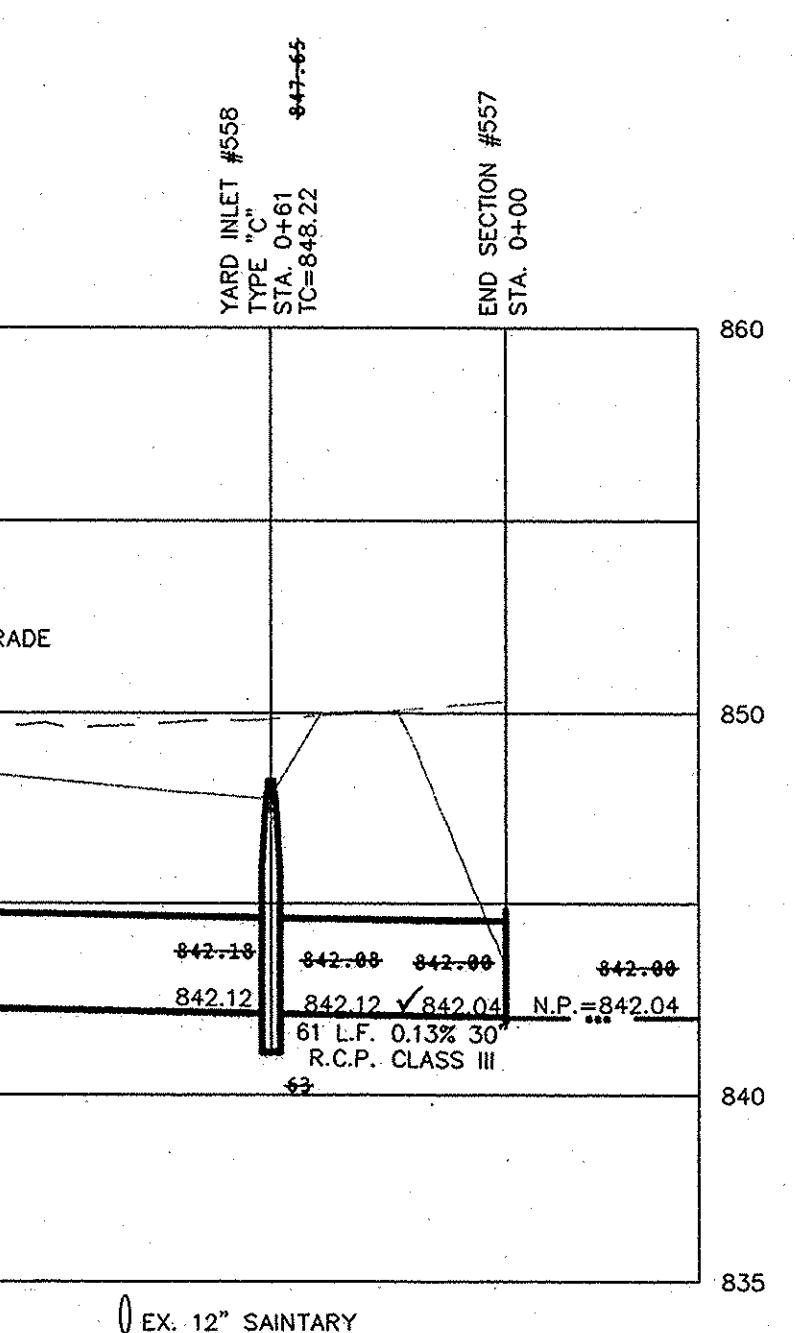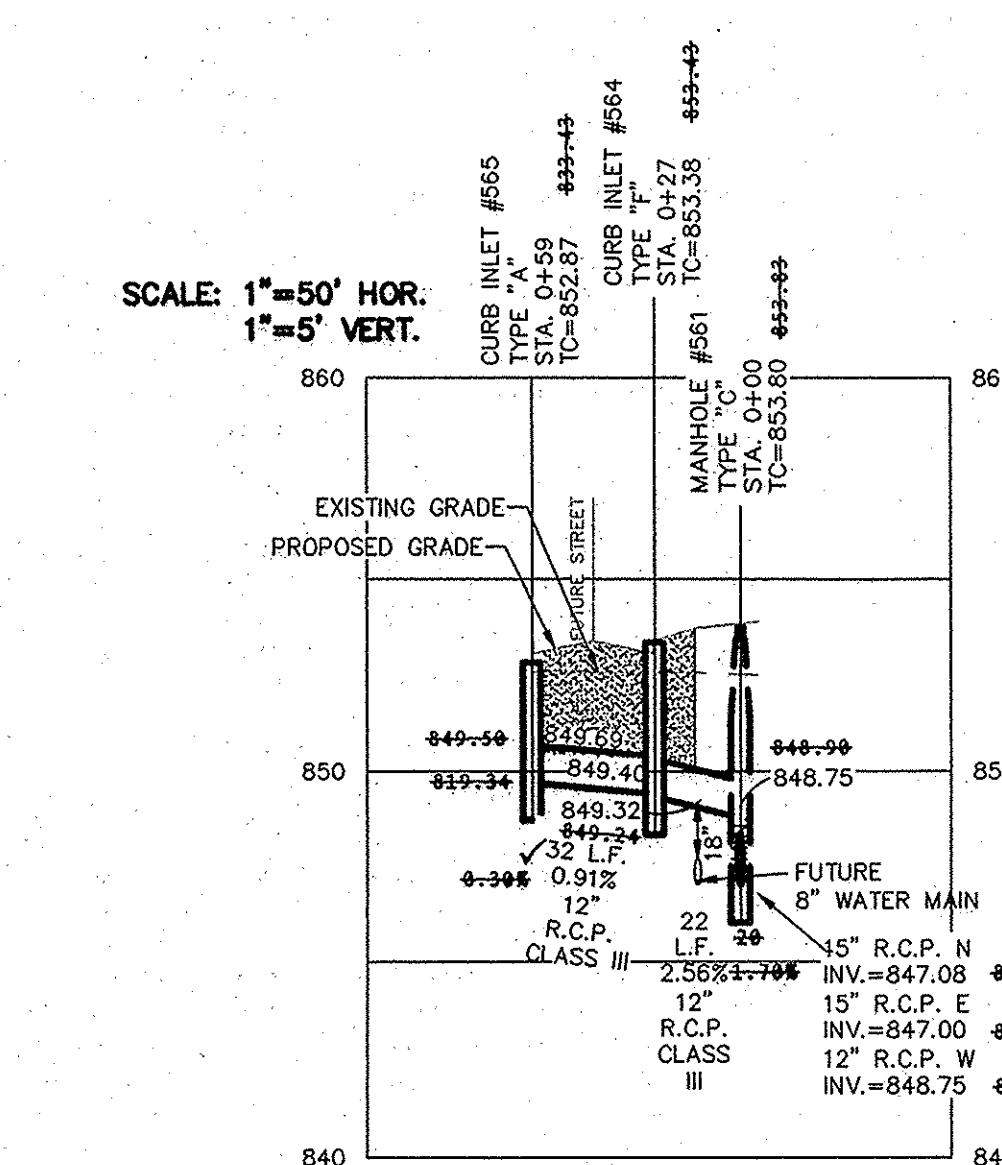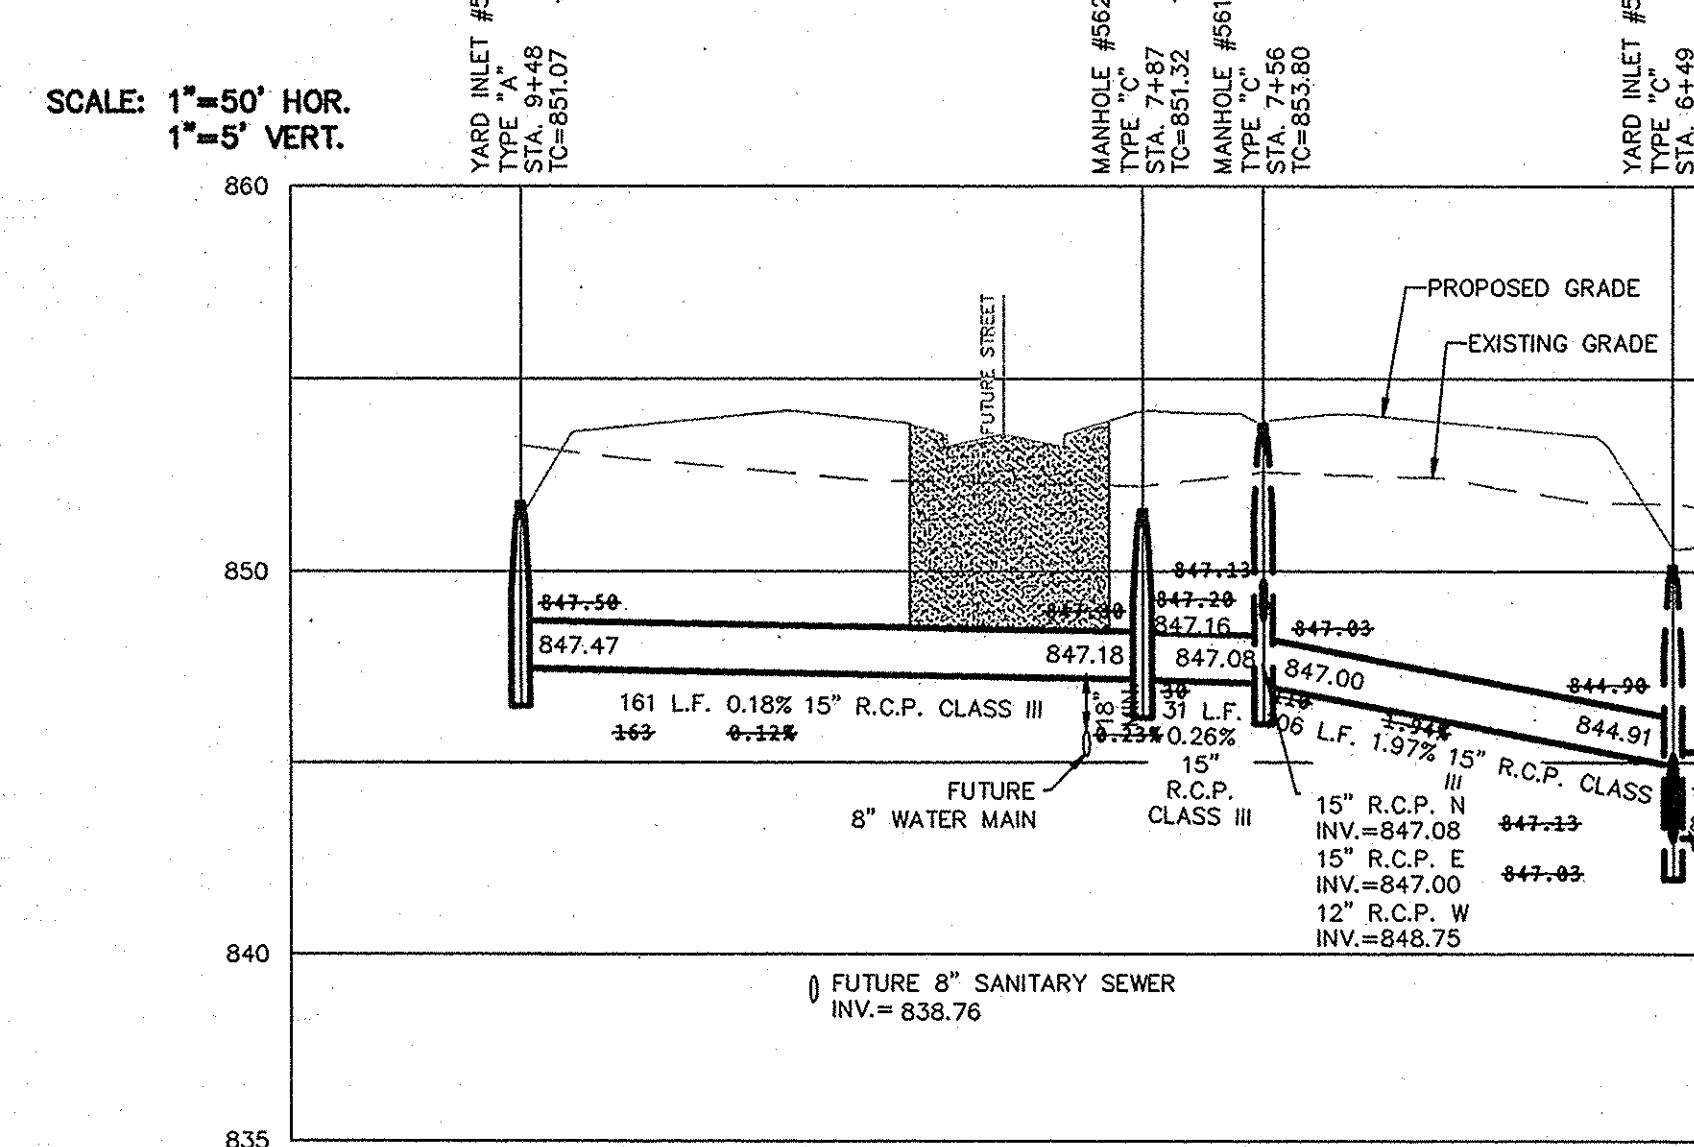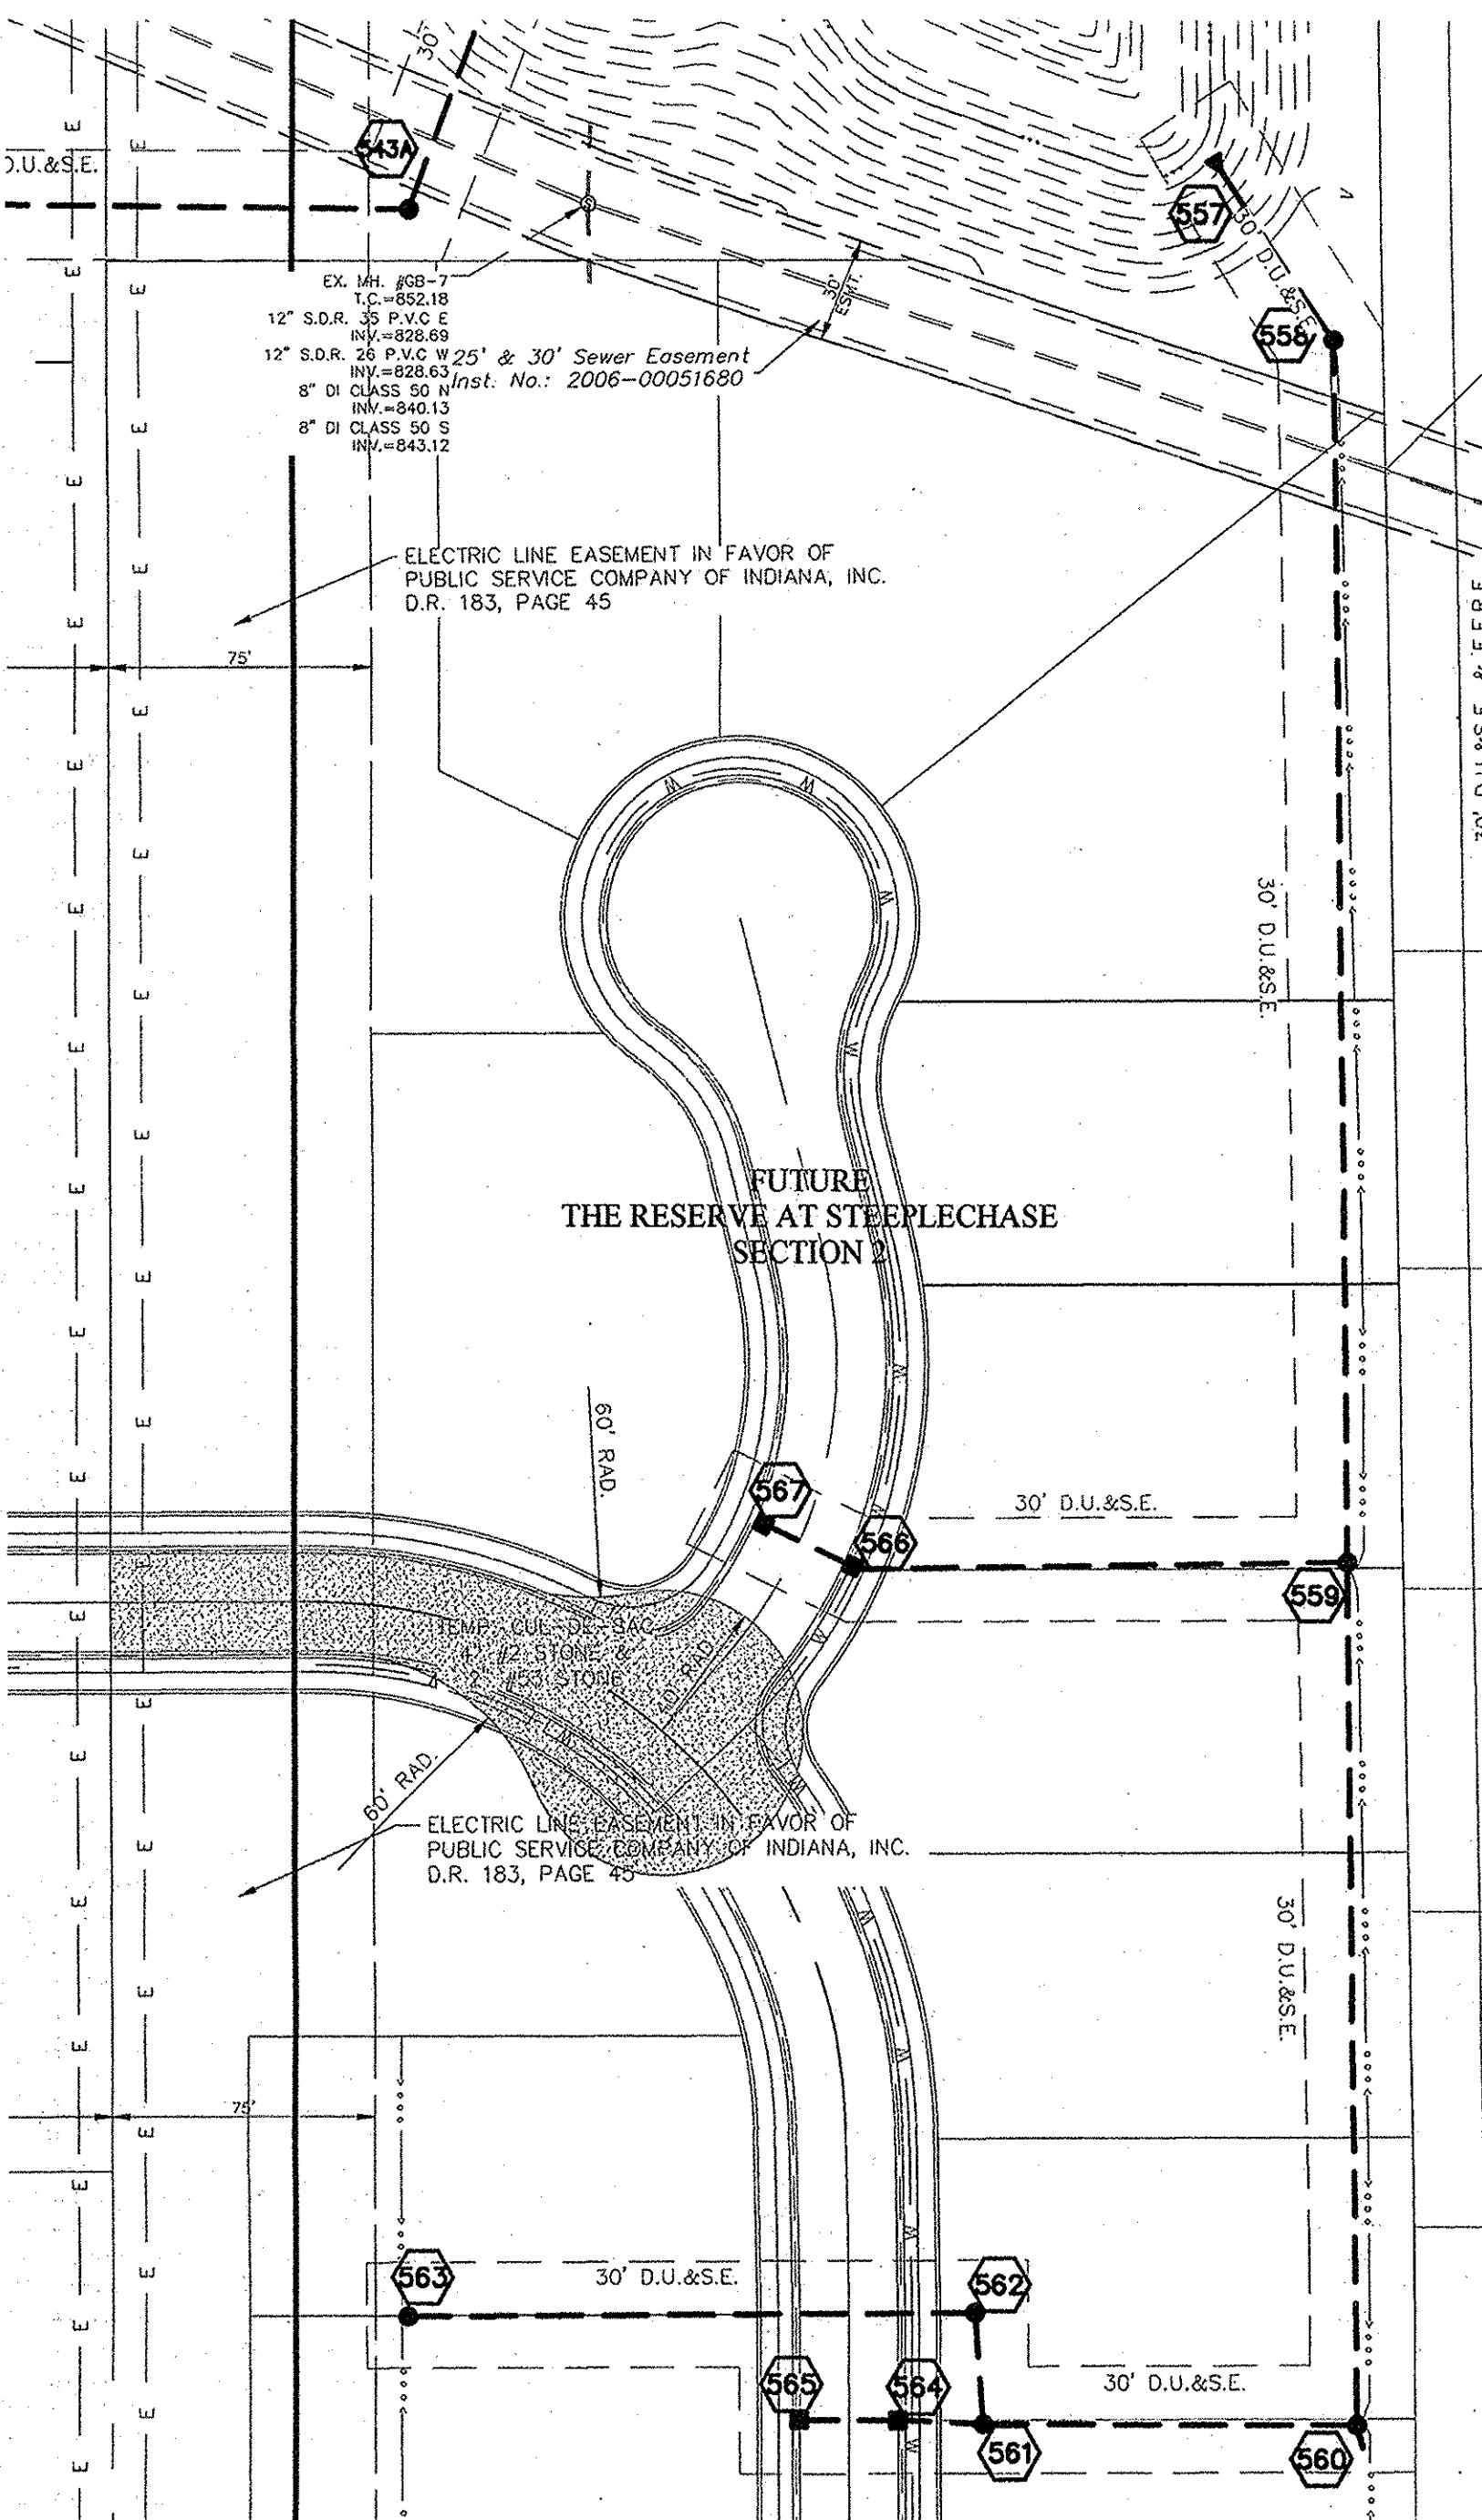

This information was gathered for input into the Hamilton County Geographic Information System (GIS). This document is considered an official record of the GIS.
Entry Date: 2018
Entered By: SLW



Know what's below.
Call before you dig.



STORM PLAN & PROFILES
THE RESERVE AT STEEPLECHASE
SECTION 1
HAMPTON COUNTY, INDIANA

DRAWN BY: KRG
CHECKED BY: BKR
SHEET NO. C604
FISHERS
S & A JOB NO. 50060MI-S1