

SURVEYOR'S OFFICE

# Hamilton County

*Kenton C. Ward, CFM*  
*Surveyor of Hamilton County*  
*Phone (317) 776-8495*  
*Fax (317) 776-9628*

*Suite 188*  
*One Hamilton County Square*  
*Noblesville, Indiana 46060-2230*

September 6, 2006

To: Hamilton County Drainage Board

Re: Fred Hines Drain, Slater Ridge Section 1 Arm

Attached is a petition and plans for the proposed relocation of the Fred Hines Drain. The relocation is being proposed by Precedent Residential Development, LLC. The proposal is to reconstruct the drain through Slater Ridge Section 1 per the plans by Schneider Corporation, Project No. 4736.001.

This line will consist of the following:

21" RCP	133 ft.	36" RCP	849 ft.	Open Pond	1,600 ft.
27" RCP	525 ft.	54" RCP	248 ft.	Open Ditch	413 ft.

The total length of new tile shall be 3,768 feet. The 2,853 feet of original drain between Sta. 46+88 and Sta. 66+84 of the main drain and between Sta. 8+57 and Sta. 0 of Arm 6 shall be vacated. This proposal will add an additional 915 feet to the drains total length.

Those portions of the drainage facilities in Slater Ridge Section 1 are those between Str. 250, 251, 253, 254, 515 and 255; Str. 522, 505, 506, 516 and 507; Str. 175, 176, 503, 521, 181, 184 and 502. The open ditch includes that portion between Str. 503 and 521 and the open drain west of Str. 502 through Common Area "A". The length of open drain through Pond #3 is measured in straight lines between Str. 175 and 255 and Str. 507 and Sta. 46+88 of the original Fred Hines Drain as it outlets into the north end of the pond.

The retention pond #3 located in Common Area A is to be considered part of the regulated drain. Pond maintenance shall include the inlet, outlet, sediment removal and erosion control along the banks as part of the regulated drain. The maintenance of the pond, such as mowing and aquatic vegetation control, will be the responsibility of the Homeowners Association. The Board will also retain jurisdiction for ensuring the storage volume for which the pond was designed will be retained, thereby, allowing no fill or easement encroachments.

The cost of the relocation is to be paid by Precedent Residential Development, LLC. Because the project is to be paid by the petitioner the project falls under the requirements as set out in IC 36-9-27-52.0. Therefore, a hearing is required for the petition.

The petitioner has provided the Performance Bond as follows:

Name of Bonding Co: Bond Safeguard Insurance Company.  
Bond No: 5013390  
Bond Date: October 11, 2004  
Bond Amount: \$268,476.67  
Bond Term: October 11, 2005


Along with Slater Ridge, Section 1, the following parcels are also affected by this relocation:

Parcel Number	Owner
10-10-04-00-00-025.003	Precedent Residential Development, LLC
10-10-04-00-00-026.000	George G. & Nancy F. Slater
10-10-04-00-00-025.000	George G. & Nancy F. Slater

The easements for the new drain shall be the drainage easements (DE) as recorded in the office of the Hamilton County Recorder, Instrument No. 200500068617, Plat Cabinet 3, Slide 745. Attached is a non-enforcement request for the easements within Slater Ridge Section 1 as recorded in the office of the Hamilton County Recorder.

I recommend the Board set this for hearing on November 27, 2006.

Sincerely,

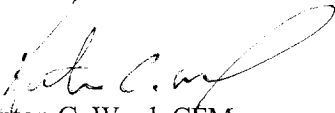

Kenton C. Ward, CFM  
Hamilton County Surveyor

KCW/llm

Hamilton County Drainage Board  
Court House  
Noblesville, Indiana

IN RE: Slater Run, Section 1)  
Hamilton County Indiana )



PETITION FOR RELOCATION AND RECONSTRUCTION

Precedent Development (hereinafter "Petitioner"),

hereby petitions the Hamilton County Drainage Board-for authority to relocate and Improve a section of the Fred Hines Drain, and in support of said petition advises the Board that:

1. Petitioner owns real estate through which a portion of the Fred Hines Drain runs.
2. Petitioner plans to develop its real estate with roads, buildings, utilities, storm drains, sanitary sewers and other structures.
3. Petitioner's proposed development of its real estate will require relocation and reconstruction of a portion of the Fred Hines Drain, as specifically shown on engineering plans and specifications filed with the Hamilton County Surveyor.
4. The work necessary for the proposed relocation and reconstruction will be undertaken at the sole expense of the Petitioner and such work will result in substantial improvement to the Fred Hines Drain, without cost to other property owners on the watershed of the Fred Hines Drain,

WHEREFORE, Petitioner requests that an Order issue from the Hamilton County Drainage Board authorizing relocation and reconstruction of the Fred Hines Drain, in conformance with applicable law and plans and specifications on file with the Hamilton County Surveyor.

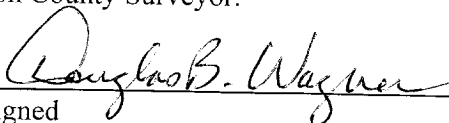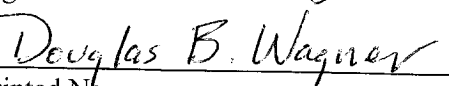  
Signed  
  
Printed Name

FINDINGS AND ORDER


CONCERNING THE PARTIAL VACATION OF THE


**Fred Hines Drain, Sta. 46+88 to Sta. 66+84 of main drain  
Sta. 8+57 to Sta. 0 of Arm 6**


On this **27th day of November, 2006**, the Hamilton County Drainage Board has held a hearing on the Maintenance Report and Schedule of Assessments of the **Fred Hines Drain, Sta. 46+88 to Sta. 66+84 of main drain and Sta. 8+57 to Sta. 0 of Arm 6**.


Evidence has been heard. Objections were presented and considered. The Board then adopted an order of action. The Board now finds that the costs of continued maintenance to the portion of the above drain exceed the benefits to the real estate benefited by the portion of the drain to be abandoned and issues this order vacating the above section of the **Fred Hines Drain**.

HAMILTON COUNTY DRAINAGE BOARD

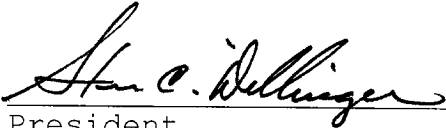  
\_\_\_\_\_  
President

  
\_\_\_\_\_  
Member

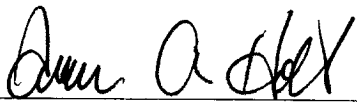  
\_\_\_\_\_  
Member

Attest: 

STATE OF INDIANA )  
 ) ss:  
COUNTY OF HAMILTON )

BEFORE THE HAMILTON COUNTY  
DRAINAGE BOARD  
NOBLESVILLE, INDIANA

IN THE MATTER OF THE  
RECONSTRUCTION OF THE  
*Fred Hines Drain, Slater Ridge Section 1 Arm*

FINDINGS AND ORDER FOR RECONSTRUCTION

The matter of the proposed Reconstruction of the *Fred Hines Drain, Slater Ridge Section 1 Arm* came before the Hamilton County Drainage Board for hearing on **November 27, 2006**, on the Reconstruction Report consisting of the report and the Schedule of Damages and Assessments. The Board also received and considered the written objection of an owner of certain lands affected by the proposed Reconstruction, said owner being:

Evidence was heard on the Reconstruction Report and on the aforementioned objections.

The Board, having considered the evidence and objections, and, upon motion duly made, seconded and unanimously carried, did find and determine that the costs, damages and expenses of the proposed Reconstruction will be less than the benefits accruing to the owners of all land benefited by the Reconstruction.


The Board having considered the evidence and objections, upon motion duly made, seconded and unanimously carried, did adopt the Schedule of Assessments as proposed, subject to amendment after inspection of the subject drain as it relates to the lands of any owners which may have been erroneously included or omitted from the Schedule of Assessments.

The Board further finds that it has jurisdiction of these proceedings and that all required notices have been duly given or published as required by law.

Wherefore, it is ORDERED, that the proposed Reconstruction of the *Fred Hines Drain, Slater Ridge Section 1 Arm* be and is hereby declared established.

Thereafter, the Board made inspection for the purpose of determining whether or not the lands of any owners had been erroneously included or excluded from the Schedule of Assessments. The Board finds on the basis of the reports and findings at this hearing as follows:

HAMILTON COUNTY DRAINAGE BOARD

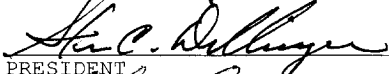  
PRESIDENT

  
Member

  
Member

ATTEST:

  
Executive Secretary



SURVEYOR'S OFFICE

# Hamilton County

Kenton C. Ward, CFM  
 Surveyor of Hamilton County  
 Phone (317) 776-8495  
 Fax (317) 776-9628

Suite 188  
 One Hamilton County Square  
 Noblesville, Indiana 46060-2230

**To: Hamilton County Drainage Board**

**September 29, 2008**

**Re: Fred Hines Drain: Slater Ridge Section 1**

Attached are as-builts, certificate of completion & compliance, and other information for Slater Ridge Section 1 Arm. An inspection of the drainage facilities for this section has been made and the facilities were found to be complete and acceptable.

During construction, changes were made to the drain, which will alter the plans submitted with my report for this drain-dated September 6, 2006. The report was approved by the Board at the hearing held November 27, 2006. (See Drainage Board Minutes Book 10, Pages 574-576) The changes are as follows:

Structure:	Length:	Size	Material:	Up Invert:	Dn Invert	Grade:	Changes:
255-515	134	27	RCP	824.5	823.7	0.96	1
515-254	117	27	RCP	823.7	822.11	0.9	-2
254-253	152	30	RCP	822.11	821.27	0.55	2
253-251	366	30	RCP	821.27	819.46	0.49	3
251-250	129	36	RCP	819.31	819.17	0.11	-9
516-506	276	27	RCP	823.18	820.02	1.14	
507-516	124	27	RCP	824.38	823.18	0.96	-6
506-505	377	36	RCP	820.02	818.91	0.29	-1
505-522	126	36	RCP	818.91	818.25	0.52	-7
502-184	20	36	RCP	829.14	828.76	1.83	-5
184-181	152	36	RCP	827.94	826.09	1.21	1
181-182	95	36	RCP	826.09	824.83	1.32	-6
182-176	54	54	RCP	824.83	824.54	0.54	
176-175	199	54	RCP	824.54	824.23	0.16	-8

**RCP Pipe Totals:**

27	651
36	899
54	253
<b>Total:</b>	<b>1803</b>

<b>Other Drain:</b>	
Open Ditch/Pond	1918
<b>Total:</b>	<b>1918</b>

The length of the drain due to the changes described above is now **3,721 feet**. It should be noted that Structures 503 and 521 were not installed. The proposed open ditch was enclosed with RCP.

The non-enforcement was approved by the Board at its meeting on November 27, 2006 and recorded under instrument #2006071265.

The following sureties were guaranteed by Bond Safeguard Insurance Company and released by the Board on its January 28, 2008 meeting.

**Bond-LC No:** 5013390


**Insured For:** Storm Sewers

**Amount:** \$268,476.67

**Issue Date:** October 11, 2004

I recommend the Board approve the drain's construction as complete and acceptable.

Sincerely,

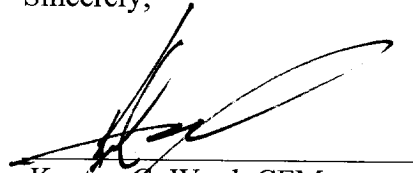

Kenton C. Ward, CFM  
Hamilton County Surveyor

KCW/slm

CERTIFICATE OF COMPLETION AND COMPLIANCE

To: Hamilton County Surveyor

Re: Slater Run, Section 1

I hereby certify that:

1. I am a Registered ~~Land Surveyor~~ or Engineer in the State of Indiana.
2. I am familiar with the plans and specifications for the above referenced subdivision.
3. I, or persons under my direct supervision, have personally observed the drainage facilities for the above referenced subdivision.
4. The drainage facilities within the above referenced subdivision to the best of my knowledge, information and belief have been installed and completed in general conformity with the plans and specifications prepared by The Schneider Corporation.
5. The drainage facilities within the above referenced subdivision to the best of my knowledge, information and belief have been correctly represented on the Record Drawings, Digital Record Drawings and the Structure Data Spreadsheet.

Signature: David K. Sexton Date: December 7, 2007

Type or Print Name: David K. Sexton

Business Address: The Schneider Corporation  
5250 E US Highway 36, Suite 250  
Avon, IN 46123

Telephone Number: 317-826-6424

SEAL

INDIANA REGISTRATION NUMBER

9500028





CERTIFICATE OF COMPLETION AND COMPLIANCE

To: Hamilton County Surveyor

Re: Slater Ridge, Section 1

I hereby certify that:

1. I am a Registered ~~Land Surveyor~~ or Engineer in the State of Indiana.
2. I am familiar with the plans and specifications for the above referenced subdivision.
3. I, or persons under my direct supervision, have personally observed the drainage facilities for the above referenced subdivision
4. The drainage facilities within the above referenced subdivision to the best of my knowledge, information and belief have been installed and completed in general conformity with the plans and specifications prepared by The Schneider Corporation.
5. The drainage facilities within the above referenced subdivision to the best of my knowledge, information and belief have been correctly represented on the Record Drawings, Digital Record Drawings and the Structure Data Spreadsheet.

Signature:  Date: December 7, 2007

Type or Print Name: David K. Sexton


Business Address: The Schneider Corporation  
5250 E US Highway 36, Suite 250  
Avon, IN 46123

Telephone Number: 317-826-6424


SEAL

INDIANA REGISTRATION NUMBER

9500028

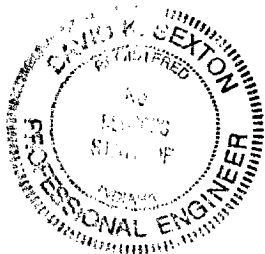




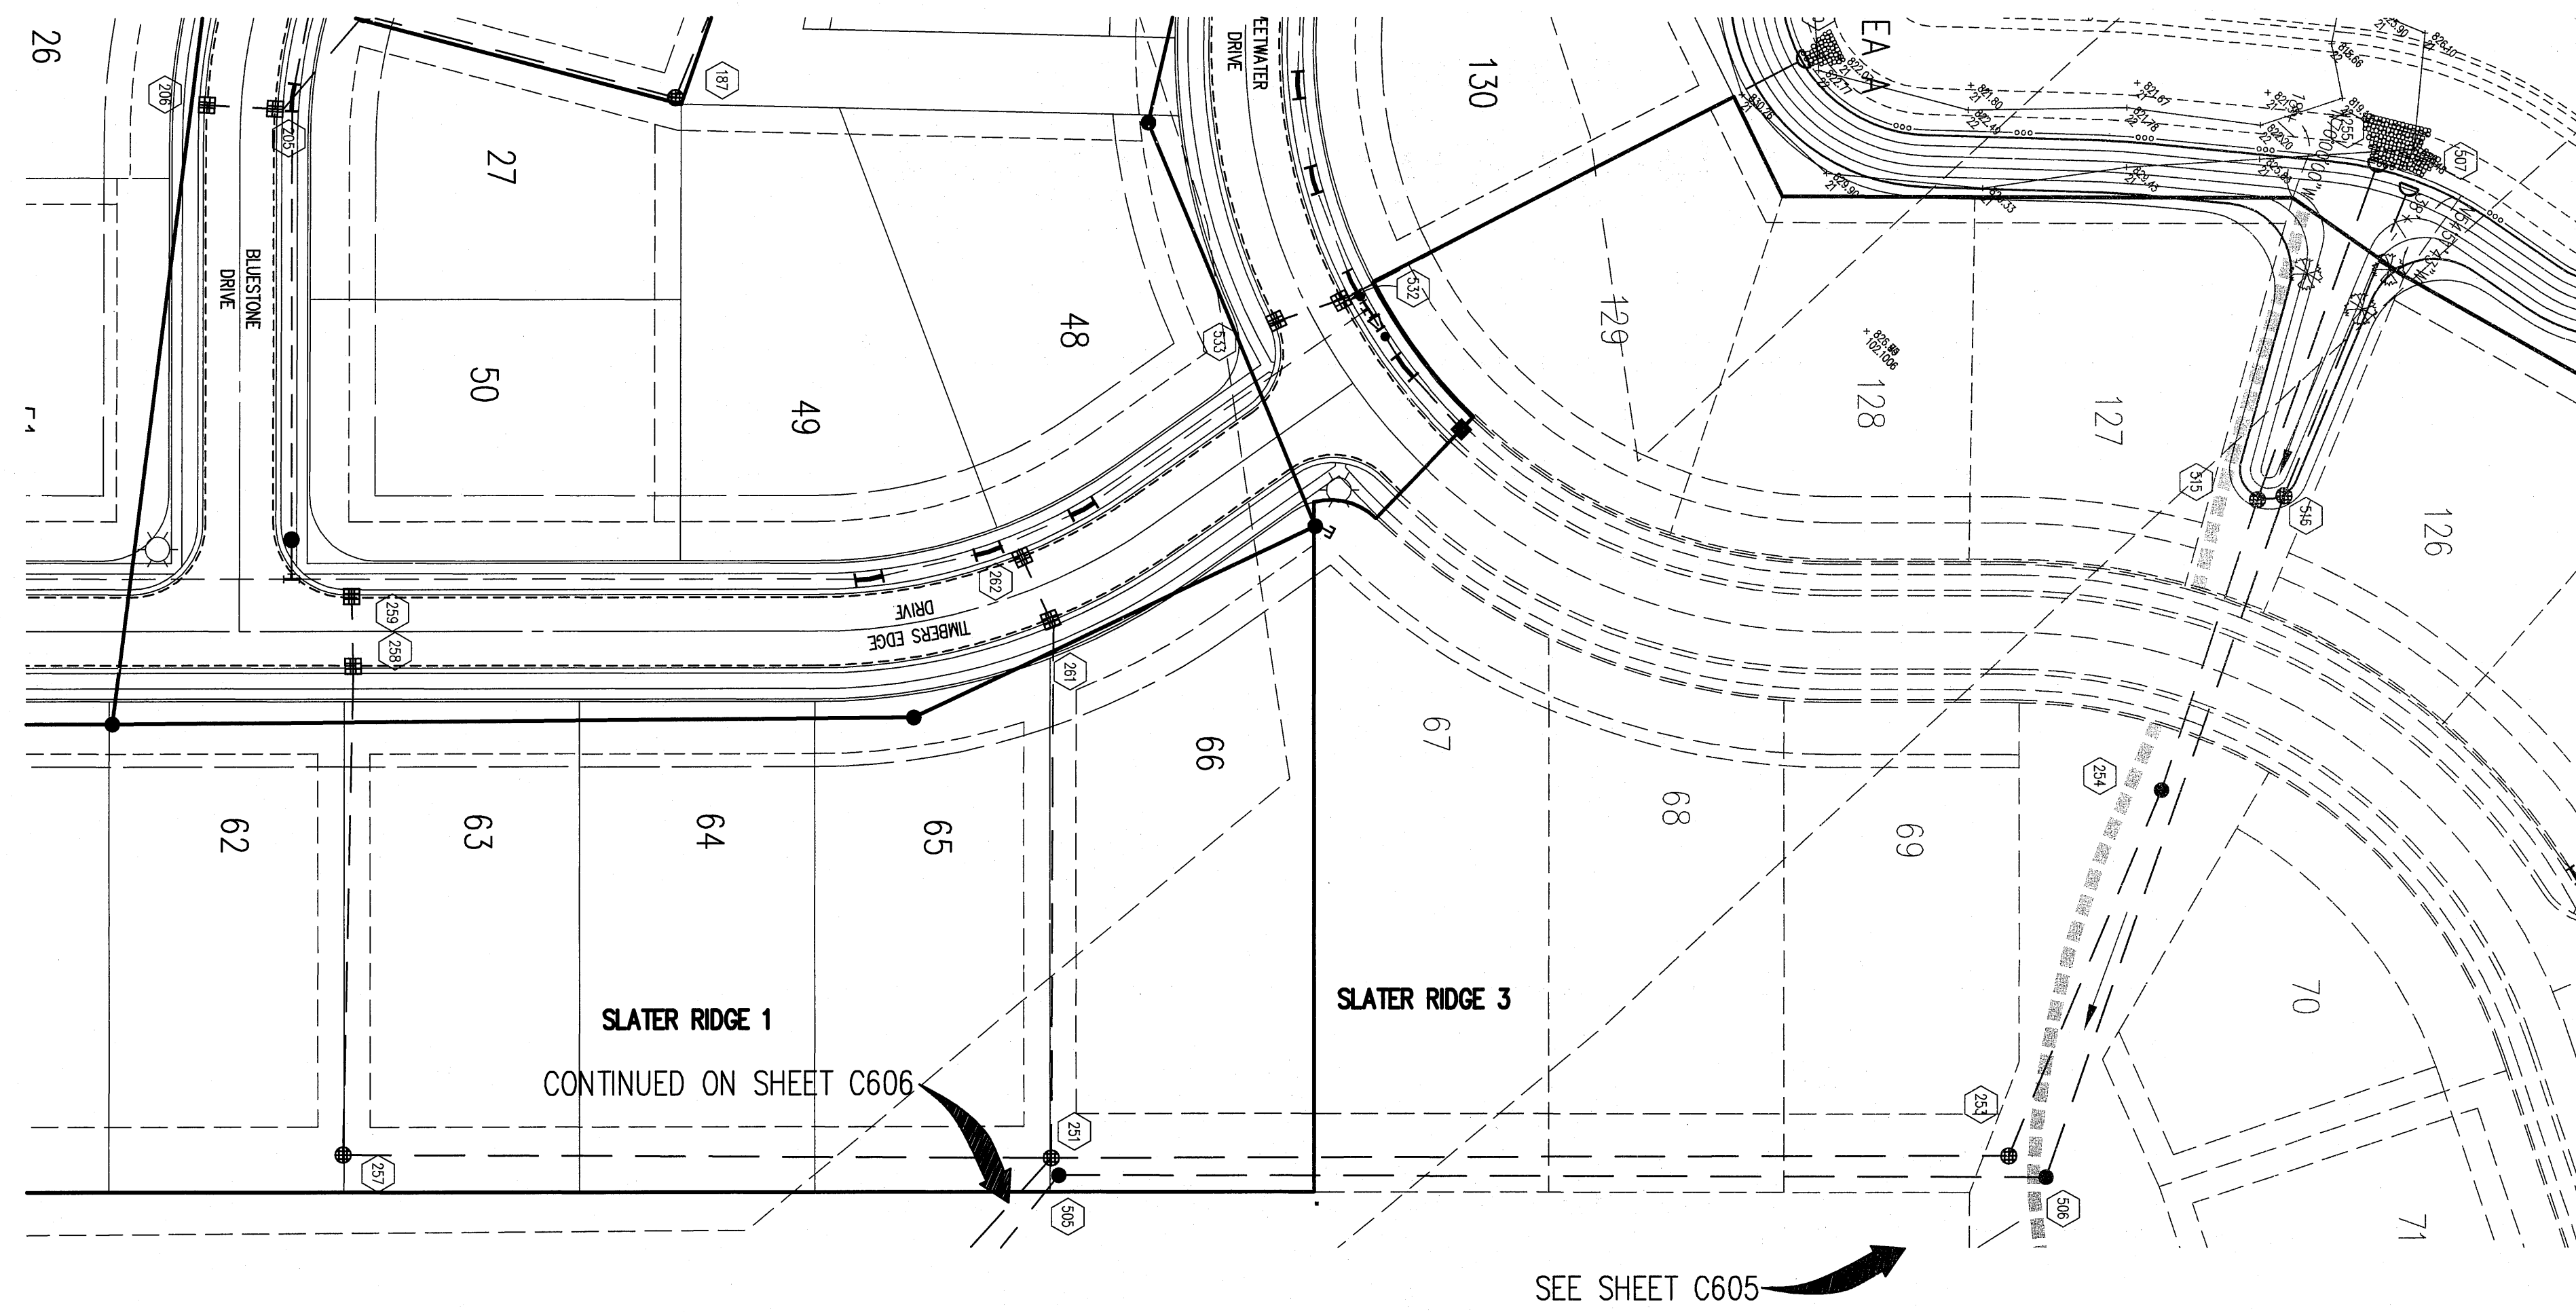

HOLEY MOLEY SAYS  
"DON'T DIG BLIND"  
"IT'S THE LAW"  
CALL 2 WORKING DAYS BEFORE YOU DIG  
1-800-382-5544  
CALL TOLL FREE  
PER INDIANA STATE LAW IS-89-1891,  
IT IS AGAINST THE LAW TO EXCAVATE  
WITHOUT NOTIFYING THE UNDERGROUND  
LOCATION SERVICE TWO (2) WORKING  
DAYS BEFORE COMMENCING WORK.

**GENERAL NOTES**


1. TEMPORARY TRAFFIC CONTROL DURING CONSTRUCTION TO CONFORM TO APPLICABLE LOCAL AND STATE STANDARDS.
2. ALL CONSTRUCTION ACTIVITY ON THIS SITE TO BE PERFORMED IN COMPLIANCE WITH APPLICABLE O.S.H.A. STANDARDS FOR WORKER SAFETY.
3. IT SHALL BE THE CONTRACTORS RESPONSIBILITY TO FIELD VERIFY ALL UTILITY LOCATIONS BEFORE CONSTRUCTION BEGINS.
4. CONTRACTORS SHALL MINIMIZE DAMAGE TO EXISTING TREES.

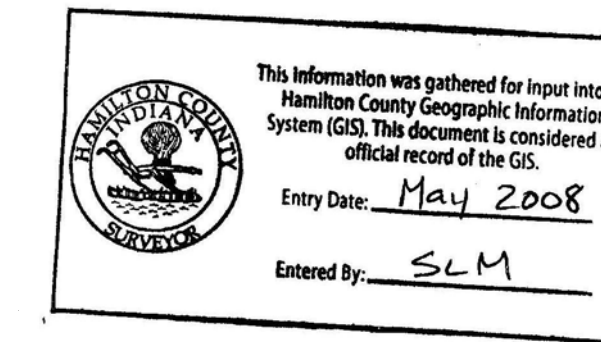

Sheet Number	Description
4	11 Bedding Detail - Reinforced Concrete Pipe (RCP)
3	11 Roll Curb Inlet Detail
5	11 Beehive Inlet Detail
5	11 Storm Manhole Detail
CB01	1 Precast Concrete End Section
C109	1 RipRap Detail @ End Section

**STORM SEWER PLAN**

SCALE: 1"=50'

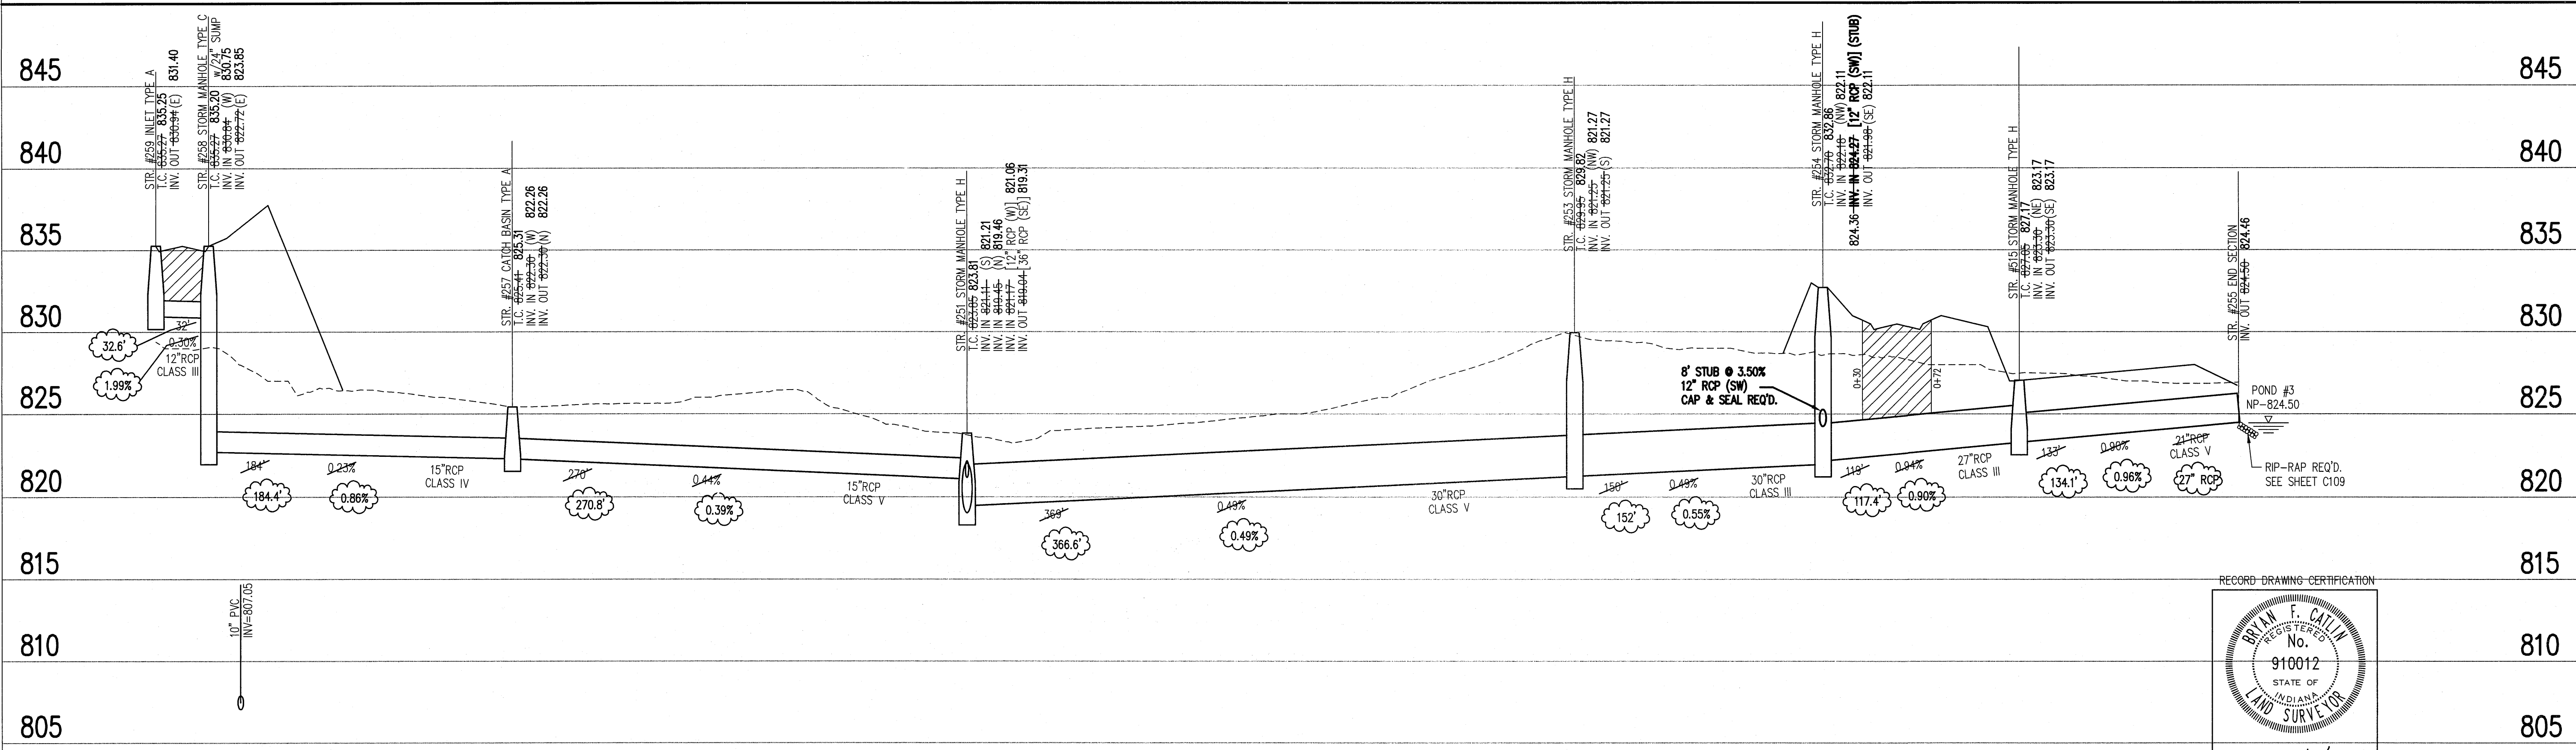

**STORM SEWER RECORD DRAWING**

**STORM SEWER PROFILE**

NOTE:  
Record drawing certification only for top of casting, invert elevations and lengths of pipe. Slope percentage represents a calculated figure and is for general information only.

**CERTIFICATION FOR "RECORD DRAWING"**

LEGEND		
	Existing Grade	
	New Grade	
	Granular Backfill	

SCALE: HORZ.: 1"=50'  
VERT.: 1"=5'

REVISIONS:  
1. DAT - 07/07/04 - FAC REVISIONS  
2. CJK - 07/16/04 - CITY OF NOBLESVILLE COMMENTS  
3. RAT - 07/20/05 - REVISE PER HAMILTON CO. SURVEYOR AND METLAND CORPORATION FOR GRADING FOR SHEETMETER DATE AND LOGS ALONG SHEETMETER  
4. CJK - 07/24/05 - REVISE STORM PROFILES  
5. CJK - 07/24/05 - REVISE STORM PROFILES  
6. CJK - 07/15/05 - STORM SEWER RECORD DRAWINGS

THIS DRAWING AND THE IDEAS, DESIGNS AND CONCEPTS CONTAINED HEREIN ARE THE EXCLUSIVE INTELLECTUAL PROPERTY OF THE SCHNEIDER CORPORATION AND ARE NOT TO BE USED OR REPRODUCED, IN WHOLE OR IN PART, WITHOUT THE WRITTEN CONSENT OF THE SCHNEIDER CORPORATION.  
© COPYRIGHTED BY THE SCHNEIDER CORP. (2001)



**Schneider**

THE SCHNEIDER CORPORATION  
Historic Fort Harrison  
8901 Otis Avenue  
Indianapolis, IN 46216-1037  
Telephone: 317.826.7100  
Fax: 317.826.7300  
www.schneidercorp.com

Architecture  
Civil Engineering  
Environmental Engineering  
Geotechnical Services  
GIS \* LIS  
Home Builder Services  
Interior Design  
Land Surveying  
Landscape Architecture  
Transportation Engineering

**SLATER RIDGE SECTION 1**  
HAMILTON COUNTY, NOBLESVILLE, INDIANA  
**PRECEDENT RESIDENTIAL DEVELOPMENT, LLC**  
9339 PRIORITY WAY WEST DR., (Suite 100), INDIANAPOLIS, INDIANA 46250

DATE: 06/22/05	PROJECT NO.: 4736.001
DRAWN BY: RAT	CHECKED BY: TPQ
SHEET TITLE: STORM SEWER PLAN AND PROFILE	
DRAWING FILES: R:\44\4736\201\dwgs\C601-06.dwg XREF: R:\44\4736\201\dwgs\lba-Ridge.dwg XREF: R:\44\4736\201\dwgs\lba-Run.dwg XREF: R:\44\4736\201\dwgs\lba-Woods.dwg XREF: R:\44\4736\201\dwgs\lba-Future.dwg XREF: R:\44\4736\201\dwgs\STORM.dwg XREF: R:\44\4736\201\dwgs\4736001S.dwg	
SHEET NO.: C604	

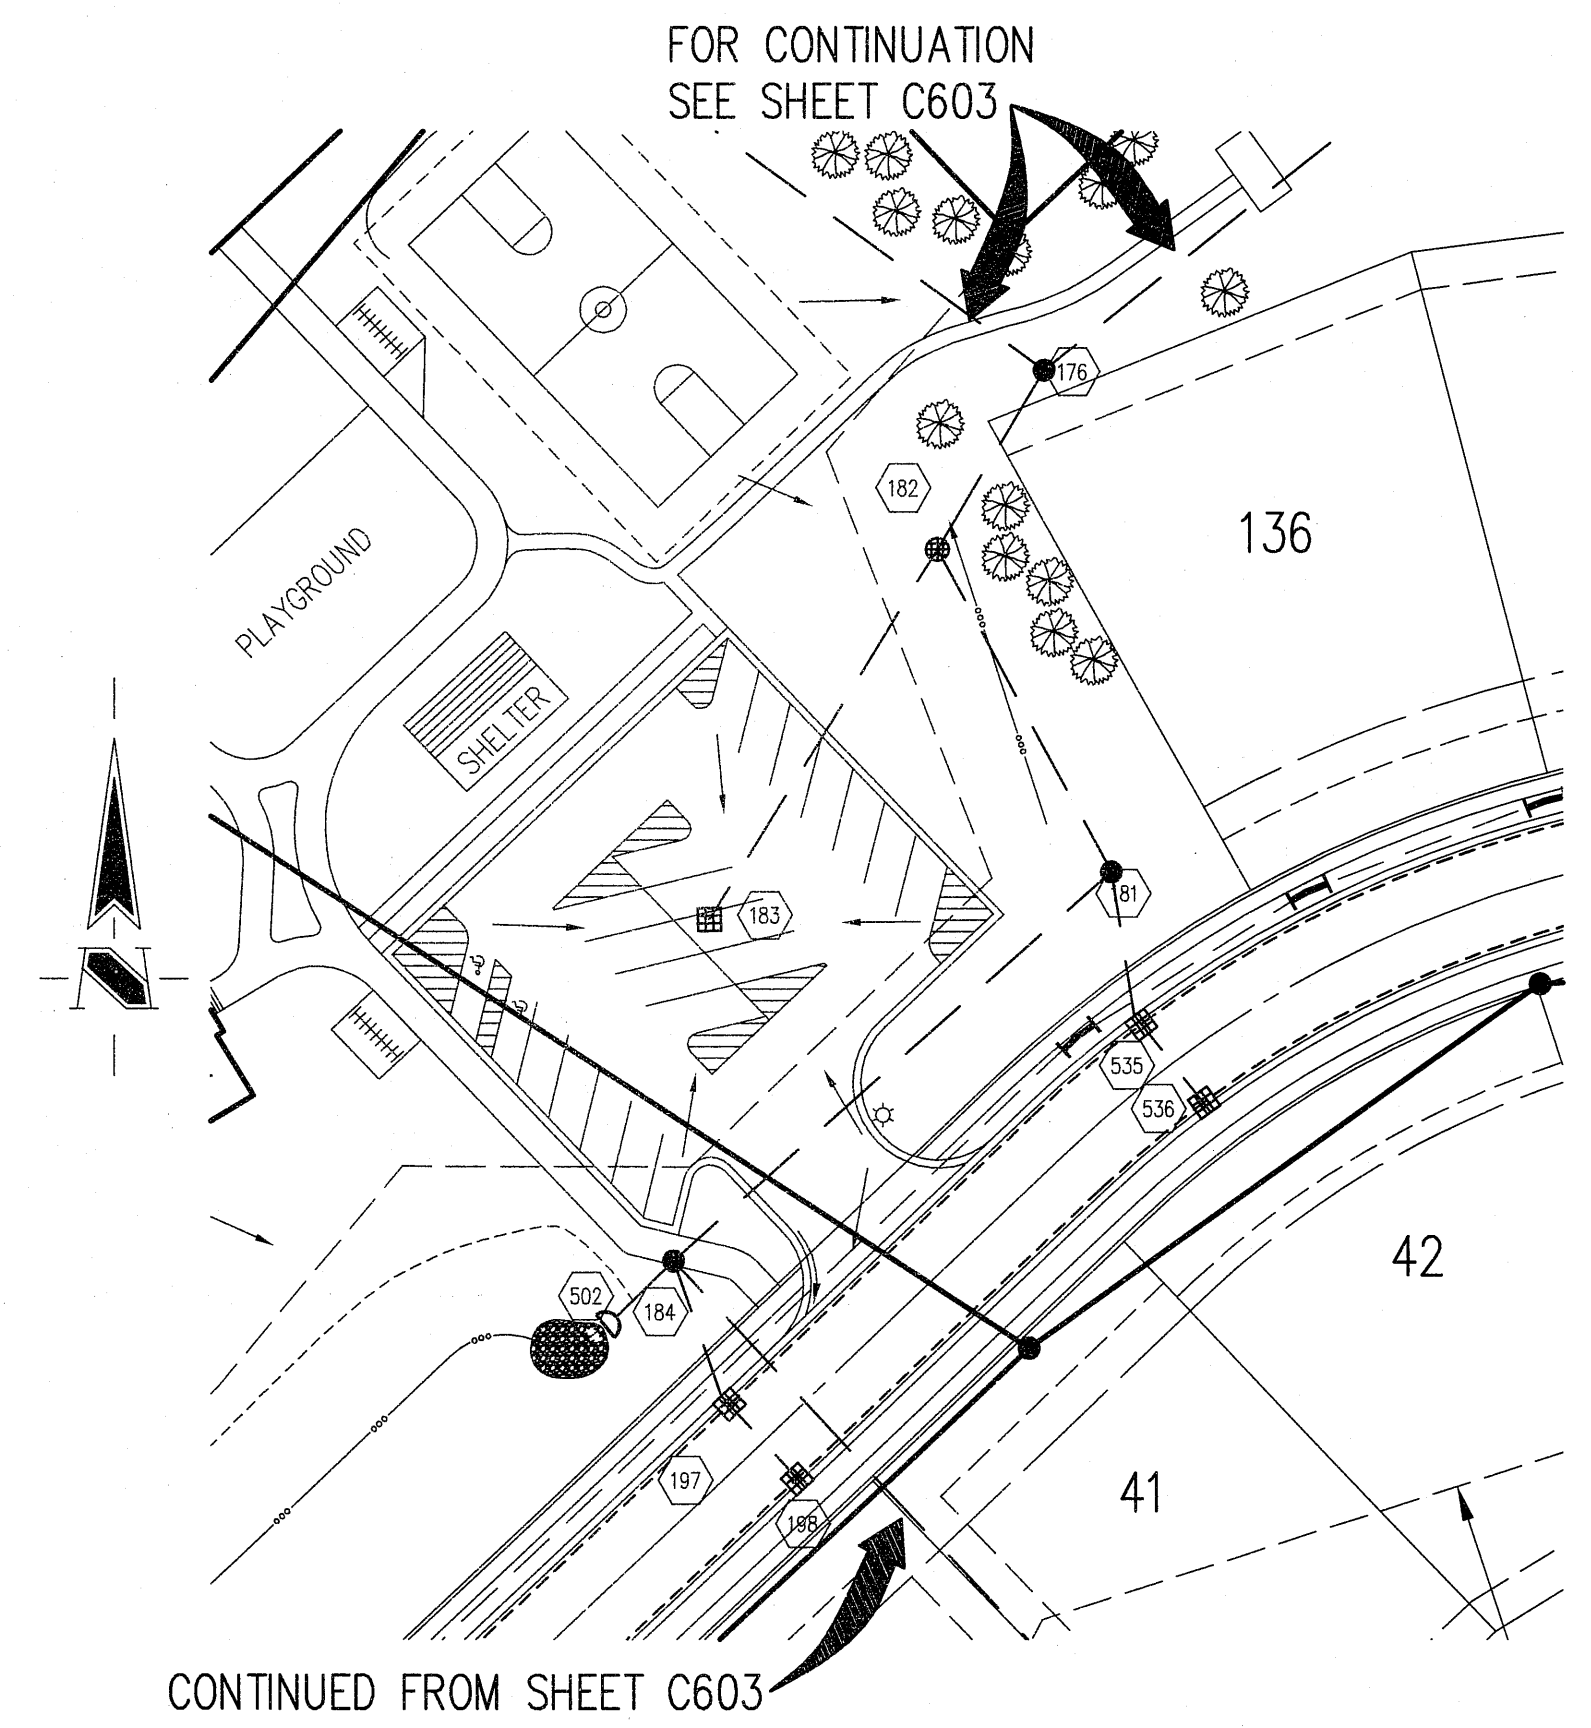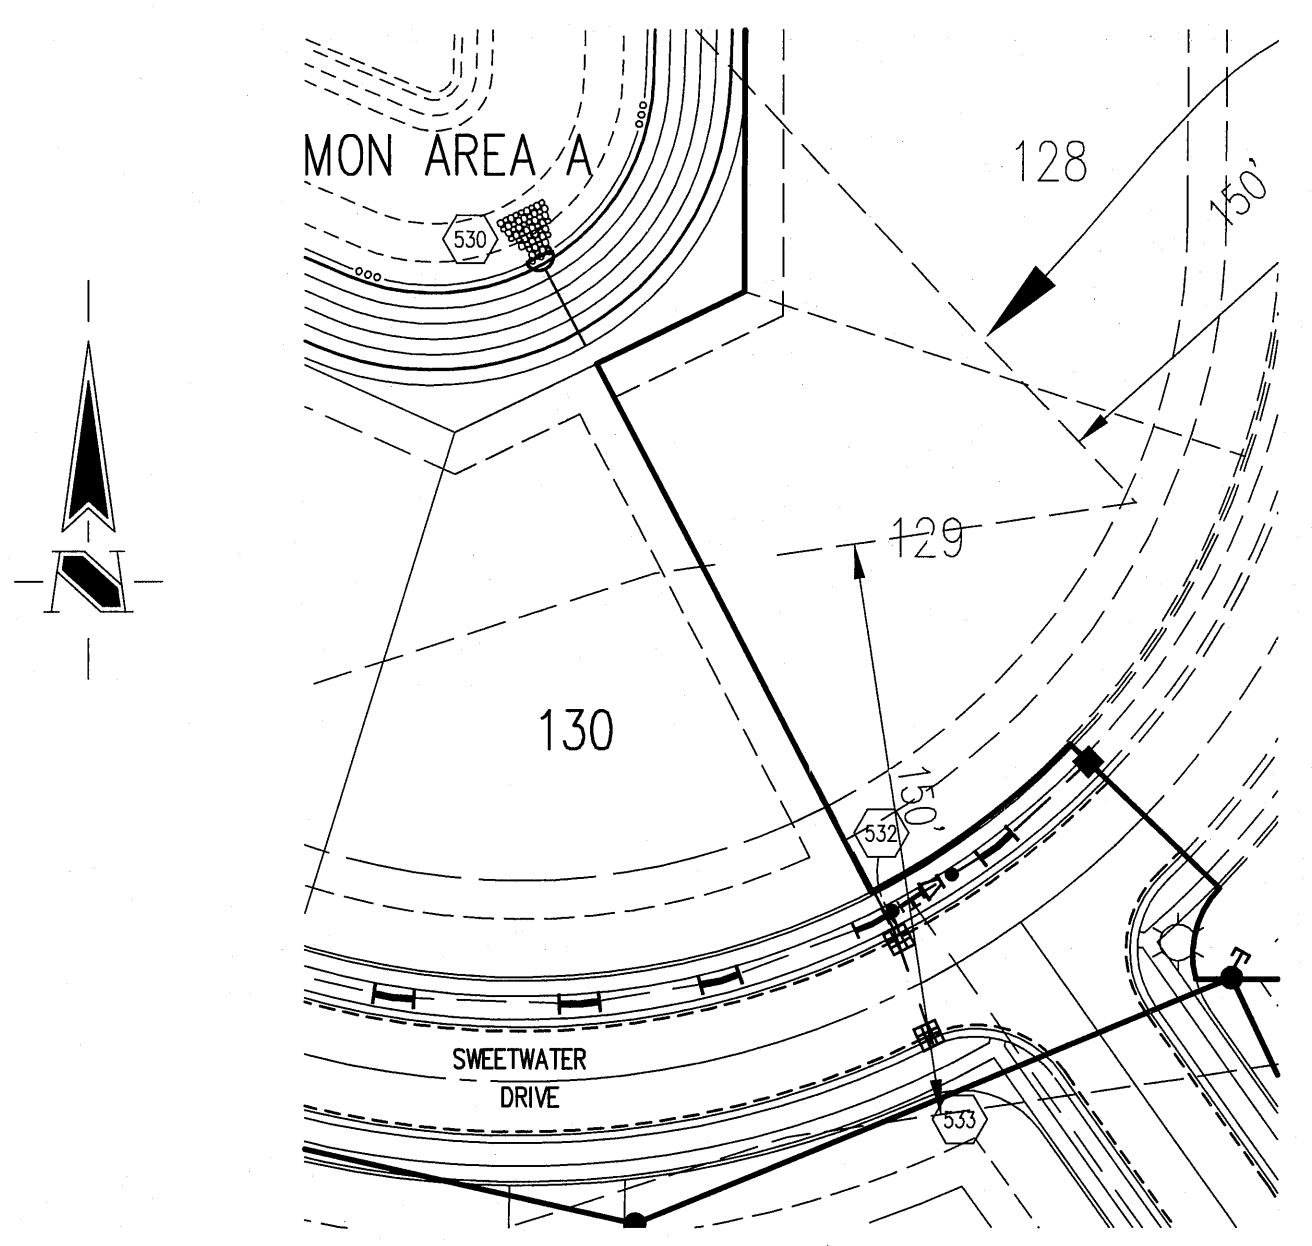

**GENERAL NOTES**

- TEMPORARY TRAFFIC CONTROL DURING CONSTRUCTION TO CONFORM TO APPLICABLE LOCAL AND STATE STANDARDS.
- ALL CONSTRUCTION ACTIVITY ON THIS SITE TO BE PERFORMED IN COMPLIANCE WITH APPLICABLE O.S.H.A. STANDARDS FOR WORKER SAFETY.
- IT SHALL BE THE CONTRACTORS RESPONSIBILITY TO FIELD VERIFY ALL UTILITY LOCATIONS BEFORE CONSTRUCTION BEGINS.
- CONTRACTORS SHALL MINIMIZE DAMAGE TO EXISTING TREES.

Sheet Number	Description
11	Bedding Detail - Reinforced Concrete Pipe (RCP)
11	Roll Curb Inlet Detail
11	Beehive Inlet Detail
11	Storm Manhole Detail
1	Precast Concrete End Section
1	Rip/Rap Detail @ End Section

HOLEY MOLEY SAYS  
"DON'T DIG BLIND"



"IT'S THE LAW"  
CALL 2 WORKING DAYS BEFORE YOU DIG  
1-800-382-5544  
CALL TOLL FREE  
PER INDIANA STATE LAW IS-68-1991  
IT IS AGAINST THE LAW TO EXCAVATE WITHOUT NOTIFYING THE UNDERGROUND LOCATION SERVICE TWO (2) WORKING DAYS BEFORE COMMENCING WORK.

This information was gathered for input into the Hamilton County Geographic Information System (GIS). This document is considered an official record of the GIS.  
Entry Date: May 2008  
Entered By: SLM

REVISIONS:

- DATE: 07/07/04 - TAC REVISIONS - COMMENTS
- DATE: 07/20/05 - REVISED PER HAMILTON COUNTY SURVEYOR AND METAL AND LAND
- DATE: 07/24/05 - REVISED GRADING FOR SWEETWATER DRIVE AND LOTS
- DATE: 07/24/05 - REVISED GRADING FOR SWEETWATER DRIVE AND LOTS
- DATE: 07/28/05 - REVISED PER HAMILTON COUNTY SURVEYOR AND METAL AND LAND
- DATE: 07/28/05 - REVISED PER HAMILTON COUNTY SURVEYOR AND METAL AND LAND
- DATE: 07/28/05 - REVISED PER HAMILTON COUNTY SURVEYOR AND METAL AND LAND
- DATE: 07/28/05 - REVISED PER HAMILTON COUNTY SURVEYOR AND METAL AND LAND


THIS DRAWING AND THE IDEAS, DESIGNS AND CONCEPTS CONTAINED HEREIN ARE THE EXCLUSIVE INTELLECTUAL PROPERTY OF THE SCHNEIDER CORPORATION, AND ARE NOT TO BE USED OR REPRODUCED, IN WHOLE OR IN PART, WITHOUT THE WRITTEN CONSENT OF THE SCHNEIDER CORPORATION.  
© COPYRIGHTED BY THE SCHNEIDER CORP. (2001)

**Schneider**  
THE SCHNEIDER CORPORATION  
Historic Fort Harrison  
8901 Otis Avenue  
Indianapolis, IN 46216-1037  
Telephone: 317.826.7100  
Fax: 317.826.7300  
www.schneidercorp.com

Architecture  
Civil Engineering  
Environmental Engineering  
Geotechnical Services  
GIS \* LIS  
Home Builder Services  
Interior Design  
Land Surveying  
Landscape Architecture  
Transportation Engineering

STORM SEWER PLAN

SCALE: 1"=50'

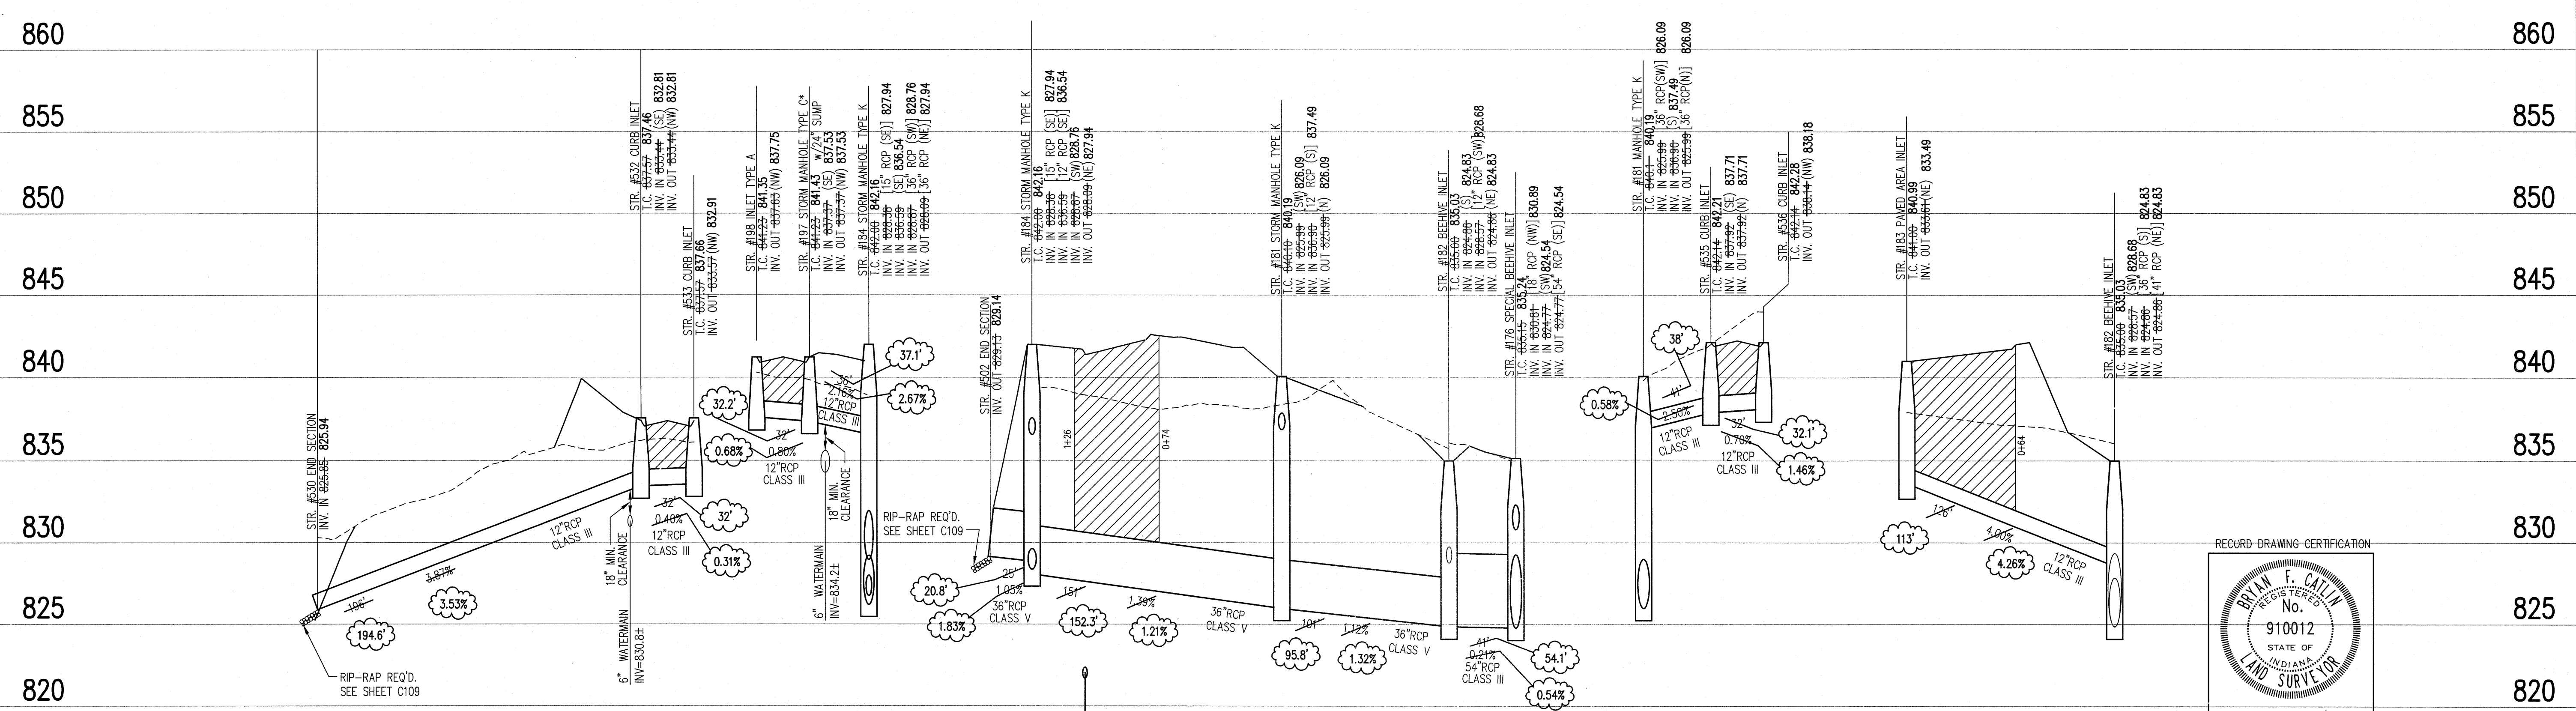

**STORM SEWER RECORD DRAWING**

STORM SEWER PROFILE

NOTE:  
Record drawing certification only for top of casing, invert elevations and lengths of pipe. Slope percentage represents a calculated figure and is for general information only.

RECORD-DRAWING CERTIFICATION  
BRYAN F. CATTEN  
No. 910012  
STATE OF INDIANA  
LAND SURVEYOR  
DATE: 9/16/08  
Certified By: *Bryan F. Catten*

CERTIFICATION FOR "RECORD DRAWING"



**LEGEND**

	Existing Grade
	New Grade
	Granular Backfill

SCALE: HORZ.: 1"=50'  
VERT.: 1"=5'

SLATER RIDGE  
SECTION 1  
HAMILTON COUNTY, NOBLESVILLE, INDIANA  
PRECEDENT RESIDENTIAL DEVELOPMENT, LLC  
9539 PRIORITY WAY WEST DR., (SUITE 100), INDIANAPOLIS, INDIANA 46250

DATE: 06/22/05	PROJECT NO.: 4736.001
DRAWN BY: RAT	CHECKED BY: TPG
SHEET TITLE: STORM SEWER PLAN AND PROFILE	
DRAWING FILES: R:\44\4736\201\dwg\5001-06.dwg XREF: R:\44\4736\201\dwg\1100-Ridge.dwg XREF: R:\44\4736\201\dwg\1100-Ridge.dwg XREF: R:\44\4736\101\dwg\1100-Woods.dwg XREF: R:\44\4736\101\dwg\1100-Future.dwg XREF: R:\44\4736\101\dwg\1100-STORM.dwg XREF: R:\44\4736\101\dwg\1100-015.dwg	
SHEET NO.: C605	

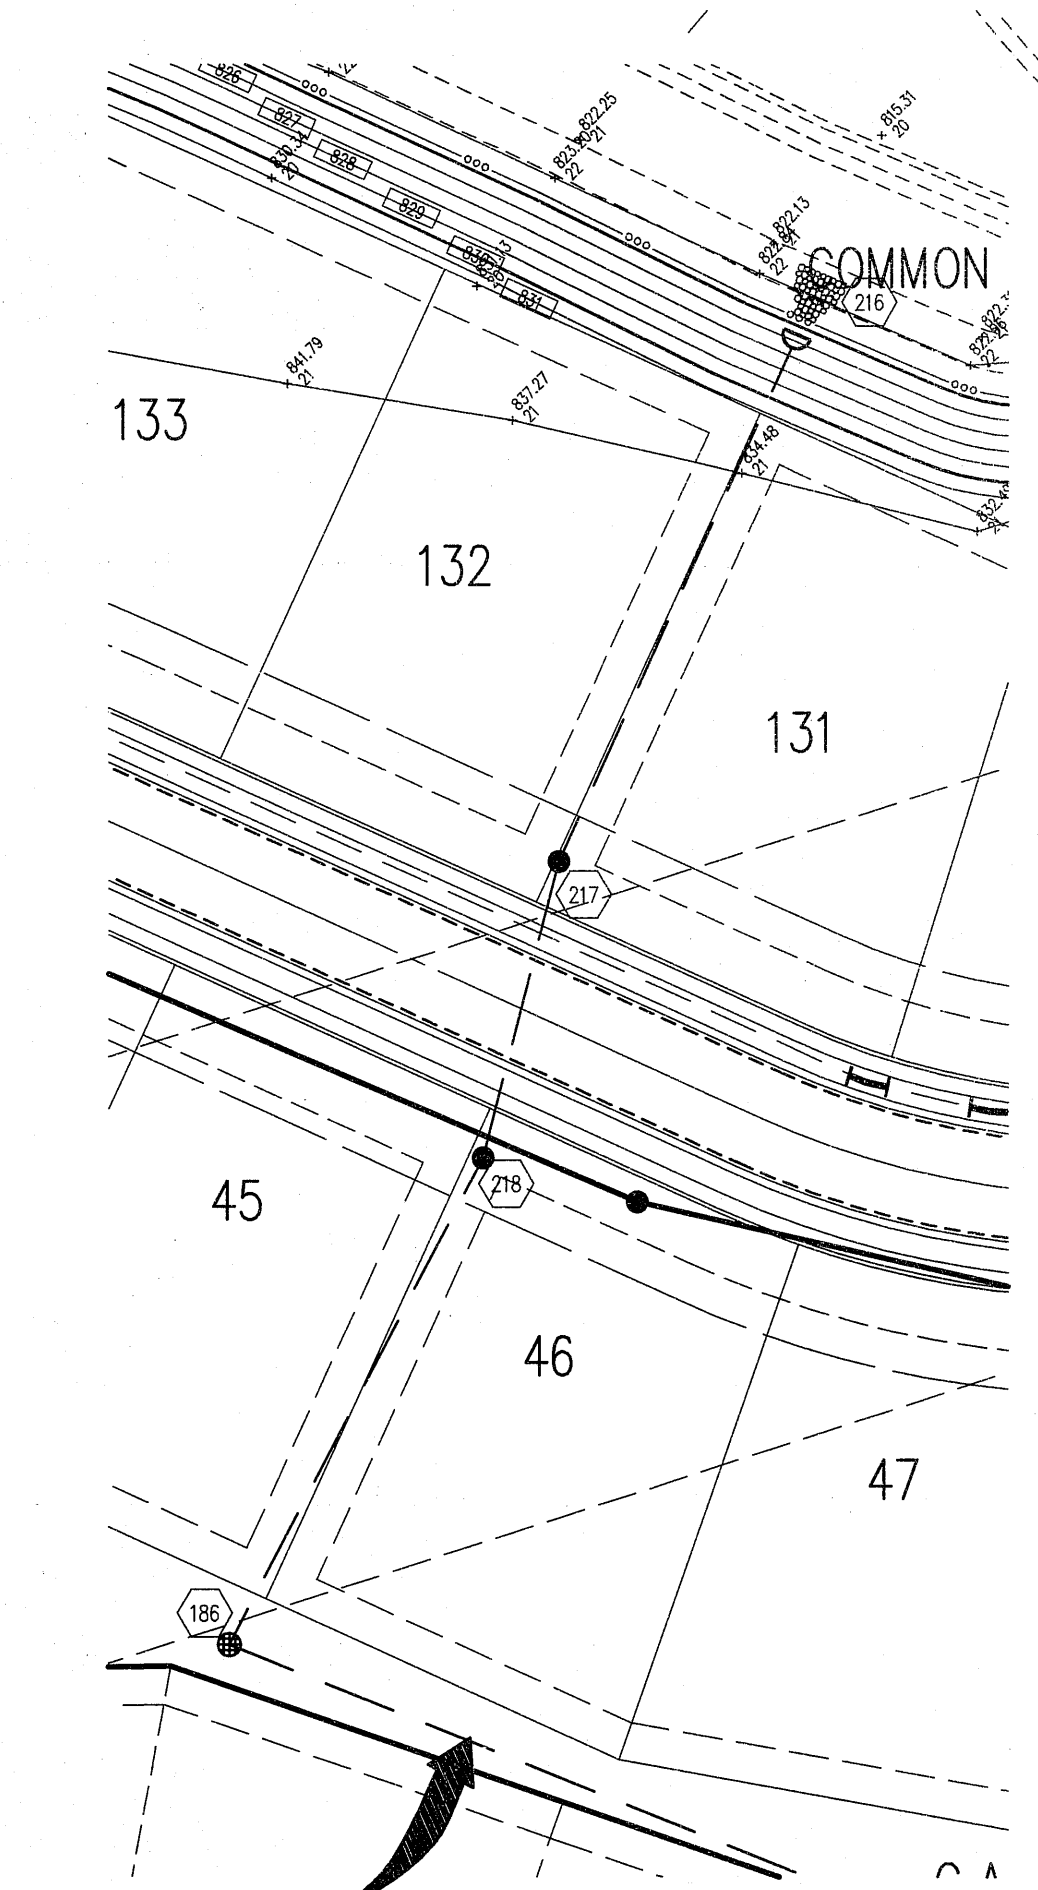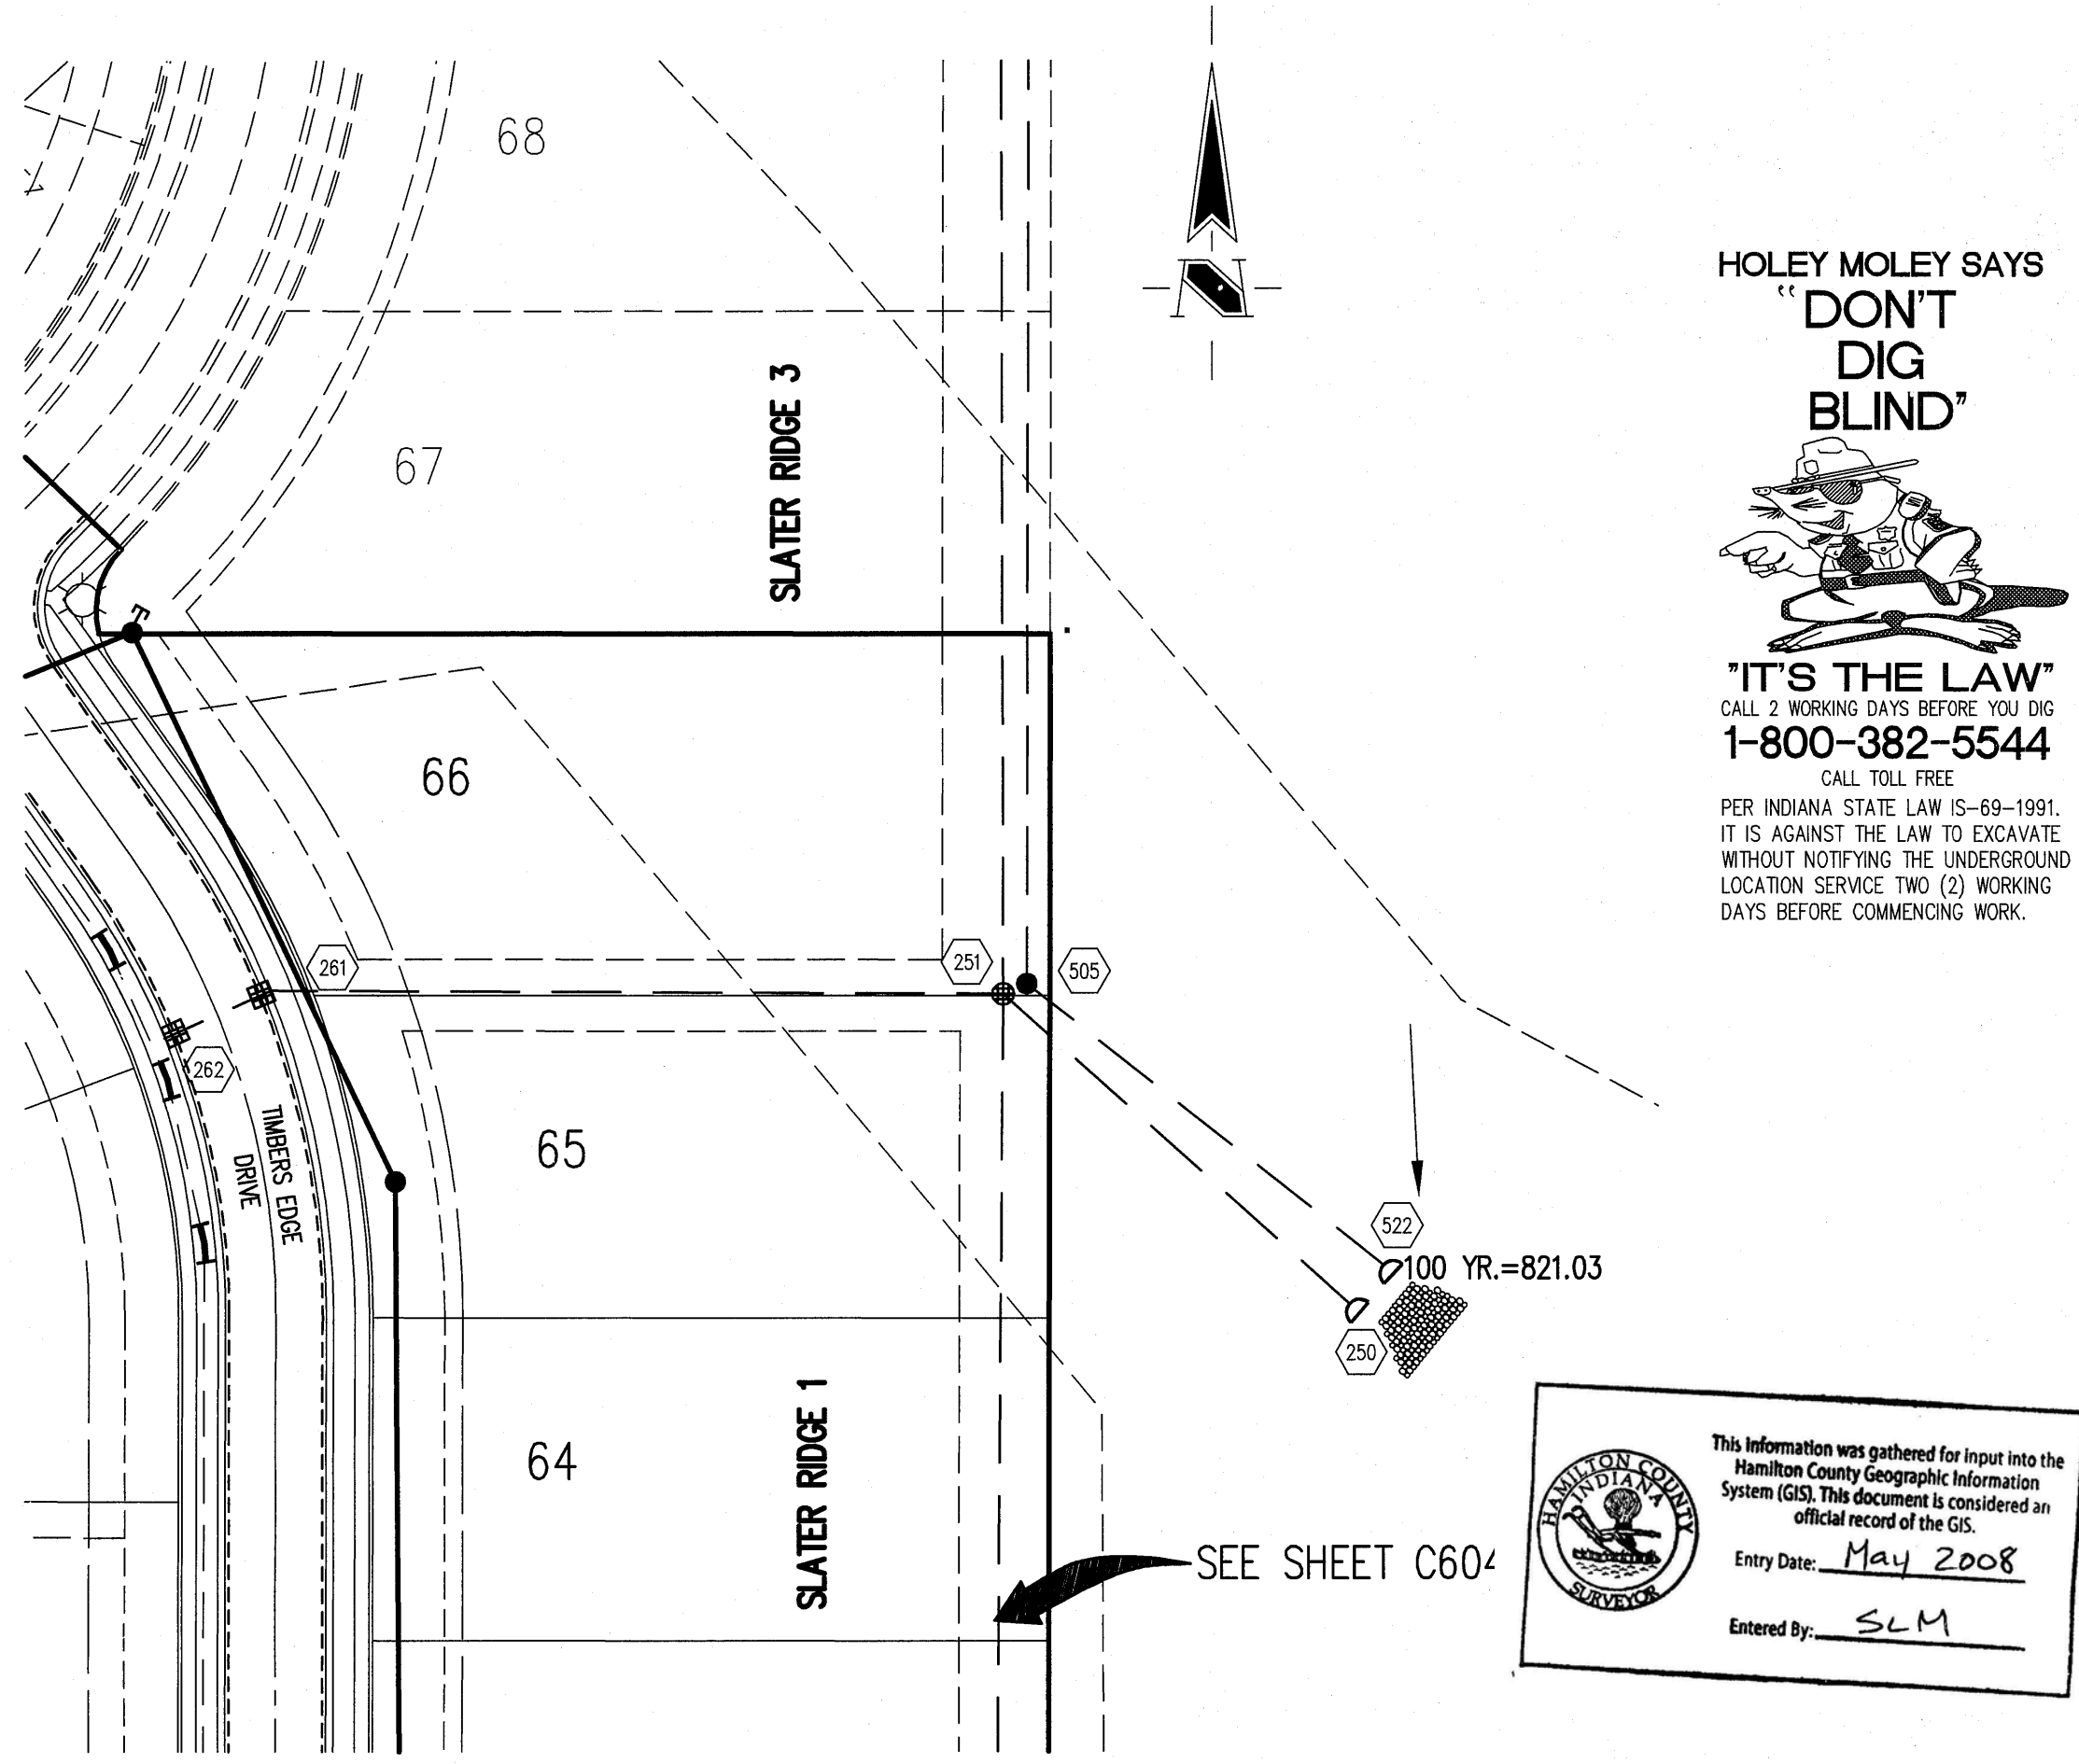

**GENERAL NOTES**

1. TEMPORARY TRAFFIC CONTROL DURING CONSTRUCTION TO CONFORM TO APPLICABLE LOCAL AND STATE STANDARDS.
2. ALL CONSTRUCTION ACTIVITY ON THIS SITE TO BE PERFORMED IN COMPLIANCE WITH APPLICABLE O.S.H.A. STANDARDS FOR WORKER SAFETY.
3. IT SHALL BE THE CONTRACTORS RESPONSIBILITY TO FIELD VERIFY ALL UTILITY LOCATIONS BEFORE CONSTRUCTION BEGINS.
4. CONTRACTORS SHALL MINIMIZE DAMAGE TO EXISTING TREES.

City of Noblesville Details & Specifications

Sheet Number	or	Description
4	11	Bedding Detail - Reinforced Concrete Pipe (RCP)
3	11	Roll Curb Inlet Detail
5	11	Beehive Inlet Detail
5	11	Storm Manhole Detail


NOTE:  
 Record drawing certification only for top of casting, invert elevations and lengths of pipe. Slope percentage represents a calculated figure and is for general information only.

RECORD DRAWING CERTIFICATION

**BRYAN F. CALLIN**  
 REGISTERED  
 No. 910012  
 STATE OF INDIANA  
 LAND SURVEYOR

DATE: 9/16/05  
 CERTIFIED BY: *Bryan F. Callin*

**CERTIFICATION FOR "RECORD DRAWING"**

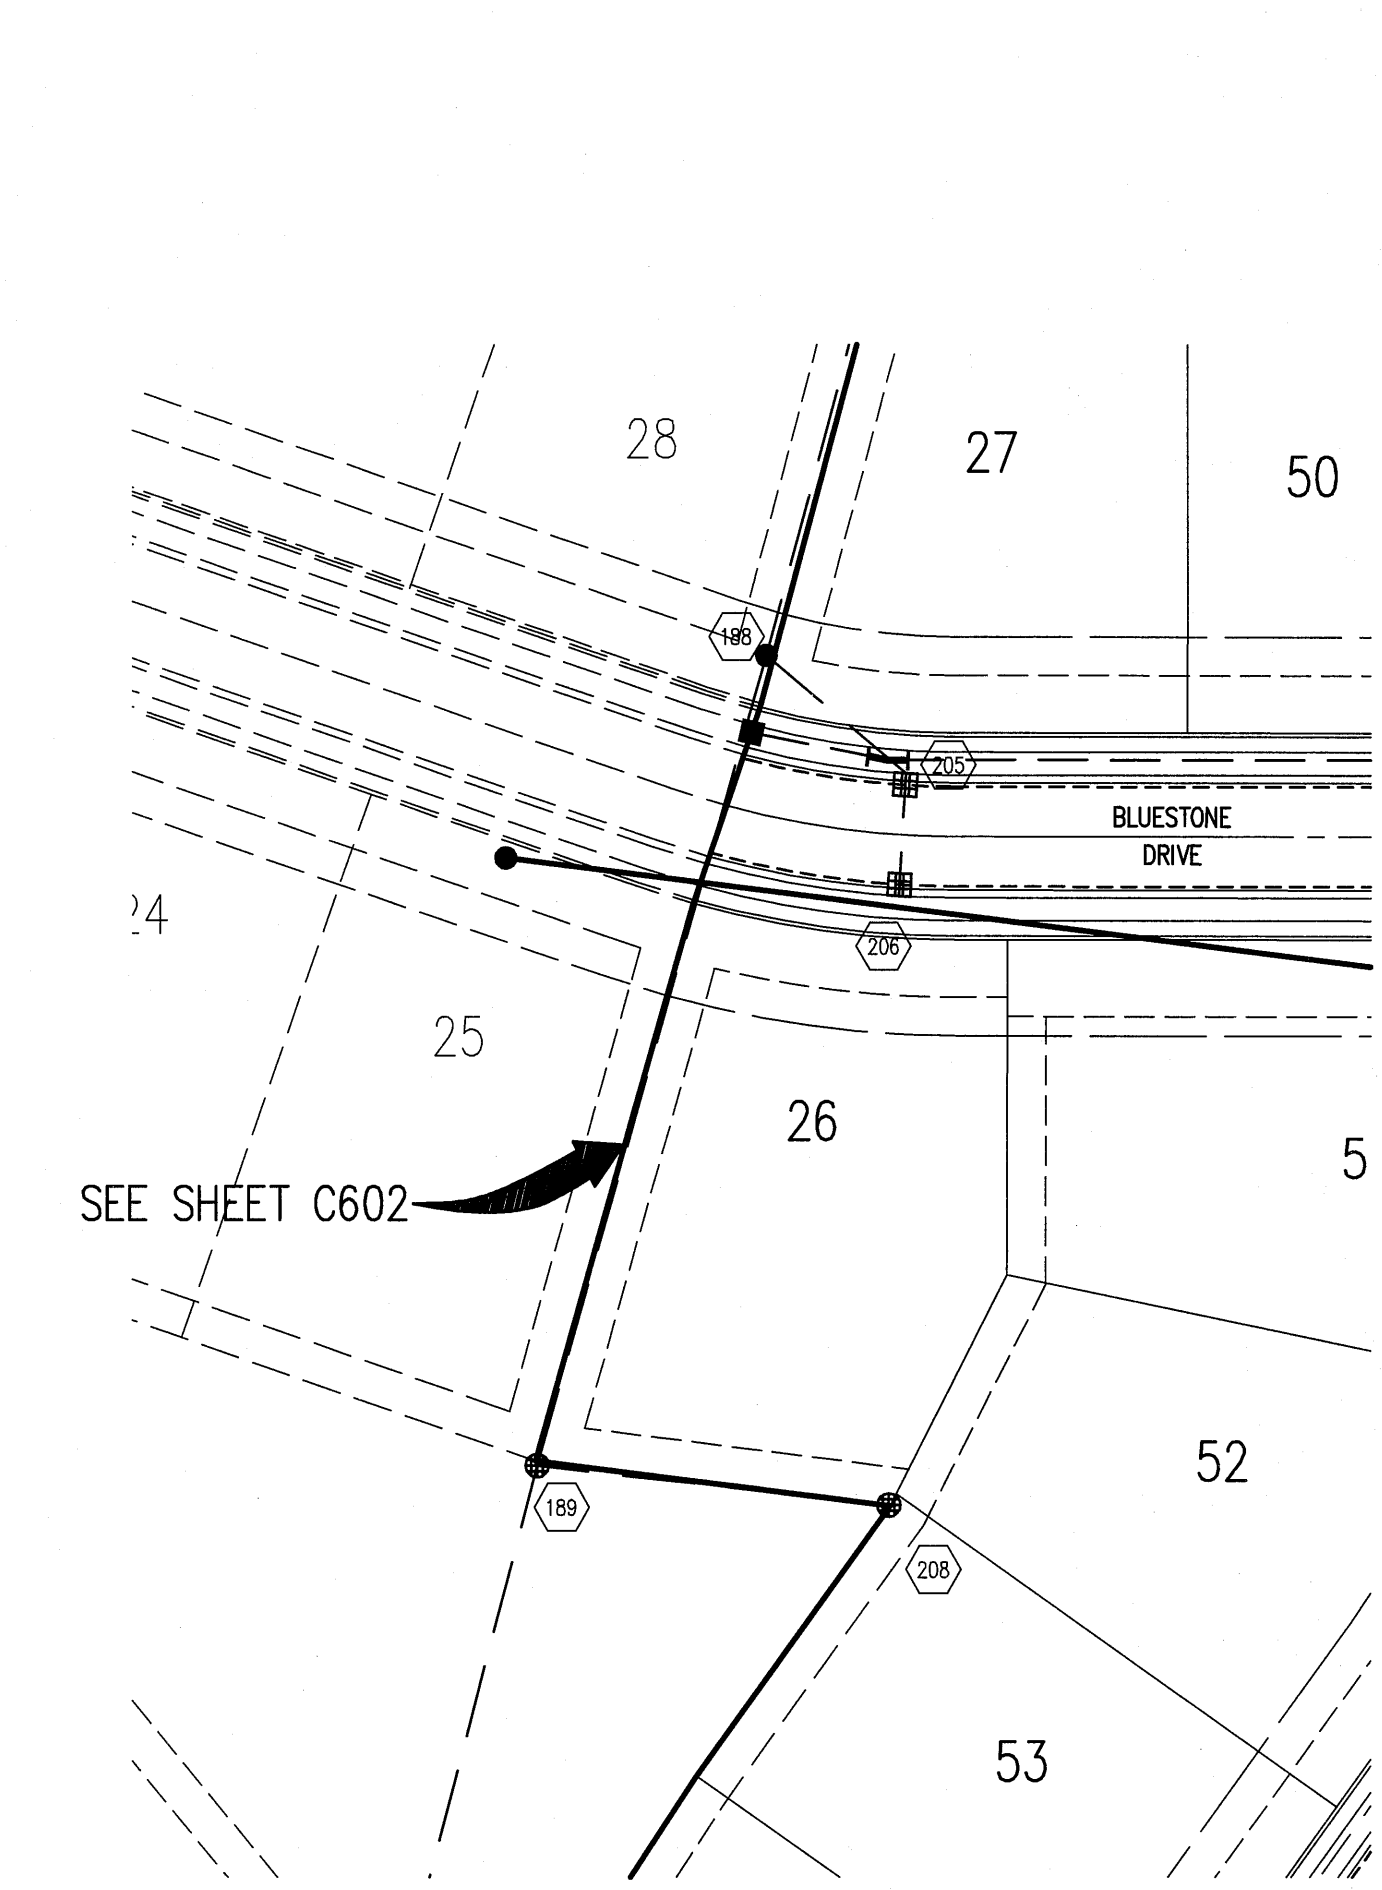

REVISIONS:

1. OK - 07/04/05 - TAC REVISIONS
2. OK - 07/16/05 - REVISE PER HAMILTON CO. SURVEYOR AND METAL
3. OK - 07/20/05 - REVISE PER HAMILTON CO. SURVEYOR AND METAL
4. OK - 07/29/05 - ALONG SHERWOOD DRIVE
5. OK - 08/02/05 - REVISE STORM PROFILES
6. OK - 08/17/05 - REVISE STUB SIZE OUT OF STR. #189 (24" TO 18")
7. OK - 09/16/05 - STORM SEWER RECORD DRAWINGS

THIS DRAWING AND THE IDEAS, DESIGNS AND CONCEPTS CONTAINED HEREIN ARE THE EXCLUSIVE INTELLECTUAL PROPERTY OF THE SCHNEIDER CORPORATION AND ARE NOT TO BE USED OR REPRODUCED, IN WHOLE OR IN PART, WITHOUT THE WRITTEN CONSENT OF THE SCHNEIDER CORPORATION.

© COPYRIGHTED BY THE SCHNEIDER CORP. (2001)

This information was gathered for input into the Hamilton County Geographic Information System (GIS). This document is considered an official record of the GIS.



Entry Date: May 2008

Entered By: SLM

CONTINUED FROM SHEET C602

**STORM SEWER PLAN**

SCALE: 1"=50'

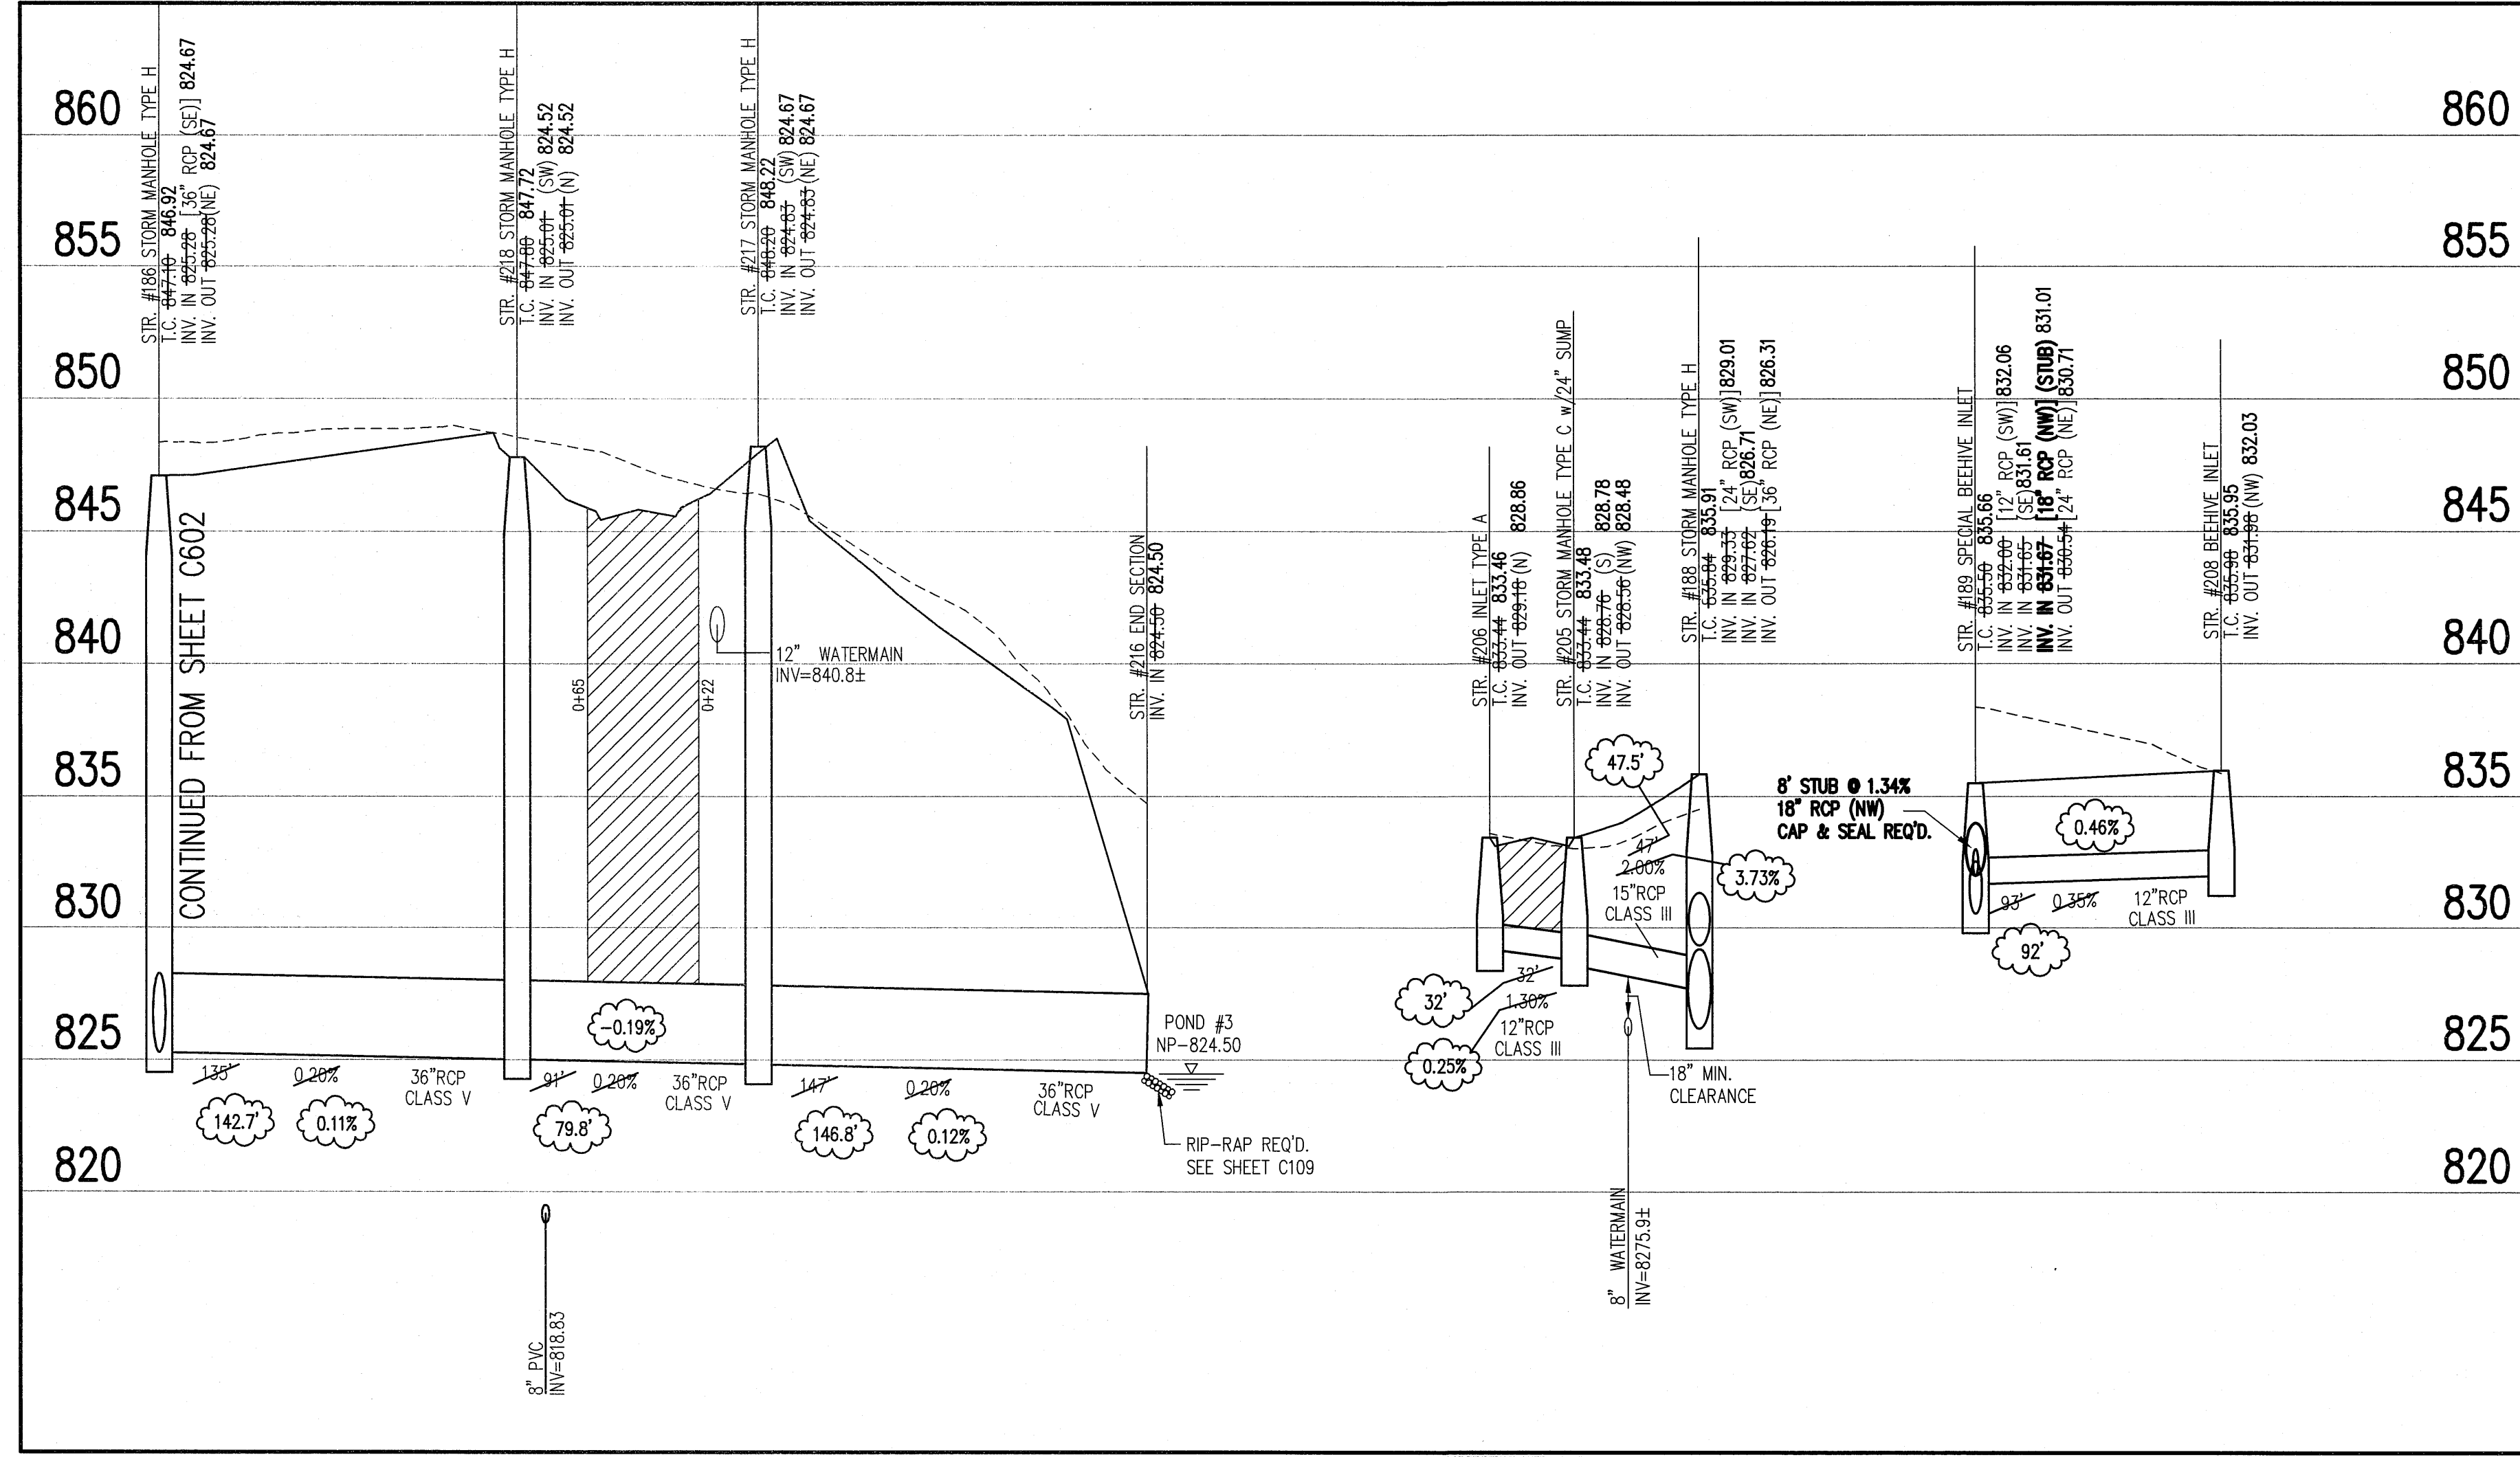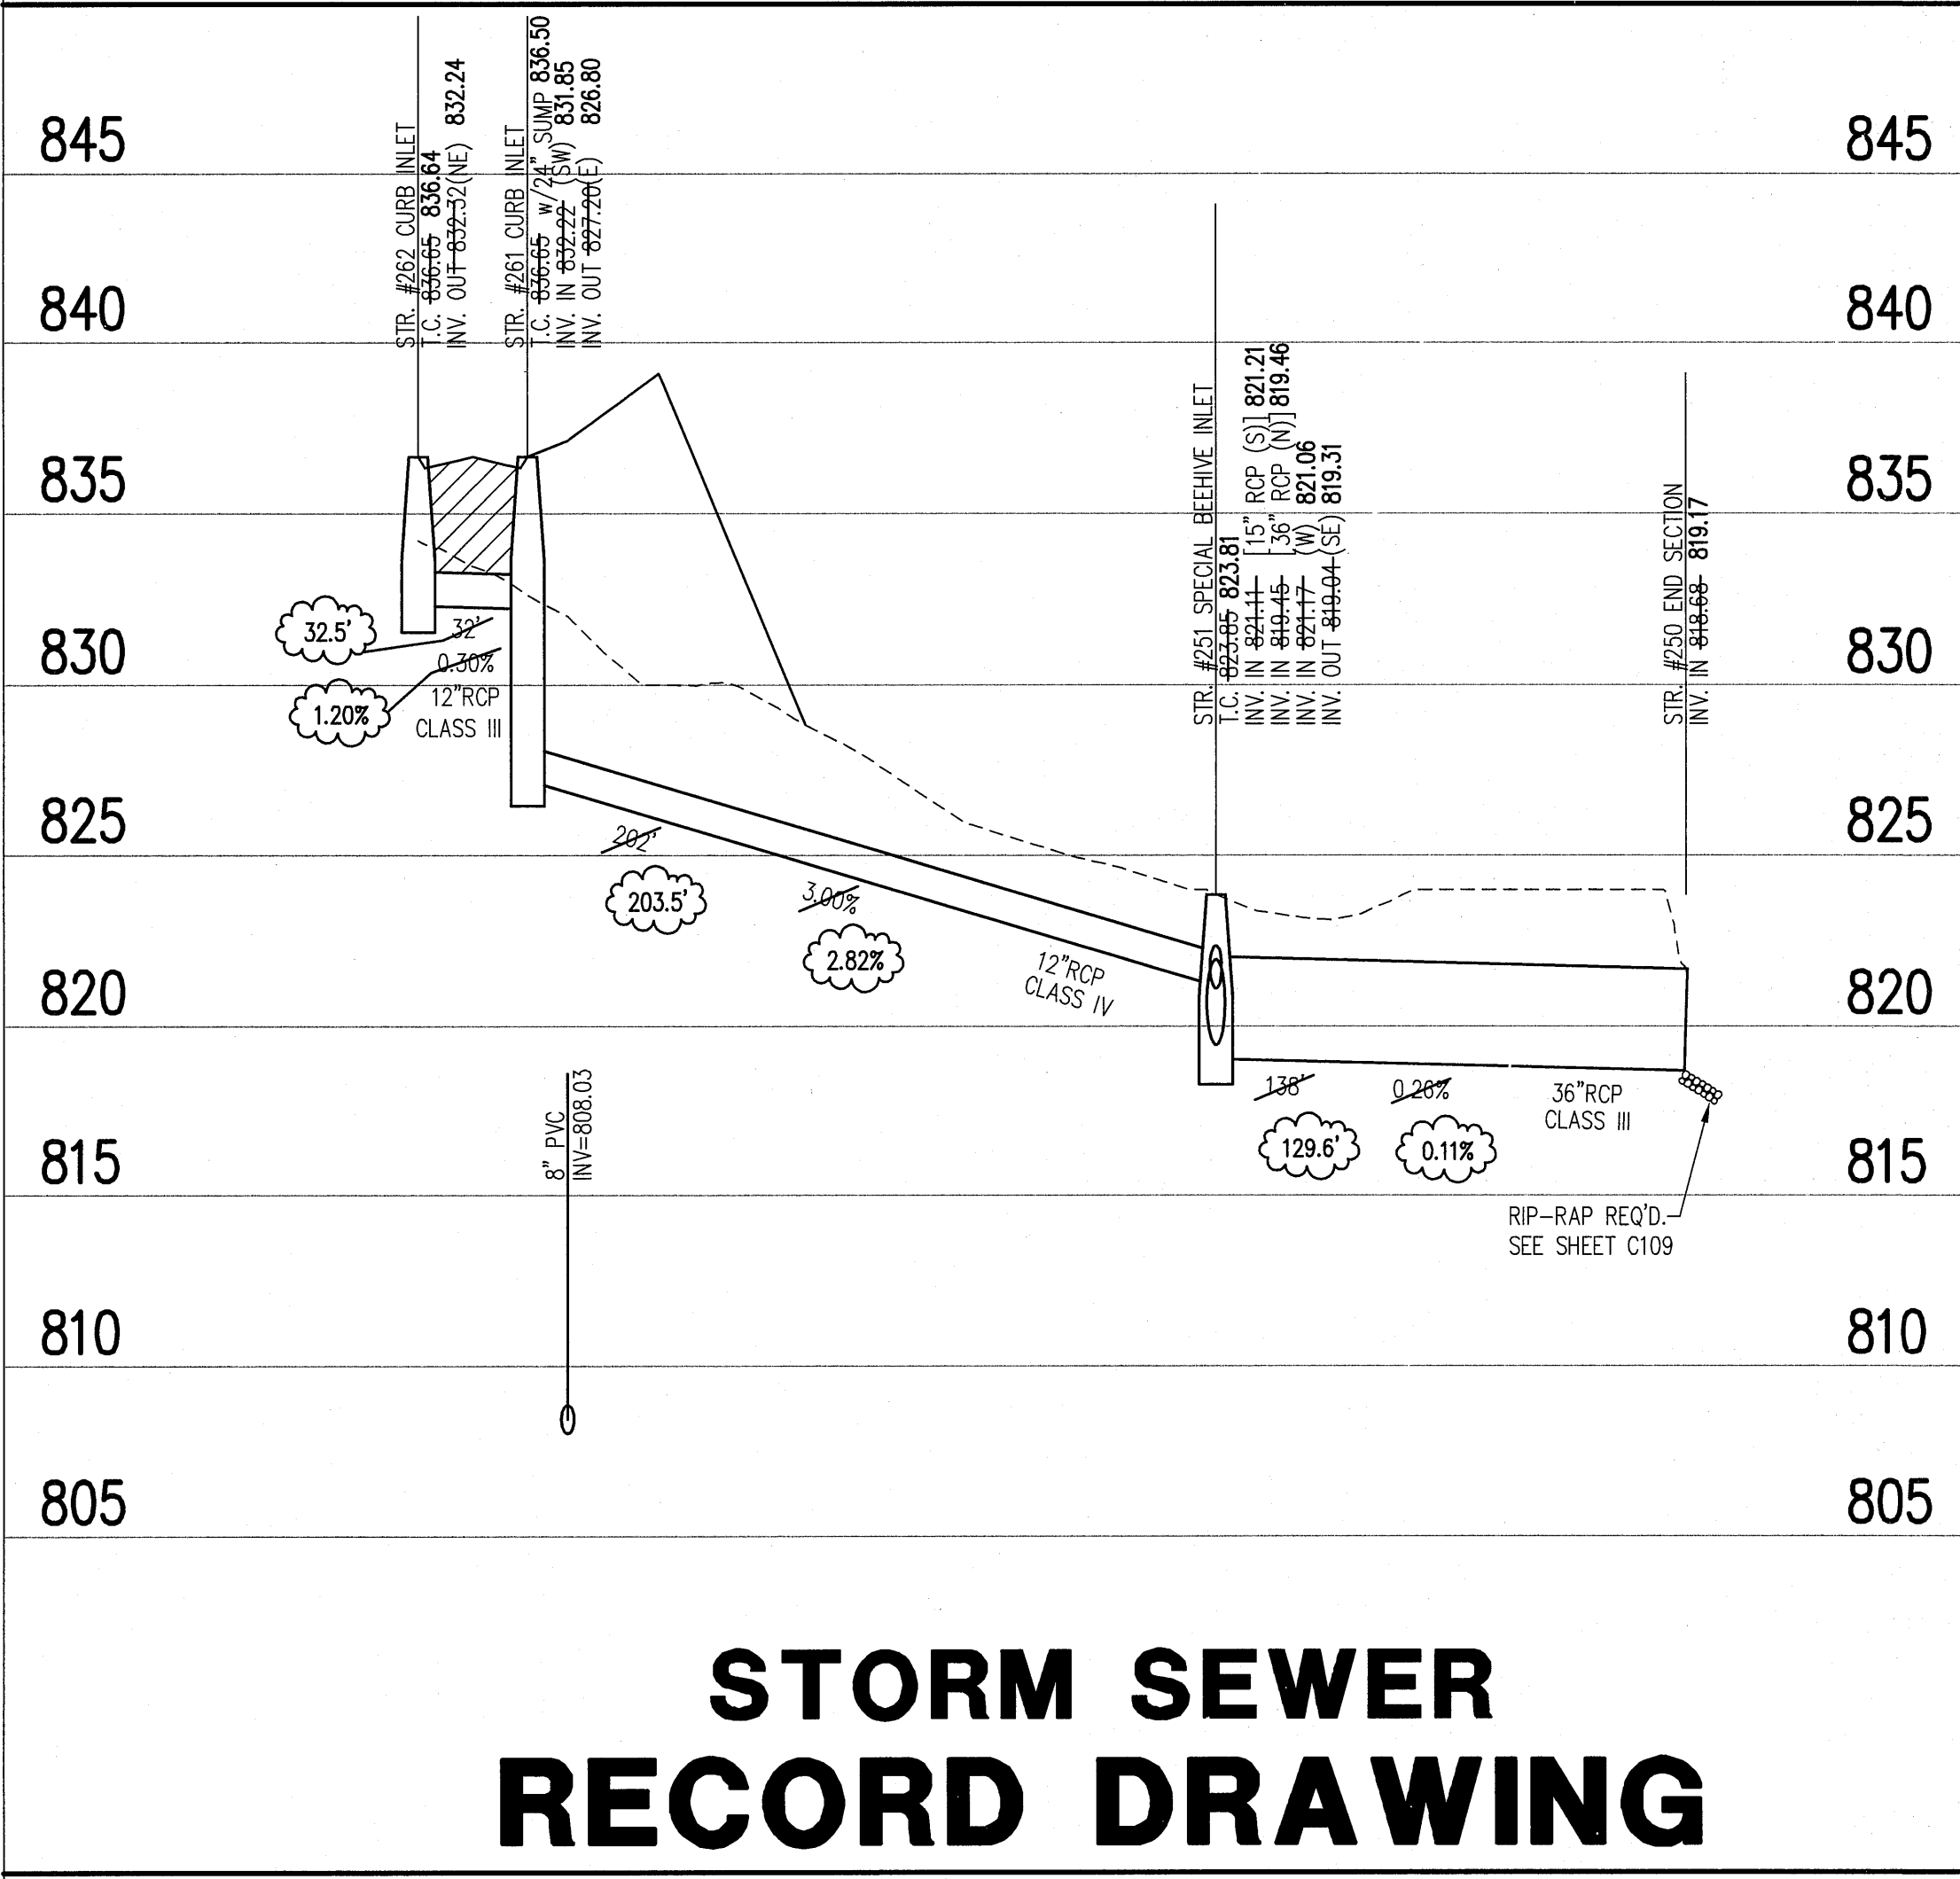

**LEGEND**

	Existing Grade
	New Grade
	Granular Backfill


SCALE: HORZ.: 1"=50'  
 VERT.: 1"=5'

THE SCHNEIDER CORPORATION  
 Historic Fort Harrison  
 8901 Otis Avenue  
 Indianapolis, IN 46216-1037  
 Telephone: 317.526.7100  
 Fax: 317.826.7300  
 www.schneidercorp.com

Architecture  
 Civil Engineering  
 Environmental Engineering  
 Geotechnical Services  
 GIS \* LIS  
 Home Builder Services  
 Interior Design  
 Land Surveying  
 Landscape Architecture  
 Transportation Engineering

**SLATER RIDGE**  
**SECTION 1**  
 HAMILTON COUNTY, NOBLESVILLE, INDIANA  
**PRECEDENT RESIDENTIAL DEVELOPMENT, LLC**  
 9339 PRIORITY WAY WEST DR., (Suite 100), INDIANAPOLIS, INDIANA 46250

DATE: 06/22/05 PROJECT NO.: 4736.001  
 DRAWN BY: RAT CHECKED BY: TPG  
 SHEET TITLE: STORM SEWER PLAN AND PROFILE  
 DRAWING FILES:  
 R:\44\4736\201\dwg\C601-06.dwg  
 XREF: R:\44\4736\201\dwg\lba-Ridge.dwg  
 XREF: R:\44\4736\201\dwg\lba-Run.dwg  
 XREF: R:\44\4736\201\dwg\lba-Road.dwg  
 XREF: R:\44\4736\201\dwg\lba-Future.dwg  
 XREF: R:\44\4736\201\dwg\STORM.dwg  
 XREF: R:\44\4736\201\dwg\4736001S.dwg  
 SHEET NO.: **C606**

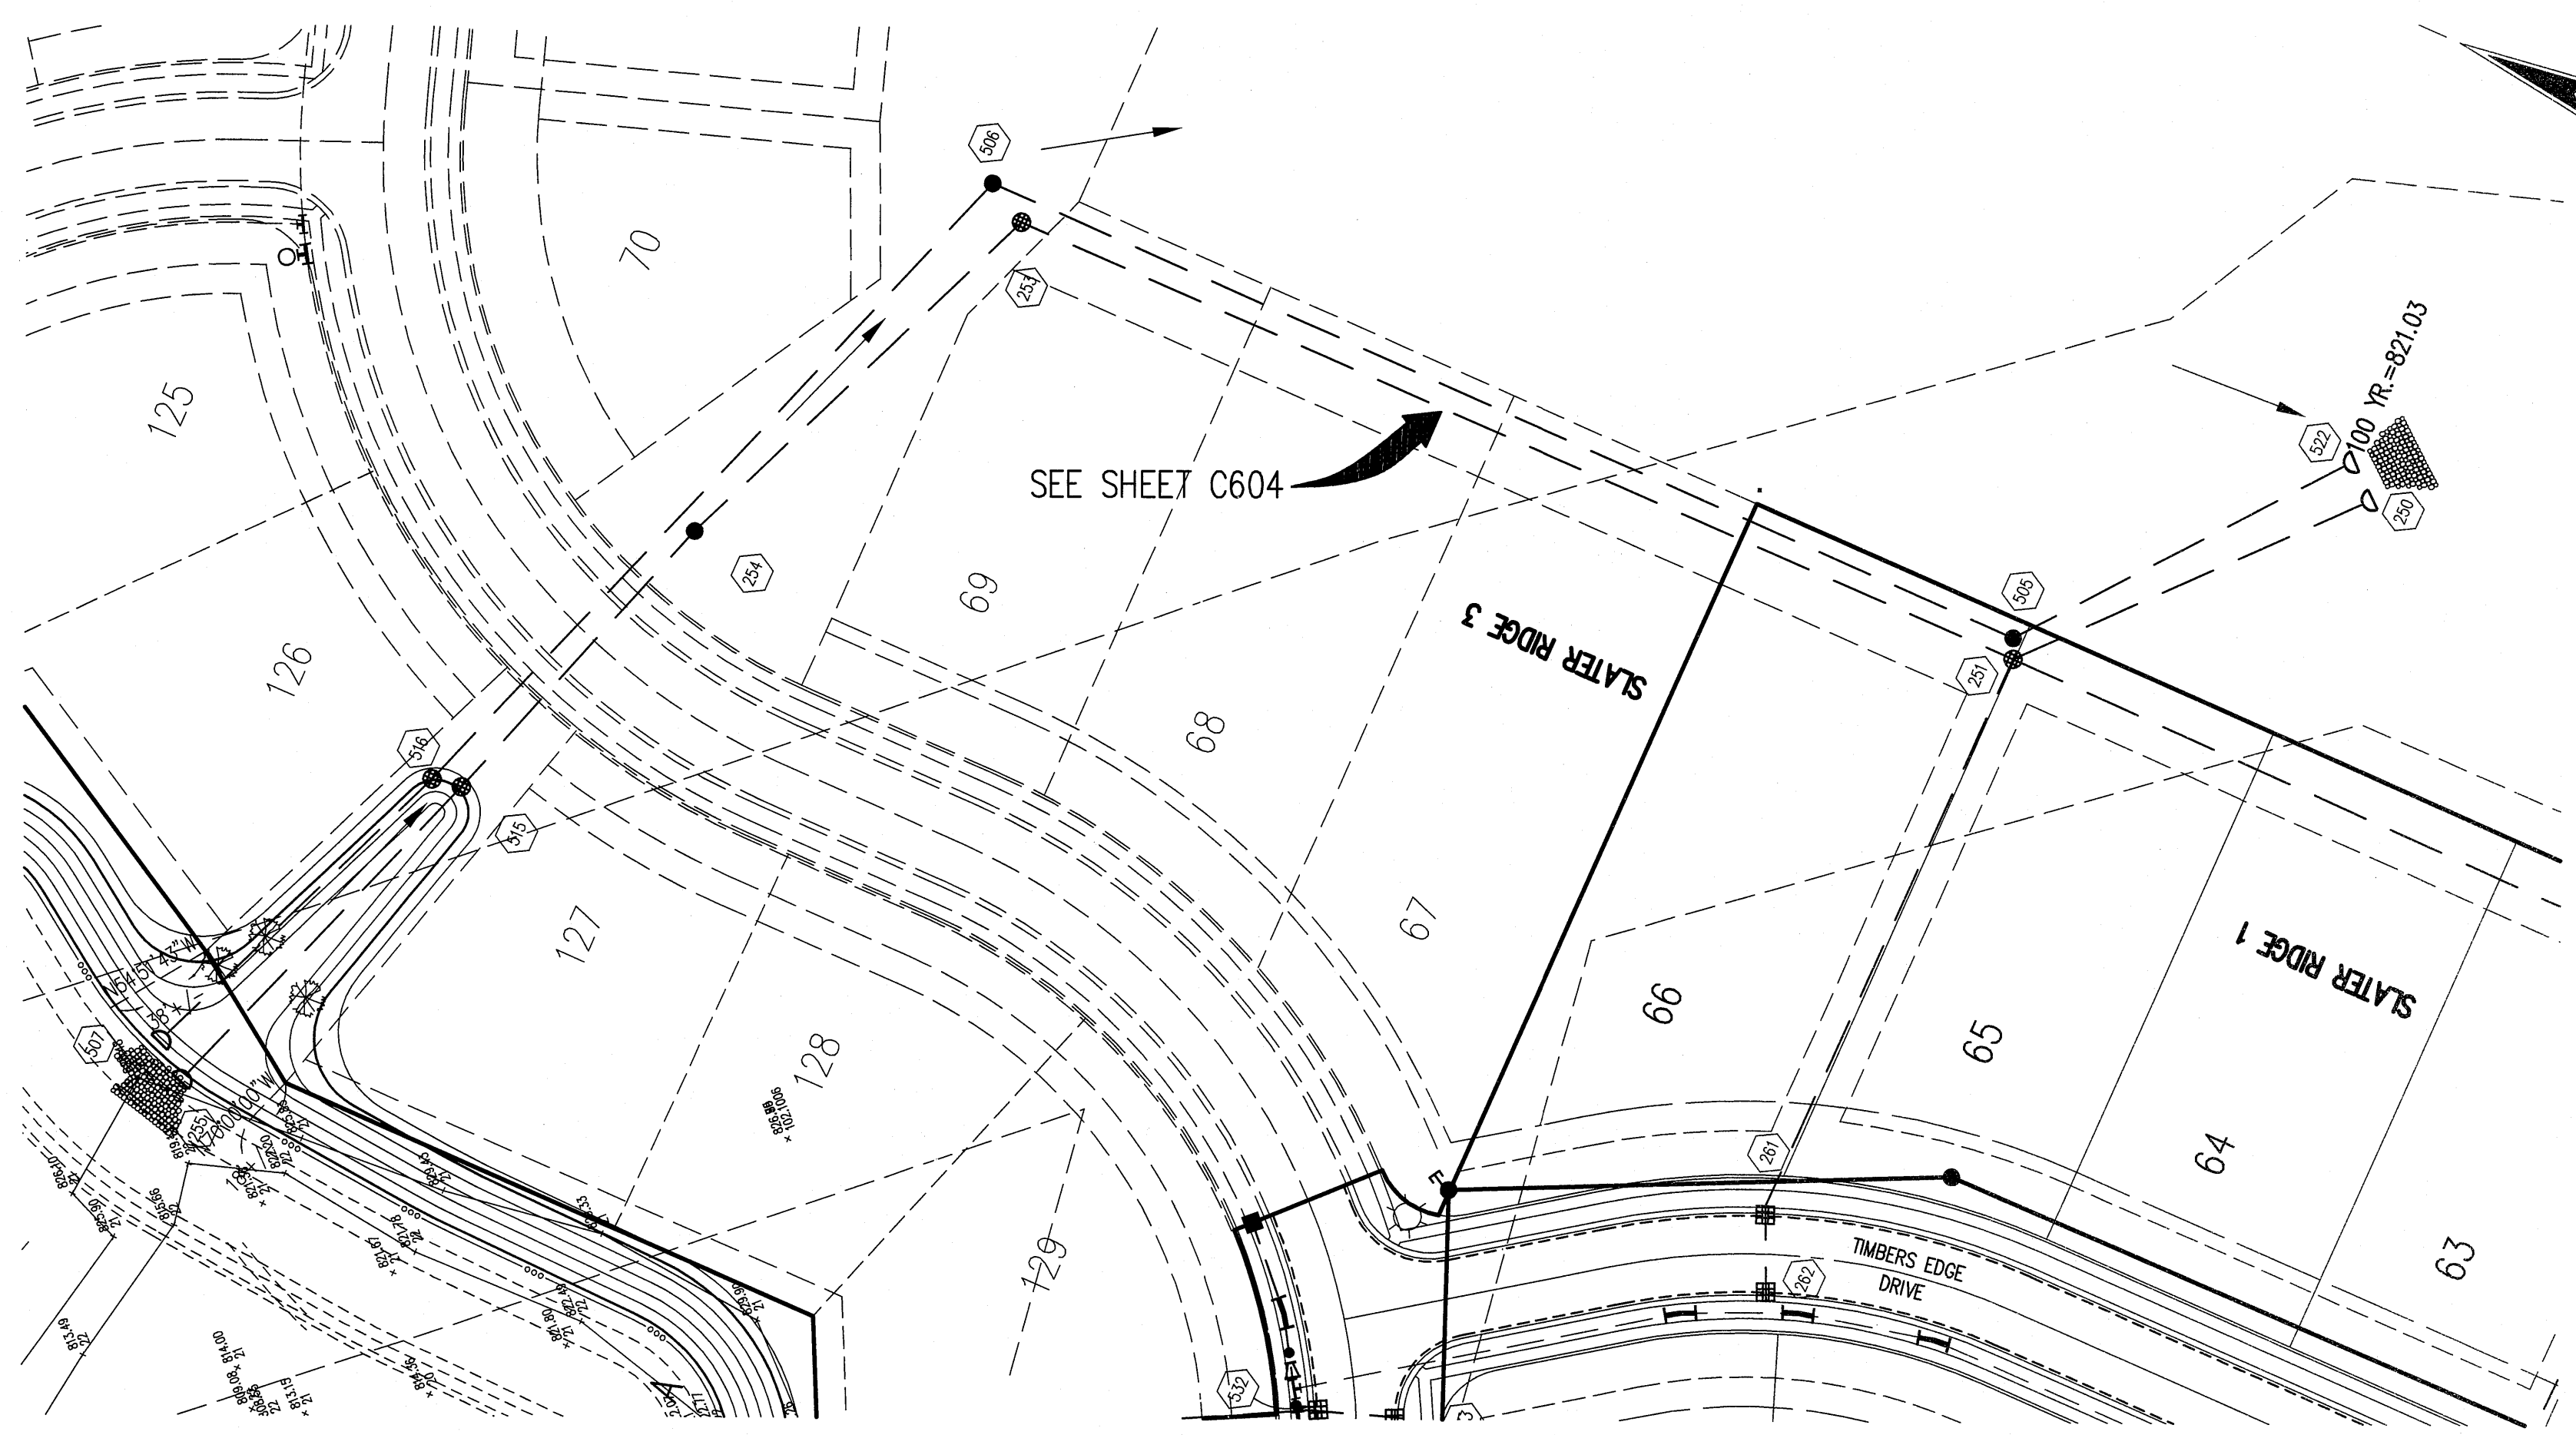

HOLEY MOLEY SAYS  
**"DON'T DIG BLIND"**  
  
**"IT'S THE LAW"**  
 CALL 2 WORKING DAYS BEFORE YOU DIG  
**1-800-382-5544**  
 CALL TOLL FREE  
 PER INDIANA STATE LAW 15-69-1991,  
 IT IS AGAINST THE LAW TO EXCAVATE  
 WITHOUT NOTIFYING THE UNDERGROUND  
 LOCATION SERVICE TWO (2) WORKING  
 DAYS BEFORE COMMENCING WORK.

**GENERAL NOTES**

1. TEMPORARY TRAFFIC CONTROL DURING CONSTRUCTION TO CONFORM TO APPLICABLE LOCAL AND STATE STANDARDS.
2. ALL CONSTRUCTION ACTIVITY ON THIS SITE TO BE PERFORMED IN COMPLIANCE WITH APPLICABLE O.S.H.A. STANDARDS FOR WORKER SAFETY.
3. IT SHALL BE THE CONTRACTORS RESPONSIBILITY TO FIELD VERIFY ALL UTILITY LOCATIONS BEFORE CONSTRUCTION BEGINS.
4. CONTRACTORS SHALL MINIMIZE DAMAGE TO EXISTING TREES.

**LEGEND/DETAILS**


Sheet Number	or	Description
4	11	Bedding Detail - Reinforced Concrete Pipe (RCP)
3	11	Roll Curb Inlet Detail
5	11	Beshive Inlet Detail
5	11	Storm Manhole Detail
CS01	1	Precast Concrete End Section
C109		RipRap Detail @ End Section

**NOTE**

City of Noblesville Details & Specifications

**REVISIONS**


1. OK - 07/01/04 - IAC REVISIONS
2. OK - 9/16/04 - CITY OF NOBLESVILLE COMMENTS
3. OK - 01/20/05 - REVISE PER HAMILTON CO. SURVEYOR AND METLAND
4. OK - 03/24/05 - REVISE PER METLAND AND STORM SEWER
5. OK - 04/01/05 - REVISE PER METLAND AND STORM SEWER
6. OK - 04/01/05 - REVISE PER METLAND AND STORM SEWER
7. OK - 09/15/05 - REVISE PER RECORD DRAWINGS

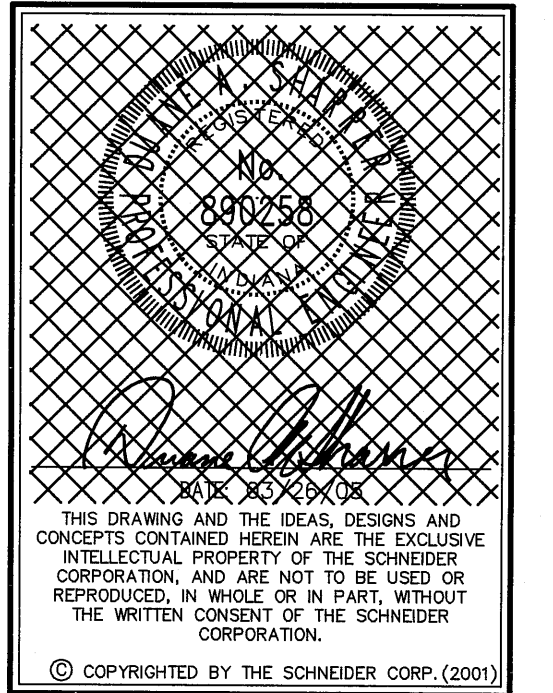

This information was gathered for input into the Hamilton County Geographic Information System (GIS). This document is considered an official record of the GIS.  
 Entry Date: May 2008  
 Entered By: SLM

**STORM SEWER PLAN**


SCALE: 1"=50'

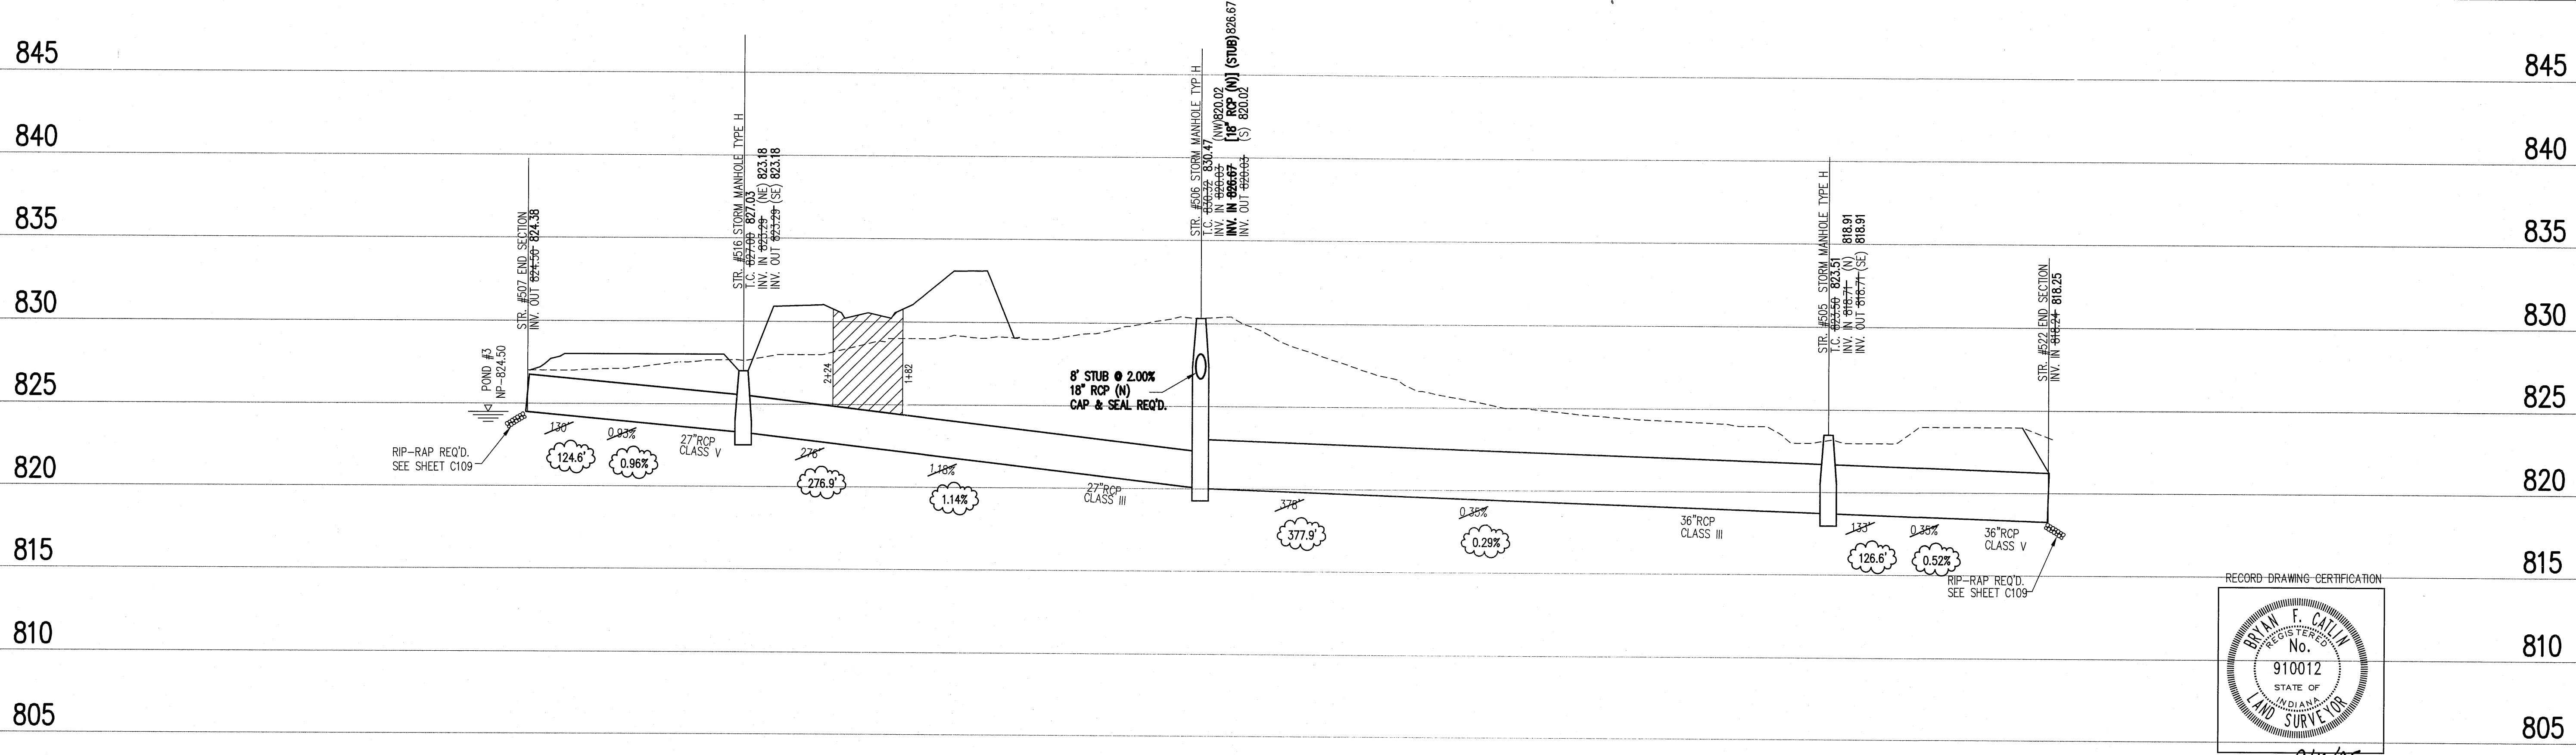

**STORM SEWER RECORD DRAWING**

**STORM SEWER PROFILE**

**NOTE:**  
 Record drawing certification only for top of casting, invert elevations and lengths of pipe. Slope percentage represents a calculated figure and is for general information only.

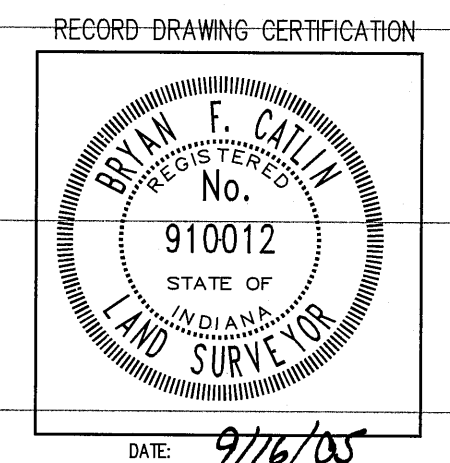

**CERTIFICATION FOR "RECORD DRAWING"**

**LEGEND**

Existing Grade	New Grade	Granular Backfill

SCALE: **HORZ.: 1"=50'**  
**VERT.: 1"=5'**

**Schneider**

THE SCHNEIDER CORPORATION  
 Historic Fort Harrison  
 8901 Otis Avenue  
 Indianapolis, IN 46216-1037  
 Telephone: 317.826.7100  
 Fax: 317.826.7300  
 www.schneidercorp.com

Architecture  
 Civil Engineering  
 Environmental Engineering  
 Geotechnical Services  
 GIS \* LIS  
 Home Builder Services  
 Interior Design  
 Land Surveying  
 Landscape Architecture  
 Transportation Engineering

**SLATER RIDGE SECTION 1**

HAMILTON COUNTY, NOBLESVILLE, INDIANA

**PRECEDENT RESIDENTIAL DEVELOPMENT, LLC**

9539 PRIORITY WAY WEST DR., (Suite 100), INDIANAPOLIS, INDIANA 46250

DATE: 06/22/05	PROJECT NO.: 4736.001
DRAWN BY: RAT	CHECKED BY: TPG
SHEET TITLE: STORM SEWER PLAN AND PROFILE	
DRAWING FILES: R:\44\4736\201\dwg\CS01-06.dwg XREF: R:\44\4736\201\dwg\Ibs-Ridge.dwg XREF: R:\44\4736\201\dwg\Ibs-Run.dwg XREF: R:\44\4736\101\dwg\Ibs-Woods.dwg XREF: R:\44\4736\001\dwg\Ibs-Future.dwg XREF: R:\44\4736\001\dwg\STORM.dwg XREF: R:\44\4736\001\dwg\47360015.dwg	
SHEET NO.: <b>C607</b>	