

Drain: VILLAGE OF WEST CLAY DRAIN
Improvement: SECTION 5006 A118
Operator: JOH
Date: 8/24/04
 1157 MILL APT# 2001

GIS Drain Input Checklist

- Digitize & Attribute Tile Drains JOH
- Digitize & Attribute Storm Drains JOH
- Digitize & Attribute SSD N/A
- Digitize & Attribute Open Ditch N/A
- Sum drain lengths & Validate JOH
- Enter Improvements into Posse JOH
- Enter Drain Age into Posse _____
- Sum drain length for Watershed in Posse _____
- Stamp Plans JOH
- Pull Source Documents for Scanning JOH

**Gasb 34 Footages for Historical Cost
Drain Length Log**


Drain-Improvement: VILLAGE OF WESTCLAY DRAIN - SECTION 5006 A16

Drain Type:	Size:	Length <i>measured length</i>	Length (DB Query)	Length Reconcile	Price:	Cost:
RCP	12"	704'	704'	Ø		
	15"	428'	428'	Ø		
	18"	69'	69'	Ø		
	21"	237'	237'	Ø		
	24"	117'	117'	Ø		
	27"	134'	134'	Ø		
	30"	257'	257'	Ø		

Sum: 1,946' 1,946' Ø

Final Report: _____

Comments:

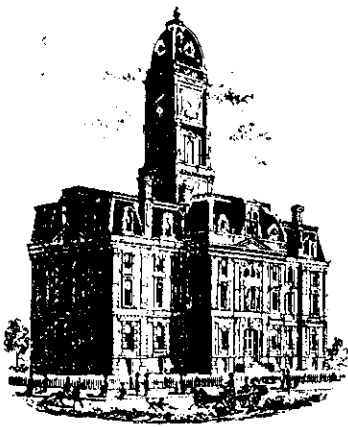

SURVEYOR'S OFFICE

Hamilton County

Kenton C. Ward, Surveyor

Phone (317) 776-8495

Fax (317) 776-9628

Suite 188

*One Hamilton County Square
Noblesville, Indiana 46060-2230*

To: Hamilton County Drainage Board

September 6, 2001

Re: Village of West Clay Drain, Section 5006 Arm ^{A&B}

Attached is a petition, non-enforcement request, plans, calculations, quantity summary and assessment roll for the Village of West Clay Section 5006 Drain. I have reviewed the submittals and petition and have found each to be in proper form.

I have made a personal inspection of the land described in the petition. Upon doing so, I believe that the drain is practicable; will improve the public health; benefit a public highway and be of public utility; and that the costs, damages, and expenses of the proposed drain will probably be less than the benefits accruing to the owners of land likely to be benefited. The drain will consist of the following:

12" RCP	702 ft	21" RCP	238 ft	30" RCP	257 ft
15" RCP	415 ft	24" RCP	116 ft		
18" RCP	68 ft	27" RCP	237 ft		

The total length of the drain will be 2,033 feet.

The retention pond (lake) located in commons Marshall Pond is not to be considered part of the regulated drain. Only the inlet and outlet will be maintained as part of the regulated drain. The maintenance of the pond (lake) will be the responsibility of the Homeowners Association. The Board will however, retain jurisdiction for ensuring the storage volume for which the lake was designed will be retained. Thereby, allowing no fill or easement encroachments. Marshall Pond was constructed with West Clay Section 10001. (See report dated November 14, 2000)

The subsurface drains (SSD) under curbs are not to be part of the regulated drain. This is per an agreement between Brenwick Development and the Hamilton County Commissioners on April 26, 1999. (See Commissioners Minute Book 93, pages 565-566) The existing storm pipe and structures F602, F603, F601 and F600

were constructed with West Clay Section 10001. (See report dated November 14, 2000)

I have reviewed the plans and believe the drain will benefit each lot equally. Therefore, I recommend each lot be assessed equally. I also believe that no damages will result to landowners by the construction of this drain. I recommend a maintenance assessment of \$5.00 per lot, \$5.00 per acre for roadways, with a \$120.00 minimum. With this assessment the total annual assessment for this drain/this section will be \$5,562.76.


Parcels assessed for this drain may be assessed for the Collins-Osborn, Williams Creek or Clay Creek Drains at sometime in the future.

I believe this proposed drain meets the requirements for Urban Drain Classification as set out in IC 36-9-27-67 to 69. Therefore, this drain shall be designated as an Urban Drain.

I recommend that upon approval of the above proposed drain that the Board also approve the attached non-enforcement request. This request is for the reduction of the regulated drain easement to those widths as shown on the secondary plat for Village of West Clay Section 5006 as recorded in the office of the Hamilton County Recorder.

I recommend the Board set a hearing for this proposed drain for October 22, 2001.

KCW/llm

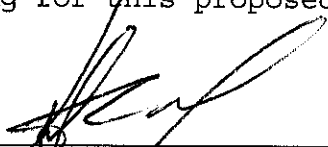

Kenton C. Ward
Hamilton County Surveyor



2001

Performance Bond

THIS DOCUMENT HAS IMPORTANT LEGAL CONSEQUENCES: CONSULTATION WITH AN ATTORNEY IS ENCOURAGED WITH RESPECT TO ITS COMPLETION OR MODIFICATION. AUTHENTICATION OF THIS ELECTRONICALLY DRAFTED AIA DOCUMENT MAY BE MADE BY USING AIA DOCUMENT D401.

Any singular reference to Contract, Surety, Owner or other party shall be considered plural where applicable.

CONTRACTOR (Name and Address):
Brenwick TND Communities, LLC
12722 Hamilton Crossing Boulevard
Carmel, IN 46032

SURETY (Name and Principal Place of Business):
Fidelity and Deposit Company of Maryland
2350 One Indiana Square
Indianapolis, IN 46204

OWNER (Name and Address):
Hamilton County Board of County Commissioners
Hamilton County Courthouse
Noblesville, IN 46060

BOND NO. 08505135

CONSTRUCTION CONTRACT

Date: July 23, 2001
Amount: Sixty-Six Thousand Three Hundred Seventy-Five and No/100 *** Dollars (\$66,375.00)
Description (Name and Location): Installation of Erosion Control and Monumentation at The Village of West Clay, Section 5006.

BOND

Date (Not earlier than Construction Contract Date): July 23, 2001
Amount: Sixty-Six Thousand Three Hundred Seventy-Five and No/100 *** Dollars (\$66,375.00)
Modifications to this Bond: None See Last Page

CONTRACTOR AS PRINCIPAL
Company: Brenwick TND Communities, LLC (Corporate Seal)

SURETY
Company: Fidelity and Deposit Company of Maryland (Corporate Seal)

Signature: [Signature]
Name and Title: V.P. OPERATIONS - BRENNICK TND CO.
(Any additional signatures appear on the last page)

Signature: [Signature]
Name and Title: Shelley E. Henry, Attorney-In-Fact

(FOR INFORMATION ONLY - Name, Address and Telephone)

AGENT or BROKER:
M.J. Schuetz Agency
PO Box 44070
Indianapolis, IN 46244
(317) 639-5679

OWNER'S REPRESENTATIVE (Architect, Engineer or other party):

1 The Contractor and the Surety, jointly and severally, bind themselves, their heirs, executors, administrators, successors and assigns to the Owner for the performance of the Construction Contract, which is incorporated herein by reference.

2 If the Contractor performs the Construction Contract, the Surety and the Contractor shall have no obligation under this Bond, except to participate in conferences as provided in Subparagraph 3.1.

3 If there is no Owner Default, the Surety's obligation under this Bond shall arise after:

3.1 The Owner has notified the Contractor and the Surety at its address described in Paragraph 10 below that the Owner is considering declaring a Contractor Default and has requested and attempted to arrange a conference with the Contractor and the Surety to be held not later than fifteen days after receipt of such notice to discuss

© 1984 THE AMERICAN INSTITUTE OF ARCHITECTS, 1735 NEW YORK AVENUE, N.W., WASHINGTON, D.C. 20006-5292. AIA DOCUMENT A312 • PERFORMANCE BOND AND PAYMENT BOND • DECEMBER 1984 ED. • AIA® • THIRD PRINTING • MARCH 1987 • WARNING: Unlicensed photocopying violates U.S. copyright laws and is subject to legal prosecution. This document was electronically produced with permission of the AIA and can be reproduced in accordance with your license without violation until the date of expiration as noted below. expiration as noted below. User Document: brenwick.aia -- 7/12/2001. AIA License Number 1003606, which expires on 5/17/2002.

the pipe grade.

- J. Concrete encasement of mains (none shown).
- K. Sales tax.

BID AMOUNT SECTION 5006	\$	134,087.00
BID AMOUNT SECTION 10001		210,715.00

III. STORM SEWERS

Includes:

- A. Excavation and placement of the gasketed R.C.P. as shown on the drawings.
- B. Inlets and manholes.
- C. Concrete end sections.
- D. Rip-rap.
- E. Granular backfill as required. No granular backfill under sidewalks and paths.
- F. 3 year – 20% maintenance bond.

Excludes:

- A. Field engineering and soils testing.
- B. Permits or performance bonds.
- C. Relocation of existing utilities.
- D. Flowable backfill under any existing or proposed streets or drives.
- E. Cost for design engineer to produce as-built record drawings.
- F. Locating or height adjustment of castings due to grade changes made by others (i.e., at the end of the maintenance bond period). This work will be performed on a time and material basis.
- G. Sales tax.

BID AMOUNT SECTION 5006	\$	70,483.00
BID AMOUNT SECTION 10001		109,425.00

IV. SUBSURFACE DRAINS

Includes:

- A. 6" perforated corrugated polyethylene tube for subsurface drains under curbs as shown.
- B. Lot laterals as shown for subsurface drains.
- C. #8 gravel backfill as required.
- D. 3 Year – 20% maintenance bond.

Excludes:

- A. Schedule 35 PVC or Double Wall pipe as required by Hamilton County.
- B. Field engineering and soils testing.
- C. Permits or performance bonds.
- D. Relocation of existing utilities.
- E. Cost for design engineer to produce as-built record drawings.


CERTIFICATE OF COMPLETION AND COMPLIANCE

TO: HAMILTON COUNTY SURVEYOR
RE: Village of West Clay Section 5006

I hereby certify that:

1. I am a Register Engineer in the State of Indiana
2. I am familiar with the plans and specifications for the above referenced subdivision.
3. I have personally observed and supervised the completion of the Drainage Facilities for the above referenced subdivision, and
4. To the best of my knowledge, information and belief, the Drainage Facilities within the subdivision has been installed and completed in conformity with all plans and specifications.

Signature: _____

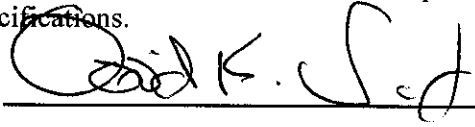

Date: July 17, 2002

Type or print name: David K. Sexton, P.E.

Business /Address: The Schneider Corporation

12821 E. New Market Street, Suite 100, Carmel, IN 46032

Telephone: (317) 569-8112

INDIANA REGISTRATION NUMBER

PE 9500028

SEAL



7 17 2002
12 17 2002



SURVEYOR'S OFFICE

Hamilton County

Kenton C. Ward, Surveyor

Phone (317) 776-8495

Fax (317) 776-9628

Suite 188

One Hamilton County Square

Noblesville, Indiana 46060-2230

To: Hamilton County Drainage Board

April 12, 2004

Re: Villages of West Clay Drain: Sec. 5006 A & B Arm

Attached are as-builts, certificate of completion & compliance, and other information for Villages of West Clay Sec. 5006 A & B. An inspection of the drainage facilities for this section has been made and the facilities were found to be complete and acceptable.

During construction, changes were made to the drain, which will alter the plans submitted with my report for this drain-dated September 6, 2001. The report was approved by the Board at the hearing held October 22, 2001. (See Drainage Board Minutes Book 6, Pages 186-187) The changes are as follows:

Structure:	T.C.:	I.E.:	Pipe:	Length:	Original Plans:	Difference:
610	891.11	888.05				
602	892.95	886.63	12	188	187	1
609	892.33	888.99				
608	894.88	888.33	12	177	175	2
608	894.88	888.33				
607	892.63	887.93	15	119	118	1
607	892.63	887.93				
606	893.01	887.72	18	69	68	1
606	893.01	887.78				
605	892.59	887.29	21	237	238	-1
605	892.59	887.13				
604	892.13	886.93	24	117	116	1
604	892.13	886.93				
603	892.01	886.83	27	29		
603	892.01	886.78				
602	892.95	886.59	27	105	108	-3
602	892.95	886.62				
601	890.18	886.18	30	169	166	3
601	890.18	886.18				
600		885.99	30	88	91	-3
607	892.63	888.23				

614	892.53	888.78	12	29		
613	894.5	890.85				
606	893.01	888.3	12	185	184	1
611	894.48	887.71				
605	892.59	887.2	15	116	115	1
615	891.29	887.19				
602	890.62	886.37	12	67	68	1
616	893.95	889.35				
603	895.32	888.17	12	58	59	1
612	892.61	888.7				
611B	894.1	888.1	15	122		
611B	894.1	888.1				
611A	894.04	887.97	15	12	10	2
611A	894.04	887.97				
611	894.48	887.71	15	59		

RCP Pipe Totals:

12	704
15	428
18	69
21	237
24	117
27	134
30	257

The length of the drain due to the changes described above is now **1,946 feet**.

The non-enforcement was approved by the Board at its meeting on October 22, 2001 and recorded under instrument #200200027356.


The following sureties were guaranteed by Fidelity and Deposit Co. and released by the Board on its August 12, 2002 meeting.

Bond-LC No: 08505122
Insured For: Storm Sewers
Amount: \$70,483
Issue Date: June 25, 2001

Bond-LC No: 08505135
Insured For: Erosion Control, Monuments
Amount: \$66,375
Issue Date: July 23, 2001

I recommend the Board approve the drain's construction as complete and acceptable.

Sincerely,

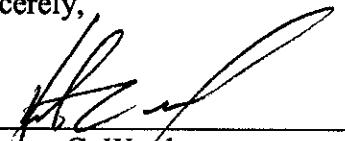

Kenton C. Ward,
Hamilton County Surveyor

KCW/slm



HOLEY MOLEY SAYS
"DON'T DIG BLIND"

"IT'S THE LAW"
 CALL 2 WORKING DAYS BEFORE YOU DIG
1-800-382-5544
 CALL TOLL FREE
 PER INDIANA STATE LAW 15-69-1991
 IT IS AGAINST THE LAW TO EXCAVATE
 WITHOUT NOTIFYING THE UNDERGROUND
 LOCATION SERVICE TWO (2) WORKING
 DAYS BEFORE COMMENCING WORK.

ASSUMED NORTH
 SCALE: 1"=50'

LEGEND

	Existing Storm Sewer
	New Storm Sewer
	Existing Sanitary Sewer
	New Sanitary Sewer
	Existing Contour
	Existing Elevation w/ description
	New Pavement Grade
	All Other Finish Grades
	Storm Structure Number
	Sanitary Structure Number
	Flow Arrow
	Denotes Elevation and Approximate Pad Size
	6" Subsurface Drain
	2' Chairback Curb
	2' Chairback Curb w/o Cutter
	Valley Gutter
	Extruded Concrete Curb
	Emergency Overflow Route

GENERAL NOTES

- ALL GRADES AT BOUNDARY SHALL MEET EXISTING GRADES.
- IT SHALL BE THE RESPONSIBILITY OF EACH CONTRACTOR TO VERIFY ALL EXISTING UTILITIES AND CONDITIONS PERTAINING TO HIS PHASE OF WORK. IT SHALL ALSO BE THE CONTRACTOR'S RESPONSIBILITY TO CONTACT THE OWNERS OF THE VARIOUS UTILITIES FOR PROPER STAKE LOCATIONS FOR EACH UTILITY BEFORE WORK IS STARTED. THE CONTRACTOR SHALL NOTIFY IN WRITING THE OWNER OR THE ENGINEER OF ANY CHANGES, OMISSIONS, OR ERRORS FOUND ON THESE PLANS OR IN THE FIELD BEFORE WORK IS STARTED OR RESUMED.
- STANDARD SPECIFICATIONS FOR THE HAMILTON COUNTY SURVEYOR SHALL APPLY FOR ALL STORM SEWERS.
- STANDARD SPECIFICATIONS FOR CLAY TOWNSHIP REGIONAL WASTE DISTRICT SHALL APPLY FOR ALL SANITARY SEWERS. ANY PART OF THE SANITARY OR STORM SEWER TRENCHES RUNNING UNDER PAVED AREAS TO BE BACKFILLED WITH GRANULAR MATERIAL.
- THE SIZE AND LOCATION OF EXISTING UTILITIES SHOWN ARE PER INFORMATION PROVIDED BY THE RESPECTIVE UTILITY COMPANIES. ALL UTILITY COMPANIES SHOULD BE NOTIFIED PRIOR TO ANY EXCAVATION FOR FIELD LOCATION OF SERVICES.
- SERVICE WALKS SHALL BE NON-REINFORCED CONCRETE 4" THICK AND 4' IN WIDTH.
- CONCRETE SERVICE WALK ACROSS FRONTAGE OF EACH LOT TO BE CONSTRUCTED BY OTHERS.
- EXPANSION JOINTS AREA TO BE PLACED AT ALL WALK INTERSECTIONS AND BETWEEN WALKS AND PLATFORMS. SIDEWALK SCORES ARE TO BE EQUALLY SPACED BETWEEN EXPANSION JOINTS, CONTRACTION JOINTS AND PERPENDICULAR TO SIDEWALKS AT 5' INTERVALS OR LESS WITH A CONTRACTION JOINT EVERY 20' OR LESS.
- TEMPORARY TRAFFIC CONTROL DURING CONSTRUCTION TO CONFORM TO APPLICABLE LOCAL AND STATE STANDARDS.
- ALL CONSTRUCTION ACTIVITY ON THIS SITE TO BE PERFORMED IN COMPLIANCE WITH APPLICABLE O.S.H.A. STANDARDS FOR WORKER SAFETY.
- CONTRACTOR SHALL MINIMIZE DAMAGE TO EXISTING TREES. REMOVE AND BACKFILL ALL AREAS WHERE ANY FIELD TILE CROSSES PROPOSED HOUSE PADS. ALL FIELD TILES INTERCEPTED TO BE PERPETUATED INTO STORM SEWER SYSTEM OR LAKE. THE SUBCONTRACTOR SHALL NOTIFY IN WRITING THE OWNER AND THE ENGINEER IN ANY CIRCUMSTANCES WHERE THIS CANNOT BE ACCOMPLISHED. ALL FILL AREAS SHALL BE COMPACTED TO AT LEAST 95 PERCENT OF THE MAXIMUM DRY DENSITY (ASTM D-1557). FILL UNDER THE FOOTING SHALL BE COMPACTED TO AT LEAST 95 PERCENT OF THE MAXIMUM DRY DENSITY (ASTM D-1557).
- WATER MAIN VALVES SHALL NOT BE LOCATED UNDER PAVEMENT.

Revisions
 1. DEC. 10/15/99, REVISED PER CTRND.
 2. DEC. 11/2/99, REVISED PER TAC COMMENTS.
 3. 11/10/99 818, REVISED ALLY GRADES BEHIND LOTS 744-754.
 4. BEI, 1/27/00, REVISED PER COUNTY SURV. COMMENTS.
 5. MG, 6/4/01, REVISED LOTS 746-775 PER CLIENT.
 6. BIR, 8/3/01, REVISED ALLY GRADES/LOTS 746-756



CERTIFIED BY: *[Signature]*
 THIS DRAWING AND THE IDEAS, DESIGNS AND CONCEPTS CONTAINED HEREIN ARE THE EXCLUSIVE INTELLECTUAL PROPERTY OF THE SENDER CORPORATION AND ARE NOT TO BE USED OR REPRODUCED IN WHOLE OR IN PART, WITHOUT THE WRITTEN CONSENT OF THE SENDER CORPORATION.

1999, The Schneider Corporation

12726 Hamilton Crossing Blvd. Engineering
 Carmel, Indiana Surveying
 46032 Landscape Architecture
 317-574-3797 GIS + LIS
 317-574-3799 Fax Geology

Formerly Schneider Engineering Corp. / Bohlen, Meyer, Gibson & Assoc.

BRENWICK DEVELOPMENT CO.
 Village of WestClay
 Section 5006


DEVELOPMENT PLAN

Date	09/17/99	Project No.	1238.5006	Drawn	DCC	Approv.	
Computer Files	J:\1238\5006\DWG\C101.DWG XREF: 5006ABS, 5006BBS, 5001BS XREF: 1001BS, 300-BS XREF: CA7, CA8, CA9, CA10						
Sheet No.	C101						

This information was gathered for input into the Hamilton County Geographical Information System. This document is considered an official record of the GIS.

Entry Date: 8-2-04

Entered by: *[Signature]*

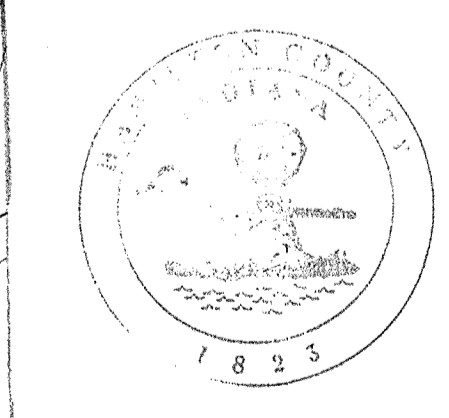

FILED
 JUL 17 2002
 OFFICE OF HAMILTON COUNTY SURVEYOR

BENCHMARK






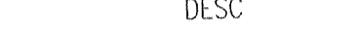
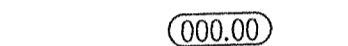
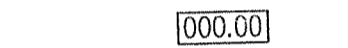










TBM #44
 USGS BENCHMARK
 CUT "X" NORTH BONNET BOLT IN FIRE HYDRANT
 EAST SIDE HOOPER RD. ±100' SOUTH OF CLARIDGE
 FARM ENTRANCE.
 ELEVATION - 893.39

HOLEY MOLEY SAYS
"DON'T DIG BLIND"

"IT'S THE LAW"
 CALL 2 WORKING DAYS BEFORE YOU DIG
1-800-382-5544
 CALL TOLL FREE
 PER INDIANA STATE LAW 15-69-1991,
 IT IS AGAINST THE LAW TO EXCAVATE
 WITHOUT NOTIFYING THE UNDERGROUND
 LOCATION SERVICE TWO (2) WORKING
 DAYS BEFORE COMMENCING WORK.

ASSUMED NORTH
 SCALE: 1"=50'

LEGEND

-  Existing Storm Sewer
-  New Storm Sewer
-  Existing Sanitary Sewer
-  New Sanitary Sewer
-  Existing Contour
-  Existing Elevation w/ description
-  New Pavement Grade
-  All Other Finish Grades
-  Storm Structure Number
-  Sanitary Structure Number
-  Flow Arrow
-  Denotes Elevation and Approximate Pad Size
-  6" Subsurface Drain
-  2" Chairback Curb
-  2" Chairback Curb w/o Gutter
-  Valley Gutter
-  Extruded Concrete Curb
-  Emergency Overflow Route

1. ALL GRADES AT BOUNDARY SHALL MEET EXISTING GRADES.
2. IT SHALL BE THE RESPONSIBILITY OF EACH CONTRACTOR TO VERIFY ALL EXISTING UTILITIES AND CONDITIONS PERTAINING TO HIS PHASE OF WORK. IT SHALL ALSO BE THE CONTRACTOR'S RESPONSIBILITY TO CONTACT THE OWNERS OF THE VARIOUS UTILITIES FOR PROPER STAKE LOCATIONS FOR EACH UTILITY BEFORE WORK IS STARTED. THE CONTRACTOR SHALL NOTIFY IN WRITING THE OWNER OR THE ENGINEER OF ANY CHANGES, OMISSIONS, OR ERRORS FOUND ON THESE PLANS OR IN THE FIELD BEFORE WORK IS STARTED OR RESUMED.
3. STANDARD SPECIFICATIONS FOR THE HAMILTON COUNTY SURVEYOR SHALL APPLY FOR ALL STORM SEWERS.
4. STANDARD SPECIFICATIONS FOR CLAY TOWNSHIP REGIONAL WASTE DISTRICT SHALL APPLY FOR ALL SANITARY SEWERS. ANY PART OF THE SANITARY OR STORM SEWER TRENCHES RUNNING UNDER PAVED AREAS TO BE BACKFILLED WITH GRANULAR MATERIAL.
5. THE SIZE AND LOCATION OF EXISTING UTILITIES SHOWN ARE PER INFORMATION PROVIDED BY THE RESPECTIVE UTILITY COMPANIES. ALL UTILITY COMPANIES SHOULD BE NOTIFIED PRIOR TO ANY EXCAVATION FOR FIELD LOCATION OF SERVICES.
6. SERVICE WALKS SHALL BE NON-REINFORCED CONCRETE 4" THICK AND 4' IN WIDTH.
7. 4" CONCRETE SERVICE WALK ACROSS FRONTAGE OF EACH LOT TO BE CONSTRUCTED BY OTHERS.
8. EXPANSION JOINTS AREA TO BE PLACED AT ALL WALK INTERSECTIONS AND BETWEEN WALKS AND PLATFORMS. SIDEWALK SCORES ARE TO BE EQUALLY SPACED BETWEEN EXPANSION JOINTS, CONTRACTION JOINTS AND PERPENDICULAR TO SIDEWALKS AT 5' INTERVALS OR LESS WITH A CONTRACTION JOINT EVERY 20' OR LESS.
9. TEMPORARY TRAFFIC CONTROL DURING CONSTRUCTION TO CONFORM TO APPLICABLE LOCAL AND STATE STANDARDS. ALL CONSTRUCTION ACTIVITY ON THIS SITE TO BE PERFORMED IN COMPLIANCE WITH APPLICABLE O.S.H.A. STANDARDS FOR WORKER SAFETY.
10. CONTRACTOR SHALL MINIMIZE DAMAGE TO EXISTING TREES. REMOVE AND BACKFILL ALL AREAS WHERE ANY FIELD TILE INTERCEPTED TO BE PERPETUATED INTO STORM SEWER SYSTEM OR LAKE. THE SUBCONTRACTOR SHALL NOTIFY IN WRITING THE OWNER AND THE ENGINEER IN ANY CIRCUMSTANCES WHERE THIS CANNOT BE ACCOMPLISHED.
11. ALL FILL AREAS SHALL BE COMPACTED TO AT LEAST 95 PERCENT OF THE MAXIMUM DRY DENSITY (ASTM D-1557). FILL UNDER THE FOOTING SHALL BE COMPACTED TO AT LEAST 95 PERCENT OF THE MAXIMUM DRY DENSITY (ASTM D-1557).
12. WATER MAIN VALVES SHALL NOT BE LOCATED UNDER PAVEMENT.

- Revisions
1. BET. 10/15/99, REVISED PER CTWD.
 2. DEC 11/2/99, REVISED PER TAC COMMENTS.
 3. 11/10/99 818, REVISED ALLY GRADES BEHIND LOTS 744-754.
 4. BET. 1/27/00, REVISED PER COUNTY SURVEYOR COMMENTS.
 5. MC. 6/4/01, REVISED LOTS 746-775 PER CLIENT.
 6. BTB. 8/3/01, REVISED ALLY GRADES/LOTS 746-756.



CERTIFIED BY 1/12/01
 THIS DRAWING AND THE IDEAS, DESIGNS AND CONCEPTS CONTAINED HEREIN ARE THE EXCLUSIVE INTELLECTUAL PROPERTY OF THE ENGINEER CORPORATION AND ARE NOT TO BE USED OR REPRODUCED IN WHOLE OR IN PART, WITHOUT THE WRITTEN CONSENT OF THE ENGINEER CORPORATION.
 1999, The Schneider Corporation



12726 Hamilton Crossing Blvd. Engineering
 Carmel, Indiana Surveying
 46032 Landscape Architecture
 317-574-3797 GIS + LIS
 317-574-3799 Fax Geology


Formerly Schneider Engineering Corp. / Bohlen, Meyer, Gibson & Assoc.
 BRENWICK DEVELOPMENT CO.
 Village of WestClay
 Section 5006

DEVELOPMENT PLAN

Date	Project No.	Drawn	Apprv.
09/17/99	1238.5006	DCC	
Computer Files	Sheet No.		
& \12385006.DWG\C101.DWG XREF: 5006AS, 5006BS, 5006BS XREF: 1001BS, 501-BS XREF: CA7, CA8, CA9, CA10	C101		


BENCHMARK


TBM #44
 USGS BENCHMARK
 CUT "X" NORTH BONNET BOLT IN FIRE HYDRANT
 EAST SIDE HOOVER RD. ±100' SOUTH OF CLARIDGE
 FARM ENTRANCE.
 ELEVATION = 893.39

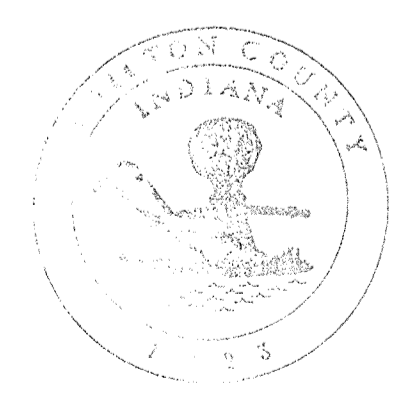

This information was gathered for input into the Hamilton County Geographical Information System. This document is considered an official record of the GIS.
 Entry Date: 8/24/01
 Entered by: JH


FILED
 JUL 17 2002
 OFFICE OF HAMILTON COUNTY SURVEYOR

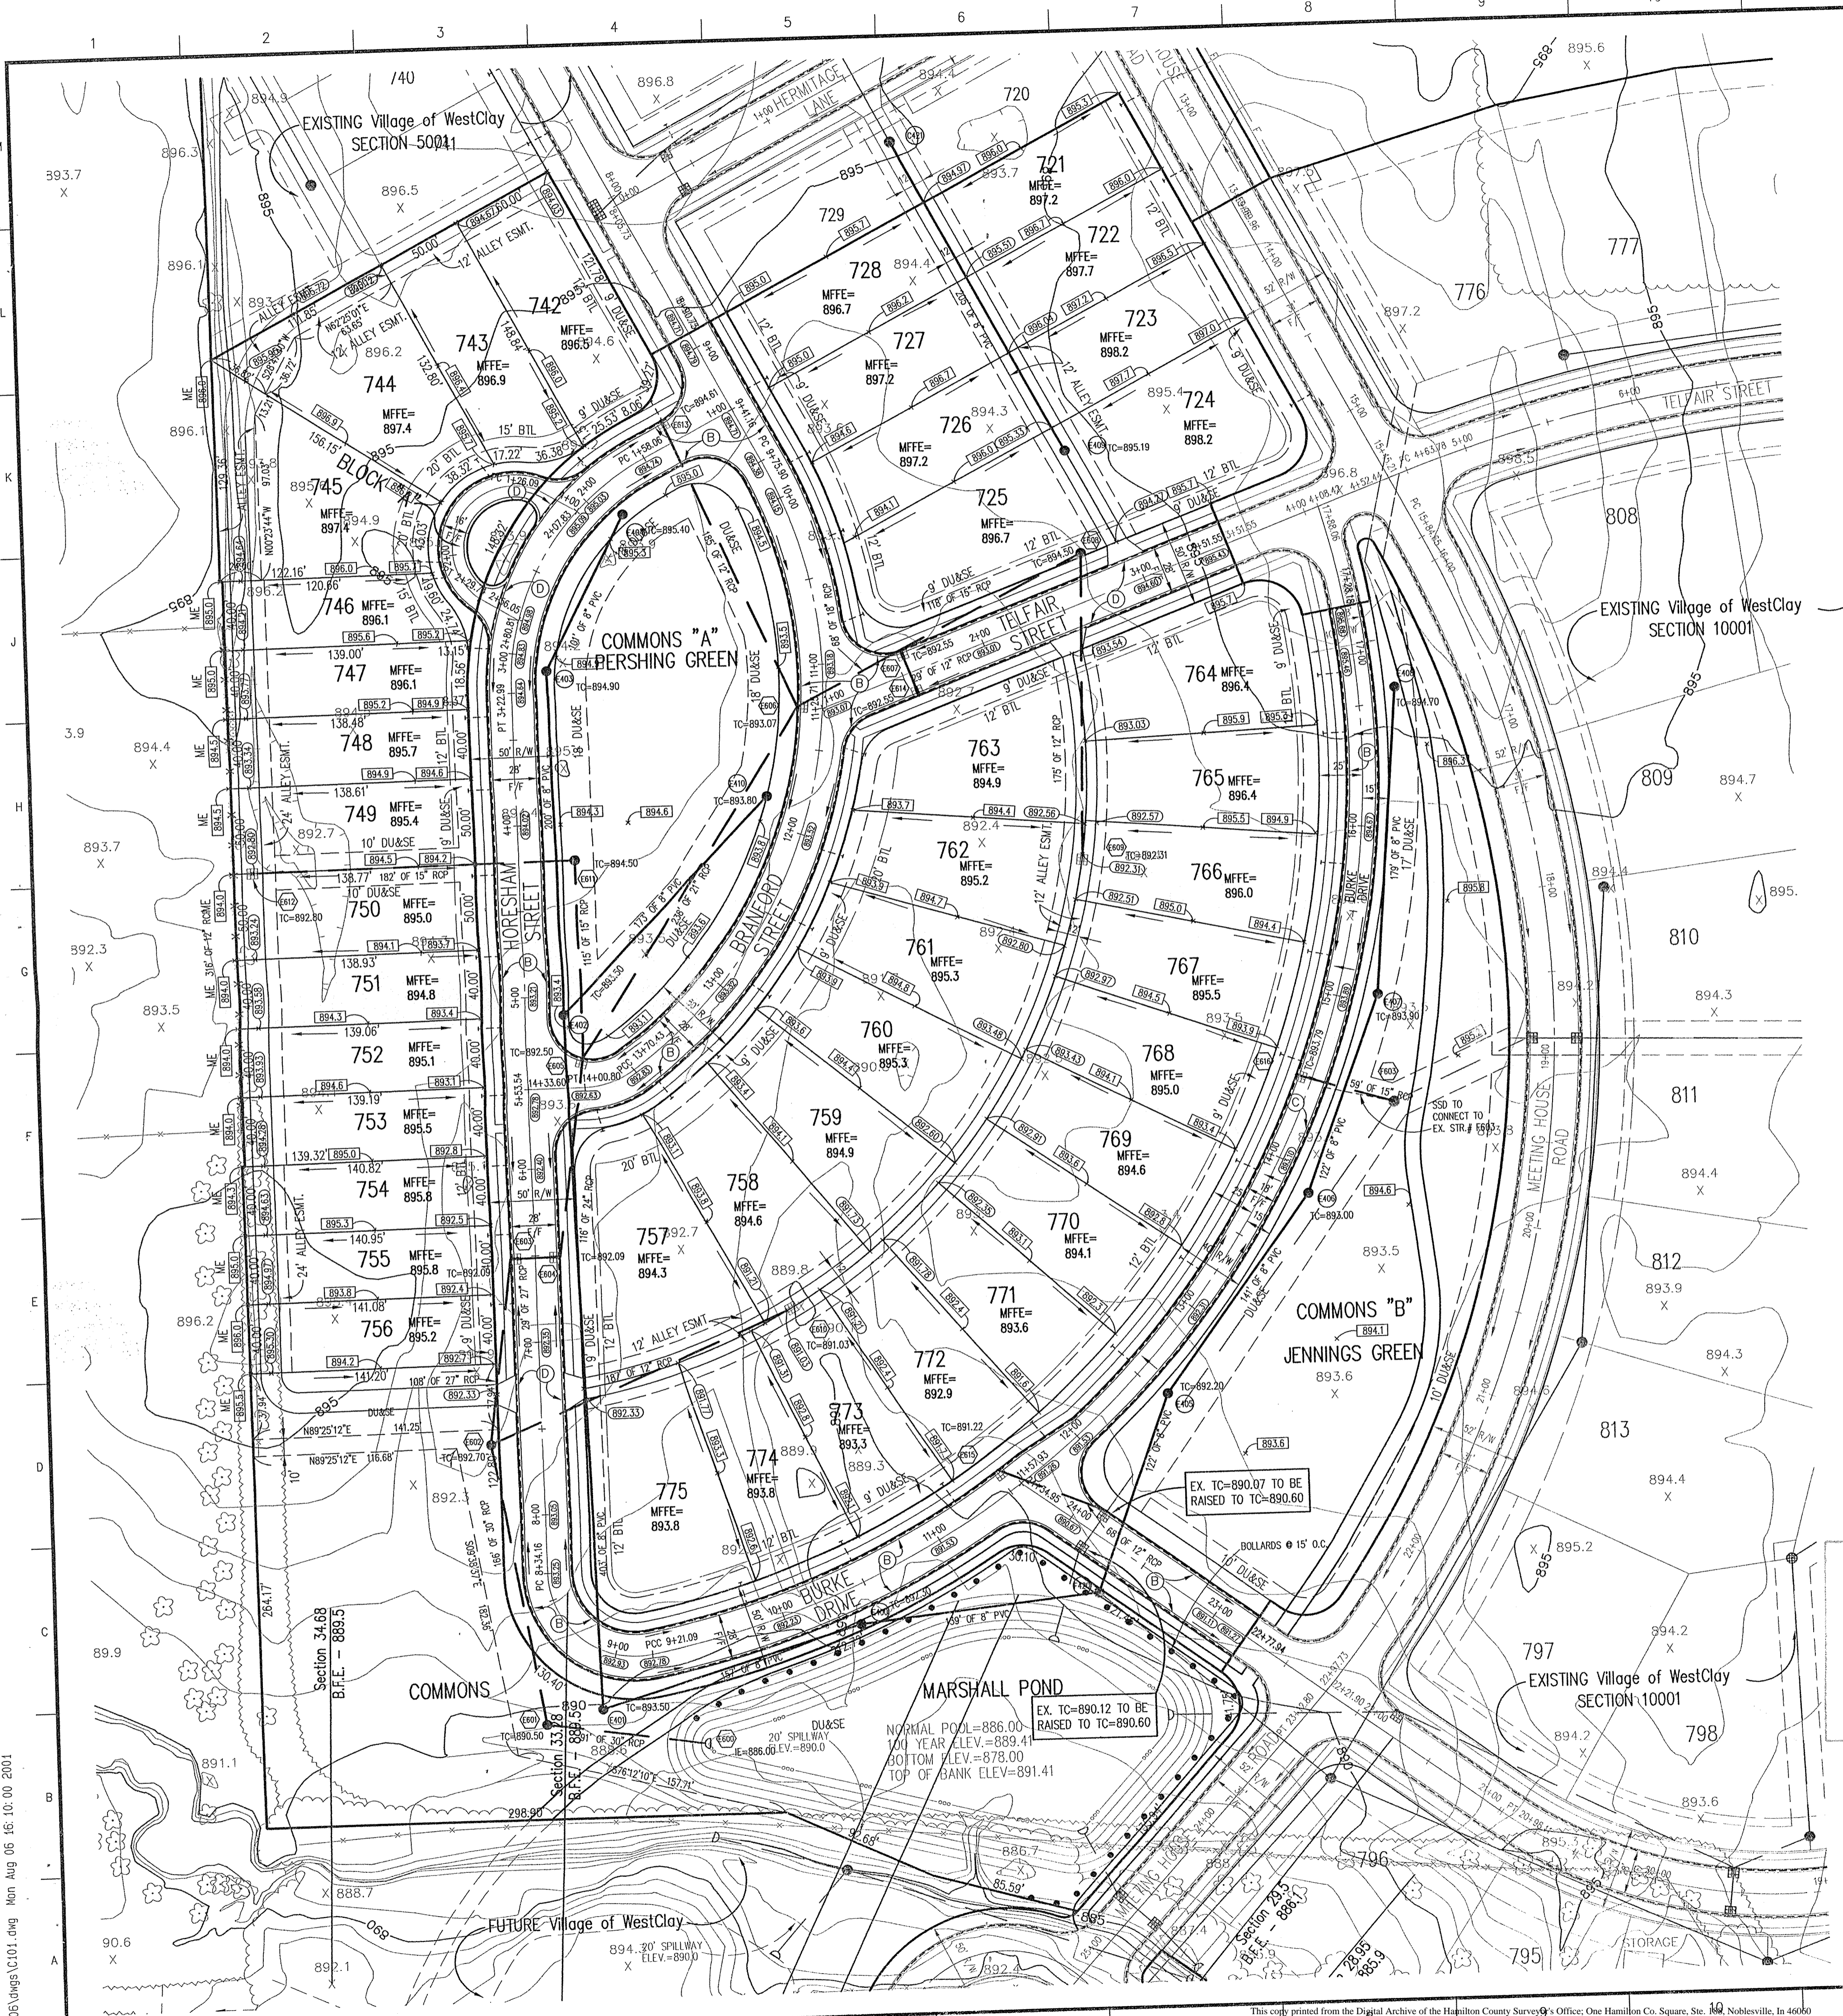

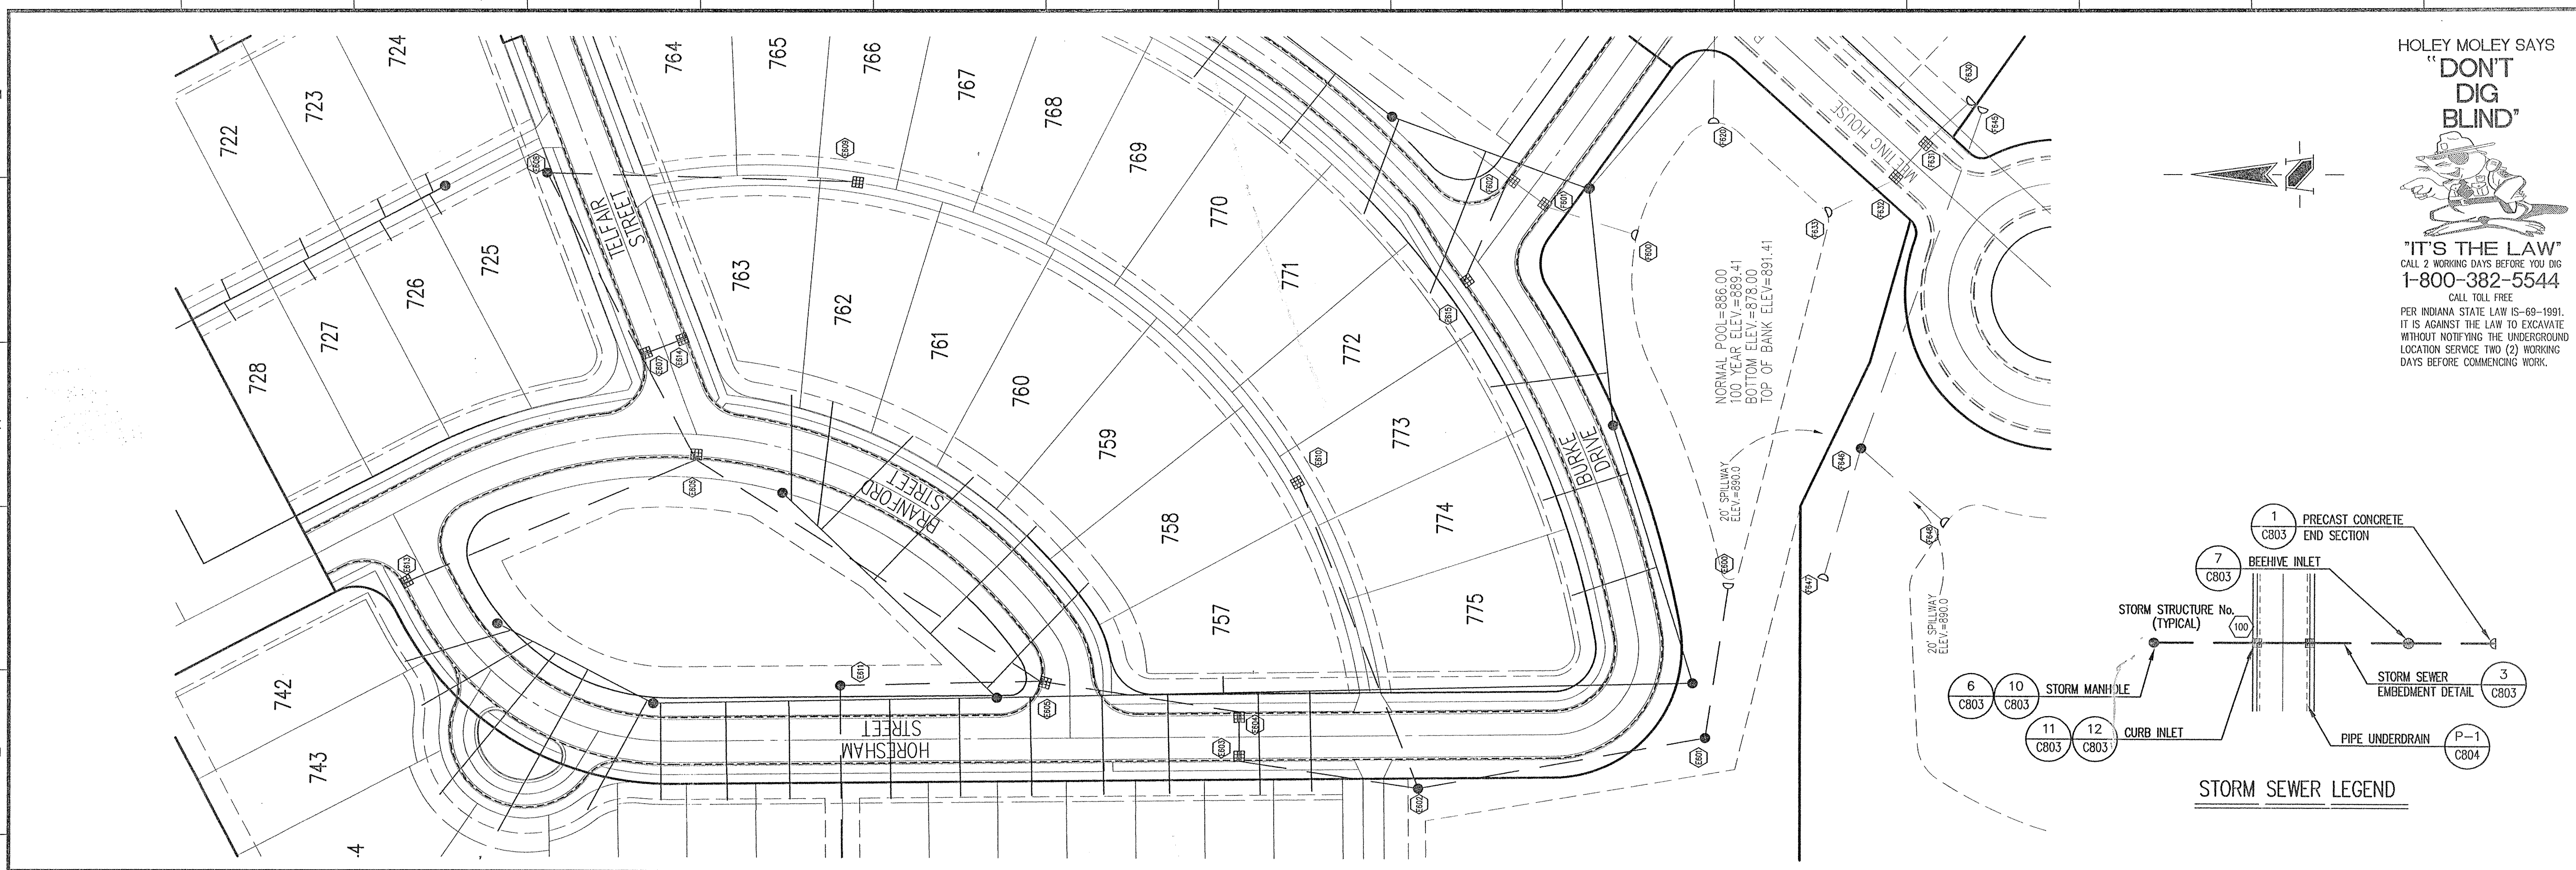

HOLEY MOLEY SAYS
"DON'T DIG BLIND"

"IT'S THE LAW"
 CALL 2 WORKING DAYS BEFORE YOU DIG
1-800-382-5544
 CALL TOLL FREE
 PER INDIANA STATE LAW IS-69-1991
 IT IS AGAINST THE LAW TO EXCAVATE
 WITHOUT NOTIFYING THE UNDERGROUND
 LOCATION SERVICE TWO (2) WORKING
 DAYS BEFORE COMMENCING WORK.

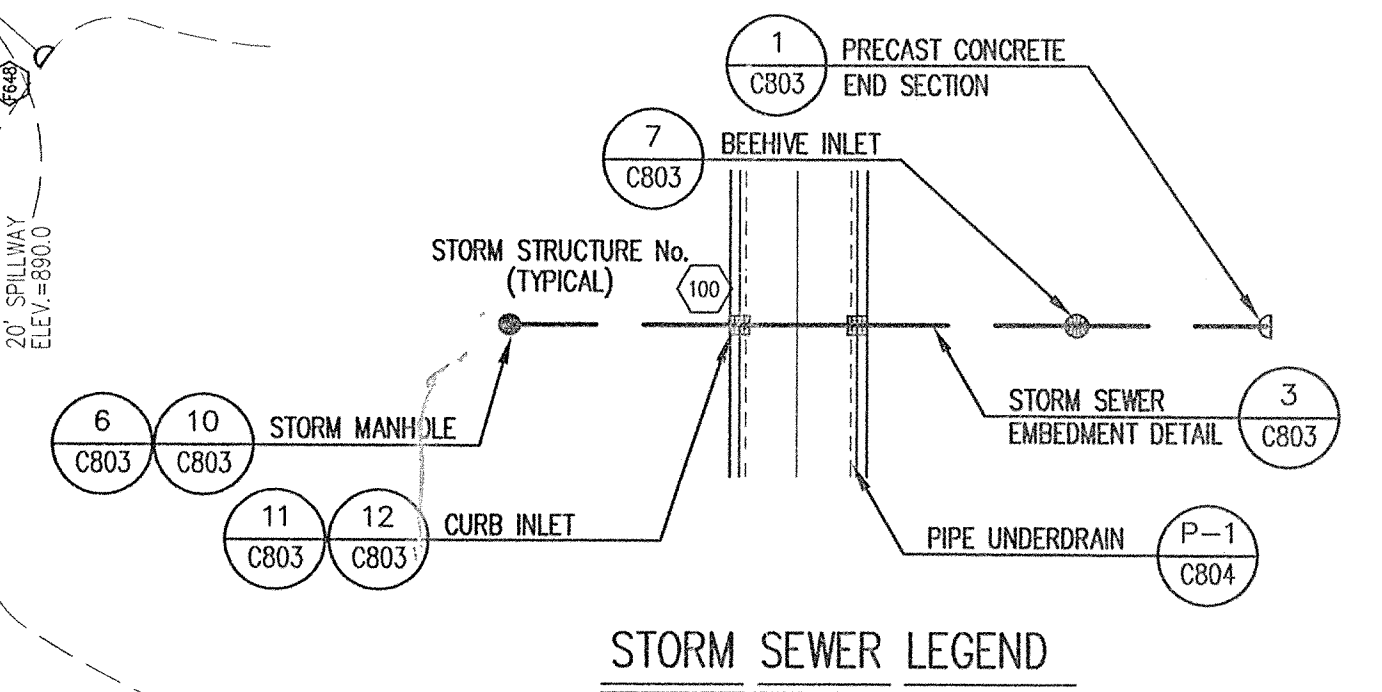

GENERAL NOTES

1. TEMPORARY TRAFFIC CONTROL DURING CONSTRUCTION TO CONFORM TO APPLICABLE LOCAL AND STATE STANDARDS.
2. ALL CONSTRUCTION ACTIVITY ON THIS SITE TO BE PERFORMED IN COMPLIANCE WITH APPLICABLE O.S.H.A. STANDARDS FOR WORKER SAFETY.
3. IT SHALL BE THE CONTRACTORS RESPONSIBILITY TO FIELD VERIFY ALL UTILITY LOCATIONS BEFORE CONSTRUCTION BEGINS.
4. CONTRACTORS SHALL MINIMIZE DAMAGE TO EXISTING TREES.

BENCHMARK


TBM #44
 USGS BENCHMARK
 CUT "X" NORTH BONNET BOLT IN FIRE HYDRANT
 EAST SIDE HOOVER RD. ±100' SOUTH OF CLARIDGE
 FARM ENTRANCE.
 ELEVATION - 893.39

Revisions

1. DEC 11/2/98: REVISED PER TAC COMMENTS.
2. BEI, 1/27/00: REVISED PER COUNTY SURVEYOR'S COMMENTS.
3. MC, 6/4/01: UPDATED E500-E510 & E508-E509 PER LOT REVISIONS.
4. BEI, 08/20/01: "RECORD DRAWING"

STORM SEWER PLAN

SCALE: 1"=50'

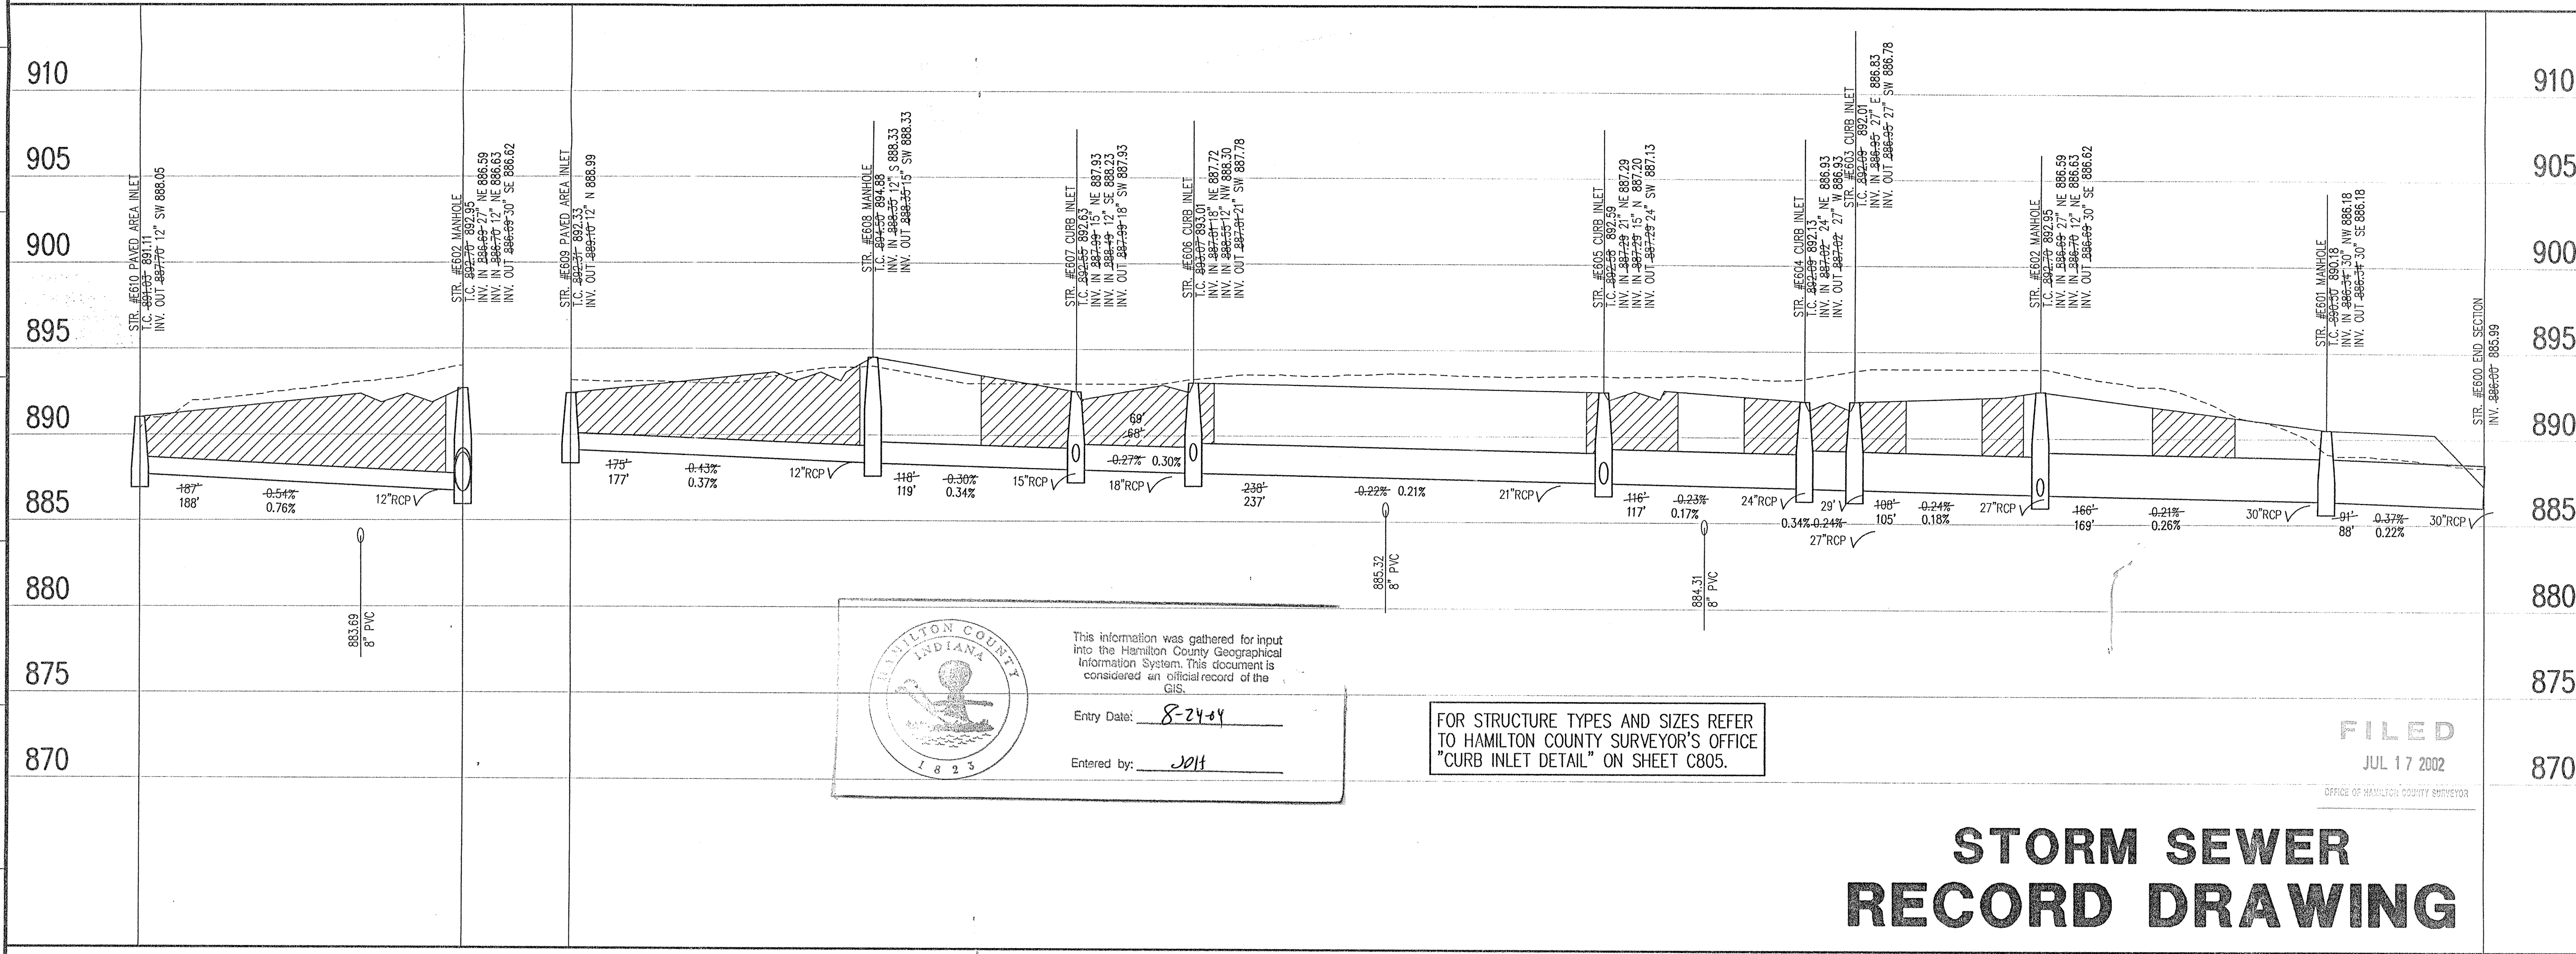

CERTIFICATION FOR "RECORD DRAWING"

NOTE:
 Record drawing certification only for top of casting, invert elevations and lengths of pipe. Slope percentage represents a calculated figure and is for general information only.

DATE: 10/15/01

CERTIFIED BY:

THIS DRAWING AND THE IDEAS, DESIGNS AND CONCEPTS CONTAINED HEREIN ARE THE EXCLUSIVE INTELLECTUAL PROPERTY OF THE SCHNEIDER CORPORATION AND ARE NOT TO BE USED OR REPRODUCED IN WHOLE OR IN PART, WITHOUT THE WRITTEN CONSENT OF THE SCHNEIDER CORPORATION.

1999, The Schneider Corporation

The Schneider Corporation

12726 Hamilton Crossing Blvd. Engineering
 Carmel, Indiana Surveying
 46032 Landscape Architecture
 317-574-3797 GIS + LIS
 317-574-3799 Fax Geology

Formerly Schneider Engineering Corp. / Bohlen, Meyer, Gibson & Assoc.

BRENNICK DEVELOPMENT CO.
 Village of WestClay
 Section 5006


STORM SEWER PLAN

Date	Project No.	Drawn	MC	Approv.
09/17/99	1238.5006			
Computer Files	Sheet No.			
4:\1238\5006\DWG\C601.DWG XREF: 5006ABS.DWG, 5006BBS.DWG XREF: 5001-BS.DWG, 5001BBS.DWG XREF: 1001BS.DWG	C601			


STORM SEWER RECORD DRAWING

FILED
 JUL 17 2002
 OFFICE OF HAMILTON COUNTY SURVEYOR

STORM SEWER PROFILE

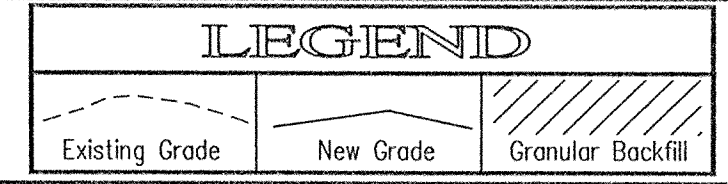


SCALE: HORZ.: 1"=50'
 VERT.: 1"=5'

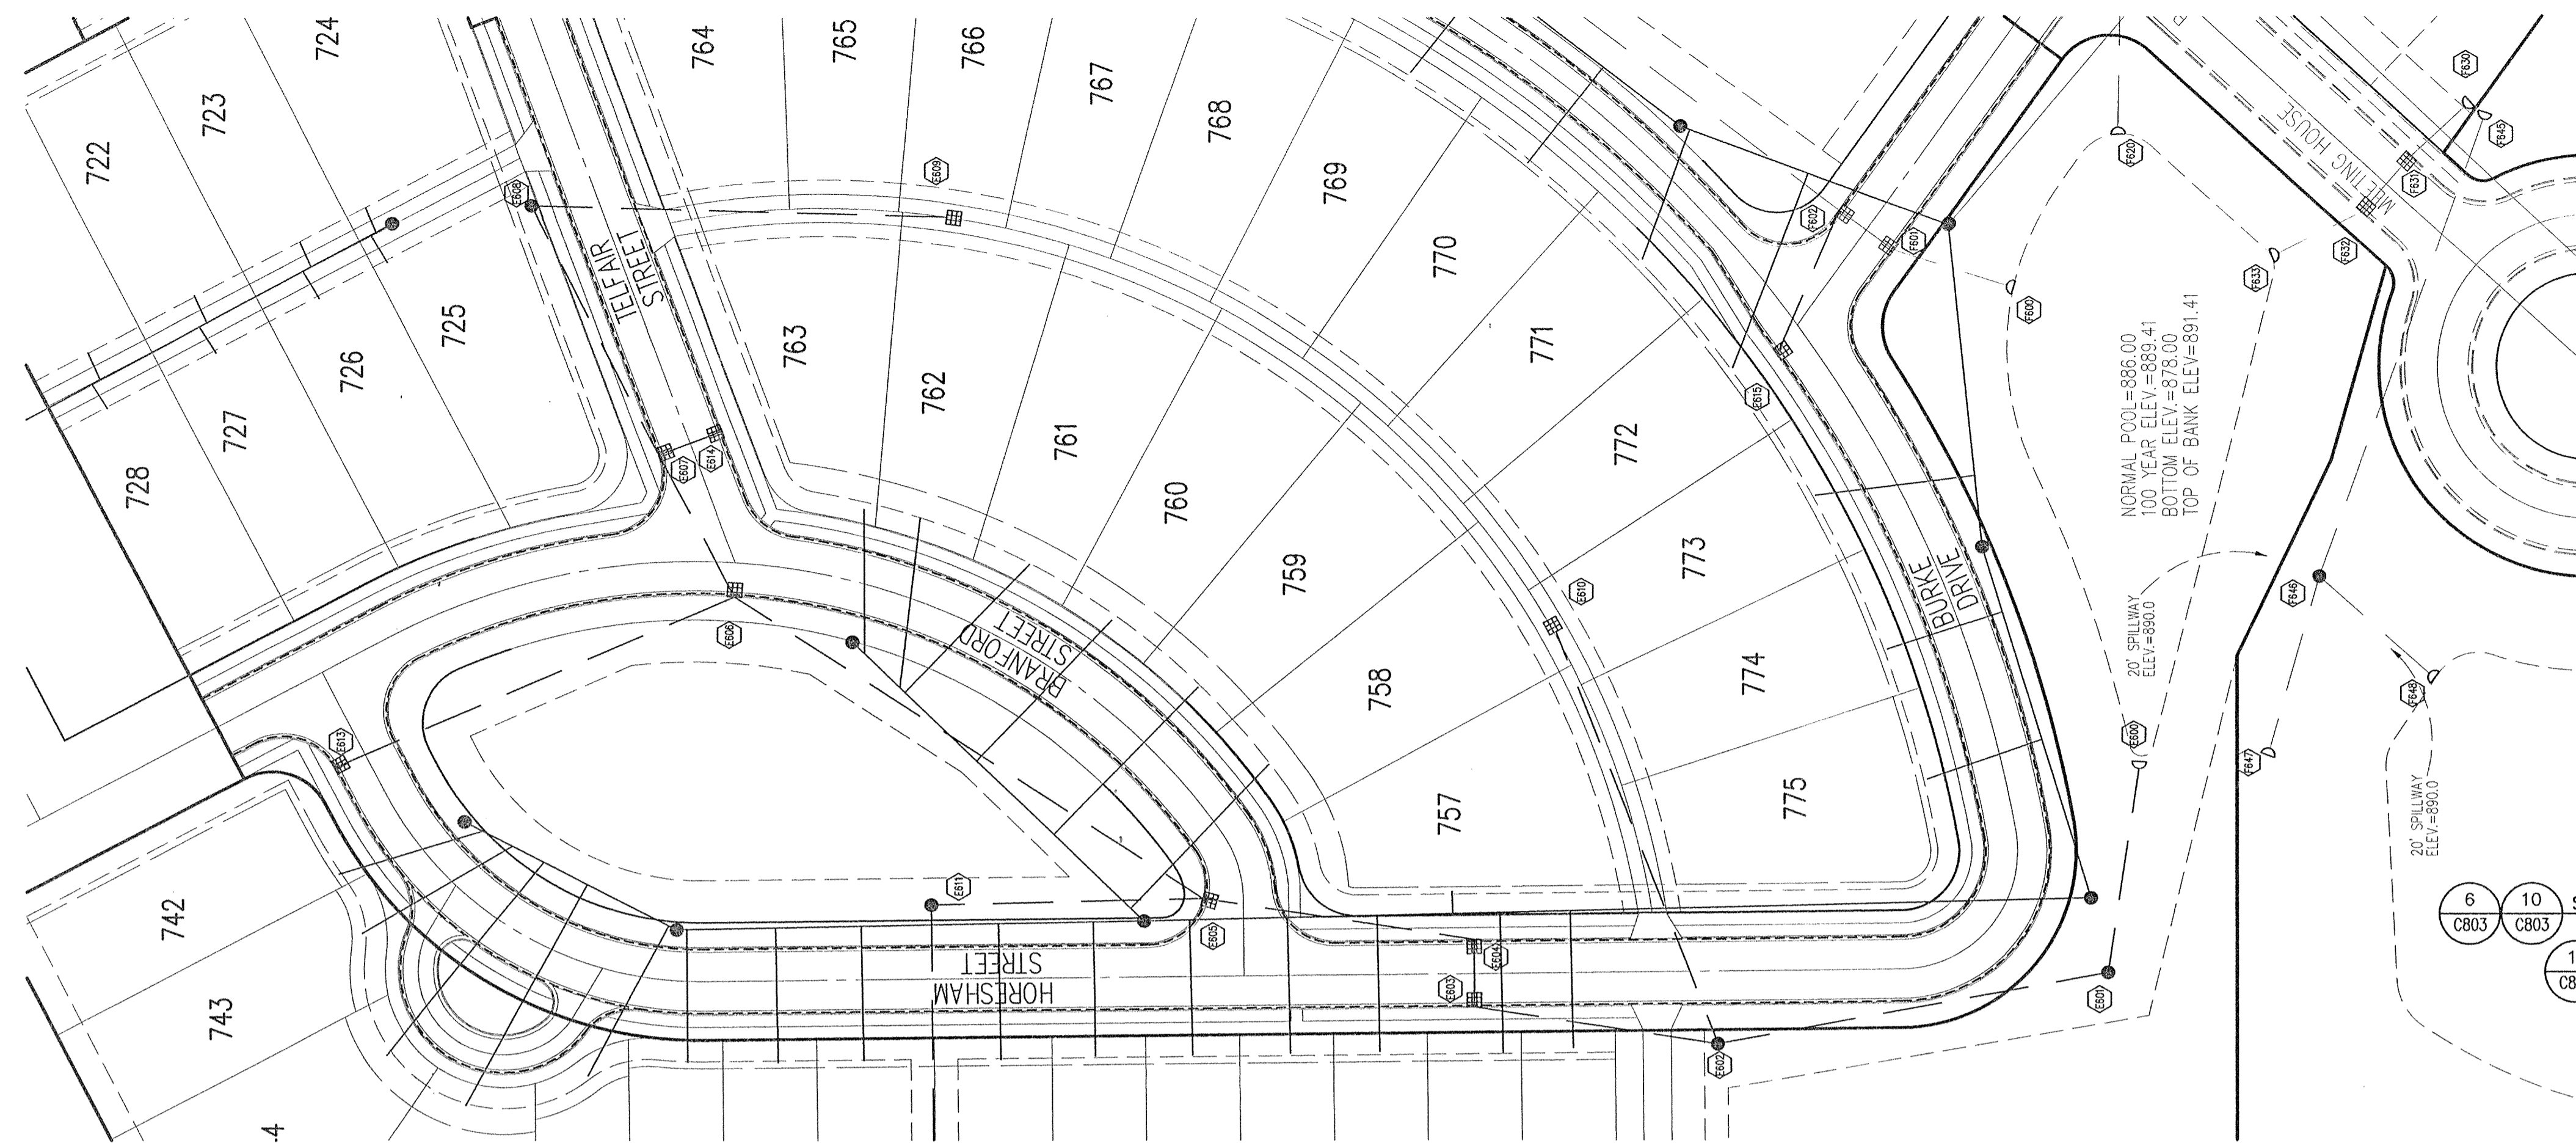

HOLEY MOLEY SAYS
"DON'T DIG BLIND"

"IT'S THE LAW"
 CALL 2 WORKING DAYS BEFORE YOU DIG
1-800-382-5544
 CALL TOLL FREE
 PER INDIANA STATE LAW IS-69-1991,
 IT IS AGAINST THE LAW TO EXCAVATE
 WITHOUT NOTIFYING THE UNDERGROUND
 LOCATION SERVICE TWO (2) WORKING
 DAYS BEFORE COMMENCING WORK.

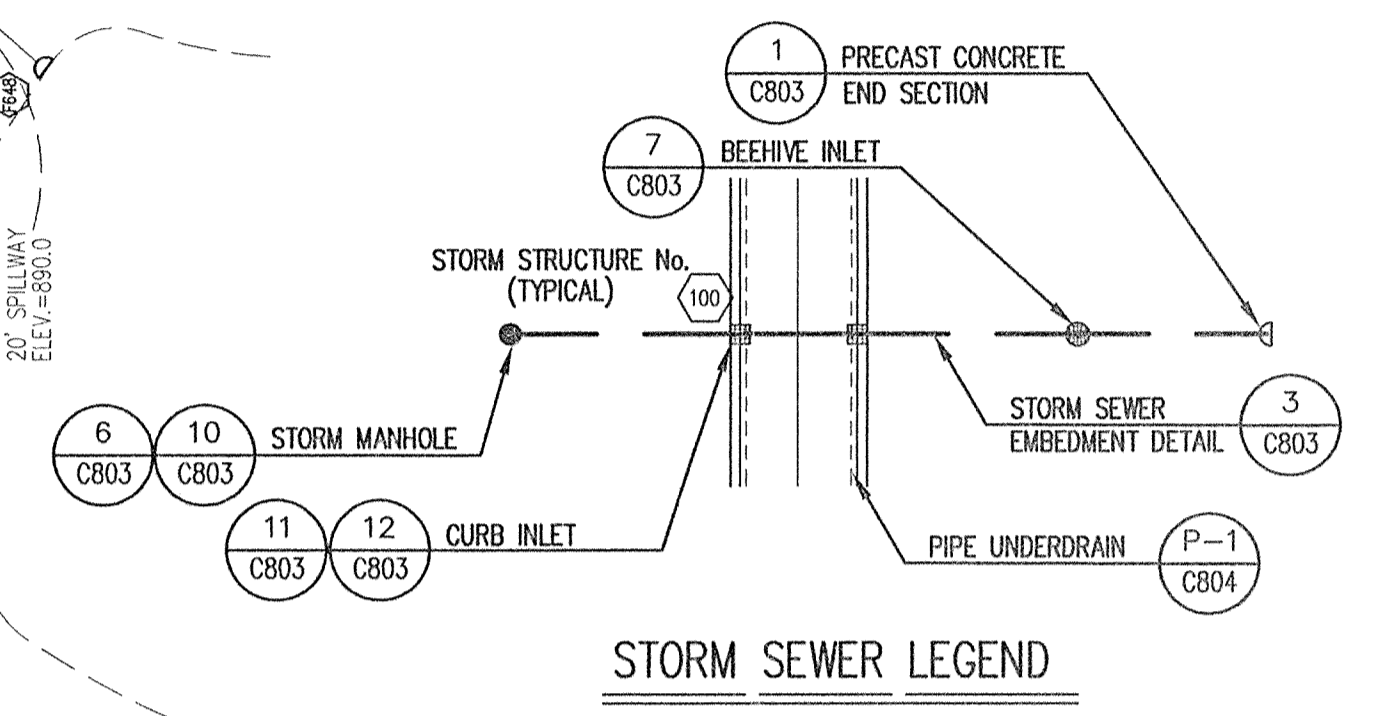

STORM SEWER PLAN

SCALE: 1"=50'


GENERAL NOTES

1. TEMPORARY TRAFFIC CONTROL DURING CONSTRUCTION TO CONFORM TO APPLICABLE LOCAL AND STATE STANDARDS.
2. ALL CONSTRUCTION ACTIVITY ON THIS SITE TO BE PERFORMED IN COMPLIANCE WITH APPLICABLE O.S.H.A. STANDARDS FOR WORKER SAFETY.
3. IT SHALL BE THE CONTRACTORS RESPONSIBILITY TO FIELD VERIFY ALL UTILITY LOCATIONS BEFORE CONSTRUCTION BEGINS.
4. CONTRACTORS SHALL MINIMIZE DAMAGE TO EXISTING TREES.

BENCHMARK

TBM #44
 USGS BENCHMARK
 CUT "X" NORTH BONNET BOLT IN FIRE HYDRANT
 EAST SIDE HOOVER RD. ±100' SOUTH OF CLARIDGE
 FARM ENTRANCE.
 ELEVATION - 893.39


- Revisions
1. DEC 11/2/99; REVISED PER TAC COMMENTS.
 2. BET. 1/27/00; REVISED PER COUNTY SURVEYOR'S COMMENTS.
 3. MG. 6/4/01; UPDATED E602-E610 & E608-E609 PER LOT REVISIONS.
 4. BET. 08/20/01; "RECORD DRAWING"

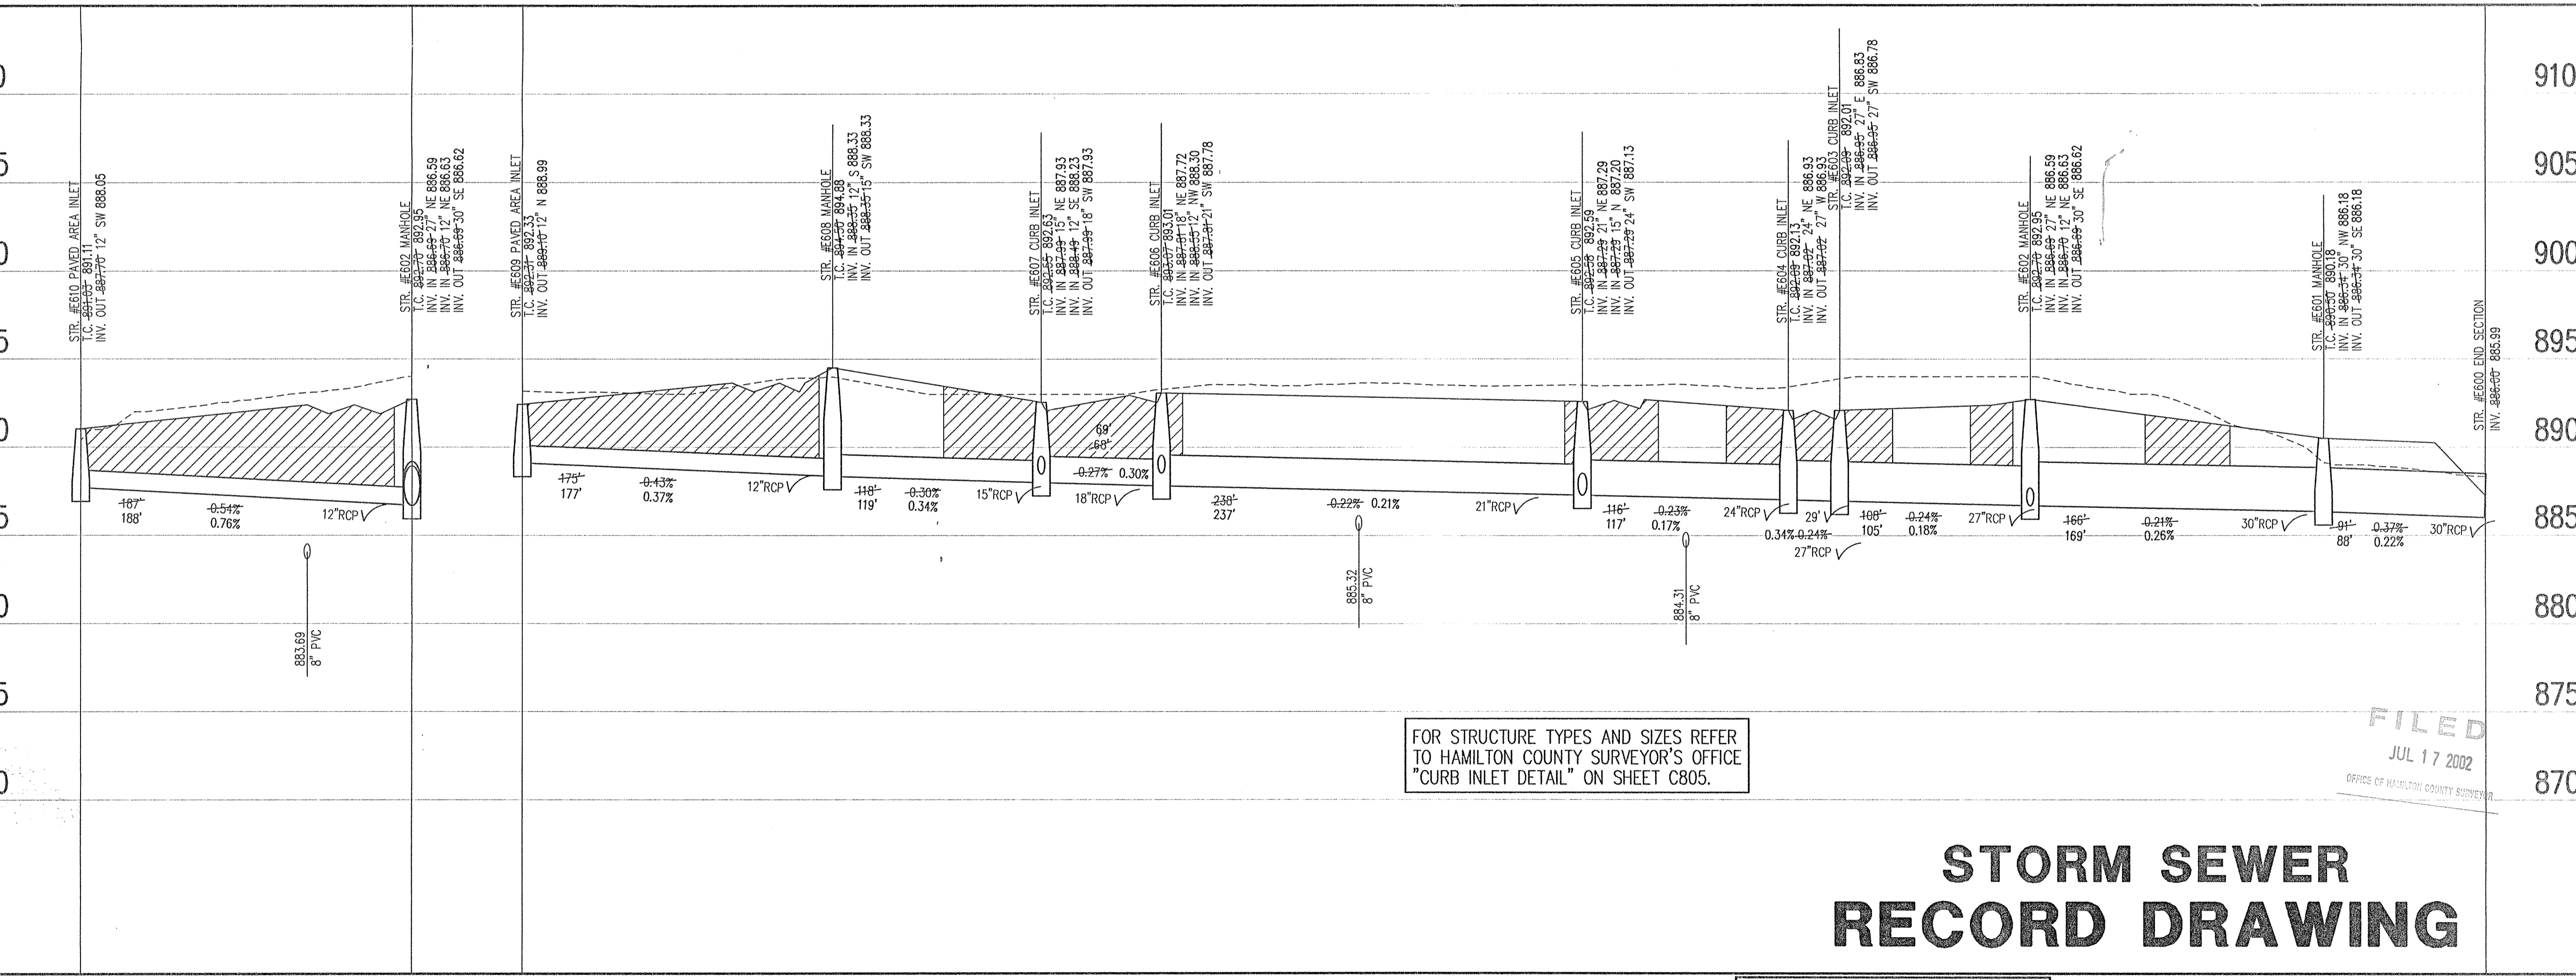

FOR STRUCTURE TYPES AND SIZES REFER TO HAMILTON COUNTY SURVEYOR'S OFFICE "CURB INLET DETAIL" ON SHEET C805.


STORM SEWER RECORD DRAWING

SCALE: HORIZ.: 1"=50'
 VERT.: 1"=5'

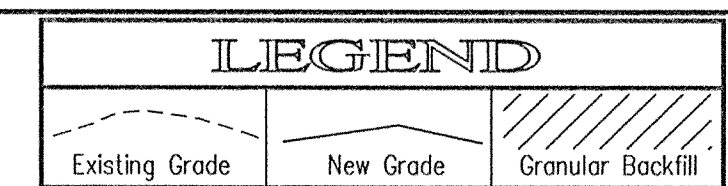

CERTIFICATION FOR "RECORD DRAWING"

NOTE:
 Record drawing certification only for top of casing, invert elevations and lengths of pipe. Slope percentage represents a calculated figure and is for general information only.

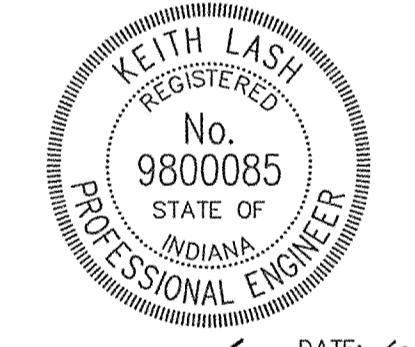

DATE: 10/17/01
 CERTIFIED BY: [Signature]

THIS DRAWING AND THE IDEAS, DESIGNS AND CONCEPTS CONTAINED HEREIN ARE THE EXCLUSIVE INTELLECTUAL PROPERTY OF THE SCHNEIDER CORPORATION AND ARE NOT TO BE USED OR REPRODUCED IN WHOLE OR IN PART, WITHOUT THE WRITTEN CONSENT OF THE SCHNEIDER CORPORATION.

1999, The Schneider Corporation



12726 Hamilton Crossing Blvd. Engineering
 Carmel, Indiana Surveying
 46032 Landscape Architecture
 317-574-3797 GIS + LIS
 317-574-3799 Fax Geology

Formerly Schneider Engineering Corp. / Bohlen, Meyer, Gibson & Assoc.

BRENNICK DEVELOPMENT CO.
 Village of WestClay
 Section 5006

STORM SEWER PLAN

Date	Project No.	Drawn	Apprv.
09/17/99	1238.5006	MG	

Computer Files	Sheet No.
1238.5006.DWG/C801.DWG 5006.RS.DWG, 5006.RS.DWG S01-RS.DWG, S001S.DWG 1001S.DWG	C601

STORM SEWER PROFILE

GENERAL NOTES

- TEMPORARY TRAFFIC CONTROL DURING CONSTRUCTION TO CONFORM TO APPLICABLE LOCAL AND STATE STANDARDS.
- ALL CONSTRUCTION ACTIVITY ON THIS SITE TO BE PERFORMED IN COMPLIANCE WITH APPLICABLE O.S.H.A. STANDARDS FOR WORKER SAFETY.
- IT SHALL BE THE CONTRACTORS RESPONSIBILITY TO FIELD VERIFY ALL UTILITY LOCATIONS BEFORE CONSTRUCTION BEGINS.
- CONTRACTORS SHALL MINIMIZE DAMAGE TO EXISTING TREES.


HOLEY MOLEY SAYS
"DON'T DIG BLIND"

"IT'S THE LAW"
 CALL 2 WORKING DAYS BEFORE YOU DIG
1-800-382-5544
 CALL TOLL FREE
 PER INDIANA STATE LAW IS-69-1991, IT IS AGAINST THE LAW TO EXCAVATE WITHOUT NOTIFYING THE UNDERGROUND LOCATION SERVICE TWO (2) WORKING DAYS BEFORE COMMENCING WORK.

BENCHMARK


TBM #44
 USGS BENCHMARK
 CUT "X" NORTH BONNET BOLT IN FIRE HYDRANT
 EAST SIDE HOOVER RD. ±100' SOUTH OF CLARIDGE FARM ENTRANCE.
 ELEVATION - 893.39

- Revisions
- DCC 11/2/99, REVISED PER TAC COMMENTS.
 - BET. 1/27/00, REVISED PER COUNTY SURVEYOR'S COMMENTS.
 - MG. 6/4/01, UPDATED 8905-8912 PER LOT REVISIONS.
 - EBL 8/4/01, UPDATED 8912 T.C. PER ALLEY REVISIONS.
 - BET. 08/20/01, "RECORD DRAWING"

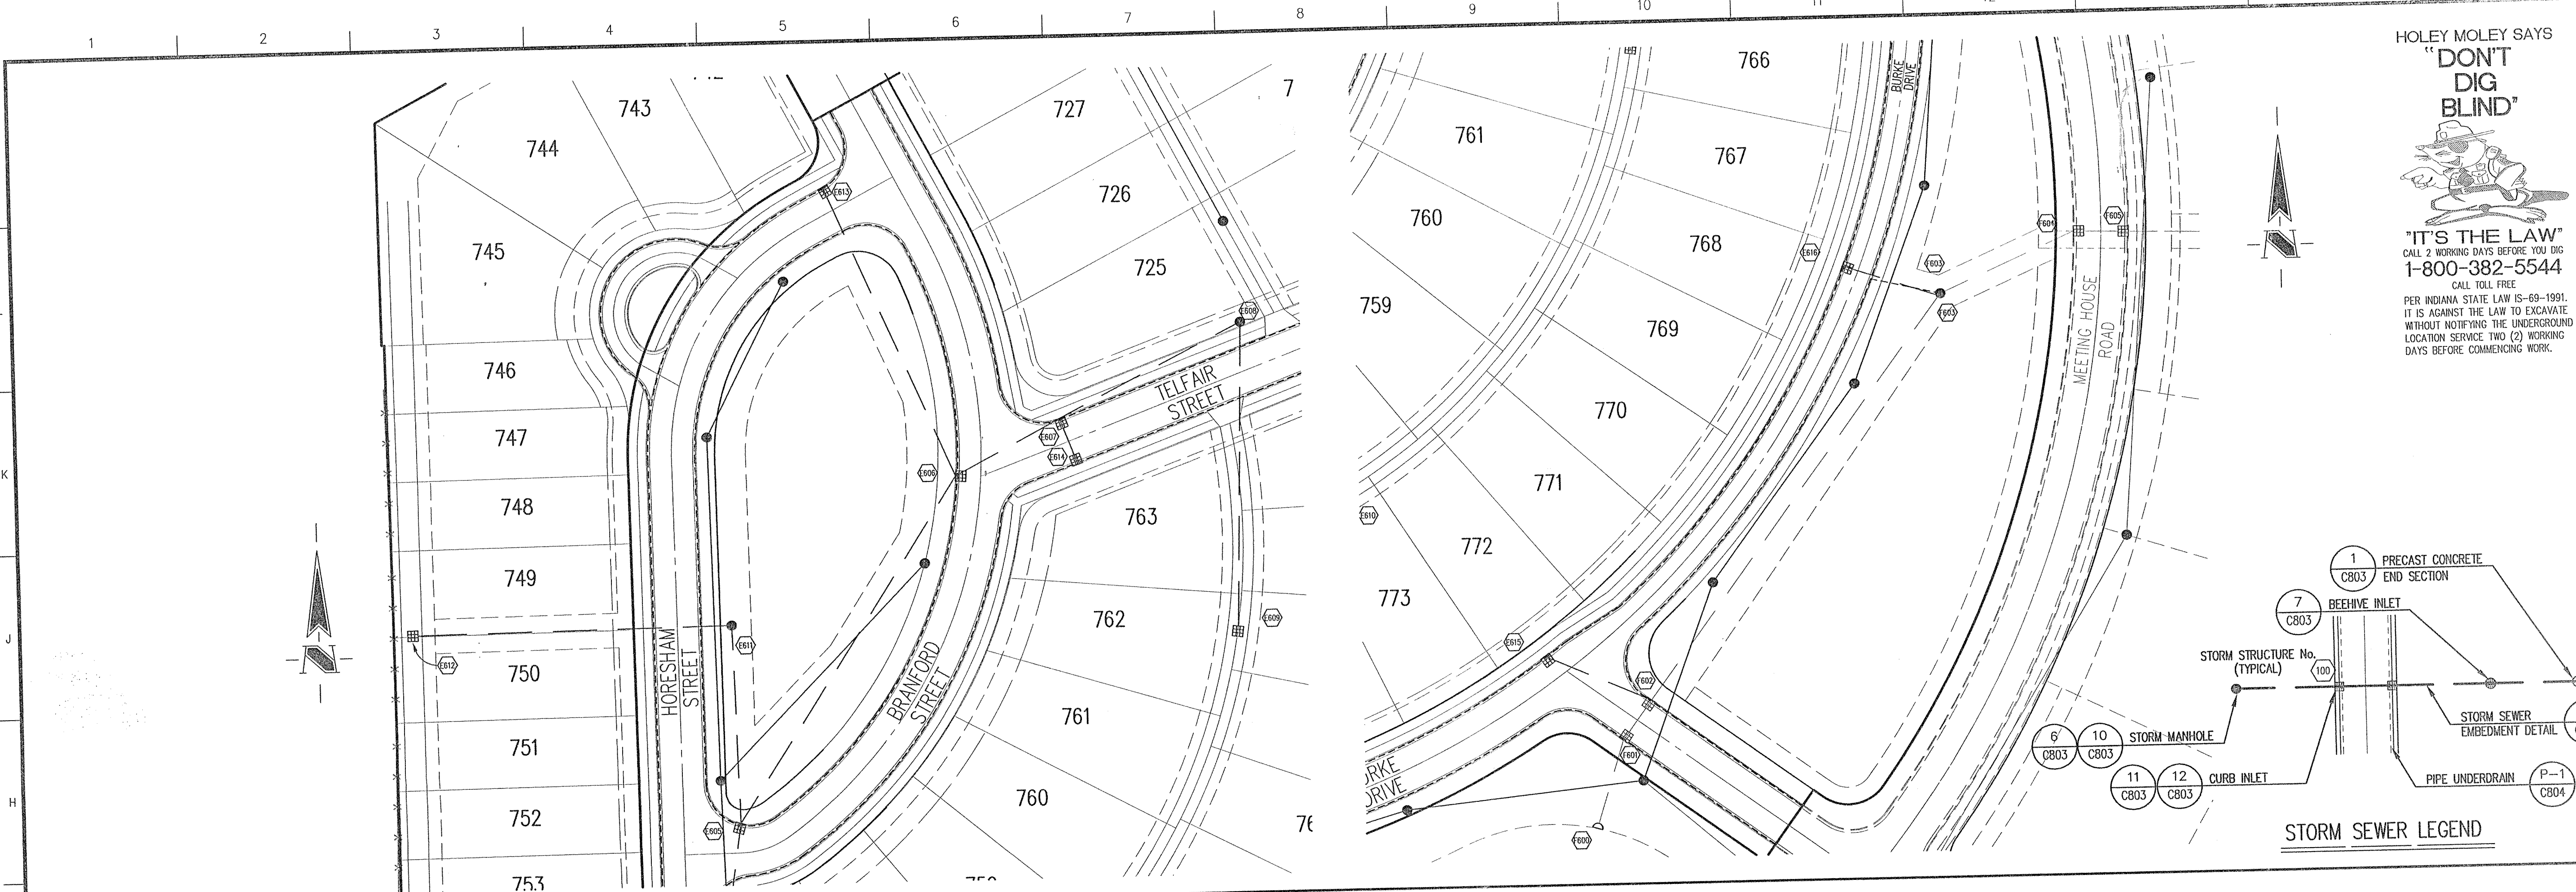

STORM SEWER PLAN

SCALE: 1"=50'

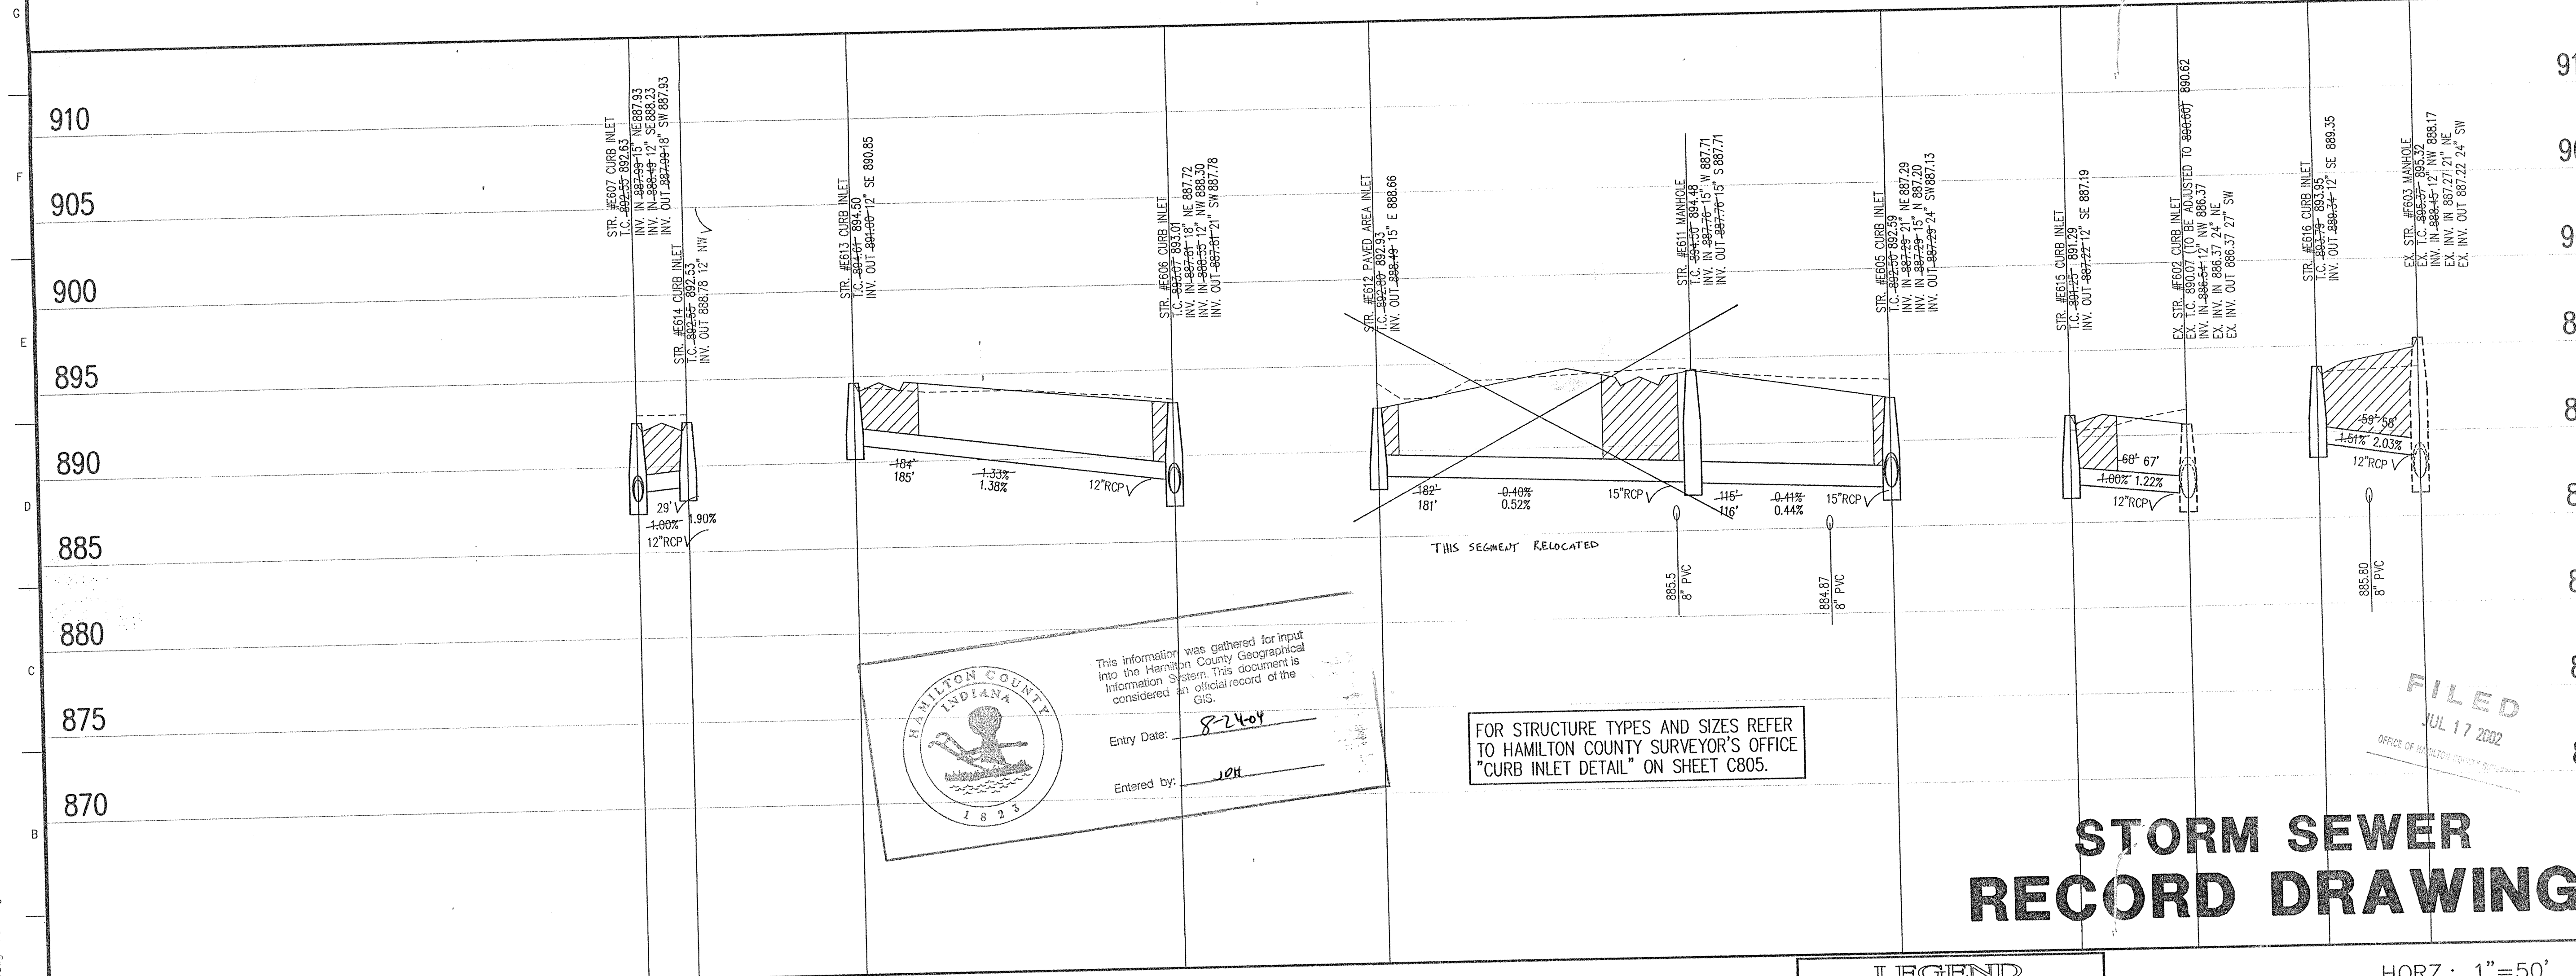

STORM SEWER PROFILE

STORM SEWER RECORD DRAWING

LEGEND

	Existing Grade
	New Grade
	Granular Backfill

SCALE: HORIZ.: 1"=50'
 VERT.: 1"=5'

CERTIFICATION FOR "RECORD DRAWING"

NOTE:
 Record drawing certification only for top of casting, invert elevations and lengths of pipe. Slope percentage represents a calculated figure and is for general information only.



CERTIFIED BY:  DATE: 10/5/01

THIS DRAWING AND THE IDEAS, DESIGNS AND CONCEPTS CONTAINED HEREIN ARE THE EXCLUSIVE INTELLECTUAL PROPERTY OF THE SCHNEIDER CORPORATION AND ARE NOT TO BE USED OR REPRODUCED IN WHOLE OR IN PART, WITHOUT THE WRITTEN CONSENT OF THE SCHNEIDER CORPORATION.



12726 Hamilton Crossing Blvd. Engineering
 Carmel, Indiana 46032 Surveying
 317-574-3797 Landscape Architecture
 317-574-3799 Fax GIS + LIS
 Geology

Formerly Schneider Engineering Corp. / Bohlen, Meyer, Gibson & Assoc.

BRENWICK DEVELOPMENT CO.
 Village of WestClay
 Section 5006

STORM SEWER PLAN

Date	Project No.	Drawn	Appr.
09/17/99	1238.5006	MC	

Computer Files	Sheet No.
1: V:\2381\5006\DWG\C602.DWG XREF: 5006BAS.DWG, 5006BBS.DWG XREF: 5006-BS.DWG, 5006BBS.DWG XREF: 1001BS.DWG	C602



1:2381\5006\DWG\C602.dwg Mon Aug 27 14:12:14 2001

GENERAL NOTES

1. TEMPORARY TRAFFIC CONTROL DURING CONSTRUCTION TO CONFORM TO APPLICABLE LOCAL AND STATE STANDARDS.
2. ALL CONSTRUCTION ACTIVITY ON THIS SITE TO BE PERFORMED IN COMPLIANCE WITH APPLICABLE O.S.H.A. STANDARDS FOR WORKER SAFETY.
3. IT SHALL BE THE CONTRACTORS RESPONSIBILITY TO FIELD VERIFY ALL UTILITY LOCATIONS BEFORE CONSTRUCTION BEGINS.
4. CONTRACTORS SHALL MINIMIZE DAMAGE TO EXISTING TREES.

HOLEY MOLEY SAYS
"DON'T DIG BLIND"

"IT'S THE LAW"
 CALL 2 WORKING DAYS BEFORE YOU DIG
1-800-382-5544
 CALL TOLL FREE
 PER INDIANA STATE LAW IS-69-1991, IT IS AGAINST THE LAW TO EXCAVATE WITHOUT NOTIFYING THE UNDERGROUND LOCATION SERVICE TWO (2) WORKING DAYS BEFORE COMMENCING WORK.

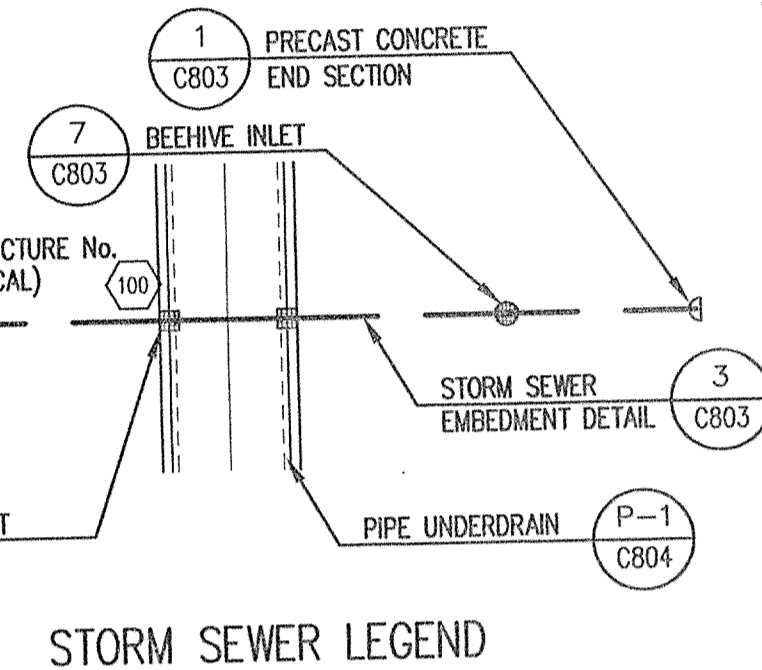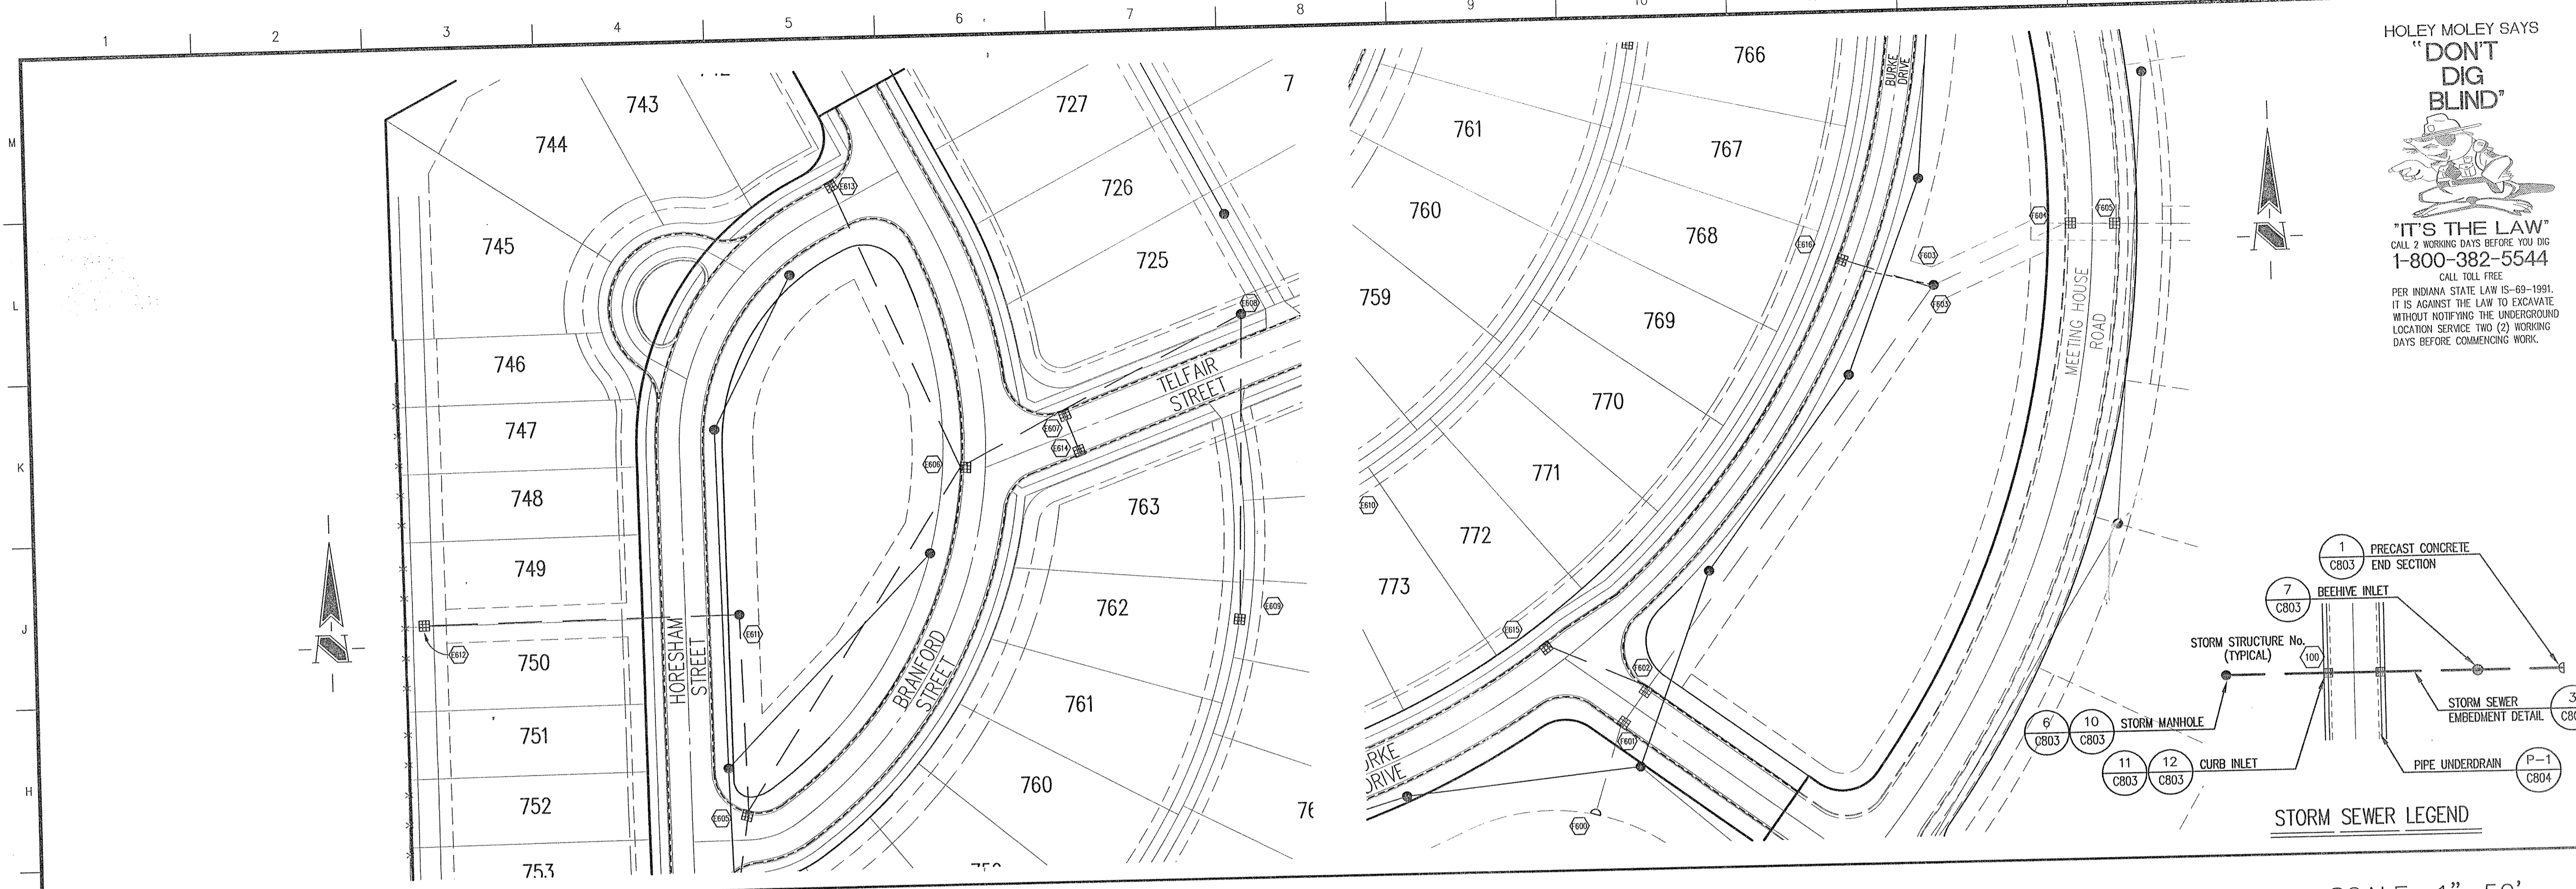

BENCHMARK

TBM #44
 USGS BENCHMARK
 CUT "X" NORTH BONNET BOLT IN FIRE HYDRANT
 EAST SIDE HOOVER RD. ±100' SOUTH OF CLARIDGE FARM ENTRANCE.
 ELEVATION - 893.39


- Revisions
1. DEC 11/2/99, REVISED PER TAC COMMENTS.
 2. BET. 1/27/00, REVISED PER COUNTY SURVEYOR'S COMMENTS.
 3. MS 6/4/01, UPDATED E805-E812 PER LOT REVISIONS.
 5. DTB, 6/3/01, UPDATED E812 T.C. PER ALLEY REVISIONS.
 6. BET. 08/20/01, "RECORD DRAWING"

STORM SEWER PLAN

SCALE: 1"=50'


CERTIFICATION FOR "RECORD DRAWING"

NOTE:
 Record drawing certification only for top of casting, invert elevations and lengths of pipe. Slope percentage represents a calculated figure and is for general information only.

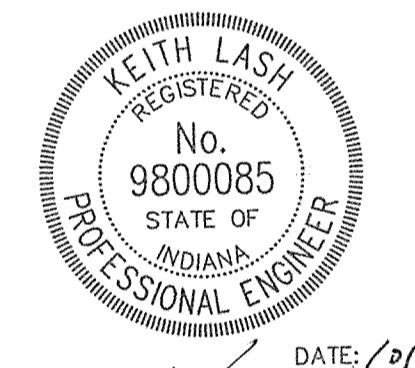

CERTIFIED BY: *[Signature]* DATE: 7/25/02

THIS DRAWING AND THE IDEAS, DESIGNS AND CONCEPTS CONTAINED HEREIN ARE THE EXCLUSIVE INTELLECTUAL PROPERTY OF THE SCHNEIDER CORPORATION AND ARE NOT TO BE USED OR REPRODUCED IN WHOLE OR IN PART, WITHOUT THE WRITTEN CONSENT OF THE SCHNEIDER CORPORATION.

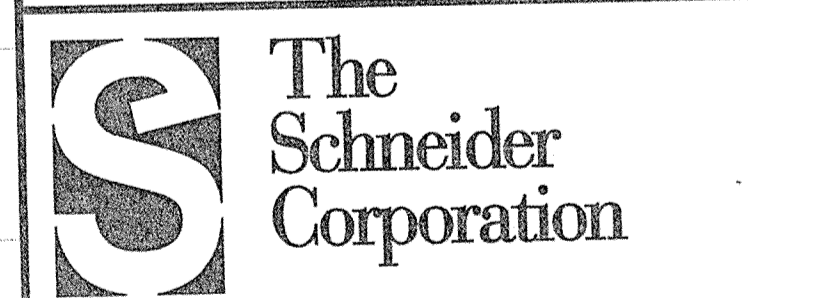


12726 Hamilton Crossing Blvd. Engineering
 Carmel, Indiana 46032 Surveying
 317-574-3797 Landscape Architecture
 317-574-3799 Fax GIS + LIS
 Geology
 Formerly Schneider Engineering Corp. / Dohlen, Meyer, Gibson & Assoc.

BRENNICK DEVELOPMENT CO.
 Village of WestClay
 Section 5006

STORM SEWER PLAN

Date	Project No.	Drawn	MG	Approv.
09/17/99	1238.5006			

Computer Files	Sheet No.
A:\V238\5006\DWGS\C602.DWG XREF: 5006A.DWG, 5006B.DWG XREF: 5006C.DWG, 5006D.DWG XREF: 1001B.DWG	C602

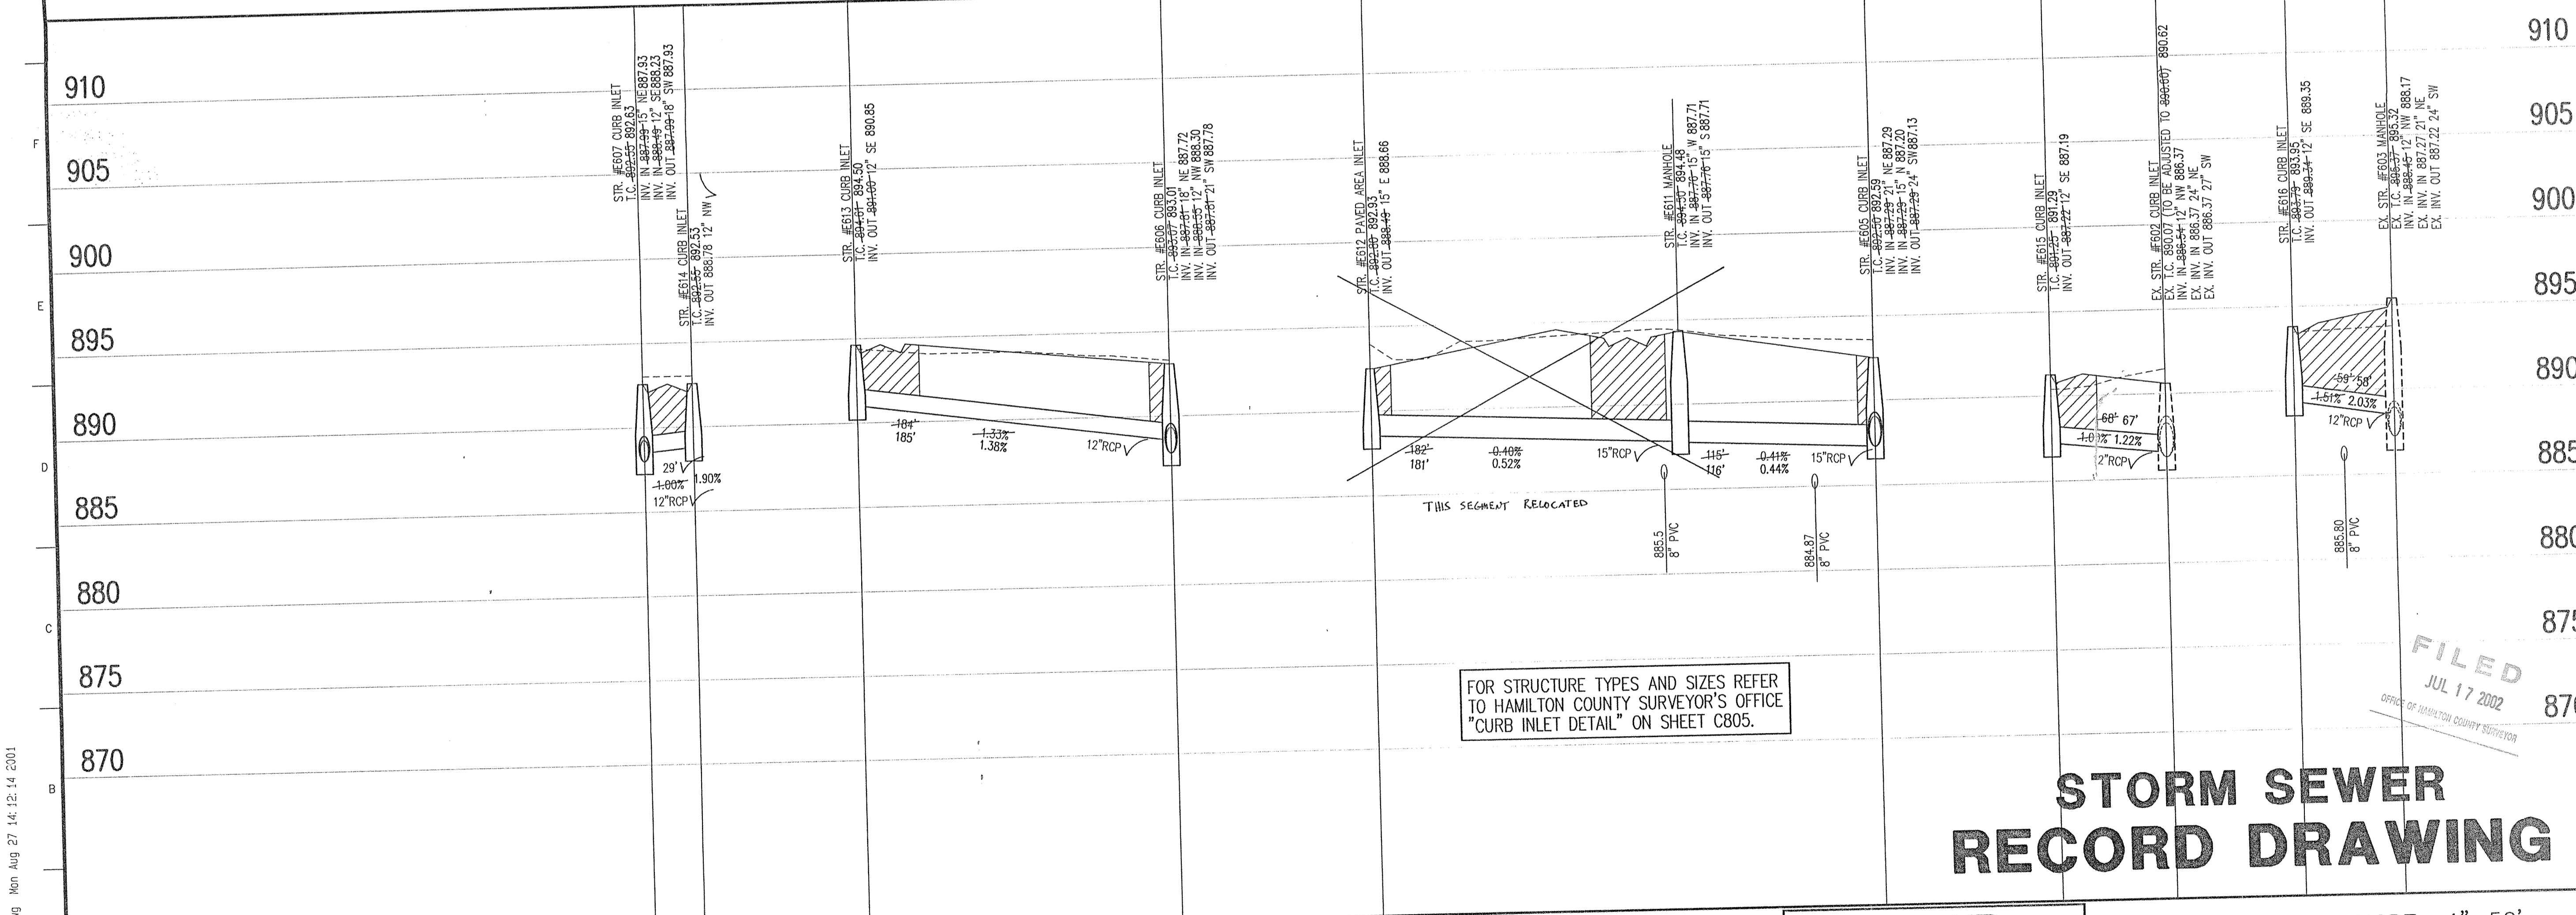

FOR STRUCTURE TYPES AND SIZES REFER TO HAMILTON COUNTY SURVEYOR'S OFFICE "CURB INLET DETAIL" ON SHEET C805.

STORM SEWER RECORD DRAWING

SCALE: HORIZ.: 1"=50'
 VERT.: 1"=5'

LEGEND

	Existing Grade
	New Grade
	Granular Backfill

STORM SEWER PROFILE

12385006\DWGS\C602.dwg Mon Aug 27 14:12:14 2001

HOLEY MOLEY SAYS
**"DON'T
 DIG
 BLIND"**




"IT'S THE LAW"
 CALL 2 WORKING DAYS BEFORE YOU DIG
1-800-382-5544
 CALL TOLL FREE
 PER INDIANA STATE LAW IS-69-1991,
 IT IS AGAINST THE LAW TO EXCAVATE
 WITHOUT NOTIFYING THE UNDERGROUND
 LOCATION SERVICE TWO (2) WORKING
 DAYS BEFORE COMMENCING WORK.

GENERAL NOTES

1. TEMPORARY TRAFFIC CONTROL DURING CONSTRUCTION TO CONFORM TO APPLICABLE LOCAL AND STATE STANDARDS.
2. ALL CONSTRUCTION ACTIVITY ON THIS SITE TO BE PERFORMED IN COMPLIANCE WITH APPLICABLE O.S.H.A. STANDARDS FOR WORKER SAFETY.
3. IT SHALL BE THE CONTRACTORS RESPONSIBILITY TO FIELD VERIFY ALL UTILITY LOCATIONS BEFORE CONSTRUCTION BEGINS.
4. CONTRACTORS SHALL MINIMIZE DAMAGE TO EXISTING TREES.

BENCHMARK


TBM #44
 USGS BENCHMARK
 CUT "X" NORTH BONNET BOLT IN FIRE HYDRANT
 EAST SIDE HOOVER RD. ±100' SOUTH OF CLARIDGE
 FARM ENTRANCE.
 ELEVATION - 893.39

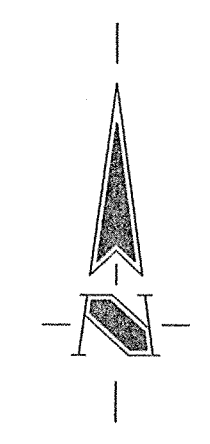

**CERTIFICATION FOR
 "RECORD DRAWING"**

NOTE:
 Record drawing certification only for top of casting, invert elevations and lengths of pipe. Slope percentage represents a calculated figure and is for general information only.

REVISIONS:
 1. BET. 4/10/02, RECORD DRAWING



DATE: 4/15/02
 THIS DRAWING AND THE IDEAS, DESIGNS AND CONCEPTS CONTAINED HEREIN ARE THE EXCLUSIVE INTELLECTUAL PROPERTY OF THE SCHNEIDER CORPORATION, AND ARE NOT TO BE USED OR REPRODUCED, IN WHOLE OR IN PART, WITHOUT THE WRITTEN CONSENT OF THE SCHNEIDER CORPORATION.
 © COPYRIGHTED BY THE SCHNEIDER CORP. (2001)




Schneider

THE SCHNEIDER CORPORATION
 12821 E. New Market Street
 Suite 100
 Carmel, IN 46032
 Telephone: 317.569.8112
 Fax: 317.826.6410
 www.schneidercorp.com

Architecture
 Civil Engineering
 Environmental Engineering
 Geotechnical Services
 GIS * LIS
 Home Builder Services
 Interior Design
 Land Surveying
 Landscape Architecture
 Transportation Engineering


Village of WestClay
 Section 5006B
 CARMEL, INDIANA
 BRENNICK DEVELOPMENT CO.
 CARMEL, INDIANA

DATE: 12/12/01	PROJECT NO.: 1238.5006
DRAWN BY: DCC	CHECKED BY:
SHEET TITLE: STORM SEWER RECONFIGURATION PLAN	
DRAWING FILES: N:\238\5006\DWG\EXHIB002.DWG REF: 5006AS.DWG REF: 5006BS.DWG	
SHEET NO.: 1	

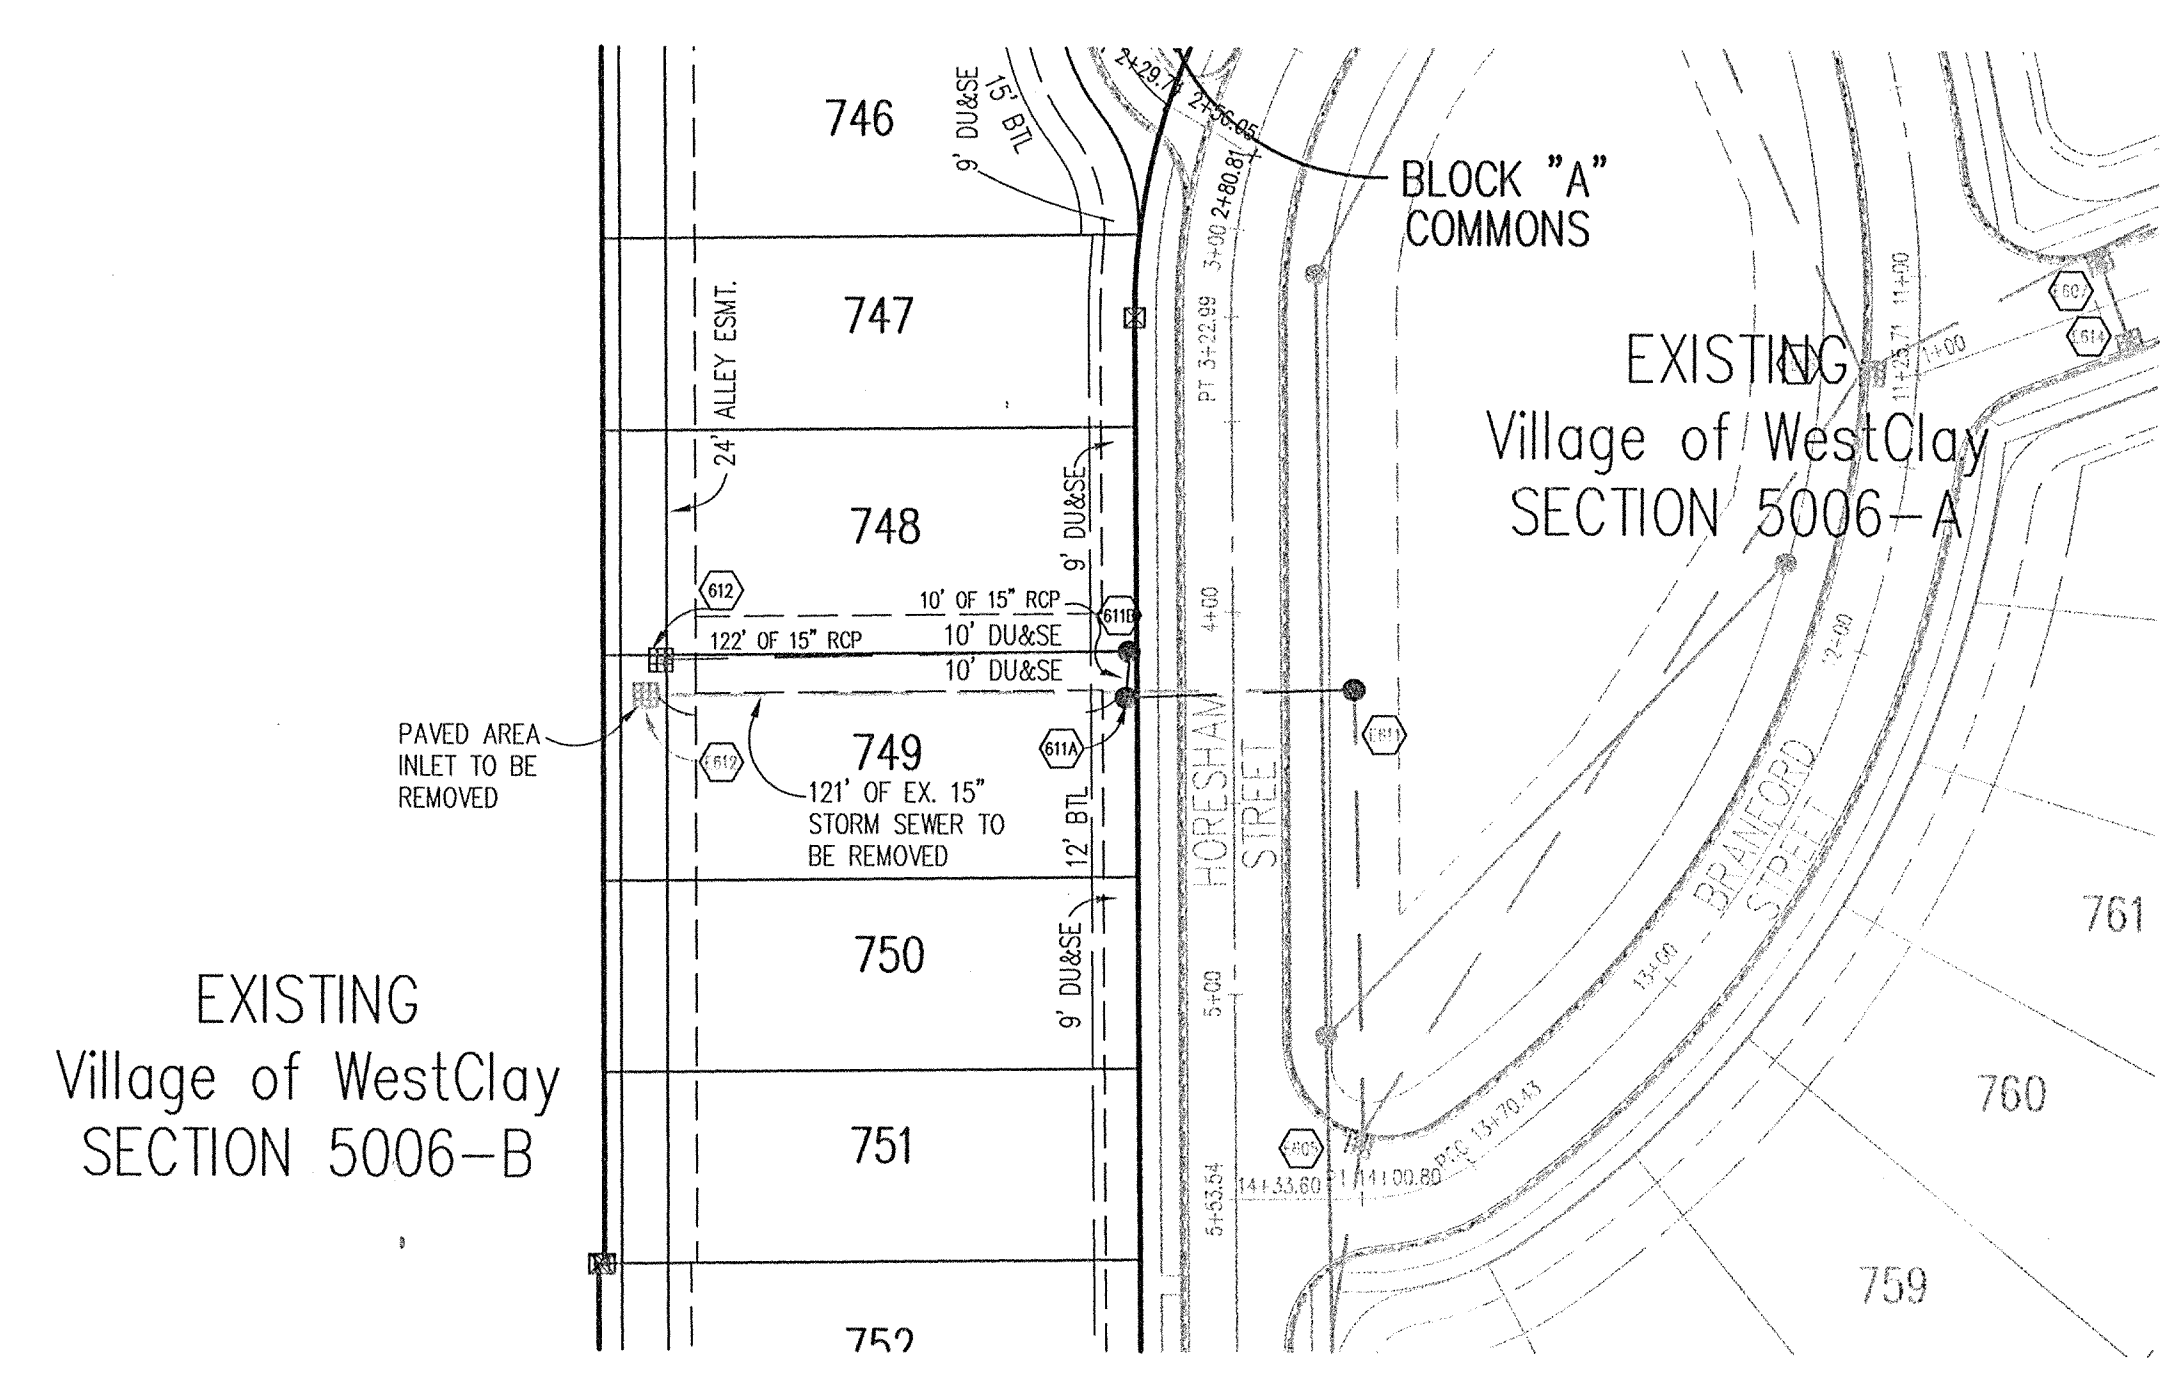


STORM SEWER PLAN

SCALE: 1"=50'

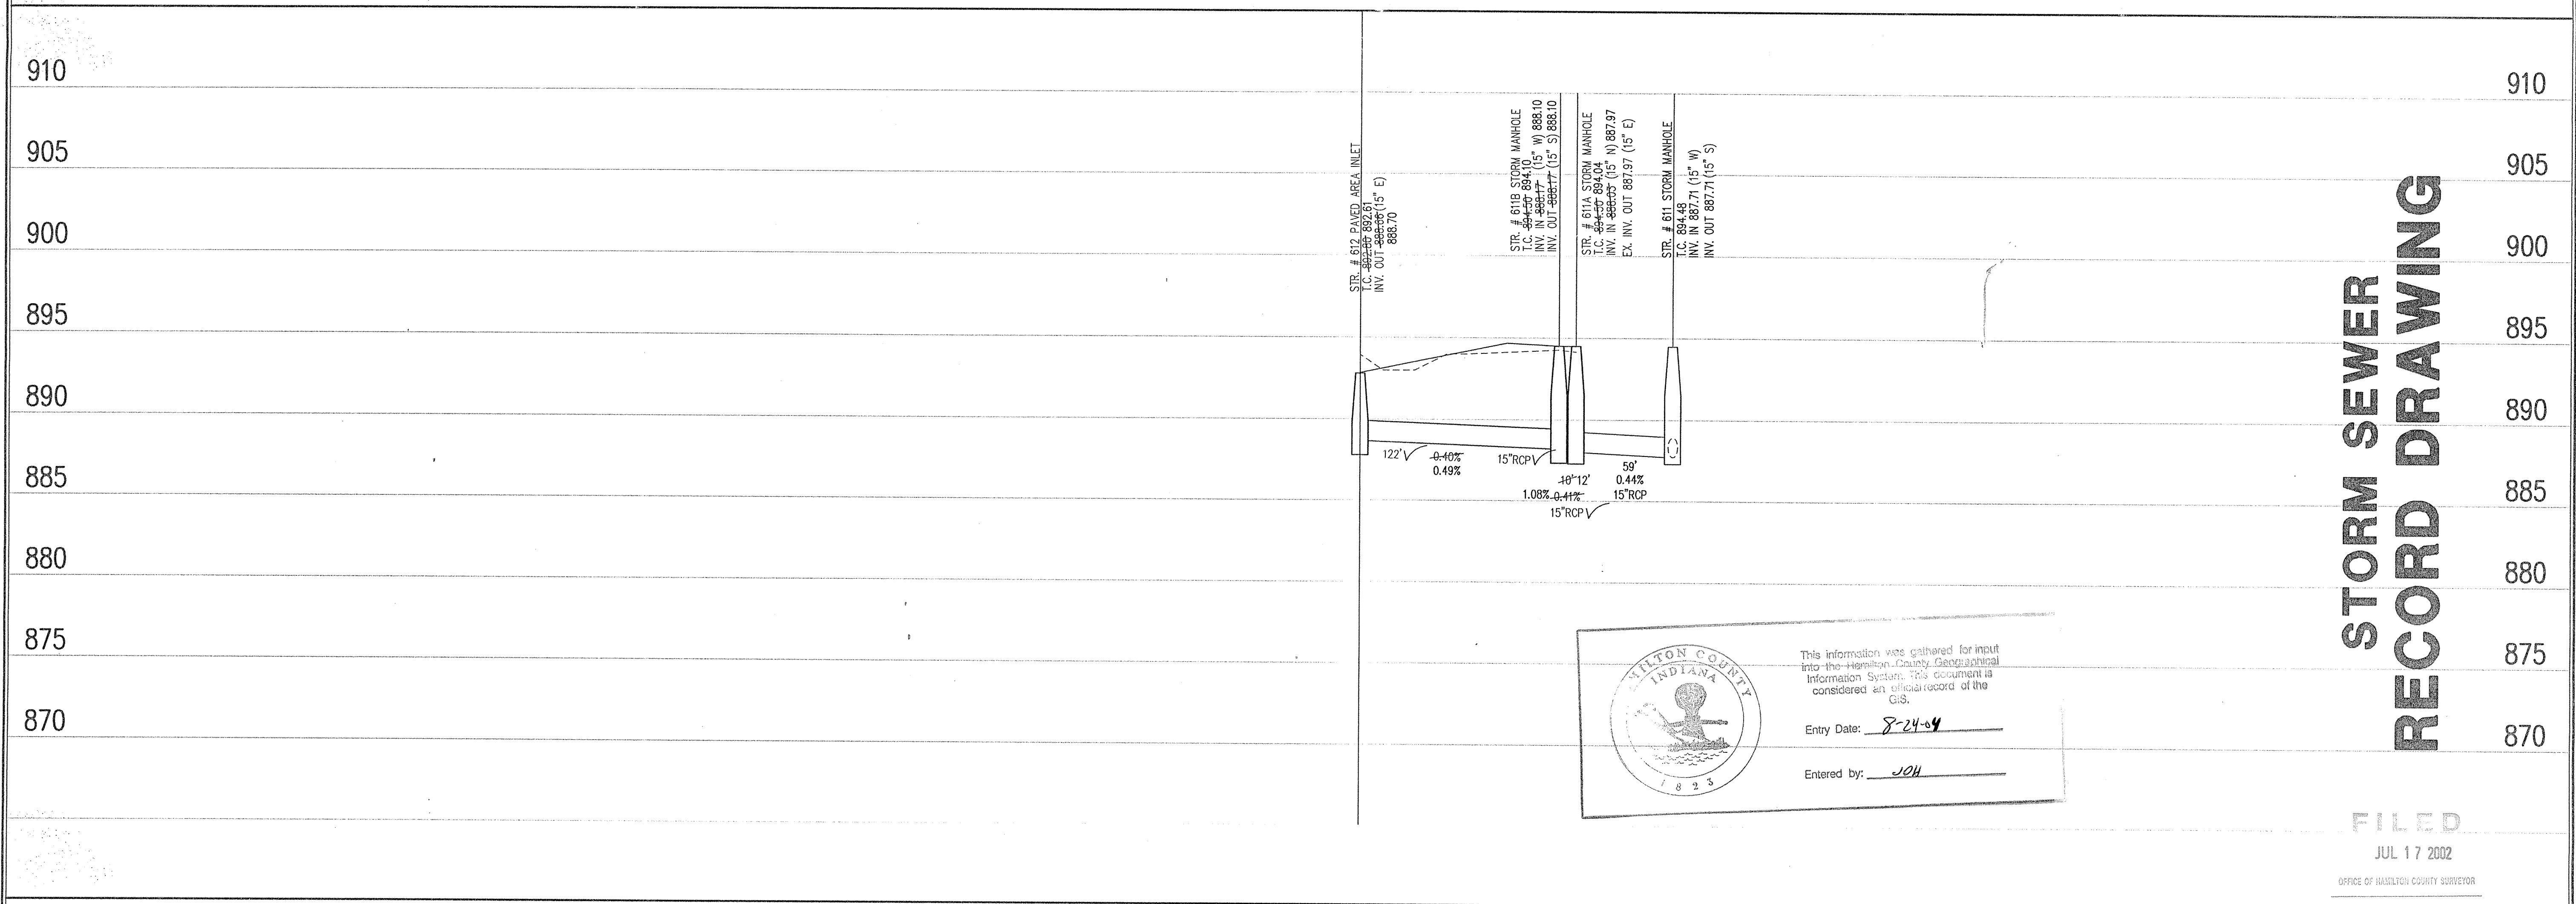

**STORM SEWER
 RECORD DRAWING**

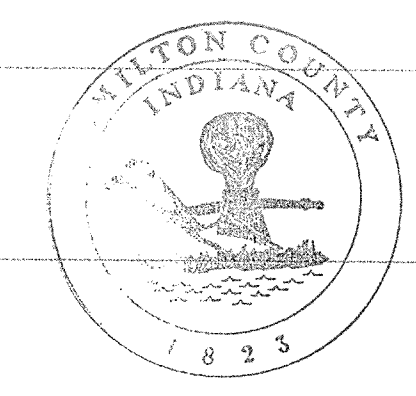

This information was gathered for input into the Hamilton County Geographic Information System. This information is considered an official record of the GIS.

Entry Date: 8-24-04

Entered by: JOH

FILED
 JUL 17 2002
 OFFICE OF HAMILTON COUNTY SURVEYOR

STORM SEWER PROFILE

LEGEND

	Existing Grade
	New Grade
	Granular Backfill

SCALE: HORZ.: 1"=50'
 VERT.: 1"=5'

HOLEY MOLEY SAYS
"DON'T DIG BLIND"


"IT'S THE LAW"
 CALL 2 WORKING DAYS BEFORE YOU DIG
1-800-382-5544
 CALL TOLL FREE
 PER INDIANA STATE LAW IS-69-1991
 IT IS AGAINST THE LAW TO EXCAVATE
 WITHOUT NOTIFYING THE UNDERGROUND
 LOCATION SERVICE TWO (2) WORKING
 DAYS BEFORE COMMENCING WORK.

GENERAL NOTES

1. TEMPORARY TRAFFIC CONTROL DURING CONSTRUCTION TO CONFORM TO APPLICABLE LOCAL AND STATE STANDARDS.
2. ALL CONSTRUCTION ACTIVITY ON THIS SITE TO BE PERFORMED IN COMPLIANCE WITH APPLICABLE O.S.H.A. STANDARDS FOR WORKER SAFETY.
3. IT SHALL BE THE CONTRACTORS RESPONSIBILITY TO FIELD VERIFY ALL UTILITY LOCATIONS BEFORE CONSTRUCTION BEGINS.
4. CONTRACTORS SHALL MINIMIZE DAMAGE TO EXISTING TREES.

BENCHMARK

TBM #44
 USGS BENCHMARK
 CUT "X" NORTH BONNET BOLT IN FIRE HYDRANT
 EAST SIDE HOOVER RD. ±100' SOUTH OF CLARIDGE
 FARM ENTRANCE.
 ELEVATION = 893.39

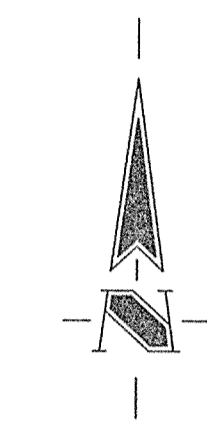

CERTIFICATION FOR "RECORD DRAWING"

NOTE:
 Record drawing certification only for top of casting, invert elevations and lengths of pipe. Slope percentage represents a calculated figure and is for general information only.

REVISIONS:
 1. BET. 5/10/02 "RECORD DRAWING"

DATE: 4/12/02

THIS DRAWING AND THE IDEAS, DESIGNS AND CONCEPTS CONTAINED HEREIN ARE THE EXCLUSIVE INTELLECTUAL PROPERTY OF THE SCHNEIDER CORPORATION, AND ARE NOT TO BE USED OR REPRODUCED, IN WHOLE OR IN PART, WITHOUT THE WRITTEN CONSENT OF THE SCHNEIDER CORPORATION.

© COPYRIGHTED BY THE SCHNEIDER CORP. (2001)




Schneider

THE SCHNEIDER CORPORATION
 12821 E. New Market Street,
 Suite 100
 Carmel, IN 46032
 Telephone: 317.569.8112
 Fax: 317.826.8410
 www.schneidercorp.com


Architecture
 Civil Engineering
 Environmental Engineering
 Geotechnical Services
 GIS * LIS
 Home Builder Services
 Interior Design
 Land Surveying
 Landscape Architecture
 Transportation Engineering

Village of WestClay
 Section 5006B
 CARMEL, INDIANA
 BRENNICK DEVELOPMENT CO.
 CARMEL, INDIANA

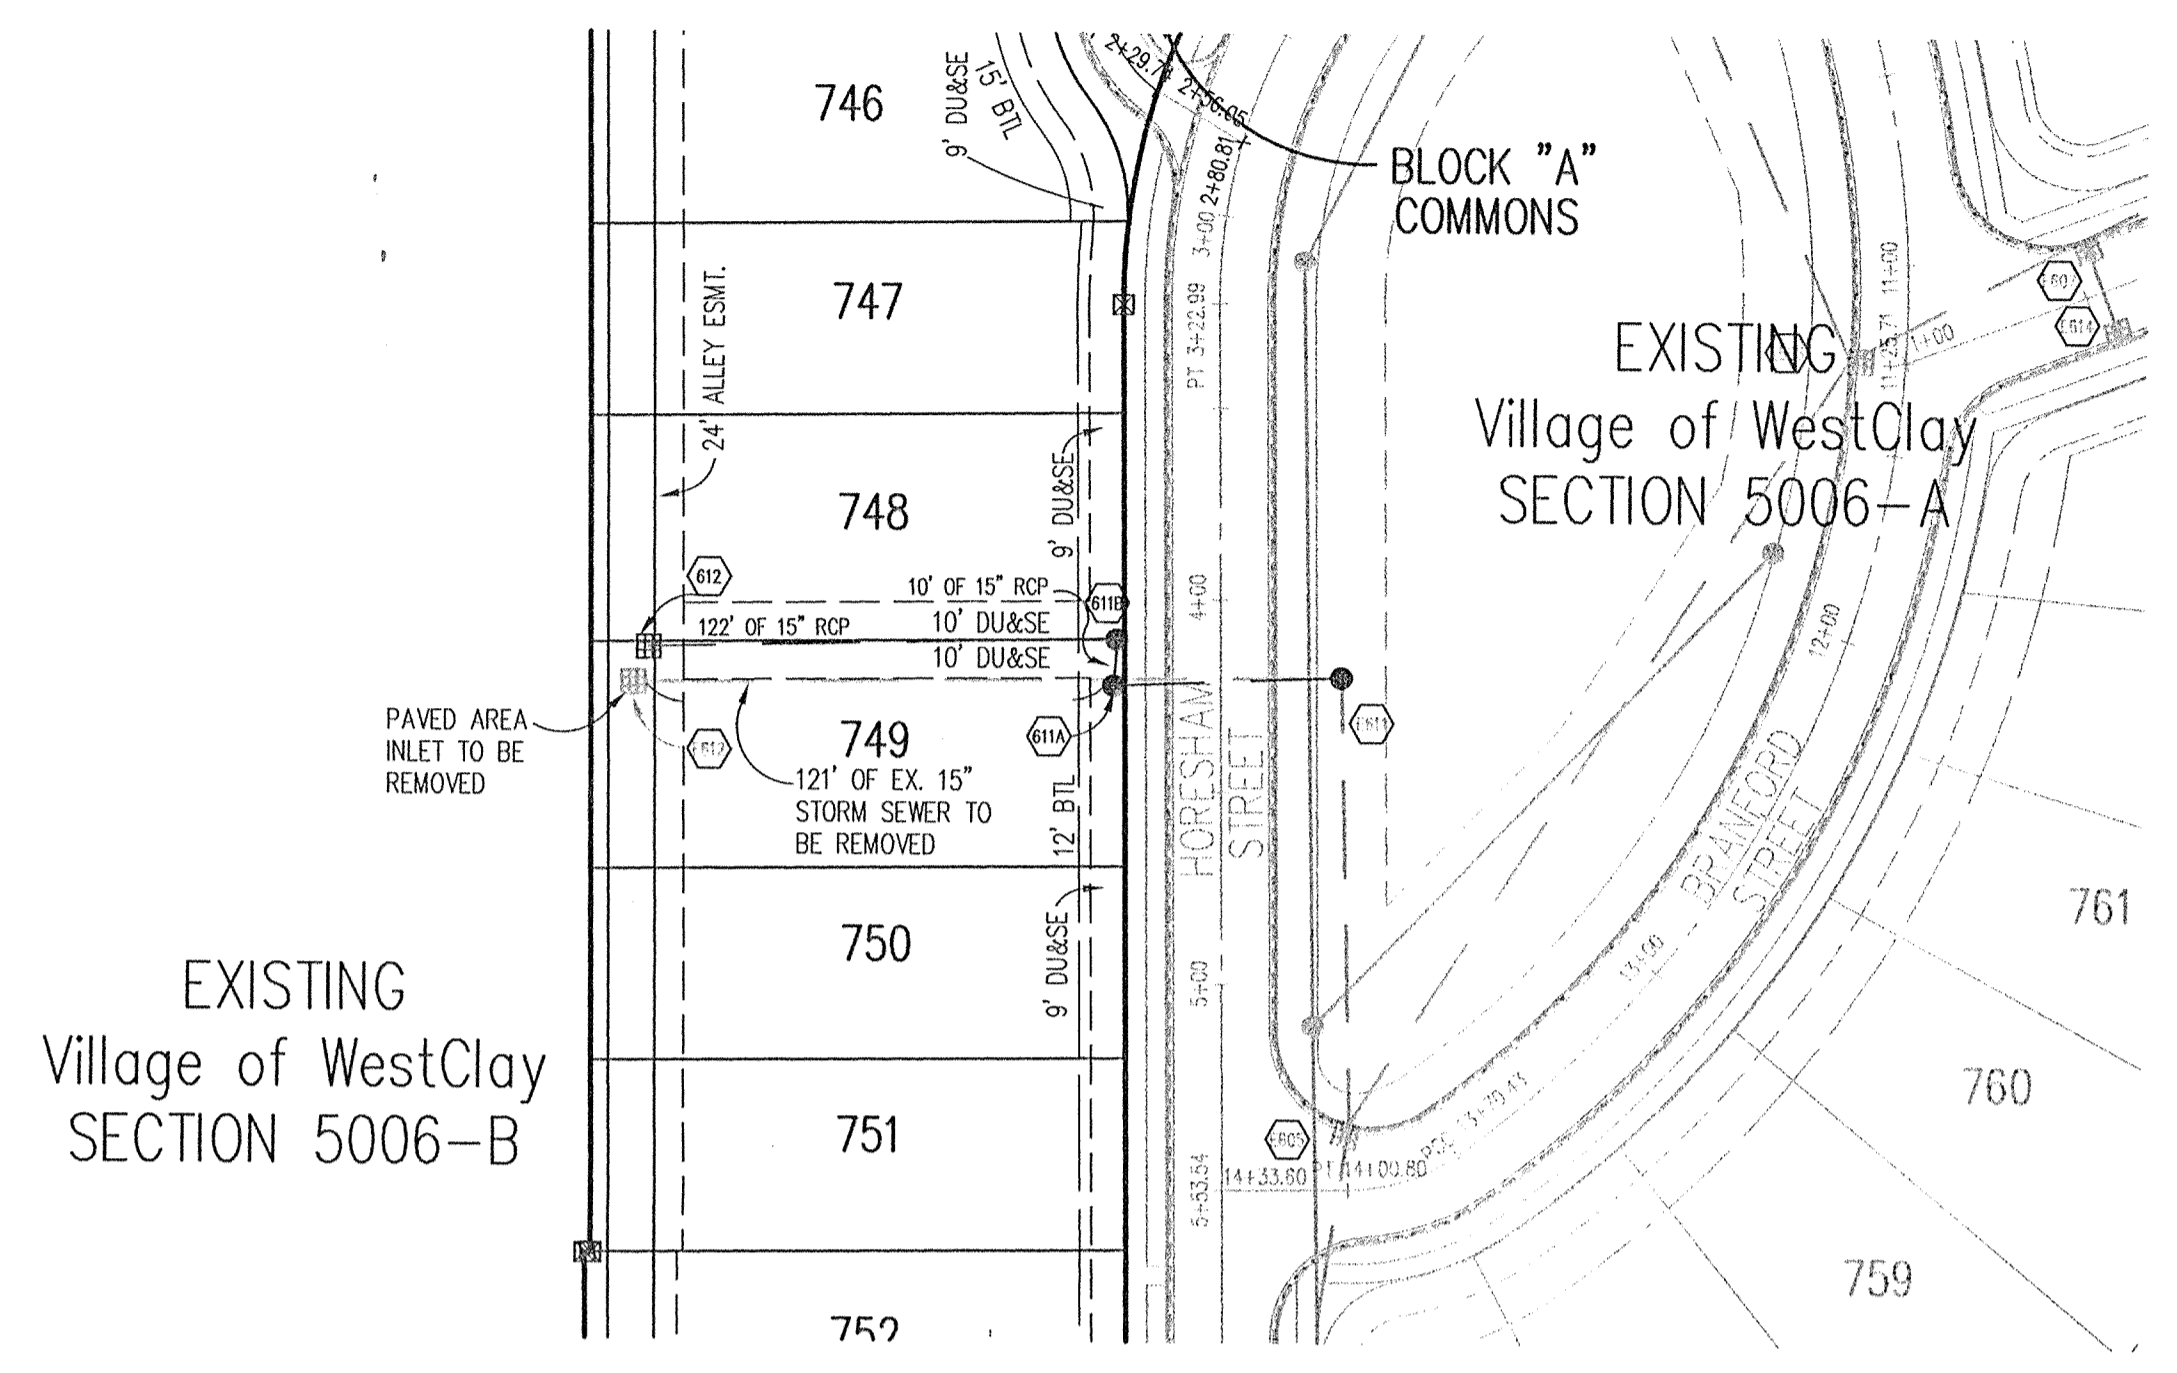

STORM SEWER PLAN

SCALE: 1"=50'

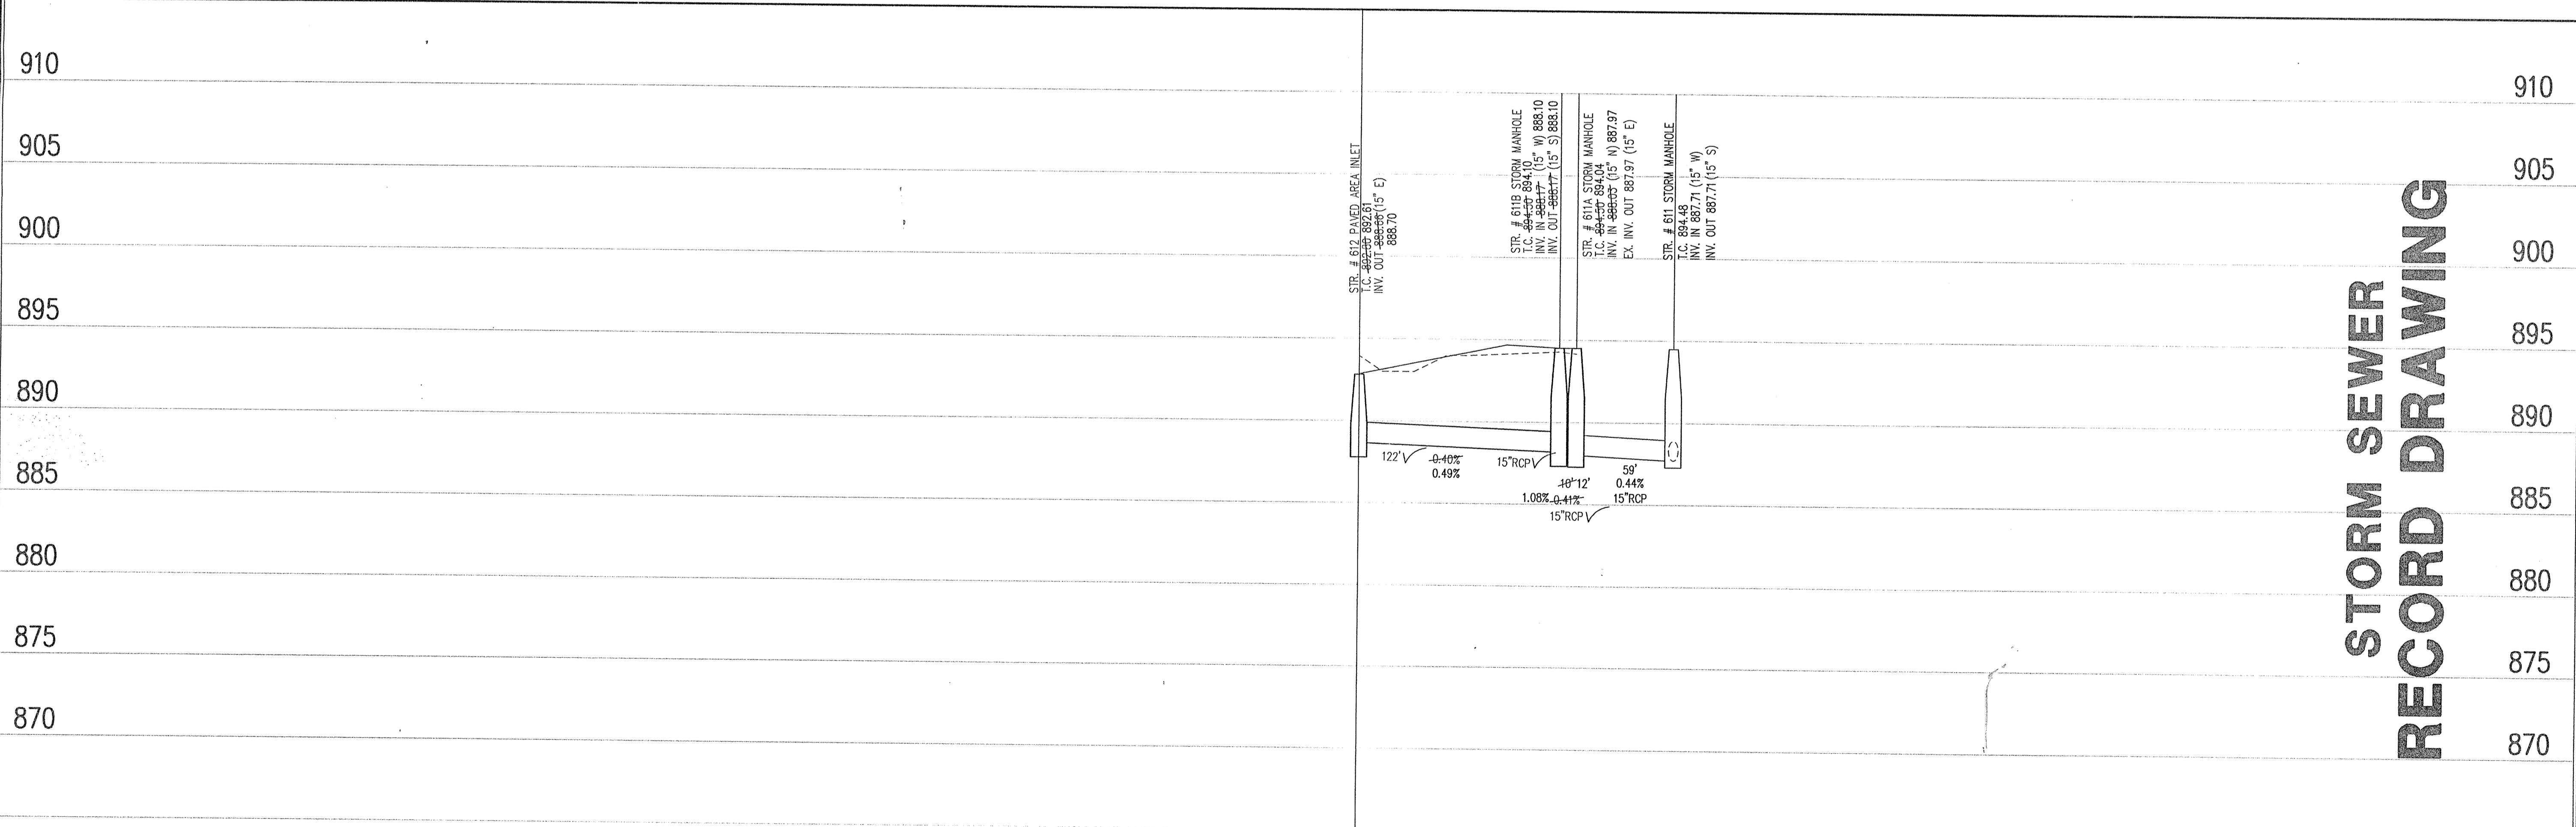

STORM SEWER RECORD DRAWING

STORM SEWER PROFILE

LEGEND

	Existing Grade
	New Grade
	Granular Backfill

SCALE: HORZ.: 1"=50'
 VERT.: 1"=5'

FILED
 JUL 17 2002
 OFFICE OF HAMILTON COUNTY ENGINEER

DATE: 12/12/01	PROJECT NO.: 1238.5006
DRAWN BY: DCC	CHECKED BY:
SHEET TITLE: STORM SEWER RECONFIGURATION PLAN	
DRAWING FILES: N:\1238\5006\DWG\5006R002.DWG XREF: 5006RS.DWG XREF: 5006RS.DWG	

SHEET NO.: 1