












Drain: ELIZABETH WEJAT **Drain #:** 289
Improvement/Arm: NAOMI FEKKER
Operator: J. LIVINGSTON **Date:** 8-19-04
Drain Classification: Urban/Rural **Year Installed:** 1884

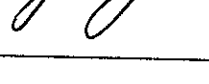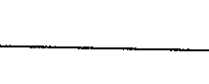GIS Drain Input Checklist

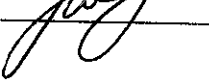- Pull Source Documents for Scanning
- Digitize & Attribute Tile Drains
- Digitize & Attribute Storm Drains
- Digitize & Attribute SSD
- Digitize & Attribute Open Ditch
- Stamp Plans
- Sum drain lengths & Validate
- Enter Improvements into Posse
- Enter Drain Age into Posse
- Sum drain length for Watershed in Posse
- Check Database entries for errors

The copy printed from the Digital Archive of the Hamilton County Surveyor's Office, One Hamilton Co. Square, Ste. 188, Noblesville, In 46060

Index Book 11
p 20
Kaoma Forkland
Kaoma Forkland

W. W. Wigham } Commissioners
S. B. Mills }

742.5


By the construction of a ditch commencing 45 rods west and 40 rods south of the north east corner of the south east quarter of section 6 township 20 north of range 4 east in Hamilton County and run thence at 32° E 300ft thence at 32° E 400ft thence at 43° E 300ft at 30° E 600ft at 61° E 400ft at 20° E 800ft at 10° E 300ft North 600ft thence at 49° N 600ft 20 north 1600ft at 16° N 400ft at 67° N 200ft at 90° N 200ft at 30° N 200ft at 40° N 400ft at 90° N 200ft at 72° N 200ft thence North 1100ft and terminate on the Deer Ditch 20 rods 20 rods south & 1 rod east of the north West corner of section 37 township 21 north of range 4 east. Below will be found a tabular statement of the No of station depth of cut at each station, width at the bottom and top at each stake & a station is 100ft. Said ditch is to consist of one row of seven inch tile from stake 0 to stake 15, 1 row of 8 inch tile from stake 15 to stake 39 and two rows of 8 inch tile from

DEC 10, 1884


BEING RECEIVED BY E. WENDT DEAN
THROU STA 2400 01

394055-75
BALANCE OF OPEN

S6-20-4

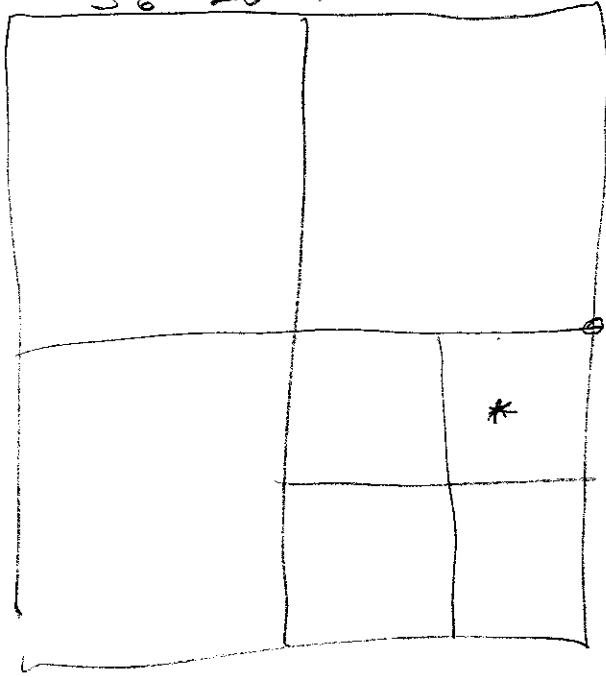

Begin 45 rods west & 40 rods south NE 3/4
SE 1/4 Sec 6-20-4

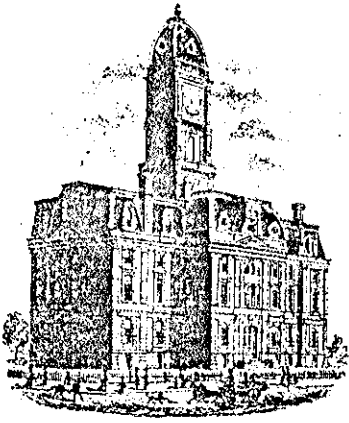

SURVEYOR'S OFFICE
Hamilton County

Kenton C. Ward, Surveyor

773-6110 Ext. 19

Noblesville, Ind. 46060 August 24, 1981

TO: Bath, Chlorus
227 West North Street
Tipton, In-46072

RE: Naomi Forkner Drain


Enclosed is a copy of the drain map showing the Naomi Forkner Drain.

I have records showing that the Forkner Drain, in red on the map, was constructed in 1884 and repaired in 1905.


I believe that when the Elizabeth Wendt Drain was constructed in 1930 the Fordkner Drain was tied into the drain and the remainder of the Forkner Drain was replaced by the Wendt Drain. But, this is not certain.

If you have any information concerning this drain such as its location or anything else please contact my office.

Sincerely,


Kenton C. Ward
Hamilton County Surveyor

KCW/no

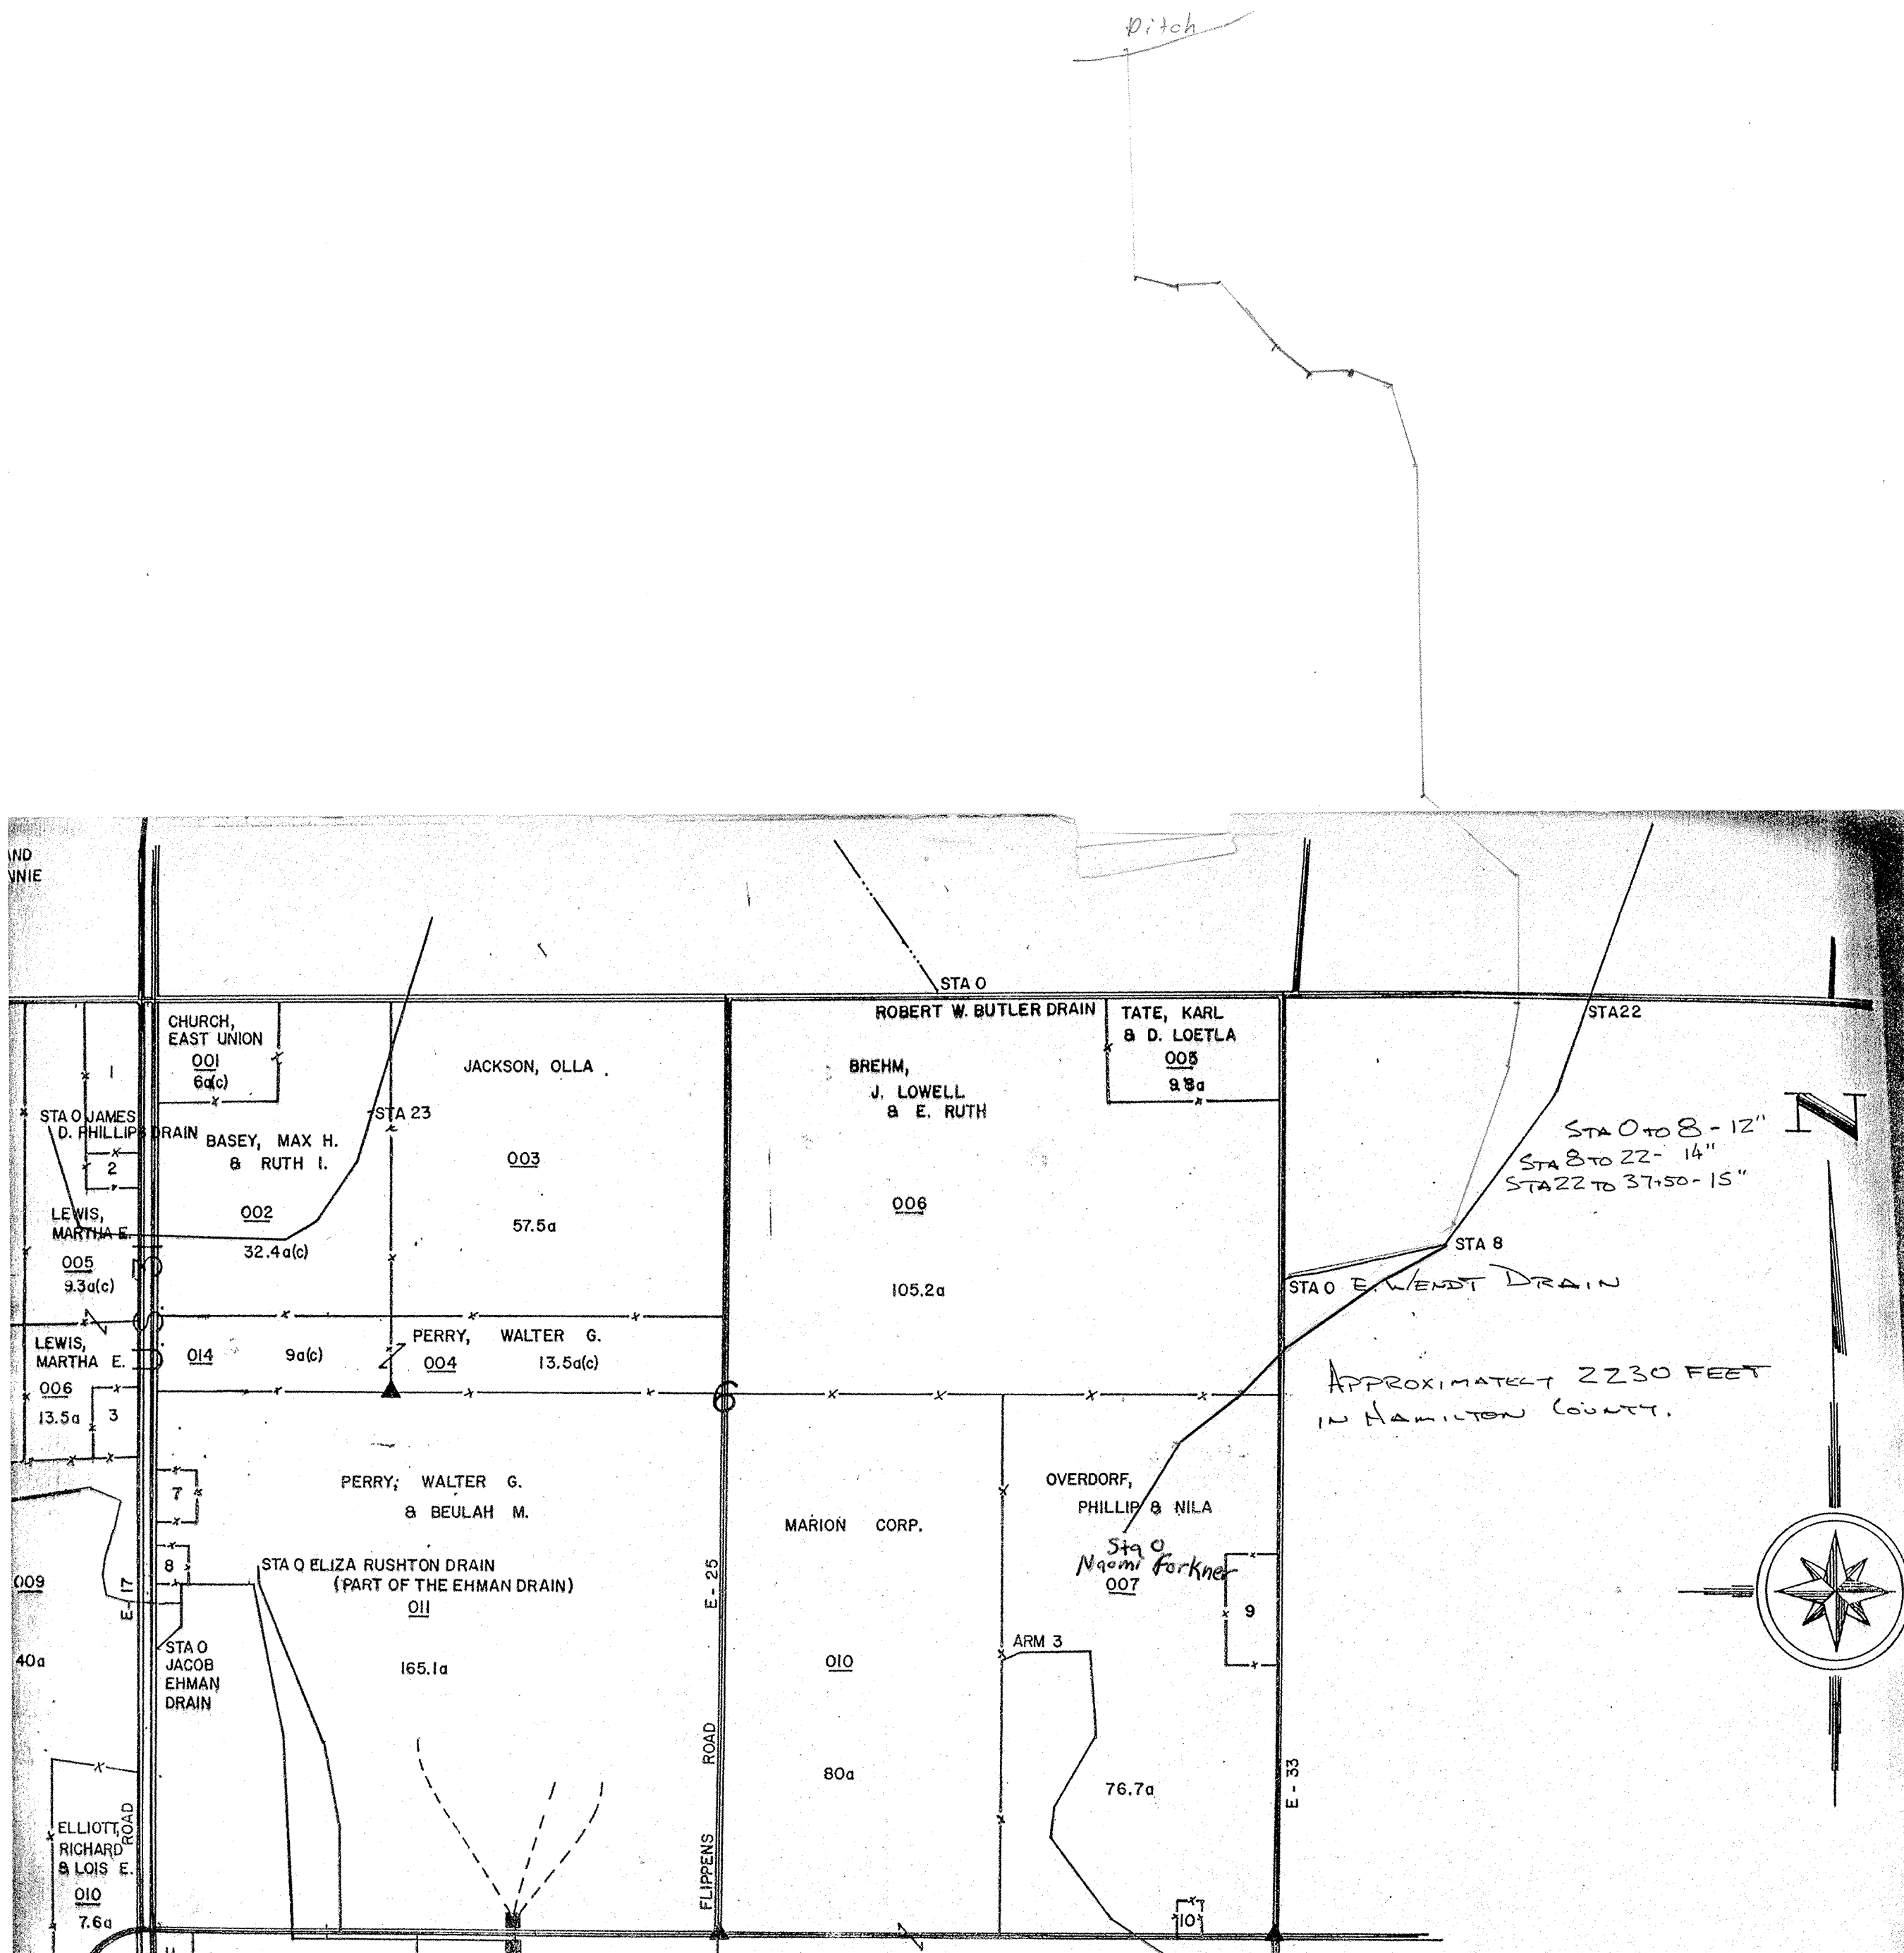

Ditch

STA 0

ROBERT W. BUTLER DRAIN

TATE, KARL
& D. LOETLA
005
9.8a

STA 22

JACKSON, OLLA

BREHM,
J. LOWELL
& E. RUTH

STA 0 TO 8 - 12"
STA 8 TO 22 - 14"
STA 22 TO 37+50 - 15"

003

006

57.5a

105.2a

STA 8

STA 0 E. WENDT DRAIN

APPROXIMATELY 2230 FEET
IN HAMILTON COUNTY.

PERRY, WALTER G.
& RUTH I.

PERRY, WALTER G.
& BEULAH M.

MARION CORP.

OVERDORF,
PHILLIP & NILA

Sta 0
Naomi Forkner
007

STA 0 ELIZA RUSHTON DRAIN
(PART OF THE EHMAN DRAIN)

011

010

76.7a

STA 0 JACOB
EHMAN
DRAIN

80a

E - 33

FLIPPENS ROAD

E - 25

E - 17

ELLIOTT,
RICHARD
& LOIS E.

010
7.6a

IND
VNIE

