

**Drain:** WHEELER AND WHEELER DRAIN      **Drain #:** 25  
**Improvement/Arm:** ARBOR GROVE-SECTION 3  
**Operator:** JOH      **Date:** 8-25-04  
**Drain Classification:** Urban/Rural      **Year Installed:** 2000

**GIS Drain Input Checklist**

- Pull Source Documents for Scanning   JA
- Digitize & Attribute Tile Drains   N/A
- Digitize & Attribute Storm Drains   JA
- Digitize & Attribute SSD   JA
- Digitize & Attribute Open Ditch   N/A
- Stamp Plans   DD
- Sum drain lengths & Validate   JA
- Enter Improvements into Posse   JA
- Enter Drain Age into Posse
- Sum drain length for Watershed in Posse
- Check Database entries for errors   JA

**Gasb 34 Footages for Historical Cost  
Drain Length Log**

Drain-Improvement: WHEELER AND WHEELER DRAIN - ARBOR GROVE - SECTION 3

Drain Type:	Size:	Length <small>SURVEYOR'S REPORT</small>	Length (DB Query)	Length Reconcile	If Applicable	
					Price:	Cost:
SD	6"	5,593.14'	5,593.14	✓	2.00	11,186.28
DCP	12"	926'	926'	✓	7.25	6,713.50
	15"	126'	126'	✓	9.50	1,197.00
	18"	520'	520'	✓	10.50	5,460.00
	21"	561'	561'	✓	14.25	7,994.25
	24"	216'	216'	✓	18.00	3,888.00
	27"	546'	546'	✓	21.30	11,629.80
	30"	88'	88'	✓	24.60	2,164.80
	33"	182'	182'	✓	28.50	5,187.00
	36"	176'	176'	✓	32.25	5,676.00

Sum: 8,934.14' 8,934.14' ✓ 6,096.63

Final Report: \_\_\_\_\_

Comments:

---



---



---




---



---



---

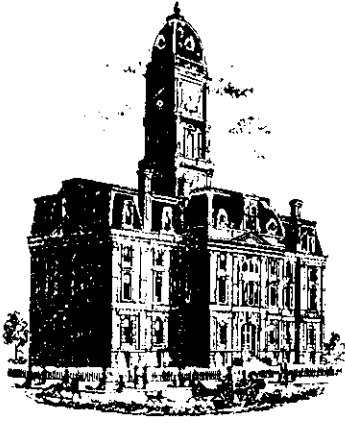

SURVEYOR'S OFFICE

# Hamilton County

*Kenton C. Ward, Surveyor*

*Phone (317) 776-8495*

*Fax (317) 776-9628*

*Suite 146*

*One Hamilton County Square*

*Noblesville, Indiana 46060-2230*

To: Hamilton County Drainage Board

September 6, 2000

Re: Wheeler & Wheeler Drain, Arbor Grove Section 3 Arm

Attached is a petition, non-enforcement request, plans, calculations, quantity summary and assessment roll for the Arbor Grove Section 3 Arm of the Wheeler & Wheeler Drain. I have reviewed the submittals and petition and have found each to be in proper form.

I have made a personal inspection of the land described in the petition. Upon doing so, I believe that the drain is practicable; will improve the public health; benefit a public highway and be of public utility; and that the costs, damages, and expenses of the proposed drain will probably be less than the benefits accruing to the owners of land likely to be benefited. The drain will consist of the following:

6" SSD 5,683 ft	18" RCP 309 ft	27" RCP 273 ft	36" RCP 176 ft
12" RCP 923 ft	21" RCP 324 ft	30" RCP 88 ft	
15" RCP 134 ft	24" RCP 216 ft	33" RCP 152 ft	

The total length of the drain will be 8,278 feet.

The retention pond (lake) #3 located in Common Area D is to be considered part of the regulated drain. The maintenance of the pond (lake), such as mowing and weed control, will be the responsibility of the Homeowners Association. The Board will, however, retain jurisdiction for ensuring the storage volume for which the lake was designed will be retained. Thereby, allowing no fill or easement encroachments.

The subsurface drains (SSD) to be part of the regulated drain are those located under the curbs. Only the main SSD lines which are located within the right of way are to be maintained as regulated drain. Laterals for individual lots will not be considered part of the regulated drain.

*changed to \$65.00 per acre.*


I have reviewed the plans and believe the drain will benefit each lot equally. Therefore, I recommend each lot be assessed equally. I also believe that no damages will result to landowners by the construction of this drain. I recommend a maintenance assessment of \$65.00 per lot, \$10.00 per acre for roadways, with common areas set at \$10.00 per acre, with a \$65.00 minimum. With this assessment the total annual assessment for this drain/this section will be \$4,712.80.

Parcels assessed for this drain may be assessed for the Stoney Creek Drain at sometime in the future.

I believe this proposed drain meets the requirements for Urban Drain Classification as set out in IC 36-9-27-67 to 69. Therefore, this drain shall be designated as an Urban Drain.

I recommend that upon approval of the above proposed drain that the Board also approve the attached non-enforcement request. This request is for the reduction of the regulated drain easement to those widths as shown on the secondary plat for Arbor Grove, Section 3 as recorded in the office of the Hamilton County Recorder.

I recommend the Board set a hearing for this proposed drain for October 23, 2000.

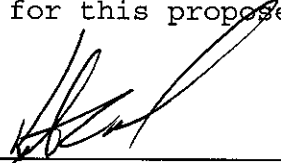  
\_\_\_\_\_  
Kenton C. Ward  
Hamilton County Surveyor

KCW/kkw

CERTIFICATE OF COMPLETION AND COMPLIANCE

To: Hamilton County Surveyor

Re: Wheeler-Wheeler Drain, Arbor Grove Sec. 3

I hereby certify that:

1. I am a Registered Land Surveyor or Engineer in the State of Indiana .
2. I am familiar with the plans and specifications for the above referenced subdivision .
3. I have personally observed and supervised the completion of the drainage facilities for the above referenced subdivision .
4. The drainage facilities within the above referenced subdivision to the best of my knowledge , information and belief have been installed and completed in conformity with all plans and specifications .

Signature: Allan H. Weihe Date: 10/31/01

Type or Print Name: Allan H. Weihe

Business Address: 10505 N. College Avenue

Indianapolis, Indiana 46280

Telephone Number: 317-846-6611

SEAL



INDIANA REGISTRATION NUMBER

10398



SURVEYOR'S OFFICE

# Hamilton County

*Kenton C. Ward, Surveyor*  
 Phone (317) 776-8495  
 Fax (317) 776-9628

Suite 188  
 One Hamilton County Square  
 Noblesville, Indiana 46060-2230

To: Hamilton County Drainage Board

April 16, 2004

Re: Wheeler & Wheeler Drain: Arbor Grove Sec. 3 Arm

Attached are as-builts, certificate of completion & compliance, and other information for Arbor Grove Sec. 3. An inspection of the drainage facilities for this section has been made and the facilities were found to be complete and acceptable.

During construction, changes were made to the drain, which will alter the plans submitted with my report for this drain-dated September 6, 2000. The report was approved by the Board at the hearing held November 14, 2000. (See Drainage Board Minutes Book 5, Pages 490-491)

The changes are as follows:

Structure:	T.C.:	I.E.:	Pipe:	Length:	Original Plans:	Difference:
750		798.62				
751	803.17	799.87	24	216		
751	803.17	799.87				
752	804.59	800.39	21	135		
752	804.59	800.39				
753	803.86	800.61	21	28		
753	803.86	800.61				
754	803.67	800.97	18	30		
754	803.67	800.97				
755	803.74	801.79	15	126	134	-8
755	803.74	801.79				
756	805.63	803.63	12	325		
759		799.24				
760	809.18	798.63	27	273		
760	809.18	798.63				
761		798.65	27	273		
762		798.65				
763	806.47	800.47	18	149		
763	806.47	800.47				
770	806.38	800.94	12	20		
770	806.38	800.94				
771	806.37	801.87	12	30		
763	806.47	800.47				

764	805.26	801.56	18	217	209	8
764	805.26	801.56				
765	805.41	801.93	18	32	53	-21
765	805.41	801.93				
766	805.52	802.22	18	62	39	13
766	805.52	802.22				
767	807.78	802.8	12	122	124	-2
767	808.78	802.8				
768	806.42	803.62	12	145	143	2
766	805.52	802.22				
769	805.31	802.51	12	35	52	-17
772		798.6				
773	803.38	799.38	21	161		
773	803.38	799.38				
774	803.65	799.46	18	30		
774	803.65	800.3				
775	802.82	801.02	12	135		
776	798.63					
777	805.5	798.88	36	40		
777	805.5	798.88				
778	807.33	799.18	36	136		
778	807.33	799.18				
779	807.23	799.33	33	30		
779	807.23	799.33				
780	807.91	799.41	33	30		
780	807.91	799.41				
781	805.66	799.96	33	122		
781	805.66	799.96				
782	805.27	800.77	30	88		
782	805.27	800.77				
795	805.91	802.08	12	84		
795	805.91	802.08				
796	806.09	802.84	12	30		
781	805.66	799.96				
797	808.35	804.45	21	237		

**6" SSD Streets:**

Concert Way	832.34
Arbor Grove Boulevard	866.42
Tenor Way	709.28
Symphony Boulevard	388.53
<b>Totalx2:</b>	<u>5593.14</u>

**RCP Pipe Totals:**

12	926
15	126
18	520
21	561
24	216
27	546
30	88
33	182
36	176
<b>Total:</b>	<u>3341</u>


The length of the drain due to the changes described above is now **8934.14 feet.**

The non-enforcement was approved by the Board at its meeting on November 14, 2000 and recorded under instrument #200100069285.

Sureties were not obtained for this project.

I recommend the Board approve the drain's construction as complete and acceptable.


Sincerely,

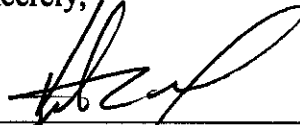A handwritten signature in black ink, appearing to read 'K. Ward', written over a horizontal line.

Kenton C. Ward,  
Hamilton County Surveyor


KCW/slm



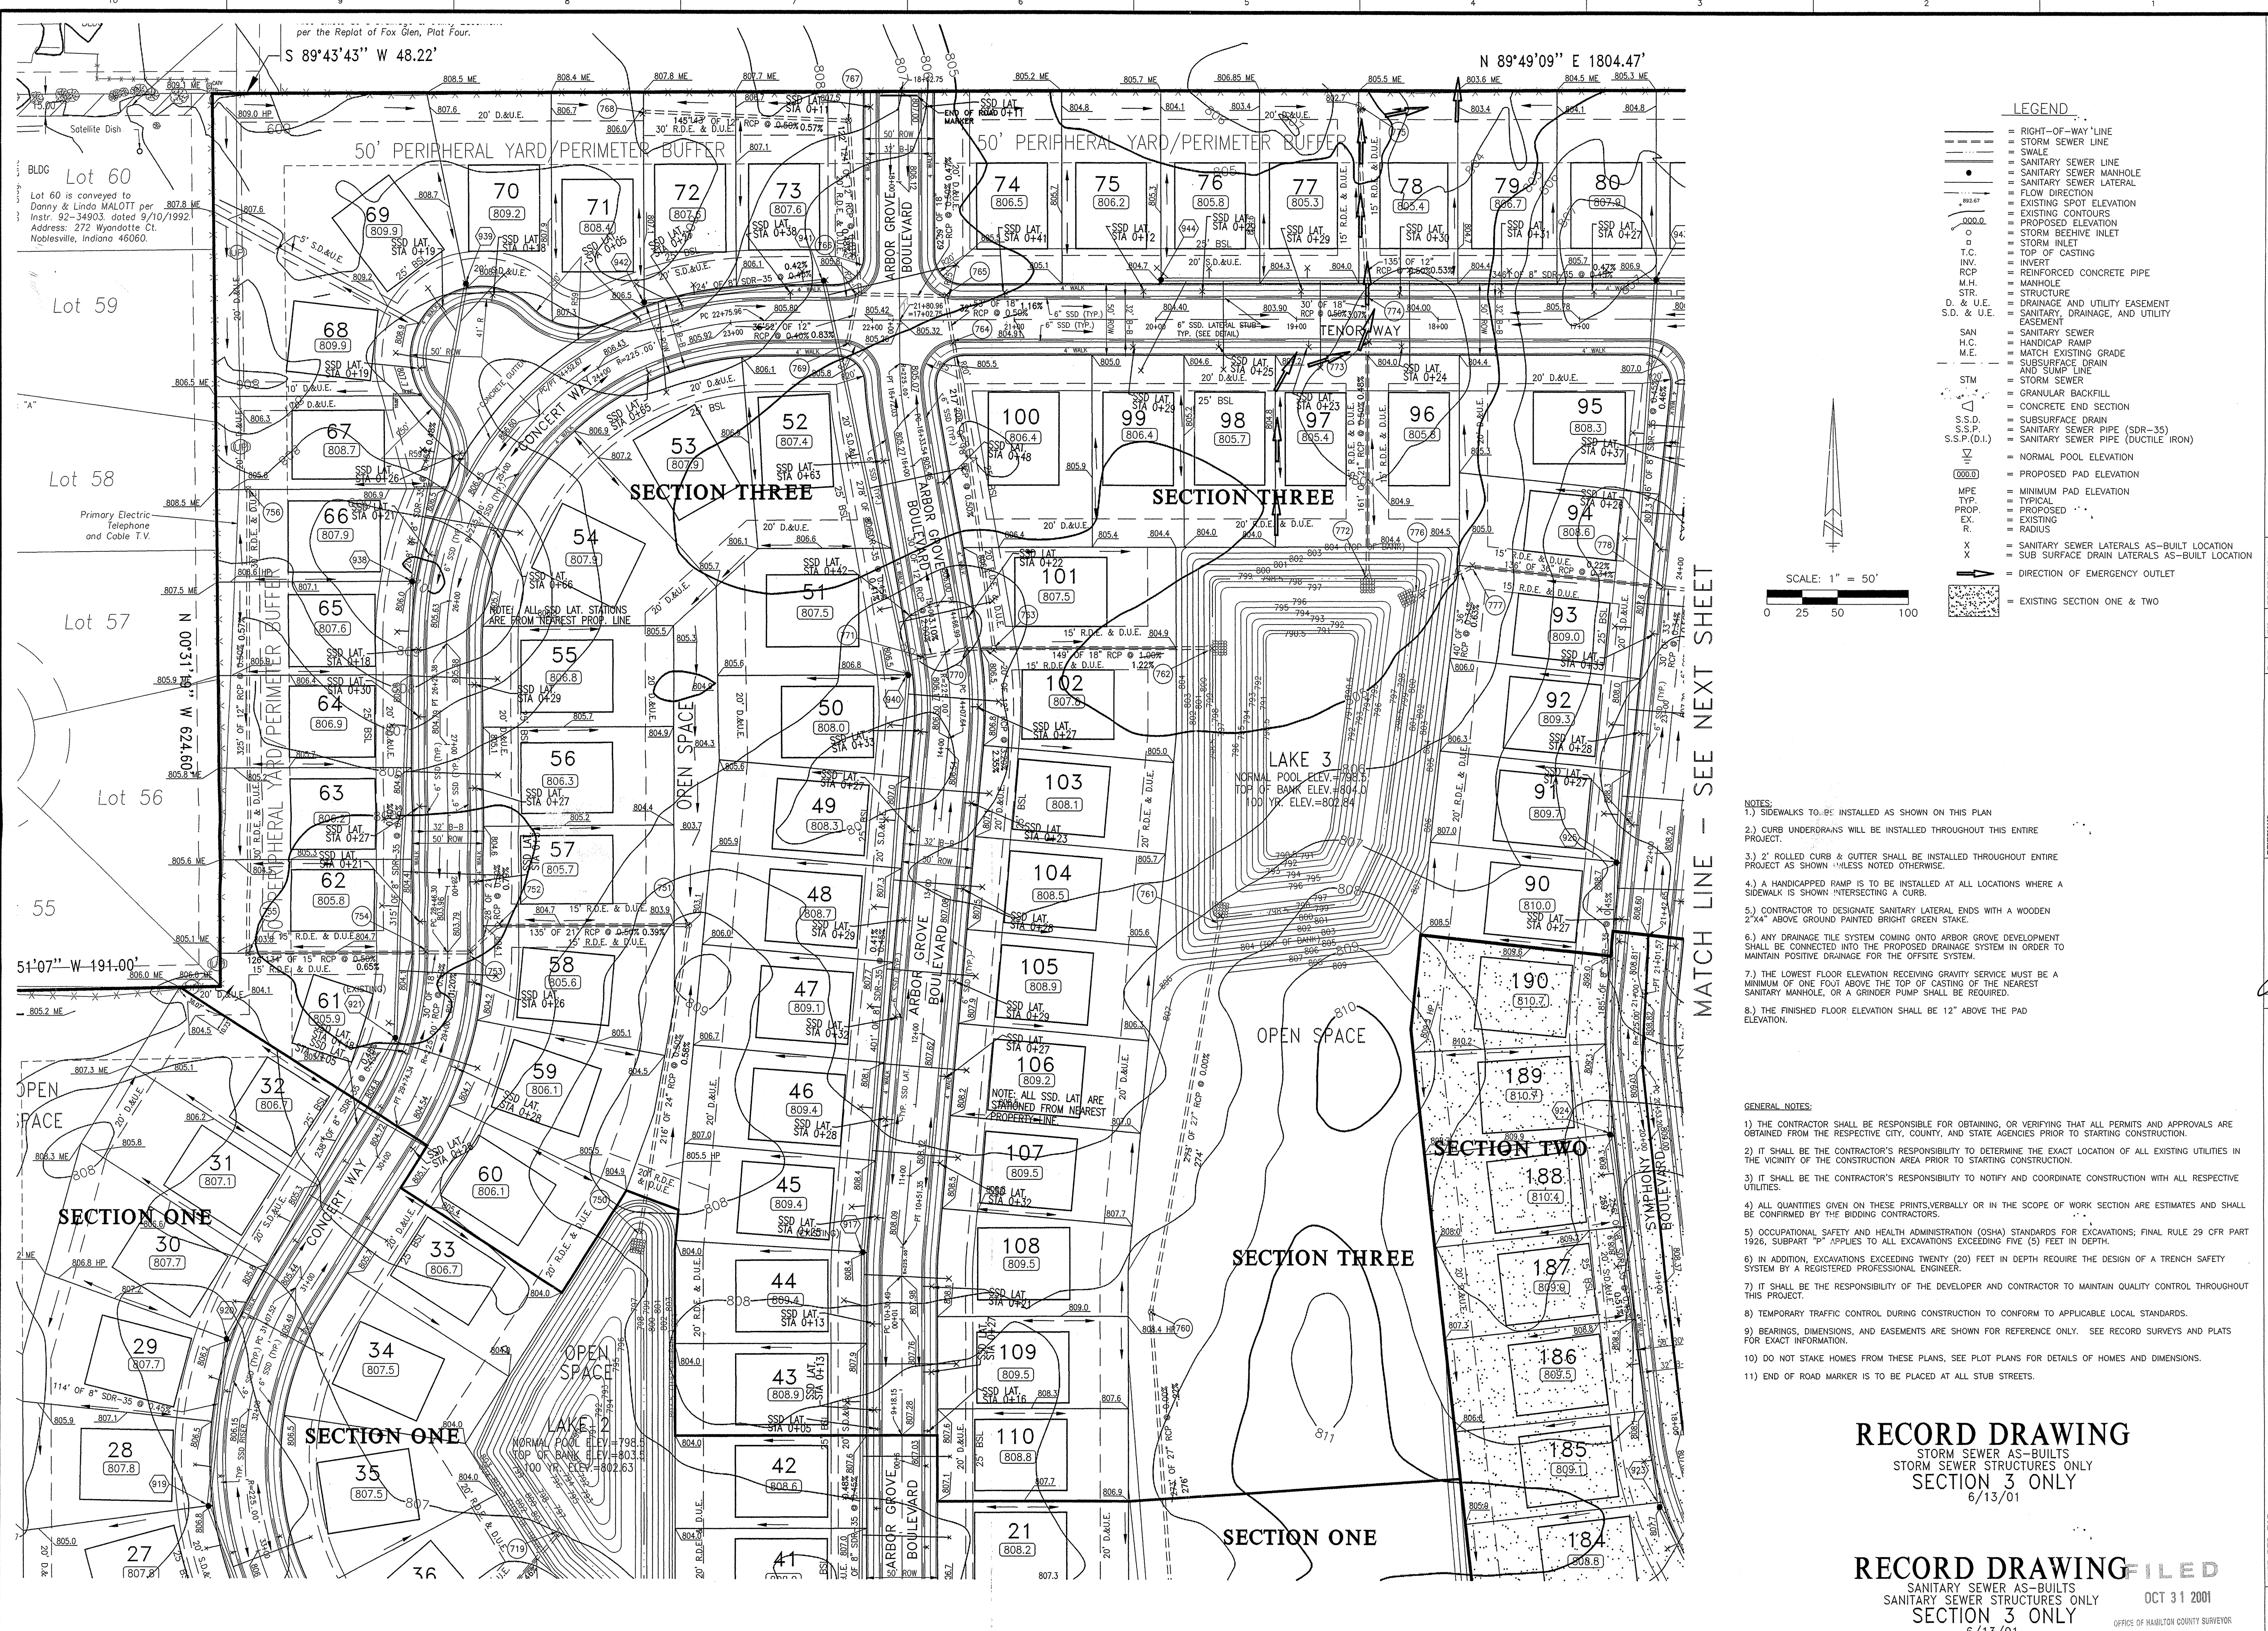

**LEGEND**

- RIGHT-OF-WAY LINE
- STORM SEWER LINE
- SWALE
- SANITARY SEWER LINE
- SANITARY SEWER MANHOLE
- SANITARY SEWER LATERAL
- FLOW DIRECTION
- EXISTING SPOT ELEVATION
- EXISTING CONTOURS
- PROPOSED ELEVATION
- STORM BEHIVE INLET
- STORM INLET
- TOP OF CASTING
- INVERT
- REINFORCED CONCRETE PIPE
- MANHOLE
- STRUCTURE
- DRAINAGE AND UTILITY EASEMENT
- SANITARY, DRAINAGE, AND UTILITY EASEMENT
- MATCH EXISTING GRADE
- SUBSURFACE DRAIN
- SANITARY SEWER PIPE (DUCTILE IRON)
- SANITARY SEWER PIPE (SDR-35)
- SANITARY SEWER PIPE (DUCTILE IRON)
- NORMAL POOL ELEVATION
- PROPOSED PAD ELEVATION
- MINIMUM PAD ELEVATION
- TYPICAL
- PROPOSED
- EXISTING
- RADIUS
- SANITARY SEWER LATERALS AS-BUILT LOCATION
- SUB SURFACE DRAIN LATERALS AS-BUILT LOCATION
- DIRECTION OF EMERGENCY OUTLET
- EXISTING SECTION ONE & TWO

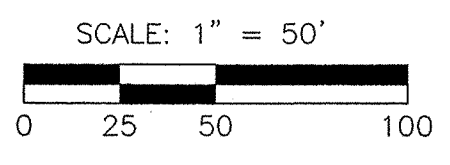

MATCH LINE - SEE NEXT SHEET

- NOTES:**
- 1.) SIDEWALKS TO BE INSTALLED AS SHOWN ON THIS PLAN
  - 2.) CURB UNDERDRAINS WILL BE INSTALLED THROUGHOUT THIS ENTIRE PROJECT.
  - 3.) 2" ROLLED CURB & GUTTER SHALL BE INSTALLED THROUGHOUT ENTIRE PROJECT AS SHOWN (UNLESS NOTED OTHERWISE).
  - 4.) A HANDICAPPED RAMP IS TO BE INSTALLED AT ALL LOCATIONS WHERE A SIDEWALK IS SHOWN INTERSECTING A CURB.
  - 5.) CONTRACTOR TO DESIGNATE SANITARY LATERAL ENDS WITH A WOODEN 2"x4" ABOVE GROUND PAINTED BRIGHT GREEN STAKE.
  - 6.) ANY DRAINAGE TILE SYSTEM COMING ONTO ARBOR GROVE DEVELOPMENT SHALL BE CONNECTED INTO THE PROPOSED DRAINAGE SYSTEM IN ORDER TO MAINTAIN POSITIVE DRAINAGE FOR THE OFFSITE SYSTEM.
  - 7.) THE LOWEST FLOOR ELEVATION RECEIVING GRAVITY SERVICE MUST BE A MINIMUM OF ONE FOOT ABOVE THE TOP OF CASTING OF THE NEAREST SANITARY MANHOLE, OR A GRINDER PUMP SHALL BE REQUIRED.
  - 8.) THE FINISHED FLOOR ELEVATION SHALL BE 12" ABOVE THE PAD ELEVATION.

- GENERAL NOTES:**
- 1) THE CONTRACTOR SHALL BE RESPONSIBLE FOR OBTAINING, OR VERIFYING THAT ALL PERMITS AND APPROVALS ARE OBTAINED FROM THE RESPECTIVE CITY, COUNTY, AND STATE AGENCIES PRIOR TO STARTING CONSTRUCTION.
  - 2) IT SHALL BE THE CONTRACTOR'S RESPONSIBILITY TO DETERMINE THE EXACT LOCATION OF ALL EXISTING UTILITIES IN THE VICINITY OF THE CONSTRUCTION AREA PRIOR TO STARTING CONSTRUCTION.
  - 3) IT SHALL BE THE CONTRACTOR'S RESPONSIBILITY TO NOTIFY AND COORDINATE CONSTRUCTION WITH ALL RESPECTIVE UTILITIES.
  - 4) ALL QUANTITIES GIVEN ON THESE PRINTS, VERBALLY OR IN THE SCOPE OF WORK SECTION ARE ESTIMATES AND SHALL BE CONFIRMED BY THE BIDDING CONTRACTORS.
  - 5) OCCUPATIONAL SAFETY AND HEALTH ADMINISTRATION (OSHA) STANDARDS FOR EXCAVATIONS; FINAL RULE 29 CFR PART 1926, SUBPART "P" APPLIES TO ALL EXCAVATIONS EXCEEDING FIVE (5) FEET IN DEPTH.
  - 6) IN ADDITION, EXCAVATIONS EXCEEDING TWENTY (20) FEET IN DEPTH REQUIRE THE DESIGN OF A TRENCH SAFETY SYSTEM BY A REGISTERED PROFESSIONAL ENGINEER.
  - 7) IT SHALL BE THE RESPONSIBILITY OF THE DEVELOPER AND CONTRACTOR TO MAINTAIN QUALITY CONTROL THROUGHOUT THIS PROJECT.
  - 8) TEMPORARY TRAFFIC CONTROL DURING CONSTRUCTION TO CONFORM TO APPLICABLE LOCAL STANDARDS.
  - 9) BEARINGS, DIMENSIONS, AND EASEMENTS ARE SHOWN FOR REFERENCE ONLY. SEE RECORD SURVEYS AND PLATS FOR EXACT INFORMATION.
  - 10) DO NOT STAKE HOMES FROM THESE PLANS, SEE PLOT PLANS FOR DETAILS OF HOMES AND DIMENSIONS.
  - 11) END OF ROAD MARKER IS TO BE PLACED AT ALL STUB STREETS.

**RECORD DRAWING**  
 STORM SEWER AS-BUILTS  
 STORM SEWER STRUCTURES ONLY  
 SECTION 3 ONLY  
 6/13/01

**RECORD DRAWING FILED**  
 SANITARY SEWER AS-BUILTS  
 SANITARY SEWER STRUCTURES ONLY  
 SECTION 3 ONLY  
 6/13/01

**WEIHE ENGINEERS, INC.**  
 10505 NORTH COLLEGE AVENUE  
 INDIANAPOLIS, INDIANA 46280  
 (317) 846-0546  
 FAX: (317) 846-0466  
 TOLL-FREE: (800) 486-6466

ALLAN H. WEIHE, P.E., L.S.  
 PRESIDENT


CIVIL ENGINEERS • LAND SURVEYORS • LAND PLANNERS • LANDSCAPE ARCHITECTS

DATE:	6/21/01	PROJECT NO.:	99-0386
BY:	AC	DWG. NAME:	STORM SEWER AS-BUILTS - SECTION 3 ONLY
CHECKED:	AC	DATE:	6/13/01
APPROVED:	AC	DATE:	6/13/01
DESIGNED:	AC	DATE:	6/13/01
DRAWN BY:	AC	DATE:	6/13/01
CHECKED BY:	AC	DATE:	6/13/01
DATE:	5/17/00		

**REGISTERED PROFESSIONAL ENGINEER**  
 ALLAN H. WEIHE  
 NO. 8827  
 STATE OF INDIANA

PREPARED FOR:  
**ARBOR GROVE SECTION THREE**  
 BAY DEVELOPMENT CORP.  
 DEVELOPMENT PLAN  
 Part of the E/2 of the SW/4 and W/2 of the SE/4 of Sec. 8-T18R-6E, Noblesville Twp., Hamilton Co., Indiana.

SHEET NO. **4**

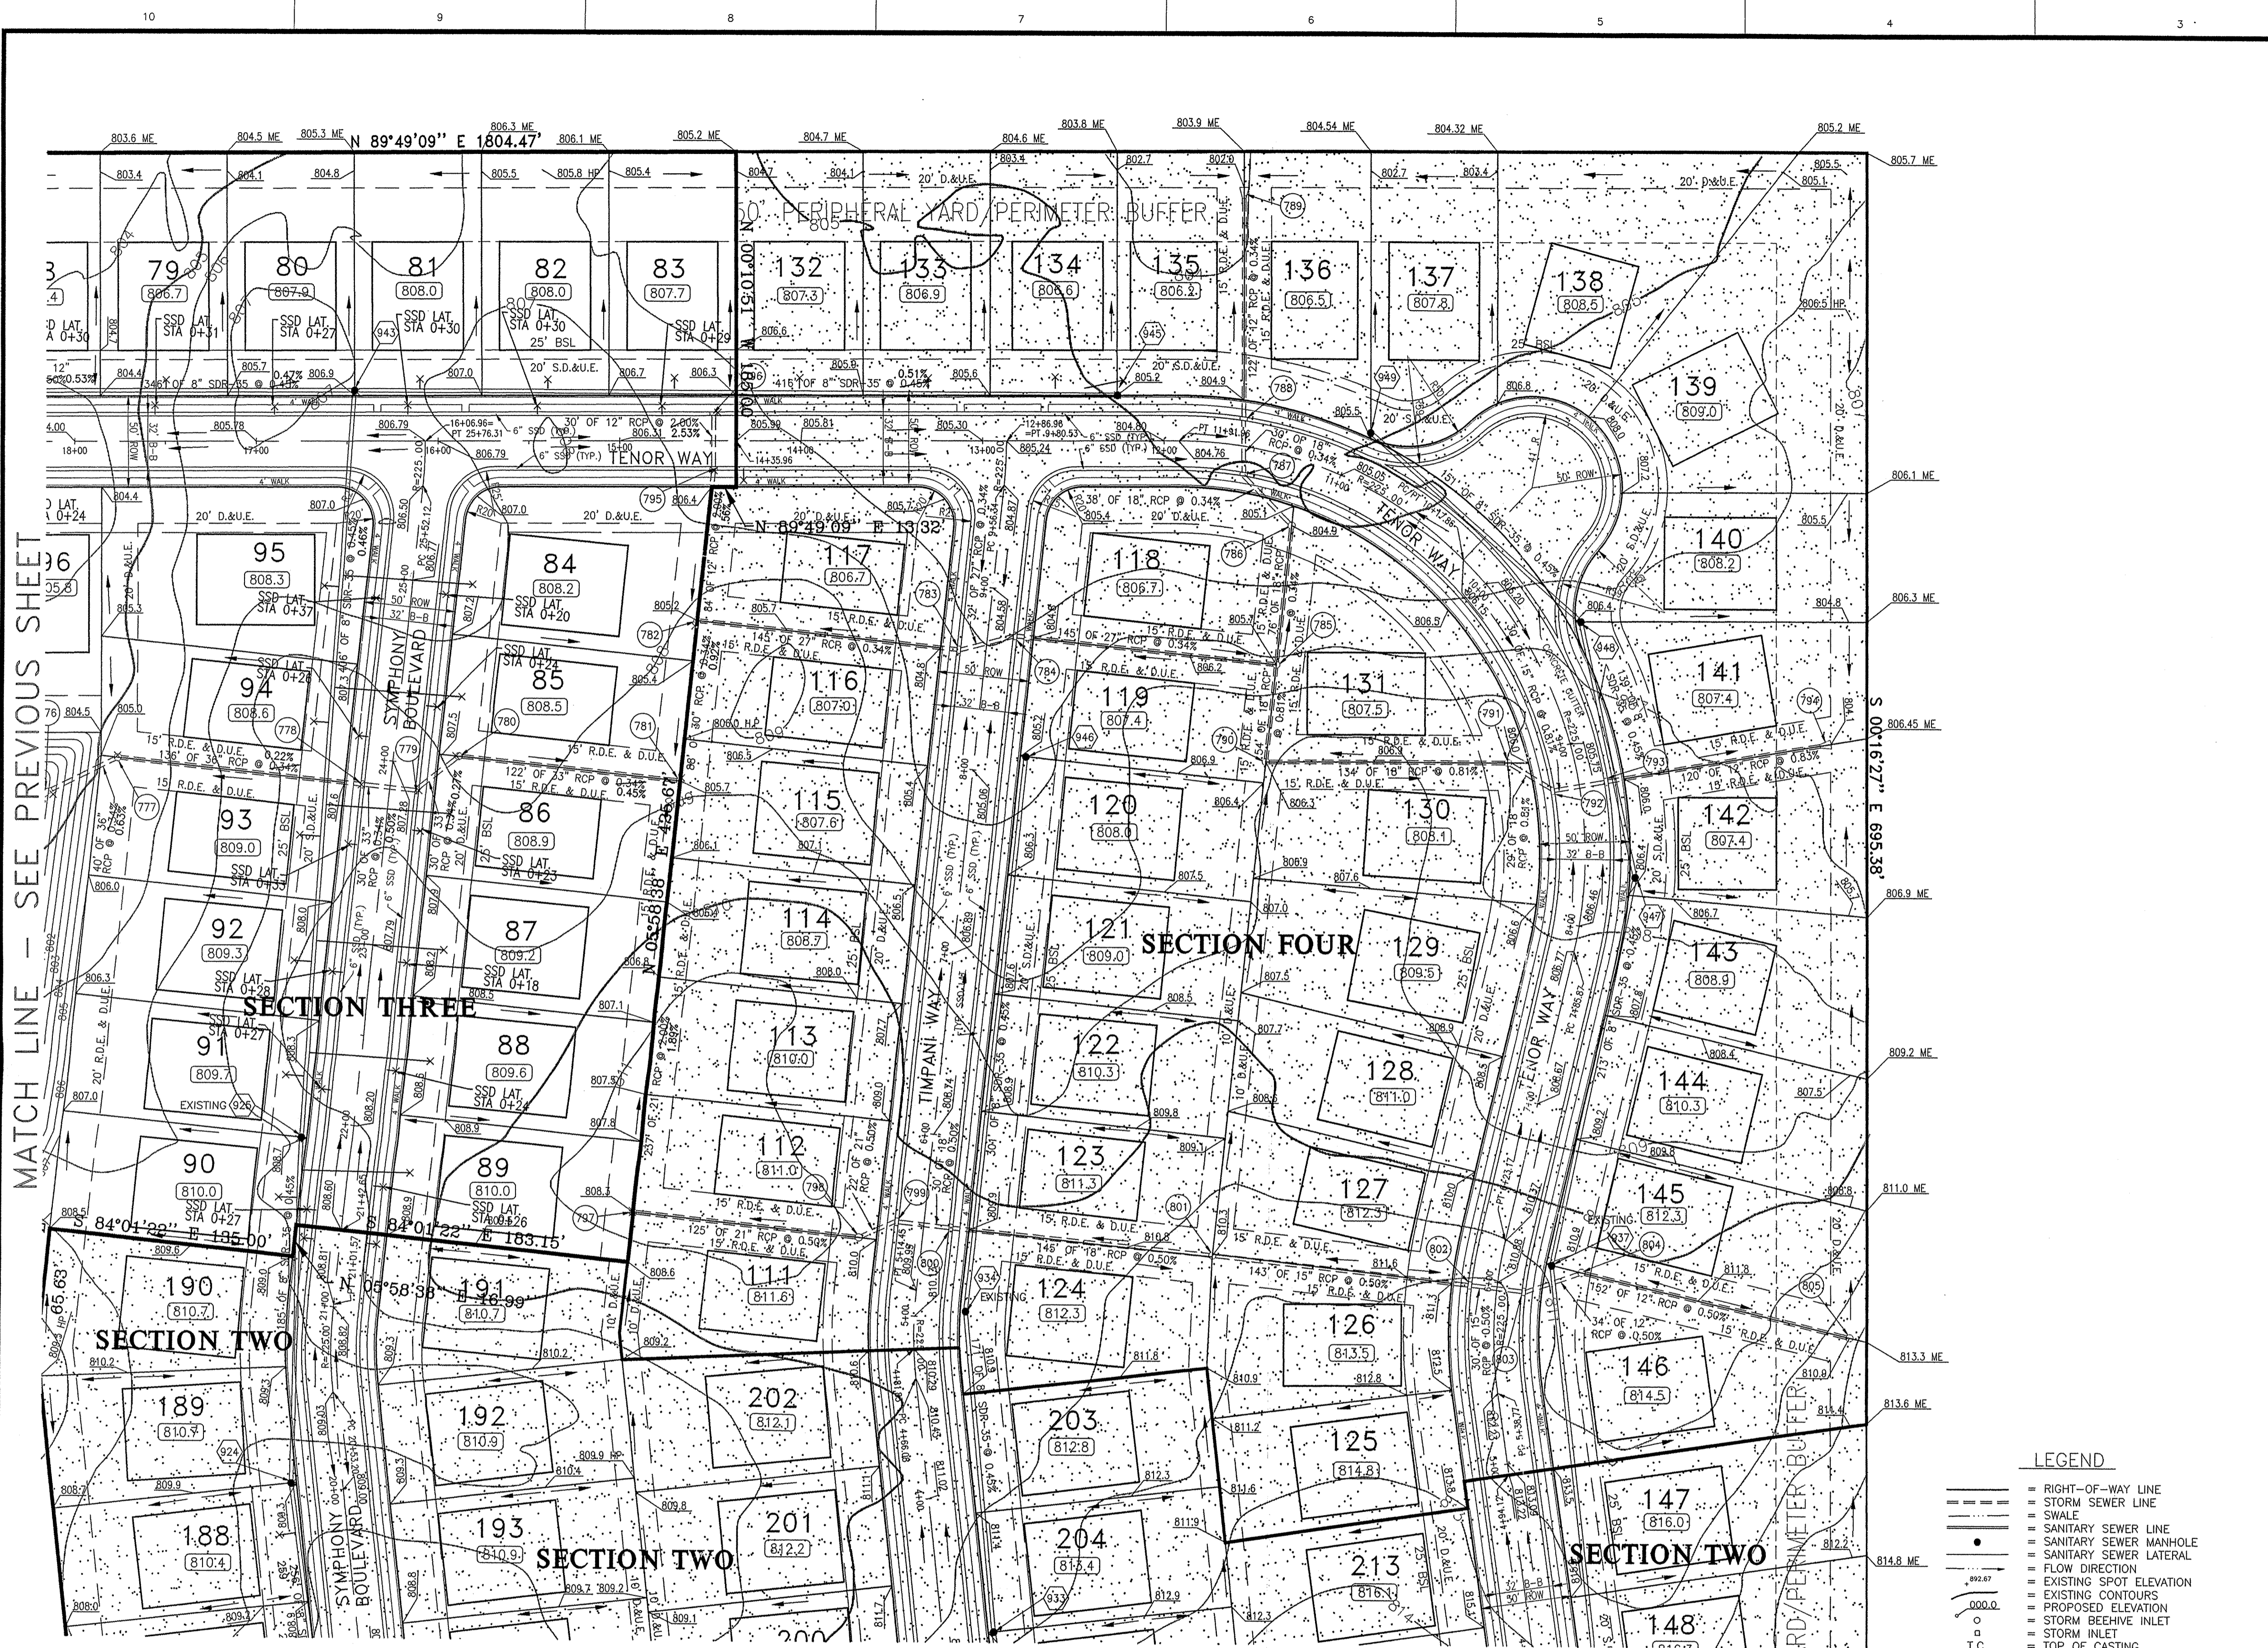

STORM SEWER STRUCTURE TABLE (700)				
STRUCTURE NUMBER	STRUCTURE TYPE	CASTING TYPE	TOP OF CASTING	INVERT
750	CES	NONE	N/A	798.50 798.62
751	MANHOLE	BEEHIVE	803.10 803.17	799.54 799.87
752	MANHOLE	SOLID	804.10 804.59	800.21 800.39
753	INLET	CURB	803.76 803.86	800.35 800.61
754	INLET	CURB	803.76 803.67	800.50 800.97
755	MANHOLE	BEEHIVE	803.80 803.74	801.80 801.79
756	MANHOLE	BEEHIVE	805.60 805.63	803.43 803.63
759	CES	NONE	N/A	798.50 799.24
760	MANHOLE	SOLID	809.00 809.18	798.50 798.63
761	CES	NONE	N/A	798.50 798.65
762	CES	NONE	N/A	798.50 798.65
763	MANHOLE	SOLID BEEHIVE	806.80 806.47	799.99 800.47
764	INLET	CURB	804.96 805.26	801.02 801.56
765	INLET	CURB	805.14 805.52	801.28 801.93
766	INLET	CURB	805.14 805.52	801.47 802.22
767	MANHOLE	SOLID	807.50 807.78	802.47 802.80
768	MANHOLE	BEEHIVE	806.00 806.42	803.19 803.62
769	INLET	CURB	804.06 805.31	801.68 802.51
770	MANHOLE	CURB	806.17 806.38	800.63 800.94
771	MANHOLE	CURB	806.17 806.37	801.23 801.87
772	CES	NONE	N/A	798.50 798.60
773	MANHOLE	CURB	803.70 803.38	799.31 799.38
774	MANHOLE	CURB	803.70 803.65	799.46(S) 800.30
775	MANHOLE	BEEHIVE	802.70 802.82	800.95 801.02
776	CES	NONE	N/A	798.50 798.63
777	MANHOLE	SOLID	805.30 805.50	798.04 798.88
778	MANHOLE	CURB	807.35 807.33	799.10 799.18
779	MANHOLE	CURB	807.35 807.23	799.20 799.33
780	MANHOLE	SOLID	807.80 807.91	799.30 799.41
781	MANHOLE	BEEHIVE	806.70 805.66	799.72 799.96
782	MANHOLE	BEEHIVE	806.20 805.27	800.02 800.77
783	INLET	CURB	804.48	800.51
784	INLET	CURB	804.48	800.62
785	MANHOLE	BEEHIVE	805.70	801.11
786	MANHOLE	BEEHIVE	804.90	801.37
787	INLET	CURB	804.64	801.50
788	INLET	CURB	804.64	801.60
789	CES	NONE	N/A	804.10
790	MANHOLE	BEEHIVE	806.30	801.55
791	MANHOLE	SOLID	806.30	802.64
792	INLET	CURB	805.68	802.87
793	INLET	CURB	805.68	803.11
794	CES	NONE	N/A	804.10
795	INLET	CURB	806.05 805.91	801.69 802.08
796	INLET	CURB	806.05 806.09	802.29 802.84
797	MANHOLE	BEEHIVE	806.30 808.35	804.46 804.45
798	MANHOLE	SOLID	810.30	805.09
799	MANHOLE	CURB	809.55	808.20
800	MANHOLE	BEEHIVE	809.55	805.35
801	MANHOLE	BEEHIVE	810.30	806.08
802	MANHOLE	BEEHIVE	810.96	806.80
803	MANHOLE	CURB	810.96	806.95
804	MANHOLE	SOLID	811.20	807.12
805	MANHOLE	BEEHIVE	810.90	807.88

SANITARY SEWER STRUCTURE TABLE (900)				
STRUCTURE NUMBER	TOP OF CASTING	INVERT (IN)	INVERT (OUT)	
917 (EX. SEC. 1)	808.70 808.25	795.99 795.94	795.89 795.84	
921 (EX. SEC. 1)	804.88 805.33	798.04 799.13	798.04 799.03	
925 (EX. SEC. 1)	809.00 809.15	794.54 794.30	794.41 794.20	
934 (EX. SEC. 1)	810.70	797.15	797.05	
937 (EX. SEC. 1)	811.20	796.33	796.23	
938	806.30 806.12	800.46 800.49	800.36 800.39	
939	808.40 808.42	N/A	804.40 801.48	
940	806.80 806.56	797.09 797.70	797.79 797.60	
941	806.20 805.95	798.24 798.93	798.14 798.83	
942	806.80 806.64	N/A	799.80 799.45	
943	807.20 807.22	796.44(W) 796.27	796.34(S) 796.17	
944	805.00 805.00	N/A	798.00 797.90	
945	805.50 805.50	N/A	798.50 798.40	
946	805.50	N/A	798.50	
947	806.70	797.30	797.29	
948	806.70	798.12	798.02	
949	805.00	N/A	798.30	

**SANITARY SEWER NOTES:**

1.) THIS PLAN IS INDICATING SANITARY SEWER LATERALS TO STOP NO CLOSER THAN 5 FEET FROM THE BUILDING LINE AT NO TIME SHALL THE CONTRACTOR EXCAVATE PAST THE BUILDING LINE DURING INSTALLATION OF ANY UTILITIES. IF EXCAVATION IS REQUIRED PAST THE BUILDING LINE, MATERIAL SHALL BE REPLACED AND COMPACTED TO 95% STANDARD PROCTOR. THIS IS INTENDED TO PREVENT ANY STRUCTURAL SETTLING WITHIN THE BUILDABLE AREA OF ALL LOTS. SANITARY LATERALS ARE TO BE INSTALLED AT NO GREATER THAN 45 DEGREE ANGLE COMING FROM THE MAIN.

2.) ALL DROP STRUCTURES MUST BE AN OUTSIDE DROP. INSIDE DROP CONNECTIONS ARE NOT ALLOWED.


- GENERAL NOTES:**
- THE CONTRACTOR SHALL BE RESPONSIBLE FOR OBTAINING, OR VERIFYING THAT ALL PERMITS AND APPROVALS ARE OBTAINED FROM THE RESPECTIVE CITY, COUNTY, AND STATE AGENCIES PRIOR TO STARTING CONSTRUCTION.
  - IT SHALL BE THE CONTRACTOR'S RESPONSIBILITY TO DETERMINE THE EXACT LOCATION OF ALL EXISTING UTILITIES IN THE VICINITY OF THE CONSTRUCTION AREA PRIOR TO STARTING CONSTRUCTION.
  - IT SHALL BE THE CONTRACTOR'S RESPONSIBILITY TO NOTIFY AND COORDINATE CONSTRUCTION WITH ALL RESPECTIVE UTILITIES.
  - ALL QUANTITIES GIVEN ON THESE PRINTS, VERBALLY OR IN THE SCOPE OF WORK SECTION ARE ESTIMATES AND SHALL BE CONFIRMED BY THE BIDDING CONTRACTORS.
  - OCCUPATIONAL SAFETY AND HEALTH ADMINISTRATION (OSHA) STANDARDS FOR EXCAVATIONS; FINAL RULE 29 CFR PART 1926, SUBPART "P" APPLIES TO ALL EXCAVATIONS EXCEEDING FIVE (5) FEET IN DEPTH.
  - IN ADDITION, EXCAVATIONS EXCEEDING TWENTY (20) FEET IN DEPTH REQUIRE THE DESIGN OF A TRENCH SAFETY SYSTEM BY A REGISTERED PROFESSIONAL ENGINEER.
  - IT SHALL BE THE RESPONSIBILITY OF THE DEVELOPER AND CONTRACTOR TO MAINTAIN QUALITY CONTROL THROUGHOUT THIS PROJECT.
  - TEMPORARY TRAFFIC CONTROL DURING CONSTRUCTION TO CONFORM TO APPLICABLE LOCAL STANDARDS.
  - BEARINGS, DIMENSIONS, AND EASEMENTS ARE SHOWN FOR REFERENCE ONLY. SEE RECORD SURVEYS AND PLATS FOR EXACT INFORMATION.
  - DO NOT STAKE HOMES FROM THESE PLANS. SEE PLOT PLANS FOR DETAILS OF HOMES AND DIMENSIONS.
  - END OF ROAD MARKER IS TO BE PLACED AT ALL STUB STREETS.

- NOTES:**
- SIDEWALKS TO BE INSTALLED AS SHOWN ON THIS PLAN
  - CURB UNDERDRAINS WILL BE INSTALLED THROUGHOUT THIS ENTIRE PROJECT.
  - 2" ROLLED CURB & GUTTER SHALL BE INSTALLED THROUGHOUT ENTIRE PROJECT AS SHOWN UNLESS NOTED OTHERWISE.
  - A HANDICAPPED RAMP IS TO BE INSTALLED AT ALL LOCATIONS WHERE A SIDEWALK IS SHOWN INTERSECTING A CURB.
  - CONTRACTOR TO DESIGNATE SANITARY LATERAL ENDS WITH A WOODEN 2"x4" ABOVE GROUND PAINTED BRIGHT GREEN STAKE.
  - ANY DRAINAGE TILE SYSTEM COMING ONTO ARBOR GROVE DEVELOPMENT SHALL BE CONNECTED INTO THE PROPOSED DRAINAGE SYSTEM IN ORDER TO MAINTAIN POSITIVE DRAINAGE FOR THE OFFSITE SYSTEM.
  - THE LOWEST FLOOR ELEVATION RECEIVING GRAVITY SERVICE MUST BE A MINIMUM OF ONE FOOT ABOVE THE TOP OF CASTING OF THE NEAREST SANITARY MANHOLE, OR A GRINDER PUMP SHALL BE REQUIRED.
  - THE FINISHED FLOOR ELEVATION SHALL BE 12" ABOVE THE PAD ELEVATION.

**RECORD DRAWING**  
STORM SEWER AS-BUILTS  
STORM SEWER STRUCTURES ONLY  
SECTION 3 ONLY  
6/13/01

**RECORD DRAWING**  
SANITARY SEWER AS-BUILTS  
SANITARY SEWER STRUCTURES ONLY  
SECTION 3 ONLY  
6/13/01

- LEGEND**
- RIGHT-OF-WAY LINE
  - STORM SEWER LINE
  - SWALE
  - SANITARY SEWER LINE
  - SANITARY SEWER MANHOLE
  - SANITARY SEWER LATERAL
  - FLOW DIRECTION
  - EXISTING SPOT ELEVATION
  - EXISTING CONTOURS
  - PROPOSED ELEVATION
  - STORM BEEHIVE INLET
  - STORM INLET
  - TOP OF CASTING
  - INVERT
  - REINFORCED CONCRETE PIPE
  - M.H.
  - STRUCTURE
  - DRAINAGE AND UTILITY EASEMENT
  - SANITARY, DRAINAGE, AND UTILITY EASEMENT
  - SANITARY SEWER
  - HANDICAP RAMP
  - MATCH EXISTING GRADE
  - SUBSURFACE DRAIN
  - AND SUMP LINE
  - STORM SEWER
  - GRANULAR BACKFILL
  - CONCRETE END SECTION
  - SUBSURFACE DRAIN
  - SANITARY SEWER PIPE (SDR-35)
  - SANITARY SEWER PIPE (DUCTILE IRON)
  - NORMAL POOL ELEVATION
  - PROPOSED PAD ELEVATION
  - MINIMUM PAD ELEVATION
  - TYPICAL
  - PROPOSED
  - EXISTING
  - RADIUS
  - SANITARY SEWER LATERALS AS-BUILT LOCATION
  - SUB SURFACE DRAIN LATERALS AS-BUILT LOCATION
  - SECTION TWO

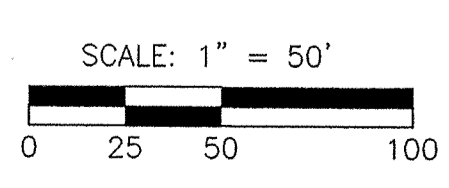

**WEIHE ENGINEERS, INC.**  
10606 NORTH COLLIER AVENUE  
INDIANAPOLIS, INDIANA 46230  
(317) 846-6611 FAX: (317) 843-0546  
TOLL-FREE: (800) 462-6405

ALLAN H. WEIHE, P.E., L.S.  
PRESIDENT

CIVIL ENGINEERS \* LAND SURVEYORS \* LAND PLANNERS \* LANDSCAPE ARCHITECTS



PROJECT NO.: 030103  
DATE: 6/13/01  
DRAWN BY: J.M.  
CHECKED BY: M.M.  
DATE: 8/17/00

REVISIONS TO STORM SEWER AS-BUILTS - SECTION 3 ONLY  
MINOR REVISIONS TO SANITARY SEWER AS-BUILTS - SECTION 3 ONLY

REGISTERED PROFESSIONAL ENGINEER  
NO. 8827  
STATE OF INDIANA  
ALLAN H. WEIHE, P.E. 0627


PREPARED FOR: ARBOR GROVE SECTION THREE  
BAY DEVELOPMENT CORP.  
DEVELOPMENT PLAN  
Part of the E.P. of the SW/4 and W/2 of the SE/4 of Sec. 8-T18N-R5E, Noblesville Twp., Hamilton Co., Indiana.

SHEET NO. 5

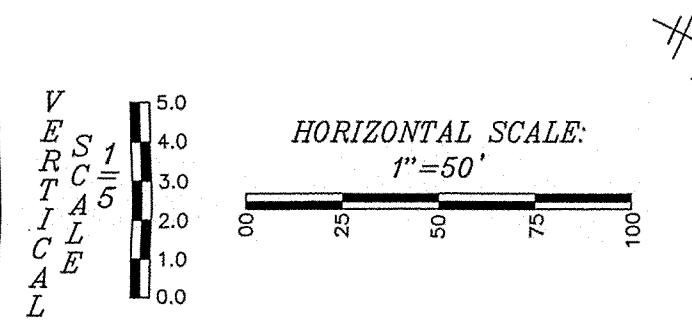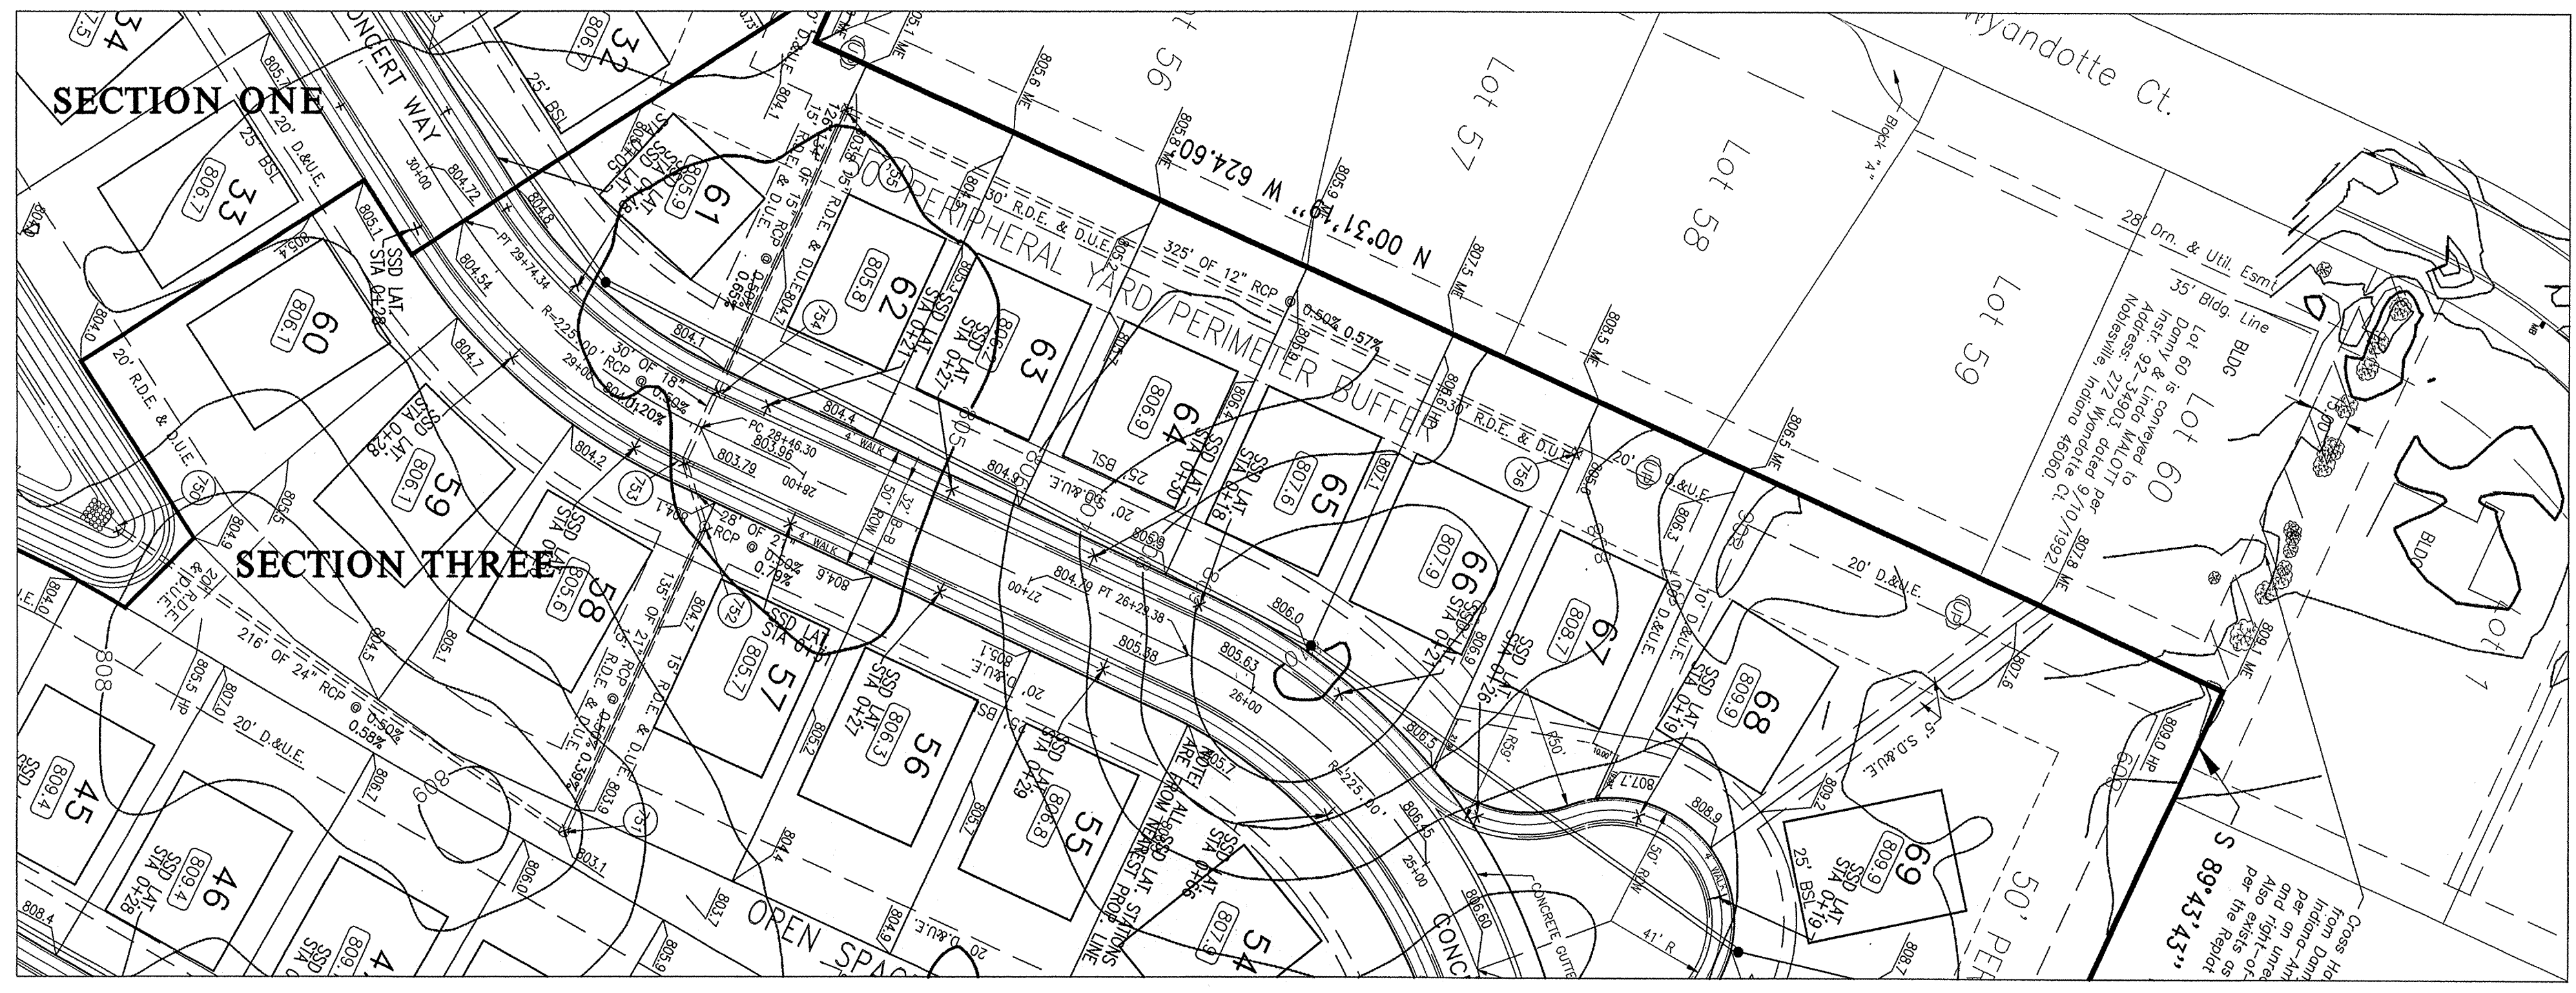

- LEGEND**
- RIGHT-OF-WAY LINE
  - STORM SEWER LINE
  - SWALE
  - SANITARY SEWER LINE
  - SANITARY SEWER MANHOLE
  - SANITARY SEWER LATERAL
  - FLOW DIRECTION
  - EXISTING SPOT ELEVATION
  - EXISTING CONTOURS
  - PROPOSED ELEVATION
  - STORM BEEHIVE INLET
  - STORM INLET
  - T.C. = TOP OF CASTING
  - INV. = INVERT
  - RCP = REINFORCED CONCRETE PIPE
  - M.H. = MANHOLE
  - STR. = STRUCTURE
  - D. & U.E. = DRAINAGE AND UTILITY EASEMENT
  - S.D. & U.E. = SANITARY, DRAINAGE, AND UTILITY EASEMENT
  - SAN = SANITARY SEWER
  - H.C.P. = HANDICAP RAMP
  - M.E. = MATCH EXISTING GRADE
  - S.D. = SUBSURFACE DRAIN AND SUMP LINE
  - STM = STORM SEWER
  - G.B. = GRANULAR BACKFILL
  - C.E.S. = CONCRETE END SECTION
  - S.S.D. = SUBSURFACE DRAIN
  - S.S.P. = SANITARY SEWER PIPE (SDR-35)
  - S.S.P.(D.I.) = SANITARY SEWER PIPE (DUCTILE IRON)
  - N.P.E. = NORMAL POOL ELEVATION
  - P.P.E. = PROPOSED PAD ELEVATION
  - M.P.E. = MINIMUM PAD ELEVATION
  - TYP. = TYPICAL
  - PROP. = PROPOSED
  - EX. = EXISTING
  - R. = RADIUS
  - X = SUB SURFACE DRAIN LATERALS AS-BUILT LOCATION
  - SECTION ONE

**RECORD DRAWING**  
 STORM SEWER AS-BUILTS  
 STORM SEWER STRUCTURES ONLY  
 SECTION 3 ONLY  
 6/13/01

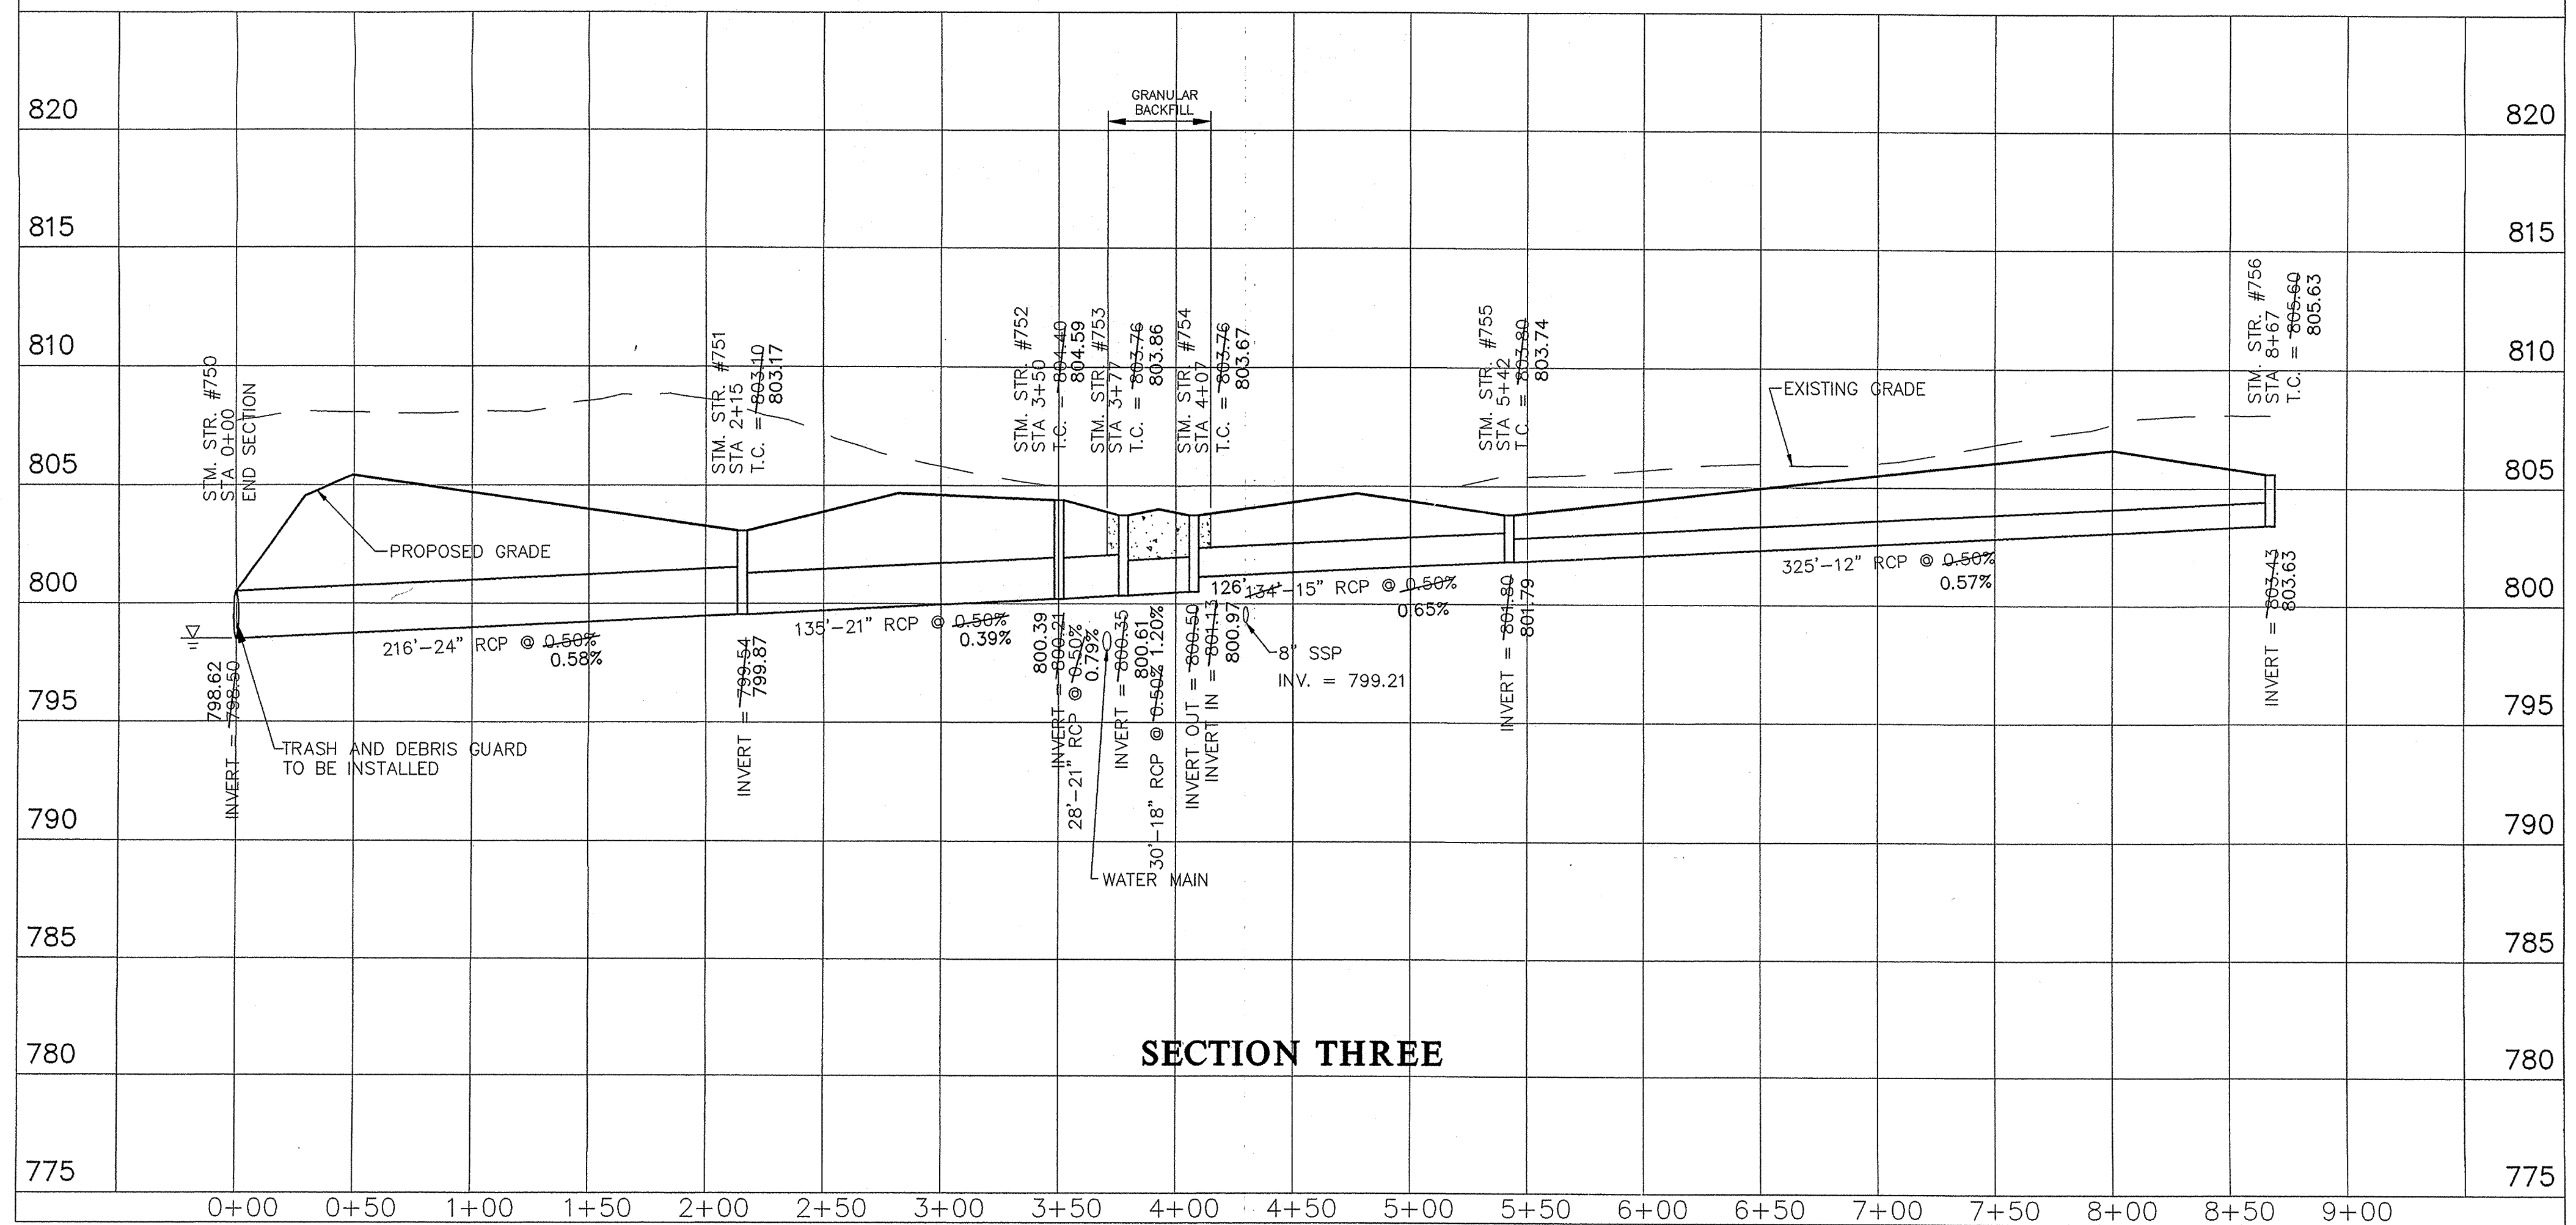

Entered by: JDR  
 Entry Date: 8-25-04  
 GIS  
 This information was gathered for input into the Hamilton County Geographical Information System. This document is considered an official record of the City of Hamilton.




**WEIHE ENGINEERS, INC.**  
 10605 NORTH COLLEGE AVENUE  
 TOLL-FREE (800) 456-4408  
 (317) 845-6611  
 FAX: (317) 843-0546  
 ALLAN H. WEIHE, P.E., L.S.  
 PRESIDENT  
 CIVIL ENGINEERS • LAND SURVEYORS • LAND PLANNERS • LANDSCAPE ARCHITECTS

PROJECT NO.:	99-0356
DATE:	6/21/01
BY:	JDR
DATE:	6/13/01
REVISIONS:	MINOR REVISIONS
DATE:	6/13/01
DESCRIPTION:	STORM SEWER AS-BUILTS - SECTION 3 ONLY
DATE:	6/13/01
BY:	JDR
DATE:	6/13/01
DESCRIPTION:	STORM SEWER AS-BUILTS - SECTION 3 ONLY
DATE:	6/13/01
BY:	JDR
DATE:	6/13/01
DESCRIPTION:	STORM SEWER AS-BUILTS - SECTION 3 ONLY




REGISTERED PROFESSIONAL ENGINEER  
 NO. 8827  
 STATE OF INDIANA  
 ALLAN H. WEIHE, P.E. 8827

PREPARED FOR:  
**ARBOR GROVE SECTION THREE**  
 BAY DEVELOPMENT CORP.  
 STORM PLAN & PROFILE SHEET  
 Part of the 22' of the S1/4 and 1/2 of the S22' of Sec. 2-126-652, Noblesville Twp., Hamilton Co., Indiana.

**FILED**  
 OCT 31 2001  
 OFFICE OF HAMILTON COUNTY SURVEYOR

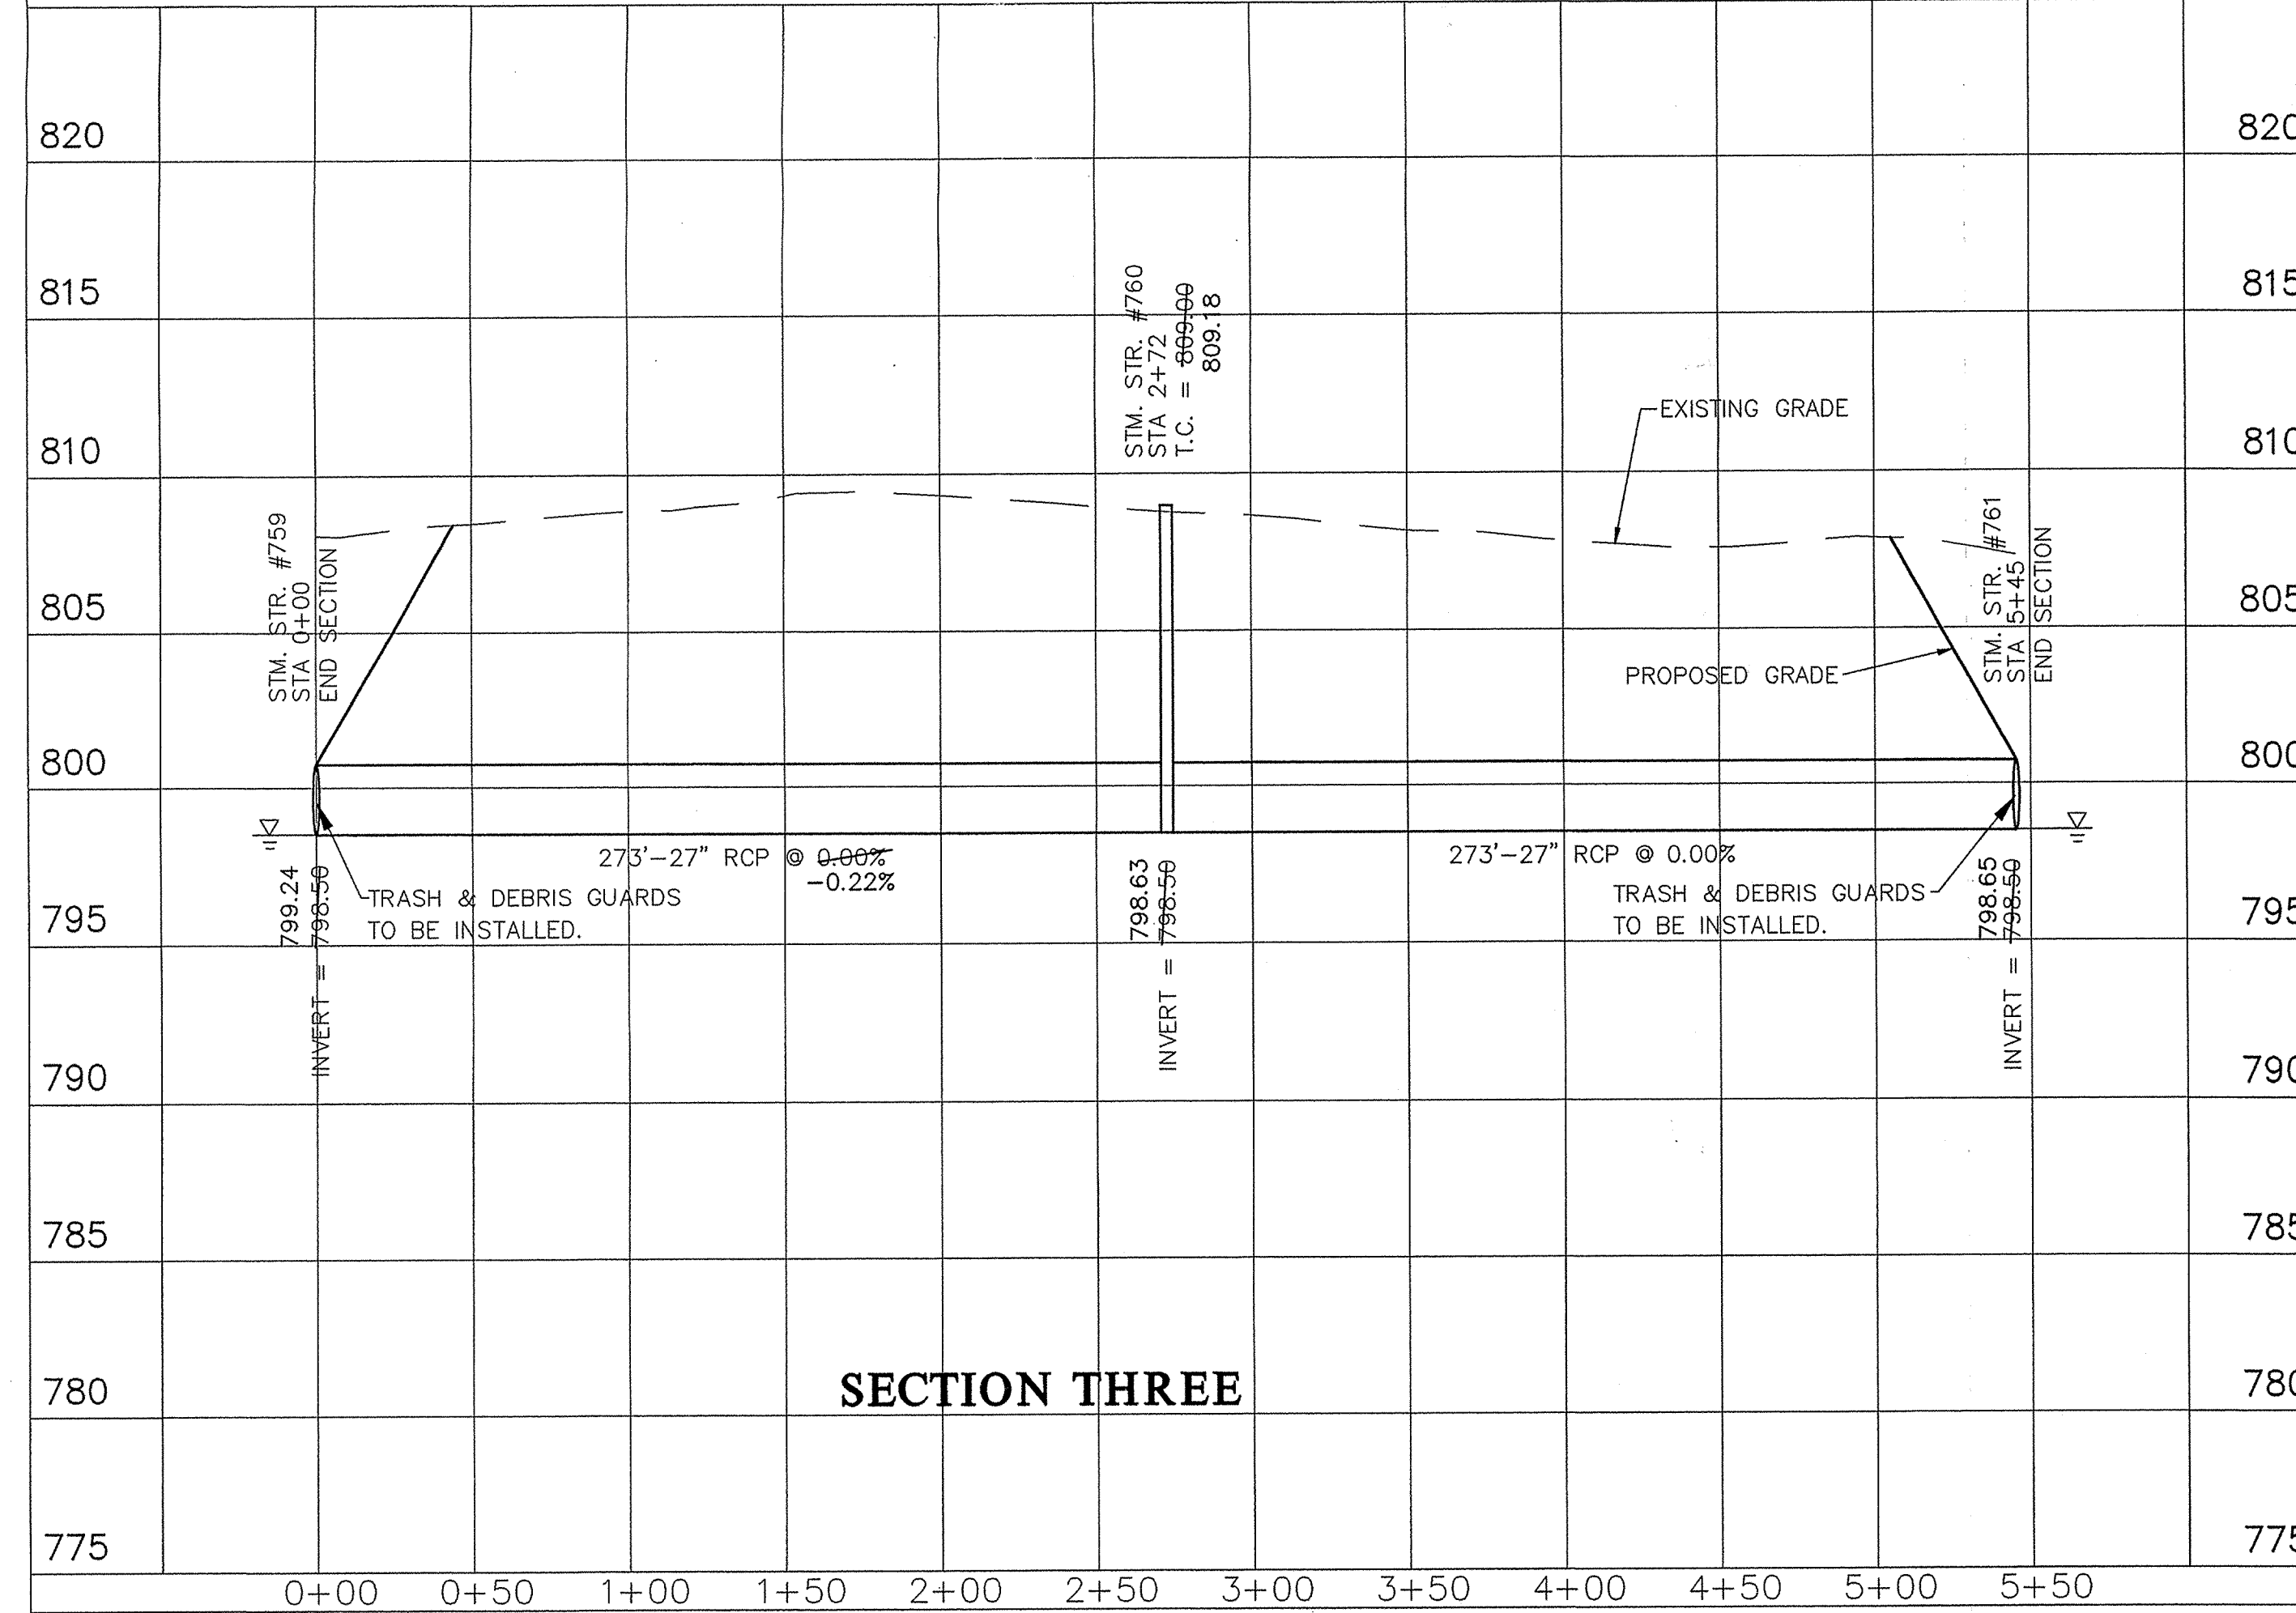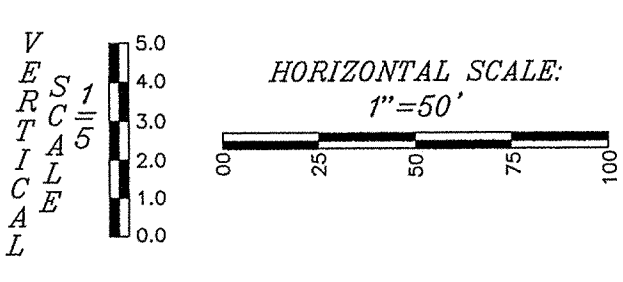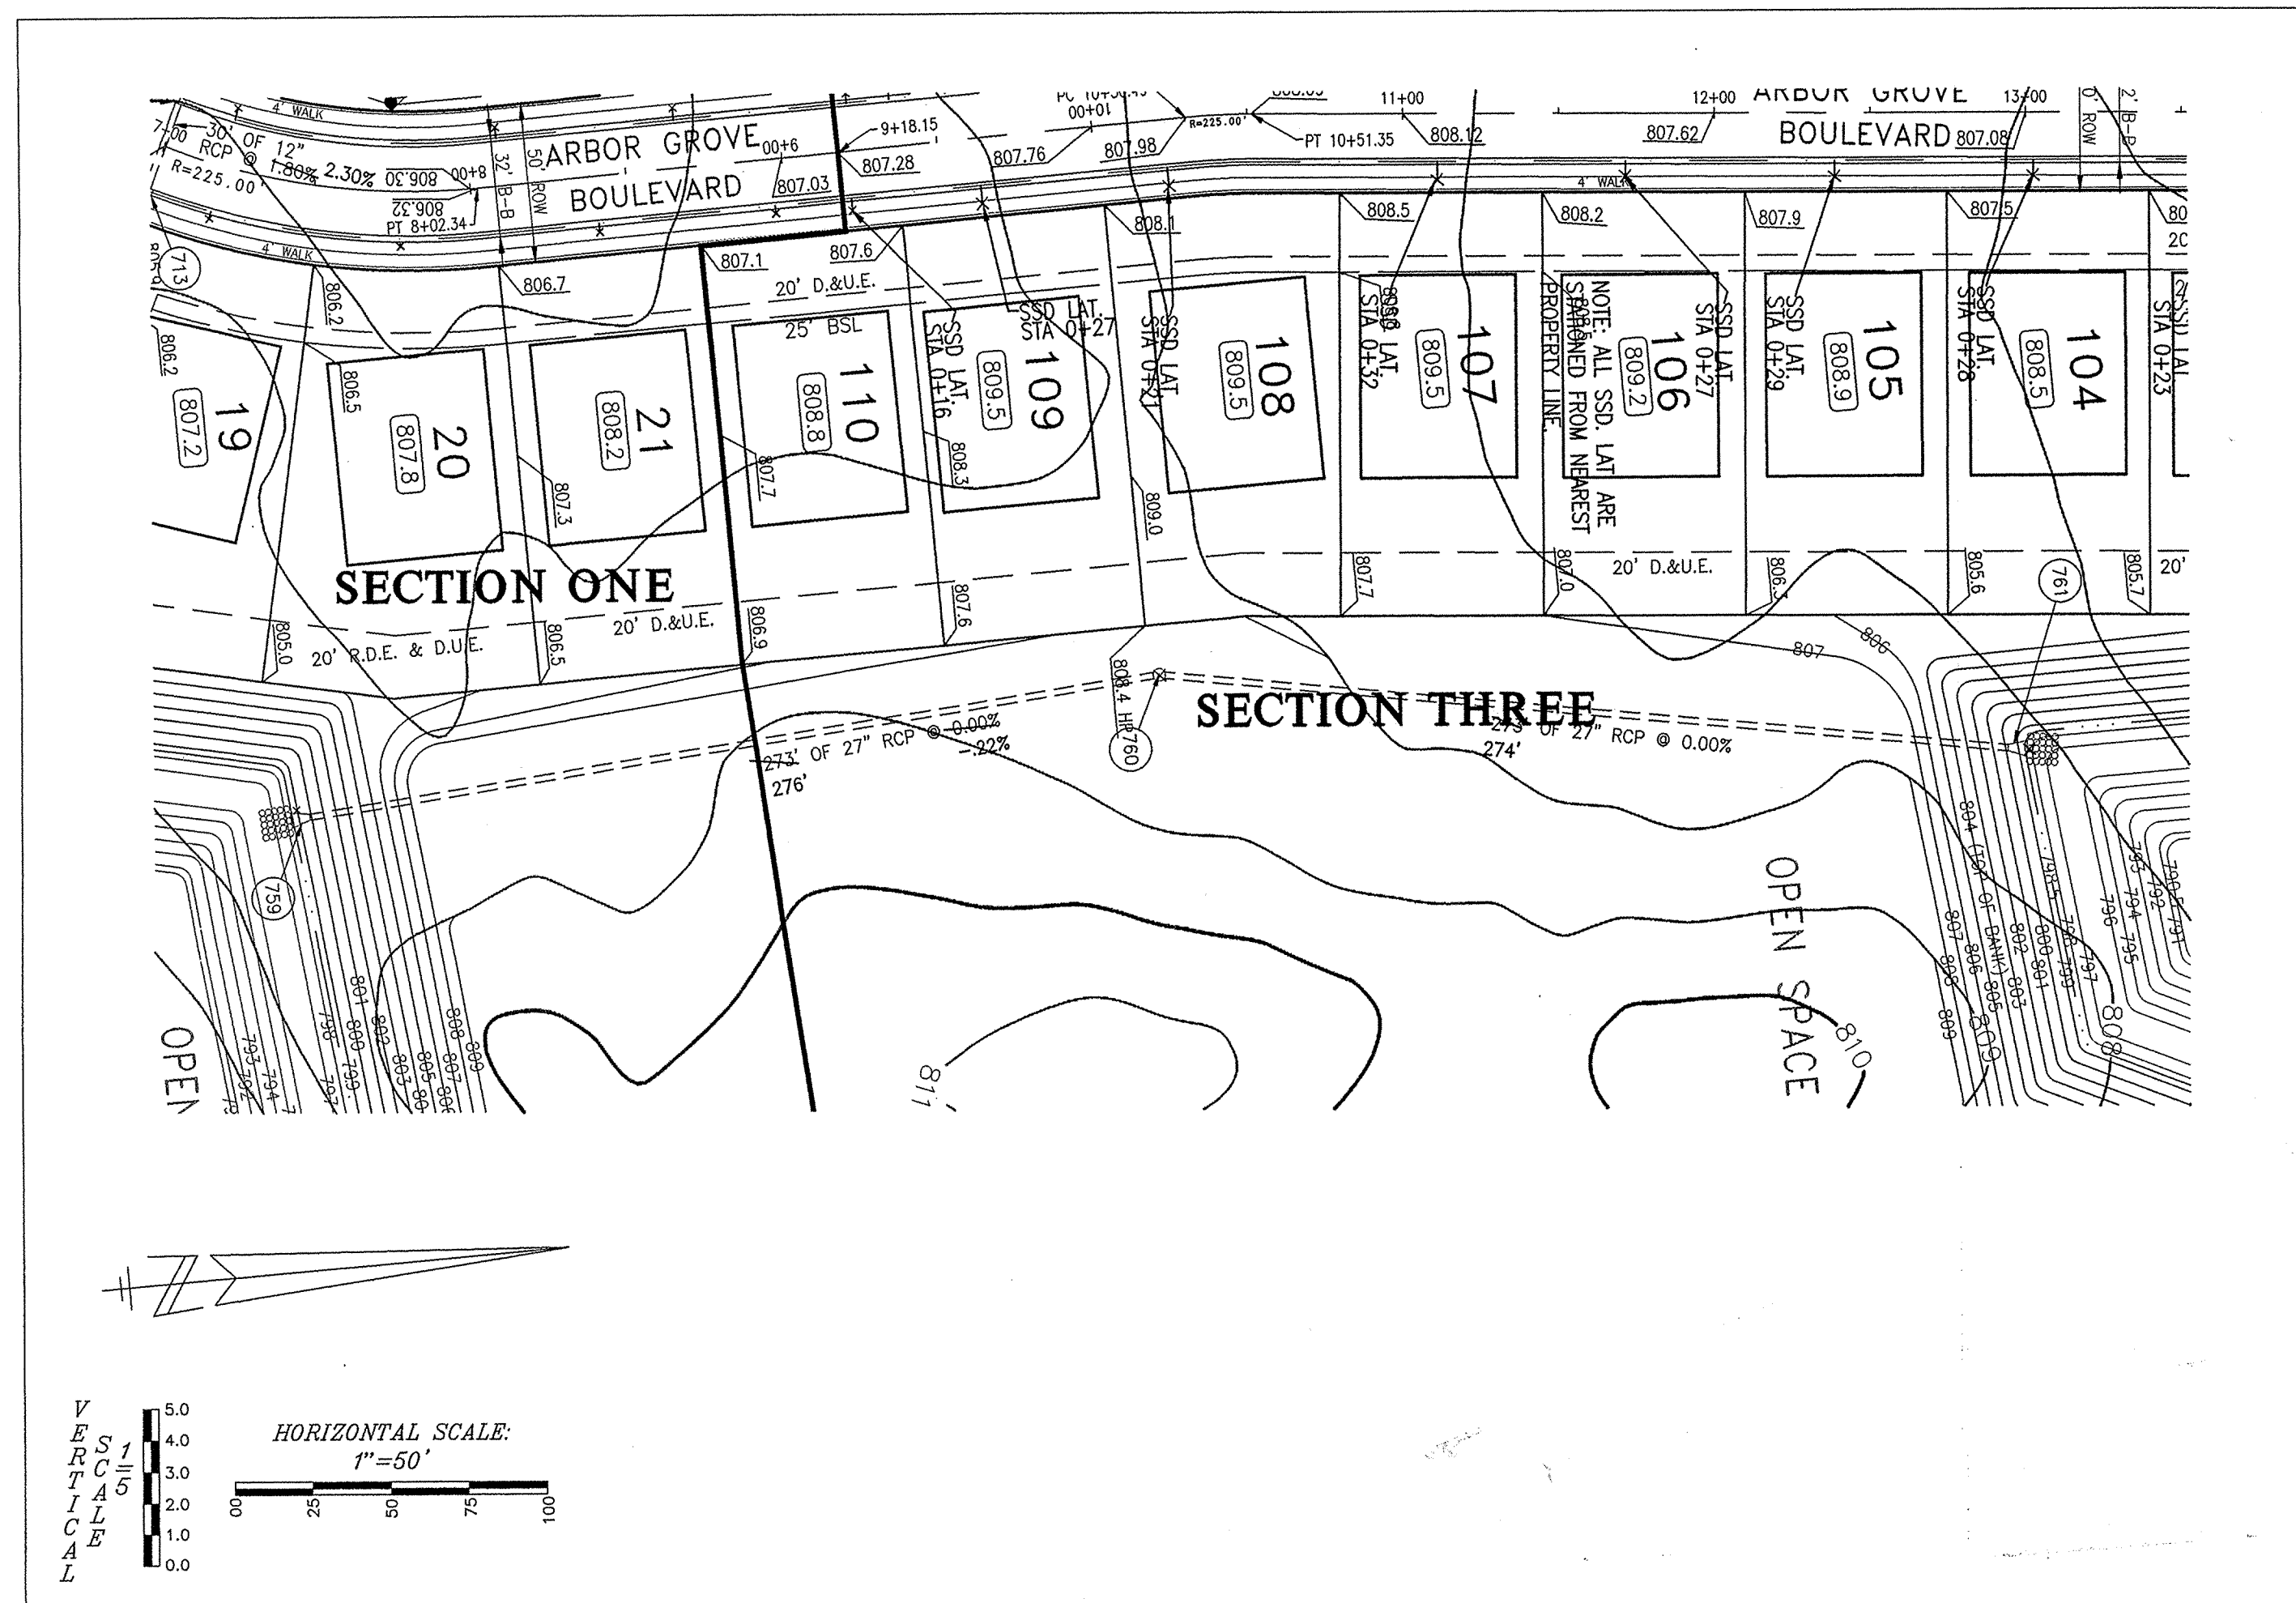

- LEGEND**
- RIGHT-OF-WAY LINE
  - STORM SEWER LINE
  - SWALE
  - SANITARY SEWER LINE
  - SANITARY SEWER MANHOLE
  - SANITARY SEWER LATERAL
  - FLOW DIRECTION
  - EXISTING SPOT ELEVATION
  - PROPOSED ELEVATION
  - STORM BEEHIVE INLET
  - STORM INLET
  - T.C. TOP OF CASTING
  - INV. INVERT
  - RCP REINFORCED CONCRETE PIPE
  - M.H. MANHOLE
  - STR. STRUCTURE
  - D. & U.E. DRAINAGE AND UTILITY EASEMENT
  - S.D. & U.E. SANITARY, DRAINAGE, AND UTILITY EASEMENT
  - SAN. SANITARY SEWER
  - H.C.P. HANDICAP RAMP
  - M.E. MATCH EXISTING GRADE
  - S.S.D. SUBSURFACE DRAIN
  - S.S.P. SANITARY SEWER PIPE (SDR-35)
  - S.S.P.(D.I.) SANITARY SEWER PIPE (DUCTILE IRON)
  - N.P.E. NORMAL POOL ELEVATION
  - P.P.E. PROPOSED PAD ELEVATION
  - M.P.E. MINIMUM PAD ELEVATION
  - TYP. TYPICAL
  - PROP. PROPOSED
  - EX. EXISTING
  - R. RADIUS
  - X SUB SURFACE DRAIN LATERALS AS-BUILT LOCATION
  - SECTION ONE

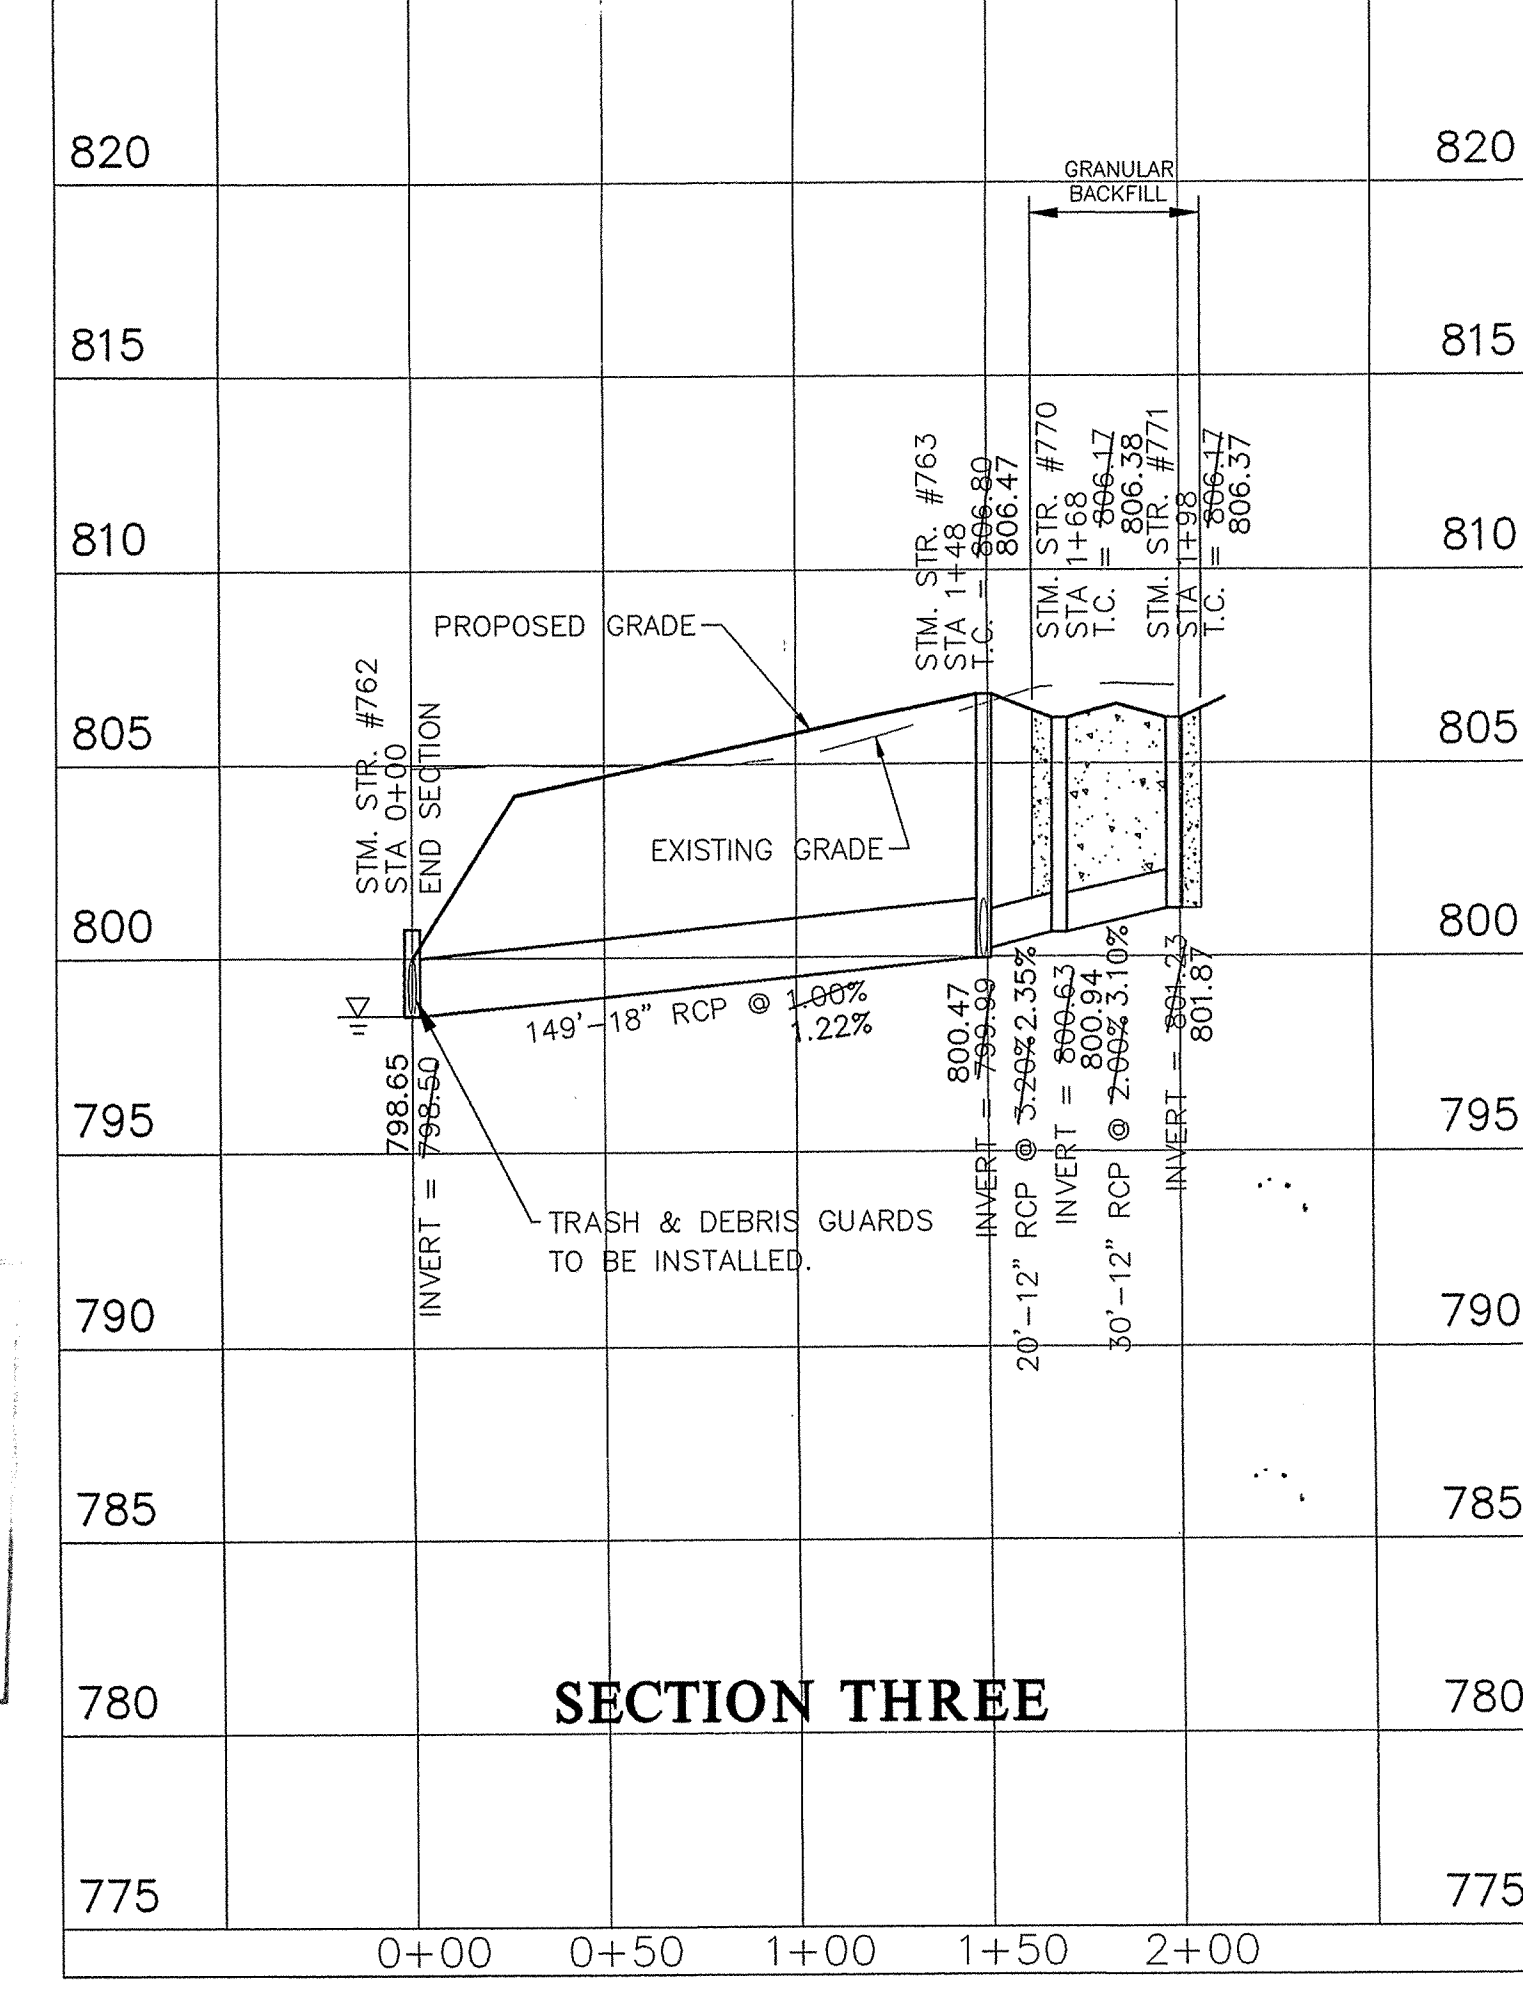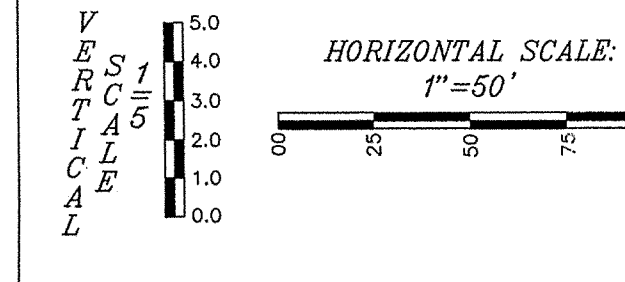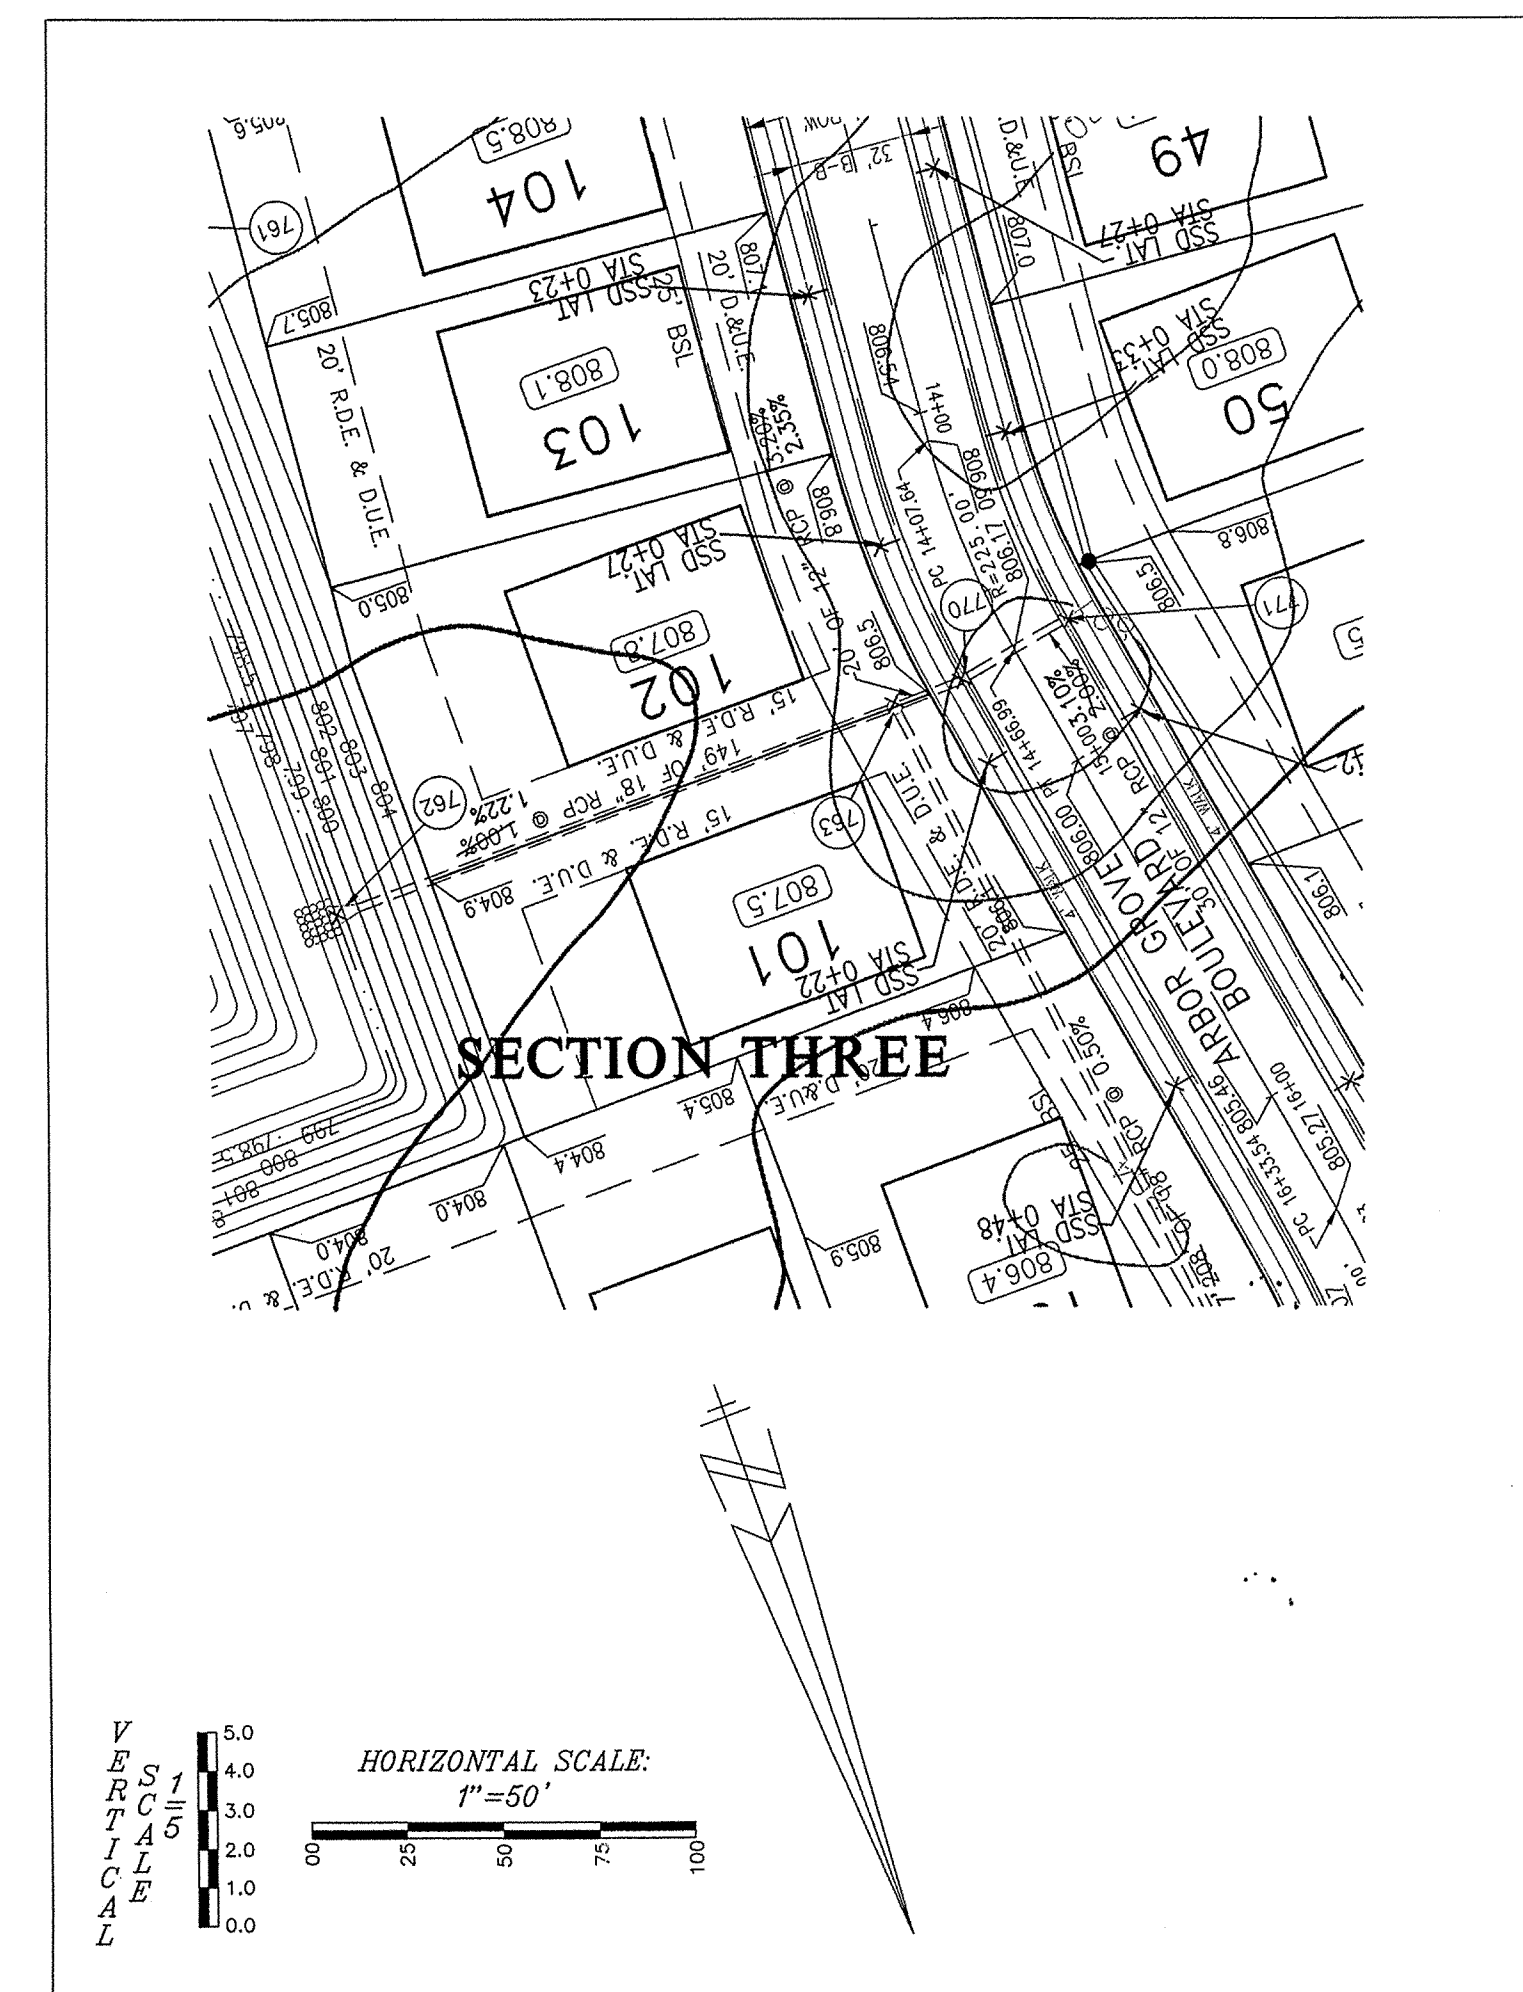

**RECORD DRAWING**  
 STORM SEWER AS-BUILTS  
 STORM SEWER STRUCTURES ONLY  
 SECTION 3 ONLY  
 6/13/01

This information was gathered for input into the Hamilton County Geographical Information System. This document is considered an official record of the GIS.

Entry Date: 8-25-04

Entered by: JOH

**WEIHE ENGINEERS, INC.**

18245 NORTH COLLIER AVENUE  
 INDIANAPOLIS, INDIANA 46260  
 (317) 846-6611 FAX: (317) 849-0546  
 TOLL-FREE (800) 452-6408

CIVIL ENGINEERS • LAND SURVEYORS • LAND PLANNERS • LANDSCAPE ARCHITECTS

ALLAN H. WEIHE, P.E., L.S.  
 PRESIDENT

PROJECT NO.: 98-C036  
 DATE: 6/21/00  
 BY: JAC  
 CHECKED BY: JAC  
 DATE: 6/21/00

REVISIONS:  
 MINOR REVISIONS TO STORM SEWER AS-BUILTS - SECTION 3 ONLY

REGISTERED PROFESSIONAL ENGINEER  
 STATE OF INDIANA  
 NO. 8827  
 ALLAN H. WEIHE


PREPARED FOR:  
**ARBOR GROVE SECTION THREE**  
 BAY DEVELOPMENT CORP.  
 STORM PLAN & PROFILE SHEET

Part of the E/2 of the SW/4 and W/2 of the SE/4 of Sec. 8-T18N-R5E, Noblesville Twp., Hamilton Co., Indiana.



SHEET NO. \_\_\_\_\_

FILED  
 OCT 31 2001  
 OFFICE OF HAMILTON COUNTY SURVEYOR

- LEGEND**
- RIGHT-OF-WAY LINE
  - STORM SEWER LINE
  - SWALE
  - SANITARY SEWER LINE
  - SANITARY SEWER MANHOLE
  - SANITARY SEWER LATERAL
  - FLOW DIRECTION
  - EXISTING SPOT ELEVATION
  - EXISTING CONTOURS
  - PROPOSED ELEVATION
  - STORM BEHIVE INLET
  - STORM INLET
  - TOP OF CASTING
  - INVERT
  - REINFORCED CONCRETE PIPE
  - MANHOLE
  - STRUCTURE
  - DRAINAGE AND UTILITY EASEMENT
  - SANITARY, DRAINAGE, AND UTILITY EASEMENT
  - SANITARY SEWER
  - HANDICAP RAMP
  - MATCH EXISTING GRADE
  - SUBSURFACE DRAIN AND SUMP LINE
  - STORM SEWER
  - GRANULAR BACKFILL
  - CONCRETE END SECTION
  - SUBSURFACE DRAIN
  - SANITARY SEWER PIPE (SDR-35)
  - SANITARY SEWER PIPE (DUCTILE IRON)
  - NORMAL POOL ELEVATION
  - PROPOSED PAD ELEVATION
  - MINIMUM PAD ELEVATION
  - TYPICAL
  - PROPOSED
  - EXISTING
  - RADIUS
  - SUB SURFACE DRAIN
  - LATERALS AS-BUILT LOCATION



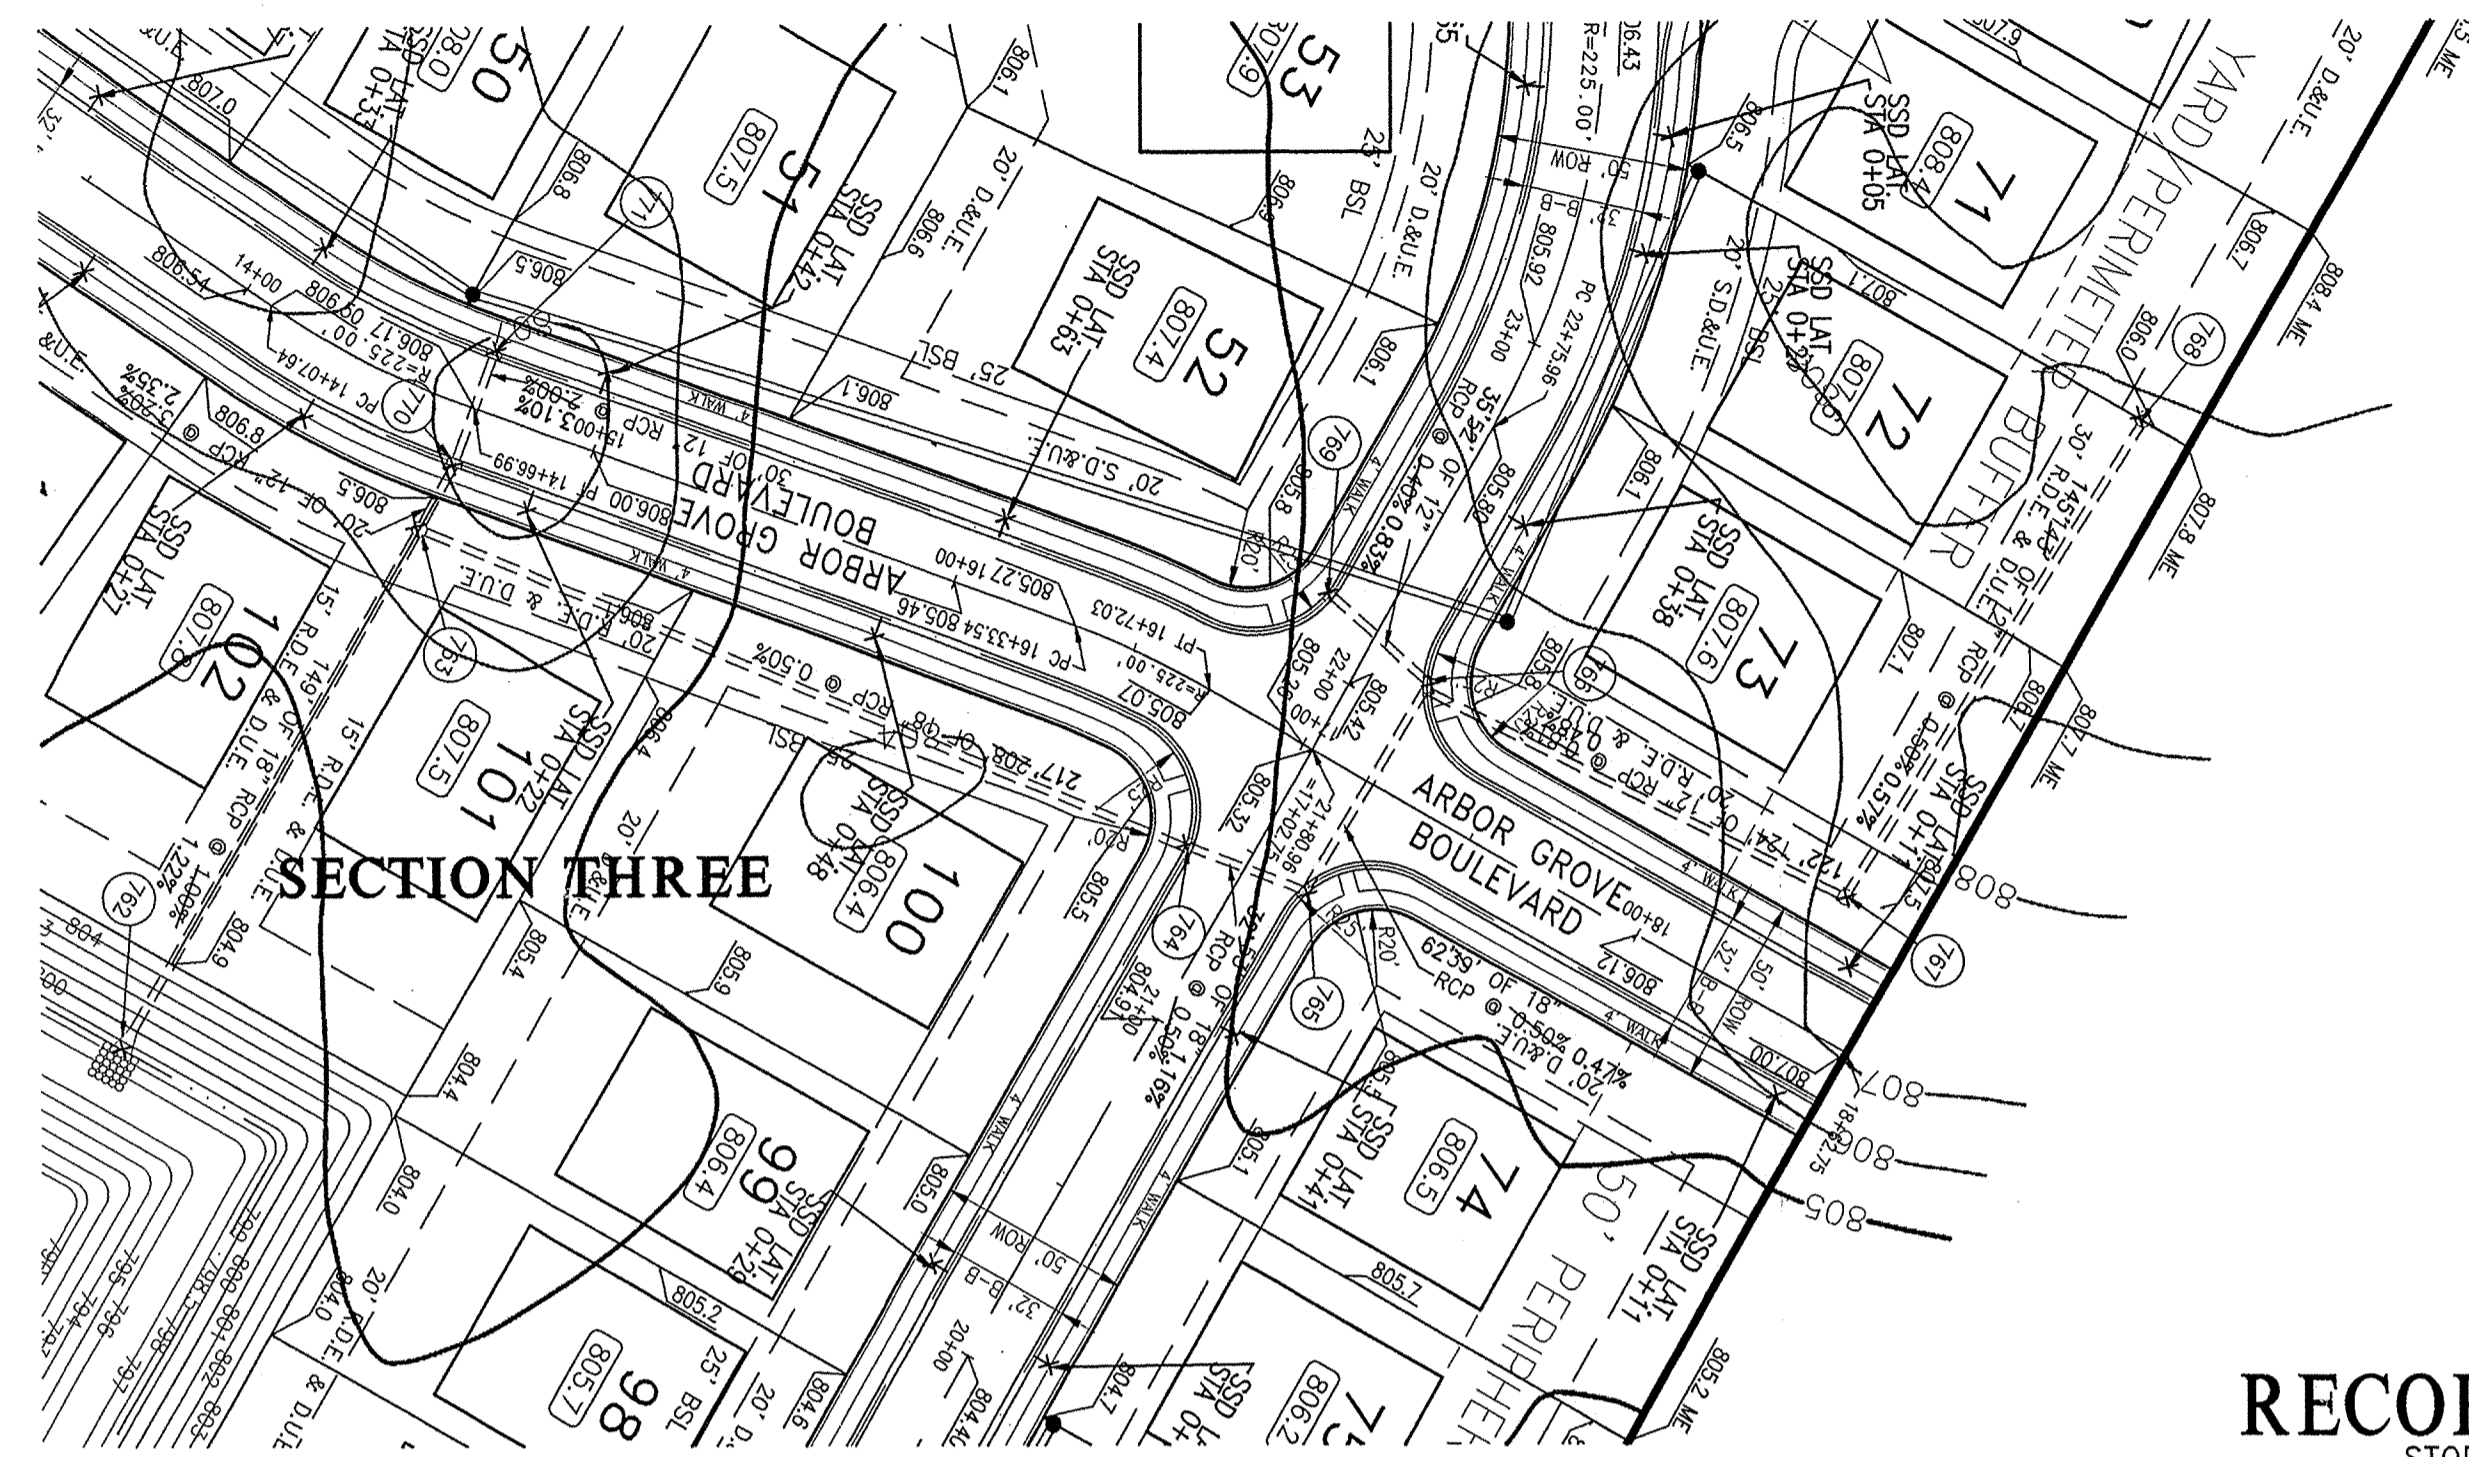


**RECORD DRAWING**  
STORM SEWER AS-BUILTS  
STORM SEWER STRUCTURES ONLY  
SECTION 3 ONLY  
6/13/01

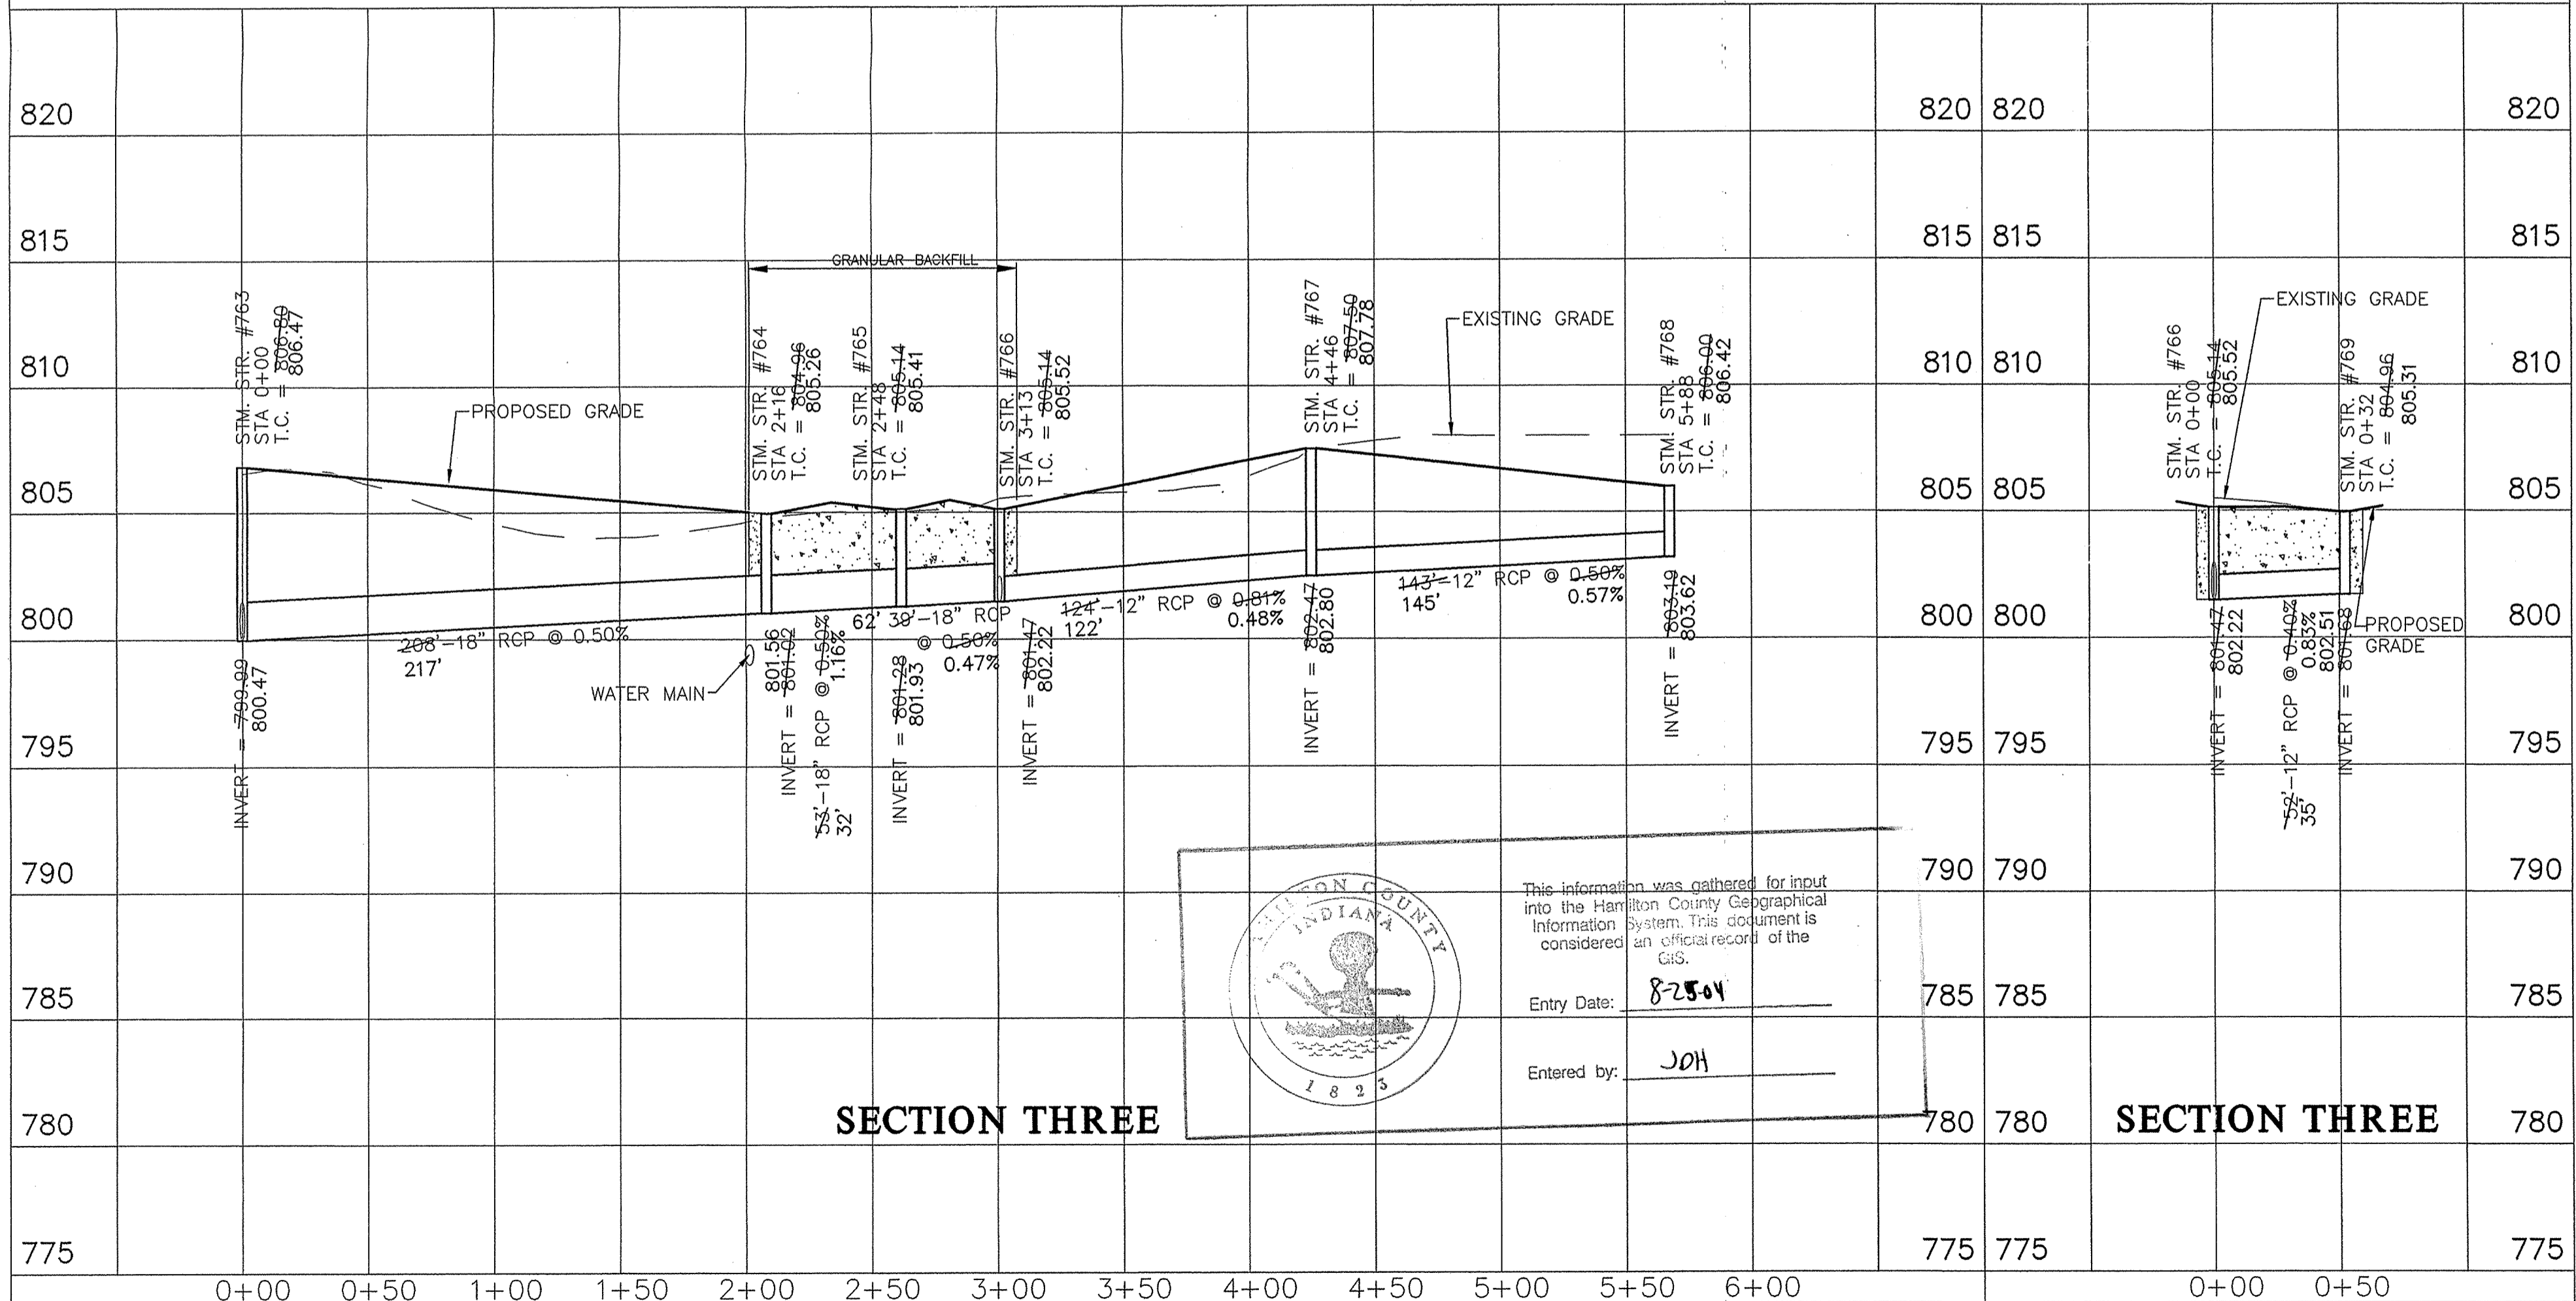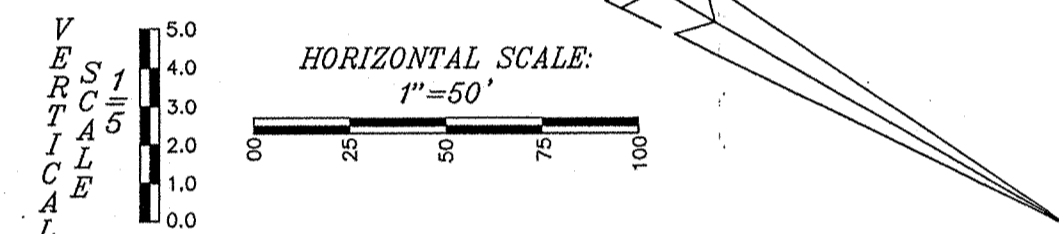

This information was gathered for input into the Hamilton County Geographical Information System. This document is an official record of the GIS.

Entry Date: 8-25-04  
Entered by: JDH

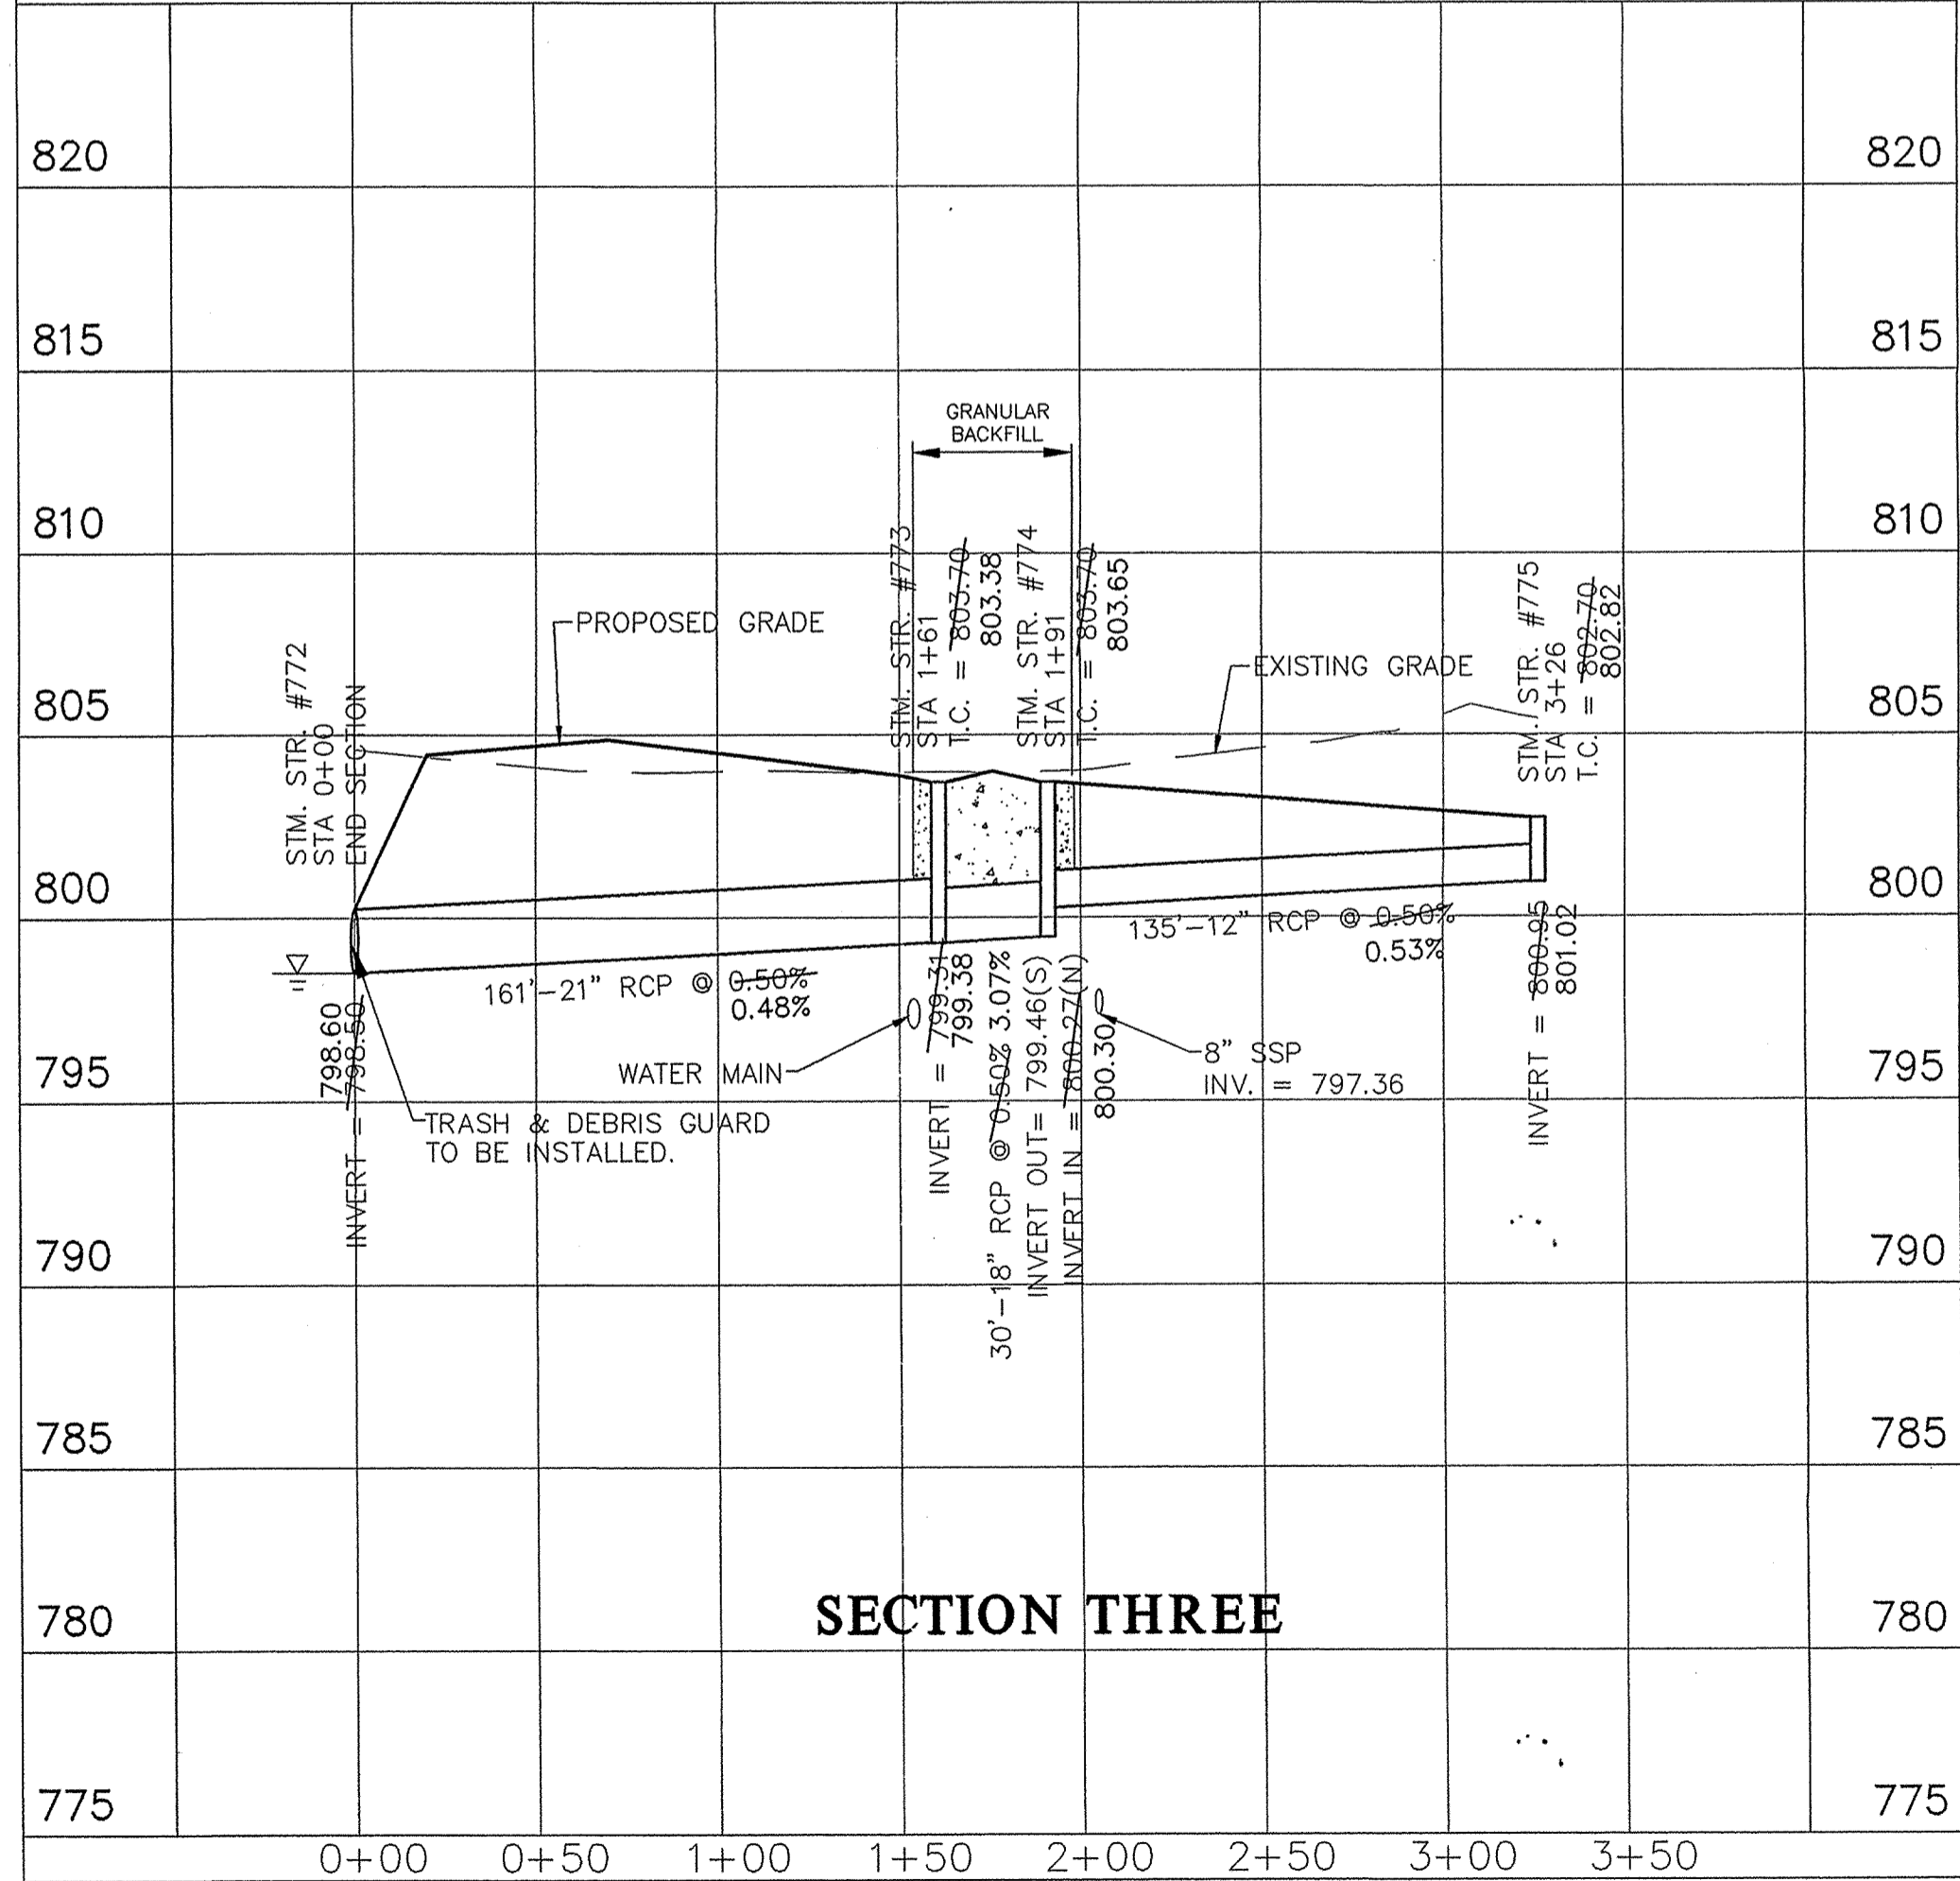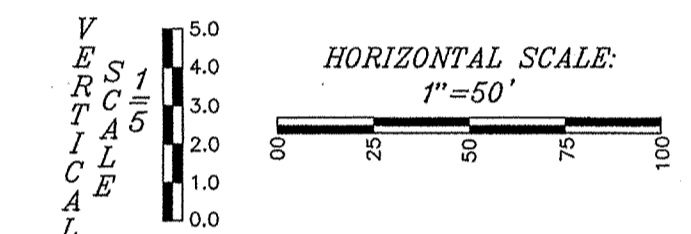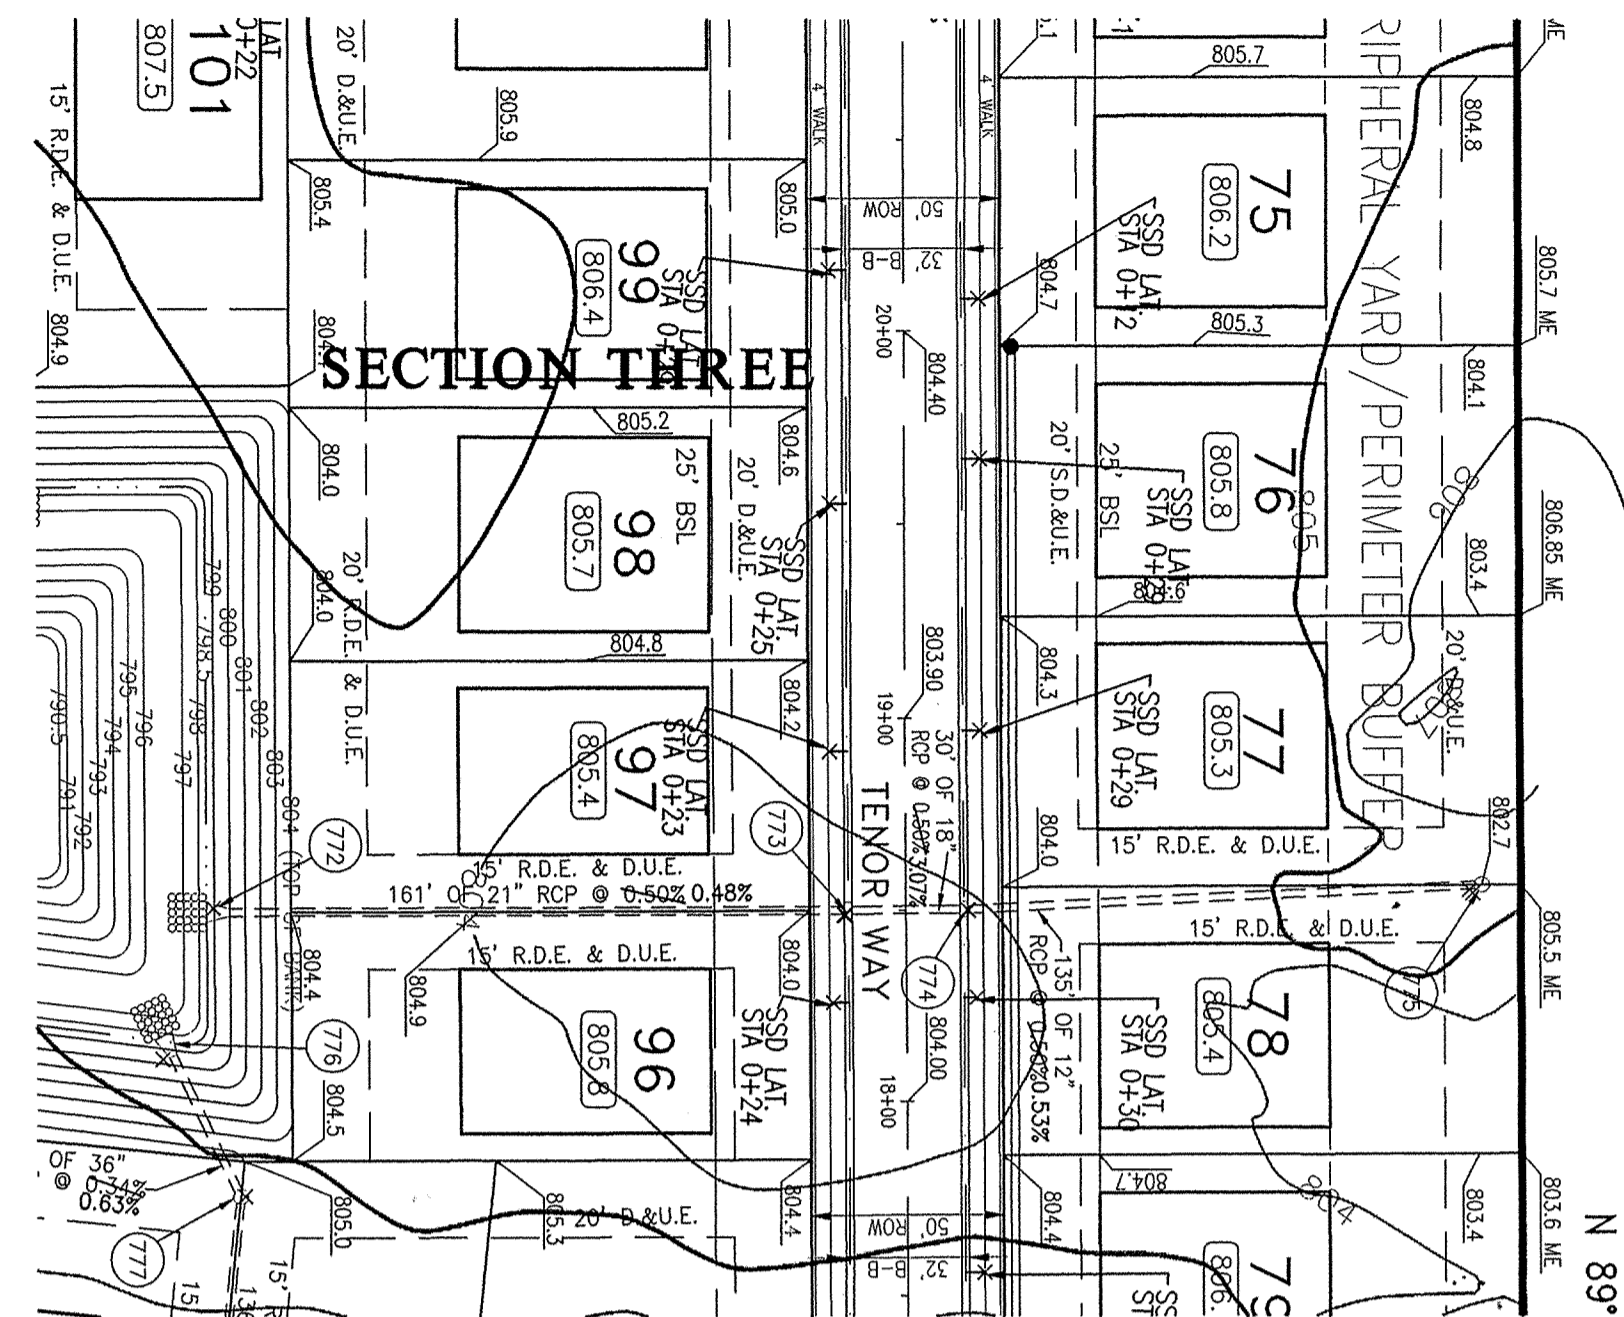

**WEIHE ENGINEERS, INC.**

15535 MARKET GARDENS AVENUE  
INDIANAPOLIS, INDIANA 46220  
(317) 846-6611 FAX: (317) 843-0546  
TOLL-FREE (800) 452-6406

ALLAN H. WEIHE, P.E., L.S.  
PRESIDENT

CIVIL ENGINEERS • LAND SURVEYORS • LAND PLANNERS • LANDSCAPE ARCHITECTS

PROJECT NO.:	99-0336
DATE:	6/21/00
BY:	JDH
DATE:	6/13/01
REVISIONS:	MINOR REVISIONS TO STORM SEWER AS-BUILTS - SECTION 3 ONLY
DATE:	6/21/00
BY:	JDH
DATE:	6/13/01
REVISIONS:	MINOR REVISIONS TO STORM SEWER AS-BUILTS - SECTION 3 ONLY
DATE:	6/21/00
BY:	JDH
DATE:	6/13/01

REGISTERED PROFESSIONAL ENGINEER

ALLAN H. WEIHE  
NO. 8827  
STATE OF INDIANA

ALLAN H. WEIHE P.E. 8827


PREPARED FOR:  
**ARBOR GROVE SECTION THREE**

BAY DEVELOPMENT CORP.  
STORM PLAN & PROFILE SHEET



Part of the E/2 of the SW/4 and W/2 of the SE/4 of Sec. 8-T18N-R9E, Noblesville, Ind.

SHEET NO. 13

**FILED**  
OCT 31 2001  
OFFICE OF HAMILTON COUNTY SURVEYOR

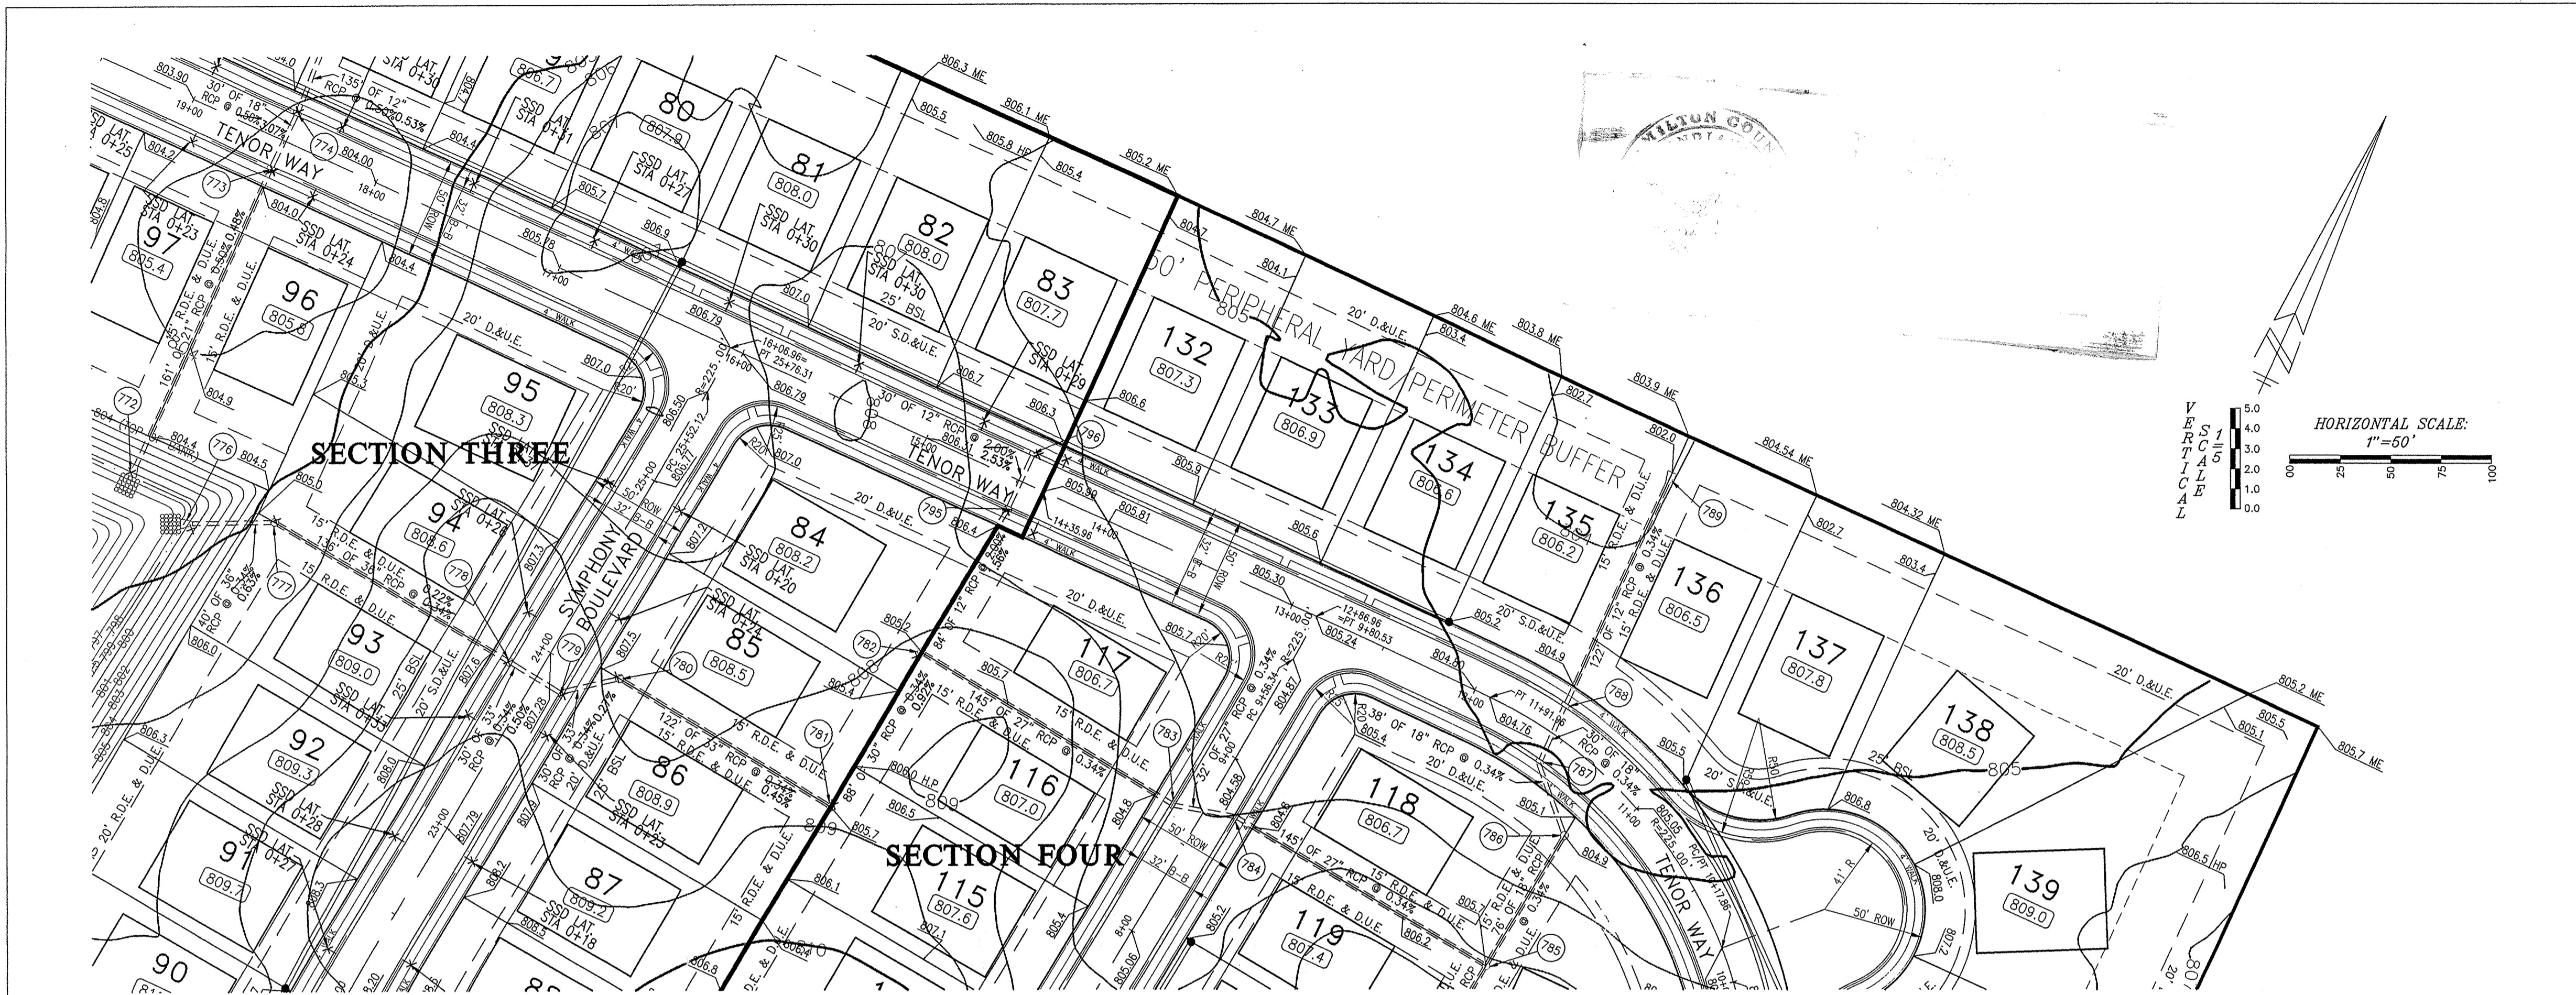

- LEGEND**
- RIGHT-OF-WAY LINE
  - STORM SEWER LINE
  - SWALE
  - SANITARY SEWER LINE
  - SANITARY SEWER MANHOLE
  - SANITARY SEWER LATERAL
  - FLOW DIRECTION
  - EXISTING SPOT ELEVATION
  - EXISTING CONTOURS
  - PROPOSED ELEVATION
  - STORM BEEHIVE INLET
  - STORM INLET
  - TOP OF CASTING
  - INVERT
  - REINFORCED CONCRETE PIPE
  - MANHOLE
  - STRUCTURE
  - DRAINAGE AND UTILITY EASEMENT
  - SANITARY, DRAINAGE, AND UTILITY EASEMENT
  - SANITARY SEWER
  - HANDICAP RAMP
  - MATCH EXISTING GRADE
  - SUSURFACE DRAIN AND SUMP LINE
  - STORM SEWER
  - GRANULAR BACKFILL
  - CONCRETE END SECTION
  - SUBSURFACE DRAIN
  - SANITARY SEWER PIPE (SDR-35)
  - SANITARY SEWER PIPE (DUCTILE IRON)
  - NORMAL POOL ELEVATION
  - PROPOSED PAD ELEVATION
  - MINIMUM PAD ELEVATION
  - TYPICAL
  - PROPOSED
  - EXISTING
  - RADIUS

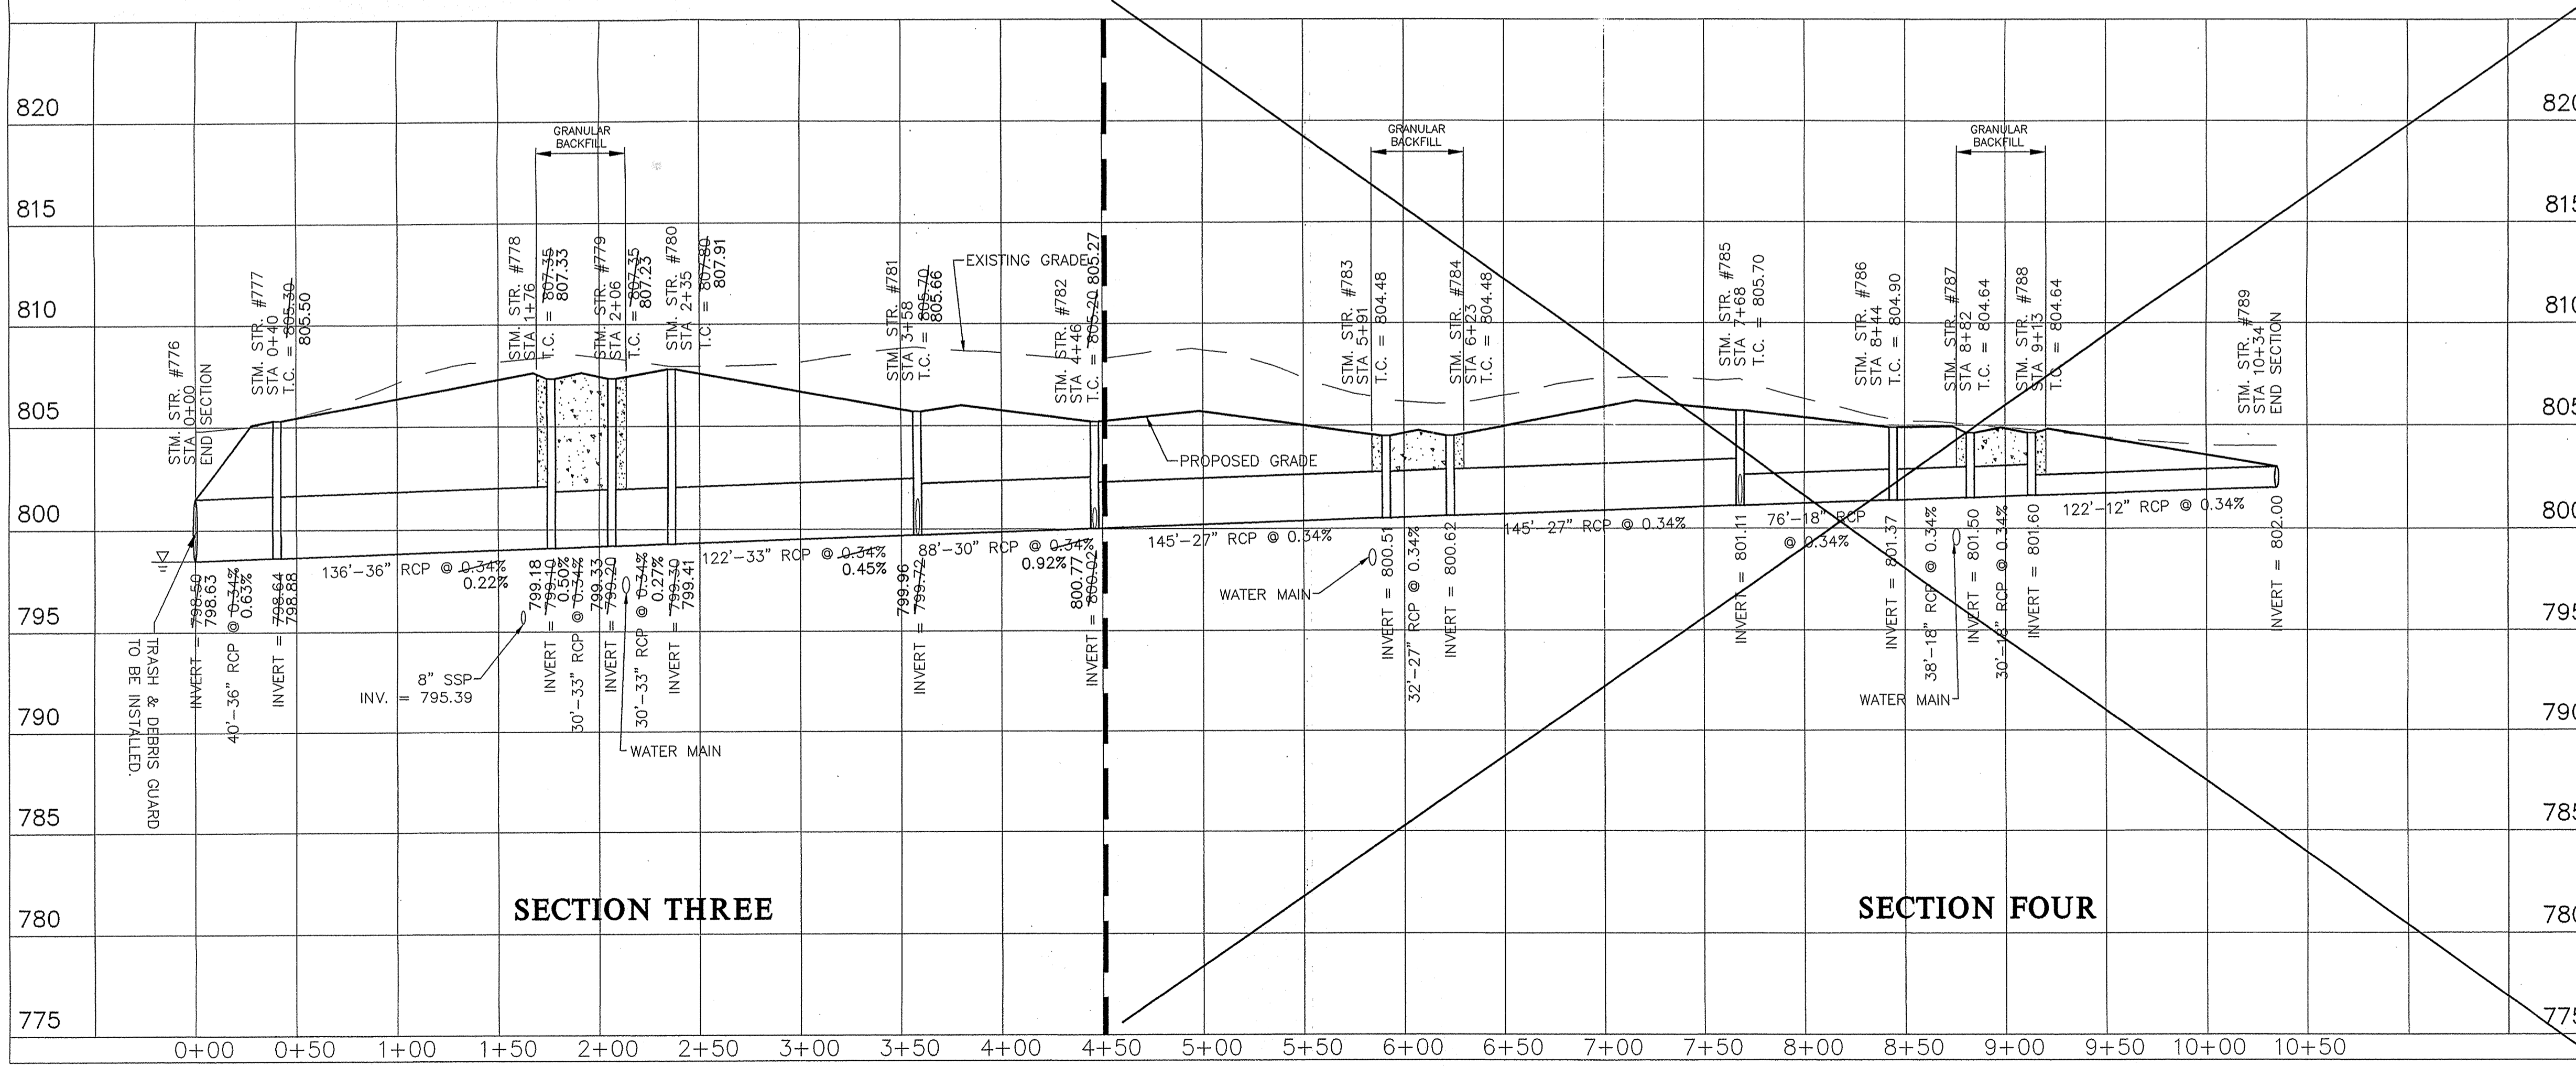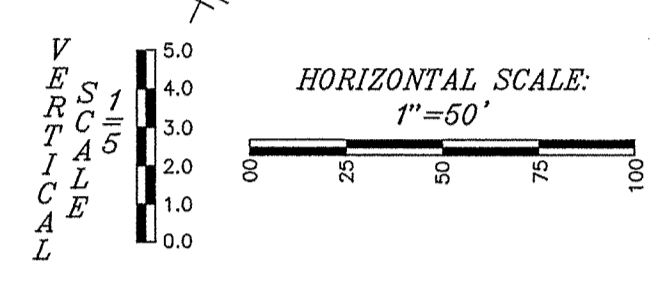

Entered by: JH  
 Date: 5-17-00

This information was gathered for field use by the Hamilton County Sanitary Sewer Department. For documents considered an official record of the City of Hamilton, Ohio.

**RECORD DRAWING**  
 STORM SEWER AS-BUILTS  
 STORM SEWER STRUCTURES ONLY  
 SECTION 3 ONLY  
 6/13/01

**FILED**  
 OCT 31 2001  
 OFFICE OF HAMILTON COUNTY SURVEYOR

**WEIHE ENGINEERS, INC.**  
 10505 NORTH COLLEGE AVENUE  
 INDIANAPOLIS, INDIANA 46260  
 TOLL-FREE (800) 452-8408

ALLAN H. WEIHE, P.E., I.S.  
 PRESIDENT

CIVIL ENGINEERS • LAND SURVEYORS • LAND PLANNERS • LANDSCAPE ARCHITECTS

---




PROJECT NO.: 99-0386  
 DWG. NAME: SUBSURFACE DRAINING  
 FIELD BY: EAC  
 DATE: 6/21/00/EAC/00E  
 6/13/01

REVISIONS:  
 MINOR REVISIONS  
 STORM SEWER AS-BUILTS - SECTION 3 ONLY




NO. 8827  
 STATE OF INDIANA  
 REGISTERED PROFESSIONAL ENGINEER  
 ALLAN H. WEIHE P.E. 8827

PREPARED FOR:  
**ARBOR GROVE SECTION THREE**  
 BAY DEVELOPMENT CORP.  
**STORM PLAN & PROFILE SHEET**  
 Part of the E/2 of the SW/4 and W/2 of the SE/4 of Sec. 8-T19N-18E, Noblesville Twp., Hamilton Co., Indiana.

SHEET NO. **14**

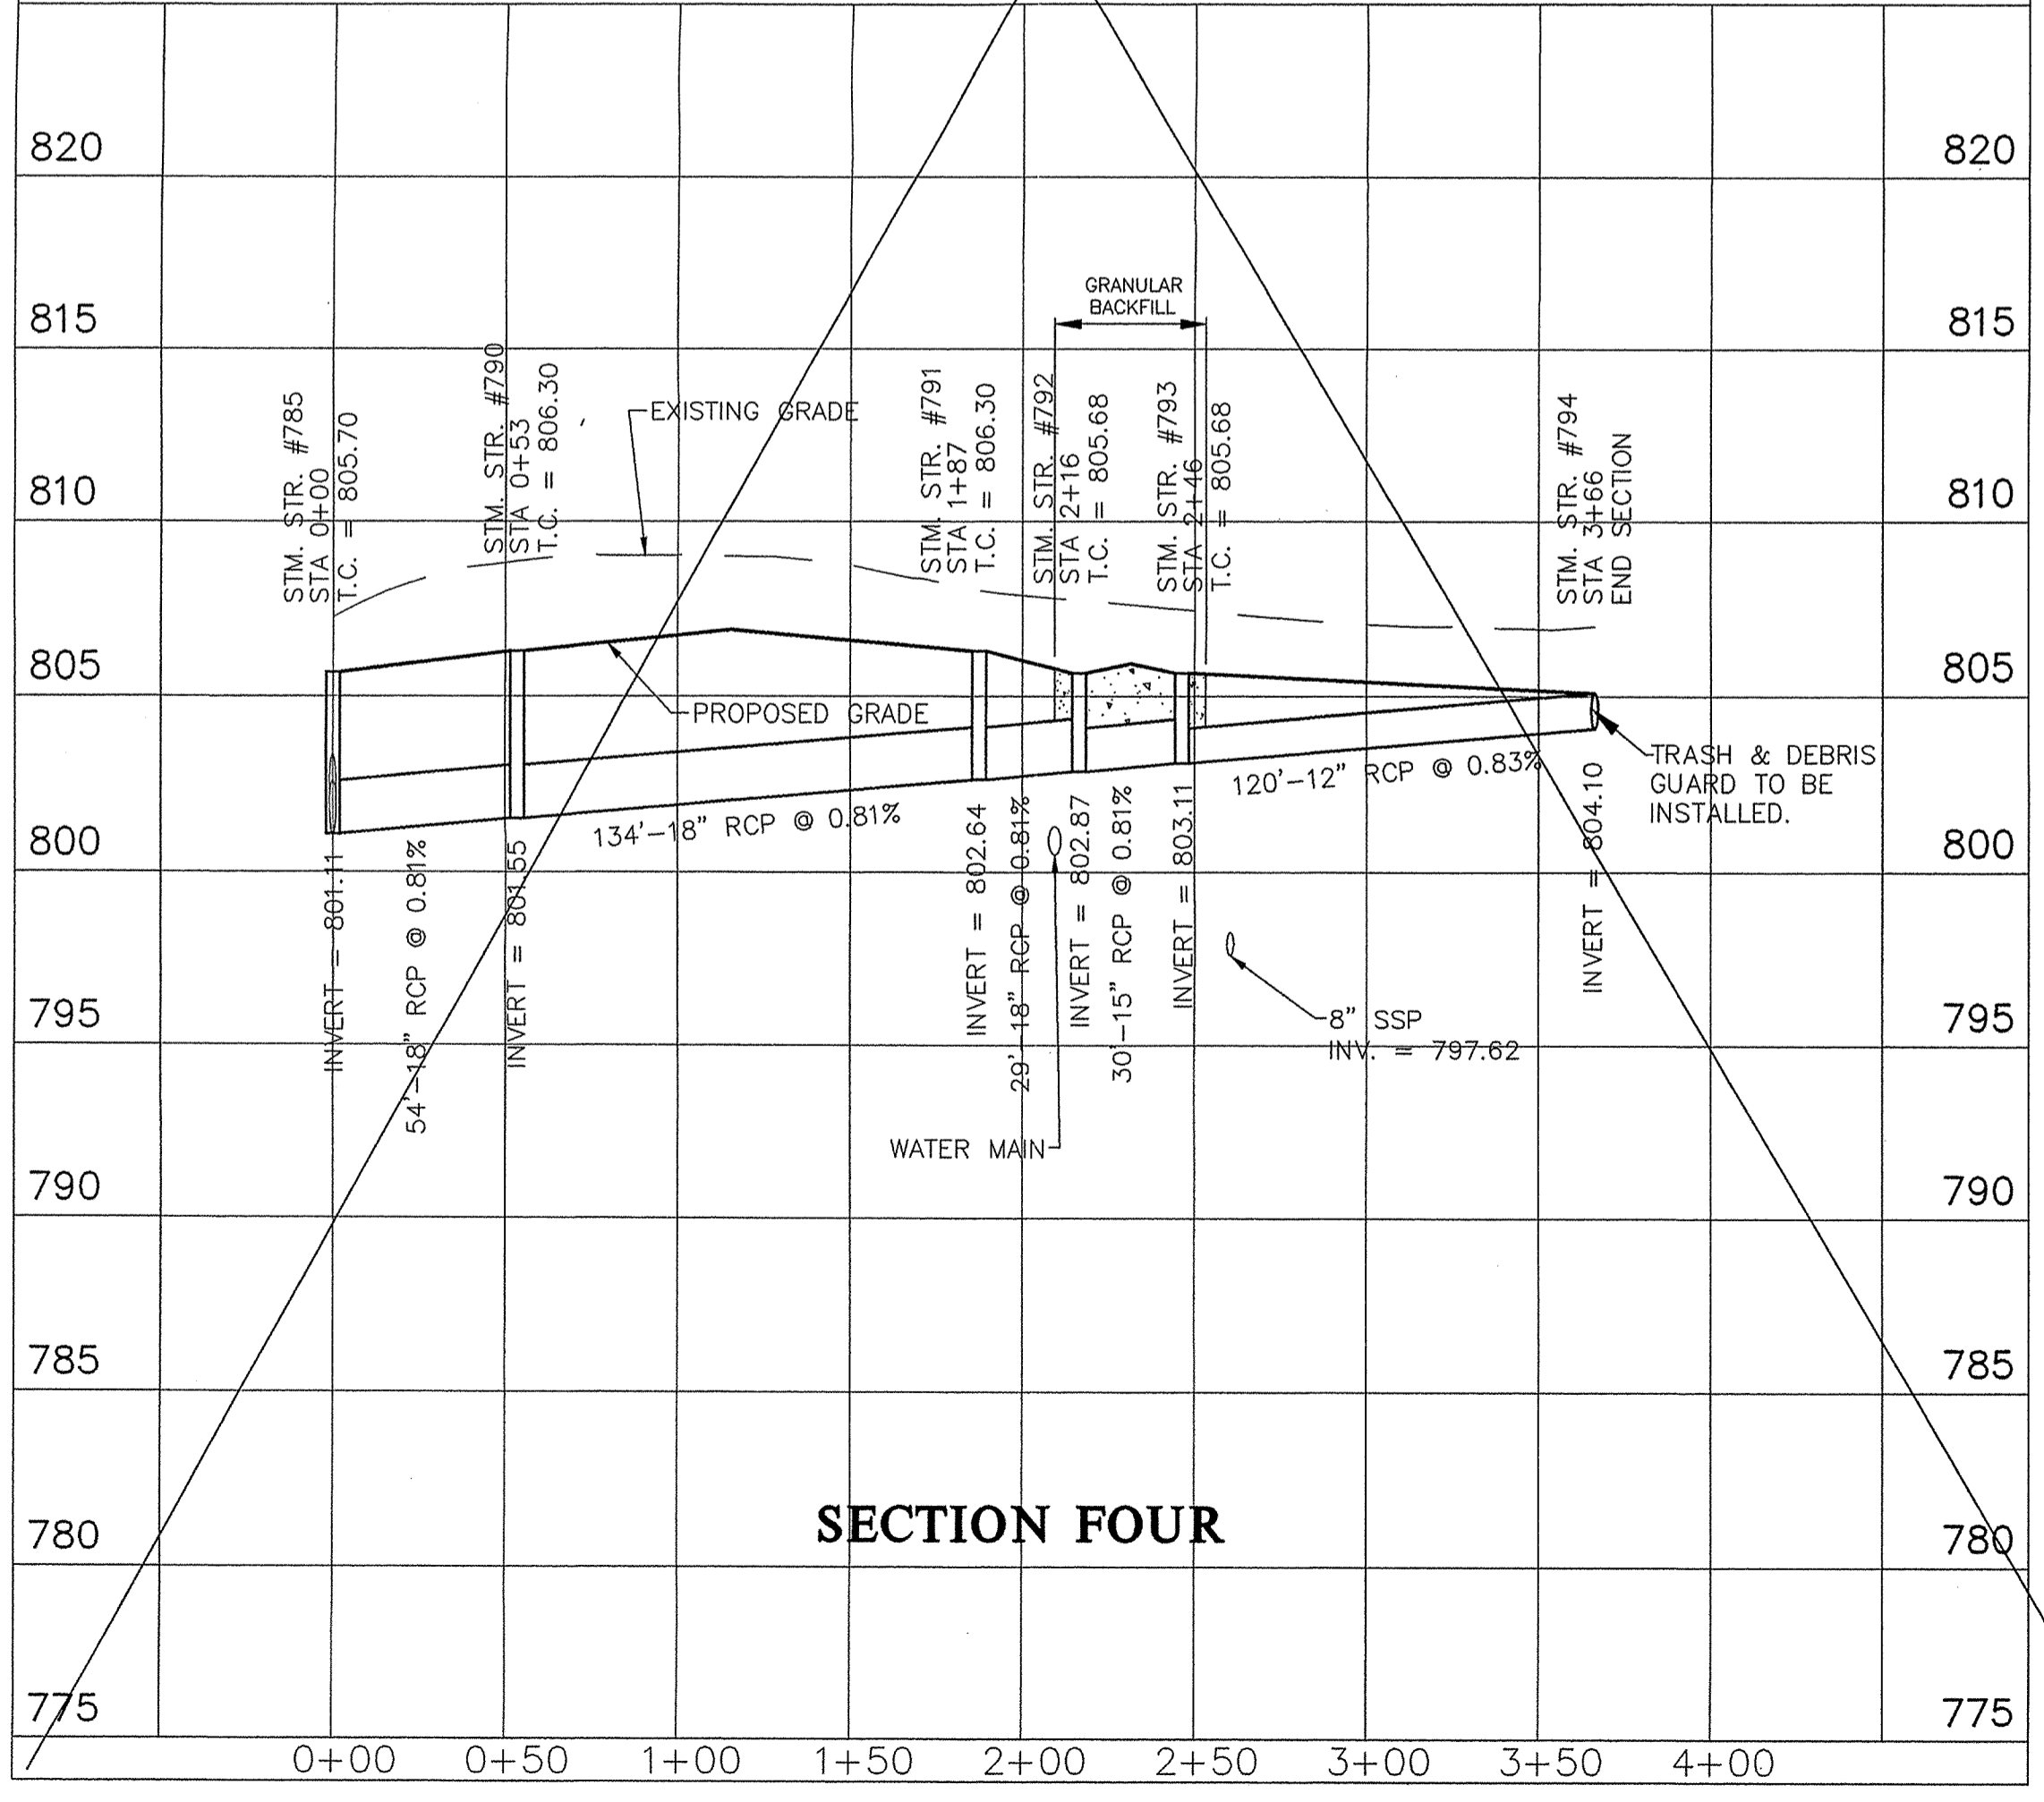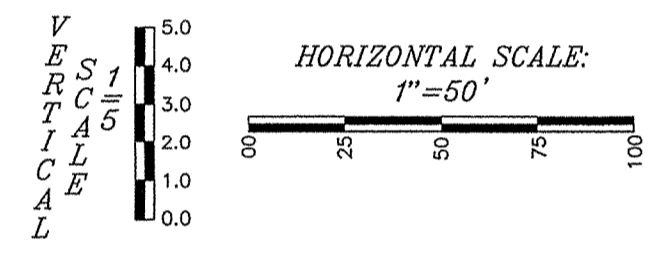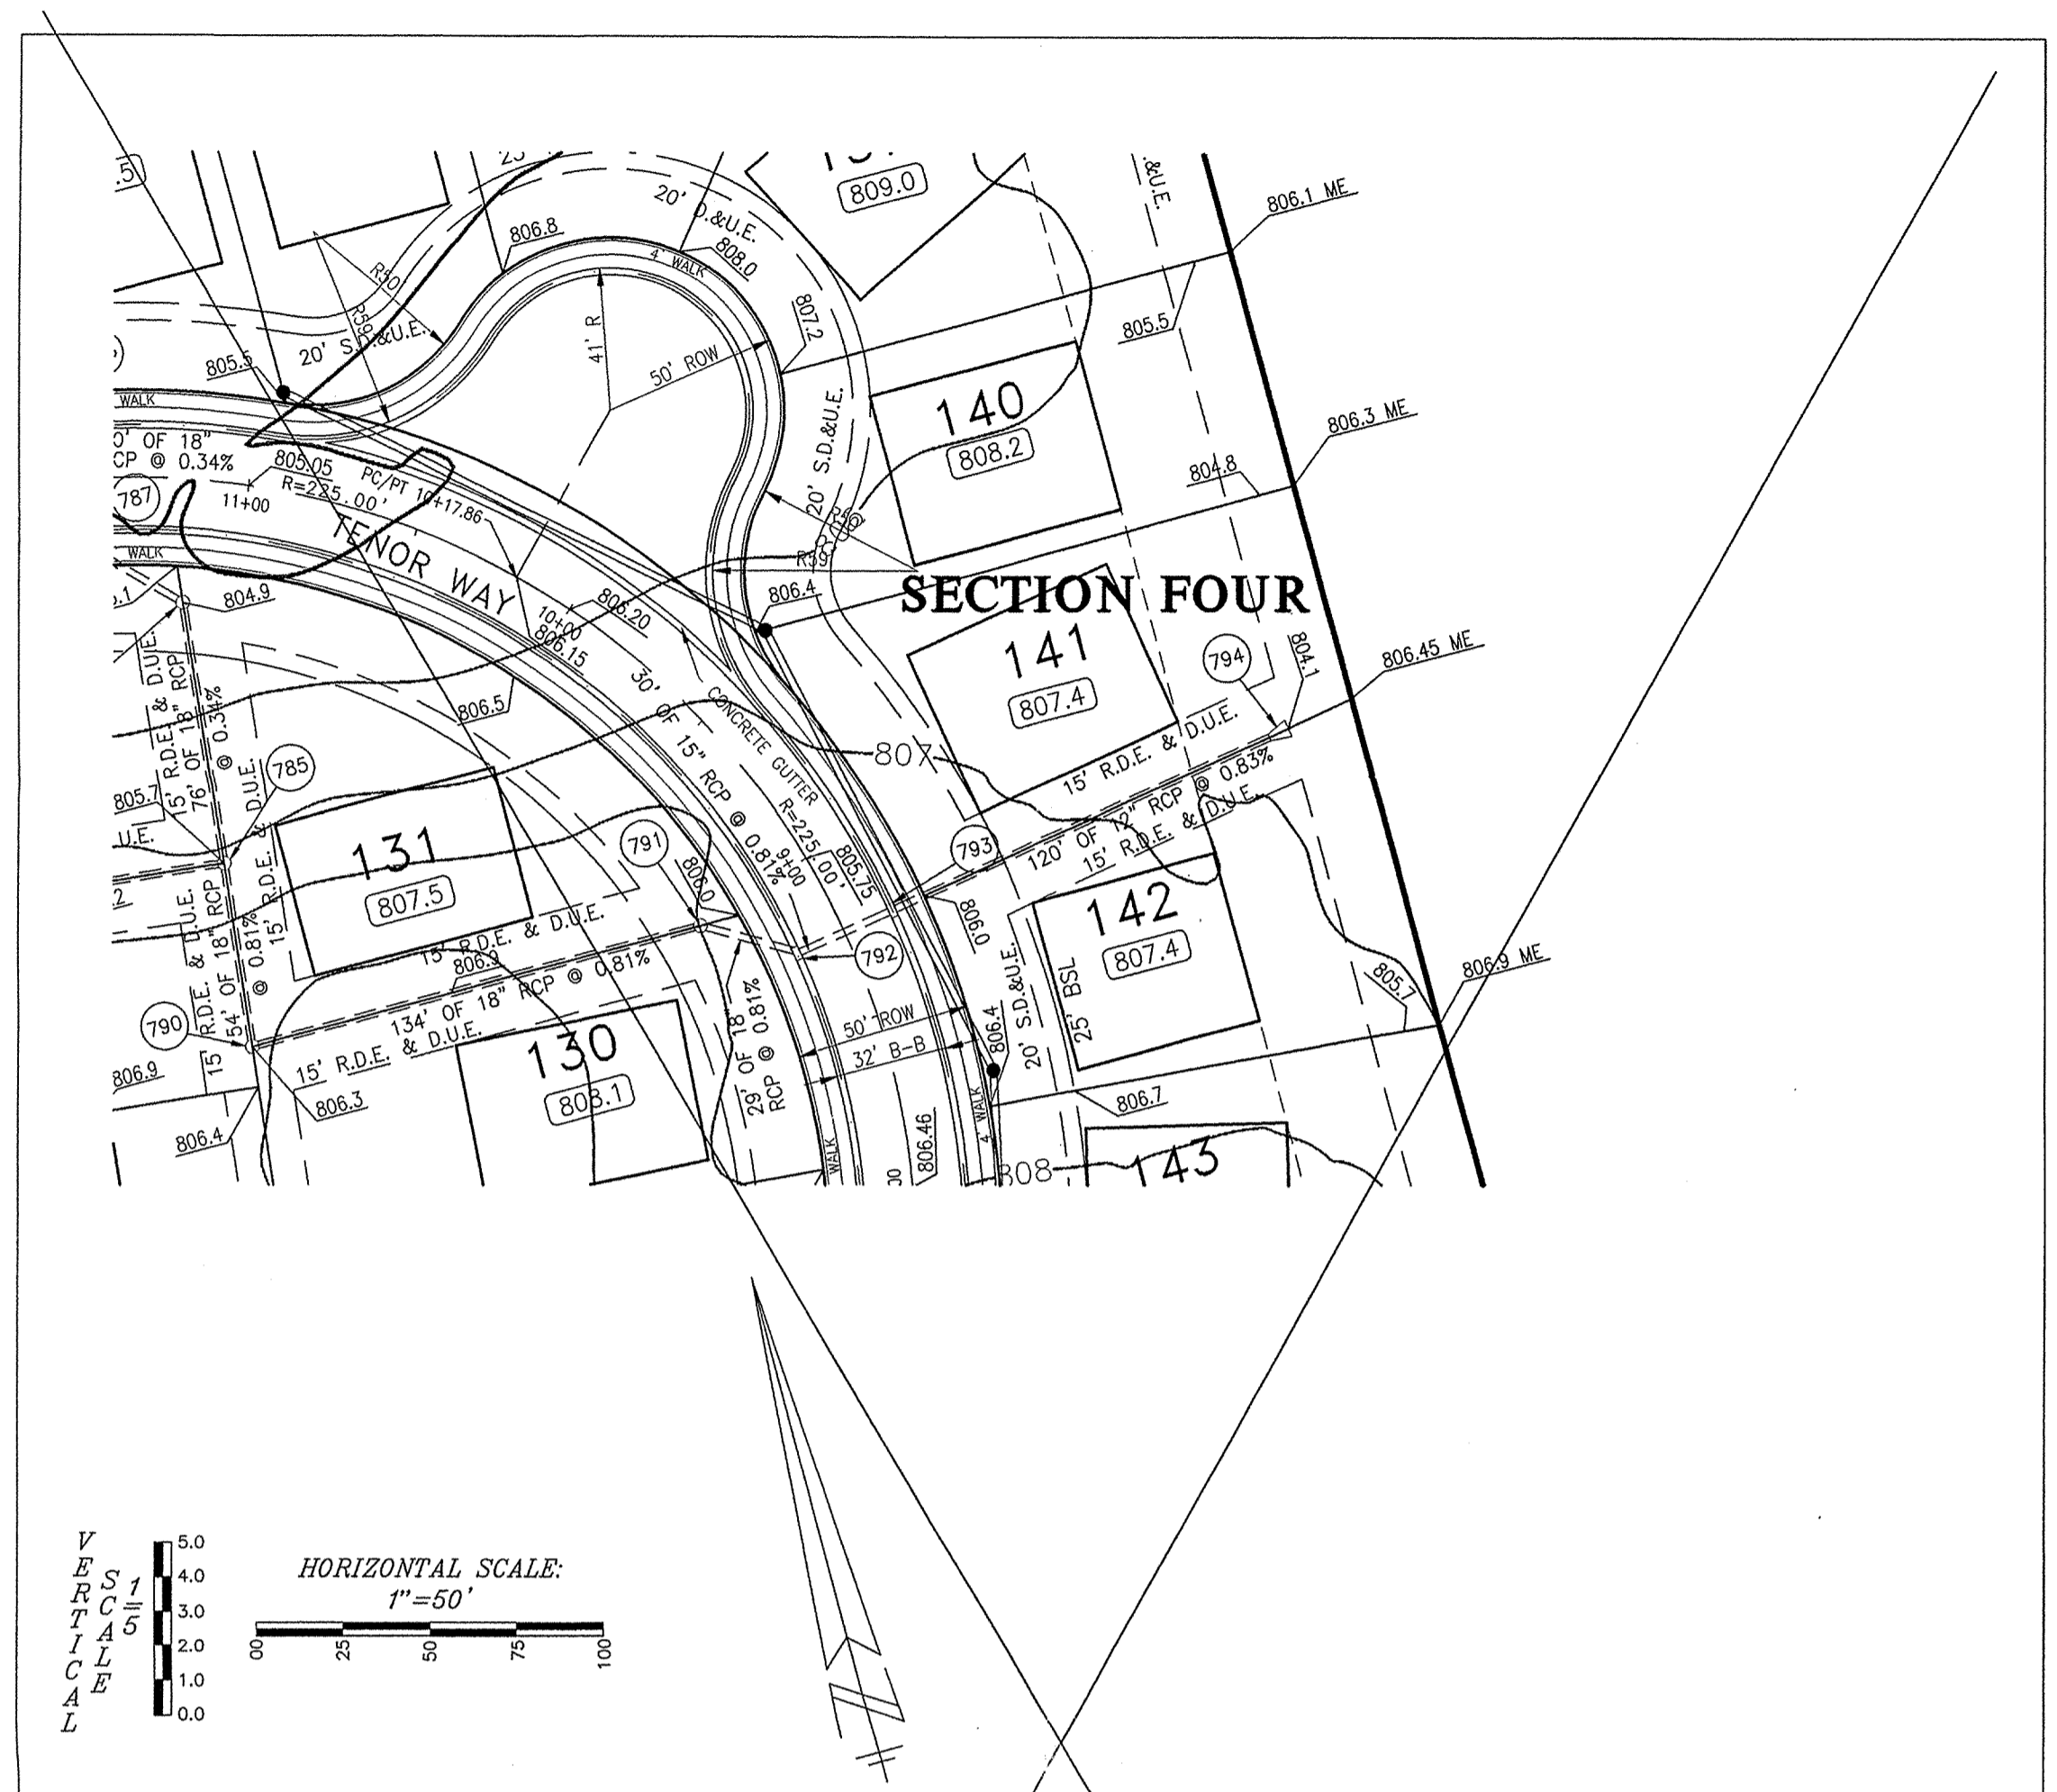

- LEGEND**
- RIGHT-OF-WAY LINE
  - STORM SEWER LINE
  - SWALE
  - SANITARY SEWER LINE
  - SANITARY SEWER MANHOLE
  - SANITARY SEWER LATERAL
  - FLOW DIRECTION
  - EXISTING SPOT ELEVATION
  - EXISTING CONTOURS
  - PROPOSED ELEVATION
  - STORM BEEHIVE INLET
  - STORM INLET
  - TOP OF CASTING
  - INVERT
  - REINFORCED CONCRETE PIPE
  - M.H.
  - STR.
  - D. & U.E.
  - S.D. & U.E.
  - SAN
  - H.C.
  - M.E.
  - SUBSURFACE DRAIN AND SUMP LINE
  - STM
  - GRANULAR BACKFILL
  - CONCRETE END SECTION
  - S.S.D.
  - S.S.P.
  - S.S.P.(D.I.)
  - NORMAL POOL ELEVATION
  - PROPOSED PAD ELEVATION
  - MPE
  - TYP
  - PROP.
  - EX.
  - R.

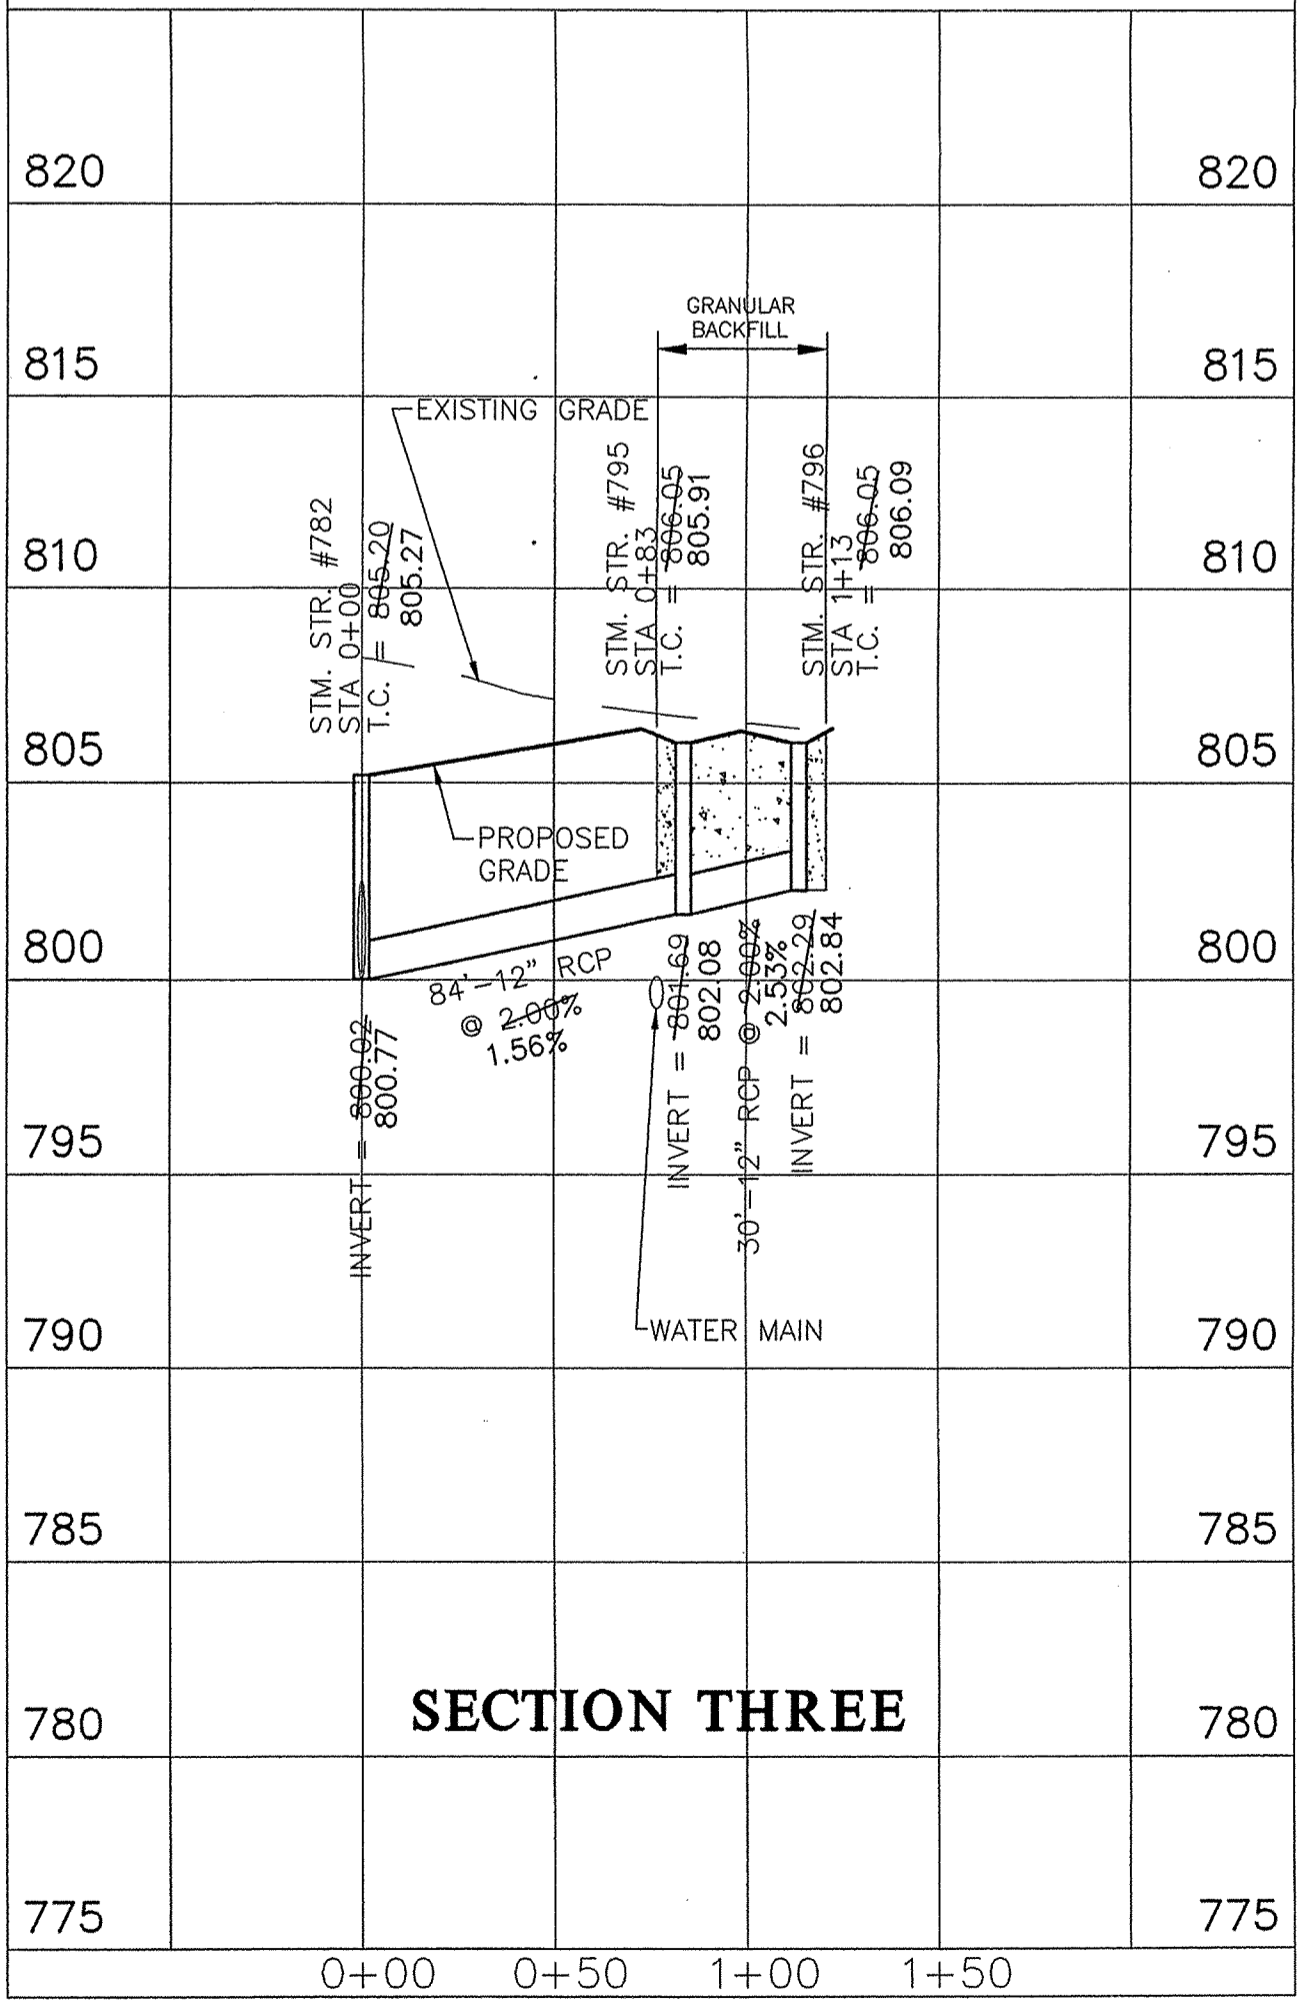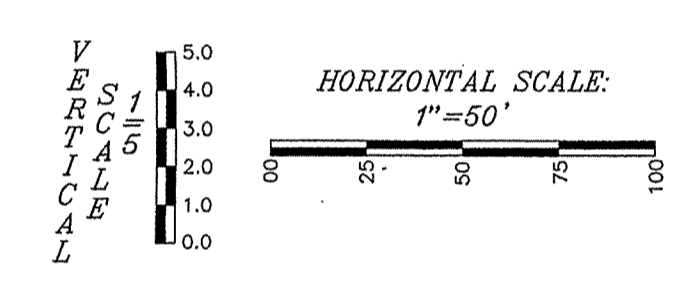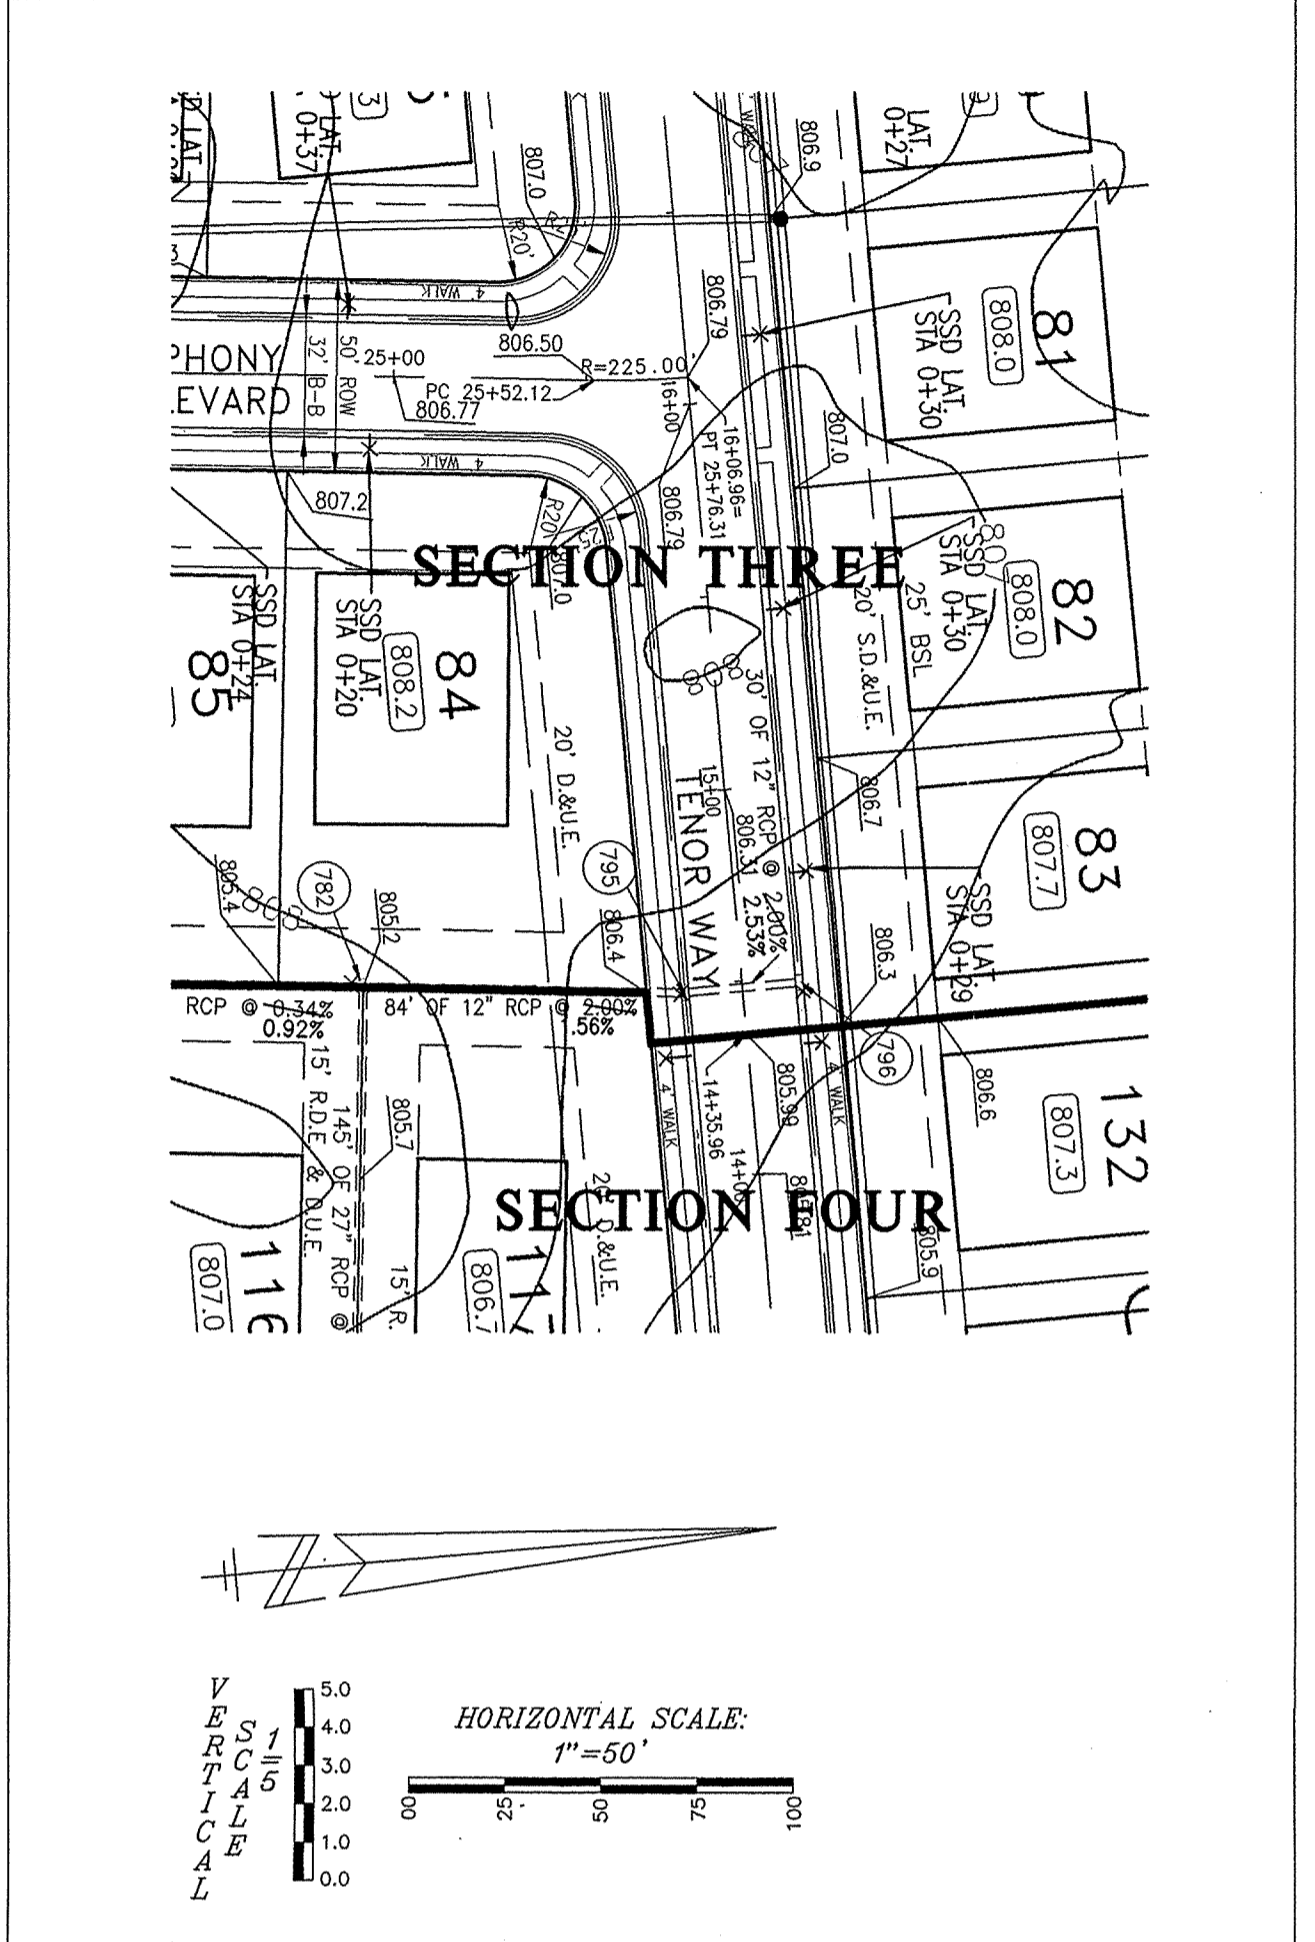

This information was gathered for input into the Hamilton County Geographical Information System. This document is considered an official record of the GIS.

Entry Date: 8-25-01

Entered by: JPH

**WEIHE ENGINEERS, INC.**  
 15645 NORTON COLLIER BLVD  
 INDIANAPOLIS, INDIANA 46280  
 (317) 846-6611 FAX: (317) 843-0546  
 TOLL-FREE (800) 452-6408

CIVIL ENGINEERS • LAND SURVEYORS • LAND PLANNERS • LANDSCAPE ARCHITECTS


PROJECT NO.: 990363  
 DWG NAME: 990363ST3UG  
 FIELD BY: [ ]  
 DRAWN BY: [ ]  
 CHECKED BY: [ ]  
 DATE: 5/17/00

DATE: 6/21/00  
 BY: [ ]  
 REVISIONS:  
 MINOR REVISIONS  
 STORM SEWER AS-BUILTS - SECTION 3 ONLY



REGISTERED PROFESSIONAL ENGINEER  
 NO. 8827  
 STATE OF INDIANA  
 ALLAN H. WEIHE P.E. 8827

PREPARED FOR:  
**ARBOR GROVE SECTION THREE**  
 BAY DEVELOPMENT CORP.  
 STORM PLAN & PROFILE SHEET  
 SECTION 3 ONLY  
 6/13/01 FILED

**RECORD DRAWING**  
 STORM SEWER AS-BUILTS  
 STORM SEWER STRUCTURES ONLY  
 SECTION 3 ONLY  
 6/13/01 FILED  
 OCT 31 2001  
 OFFICE OF HAMILTON COUNTY SURVEYOR

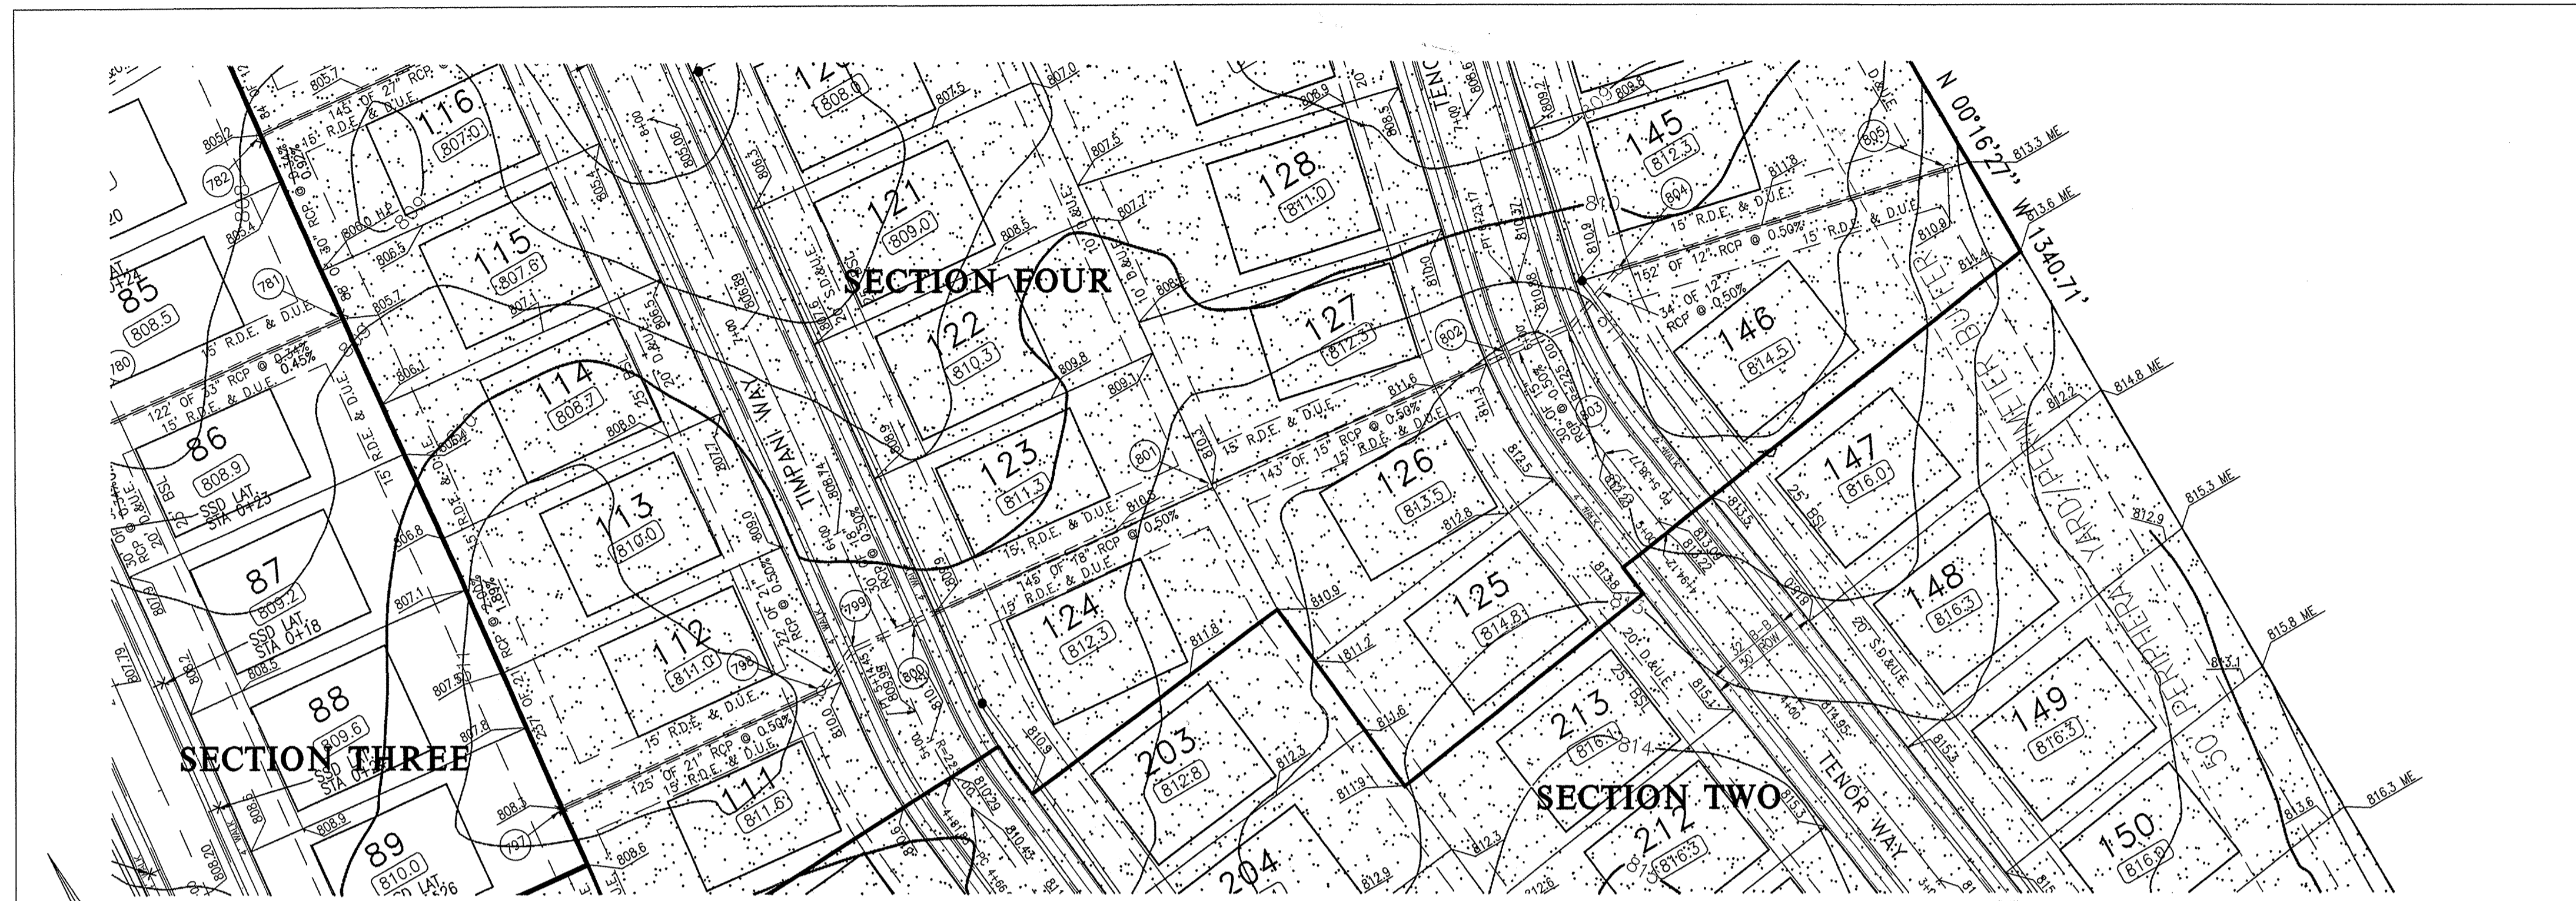


- LEGEND**
- RIGHT-OF-WAY LINE
  - STORM SEWER LINE
  - SWALE
  - SANITARY SEWER LINE
  - SANITARY SEWER MANHOLE
  - SANITARY SEWER LATERAL
  - FLOW DIRECTION
  - EXISTING SPOT ELEVATION
  - EXISTING CONTOURS
  - PROPOSED ELEVATION
  - STORM BEEHIVE INLET
  - STORM INLET
  - TOP OF CASTING
  - INVERT
  - R.C.P. = REINFORCED CONCRETE PIPE
  - M.H. = MANHOLE
  - STR. = STRUCTURE
  - D. & U.E. = DRAINAGE AND UTILITY EASEMENT
  - S.D. & U.E. = SANITARY, DRAINAGE, AND UTILITY EASEMENT
  - SAN = SANITARY SEWER
  - H.C. = HANDICAP RAMP
  - M.E. = MATCH EXISTING GRADE
  - S.S.D. = SUBSURFACE DRAIN
  - S.S.P. = SANITARY SEWER PIPE (SDR-35)
  - S.S.P.(D.I.) = SANITARY SEWER PIPE (DUCTILE IRON)
  - ◻ = NORMAL POOL ELEVATION
  - ◻ = PROPOSED PAD ELEVATION
  - ◻ = MINIMUM PAD ELEVATION
  - TYP. = TYPICAL
  - PROP. = PROPOSED
  - EX. = EXISTING
  - R. = RADIUS
  - X = SUB SURFACE DRAIN LATERAL AS-BUILT LOCATION
  - SECTION TWO

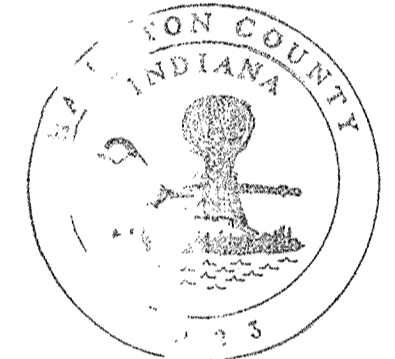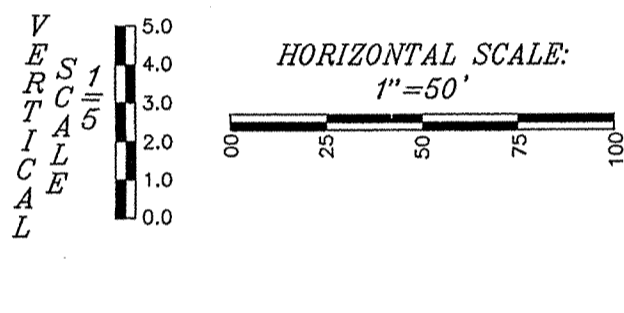

This information was gathered for input into the Hamilton County Geographical Information System. This document is considered an official record of the GIS.

Entry Date: 8-25-04

Entered by: JHF

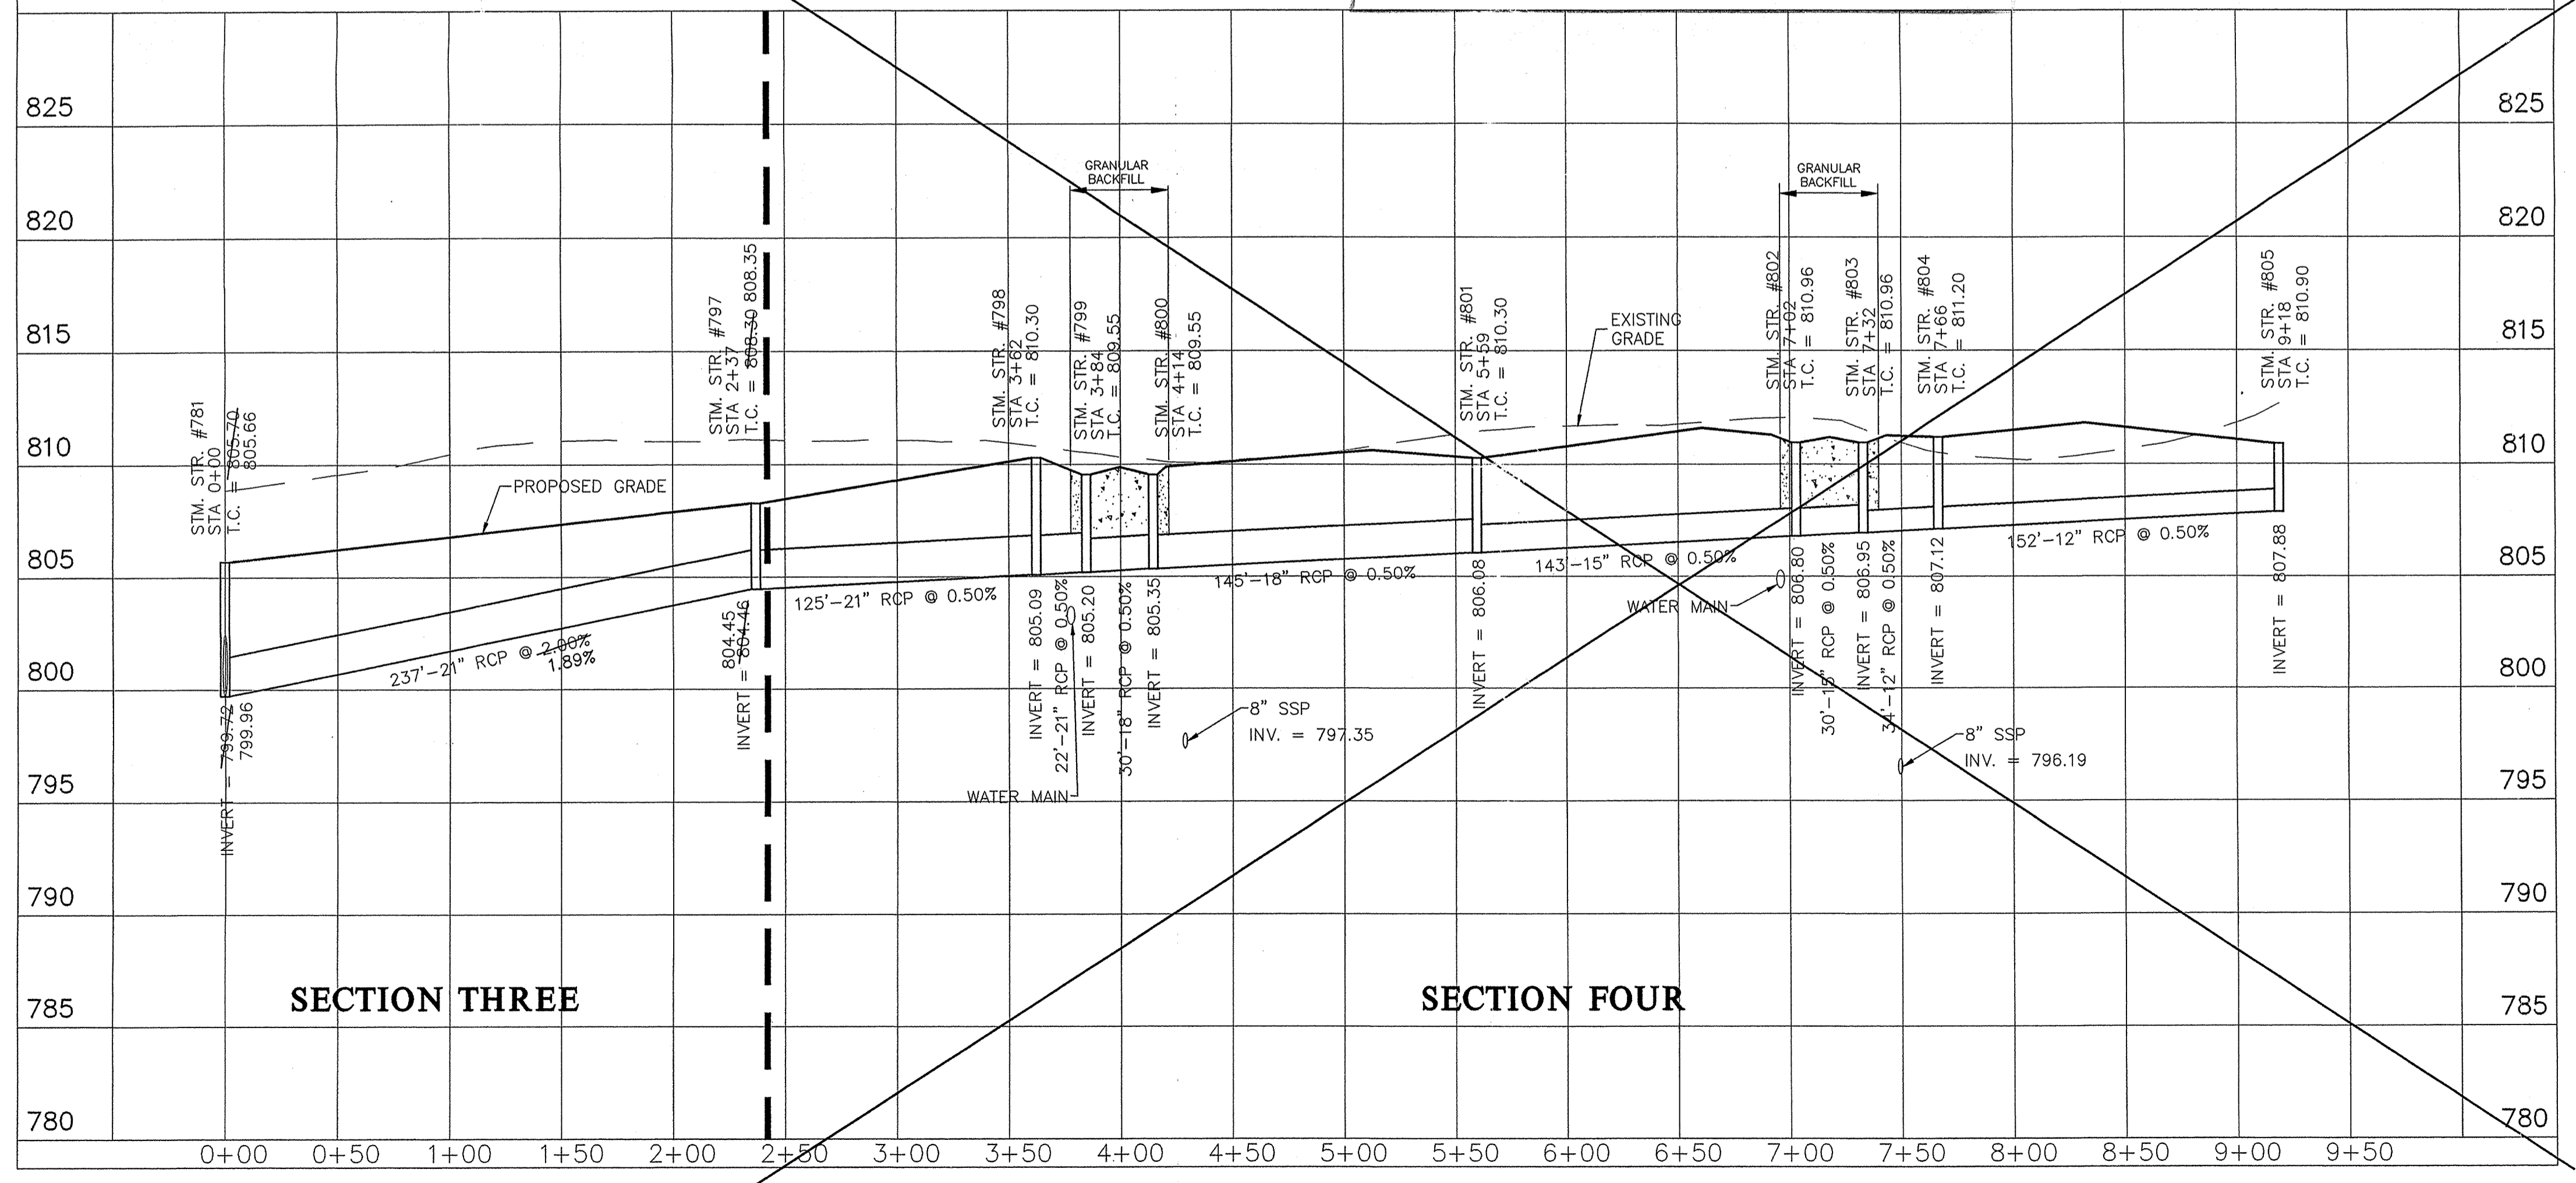

**WEIHE ENGINEERS, INC.**  
 ALLAN H. WEIHE, P.E., I.S.  
 PRESIDENT  
 15505 NORTH COLLEGE AVENUE  
 INDIANAPOLIS, INDIANA 46280  
 (317) 846-6611 FAX: (317) 843-0546  
 TOLL-FREE (800) 452-6408  
 CIVIL ENGINEERS • LAND SURVEYORS • LAND PLANNERS • LANDSCAPE ARCHITECTS

PROJECT NO.:	99-0055
BY:	JKM
DATE:	6/21/04/06/06/09/12/01
REVISIONS:	MINOR REVISIONS STORM SEWER AS-BUILTS - SECTION 3 ONLY
CHECKED BY:	MLM
DATE:	5/17/06



PREPARED FOR:  
**ARBOR GROVE SECTION THREE**  
 BAY DEVELOPMENT CORP.  
 STORM PLAN & PROFILE SHEET  
 Part of the S/D of the S/D and W/D of the S/D of Sec. 8-1189-162, Noblesville Twp., Hamilton Co., Indiana.

**RECORD DRAWING**  
 STORM SEWER AS-BUILTS  
 STORM SEWER STRUCTURES ONLY  
 SECTION 3 ONLY  
 6/13/01

FILED  
 OCT 31 2001  
 OFFICE OF HAMILTON COUNTY SURVEYOR