

SURVEYOR'S OFFICE
Hamilton County

Kenton C. Ward, CFM
Surveyor of Hamilton County
Phone (317) 776-8495
Fax (317) 776-9628

Suite 188
One Hamilton County Square
Noblesville, Indiana 46060-2230

October 19, 2007

To: Hamilton County Drainage Board

Re: Wheeler and Wheeler Drain, Cumberland Pointe Arm

Attached is a petition and plans for an arm to the Wheeler and Wheeler Drain. The arm is being proposed under IC 36-9-27-66 by Cumberland Pointe Apartments, LLC/Cumberland Pointe Apartments II, LLC. The proposal is to extend the arm across the following parcels:

10-11-17-00-13-084.000, owned by C.P. Morgan Communities, LP
10-11-08-00-03-007.000, owned by Cumberland Pointe Apartments, LLC
10-11-17-00-00-001.005, owned by SRS, LLC
10-11-08-03-01-030.000, owned by Bruce L. & Susan R. Buckwalter
Greenfield Avenue right-of-way owned by City of Noblesville

This proposal is being done as part of the Cumberland Pointe Apartments project per plans by Crossroad Engineers, PC., dated 9/14/2006; plans for Horizons at Cumberland Pointe, Sec. 2 by Stoepelwerth and Assoc., Inc., Job No. 45500, dated 11/30/2004; plans for Howe Place by Stoepelwerth and Assoc., Inc., Job No. 45550, dated 12/08/2003; and Cumberland Pointe Commercial Site by Stoepelwerth and Assoc., Job No. 45810, dated 04/28/2003.

Per the plans for Howe Place Sheet C601, the arm will begin at Structure 149, which is now the outflow pipe for Lake #4 in the Horizons at Cumberland Pointe, Section 2. The arm will flow west to Structure 830 per Sheet C203 for Cumberland Pointe Commercial Site. This structure is also called out as Structure EX 830 on the plans for Howe Place and as Structure EX 1 on the plans by Crossroads Engineers and is located near the southeast corner of the Cumberland Pointe Apartments site approximately 40 feet north of Cumberland Pointe Boulevard edge of pavement. The arm will include the existing 36 inch RCP storm sewer and extend north along the east property line to Structure 100 of the Cumberland Apartment Plan which is Structure 833 of the Cumberland Point Commercial Site Plan. The drain will continue to be piped north, then, flow northwesterly as an open ditch along Greenfield Avenue right-of-way, then be piped under Greenfield Avenue to the flowline of the Wheeler and Wheeler Drain at approximately Station 78+56 of the original description.

The proposed arm shall consist of the lengths of pipe between the following structures:

Howe Place, Sheet C601
Station 149 to Station EX830

Cumberland Pointe Commercial Site, Sheet C203
Str. 830 to Str. 831; Str. 831 to Str. 832; Str. 832 to Str. 833
Cumberland Apartments, Sheet 7 & 8
Str. 100 (same as Str. 833 above) to Str. 101; Str. 101 to Str. 102; Str. 102 to Str.
To Str. 63; Str. 64 to outlet; open ditch from outlet to new pipe under Greenfield
Ave. (Str. 103); Str. 832 above to Str. 61; Str. 831 above to Str. 62.

This arm will consist of the following:

| | | | |
|---------|--------|------------|-----------|
| 12" RCP | 24 ft. | 24" RCP | 237 ft. |
| 21" CMP | 68 ft. | 36" RCP | 1,245 ft. |
| | | Open Ditch | 185 ft. |

The total length of the new arm shall be 1,759 feet. This proposal will add 1,759 feet to the drain's total length.

A portion of the storm line was originally designed by Stoeppelwerth and Associates and installed as part of the overall Cumberland Pointe Project and Howe Place Subdivision, per plans dated 12/8/2003, Job No. 45550, Sheet C601.

The existing line is noted in the Stoeppelwerth drainage report as Structures 920 (EX149 on Horizons at Cumberland Pointe, Section 2 plans), EX830, EX831, EX832 and EX833. This report was dated November 11, 2004 and filed with the Surveyor's Office on March 3, 2005. Per the Stoeppelwerth drainage report, the outflow structure (Str. 920/EX149) on Lake #4 includes a 21" orifice in order to comply with the allowable discharge rates set by the Wheeler and Wheeler Watershed Study by Christopher B. Burke Engineering, Ltd., dated January 22, 2004. This orifice is reflected on the Horizons at Cumberland Pointe, Section 2 plans.

The easement for the proposed arm on the Cumberland Pointe Apartment site will be 30' measured from the east property line per the attached legal description, instrument #2008005009. It should be noted that this site has previous existing commitments to the City of Noblesville with respect to landscaping and buffering requirements located in the area adjacent to the proposed regulated drain and within the easement. Pursuant to this, the mounding may be installed with the eastern toe of the slope beginning at the storm pipe. Trees and shrubs may be installed within the easement, but not over the pipe.

The easement across the Buckwalter Property is per the platted Drainage Easement shown on the plat for Fox Glen, Section 1 as recorded on January 25, 1972 in the office of the Hamilton County Recorder in Plat Book 4, Pages 41 - 43.

The easement across the Morgan property is platted Drainage Easement as Common Area #10 of the Horizons at Cumberland Pointe, Section 2 as shown on the plat recorded on November 2, 2005 in the office of the Hamilton County Recorder in Plat Cabinet 3, Slide 761.


The easement across the SRS, LLC property is platted Drainage Easement as shown on the plat for Cumberland Pointe Commercial as recorded on January 7, 2004 in the office of the Hamilton County Recorder in Plat Cabinet 3, Slide 322.

I recommend that this arm be classified as an urban drain.

Due to the development of Cumberland Pointe Apartments parcels 10-11-08-00-03-001.001 and 10-11-17-00-00-001.105 owned by Cumberland Pointe Apartments and parcel 10-11-17-00-00-001.005 owned by SRS LLC, should be removed from the Oliver Armstrong Drain and assessed to the Wheeler & Wheeler Drain. Parcel 10-11-08-00-03-007.000 owned by Cumberland Pointe Apartments should be increased from 7.38 to 20.10 acres benefited at a commercial rate for the Wheeler & Wheeler Drain and reduced from 12.90 to 0.18 acres benefited for the Oliver Armstrong Drain.

The project falls under the requirements as set out in IC 36-9-27-66. Therefore, a hearing is required for the petition. I recommend that the Board set a hearing date for March 24, 2008.

Sincerely,

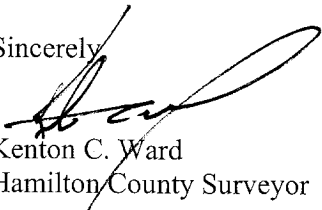

Kenton C. Ward
Hamilton County Surveyor

KCW/llm

To: Hamilton County Drainage Board

Date: 10/24/06

Re: Wheeler & Wheeler Drain

Cumberland Pointe Apartments, L.L.C.
Cumberland Pointe Apartments II, L.L.C. (Here-in-after "Petitioner"),

hereby petitions the Hamilton County Drainage Board under IC 36-9-27-66 for an arm to be installed to the Wheeler & Wheeler Drain in order to serve the property of the petitioner. The petitioner, in support of said petition, advises the Board that:

1. The Wheeler & Wheeler Drain is presently on a maintenance program and that land of the petitioner is assessed as benefited by the maintenance of the regulated drain
2. There is no known adequate open or tiled drain connecting the land of the petitioner with the regulated drain;
3. The waters from the petitioners land flow over or through land owned by others to reach the regulated drain;
4. The legal description of lands through which the new regulated drain will run along with the parcel numbers, name and address of each owner of that land is shown on Exhibit "A" which is attached;
5. The general route of the proposed new regulated drain and method of construction is shown on Exhibit "B" which is attached.
6. Petitioner agrees to pay all legal and construction costs involved with the construction of the proposed new regulated drain.

Signed

Printed

SOHEIL A. SHAKIR



FINDINGS AND ORDER


CONCERNING THE MAINTENANCE OF THE

Wheeler & Wheeler Drain, Cumberland Pointe Arm


On this **24th day of March 2008**, the Hamilton County Drainage Board has held a hearing on the Maintenance Report and Schedule of Assessments of the **Wheeler & Wheeler Drain, Cumberland Pointe Arm.**

Evidence has been heard. Objections were presented and considered. The Board then adopted the original/amended Schedule of Assessments. The Board now finds that the annual maintenance assessment will be less than the benefits to the landowners and issues this order declaring that this Maintenance Fund be established.


HAMILTON COUNTY DRAINAGE BOARD

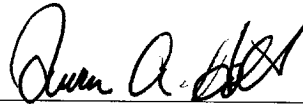

President

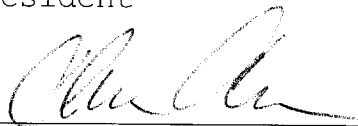


Member

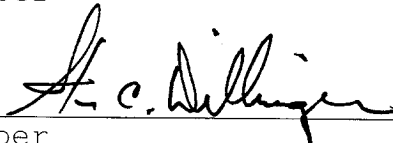

Member

Attest:

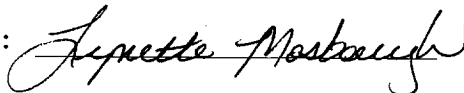

FINDINGS AND ORDER


CONCERNING THE MAINTENANCE OF THE

Oliver Armstrong Drain


On this **24th day of March 2008**, the Hamilton County Drainage Board has held a hearing on the Maintenance Report and Schedule of Assessments of the **Oliver Armstrong Drain**.

Evidence has been heard. Objections were presented and considered. The Board then adopted the original/amended Schedule of Assessments. The Board now finds that the annual maintenance assessment will be less than the benefits to the landowners and issues this order declaring that this Maintenance Fund be established.


HAMILTON COUNTY DRAINAGE BOARD

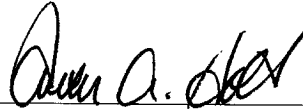

President

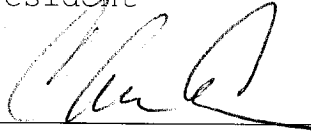

Member

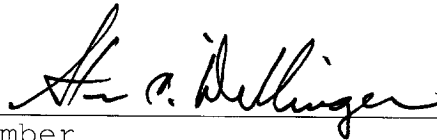

Member

Attest:



STATE OF INDIANA)
) ss:
COUNTY OF HAMILTON)

BEFORE THE HAMILTON COUNTY
DRAINAGE BOARD
NOBLESVILLE, INDIANA

IN THE MATTER OF THE
RECONSTRUCTION OF THE
Wheeler & Wheeler Drain, Cumberland Pointe Arm

FINDINGS AND ORDER FOR RECONSTRUCTION

The matter of the proposed Reconstruction of the *Wheeler & Wheeler Drain, Cumberland Pointe Arm* came before the Hamilton County Drainage Board for hearing on *March 24, 2008*, on the Reconstruction Report consisting of the report and the Schedule of Damages and Assessments. The Board also received and considered the written objection of an owner of certain lands affected by the proposed Reconstruction, said owner being:

Evidence was heard on the Reconstruction Report and on the aforementioned objections.

The Board, having considered the evidence and objections, and, upon motion duly made, seconded and unanimously carried, did find and determine that the costs, damages and expenses of the proposed Reconstruction will be less than the benefits accruing to the owners of all land benefited by the Reconstruction.


The Board having considered the evidence and objections, upon motion duly made, seconded and unanimously carried, did adopt the Schedule of Assessments as proposed, subject to amendment after inspection of the subject drain as it relates to the lands of any owners which may have been erroneously included or omitted from the Schedule of Assessments.

The Board further finds that it has jurisdiction of these proceedings and that all required notices have been duly given or published as required by law.

Wherefore, it is ORDERED, that the proposed Reconstruction of the *Wheeler & Wheeler Drain, Cumberland Pointe Arm* be and is hereby declared established.

Thereafter, the Board made inspection for the purpose of determining whether or not the lands of any owners had been erroneously included or excluded from the Schedule of Assessments. The Board finds on the basis of the reports and findings at this hearing as follows:

HAMILTON COUNTY DRAINAGE BOARD

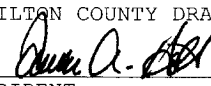

PRESIDENT



Member



Member

ATTEST:


Executive Secretary

BEFORE THE HAMILTON COUNTY DRAINAGE BOARD
IN THE MATTER OF

Wheeler and Wheeler Drain, Cumberland Pointe Arm

NOTICE

To Whom It May Concern and: _____

Notice is hereby given of the hearing of the Hamilton County Drainage Board concerning the reconstruction of the **Wheeler and Wheeler Drain, Cumberland Pointe Arm** on **March 24, 2008**, at **9:05 A.M.** in Commissioners Court, Hamilton County Judicial Center, One Hamilton County Square, Noblesville, Indiana. Construction and maintenance reports of the Surveyor and the Schedule of Assessments proposed by the Drainage Board have been filed and are available for public inspection in the office of the Hamilton County Surveyor.

Hamilton County Drainage Board

Attest: Lynette Mosbaugh

ONE TIME ONLY

STATE OF INDIANA)
) SS BEFORE THE HAMILTON
)
COUNTY OF HAMILTON) DRAINAGE BOARD

IN THE MATTER OF **Wheeler & Wheeler Drain, Cumberland Pointe Arm**

NOTICE

Notice is hereby given that the Hamilton County Drainage Board at its regular meeting **March 24, 2008** adopted the reconstruction report of the Surveyor and the Amended Schedule of damages and assessments including annual assessment for periodic maintenance, finding that the costs, damages and expense of the proposed improvement would be less than the benefits which will result to the owner of lands benefited thereby.


The Board issued an order declaring the proposed improvement established. Such findings and order were marked filed and are available for inspection in the Office of the Hamilton County Surveyor.

If judicial review of the findings and order of the Board is not requested pursuant to Article VIII of the 1965 Indiana Drainage Code as amended within twenty (20) days from the date of publication of this notice, the findings and order shall become conclusive.

HAMILTON COUNTY DRAINAGE BOARD

BY: Steven A. Holt
PRESIDENT

ATTEST: Lynette Mosbaugh
SECRETARY

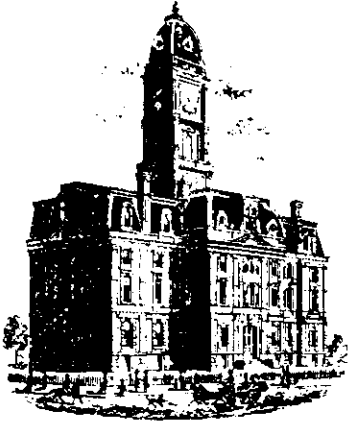

SURVEYOR'S OFFICE

Hamilton County

Kenton C. Ward, CFM
 Surveyor of Hamilton County
 Phone (317) 776-8495
 Fax (317) 776-9628

Suite 188
 One Hamilton County Square
 Noblesville, Indiana 46060-2230

To: Hamilton County Drainage Board

March 13, 2009

Re: Wheeler & Wheeler: Cumberland Pointe Arm

Attached are as-builts, certificate of completion & compliance, and other information for Cumberland Pointe Arm. An inspection of the drainage facilities for this section has been made and the facilities were found to be complete and acceptable.

During construction, changes were made to the drain, which will alter the plans submitted with my report for this drain-dated October 19, 2007. The report was approved by the Board at the hearing held March 24, 2008. (See Drainage Board Minutes Book 11, Pages 71-73) The changes are as follows:

| Structure: | Size: | Length: | Material: | Up Invert: | Dn Invert: | Grade: |
|------------|-------|---------|-----------|------------|------------|--------|
| 149-830 | 24 | 240 | RCP | 807.97 | 806.83 | 0.48 |
| 830-831 | 36 | 125 | RCP | 806.8 | 804.73 | 1.66 |
| 831-832 | 36 | 255 | RCP | 804.73 | 803.96 | 0.3 |
| 832-101 | 36 | 440 | RCP | 803.96 | 803.21 | 0.17 |
| 101-63 | 36 | 230 | RCP | 803.37 | 798.27 | 2.22 |
| 63-64 | 36 | 142 | RCP | 798.17 | 797.41 | 0.54 |
| 64-64A | 36 | 52 | RCP | 797.41 | 797 | 0.79 |
| 601-602 | 21* | 77 | RCP | 792.94 | 791.55 | 1.81 |
| 603-604 | 21 | 77 | RCP | 793.02 | 791.51 | 1.96 |
| 605-606 | 21 | 77 | RCP | 793 | 791.63 | 1.78 |
| 61-831 | 12 | 8 | RCP | 808.06 | 807.63 | 5.38 |
| 62-832 | 12 | 9 | RCP | 805.28 | 805.12 | 1.78 |

RCP Pipe Totals:

| | |
|----|------|
| 12 | 17 |
| 21 | 77 |
| 24 | 240 |
| 36 | 1244 |

Total: 1578

Other Drain:

| | |
|---------------|------------|
| Open ditch | 185 |
| Total: | <u>185</u> |

* The 21" RCP is a triple pipe and the lengths are reported as parallel. This was originally reported as 68 feet of 21" CMP. The length of the drain due to the changes described above is now **1763 feet**.


The drainage easement for this project was recorded in the Hamilton County Recorder's Office under instrument # 2008005009.

The following sureties were guaranteed by Bond Safeguard Insurance Company and on September 14, 2007.

Bond-LC No: 5018759
Insured For: Storm Sewers
Amount: \$165,240.00
Issue Date: September 14, 2005

I recommend the Board approve the drain's construction as complete and acceptable.

Sincerely,

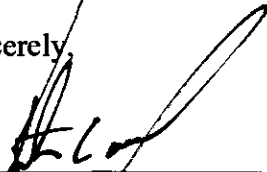

Kenton C. Ward, CFM
Hamilton County Surveyor

KCW/slm

CERTIFICATE OF COMPLETION AND COMPLIANCE

To: Hamilton County Surveyor

Re: CUMBERLAND POINT APARTMENTS
WHEELER-WHEELER REGULATED DRAIN
AS-BUILT PLANS

I hereby certify that:

1. I am a Registered Land Surveyor or Engineer in the State of Indiana.
2. I am familiar with the plans and specifications for the above referenced subdivision.
3. I have personally observed and supervised the completion of the drainage facilities for the above referenced subdivision.
4. The drainage facilities within the above referenced subdivision to the best of my knowledge, information and belief have been installed and completed in conformity with all plans and specifications.
5. The drainage facilities within the above referenced subdivision to the best of my knowledge, information and belief have been correctly represented on the Record Drawings, Digital Record Drawings and the Structure Data Spreadsheet.

Signature:  Date: 8.10.07



Type or Print Name: GREGORY J. ILKO

Business Address: 3417 SHERMAN DRIVE
BEECH GROVE, IN 46107



Telephone Number: 317-780-1555 x 112





INDIANA REGISTRATION NUMBER
10300059

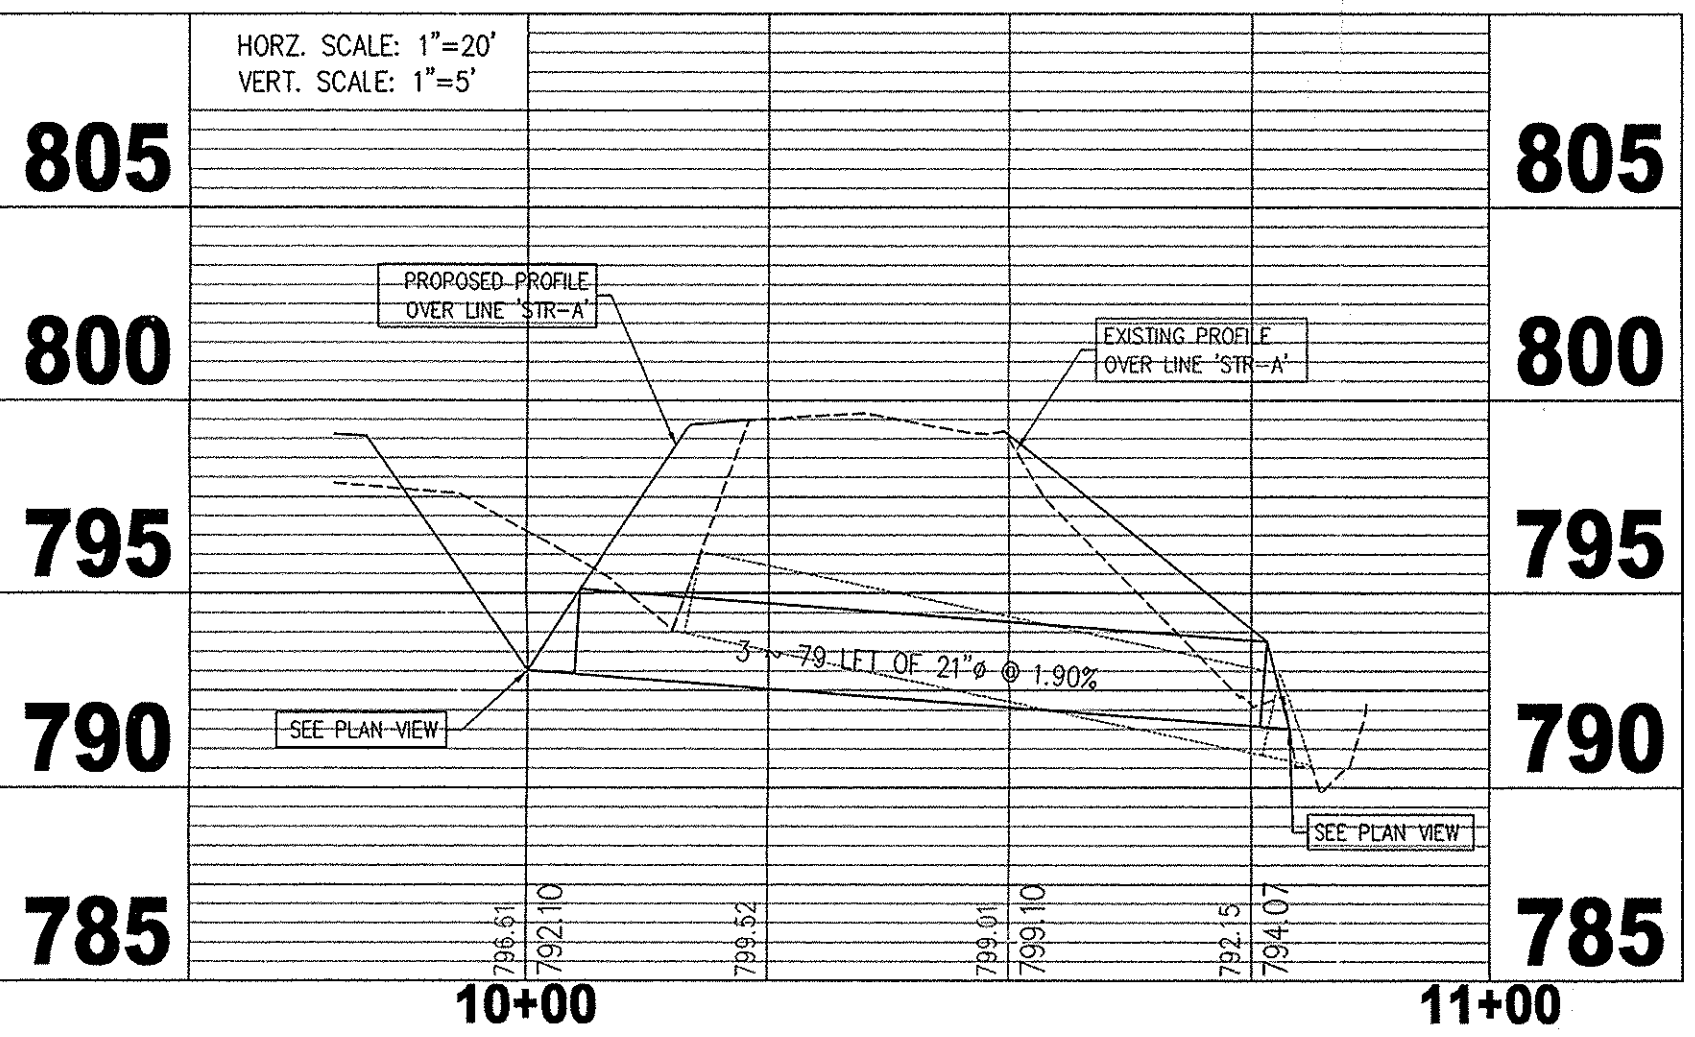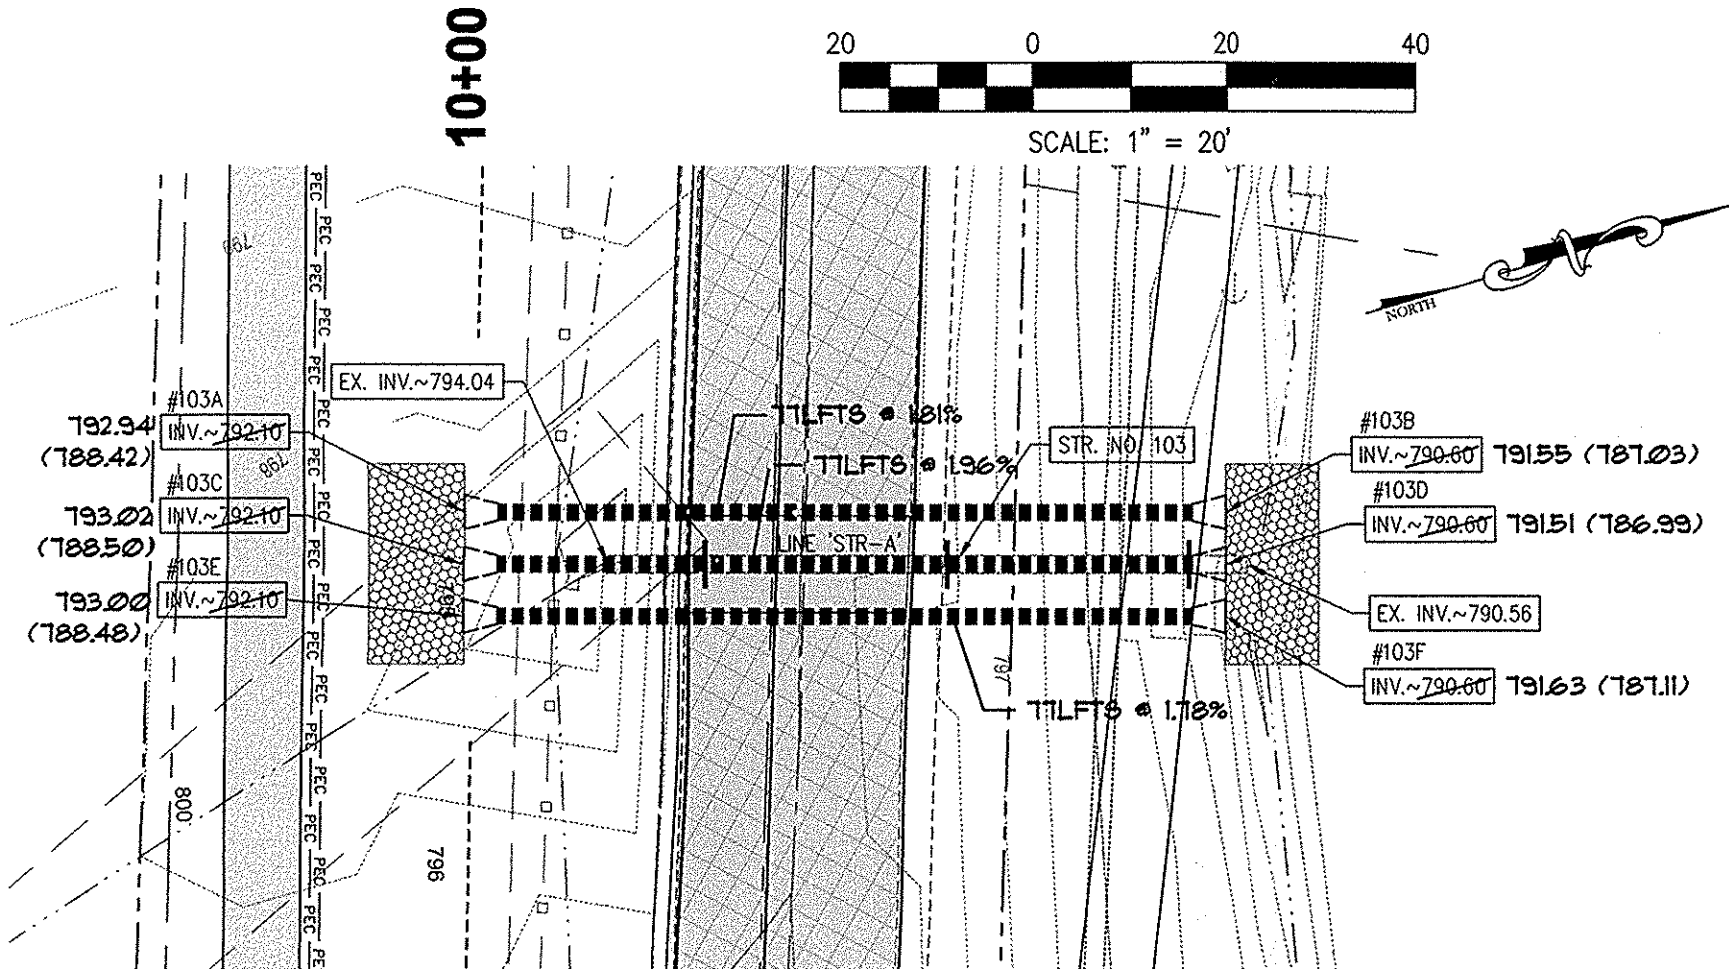

LINE 'STR-A'


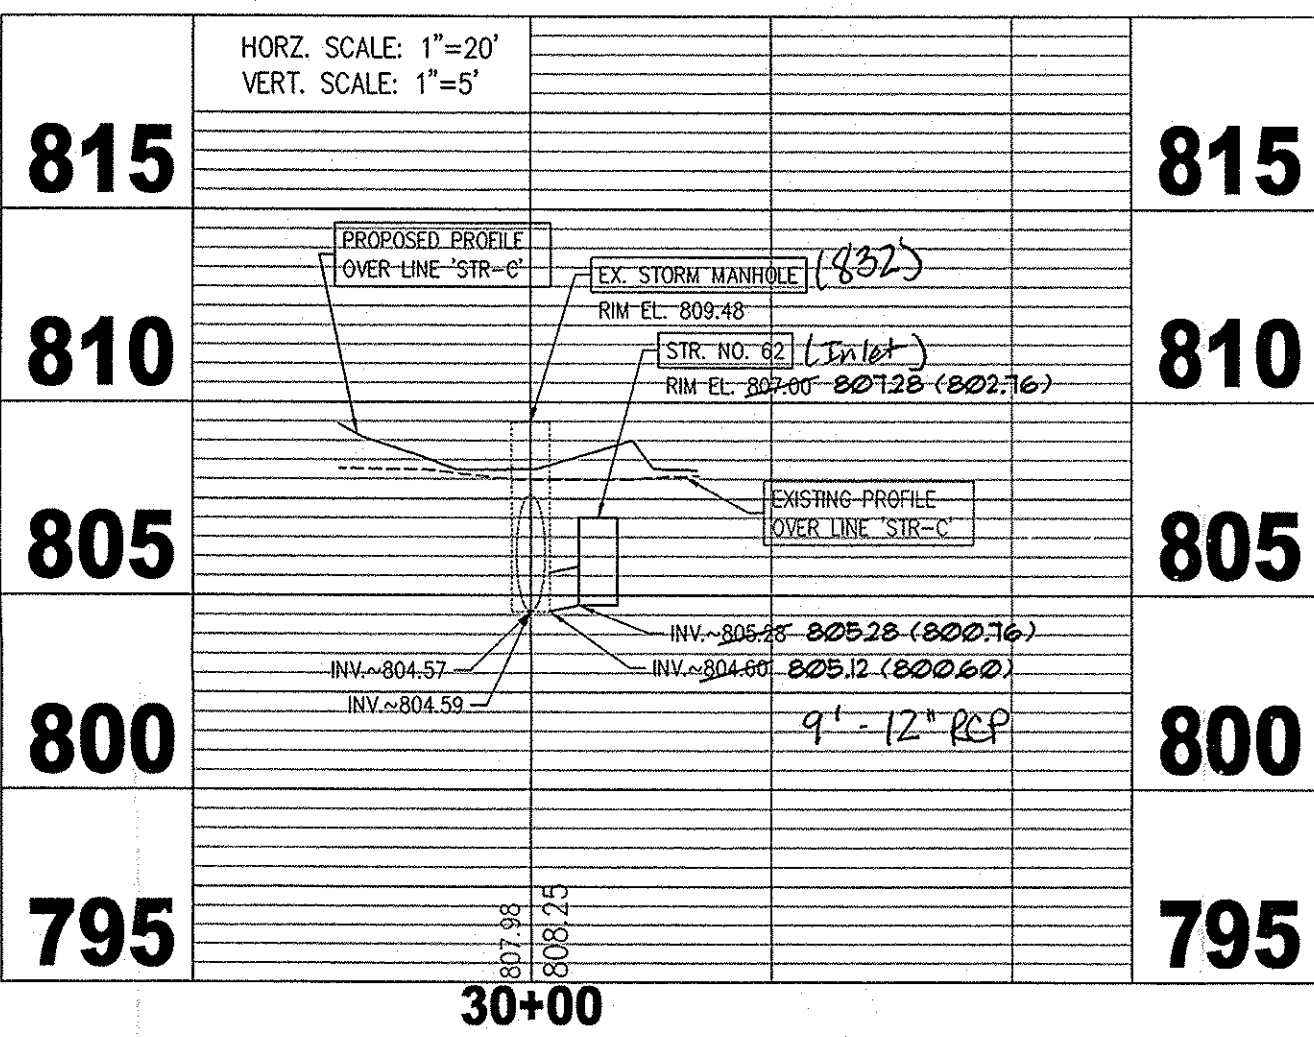
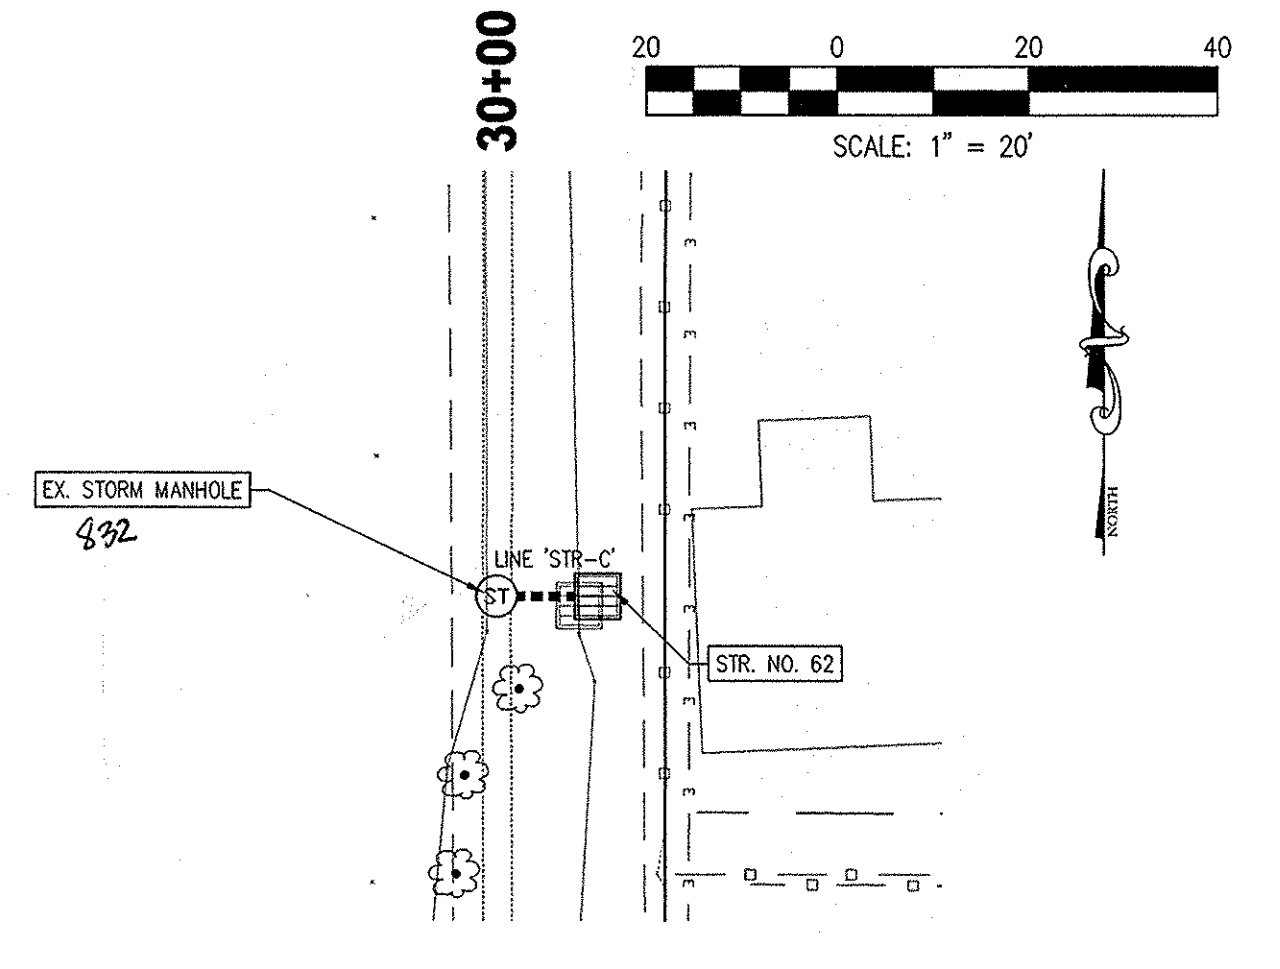


LINE 'STR-C'

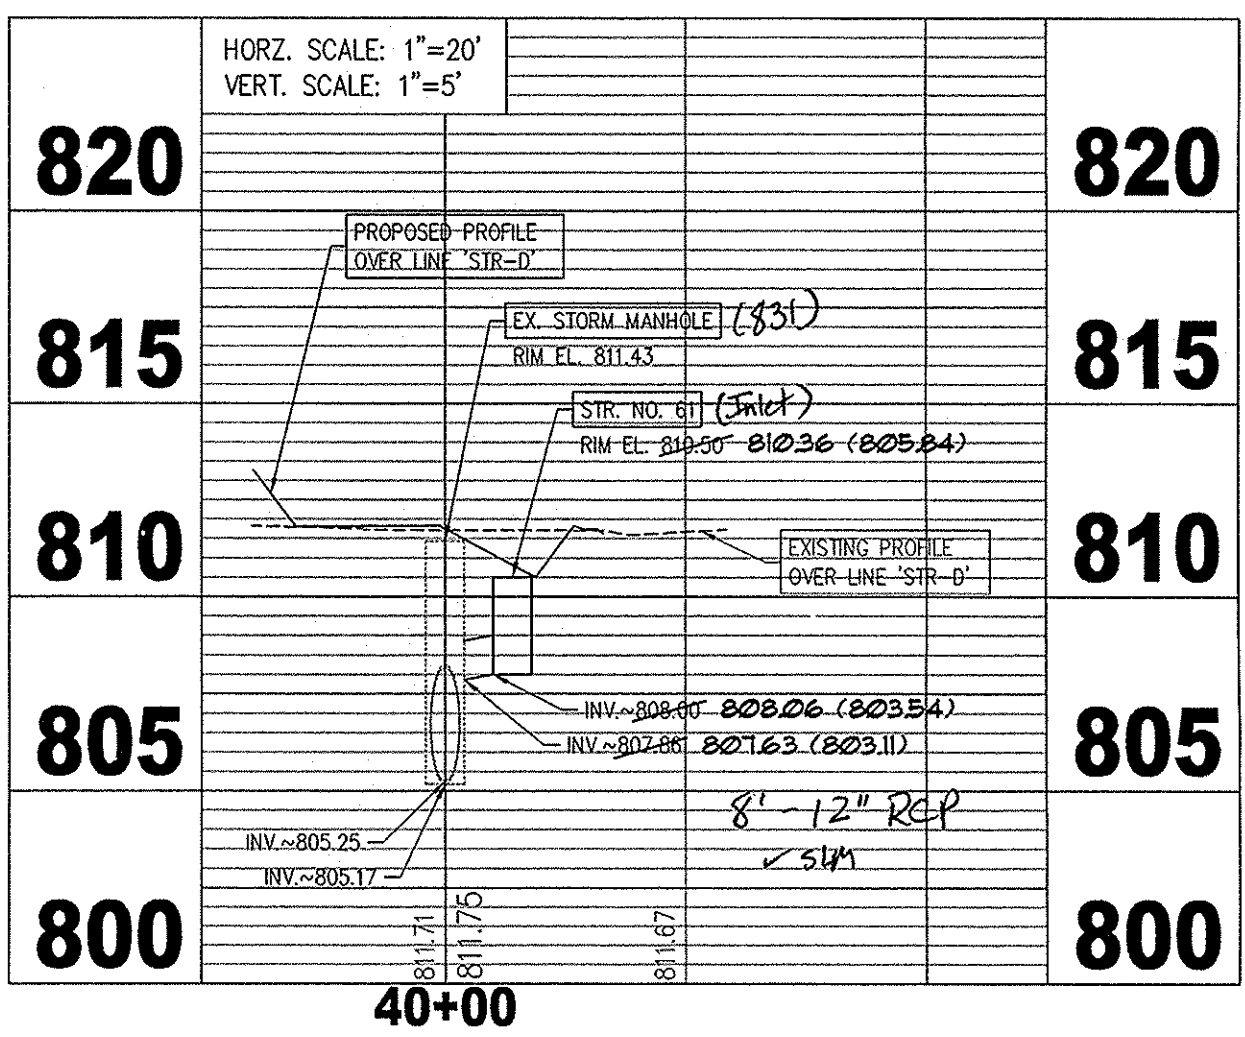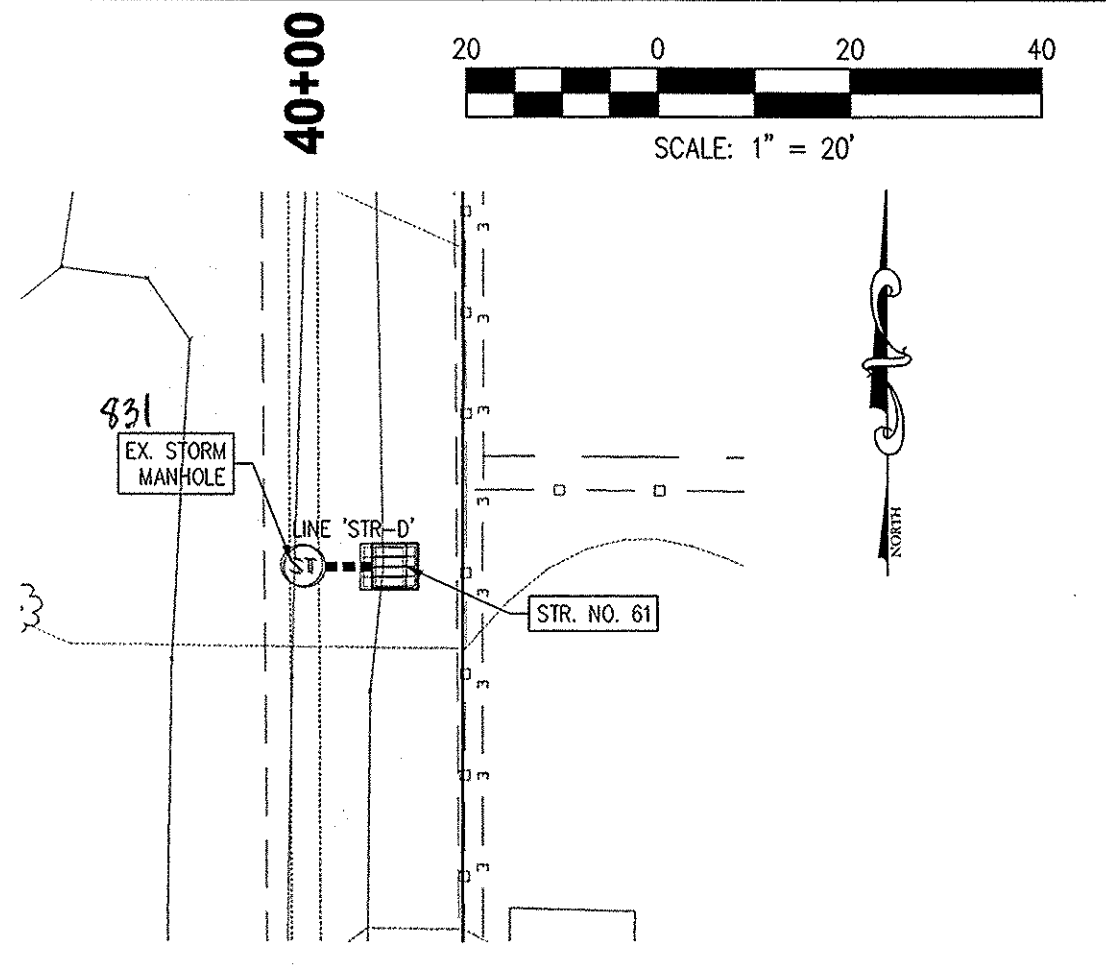

LINE 'STR-D'

| STORM STRUCTURE DATA TABLE | |
|--|--|
| STR. NO. 61 | STR. NO. 62 |
| INSTALL INLET TYPE 'E' WITH NEENAH CASTING R-4215-C OR APPROVED EQUAL WITH 7' LFT OF 12" RCP @ 2.0% 2.38% CONNECT INTO EXISTING MANHOLE RIM EL.=810.50 810.36 (805.84) INV. OUT (W)=808.00 808.06 (803.54) D.S. EL.=807.65 807.63 (803.11) | INSTALL INLET TYPE 'E' WITH NEENAH CASTING R-4215-C OR APPROVED EQUAL WITH 7' LFT OF 12" RCP @ 2.0% 2.38% CONNECT INTO EXISTING MANHOLE RIM EL.=807.00 807.18 (802.16) INV. OUT (W)=804.74 805.28 (800.60) D.S. EL.=804.60 805.12 (800.16) |
| STR. NO. 63 | STR. NO. 64 |
| INSTALL STORM MANHOLE TYPE 'H' WITH PRECAST FLAT CAP WITH NEENAH CASTING R-4215-C OR APPROVED EQUAL WITH 14' LFT OF 36" RCP @ 0.50% 0.54% RIM EL.=806.00 807.01 (802.55) INV. IN (S)=800.57 198.21 (193.75) INV. IN (W)=798.00 198.51 (194.05) INV. OUT (N)=798.00 198.11 (193.65) | INSTALL STORM MANHOLE TYPE 'H' WITH PRECAST FLAT CAP WITH NEENAH CASTING R-4215-C OR APPROVED EQUAL WITH 14' LFT OF 36" RCP @ 0.50% WITH (1) CONCRETE END SECTION RIM EL.=802.50 802.31 (191.79) INV. IN (S)=797.29 191.41 (192.09) INV. OUT (NW)=797.29 191.41 (192.09) D.S. EL.=797.03 191.00 (192.48) |
| STR. NO. 100 | STR. NO. 101 |
| REMOVE EXISTING STRUCTURE, CASTING, AND 136 LFT OF 20" 36" RCP, EXTEND 34' LFT OF 36" RCP @ 0.32% 0.25% RESET AS STR. NO. 101 | INSTALL STR. NO. 100. PLUG EXISTING HOLES AND INSTALL 22' LFT OF 36" RCP @ 1.2% 2.25% RIM = 808.25 808.61 (804.09) 36" INV. IN (S) = 803.14 803.21 (198.69) 12" INV. IN (E) = 803.92 803.37 (198.85) 36" INV. OUT (N) = 803.14 803.21 (198.69) |
| STR. NO. 102 | STR. NO. 103 |
| REMOVE 37 LFT OF 12" RCP AND PLUG EXISTING HOLE. INSTALL 10 LFT OF 12" RCP @ 1.00% 0.40% INV. OUT (W) = 804.07 804.21 (199.69) | INSTALL 3~21" REINFORCED CONCRETE PIPES (CLASS III) EACH BEING 79 LFT @ 1.90% WITH TWO (2) CONCRETE PIPE END SECTIONS FOR EACH CULVERT. U.S. EL.=792.00 SEE PLAN (FOR ALL 3 CULVERTS) D.S. EL.=790.00 SEE PLAN (FOR ALL 3 CULVERTS) |

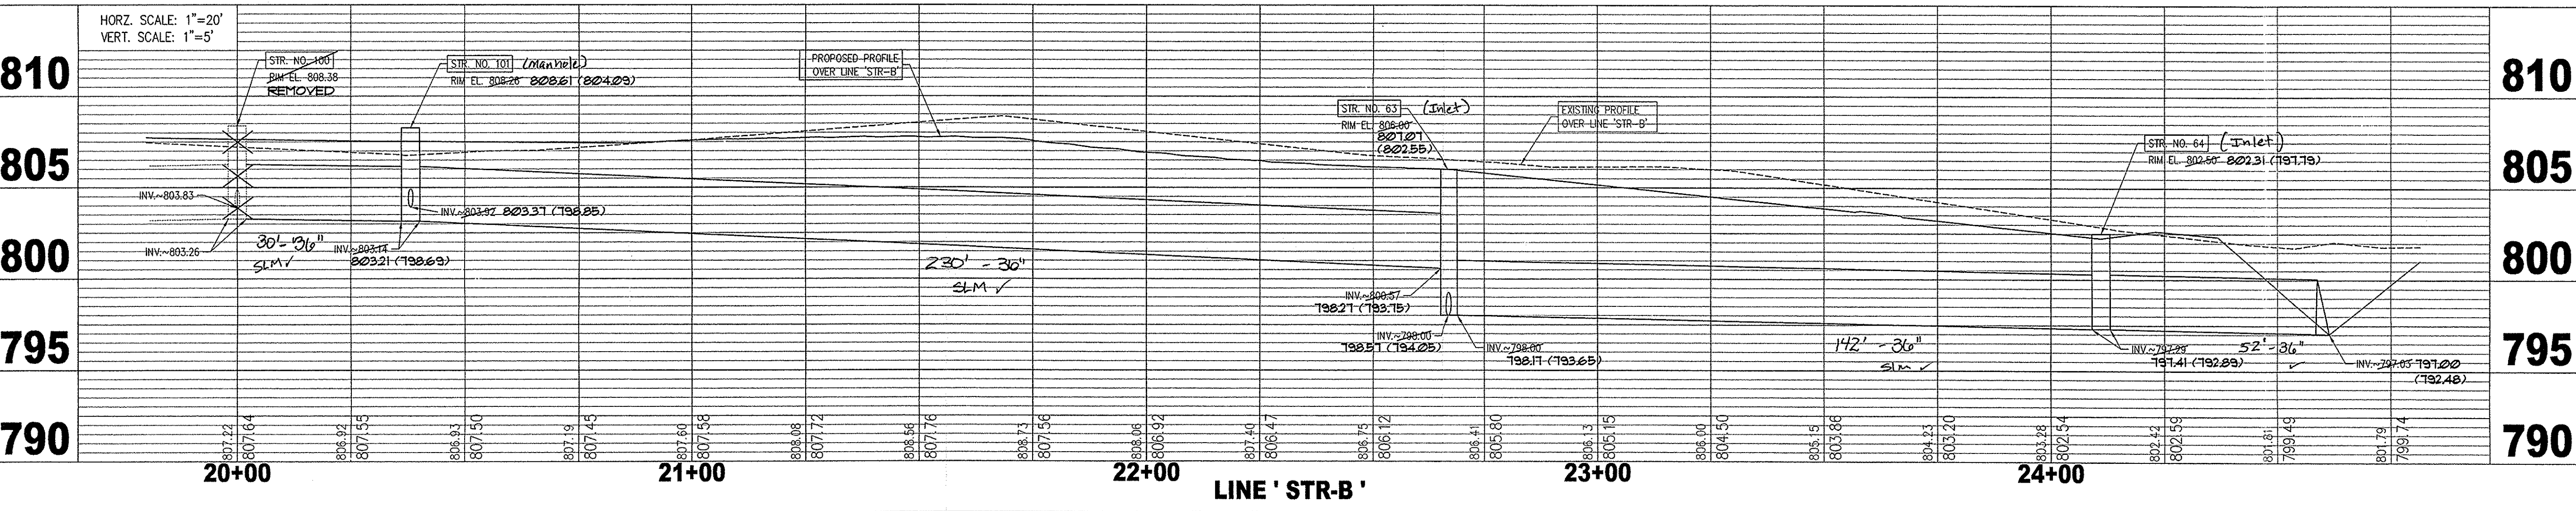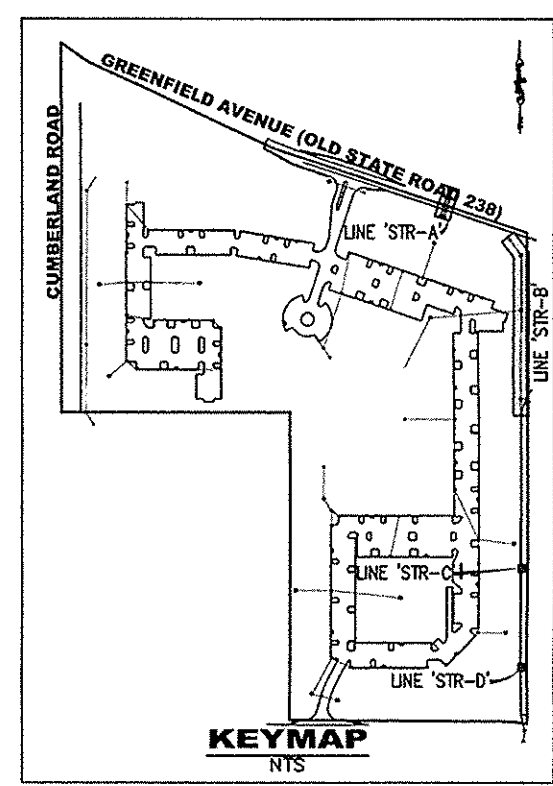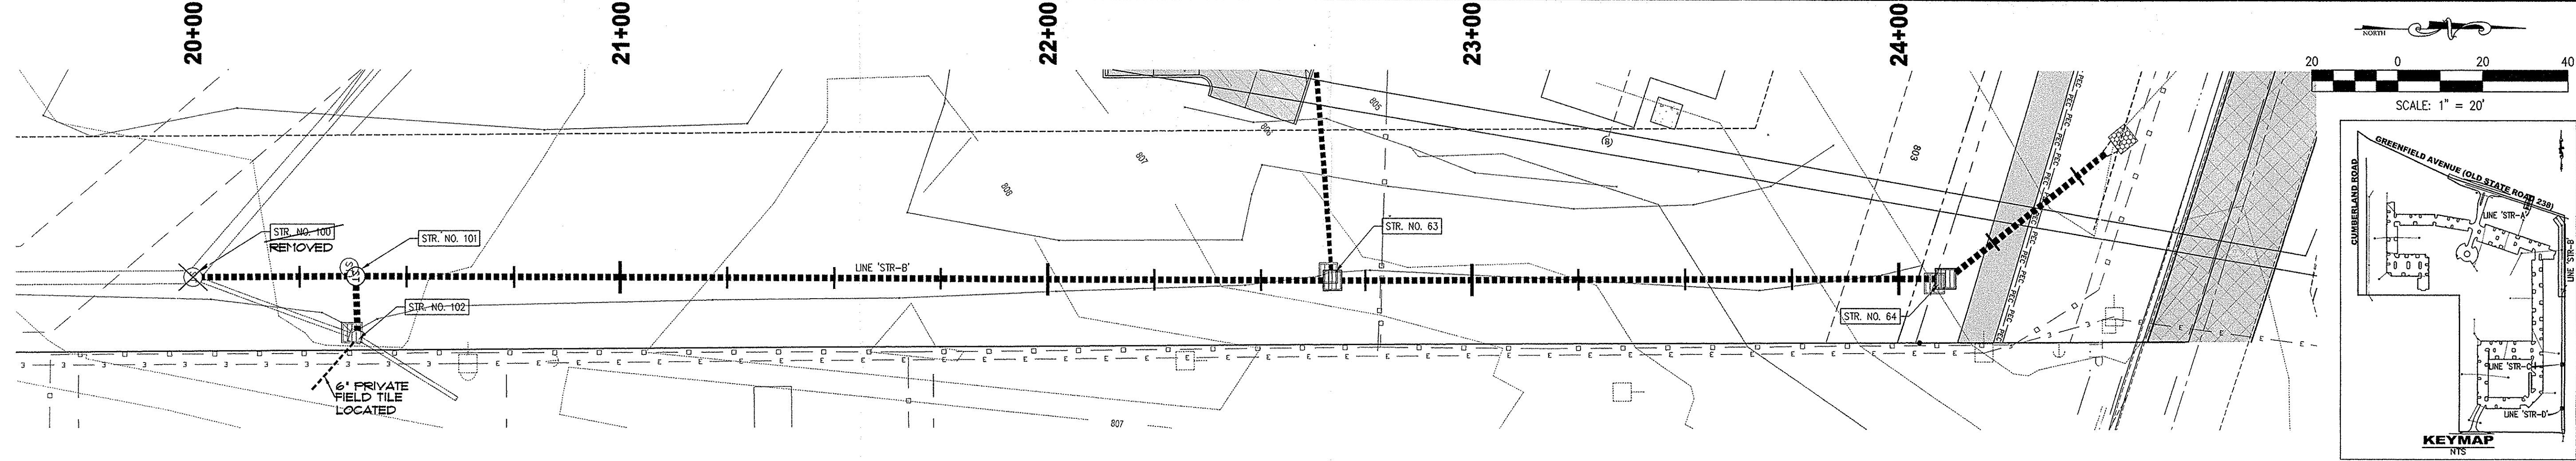

LINE 'STR-B'

LEGEND
80452 ASBUILT DESIGN ELEVATIONS
(80000) NAVD 88 ELEVATIONS


This information was gathered for input into the Stormwater Management Information System (S.M.I.S.). This document is considered an official record of the G.S.
Entry Date: 3-12-2009
Entered By: SLM



STORM PLAN AND PROFILE
STR. NO. 63, 64 & 100 THRU 103
CUMBERLAND APARTMENTS - STORM AS-BUILTS



CHECKED: GJJ
APPROVED: TEN
DRAWN: LMC
DESIGNED: BAB
DATE: AUGUST 2007

JOB NO. _____
SHEET 1 OF 1

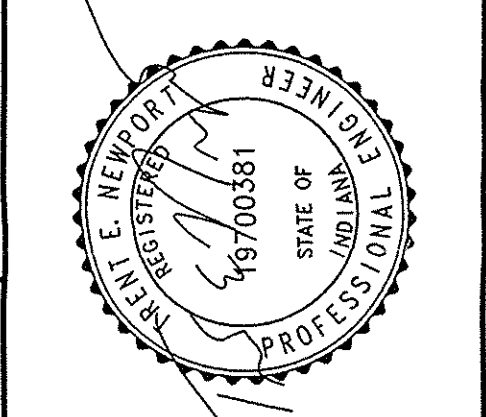

| NO. | DATE | BY | APPR. | REVISIONS |
|-----|------|----|-------|-----------|
| 1 | | | | |
| 2 | | | | |
| 3 | | | | |
| 4 | | | | |
| 5 | | | | |
| 6 | | | | |
| 7 | | | | |
| 8 | | | | |


REFERENCES: None
 PERMIT: AL
 DIRECTOR: M. G. ...
 FILE NAME: 29-005-07-18.03.02 - LMC
 DRAWN BY: LMC

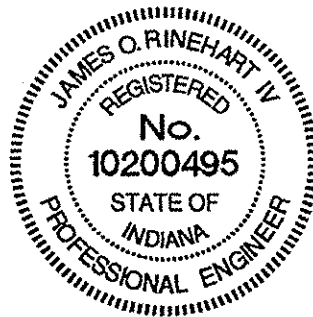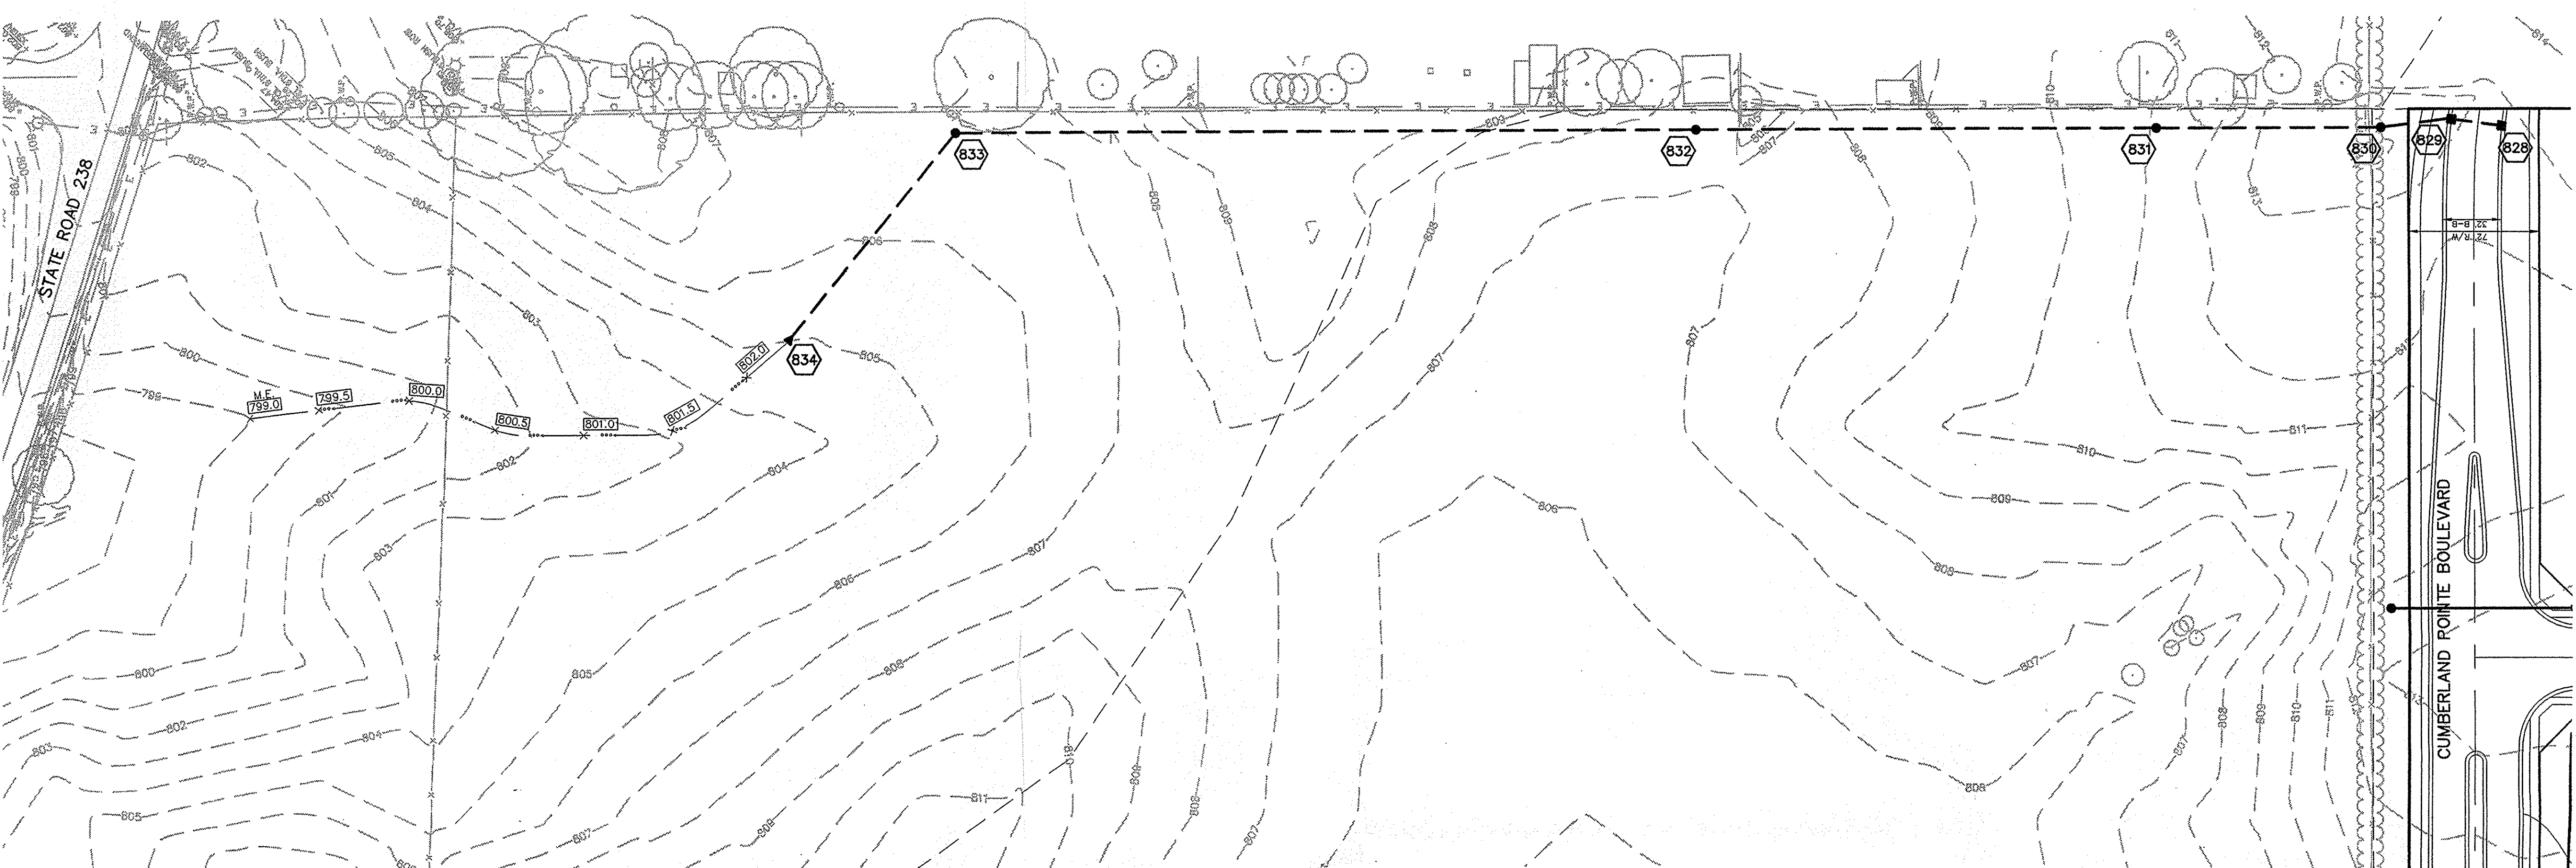



| | | | |
|------|---------|-----------|--|
| DATE | 4/28/03 | REVISIONS | |
| BY | | | |
| MARK | | | |
| DATE | 7/7/03 | REVISIONS | |
| BY | | | |
| MARK | | | |
| DATE | 8/27/03 | REVISIONS | |
| BY | | | |
| MARK | | | |
| DATE | 8/28/03 | REVISIONS | |
| BY | | | |
| MARK | | | |
| DATE | 8/28/03 | REVISIONS | |
| BY | | | |
| MARK | | | |
| DATE | 8/28/03 | REVISIONS | |
| BY | | | |
| MARK | | | |

CERTIFIED: 4/28/03

CONSULTING ENGINEERS - LAND SURVEYORS
 (317) 849-5935 1-800-728-6917 FAX: (317) 849-5942
 INDIANAPOLIS INDIANA

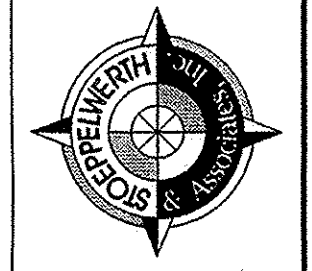

SCALE: 1" = 50'

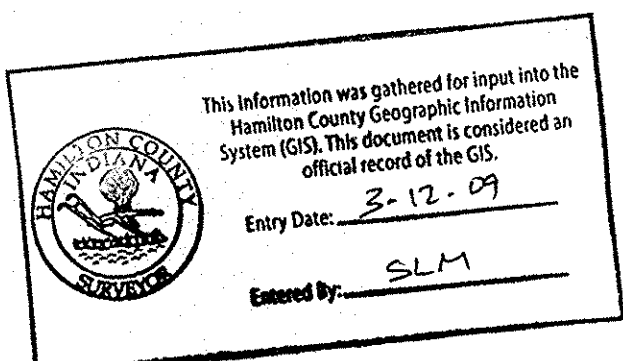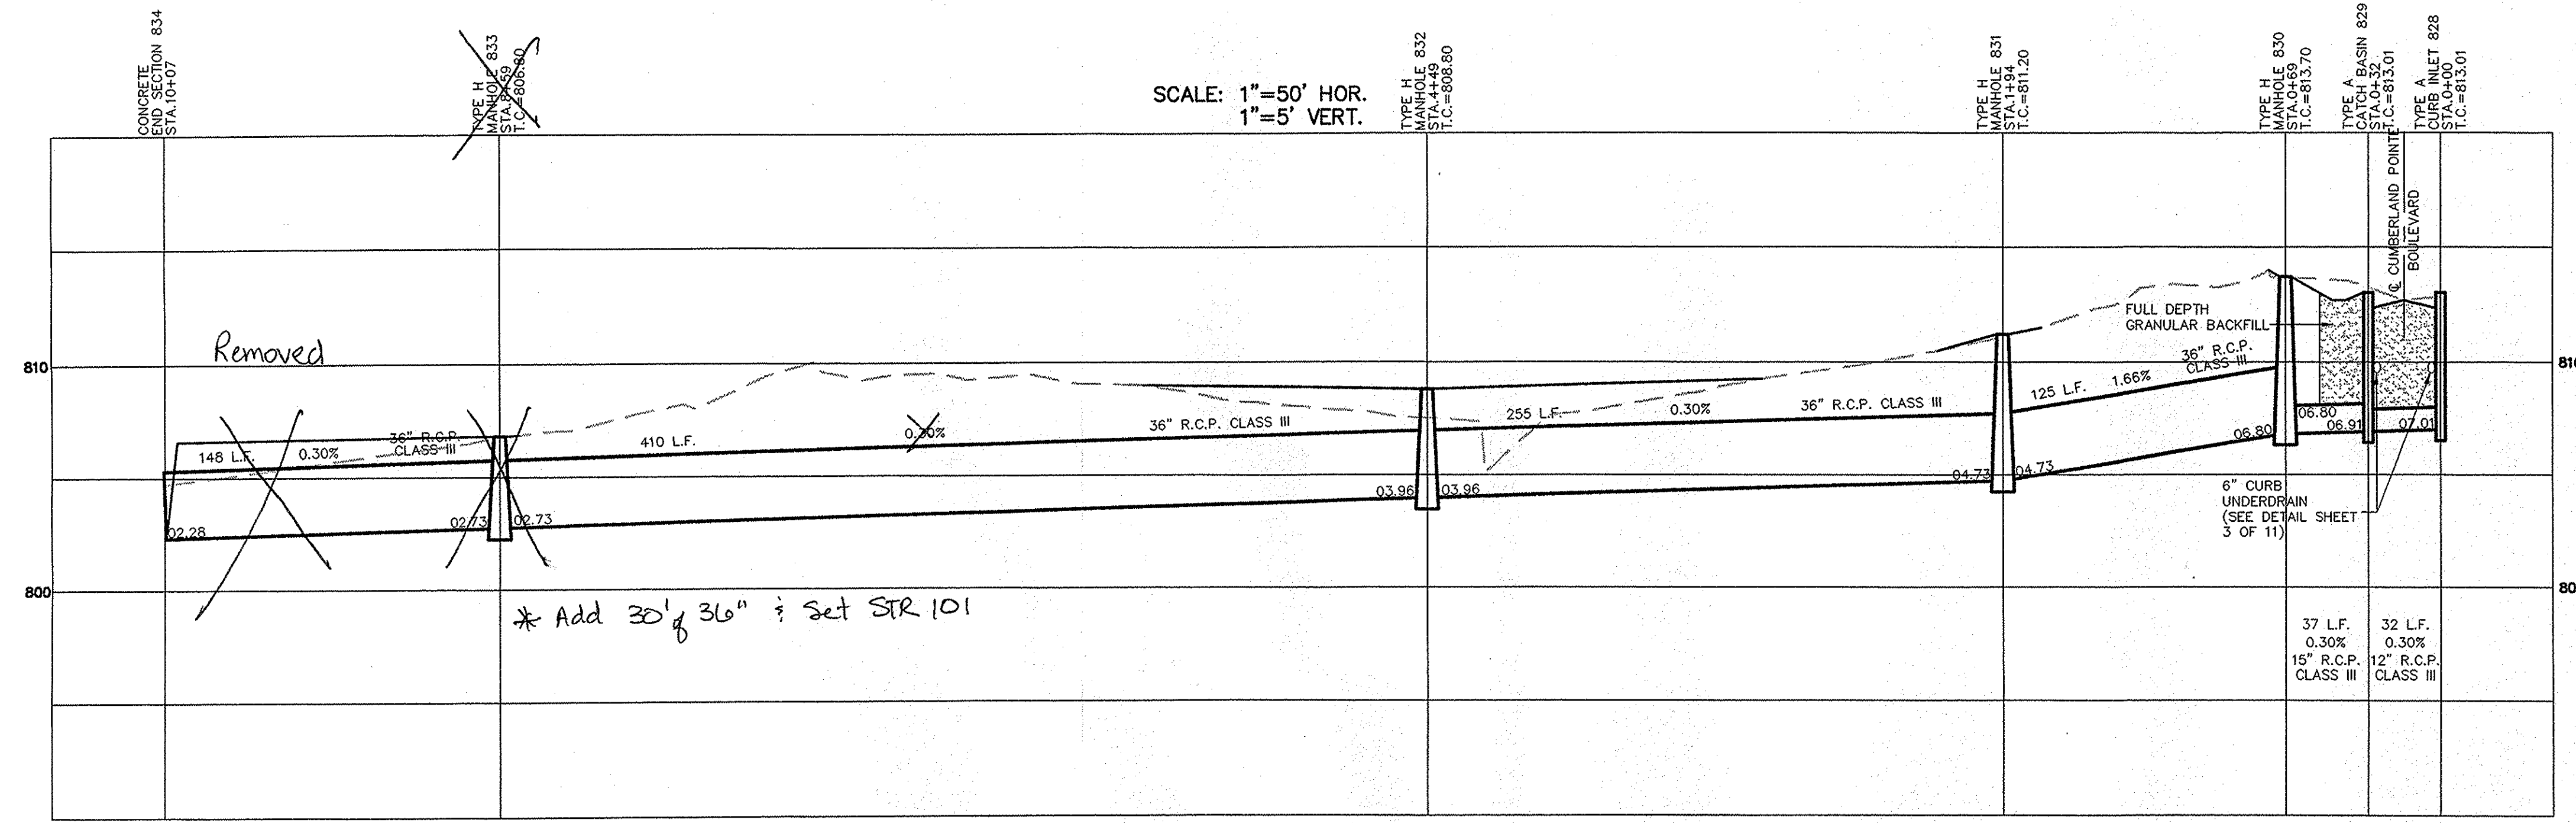

INDIANA

OFFSITE STORM PLAN & PROFILE
 CUMBERLAND POINTE
 COMMERCIAL SITE

NOBLESVILLE INDIANA

SHEET NO.
C603


FILED
 APR 07 2004

JOB NO. 45810


RECORD DRAWING

Jeffrey W. Darling
 JEFFORY W. DARLING
 Registered Land Surveyor
 No. 900017
 (ELEV) DENOTES DESIGN VALUE

7/28/04
 DATE

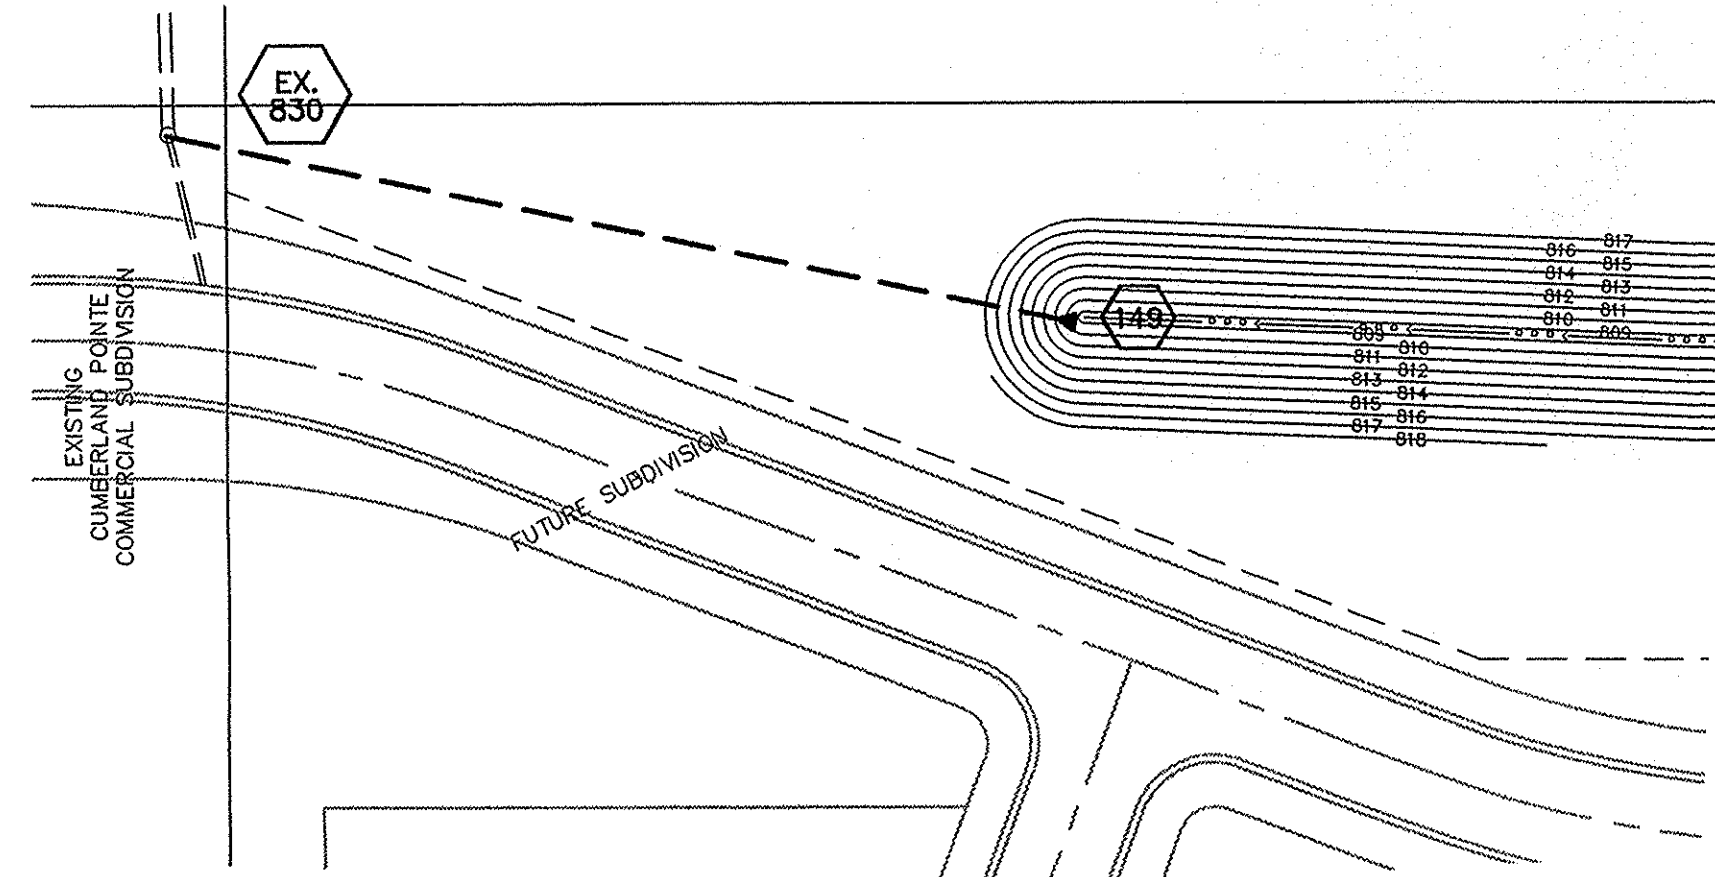


SCALE: 1"=50' HOR.
 1"=5' VERT.

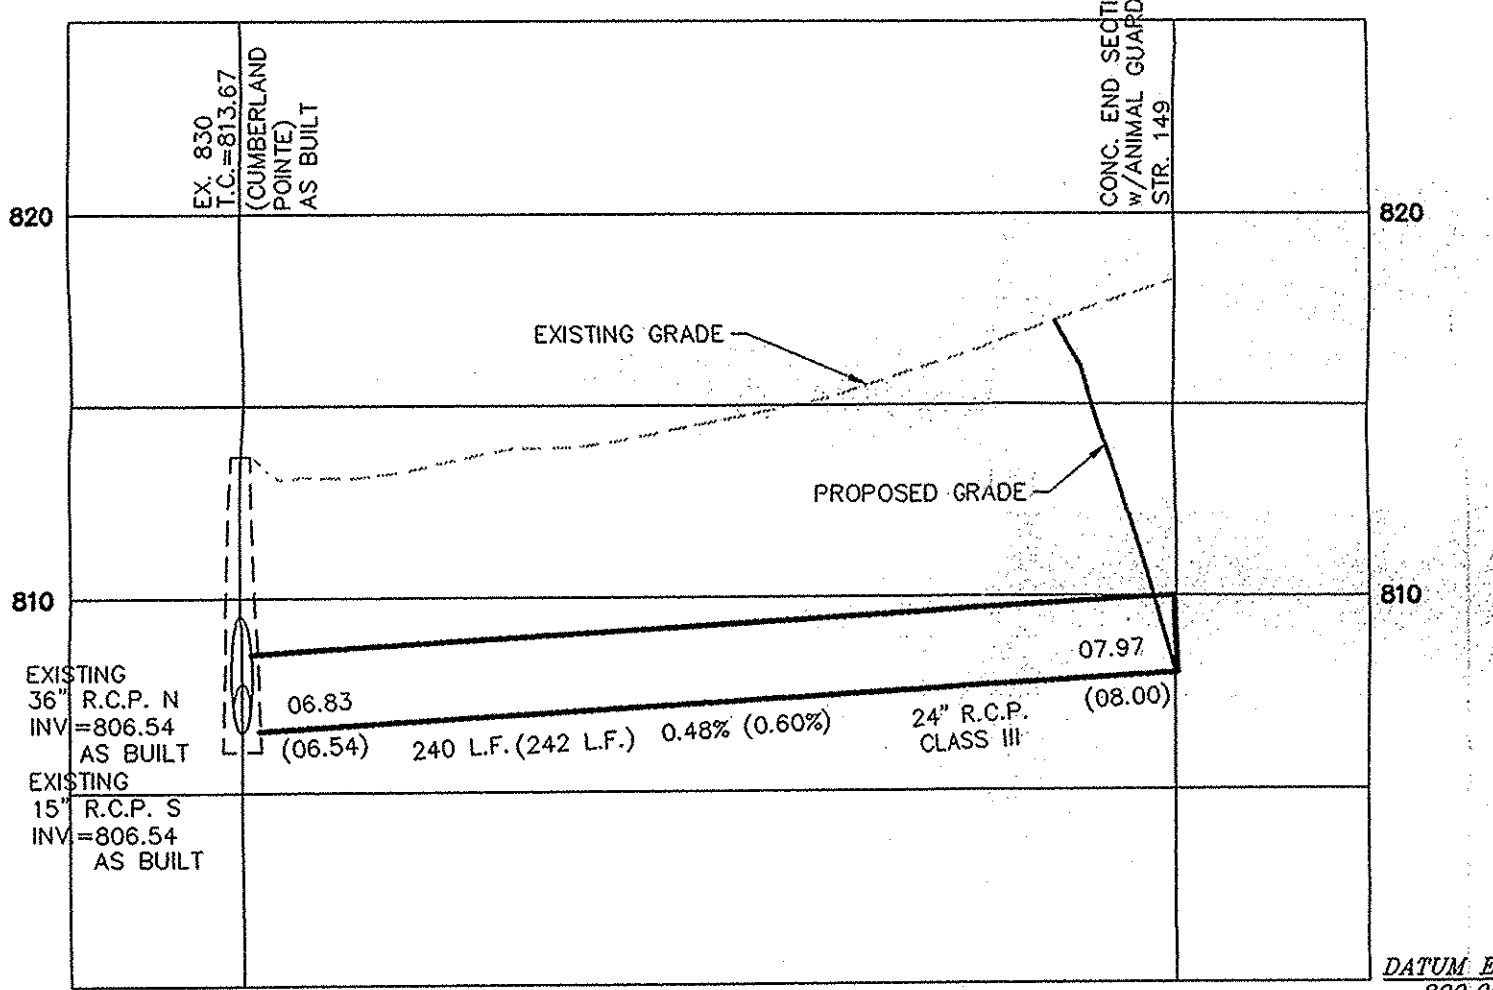


This information was gathered for input into the Hamilton County Geographic Information System (GIS). This document is considered an official record of the GIS.
 Entry Date: 3-12-09
 Entered By: SLM


SCALE: 1"=50' HOR.
 1"=5' VERT.

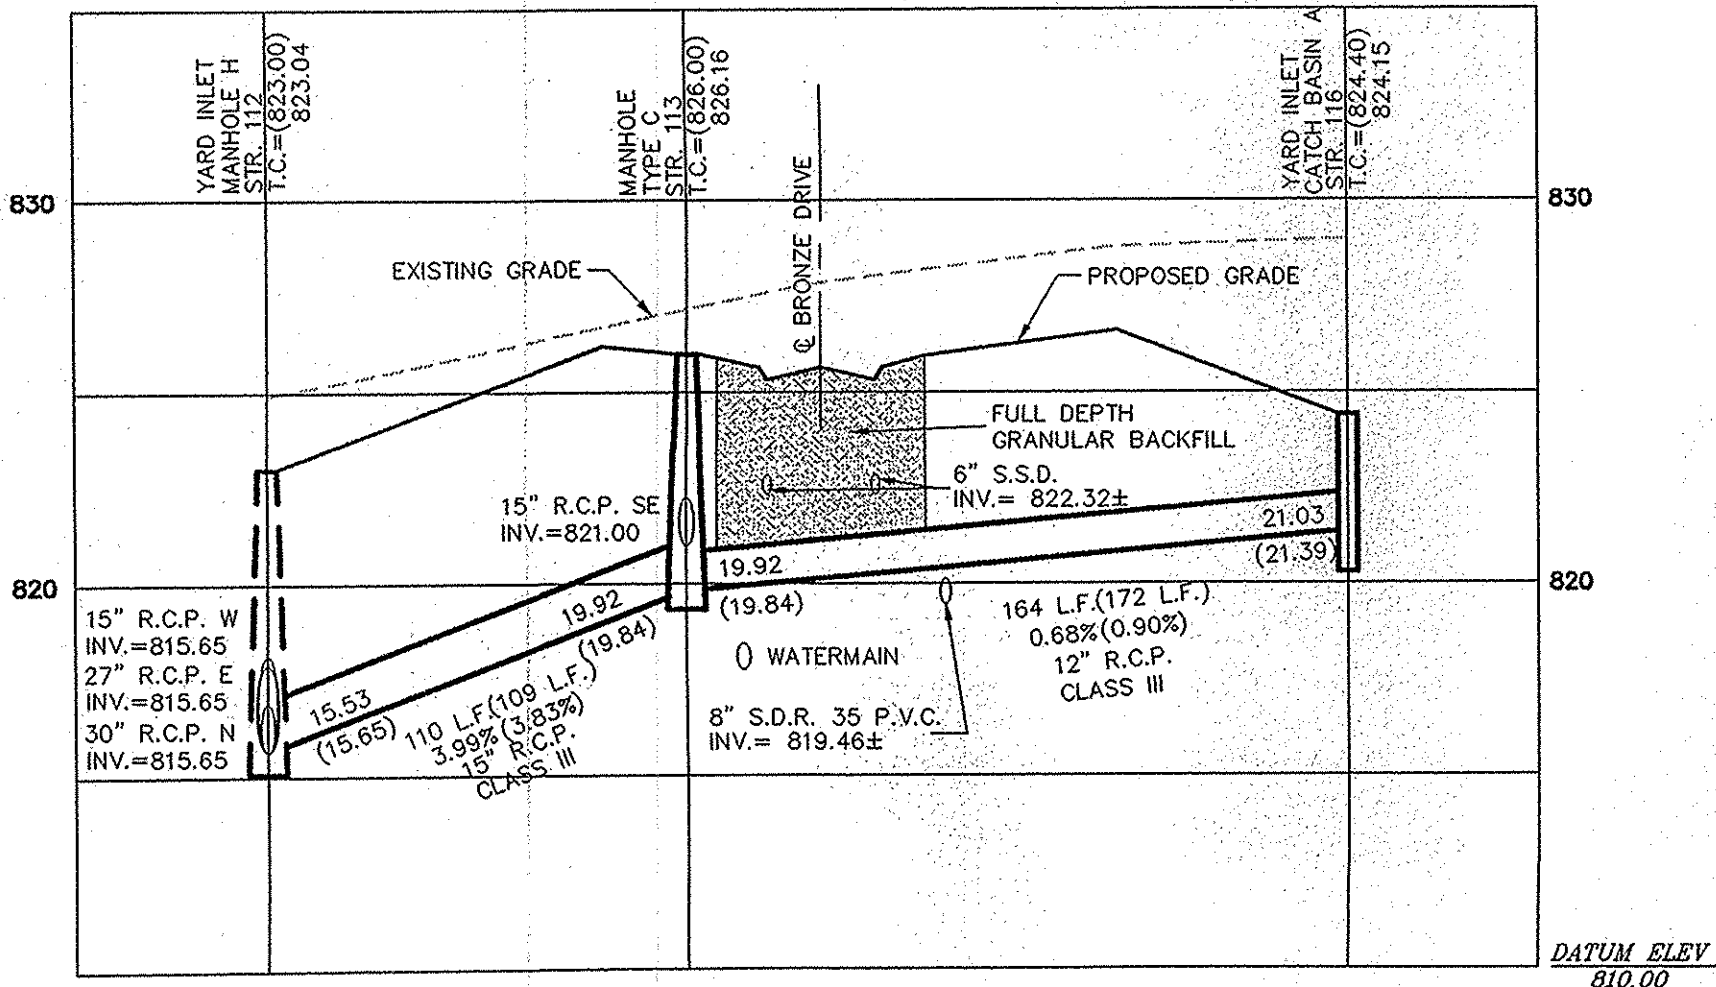


SCALE: 1"=50' HOR.
 1"=5' VERT.

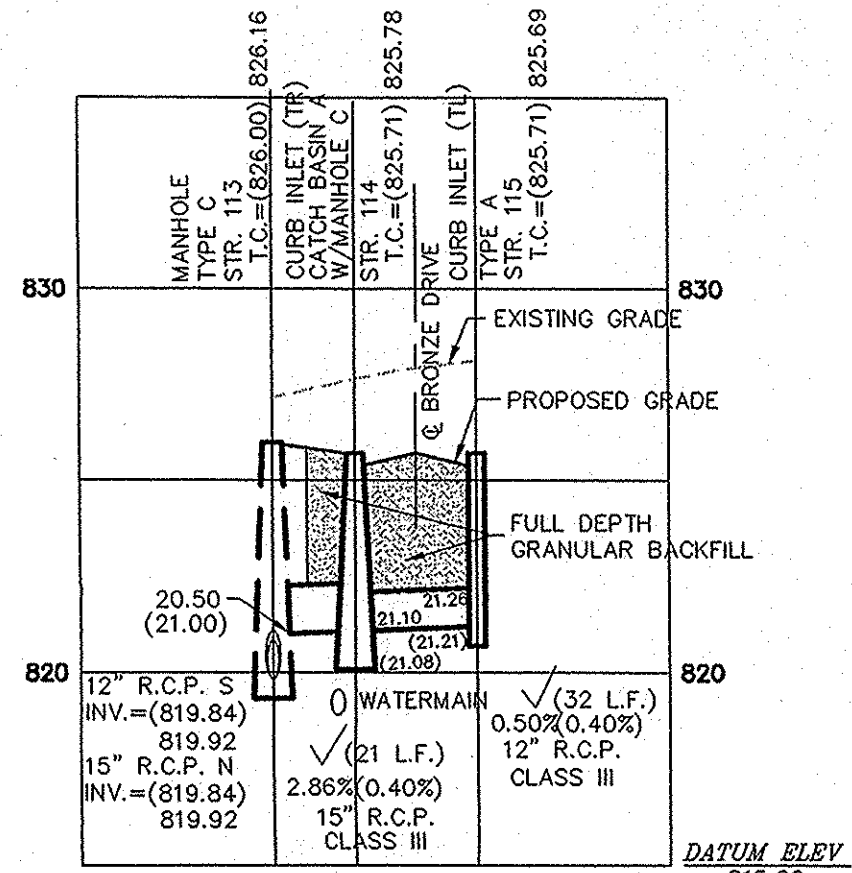


SCALE: 1"=50' HOR.
 1"=5' VERT.

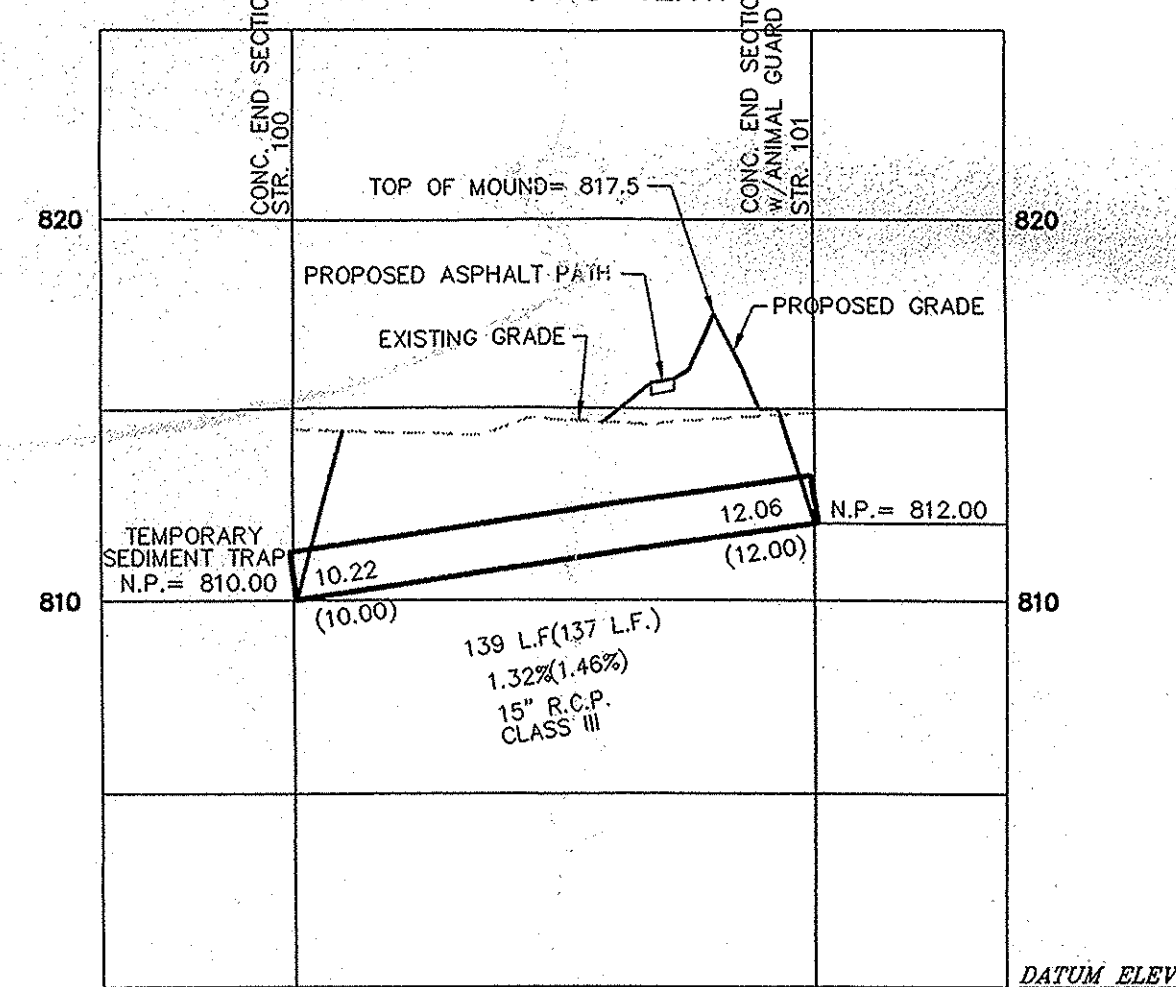



SCALE: 1"=50' HOR.
 1"=5' VERT.

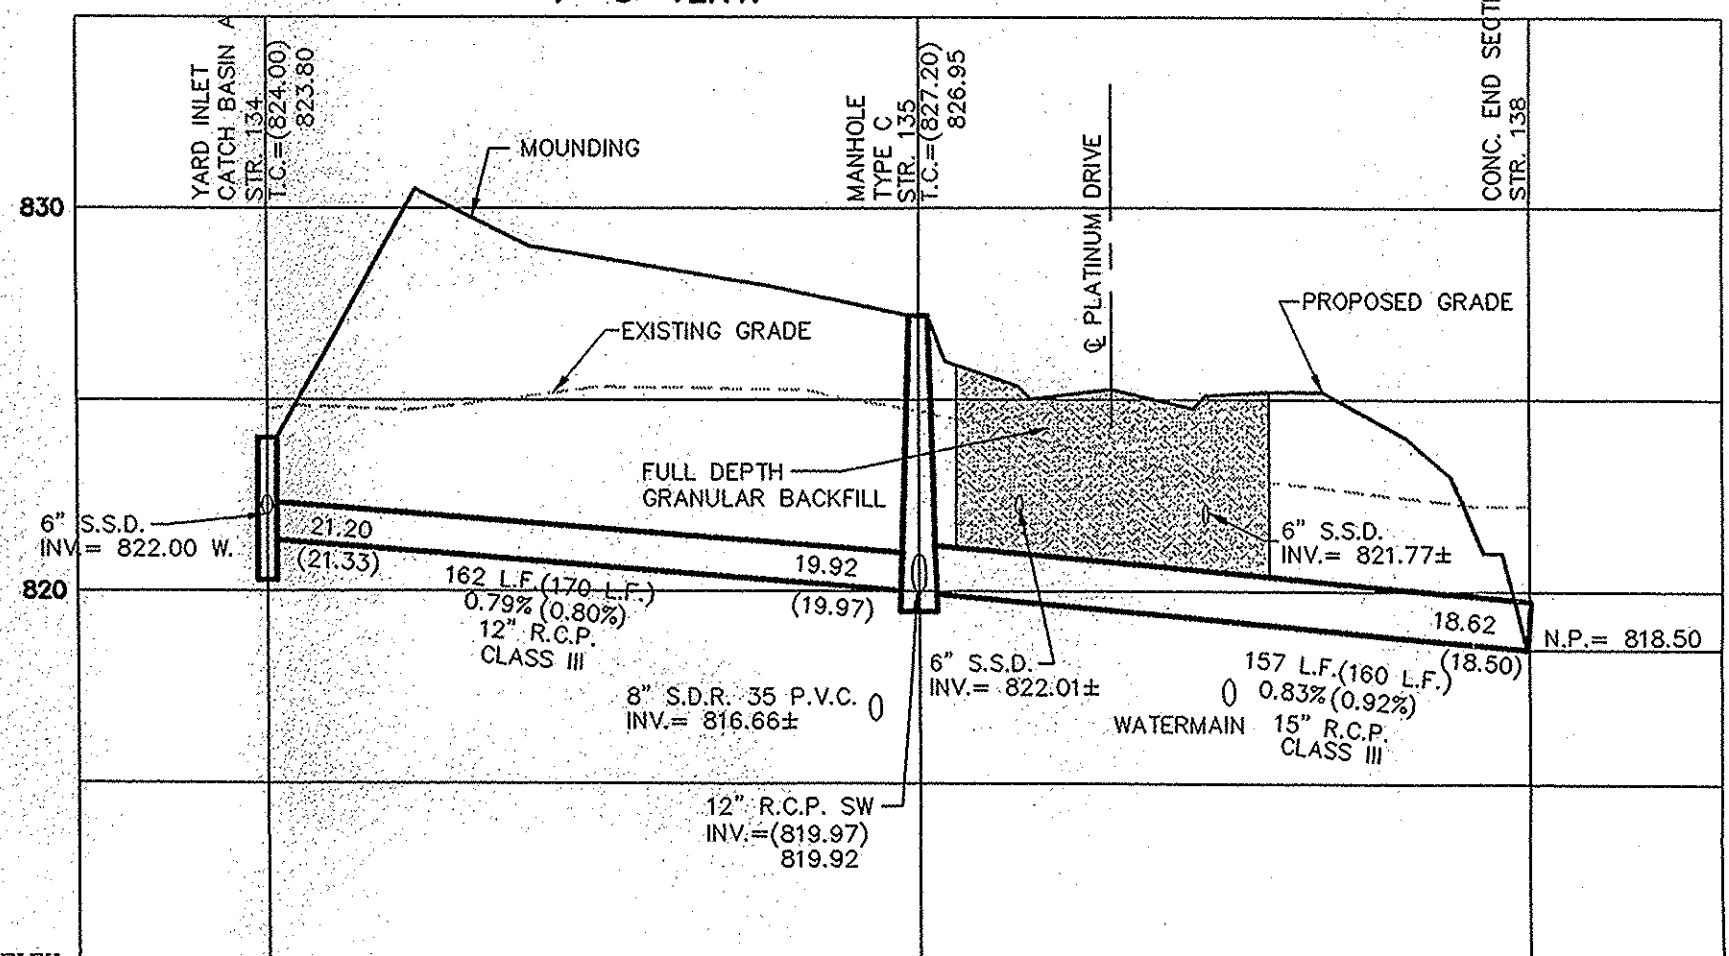


SCALE: 1"=50' HOR.
 1"=5' VERT.

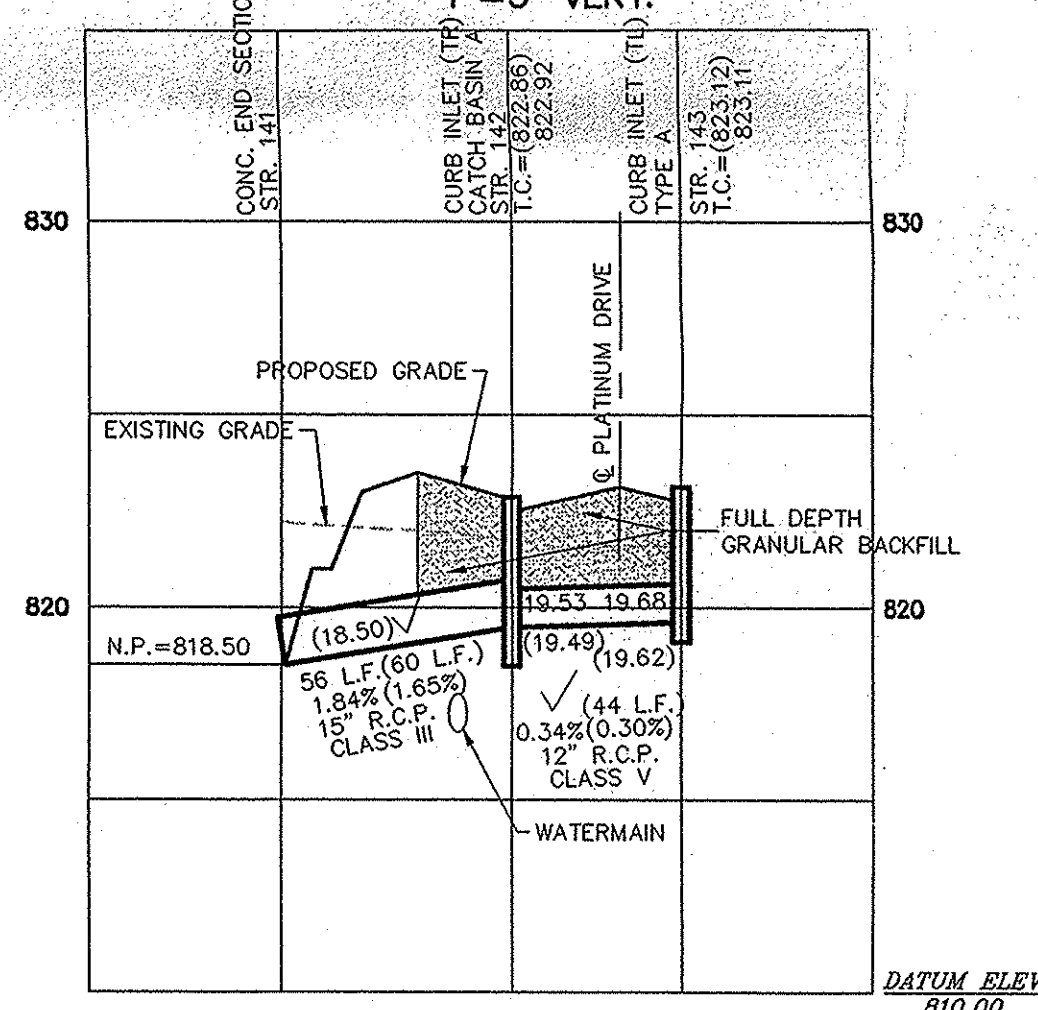


SCALE: 1"=50' HOR.
 1"=5' VERT.

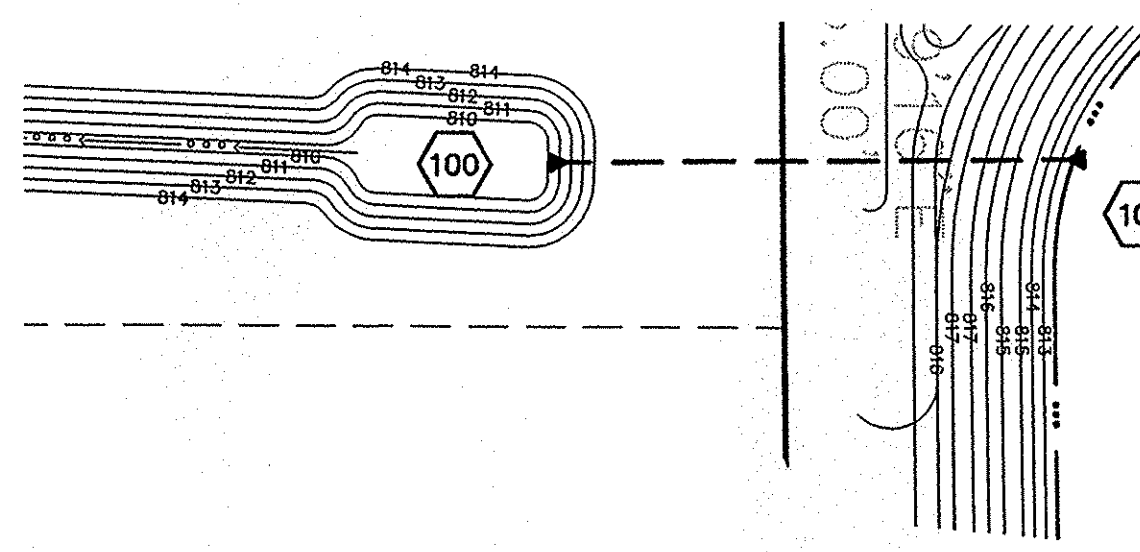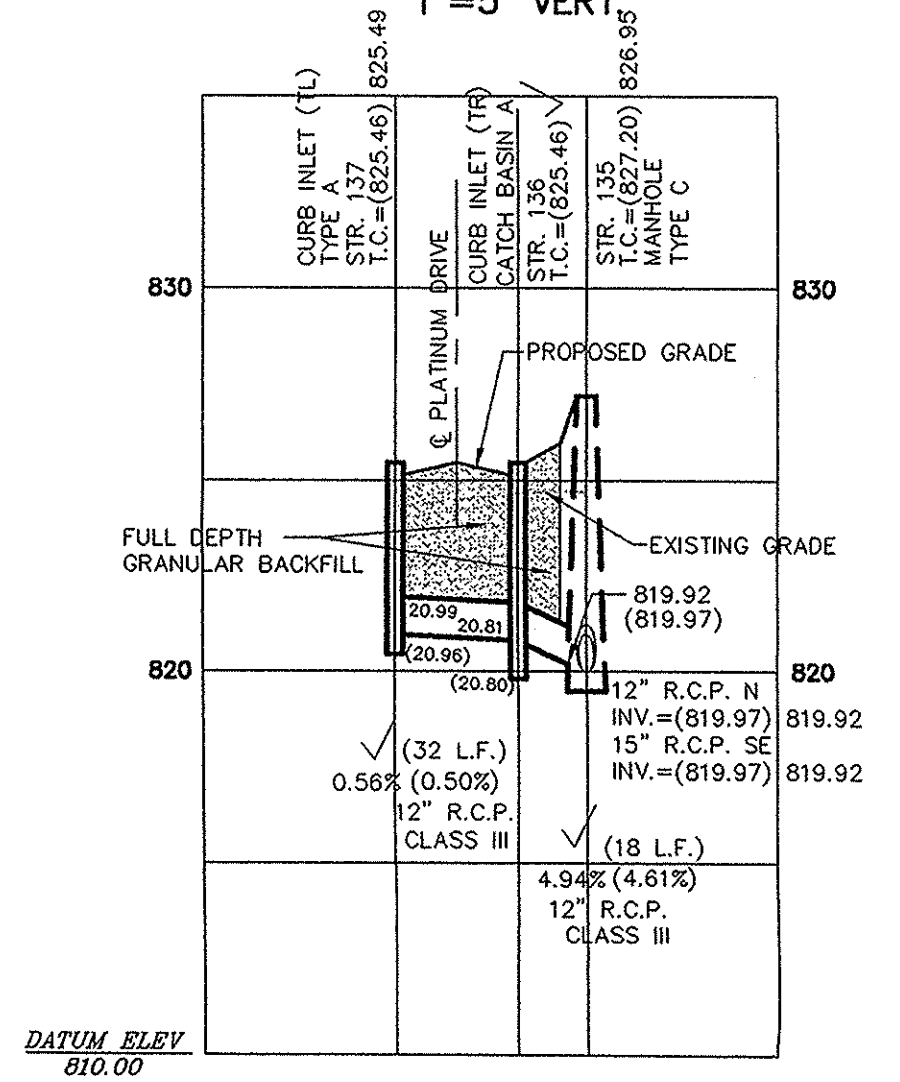



SCALE: 1"=50' HOR.
 1"=5' VERT.

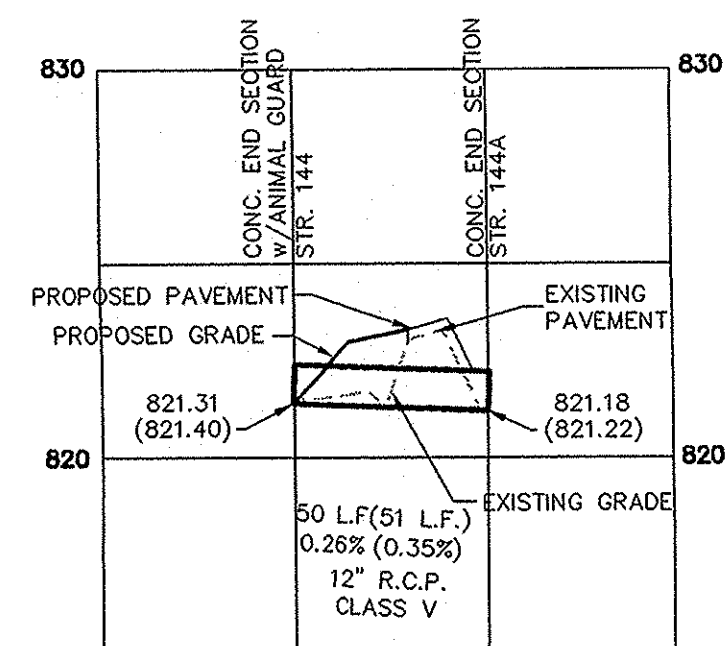

SCALE: 1"=50' HOR.
 1"=5' VERT.

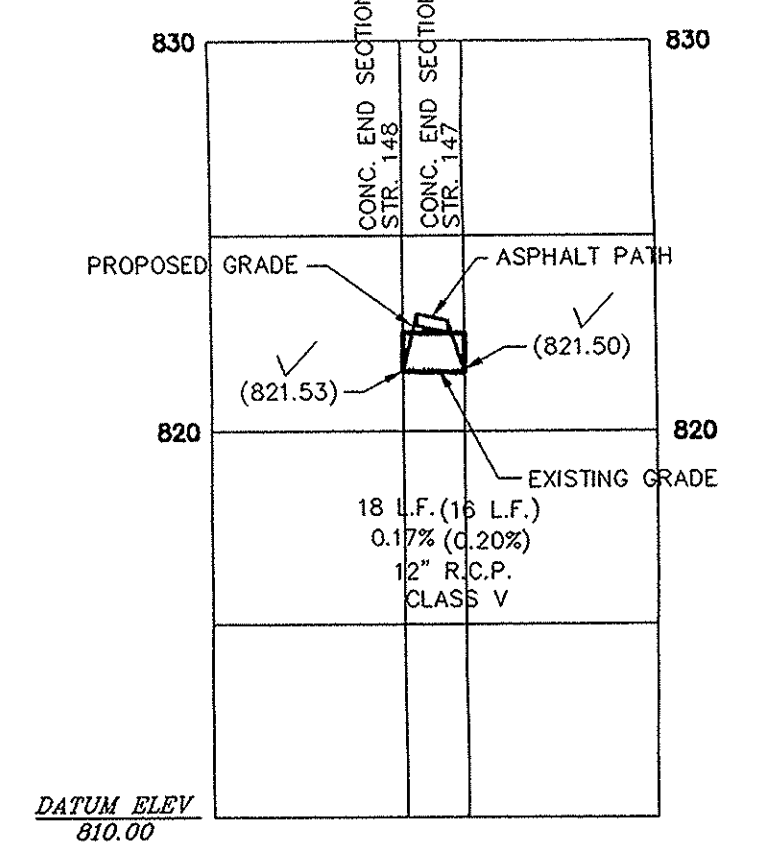

SCALE: 1"=50' HOR.
 1"=5' VERT.

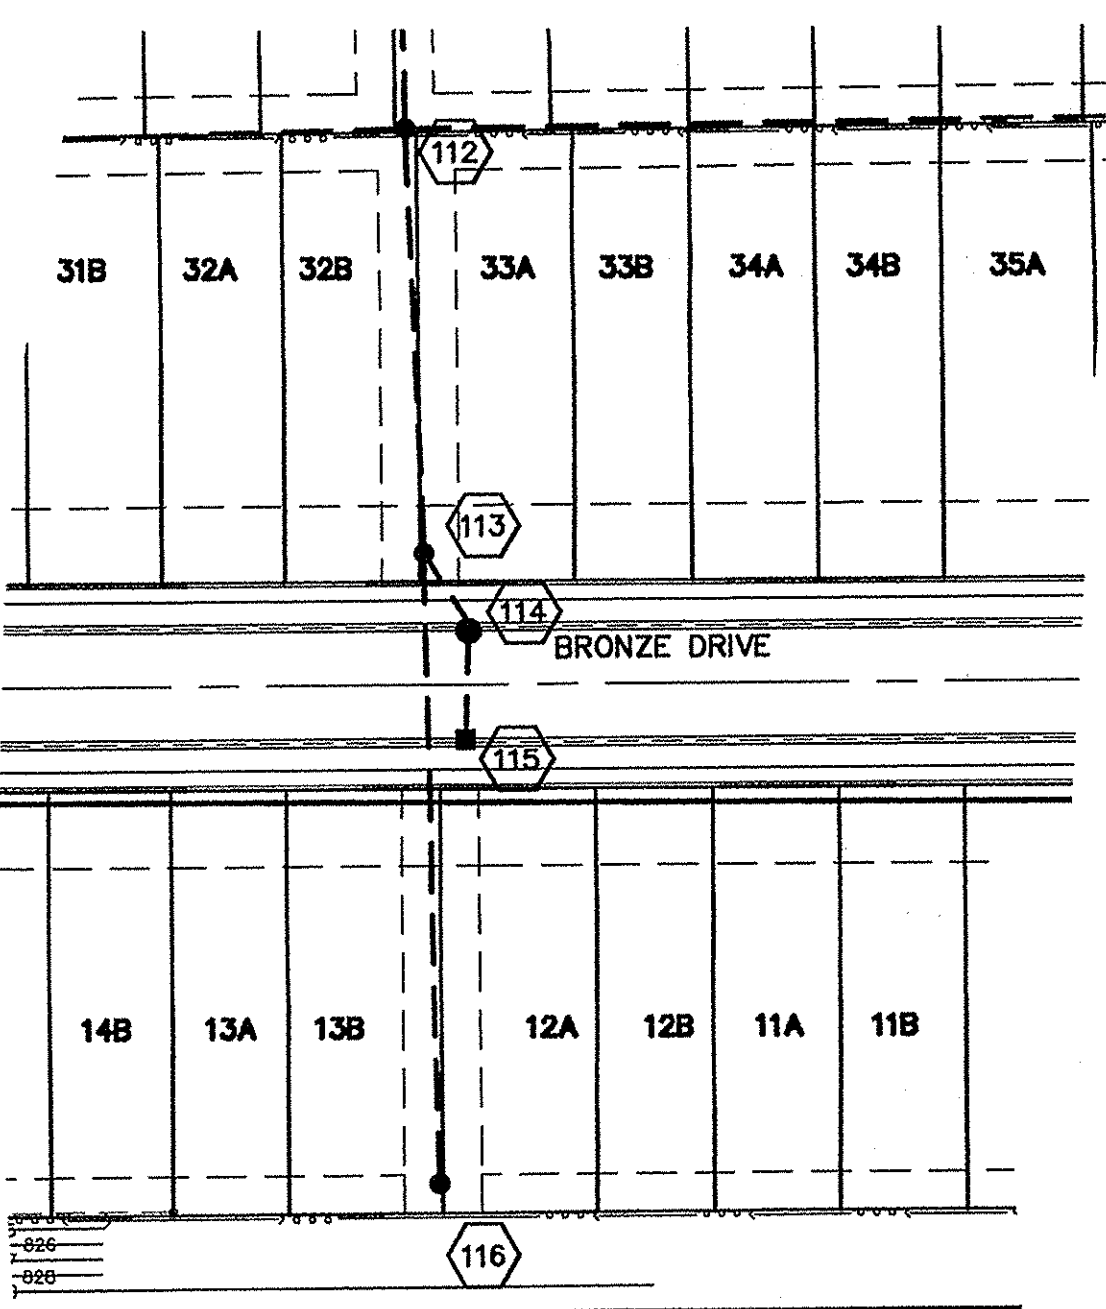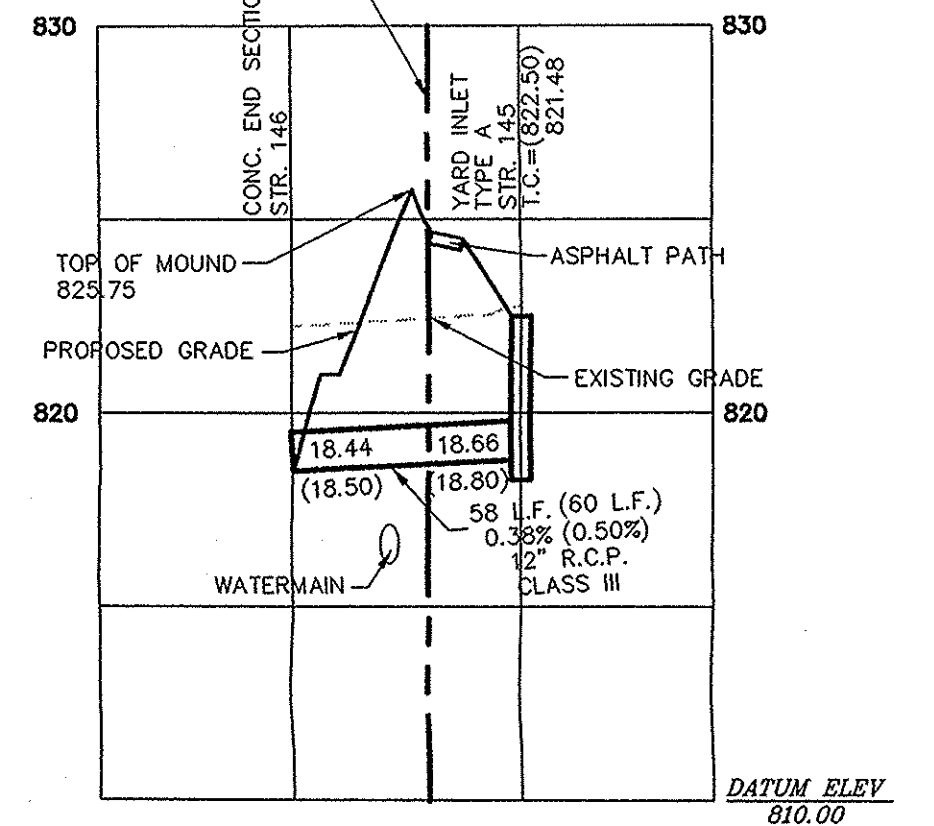

CERTIFIED: 12/8/03

CONSULTING ENGINEERS - LAND SURVEYORS
 (317) 849-5935 1-800-728-6917 FAX: (317) 849-5942
 INDIANA

DAVID J. STAPP
 REGISTERED PROFESSIONAL ENGINEER
 No. 19358
 STATE OF INDIANA

STORM SEWER PLAN & PROFILES
 HOWE PLACE
 NOBLESVILLE

SEP 03 2004 SHEET NO. 601
 OFFICE OF HAMILTON COUNTY SURVEYOR

JOB NO. 45550