

Drain: MERRIMAC DRAIN **Drain #:** 278
Improvement/Arm: MERRIMAC SECTION 2
Operator: JDH **Date:** 2-10-04
Drain Classification: Urban/Rural **Year Installed:** 278

GIS Drain Input Checklist

- Pull Source Documents for Scanning JDH 2-10
- Digitize & Attribute Tile Drains N/A
- Digitize & Attribute Storm Drains JDH 2-10
- Digitize & Attribute SSD JDH 2-10
- Digitize & Attribute Open Ditch N/A
- Stamp Plans JDH 2-10
- Sum drain lengths & Validate JDH 2-10
- Enter Improvements into Posse JDH 2-10
- Enter Drain Age into Posse JDH 3-1
- Sum drain length for Watershed in Posse JDH 3-1
- Check Database entries for errors JDH 2-10



SURVEYOR'S OFFICE

Hamilton County

Kenton C. Ward, Surveyor

Phone (317) 776-8495

Fax (317) 776-9628

Suite 146

One Hamilton County Square

Noblesville, Indiana 46060-2230

TO: HAMILTON COUNTY DRAINAGE BOARD

RE: Merrimac Drain-Section 2

Attached is a petition, non-enforcement request, plans, calculations, quantity summary and assessment roll for the Section 2 Arm Merrimac Drain. I have reviewed the submittals and petition and have found each to be in proper form.

I have made a personal inspection of the land described in the petition. Upon doing so, I believe that the drain is practicable; will improve the public health; benefit a public highway and be of public utility; and that the costs, damages and expenses of the proposed drain will probably be less than the benefits accruing to the owners of land likely to be benefited. The drain will consist of the following:

| | | | |
|---------|------------|---------|----------|
| 6" SSD | 8,694 feet | 24" RCP | 738 feet |
| 12" RCP | 1,715 feet | 30" RCP | 311 feet |
| 15" RCP | 525 feet | 36" RCP | 617 feet |
| 18" RCP | 221 feet | | |

The total length of the drain will be 12,821 feet.

The subsurface drains (SSD) to be part of the regulated drain are those located under the curbs. Only the main SSD lines, which are located within the Right of Way, are to be maintained as regulated drain. Laterals for individual lots will not be considered part of the regulated drain.


I have reviewed the plans and believe the drain will benefit each lot equally. I also believe that no damages will result to landowners by the construction of this drain. I recommend a maintenance assessment of \$30.00 per lot, \$5.00 per acre for roadways, with a \$30.00 minimum. With this assessment the total annual assessment for this section will be \$ 1755.00 .

Parcels assessed for this drain may be assessed for the Osborn-Collins Drain or Williams Creek Drain at sometime in the future.

I believe this proposed drain meets the requirements for Urban Drain Classification as set out in IC 36-9-27-67 to 69. Therefore, this drain shall be designated as an Urban Drain.

I recommend that upon approval of the above proposed drain that the Board also approve the attached non-enforcement request. This request is for the reduction of the regulated drain easement to those easement widths as shown on the secondary plat for Merrimac Section 2 as recorded in the office of the Hamilton County Recorder.

I recommend the Board set a hearing for this proposed drain for September 1996.

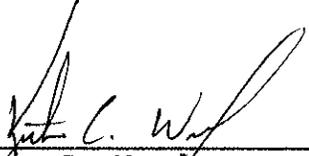

Kenton C. Ward
Hamilton County Surveyor
KCW/no

Fidelity and Deposit Company

HOME OFFICE

OF MARYLAND

BALTIMORE, MD. 21203



*Has expired
But not
released*

SUBDIVISION BOND

#3069 58 07

COPY

KNOW ALL MEN BY THESE PRESENTS, That we, Wilfong Construction Co., Inc.
and Merrimac Corporation and M. Kathleen McKinney Stasey as Principal,
and Fidelity and Deposit Company of Maryland, of Baltimore,
Maryland, as Surety, are held and firmly bound unto the
Hamilton County Board of Commissioners
 in the sum of One Hundred Seventy Six Thousand Five Hundred Sixty Four & XX/100
 (\$176,564.00) Dollars for the payment of which, well and
 truly to be made, we jointly and severally bind ourselves,
 our heirs, legatees, executors, administrators, personal
 representatives, successors and assigns firmly by these
 presents.

Sealed with our seals and dated this 30th day of
November 1995.

THE CONDITIONS OF THE ABOVE OBLIGATION ARE SUCH THAT:

Whereas, the Hamilton County Board of Commissioners
_____ has granted Wilfong Construction Co., Inc.
and Merrimac Corporation and M. Kathleen McKinney Stasey a permit to
 construct Storm Sewer and Sub surface - Merrimac - Section II

Now, if said Wilfong Construction Co., Inc. and Merrimac Corporation and M. Kathleen
_____ shall improve said Merrimac Section II McKinney Stasey
_____ in accordance with specifications and regulations of the
Hamilton County Board of Commissioners
 and comply with all of the provisions of said permit then
 this obligation to be void, otherwise to be and remain in
 full force and effect.

WILFONG CONSTRUCTION CO., INC.

BY: [Signature]
 MERRIMAC CORPORATION

BY: [Signature]
M. Kathleen McKinney Stasey
 FIDELITY AND DEPOSIT COMPANY OF MARYLAND

BY: [Signature]
 Kevin W. Birch - Attorney-in-Fact

RELEASED 1-27-97

1-27-97

Power of Attorney
FIDELITY AND DEPOSIT COMPANY OF MARYLAND

HOME OFFICE, BALTIMORE, MD

KNOW ALL MEN BY THESE PRESENTS: That the FIDELITY AND DEPOSIT COMPANY OF MARYLAND, a corporation of the State of Maryland, by C. M. PECOT, JR., Vice-President, and C. W. ROBBINS, Assistant Secretary, in pursuance of authority granted by Article VI, Section 2, of the By-Laws of said Company, which are set forth on the reverse side hereof and are hereby certified to be in full force and effect on the date hereof, does hereby nominate, constitute and appoint William E. Frick, Jr., Steven E. Wolf, Anthony E. Ortman, Andrew M. Hatheway, Eric A. Schieferstein and Kevin W. Birch, all of Indianapolis, Indiana, EACH..... its true and lawful agent and Attorney-in-Fact, to make, execute, seal and deliver, for, and on its behalf as surety, and as its act and deed: any and all bonds and undertakings.....

And the execution of such bonds or undertakings in pursuance of these presents, shall be as binding upon said Company, as fully and amply, to all intents and purposes, as if they had been duly executed and acknowledged by the regularly elected officers of the Company at its office in Baltimore, Md., in their own proper persons. This power of attorney revokes that issued on behalf of William E. Frick, Jr., et al, dated January 4, 1994.

The said Assistant Secretary does hereby certify that the extract set forth on the reverse side hereof is a true copy of Article VI, Section 2, of the By-Laws of said Company, and is now in force.


IN WITNESS WHEREOF, the said Vice-President and Assistant Secretary have hereunto subscribed their names and affixed the Corporate Seal of the said FIDELITY AND DEPOSIT COMPANY OF MARYLAND, this 27th day of June, A.D. 1995

FIDELITY AND DEPOSIT COMPANY OF MARYLAND

ATTEST:



Assistant Secretary

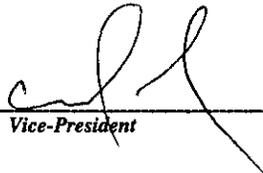
By 

Vice-President

STATE OF MARYLAND }
COUNTY OF BALTIMORE } ss:

On this 27th day of June, A.D. 1995, before the subscriber, a Notary Public of the State of Maryland, duly commissioned and qualified, came C. M. PECOT, JR., Vice-President and C. W. ROBBINS, Assistant Secretary of the FIDELITY AND DEPOSIT COMPANY OF MARYLAND, to me personally known to be the individuals and officers described in and who executed the preceding instrument, and they each acknowledged the execution of the same, and being by me duly sworn, severally and each for himself depose and saith, that they are the said officers of the Company aforesaid, and that the seal affixed to the preceding instrument is the Corporate Seal of said Company, and that the said Corporate Seal and their signatures as such officers were duly affixed and subscribed to the said instrument by the authority and direction of the said Corporation.

IN TESTIMONY WHEREOF, I have hereunto set my hand and affixed my Official Seal the day and year first above written.

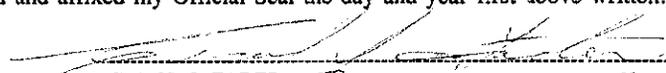

CAROL J. FADER

Notary Public

My Commission Expires August 1, 1996


CERTIFICATE

I, the undersigned, Assistant Secretary of the FIDELITY AND DEPOSIT COMPANY OF MARYLAND, do hereby certify that the original Power of Attorney of which the foregoing is a full, true and correct copy, is in full force and effect on the date of this certificate; and I do further certify that the Vice-President who executed the said Power of Attorney was one of the additional Vice-Presidents specially authorized by the Board of Directors to appoint any Attorney-in-Fact as provided in Article VI, Section 2, of the By-Laws of the FIDELITY AND DEPOSIT COMPANY OF MARYLAND.

This Certificate may be signed by facsimile under and by authority of the following resolution of the Board of Directors of the FIDELITY AND DEPOSIT COMPANY OF MARYLAND at a meeting duly called and held on the 16th day of July, 1969.

RESOLVED: "That the facsimile or mechanically reproduced signature of any Assistant Secretary of the Company, whether made heretofore or hereafter, wherever appearing upon a certified copy of any power of attorney issued by the Company, shall be valid and binding upon the Company with the same force and effect as though manually affixed."

IN TESTIMONY WHEREOF, I have hereunto subscribed my name and affixed the corporate seal of the said Company, this 30th day of November, 1995.

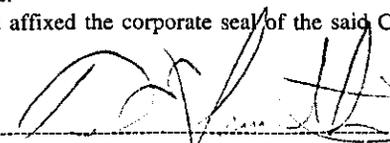

Assistant Secretary

L1428c-044

EXTRACT FROM BY-LAWS OF FIDELITY AND DEPOSIT COMPANY OF MARYLAND

"Article VI, Section 2. The Chairman of the Board, or the President, or any Executive Vice-President, or any of the Senior Vice-Presidents or Vice-Presidents specially authorized so to do by the Board of Directors or by the Executive Committee, shall have power, by and with the concurrence of the Secretary or any one of the Assistant Secretaries, to appoint Resident Vice-Presidents, Assistant Vice-Presidents and Attorneys-in-Fact as the business of the Company may require, or to authorize any person or persons to execute on behalf of the Company any bonds, undertakings, recognizances, stipulations, policies, contracts, agreements, deeds, and releases and assignments of judgements, decrees, mortgages and instruments in the nature of mortgages, . . . and to affix the seal of the Company thereto."

Fidelity and Deposit Company

HOME OFFICE

OF MARYLAND

BALTIMORE, MD. 21203



Has expired But not released

SUBDIVISION BOND

#3069 58 08

COPY

KNOW ALL MEN BY THESE PRESENTS, That we, Wilfong Construction Co., Inc.
and Merrimac Corporation and M. Kathleen McKinney Stasey as Principal,
and Fidelity and Deposit Company of Maryland, of Baltimore,
Maryland, as Surety, are held and firmly bound unto the
Hamilton County Board of Commissioners
 in the sum of Thirty Five Thousand Eight Hundred Ninety Three and XX/100
 (\$ 35,893.00) Dollars for the payment of which, well and
 truly to be made, we jointly and severally bind ourselves,
 our heirs, legatees, executors, administrators, personal
 representatives, successors and assigns firmly by these
 presents.

Sealed with our seals and dated this 30th day of
November 19 95.

THE CONDITIONS OF THE ABOVE OBLIGATION ARE SUCH THAT:

Whereas, the Hamilton County Board of Commissioners
and Merrimac Corporation and M. Kathleen McKinney Stasey has granted Wilfong Construction Co., Inc.
construct Erosion - Merrimac - Section II a permit to

Now, if said Wilfong Construction Co., Inc. and Merrimac Corporation and M. Kathleen
shall improve said Merrimac Section II McKinney Stasey
in accordance with specifications and regulations of the
Hamilton County Board of Commissioners
and comply with all of the provisions of said permit then
this obligation to be void, otherwise to be and remain in
full force and effect.

WILFONG CONSTRUCTION CO., INC.

BY: [Signature]
 MERRIMAC CORPORATION

BY: [Signature]
 M. Kathleen McKinney Stasey

FIDELITY AND DEPOSIT COMPANY OF MARYLAND

BY: [Signature]
 Kevin W. Birch - Attorney-in-Fact

Power of Attorney
FIDELITY AND DEPOSIT COMPANY OF MARYLAND

HOME OFFICE, BALTIMORE, MD

KNOW ALL MEN BY THESE PRESENTS: That the FIDELITY AND DEPOSIT COMPANY OF MARYLAND, a corporation of the State of Maryland, by C. M. PECOT, JR., Vice-President, and C. W. ROBBINS, Assistant Secretary, in pursuance of authority granted by Article VI, Section 2, of the By-Laws of said Company, which are set forth on the reverse side hereof and are hereby certified to be in full force and effect on the date hereof, does hereby nominate, constitute and appoint William E. Frick, Jr., Steven E. Wolf, Anthony E. Ortman, Andrew M. Hatheway, Eric A. Schieferstein and Kevin W. Birch, all of Indianapolis, Indiana, EACH..... its true and lawful agent and Attorney-in-Fact, to make, execute, seal and deliver, for and on its behalf as surety, and as its act and deed: any and all bonds and undertakings.....

And the execution of such bonds or undertakings in pursuance of these presents, shall be as binding upon said Company, as fully and amply, to all intents and purposes, as if they had been duly executed and acknowledged by the regularly elected officers of the Company at its office in Baltimore, Md., in their own proper persons. This power of attorney revokes that issued on behalf of William E. Frick, Jr., etal, dated January 4, 1994.


The said Assistant Secretary does hereby certify that the extract set forth on the reverse side hereof is a true copy of Article VI, Section 2, of the By-Laws of said Company, and is now in force.

IN WITNESS WHEREOF, the said Vice-President and Assistant Secretary have hereunto subscribed their names and affixed the Corporate Seal of the said FIDELITY AND DEPOSIT COMPANY OF MARYLAND, this 27th.....day of June....., A.D. 1995



FIDELITY AND DEPOSIT COMPANY OF MARYLAND


Assistant Secretary

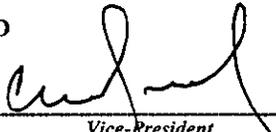By 
Vice-President


STATE OF MARYLAND
COUNTY OF BALTIMORE

ss:

On this 27th day of June....., A.D. 1995, before the subscriber, a Notary Public of the State of Maryland, duly commissioned and qualified, came C. M. PECOT, JR., Vice-President and C. W. ROBBINS, Assistant Secretary of the FIDELITY AND DEPOSIT COMPANY OF MARYLAND, to me personally known to be the individuals and officers described in and who executed the preceding instrument, and they each acknowledged the execution of the same, and being by me duly sworn, severally and each for himself depose and saith, that they are the said officers of the Company aforesaid, and that the seal affixed to the preceding instrument is the Corporate Seal of said Company, and that the said Corporate Seal and their signatures as such officers were duly affixed and subscribed to the said instrument by the authority and direction of the said Corporation.

IN TESTIMONY WHEREOF, I have hereunto set my hand and affixed my Official Seal the day and year first above written.

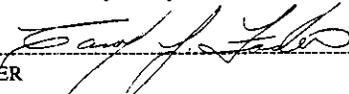


CAROL J. FADER Notary Public
My Commission Expires August 1, 1996


CERTIFICATE

I, the undersigned, Assistant Secretary of the FIDELITY AND DEPOSIT COMPANY OF MARYLAND, do hereby certify that the original Power of Attorney of which the foregoing is a full, true and correct copy, is in full force and effect on the date of this certificate; and I do further certify that the Vice-President who executed the said Power of Attorney was one of the additional Vice-Presidents specially authorized by the Board of Directors to appoint any Attorney-in-Fact as provided in Article VI, Section 2, of the By-Laws of the FIDELITY AND DEPOSIT COMPANY OF MARYLAND.

This Certificate may be signed by facsimile under and by authority of the following resolution of the Board of Directors of the FIDELITY AND DEPOSIT COMPANY OF MARYLAND at a meeting duly called and held on the 16th day of July, 1969.

RESOLVED: "That the facsimile or mechanically reproduced signature of any Assistant Secretary of the Company, whether made heretofore or hereafter, wherever appearing upon a certified copy of any power of attorney issued by the Company, shall be valid and binding upon the Company with the same force and effect as though manually affixed."

IN TESTIMONY WHEREOF, I have hereunto subscribed my name and affixed the corporate seal of the said Company, this 30th day of November....., 1995

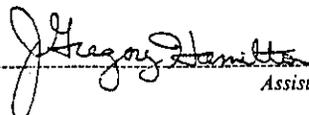
Assistant Secretary

L1428c-044

EXTRACT FROM BY-LAWS OF FIDELITY AND DEPOSIT COMPANY OF MARYLAND

“Article VI, Section 2. The Chairman of the Board, or the President, or any Executive Vice-President, or any of the Senior Vice-Presidents or Vice-Presidents specially authorized so to do by the Board of Directors or by the Executive Committee, shall have power, by and with the concurrence of the Secretary or any one of the Assistant Secretaries, to appoint Resident Vice-Presidents, Assistant Vice-Presidents and Attorneys-in-Fact as the business of the Company may require, or to authorize any person or persons to execute on behalf of the Company any bonds, undertakings, recognizances, stipulations, policies, contracts, agreements, deeds, and releases and assignments of judgements, decrees, mortgages and instruments in the nature of mortgages, . . . and to affix the seal of the Company thereto.”

CERTIFICATE OF COMPLETION AND COMPLIANCE


TO: HAMILTON COUNTY SURVEYOR

RE: MERRIMAC SECTION 2

I hereby certify that:

- 1.) I am a Registered Professional Engineer in the State of Indiana,
- 2.) I am familiar with the plans and specifications for the above referenced subdivision,
- 3.) I have personally observed and supervised the completion of the Drainage Facilities for the above referenced subdivision, and
- 4.) To the best of my knowledge, information and belief, the Drainage Facilities within the subdivision has been installed and completed in conformity with all plans and specifications.

Signature: _____

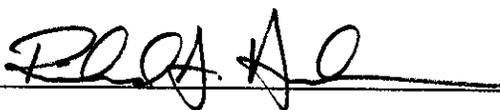

Date: 10/2/96

Typed or Printed Name: Richard A. Henderson

Business Address: Schneider Engineering Corp.


3020 North Post Road, Indianapolis, IN 46226

Telephone: 898-8282

Indiana Registration Number

900081

SEAL

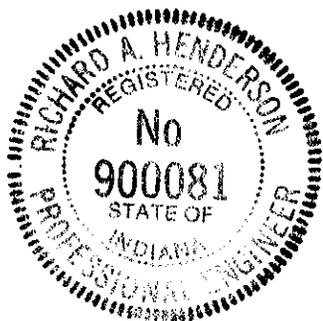



SURVEYOR'S OFFICE
Hamilton County

Kenton C. Ward, Surveyor

Phone (317) 776-8495

Fax (317) 776-9628

Suite 146

One Hamilton County Square

Noblesville, Indiana 46060-2230

To: Hamilton County Drainage Board

January 7, 1997

Re: Merrimac Drain - Sec. 2 Arm

Attached are as-builts, certificate of completion & compliance, and other information for Merrimac Sec. 2. An inspection of the drainage facilities for this section has been made and the facilities were found to be complete and acceptable.

During construction, changes were made to the drain which will alter the plans submitted with my report for this drain dated August 26, 1996. The changes are as follows:

- Structure 128-127 12" RCP shortened from 45' feet to 41" feet.
- Structure 126-125 12" RCP shortened from 120' feet to 118' feet.
- Structure 124-123 15" RCP shortened from 28' feet to 27' feet.
- Structure 122-119 30" RCP lengthened from 150' feet to 153' feet.
- Structure 119-120 12" RCP shortened from 100' feet to 99' feet.
- Structure 130-129 15" RCP lengthened from 20' feet to 21' feet.
- Structure 139-134 12" RCP shortened from 195' feet to 189' feet.
- Structure 133-132 18" RCP lengthened from 20' feet to 21' feet.
- Structure 129-122 24" RCP was incorrectly reported at 320' feet. The correct length is 230' feet.
- Structure 132-135 15" RCP was lengthened from 120' feet to 123' feet.
- Structure 135-136 12" RCP was lengthened from 192' feet to 196' feet.
- Structure EX-101 36" RCP was lengthened from 152' feet to 155' feet.
- Structure 101-102 36" RCP was shortened from 180' feet to 179' feet.
- Structure 102-103 12" RCP was shortened from 110' feet to 107' feet.
- Structure EX-140 15" RCP was shortened from 161' feet to 160' feet.
- Structure 141-142 12" RCP was shortened from 85' feet to 37' feet.
- Structure 112-118 12" RCP was shortened from 105' feet to 99' feet.
- Structure 135-137 12" RCP was shortened from 235' feet to 232' feet.
- Structure 137-138 12" RCP was shortened from 120' feet to 116' feet.
- Structure 116-114 15" RCP was lengthened from 70' feet to 71' feet.
- Structure 108-102 30" RCP was lengthened from 161' feet to 150' feet.

Structure 102-104 18" RCP was lengthened from 161' feet to 163' feet.
Structure 104-106 12" RCP was shortened from 70' feet to 69' feet.


The length of the drain due to the changes described above is now **12,657 feet**.

The non-enforcement was approved by the Board at its meeting on June 3, 1996 and recorded under instrument # 9609641978.

The bond or letter of credit from Fidelity and Deposit Company , number 30695807 form Storm Sewer and Sub Surface drainage, and 30695808 for eroison control, dated November 30, 1995, in the amount of \$176,564.00 and \$35,893.00, has expired.

I recommend the Board approve the drains construction as complete and acceptable.

Sincerely,

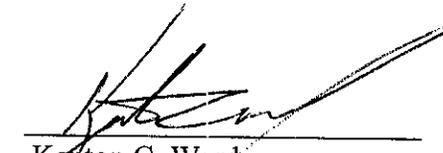

Keifton C. Ward,
Hamilton County Surveyor

KCW/slm

SEC. 15-18N-3E

(CONSTRUCTION PLANS)

MERRIMAC SECTION 2

WESTFIELD, INDIANA

WASHINGTON TOWNSHIP HAMILTON COUNTY, INDIANA

DEVELOPER:



MERRIMAC CORP.

254 EAST CARMEL DRIVE
CARMEL, INDIANA 46032
(317) 844-5111

Engineer:

SCHNEIDER ENGINEERING CORP.


3020 NORTH POST ROAD
INDIANAPOLIS, INDIANA 46226
(317) 898-8282 FAX (317) 899-8010

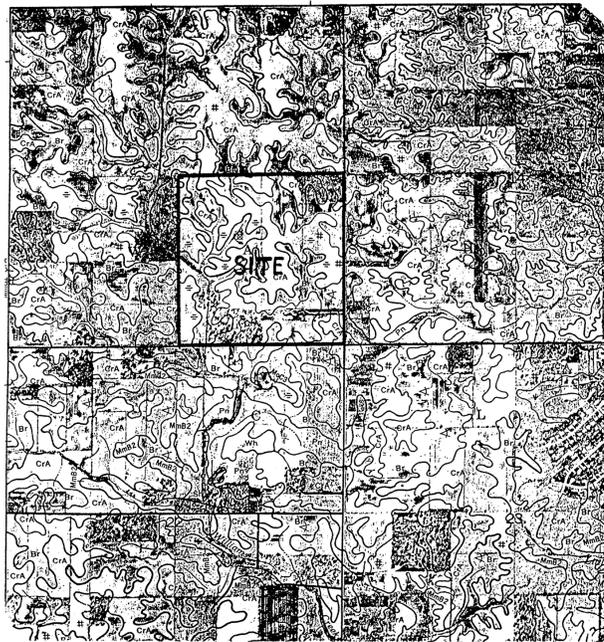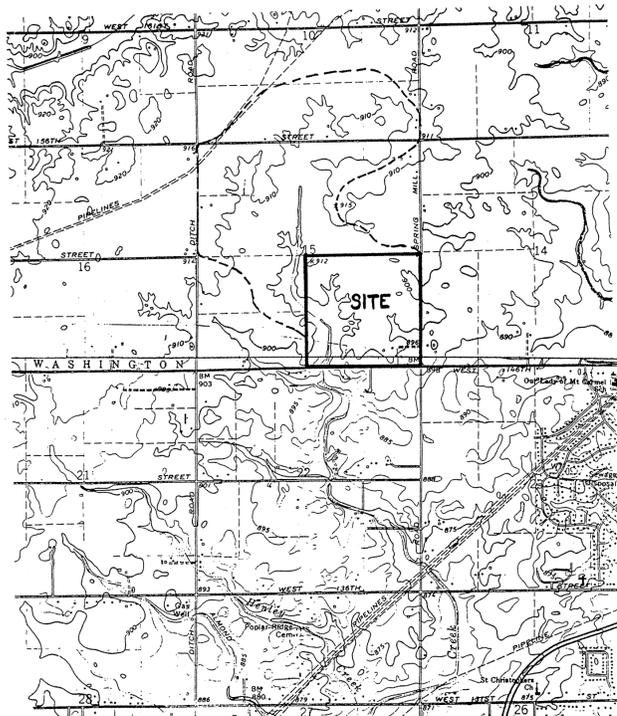

AREA MAP
NOT TO SCALE

SOILS MAP
NOT TO SCALE

SOILS LEGEND:
FA Fox loam, 0-2% slopes
Fb2 Fox loam, 2-5% slopes, eroded
Hf Heavy silt loam, 18 to 50% slopes
Mm Miami silt loam, 0-2% slopes
Mm2 Miami silt loam, 2-5% slopes, eroded
Mm3 Miami silt loam, 12-18% slopes, eroded
Mc2 Miami clay loam, 6-12% slopes, severely eroded
Mc3 Miami clay loam, 12-18% slopes
Pt Pits
Oa2 Oakley silt loam, 2-5% slopes, eroded
Sh Shale silt loam
St Silt loam
Ww Westland silty clay loam

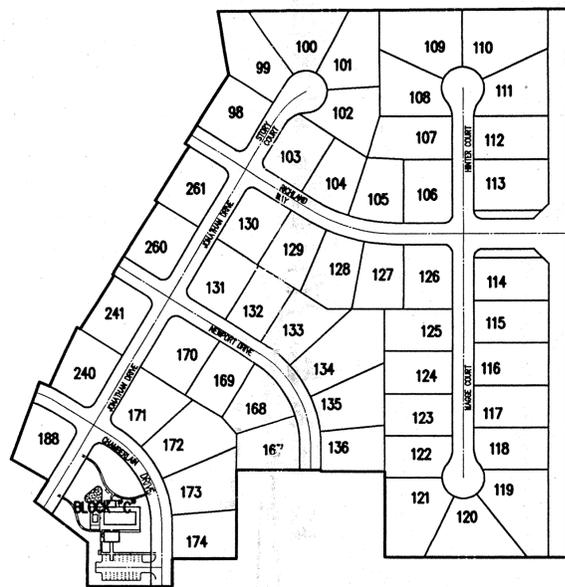

SITE MAP
SCALE: 1"=200'

| INDEX | |
|-----------|-------------------------------------|
| SHEET No. | DESCRIPTION |
| S-1 | TITLE SHEET |
| S-2-3 | DEVELOPMENT PLAN |
| S-4-5 | EROSION CONTROL PLAN |
| S-6 | ENTRANCE PLAN |
| S-7-10 | STREET PLANS |
| S-11 | CUL-DE-SAC & INTERSECTION DETAILS |
| S-12-16 | SANITARY SEWER PLANS |
| S-17-20 | STORM SEWER PLANS |
| S-21-21A | WATER DISTRIBUTION SYSTEM |
| S-22 | WATER DISTRIBUTION DETAILS & SPECS. |
| S-23-24 | GENERAL DETAILS |
| S-25 | SPECIFICATIONS |
| S-26 | COMMUNITY CENTER |
| L101-102 | LANDSCAPING PLANS |

STORM SEWER
RECORD DRAWING

The information was gathered for this project by the engineer and is based on the records of the GIS.

Entry Date: 2-10-04

Entered by: JDH



Schneider Engineering Corporation


3020 North Post Road
Indianapolis, Indiana
46226-0068
317-898-8282
317-899-8010 Fax

Engineering Surveying GIS • LIS Geology
FILED
OCT 04 1996
OFFICE OF HAMILTON COUNTY SURVEYOR

A Partnered Entity with Bohlen, Meyer, Gibson & Associates, Incorporated

CERTIFIED BY: RICHARD HENDERSON

PRINTED
SEP 11 1996
SCHNEIDER ENGINEERING CORP.

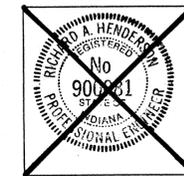

PROJECT MANAGER: DKS
CHECKED BY: _____ DATE CHECKED: _____

(JOB No. _____)
1045.02

SHEET S-1
OF 26

LEGEND

- Existing Storm Sewer
- New Storm Sewer
- Existing Sanitary Sewer
- New Sanitary Sewer
- Existing Contour
- Existing Elevation
- New Pavement Elevation
- All Other Finish Elevations
- Corrected Elevations
- Storm Structure Number
- Sanitary Structure Number
- Flow Arrow
- Denotes Elevation
- Approximate Pad Size
- Subsurface Drain w/4" Lateral Connection
- Swale (E)
- Swale Elevation (Flow Line)


ASSUMED NORTH SCALE: 1"=50'

FOR CONTINUATION SEE SHEET S-3

FOR CONTINUATION SEE SHEET S-3

FOR CONTINUATION SEE SHEET S-12

COMMON AREA
BLOCK "C"

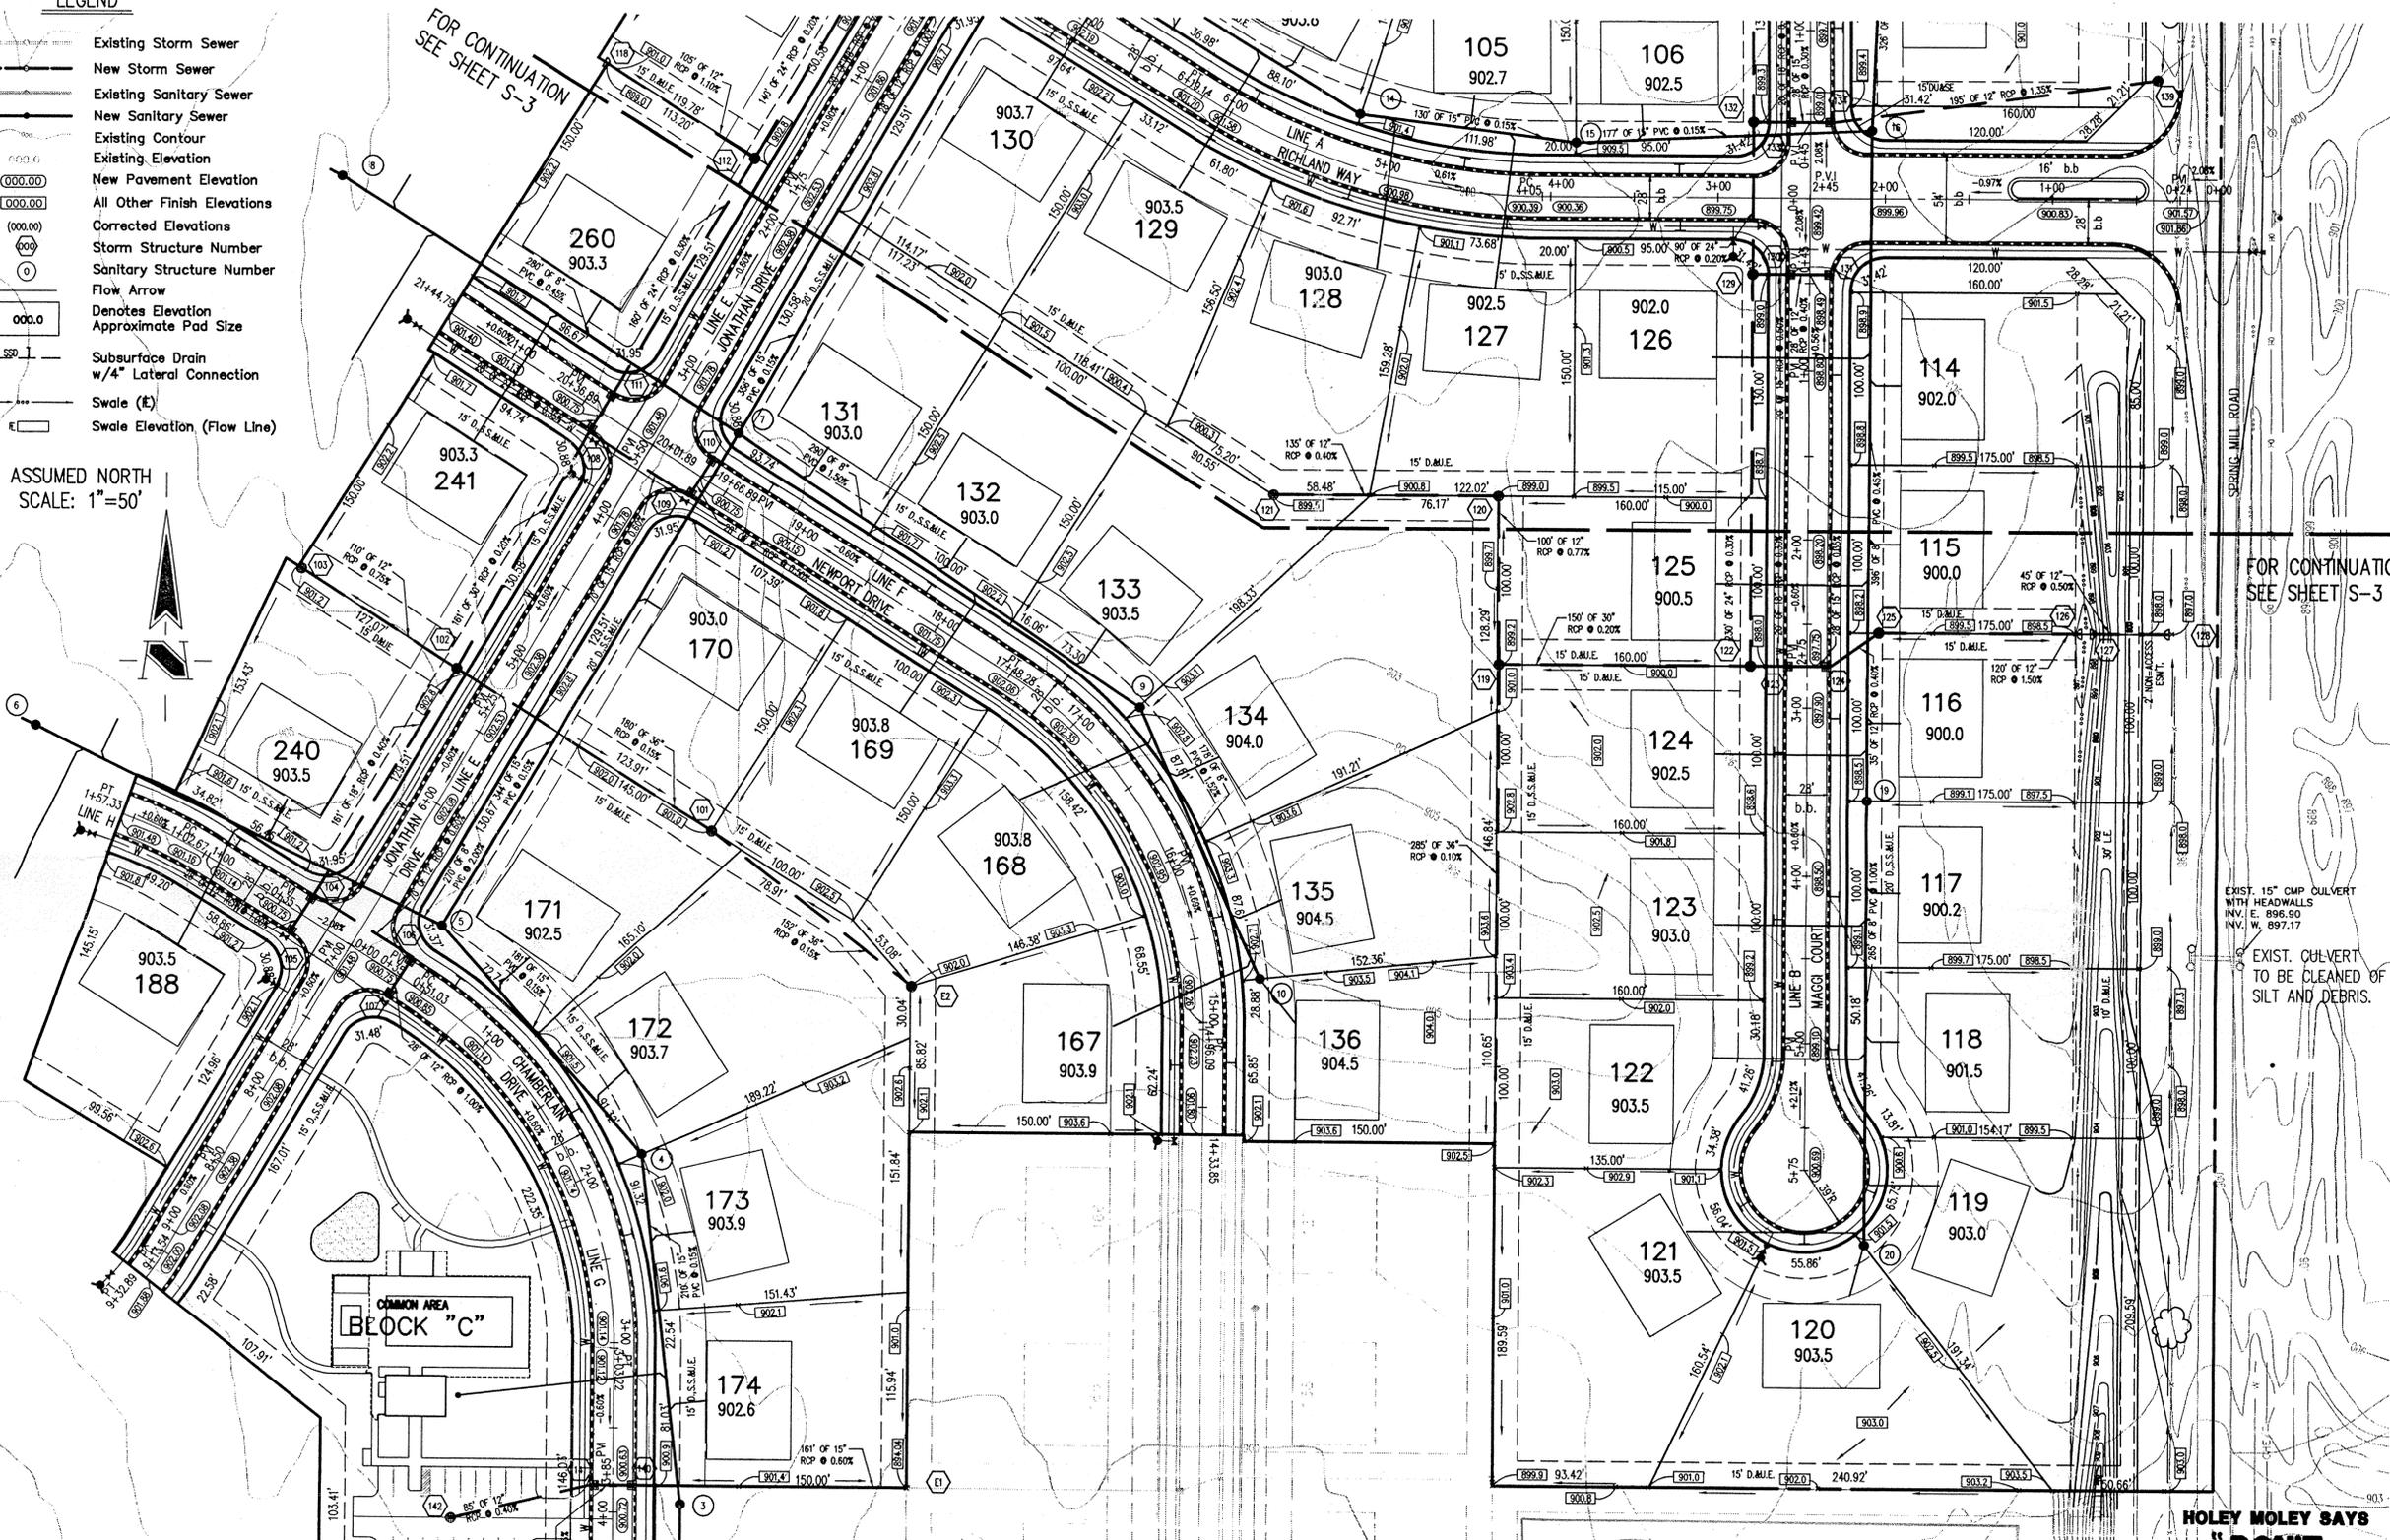

- GENERAL NOTES:**
1. ALL GRADES AT BOUNDARY SHALL MEET EXISTING GRADES.
 2. IT SHALL BE THE RESPONSIBILITY OF EACH SUBCONTRACTOR TO VERIFY ALL EXISTING UTILITIES AND CONDITIONS PERTAINING TO HIS PHASE OF WORK. IT SHALL ALSO BE THE SUBCONTRACTOR'S RESPONSIBILITY TO CONTACT THE OWNERS OF THE VARIOUS UTILITIES FOR PROPER STAKE LOCATION OF EACH UTILITY BEFORE WORK IS STARTED. THE SUBCONTRACTOR SHALL NOTIFY IN WRITING THE OWNER OR THE ENGINEER OF ANY CHANGES, OMISSIONS OR ERRORS FOUND ON THESE PLANS OR IN FIELD BEFORE WORK IS STARTED OR RESUMED.
 3. STANDARD SPECIFICATIONS FOR WESTFIELD, INDIANA SHALL APPLY FOR ALL SANITARY SEWERS AND STORM SEWERS.
 4. ANY PART OF THE SANITARY OR STORM SEWER TRENCHES RUNNING UNDER PAVED AREAS TO BE BACKFILLED WITH GRANULAR MATERIAL.
 5. THE SIZE AND LOCATION OF EXISTING UTILITIES SHOWN ARE PER INFORMATION PROVIDED BY THE RESPECTIVE UTILITY COMPANIES. ALL UTILITY COMPANIES SHOULD BE NOTIFIED PRIOR TO ANY EXCAVATION FOR FIELD LOCATION OF SERVICES.
 6. SERVICE WALKS SHALL BE NON-REINFORCED CONCRETE 4" THICK AND 4' IN WIDTH. CURB RAMP FOR THE DISABLED SHALL BE REQUIRED WITHIN THE PUBLIC RIGHT OF WAY AND SHALL CONFORM WITH CURRENT SPECIFICATIONS ESTABLISHED BY THE AMERICAN DISABILITIES ACT (ADA), SECTION (4.7) "CURB RAMP".
 7. EXPANSION JOINTS ARE TO BE PLACED AT ALL WALK INTERSECTIONS AND BETWEEN WALKS AND PLATFORMS. SIDEWALK SPACES ARE TO BE EQUALLY SPACED BETWEEN EXPANSION JOINTS. CONTRACTION JOINTS AND PERPENDICULAR SIDEWALKS AT 5' INTERVALS OR LESS WITH A CONTRACTION JOINT EVERY 20' OR LESS.
 8. 4" CONCRETE SERVICE WALK ACROSS FRONTAGE OF EACH LOT TO BE CONSTRUCTED BY OTHERS.
 9. TEMPORARY TRAFFIC CONTROL DURING CONSTRUCTION TO CONFORM TO APPLICABLE LOCAL AND STATE STANDARDS.
 10. ALL CONSTRUCTION ACTIVITY ON THIS SITE TO BE PERFORMED IN COMPLIANCE WITH APPLICABLE O.S.H.A. STANDARDS FOR WORKER SAFETY.
 11. CONTRACTOR SHALL MINIMIZE DAMAGE TO EXISTING TREES.
 12. REMOVE AND BACKFILL ALL AREAS WHERE ANY FIELD TILE CROSSES PROPOSED HOUSE PADS. ALL FIELD TILES INTERCEPTED TO BE PERPETUATED INTO STORM SEWER SYSTEM OR LAKE.
- BENCH MARK**
U.S.G.S. 93 RHP (1951)
BRONZE TABLE SET IN CONCRETE POST, LOCATED ON THE SOUTH SIDE OF 146TH STREET, APPROX. 25' WEST OF THE CENTERLINE OF DITCH ROAD.
(ELEVATION = 903.373)

Revisions

FILED
OCT 04 1996
OFFICE OF HAMILTON COUNTY SURVEYOR

CERTIFIED BY: *[Signature]*
NOTARIES PUBLIC
ALL RIGHTS RESERVED
EXCEPT FOR USES EXPRESSLY PERMITTED IN WRITING, INFORMATION SHOWN OR INCLUDED IN THIS DOCUMENT IS SOLELY THE PROPERTY OF SCHNEIDER ENGINEERING CORPORATION.

Schneider Engineering Corporation
3020 North Post Road
Indianapolis, Indiana 46226-0668
317-898-8282
317-899-8010 Fax

Engineering
Surveying
GIS + LIS
Geology

A Partnered Entity with Bohlen, Meyer, Gibson & Associates, Incorporated

MERRIMAC SECTION

This information was gathered for input into the Hamilton County Geographical Information System. This document is considered an official record of the GIS.

Entry Date: 2-10-04
Entered by: JDI

HOLEY MOLEY SAYS
"DON'T DIG BLIND"

STORM SEWER RECORD DRAWING


1-800-382-5544
CALL TOLL FREE
1-800-428-5200
FOR CALLS OUTSIDE OF INDIANA
PER INDIANA STATE LAW IS-69-1991. IT IS AGAINST THE LAW TO EXCAVATE WITHOUT NOTIFYING THE UNDERGROUND LOCATION SERVICE TWO (2) WORKING DAYS BEFORE COMMENCING WORK.

MERRIMAC CORPORATION
MERRIMAC SECTION 2
WESTFIELD, INDIANA

DEVELOPMENT PLAN

| | | | |
|-------------------------|-------------|-------|---------|
| Date | Project No. | Drawn | Approv. |
| 7/28/95 | 1045.02 | DCC | |
| Computer Files | Sheet No. | | |
| J:\1045\DWG\S2\1045202V | S-2 | | |
| XREF: 10452PL | | | |
| XREF: 104510PO | | | |
| XREF: 104510S | | | |

Of 26

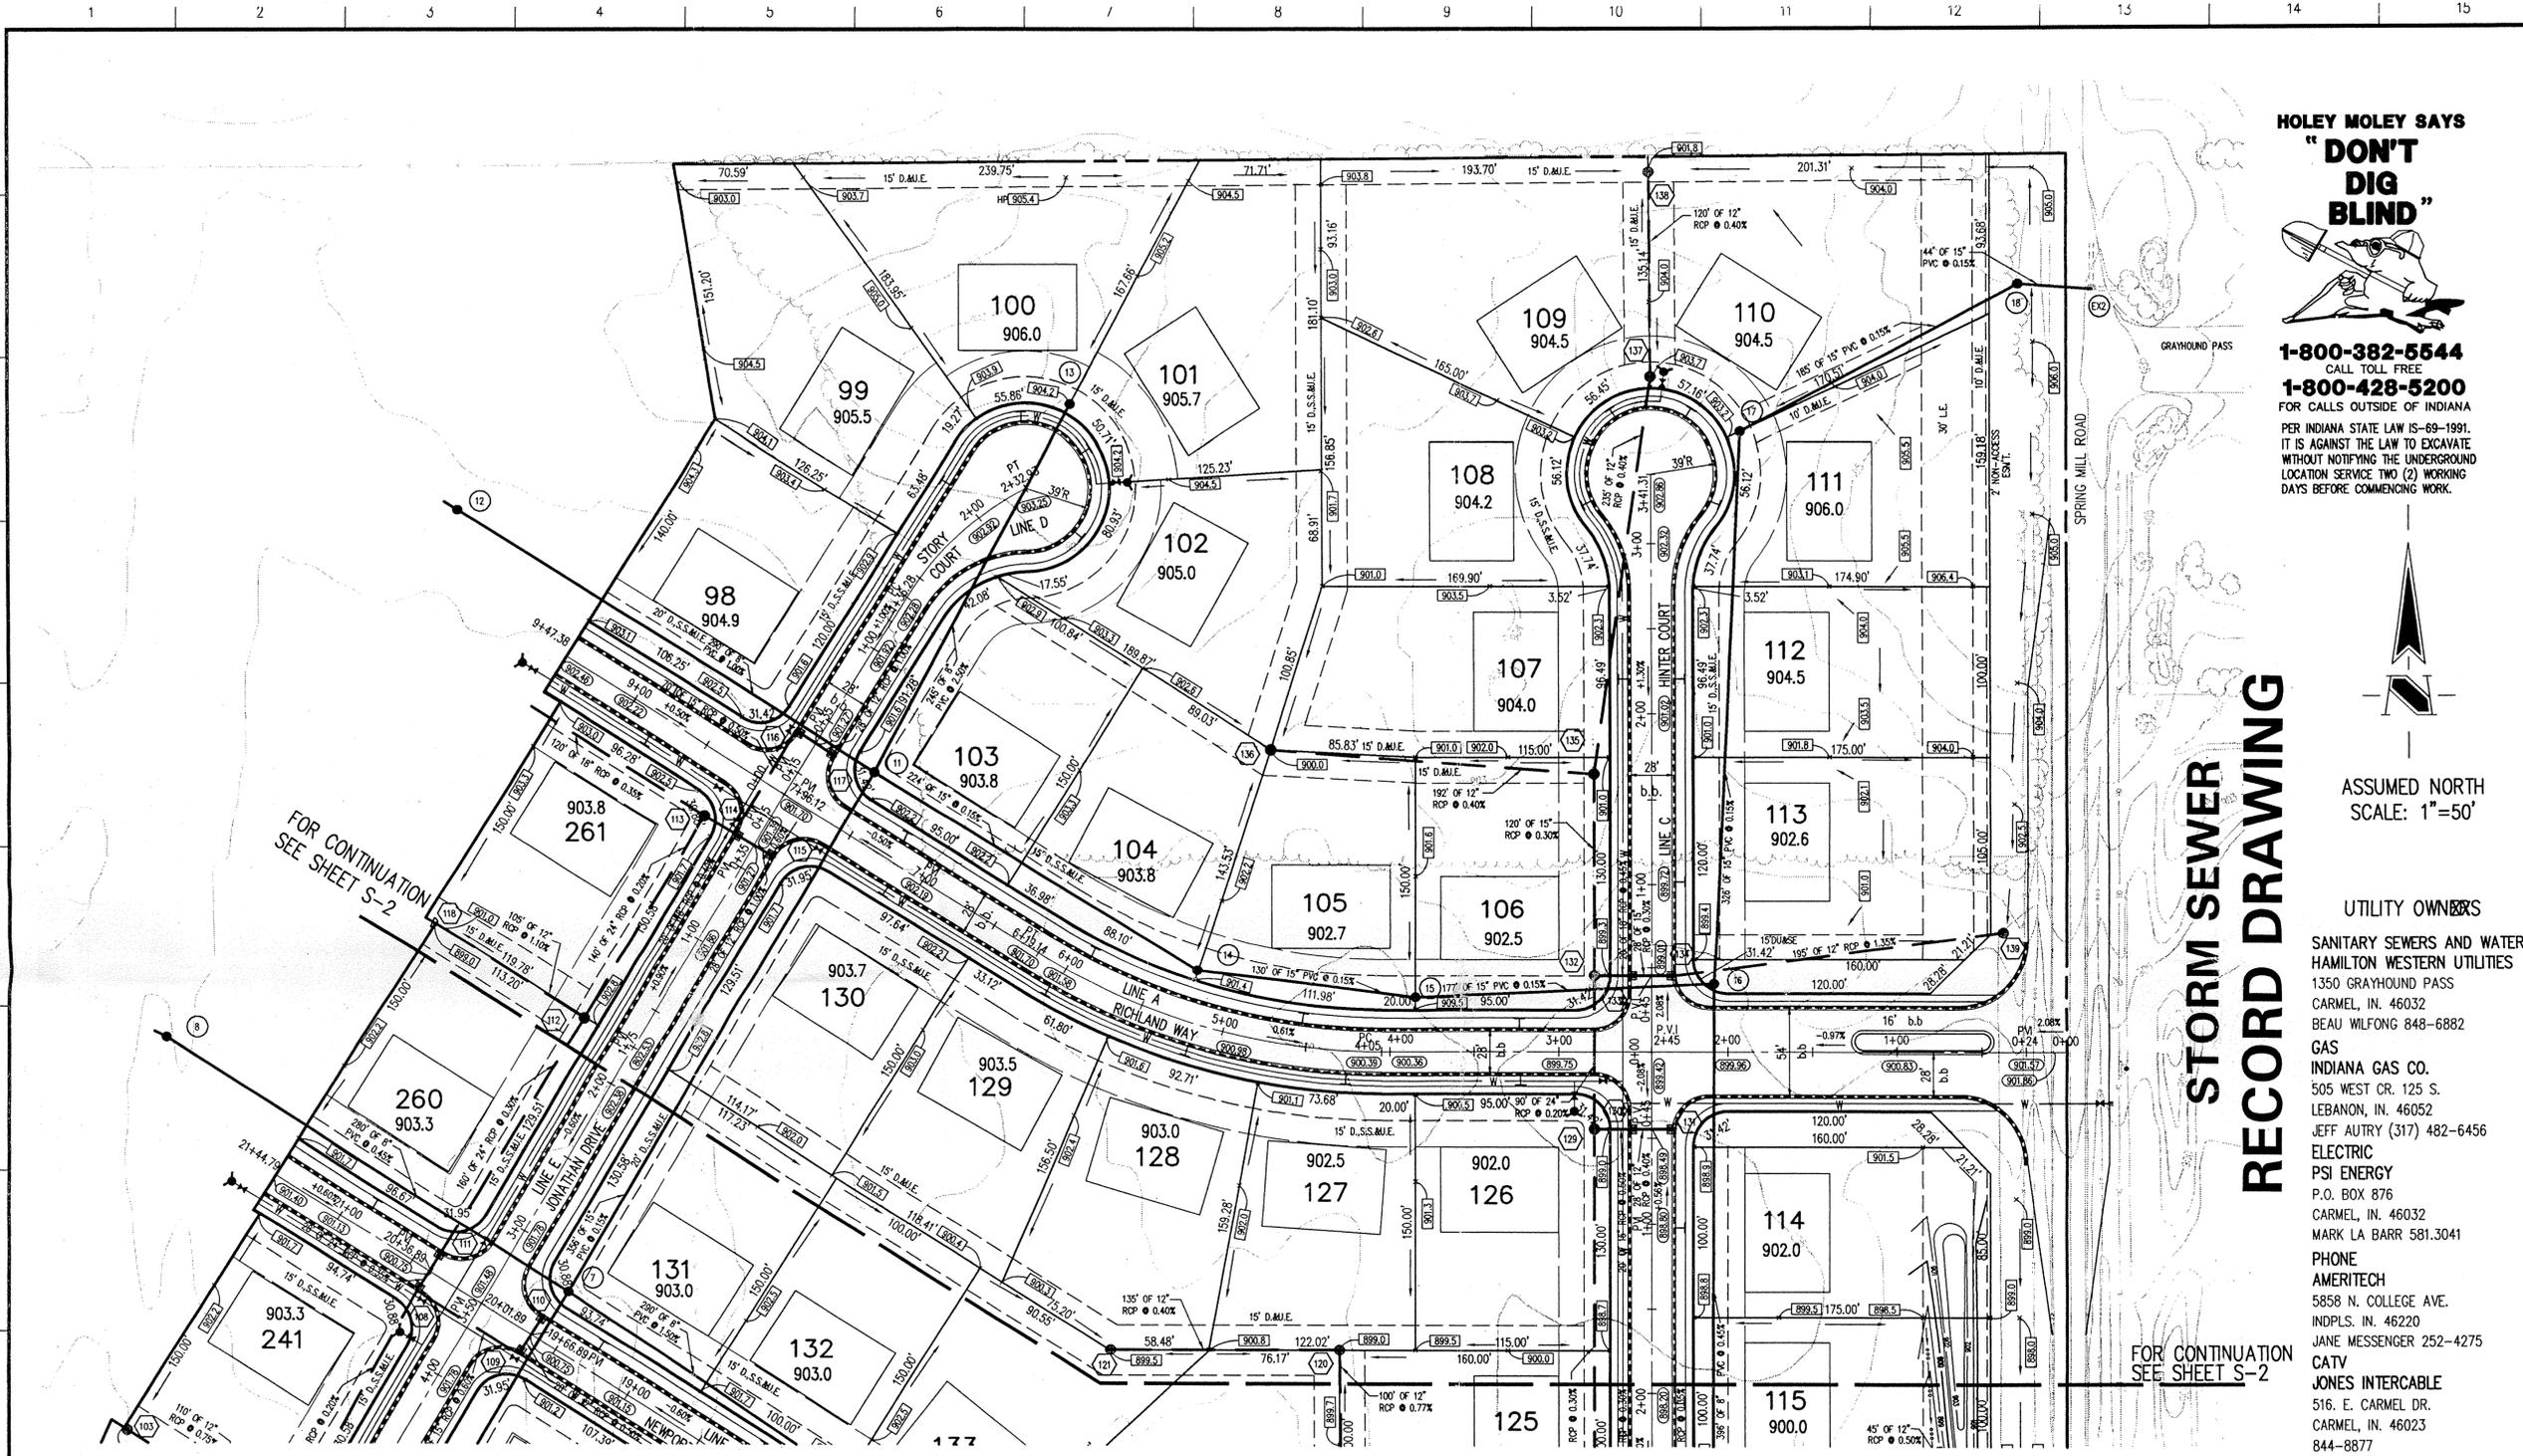

**HOLEY MOLEY SAYS
"DON'T
DIG
BLIND"**



1-800-382-5544
CALL TOLL FREE
1-800-428-5200
FOR CALLS OUTSIDE OF INDIANA
PER INDIANA STATE LAW IS-69-1991,
IT IS AGAINST THE LAW TO EXCAVATE
WITHOUT NOTIFYING THE UNDERGROUND
LOCATION SERVICE TWO (2) WORKING
DAYS BEFORE COMMENCING WORK.



ASSUMED NORTH
SCALE: 1"=50'

**STORM SEWER
RECORD DRAWING**

UTILITY OWNERS
SANITARY SEWERS AND WATER
HAMILTON WESTERN UTILITIES
1350 GRAYHOUND PASS
CARMEL, IN. 46032
BEAU WILFONG 848-6882
GAS
INDIANA GAS CO.
505 WEST CR. 125 S.
LEBANON, IN. 46052
JEFF AURY (317) 482-6456
ELECTRIC
PSI ENERGY
P.O. BOX 876
CARMEL, IN. 46032
MARK LA BARR 581.3041
PHONE
AMERITECH
5858 N. COLLEGE AVE.
INDPLS. IN. 46220
JANE MESSENGER 252-4275
CATV
JONES INTERCABLE
516 E. CARMEL DR.
CARMEL, IN. 46023
844-8877

- GENERAL NOTES:**
1. ALL GRADES AT BOUNDARY SHALL MEET EXISTING GRADES.
 2. IT SHALL BE THE RESPONSIBILITY OF EACH SUBCONTRACTOR TO VERIFY ALL EXISTING UTILITIES AND CONDITIONS PERTAINING TO HIS PHASE OF WORK. IT SHALL ALSO BE THE SUBCONTRACTOR'S RESPONSIBILITY TO CONTACT THE OWNERS OF THE VARIOUS UTILITIES FOR PROPER STAKE LOCATION OF EACH UTILITY BEFORE WORK IS STARTED. THE SUBCONTRACTOR SHALL NOTIFY IN WRITING THE OWNER OR THE ENGINEER OF ANY CHANGES, OMISSIONS, OR ERRORS FOUND ON THESE PLANS OR IN FIELD BEFORE WORK IS STARTED OR RESUMED.
 3. STANDARD SPECIFICATIONS FOR WESTFIELD INDIANA SHALL APPLY FOR ALL SANITARY SEWERS AND STORM SEWERS.
 4. ANY PART OF THE SANITARY OR STORM SEWER TRENCHES RUNNING UNDER PAVED AREAS TO BE BACKFILLED WITH GRANULAR MATERIAL.
 5. THE SIZE AND LOCATION OF EXISTING UTILITIES SHOWN ARE PER INFORMATION PROVIDED BY THE RESPECTIVE UTILITY COMPANIES. ALL UTILITY COMPANIES SHOULD BE NOTIFIED PRIOR TO ANY EXCAVATION FOR FIELD LOCATION OF SERVICES.
 6. SERVICE WALKS SHALL BE NON-REINFORCED CONCRETE 4" THICK AND 4" IN WIDTH. CURB RAMP FOR THE DISABLED SHALL BE REQUIRED WITHIN THE PUBLIC RIGHT OF WAY AND SHALL CONFORM WITH CURRENT SPECIFICATIONS ESTABLISHED BY THE AMERICAN DISABILITIES ACT (ADA), SECTION (4.7) "CURB RAMP".
 7. EXPANSION JOINTS ARE TO BE PLACED AT ALL WALK INTERSECTIONS AND BETWEEN WALKS AND PLATFORMS. SIDEWALK SPACES ARE TO BE EQUALLY SPACED BETWEEN EXPANSION JOINTS. CONTRACTION JOINTS AND PERPENDICULAR SIDEWALKS AT 5' INTERVALS OR LESS WITH A CONTRACTION JOINT EVERY 20' OR LESS.
 8. 4" CONCRETE SERVICE WALK ACROSS FRONTAGE OF EACH LOT TO BE CONSTRUCTED BY OTHERS.
 9. TEMPORARY TRAFFIC CONTROL DURING CONSTRUCTION TO CONFORM TO APPLICABLE LOCAL AND STATE STANDARDS.
 10. ALL CONSTRUCTION ACTIVITY ON THIS SITE TO BE PERFORMED IN COMPLIANCE WITH APPLICABLE O.S.H.A. STANDARDS FOR WORKER SAFETY.
 11. CONTRACTOR SHALL MINIMIZE DAMAGE TO EXISTING TREES.
 12. REMOVE AND BACKFILL ALL AREAS WHERE ANY FIELD TILE CROSSES PROPOSED HOUSE PADS. ALL FIELD TILES INTERCEPTED TO BE PERPETUATED INTO STORM SEWER SYSTEM OR LAKE.
- BENCH MARK**
U.S.G.S. 93 RHP (1951)
BRONZE TABLET SET IN CONCRETE POST, LOCATED ON THE SOUTH SIDE OF 146TH STREET, APPROX. 25' WEST OF THE CENTERLINE OF DITCH ROAD.
(ELEVATION = 903.373)

Revisions

Richmond Professional Engineer
900681
INDIANA PROFESSIONAL ENGINEER
OFFICE OF THE ENGINEER
CARMEL, IN. 46032

EXCEPT FOR USES EXPRESSLY PERMITTED IN WRITING, INFORMATION SHOWN OR INCLUDED IN THIS DOCUMENT IS SOLELY THE PROPERTY OF SCHNEIDER ENGINEERING CORPORATION.

Schneider Engineering Corporation
3020 North Post Road
Indianapolis, Indiana
46226-0068
317-898-8282
317-899-8010 Fax

Engineering
GIS + IIS
Geology

FILED
OCT 04 1996
OFFICE OF THE ENGINEER
HAMILTON COUNTY SUPERVISOR
A Partnered Entity with Bohlen, Meyer, Gibson & Associates, Incorporated

MERRIMAC CORPORATION
MERRIMAC SECTION 2
WESTFIELD, INDIANA

| Date | Project No. | Drawn | Approx. |
|---------|-------------|-------|---------|
| 7/28/95 | 1045.02 | DOC | |

Computer Files
J:\1045\DWG\104502\104522E
XREF: 104522P
XREF: 104520P
XREF: 104501B

Sheet No.
S-3

Of 26

STORM SEWER TABLE

| STR # | STA BASELINE | OFFSET LT/RT | TYPE | TC | INVERTS |
|-------|--------------|--------------|-------------|--------|------------------------------------|
| 142 | 4+04.25 'G' | 96.61 RT | PAVED AREA | 900.30 | 897.74 (E) |
| 141 | 3+85.00 'G' | 14.00 RT | CURB INLET | 900.63 | 897.40 (W), 897.25 (E) |
| 140 | 3+85.00 'G' | 14.00 LT | CURB INLET | 900.63 | 897.15 (E & W) |
| 139 | 4+70.86 'G' | 207.38 RT | REDRIVE | 901.00 | 898.00 |
| 138 | 5+17.35 'G' | 124 LT | REDRIVE | 901.80 | 899.30 |
| 137 | 3+97.55 'G' | 0.40 LT | MANHOLE | 903.60 | 898.00 (E & S) |
| 136 | 1+78.95 'G' | 225.74 LT | REDRIVE | 901.00 | 897.00 |
| 135 | 1+65.00 'G' | 34.25 LT | MANHOLE | 901.00 | 897.88 (N), 896.23 (W) |
| 134 | 0+45.00 'G' | 14.00 RT | CURB INLET | 899.01 | 895.81 (W), 895.79 (E) |
| 133 | 0+45.00 'G' | 14.00 LT | CURB INLET | 899.01 | 895.81 (W), 895.46 (E) |
| 132 | 0+45.00 'G' | 34.00 LT | MANHOLE | 899.50 | 894.87 (S), 895.12 (E), 895.62 (N) |
| 131 | 0+45.00 'G' | 0.00 LT | CURB INLET | 899.49 | 895.56 (W) |
| 130 | 0+45.00 'G' | 0.00 RT | CURB INLET | 898.49 | 895.45 (E), 895.20 (W) |
| 129 | 0+45.00 'G' | 34.00 RT | MANHOLE | 899.00 | 894.69 (S & N), 895.10 (E) |
| 128 | 2+55.00 'G' | 214.50 | END SECTION | 897.00 | |
| 127 | 2+55.00 'G' | 16.50 | END SECTION | 896.78 | |
| 126 | 2+55.00 'G' | 162.70 | END SECTION | 896.50 | |
| 125 | 2+55.00 'G' | 12.72 LT | MANHOLE | 898.50 | 894.70 (E & W) |
| 124 | 2+75.00 'G' | 14.00 LT | CURB INLET | 897.75 | 894.55 (NE), 894.30 (W) |
| 123 | 2+75.00 'G' | 14.00 RT | CURB INLET | 897.75 | 894.20 (NE), 894.06 (E) |
| 122 | 2+75.00 'G' | 34.00 RT | MANHOLE | 898.20 | 894.00 (E & N), 893.75 (W) |
| 121 | 1+75.00 'G' | 320.00 RT | REDRIVE | 899.50 | 896.51 (E) |
| 120 | 1+75.00 'G' | 185.00 RT | REDRIVE | 899.00 | 895.97 (W & S) |

STORM SEWER TABLE

| STR # | STA BASELINE | OFFSET LT/RT | TYPE | TC | INVERTS |
|-------|--------------|--------------|-------------|--------|---|
| 119 | 2+75.00 'B' | 185.00 RT | REDRIVE | 899.20 | 895.20 (N), 893.45 (E), 893.20 (S) |
| 118 | 1+71.34 'E' | 128.94 RT | END SECTION | 899.00 | |
| 117 | 0+35.00 'G' | 14.00 RT | CURB INLET | 901.27 | 898.55 (NW) |
| 116 | 0+35.00 'G' | 14.00 LT | CURB INLET | 901.27 | 898.27 (SE), 898.02 (SW) |
| 115 | 0+35.00 'G' | 14.00 LT | CURB INLET | 901.27 | 898.20 (NW) |
| 114 | 0+35.00 'G' | 14.00 RT | CURB INLET | 901.27 | 897.60 (SE), 897.42 (NW) |
| 113 | 0+35.00 'G' | 34.00 RT | MANHOLE | 902.00 | 897.34 (SE) |
| 112 | 1+75.00 'E' | 34.00 RT | MANHOLE | 902.00 | 897.81 (E & S), 897.78 (W) |
| 111 | 2+36.89 'G' | 14.00 RT | CURB INLET | 901.27 | 896.33 (N), 896.28 (S) |
| 110 | 1+46.89 'G' | 14.00 RT | CURB INLET | 900.75 | 895.55 (NW), 895.51 (SW) |
| 109 | 1+46.89 'G' | 14.00 LT | CURB INLET | 900.75 | 895.55 (NW), 895.65 (NW) |
| 108 | 2+36.89 'G' | 14.00 LT | CURB INLET | 901.27 | 897.23 (SE), 895.98 (SW), 896.23 (NE) |
| 107 | 0+35.00 'G' | 14.00 LT | CURB INLET | 901.27 | 898.00 (NE) |
| 106 | 0+35.00 'G' | 14.00 LT | CURB INLET | 901.27 | 897.72 (NW & S) |
| 105 | 0+35.00 'G' | 14.00 LT | CURB INLET | 901.27 | 897.60 (NE) |
| 104 | 0+35.00 'G' | 14.00 RT | CURB INLET | 901.27 | 897.32 (SE), 897.30 (SE), 896.80 (NE) |
| 103 | 0+35.00 'G' | 14.00 RT | REDRIVE | 901.20 | 898.23 (SW) |
| 102 | 5+25.00 'G' | 31.77 RT | MANHOLE | 902.90 | 897.41 (NW), 896.16 (SW), 895.66 (NE), 895.41 (S) |
| 101 | 5+25.00 'G' | 148.87 LT | REDRIVE | 901.00 | 895.14 (NW & SE) |
| E3 | | | REDRIVE | 902.00 | 894.91 (S & NW) |
| E2 | | | REDRIVE | 899.16 | 894.04 (N & S), 896.18 (W) |

SANITARY SEWER TABLE

| STR # | STA BASELINE | OFFSET LT/RT | TYPE | TC | INVERTS |
|-------|--------------|--------------|---------|--------|---------------------------------------|
| 1 | | | MANHOLE | 899.00 | 885.81 (NE & S) |
| 2 | | | MANHOLE | 899.50 | 895.98 (N & S) |
| 3 | 3+51.32 'G' | 4.00 LT | MANHOLE | 901.10 | 886.60 (N & S) |
| 4 | 1+99.72 'G' | 4.00 LT | MANHOLE | 902.20 | 887.01 (NW), 886.91 (S) |
| 5 | 0+39.40 'G' | 39.63 LT | MANHOLE | 901.80 | 887.28 (SE), 887.38 (NE), 887.78 (E) |
| 6 | 2+24.81 'G' | 24.37 RT | MANHOLE | 902.40 | 894.18 (SE) |
| 7 | 1+42.28 'G' | 33.47 RT | MANHOLE | 901.80 | 888.11 (NW), 888.11 (SW), 888.11 (SE) |
| 8 | 2+42.28 'G' | 33.47 RT | MANHOLE | 902.40 | 888.11 (NW), 888.11 (SW), 888.11 (SE) |
| 9 | 1+68.89 'G' | 35.36 RT | MANHOLE | 901.80 | 887.72 (SE), 887.51 (NW) |
| 10 | 1+52.24 'G' | 35.16 RT | MANHOLE | 901.80 | 887.72 (SE), 887.51 (NW) |
| 11 | 7+58.83 'A' | 39.38 RT | MANHOLE | 902.00 | 888.93 (SE), 888.93 (NW), 888.43 (S) |
| 12 | 1+48.83 'A' | 39.38 RT | MANHOLE | 902.75 | 891.30 (SE), 891.93 (NW) |
| 13 | 2+48.83 'A' | 39.38 RT | MANHOLE | 902.75 | 891.30 (SE), 891.93 (NW) |
| 14 | 5+25.00 'A' | 32.15 RT | MANHOLE | 900.60 | 888.87 (E & W) |
| 15 | 3+45.00 'A' | 32.15 RT | MANHOLE | 900.60 | 888.87 (E & W) |
| 16 | 0+40.11 'G' | | MANHOLE | 899.70 | 889.72 (S), 889.42 (NE), 889.32 (W) |
| 17 | 3+45.73 'G' | | MANHOLE | 900.30 | 890.00 (NE), 899.90 (W) |
| 18 | 4+51.28 'G' | | MANHOLE | 906.00 | 890.28 (E & S) |
| 19 | 3+35.00 'G' | | MANHOLE | 898.70 | 891.60 (SE), 891.50 (W) |
| 20 | 6+28.45 'G' | | MANHOLE | 901.60 | 894.25 (N) |
| E1 | | | MANHOLE | 897.50 | 885.60 (N), 855.49 (W), 885.99 (E) |
| E2 | | | MANHOLE | 906.00 | 890.35 (W), 890.53 (N), 890.59 (E) |


LEGEND

- Existing Storm Sewer
- New Storm Sewer
- Existing Sanitary Sewer
- New Sanitary Sewer
- Existing Contour
- Existing Elevation
- New Pavement Elevation
- All Other Finish Elevations
- Corrected Elevations
- Storm Structure Number
- Sanitary Structure Number
- Flow Arrow
- Denotes Elevation
- Approximate Pad Size
- Subsurface Drain w/4" Lateral Connection
- Swale (E)
- Swale Elevation (Flow Line)

This information was gathered for final information. Hamilton County Geographical Information System (GIS) was used to create this document. It is not a substitute for a field survey.

Entry Date: 2-10-96
Entered by: JMH

HAMILTON COUNTY
INDIANA
1823

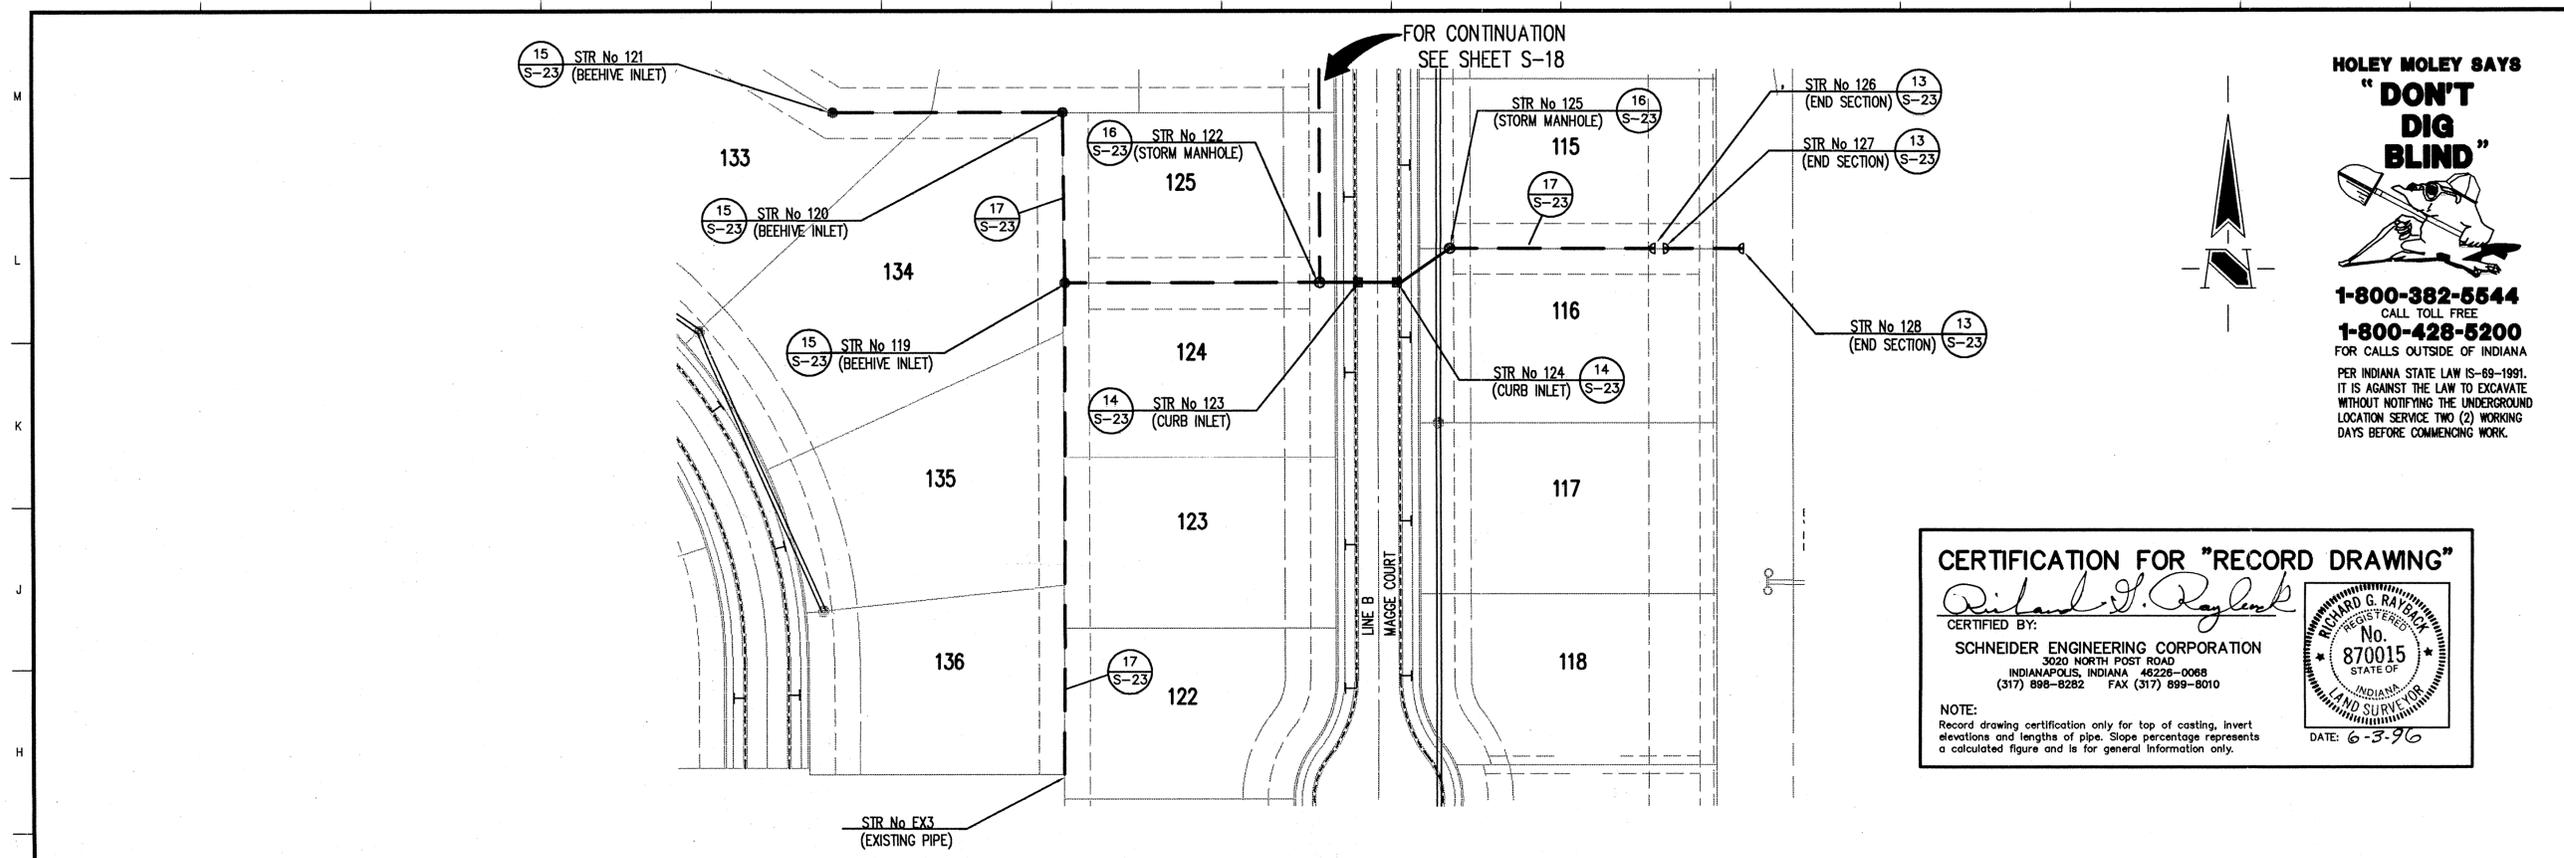

HOLEY MOLEY SAYS
"DON'T DIG BLIND"

1-800-382-5544
 CALL TOLL FREE
1-800-428-5200
 FOR CALLS OUTSIDE OF INDIANA
 PER INDIANA STATE LAW IS-89-1991, IT IS AGAINST THE LAW TO EXCAVATE WITHOUT NOTIFYING THE UNDERGROUND LOCATION SERVICE TWO (2) WORKING DAYS BEFORE COMMENCING WORK.

CERTIFICATION FOR "RECORD DRAWING"
 CERTIFIED BY: *Richard J. Raylent*
 SCHNEIDER ENGINEERING CORPORATION
 3020 NORTH POST ROAD
 INDIANAPOLIS, INDIANA 46226-0068
 (317) 898-8282 FAX (317) 899-8010
 NOTE: Record drawing certification only for top of casting, invert elevations and lengths of pipe. Slope percentage represents a calculated figure and is for general information only.
 DATE: 6-3-96

GENERAL NOTES:

- ALL CUTS ARE TAKEN FROM THE EXISTING GRADE TO THE PIPE INVERT.
- ALL STATIONING IS TAKEN FROM THE NEAREST DOWNSTREAM STRUCTURE.
- IT SHALL BE THE CONTRACTORS RESPONSIBILITY TO FIELD VERIFY ALL UTILITY LOCATIONS BEFORE CONSTRUCTION BEGINS.
- TEMPORARY TRAFFIC CONTROL DURING CONSTRUCTION TO CONFORM TO APPLICABLE LOCAL AND STATE STANDARDS.
- ALL CONSTRUCTION ACTIVITY ON THIS SITE TO BE PERFORMED IN COMPLIANCE WITH APPLICABLE O.S.H.A. STANDARDS FOR WORKER SAFETY.
- CONTRACTOR SHALL MINIMIZE DAMAGE TO EXISTING TREES.
- FOR LOCATION OF STORM SEWER STRUCTURES SEE DEVELOPMENT PLAN.
- FOR LOCATION OF EASEMENTS SEE RECORDED PLAT.


BENCH MARK:

BENCH MARK
 U.S.G.S. 93 RHP (1951)
 BRONZE TABLET SET IN CONCRETE POST, LOCATED ON THE SOUTH SIDE OF 146th STREET, APPROX. 25' WEST OF THE CENTERLINE OF DITCH ROAD.
 (ELEVATION = 903.373)

Revisions
 1) 29 MAY 96 - TJ - STORM SEWER RECORD DRAWING.

STORM SEWER PLAN

SCALE: 1"=50'

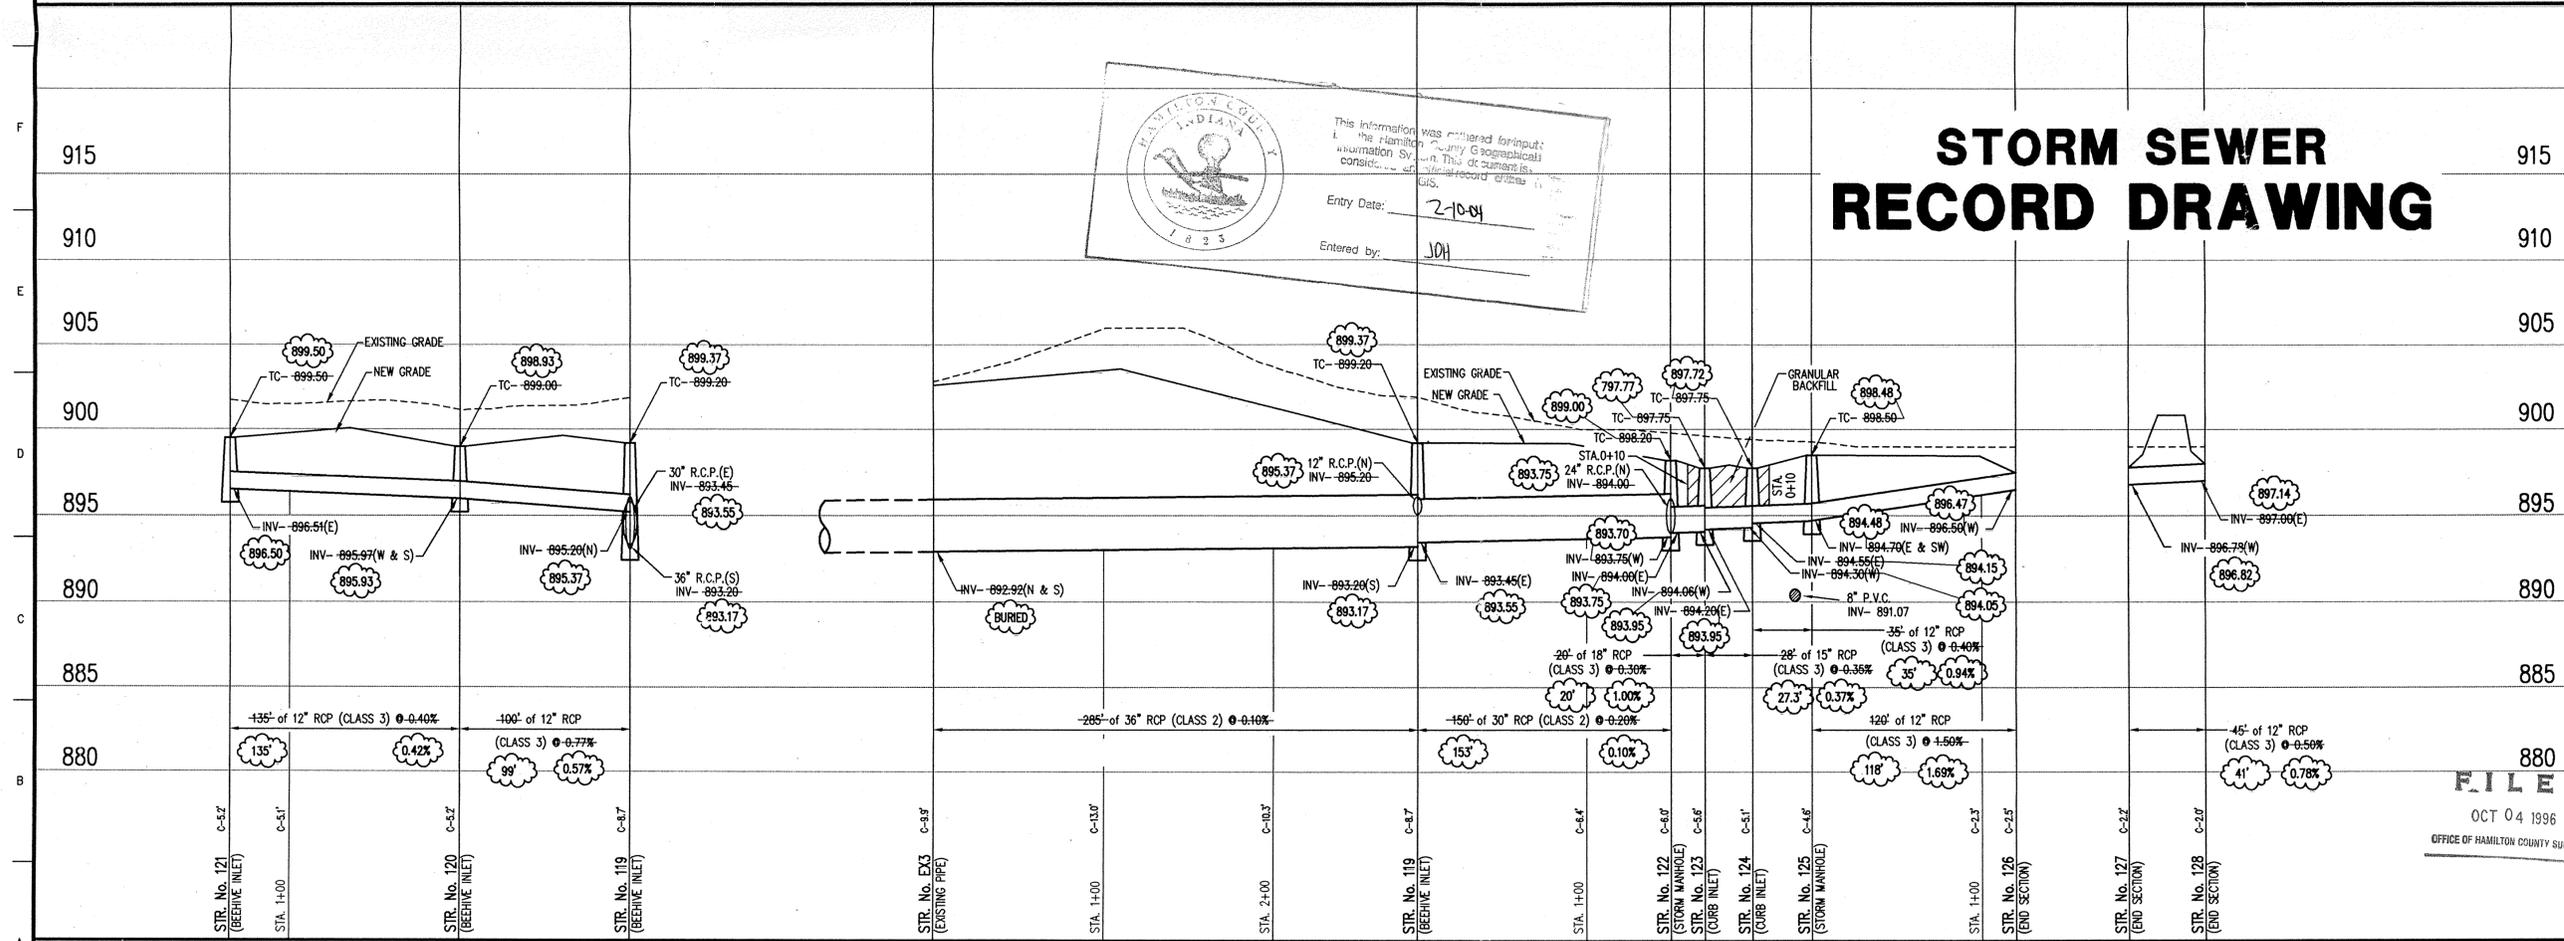

STORM SEWER PROFILE

SCALE: HORZ.: 1"=50'
 VERT.: 1"=5'

CERTIFIED BY: _____
 NOT PUBLISHED
 ALL RIGHTS RESERVED
 EXCEPT FOR USES EXPRESSLY PERMITTED IN WRITING, INFORMATION SHOWN OR INCLUDED IN THIS DOCUMENT IS SOLELY THE PROPERTY OF SCHNEIDER ENGINEERING CORPORATION.

Schneider Engineering Corporation
 3020 North Post Road
 Indianapolis, Indiana 46226-0068
 317-898-8282
 317-899-8010 Fax
 Engineering Surveying GIS • LIS Geology

A Partnered Entity with Bohlen, Meyer, Gibson & Associates, Incorporated




MERRIMAC CORP.
 MERRIMAC SECTION 2
 WESTFIELD, INDIANA

STORM SEWER PLAN

| | | | |
|----------|-------------|-------|--------|
| Date | Project No. | Drawn | Apprv. |
| 07/21/95 | 1045.02 | 866 | |

Computer Files
 104525M1
 XREF: 104502P1
 Sheet No.
S-17
 Of 26

U:\1045\UNGS\02104525M1.dwg May 29 06:16:15 1995

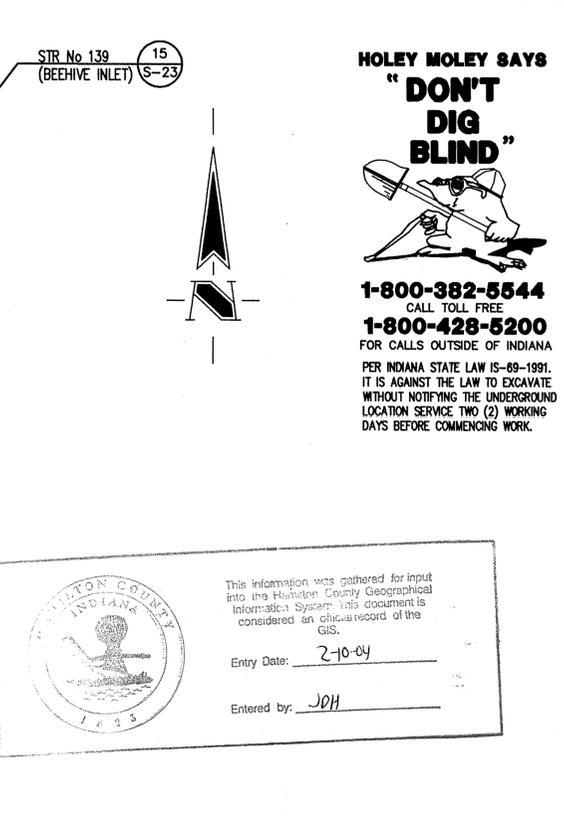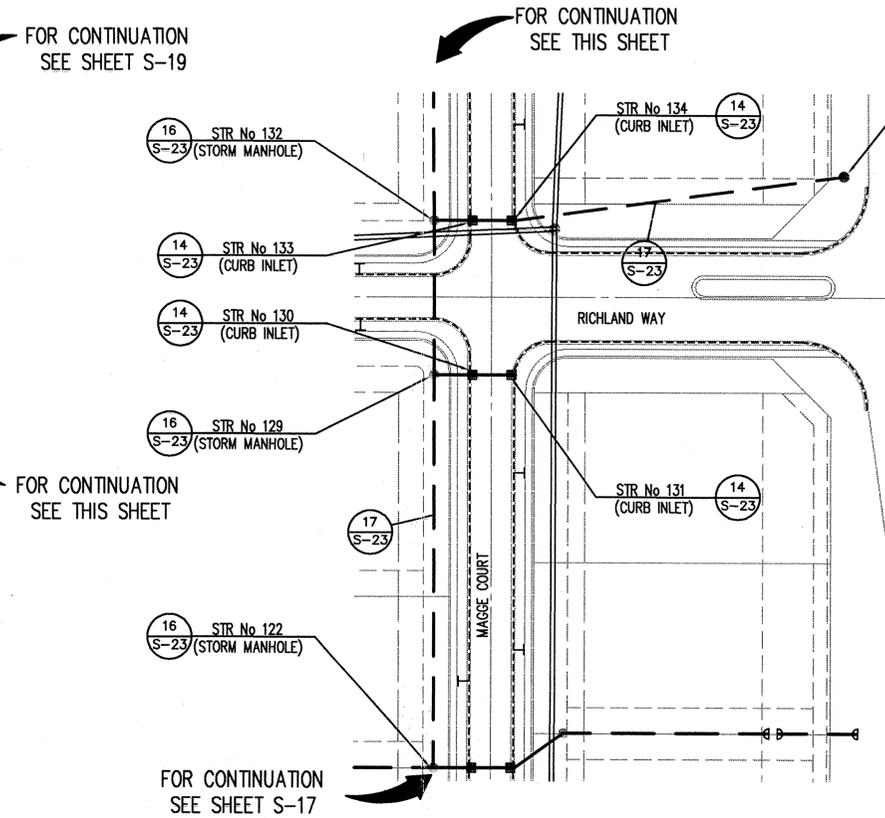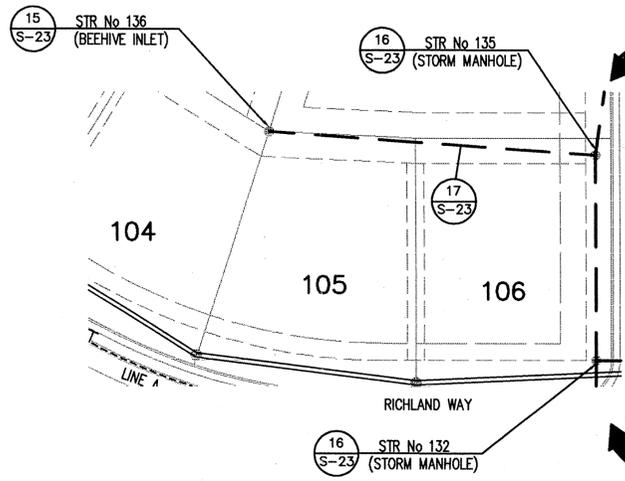

CERTIFICATION FOR "RECORD DRAWING"

CERTIFIED BY: *Richard G. Raab*

SCHNEIDER ENGINEERING CORPORATION
 3020 NORTH POST ROAD
 INDIANAPOLIS, INDIANA 46226-0068
 (317) 898-8282 FAX (317) 899-8010

NOTE:
 Record drawing certification only for top of casting, invert elevations and lengths of pipe. Slope percentage represents a calculated figure and is for general information only.

DATE: 6-3-96

HOLEY MOLEY SAYS "DON'T DIG BLIND"

1-800-382-5544
 CALL TOLL FREE
1-800-428-5200
 FOR CALLS OUTSIDE OF INDIANA

PER INDIANA STATE LAW IS-69-1991, IT IS AGAINST THE LAW TO EXCAVATE WITHOUT NOTIFYING THE UNDERGROUND LOCATION SERVICE TWO (2) WORKING DAYS BEFORE COMMENCING WORK.

This information was gathered for input into the Hamilton County Geographical Information System. This document is considered an official record of the GIS.

Entry Date: 2-10-04
 Entered by: JPH

GENERAL NOTES:

1. ALL CUTS ARE TAKEN FROM THE EXISTING GRADE TO THE PIPE INVERT.
2. ALL STATIONING IS TAKEN FROM THE NEAREST DOWNSTREAM STRUCTURE.
3. IT SHALL BE THE CONTRACTORS RESPONSIBILITY TO FIELD VERIFY ALL UTILITY LOCATIONS BEFORE CONSTRUCTION BEGINS.
4. TEMPORARY TRAFFIC CONTROL DURING CONSTRUCTION TO CONFORM TO APPLICABLE LOCAL AND STATE STANDARDS.
5. ALL CONSTRUCTION ACTIVITY ON THIS SITE TO BE PERFORMED IN COMPLIANCE WITH APPLICABLE O.S.H.A. STANDARDS FOR WORKER SAFETY.
6. CONTRACTOR SHALL MINIMIZE DAMAGE TO EXISTING TREES.
7. FOR LOCATION OF STORM SEWER STRUCTURES SEE DEVELOPMENT PLAN.
8. FOR LOCATION OF EASEMENTS SEE RECORDED PLAT.

BENCH MARK:


BENCH MARK
 U.S.G.S. 93 RHP (1951)
 BRONZE TABLE SET IN CONCRETE POST, LOCATED ON THE SOUTH SIDE OF 146th STREET, APPROX. 25' WEST OF THE CENTERLINE OF DITCH ROAD.
 (ELEVATION = 903.373)

Revisions
 1) 29 MAY 96 - TJ - STORM SEWER RECORD DRAWING.

STORM SEWER PLAN

SCALE: 1"=50'

STORM SEWER RECORD DRAWING

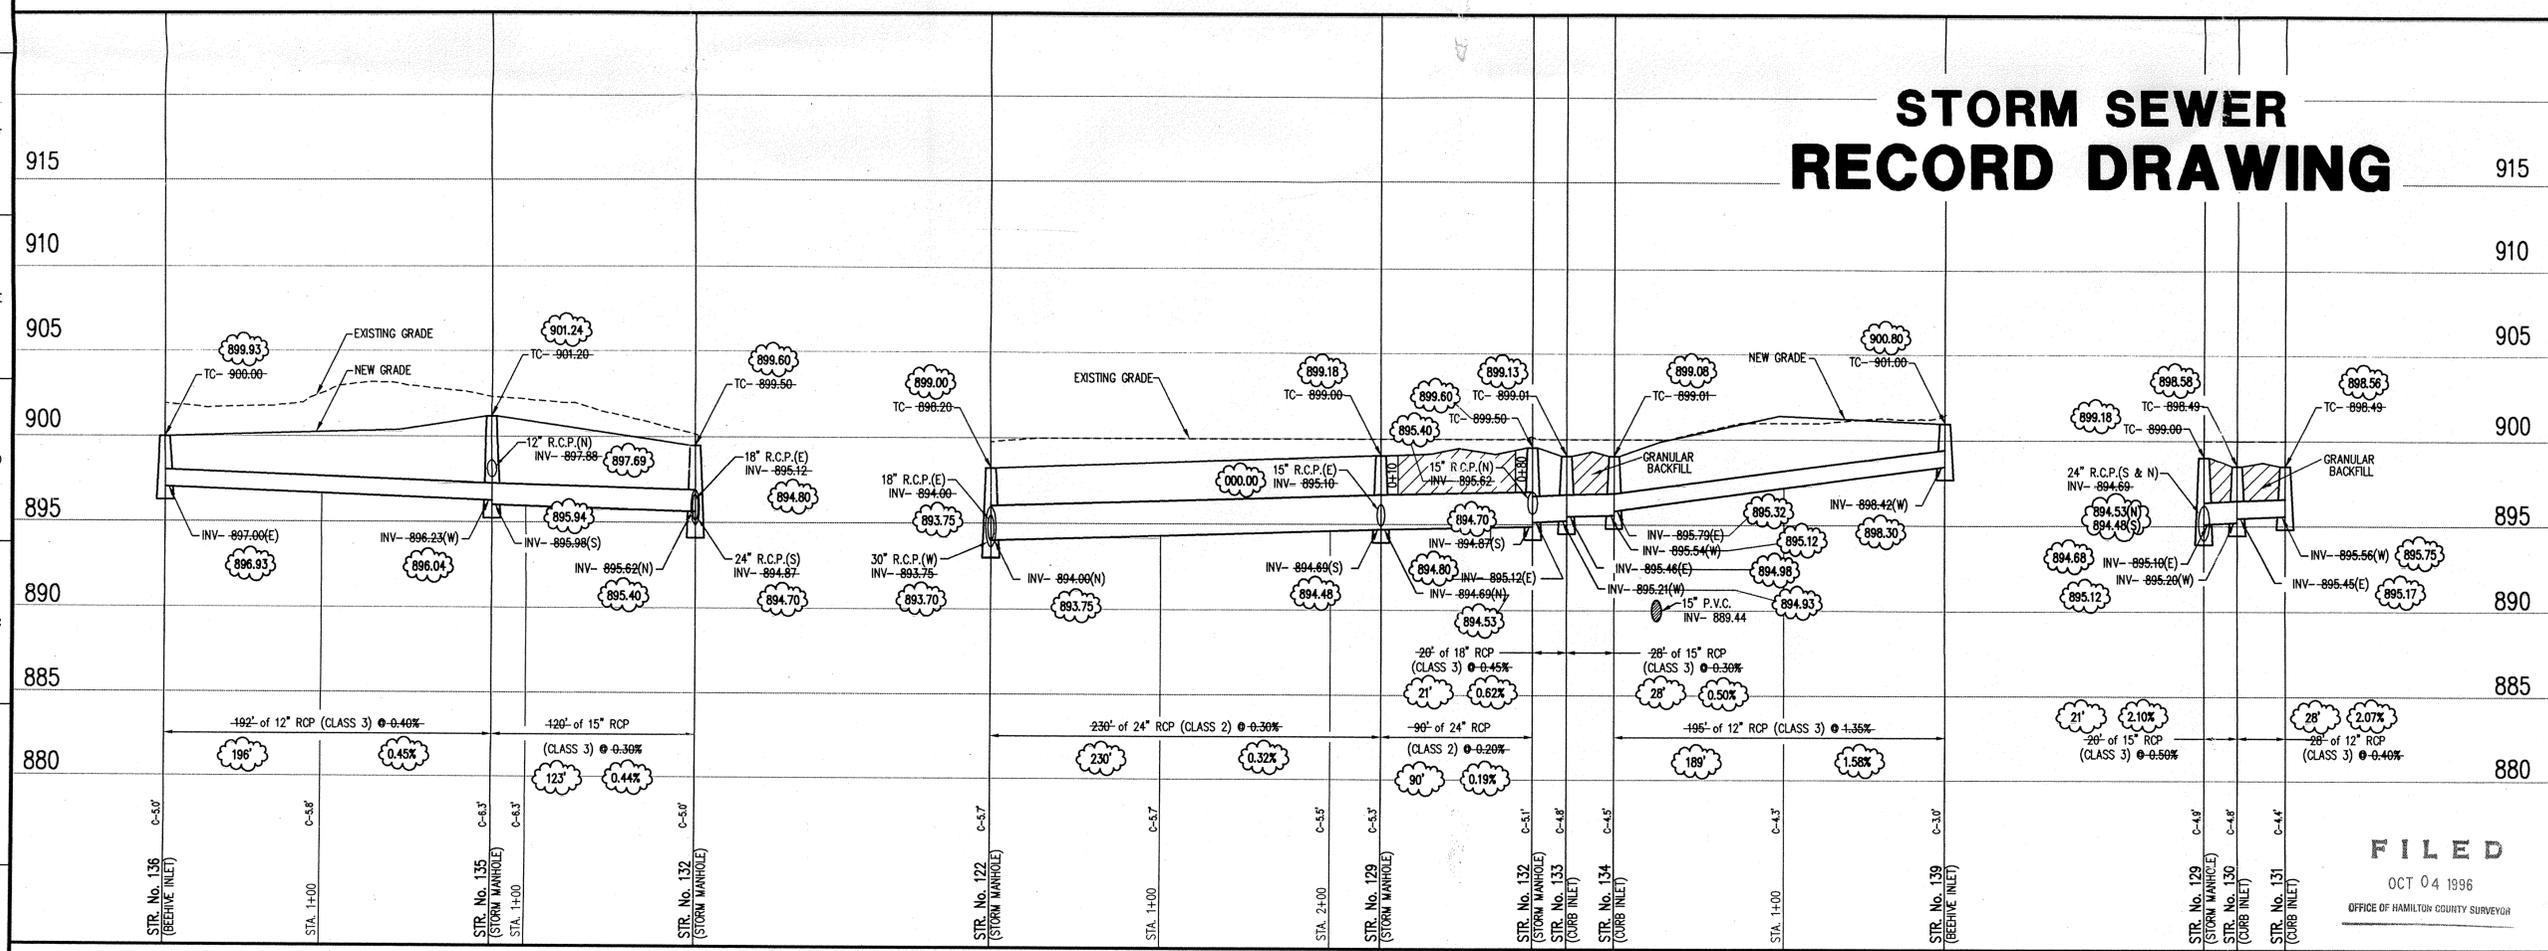

STORM SEWER PROFILE

SCALE: HORZ.: 1"=50'
 VERT.: 1"=5'

CERTIFIED BY: _____
 NOT PUBLISHED
 ALL RIGHTS RESERVED
 EXCEPT FOR USES EXPRESSLY PERMITTED IN WRITING, INFORMATION SHOWN OR INCLUDED IN THIS DOCUMENT IS SOLELY THE PROPERTY OF SCHNEIDER ENGINEERING CORPORATION.

Schneider Engineering Corporation

3020 North Post Road
 Indianapolis, Indiana 46226-0068
 317-898-8282
 317-899-8010 Fax

Engineering
 Surveying
 GIS + LIS
 Geology

A Partnered Entity with Bohlen, Meyer, Gibson & Associates, Incorporated

MERRIMAC CORP.
 MERRIMAC SECTION 2
 WESTFIELD, INDIANA

STORM SEWER PLAN

| | | | |
|----------|-------------|-------|---------|
| Date | Project No. | Drawn | Approv. |
| 07/21/95 | 1045.02 | BGG | |

Computer Files
 104525M2
 XREF: 104502PL

Sheet No.
S-18
 OF 26

J:\104525M2\104525M2.dwg, Wed May 29 09:30:44 1996

GENERAL NOTES:

1. ALL CUTS ARE TAKEN FROM THE EXISTING GRADE TO THE PIPE INVERT.
2. ALL STATIONING IS TAKEN FROM THE NEAREST DOWNSTREAM STRUCTURE.
3. IT SHALL BE THE CONTRACTORS RESPONSIBILITY TO FIELD VERIFY ALL UTILITY LOCATIONS BEFORE CONSTRUCTION BEGINS.
4. TEMPORARY TRAFFIC CONTROL DURING CONSTRUCTION TO CONFORM TO APPLICABLE LOCAL AND STATE STANDARDS.
5. ALL CONSTRUCTION ACTIVITY ON THIS SITE TO BE PERFORMED IN COMPLIANCE WITH APPLICABLE O.S.H.A. STANDARDS FOR WORKER SAFETY.
6. CONTRACTOR SHALL MINIMIZE DAMAGE TO EXISTING TREES.
7. FOR LOCATION OF STORM SEWER STRUCTURES SEE DEVELOPMENT PLAN.
8. FOR LOCATION OF EASEMENTS SEE RECORDED PLAT.


HOLEY MOLEY SAYS
"DON'T DIG BLIND"

1-800-382-5544
 CALL TOLL FREE
1-800-428-5200
 FOR CALLS OUTSIDE OF INDIANA
 PER INDIANA STATE LAW IS-69-1991, IT IS AGAINST THE LAW TO EXCAVATE WITHOUT NOTIFYING THE UNDERGROUND LOCATION SERVICE TWO (2) WORKING DAYS BEFORE COMMENCING WORK.

BENCH MARK:

BENCH MARK
 U.S.G.S. 93 RHP (1951)
 BRONZE TABLE SET IN CONCRETE POST, LOCATED ON THE SOUTH SIDE OF 146th STREET, APPROX. 25' WEST OF THE CENTERLINE OF DITCH ROAD.
 (ELEVATION = 903.373)

Revisions
 1) 29 MAY 96 - T1 - STORM SEWER RECORD DRAWING.

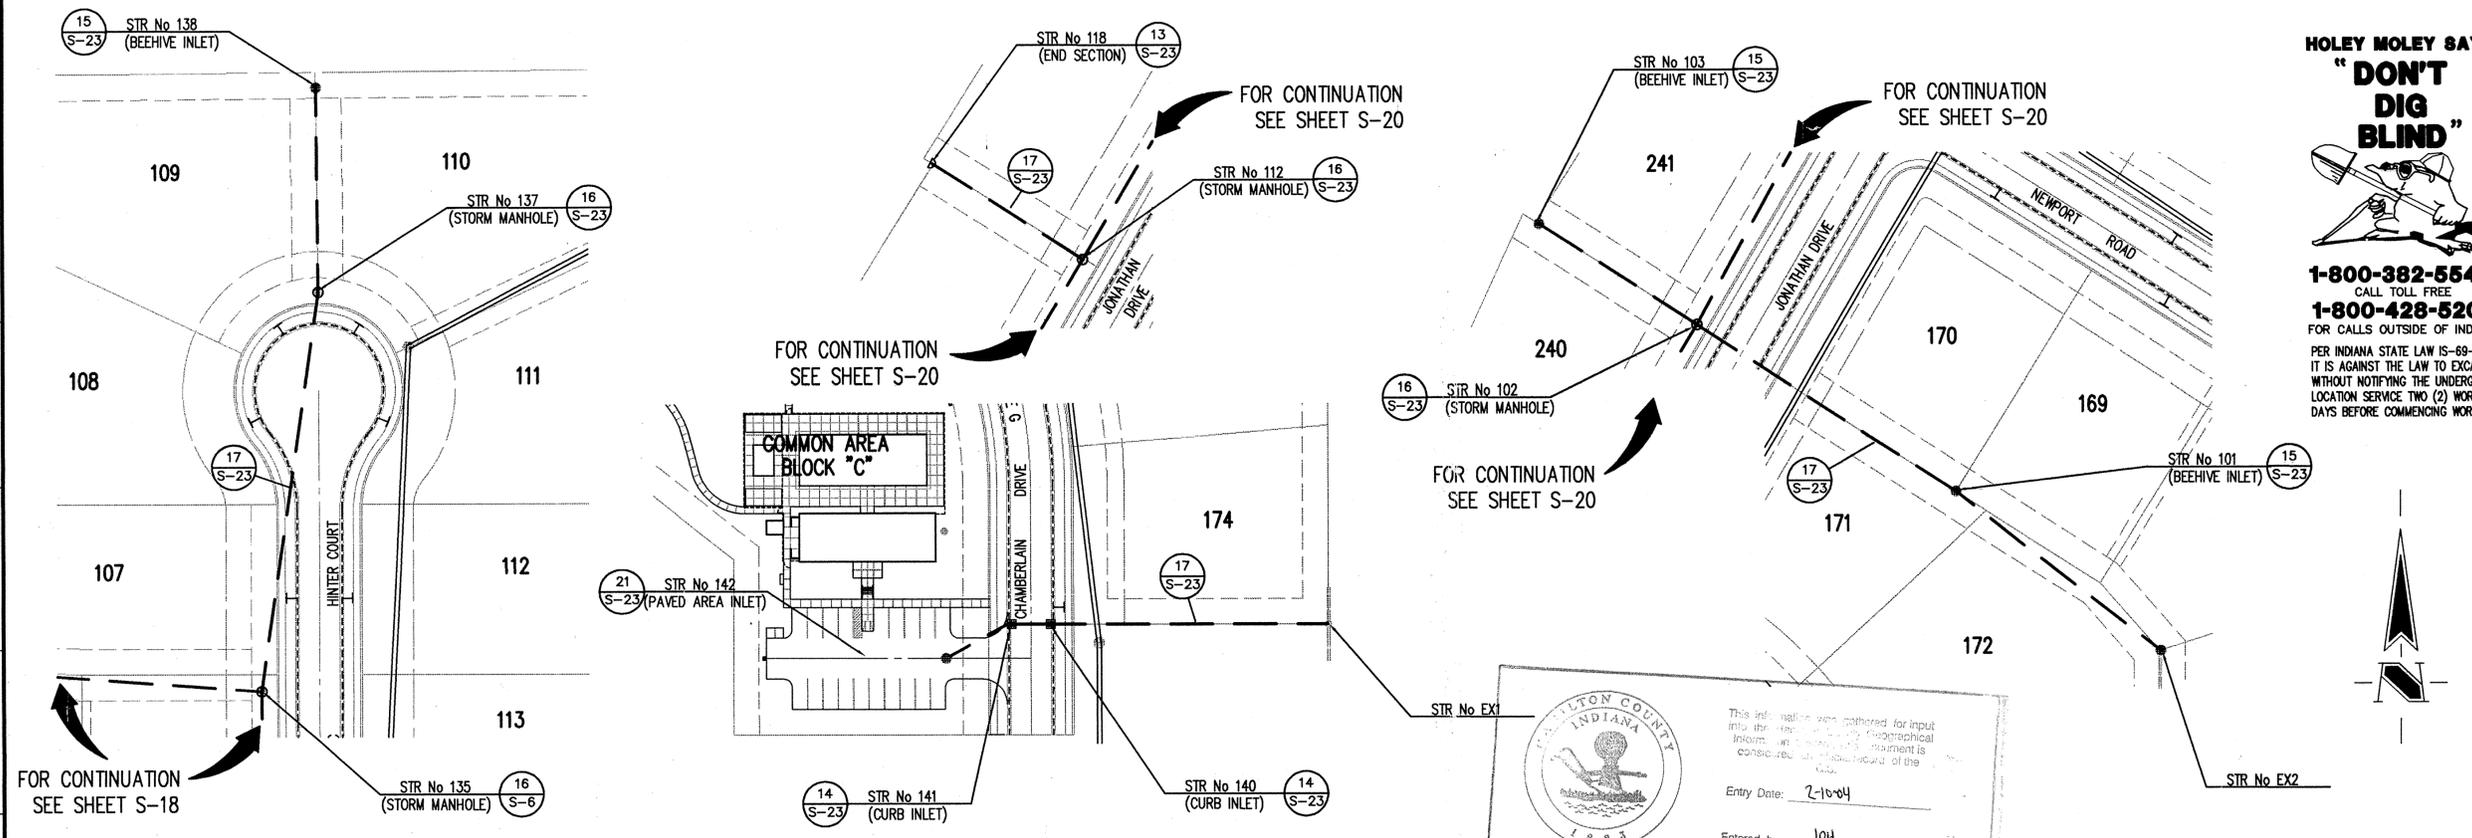

STORM SEWER PLAN

SCALE: 1"=50'

CERTIFICATION FOR "RECORD DRAWING"

CERTIFIED BY:


SCHNEIDER ENGINEERING CORPORATION
 3020 NORTH POST ROAD
 INDIANAPOLIS, INDIANA 46226-0068
 (317) 898-8282 FAX (317) 899-8010

NOTE:
 Record drawing certification only for top of coating, invert elevations and lengths of pipe. Slope percentage represents a calculated figure and is for general information only.

DATE: 6-3-96



STORM SEWER RECORD DRAWING

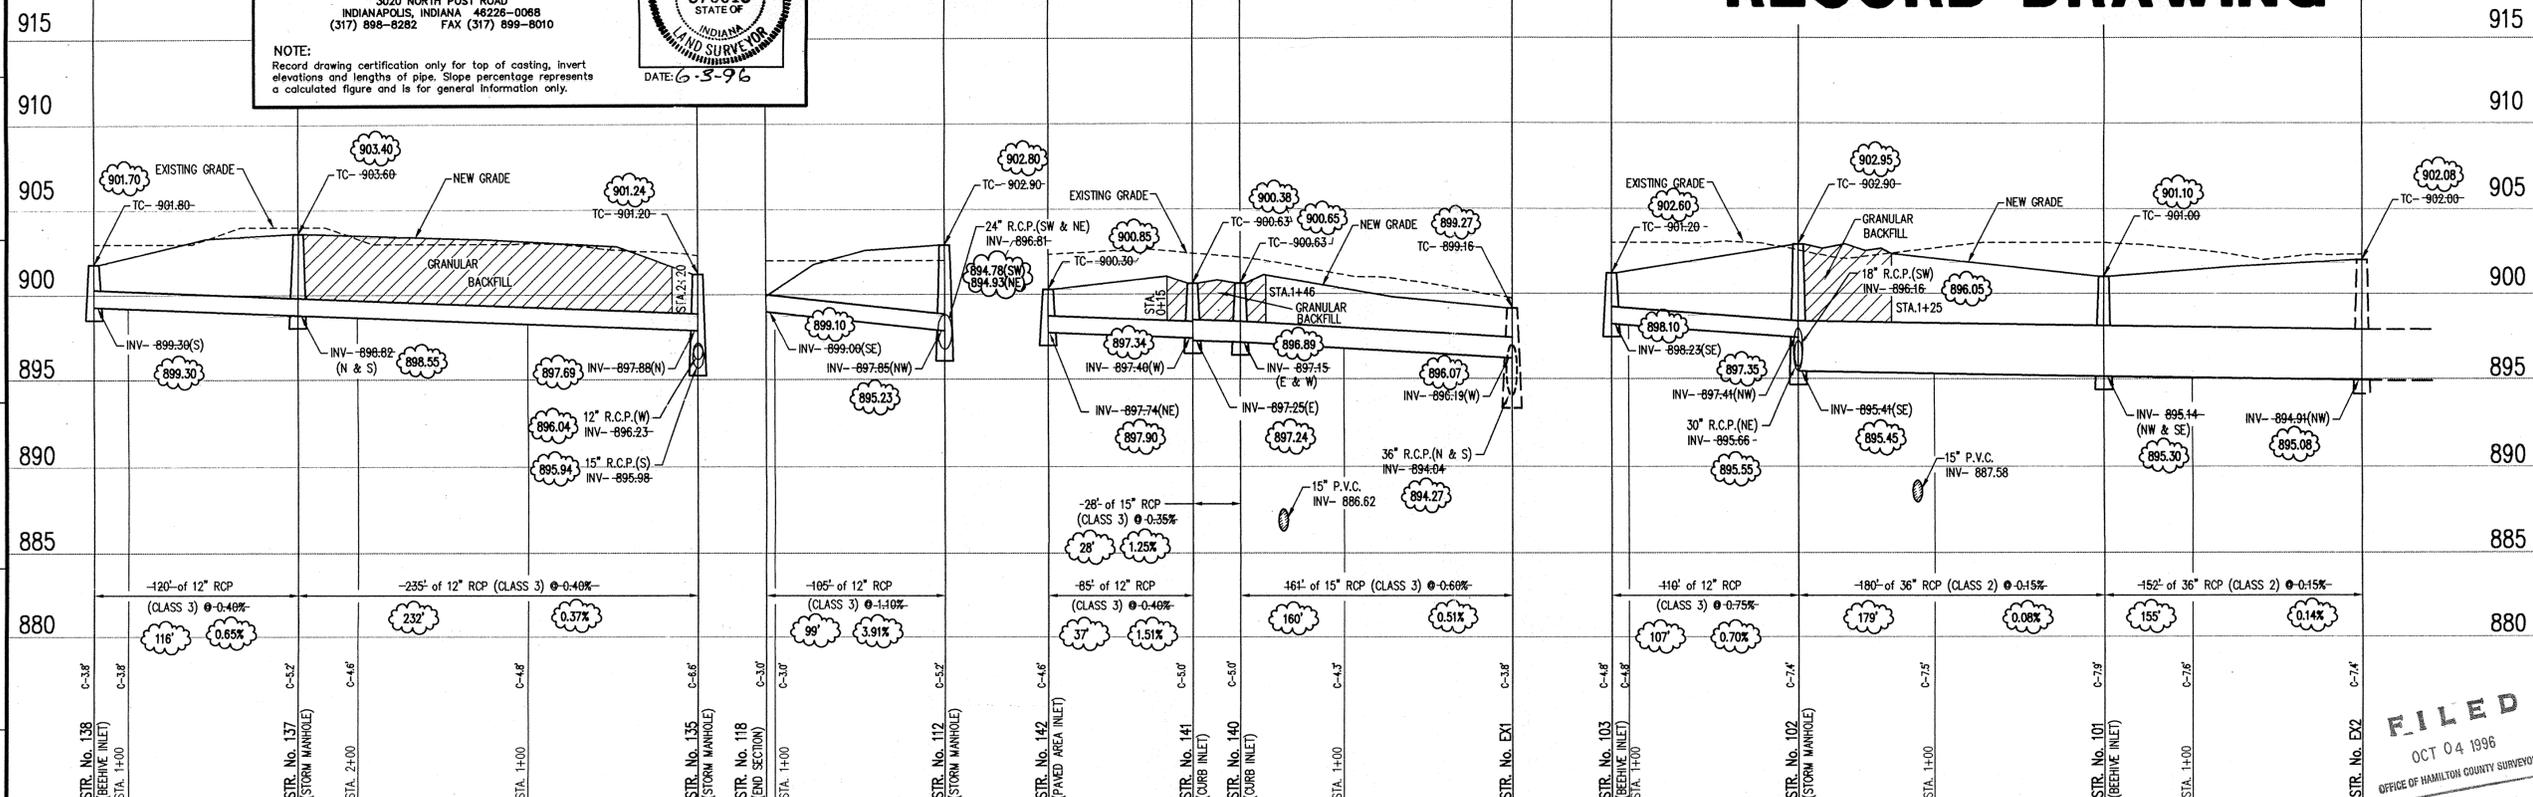

STORM SEWER PROFILE

SCALE: HORZ.: 1"=50'
 VERT.: 1"=5'

CERTIFIED BY:
 NOT PUBLISHED
 ALL RIGHTS RESERVED
 EXCEPT FOR USES EXPRESSLY PERMITTED IN WRITING, INFORMATION SHOWN OR INCLUDED IN THIS DOCUMENT IS SOLELY THE PROPERTY OF SCHNEIDER ENGINEERING CORPORATION.



3020 North Post Road
 46226-0068
 317-898-8282
 317-899-8010 Fax

Engineering
 Surveying
 GIS • LIS
 Geology

A Partnered Entity with Bohlen, Meyer, Gibson & Associates, Incorporated

MERRIMAC CORP.
 MERRIMAC SECTION 2
 WESTFIELD, INDIANA

STORM SEWER PLAN

Date: 07/21/95 Project No. 1045.02 Drawn: BGG Approved:

Computer Files
 104525M3
 XREF: 104502P1

Sheet No.
S-19

Of 26

FILED
 OCT 04 1996
 OFFICE OF HAMILTON COUNTY SURVEYOR

GENERAL NOTES:

1. ALL CUTS ARE TAKEN FROM THE EXISTING GRADE TO THE PIPE INVERT.
2. ALL STATIONING IS TAKEN FROM THE NEAREST DOWNSTREAM STRUCTURE.
3. IT SHALL BE THE CONTRACTORS RESPONSIBILITY TO FIELD VERIFY ALL UTILITY LOCATIONS BEFORE CONSTRUCTION BEGINS.
4. TEMPORARY TRAFFIC CONTROL DURING CONSTRUCTION TO CONFORM TO APPLICABLE LOCAL AND STATE STANDARDS.
5. ALL CONSTRUCTION ACTIVITY ON THIS SITE TO BE PERFORMED IN COMPLIANCE WITH APPLICABLE O.S.H.A. STANDARDS FOR WORKER SAFETY.
6. CONTRACTOR SHALL MINIMIZE DAMAGE TO EXISTING TREES.
7. FOR LOCATION OF STORM SEWER STRUCTURES SEE DEVELOPMENT PLAN.
8. FOR LOCATION OF EASEMENTS SEE RECORDED PLAT.




1-800-382-5544
CALL TOLL FREE
1-800-428-5200
FOR CALLS OUTSIDE OF INDIANA
PER INDIANA STATE LAW IS-69-1991,
IT IS AGAINST THE LAW TO EXCAVATE
WITHOUT NOTIFYING THE UNDERGROUND
LOCATION SERVICE TWO (2) WORKING
DAYS BEFORE COMMENCING WORK.

BENCH MARK:

BENCH MARK
U.S.G.S. 93 RHP (1951)
BRONZE TABLET SET IN CONCRETE POST, LOCATED ON THE
SOUTH SIDE OF 146th STREET, APPROX. 25' WEST OF THE
CENTERLINE OF DITCH ROAD.
(ELEVATION = 903.373)

Revisions
1) 29 MAY 96 - T4 - STORM SEWER RECORD DRAWING.

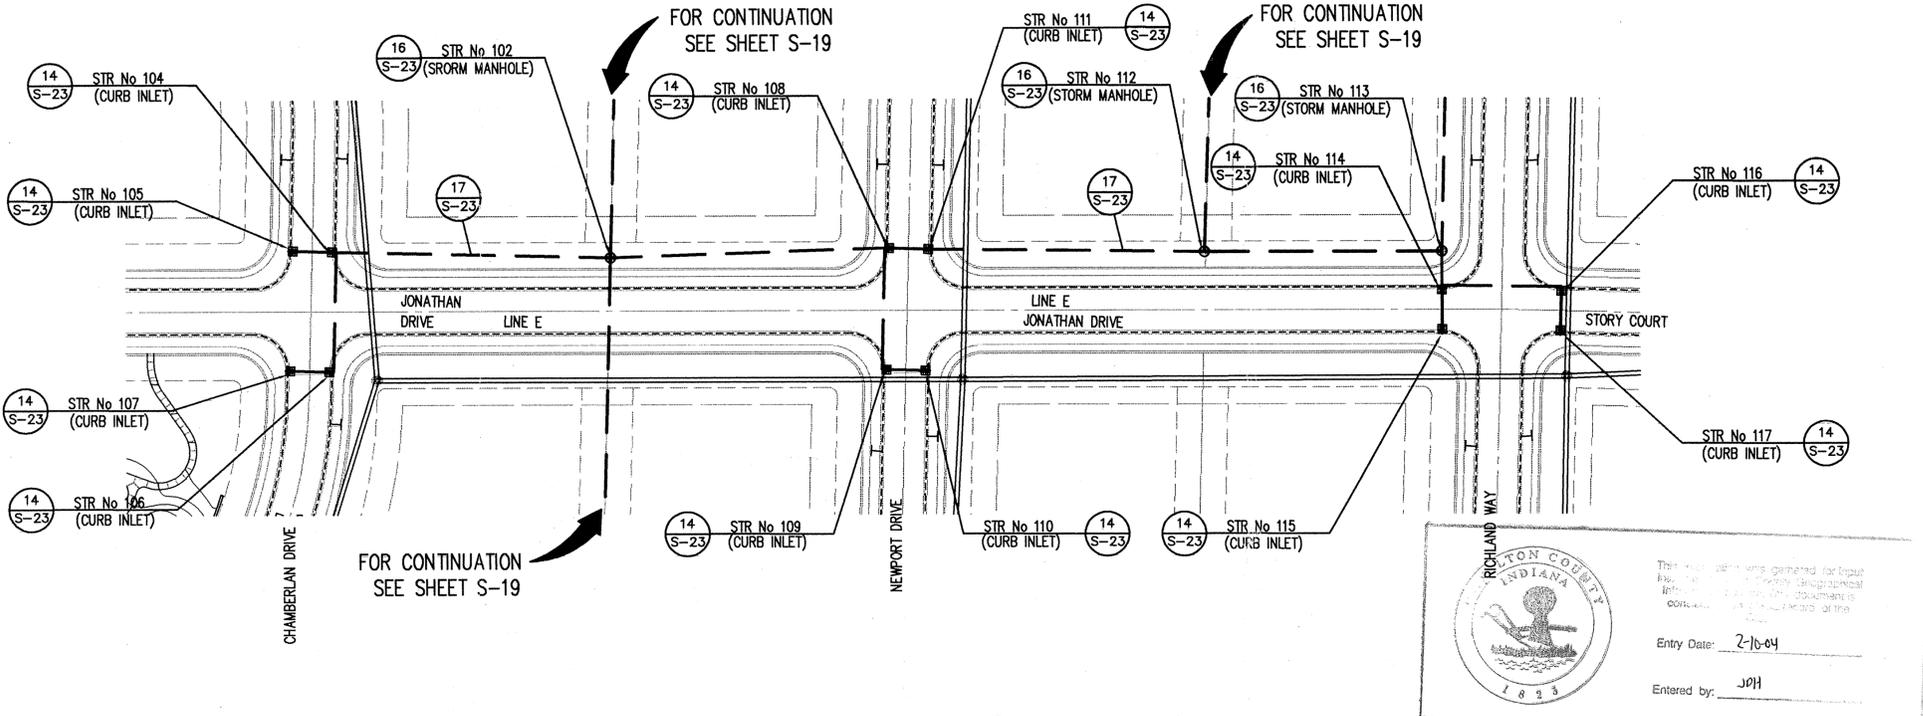

RICHLAND COUNTY INDIANA
The information was generated for your file and is the property of the Hamilton County Surveyor's Office. It is not to be used for any other purpose without the written consent of the Surveyor's Office.
Entry Date: 2-16-04
Entered by: JPH


STORM SEWER PLAN

SCALE: 1"=50'

CERTIFICATION FOR "RECORD DRAWING"
Certified by:
Richard J. Raybank
SCHNEIDER ENGINEERING CORPORATION
3020 NORTH POST ROAD
INDIANAPOLIS, INDIANA 46226-0068
(317) 898-8282 FAX (317) 899-8010
NOTE:
Record drawing certification only for top of casting, invert elevations and lengths of pipe. Slope percentage represents a calculated figure and is for general information only.



STORM SEWER RECORD DRAWING

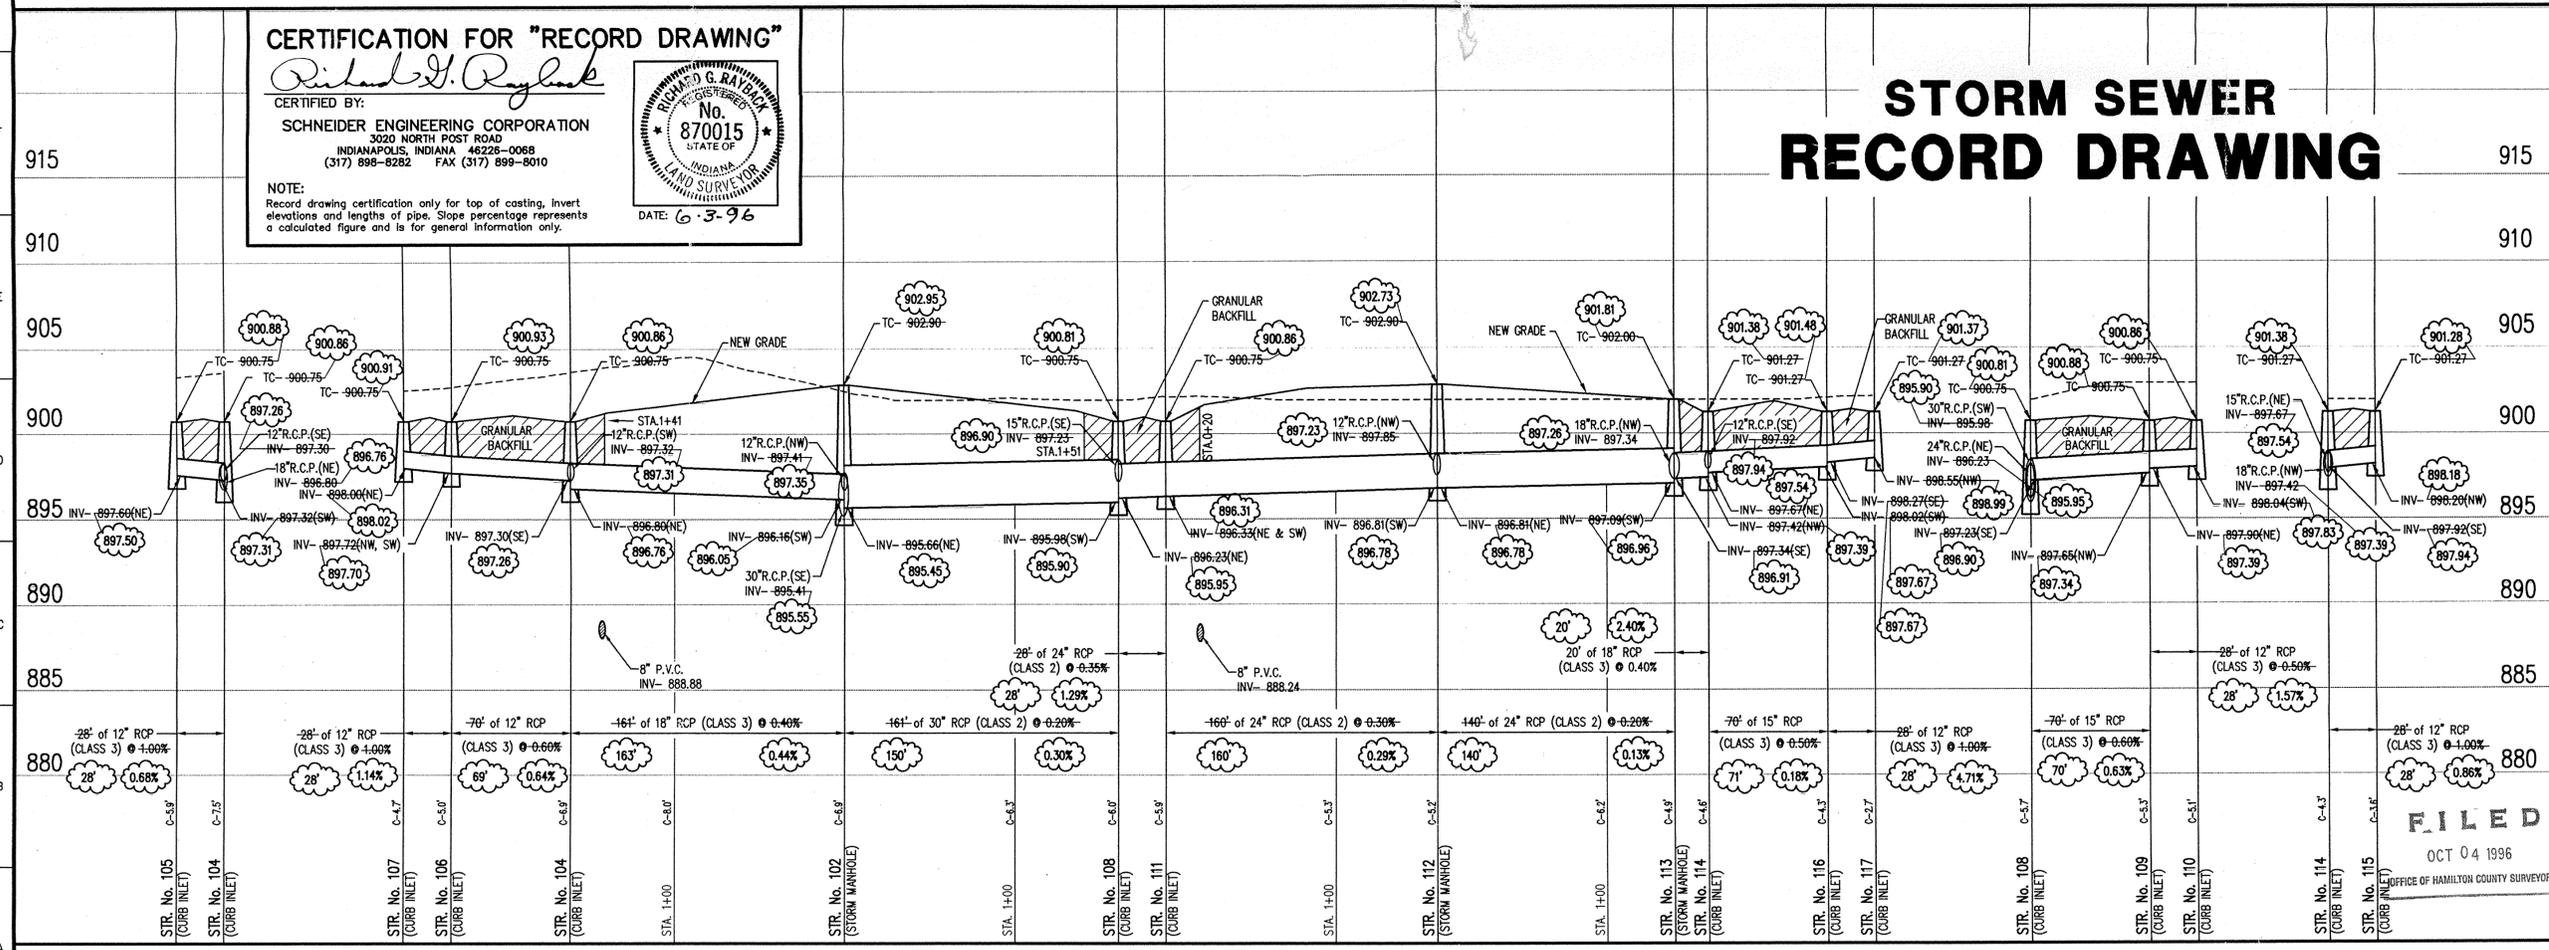

CERTIFIED BY: [Signature]
NOT PUBLISHED
ALL RIGHTS RESERVED
EXCEPT FOR USES EXPRESSLY PERMITTED IN WRITING, INFORMATION SHOWN OR INCLUDED IN THIS DOCUMENT IS SOLELY THE PROPERTY OF SCHNEIDER ENGINEERING CORPORATION.

Schneider Engineering Corporation
3020 North Post Road
Indianapolis, Indiana 46226-0068
317-898-8282
317-899-8010 Fax
Engineering Surveying GIS • LIS Geology

A Partnered Entity with Bohlen, Meyer, Gibson & Associates, Incorporated

MERRIMAC CORP.
MERRIMAC SECTION 2
WESTFIELD, INDIANA

STORM SEWER PLAN

| | | | |
|----------------------------|-------------|-------|--------|
| Date | Project No. | Drawn | Apprv. |
| 07/21/95 | 1045.02 | 866 | |
| Computer Files | Sheet No. | | |
| 10452SM4 XREF: 104502PL | S-20 | | |

STORM SEWER PROFILE

SCALE: HORZ.: 1"=50'
VERT.: 1"=5'


CERTIFICATION FOR "RECORD DRAWING"

CERTIFIED BY:
Richard G. Rayback
 SCHNEIDER ENGINEERING CORPORATION
 3020 NORTH POST ROAD
 INDIANAPOLIS, INDIANA 46226-0088
 (317) 898-8282 FAX (317) 899-8010



NOTE:
 Record drawing certification for sub-surface drain lateral marker location only.

DATE:

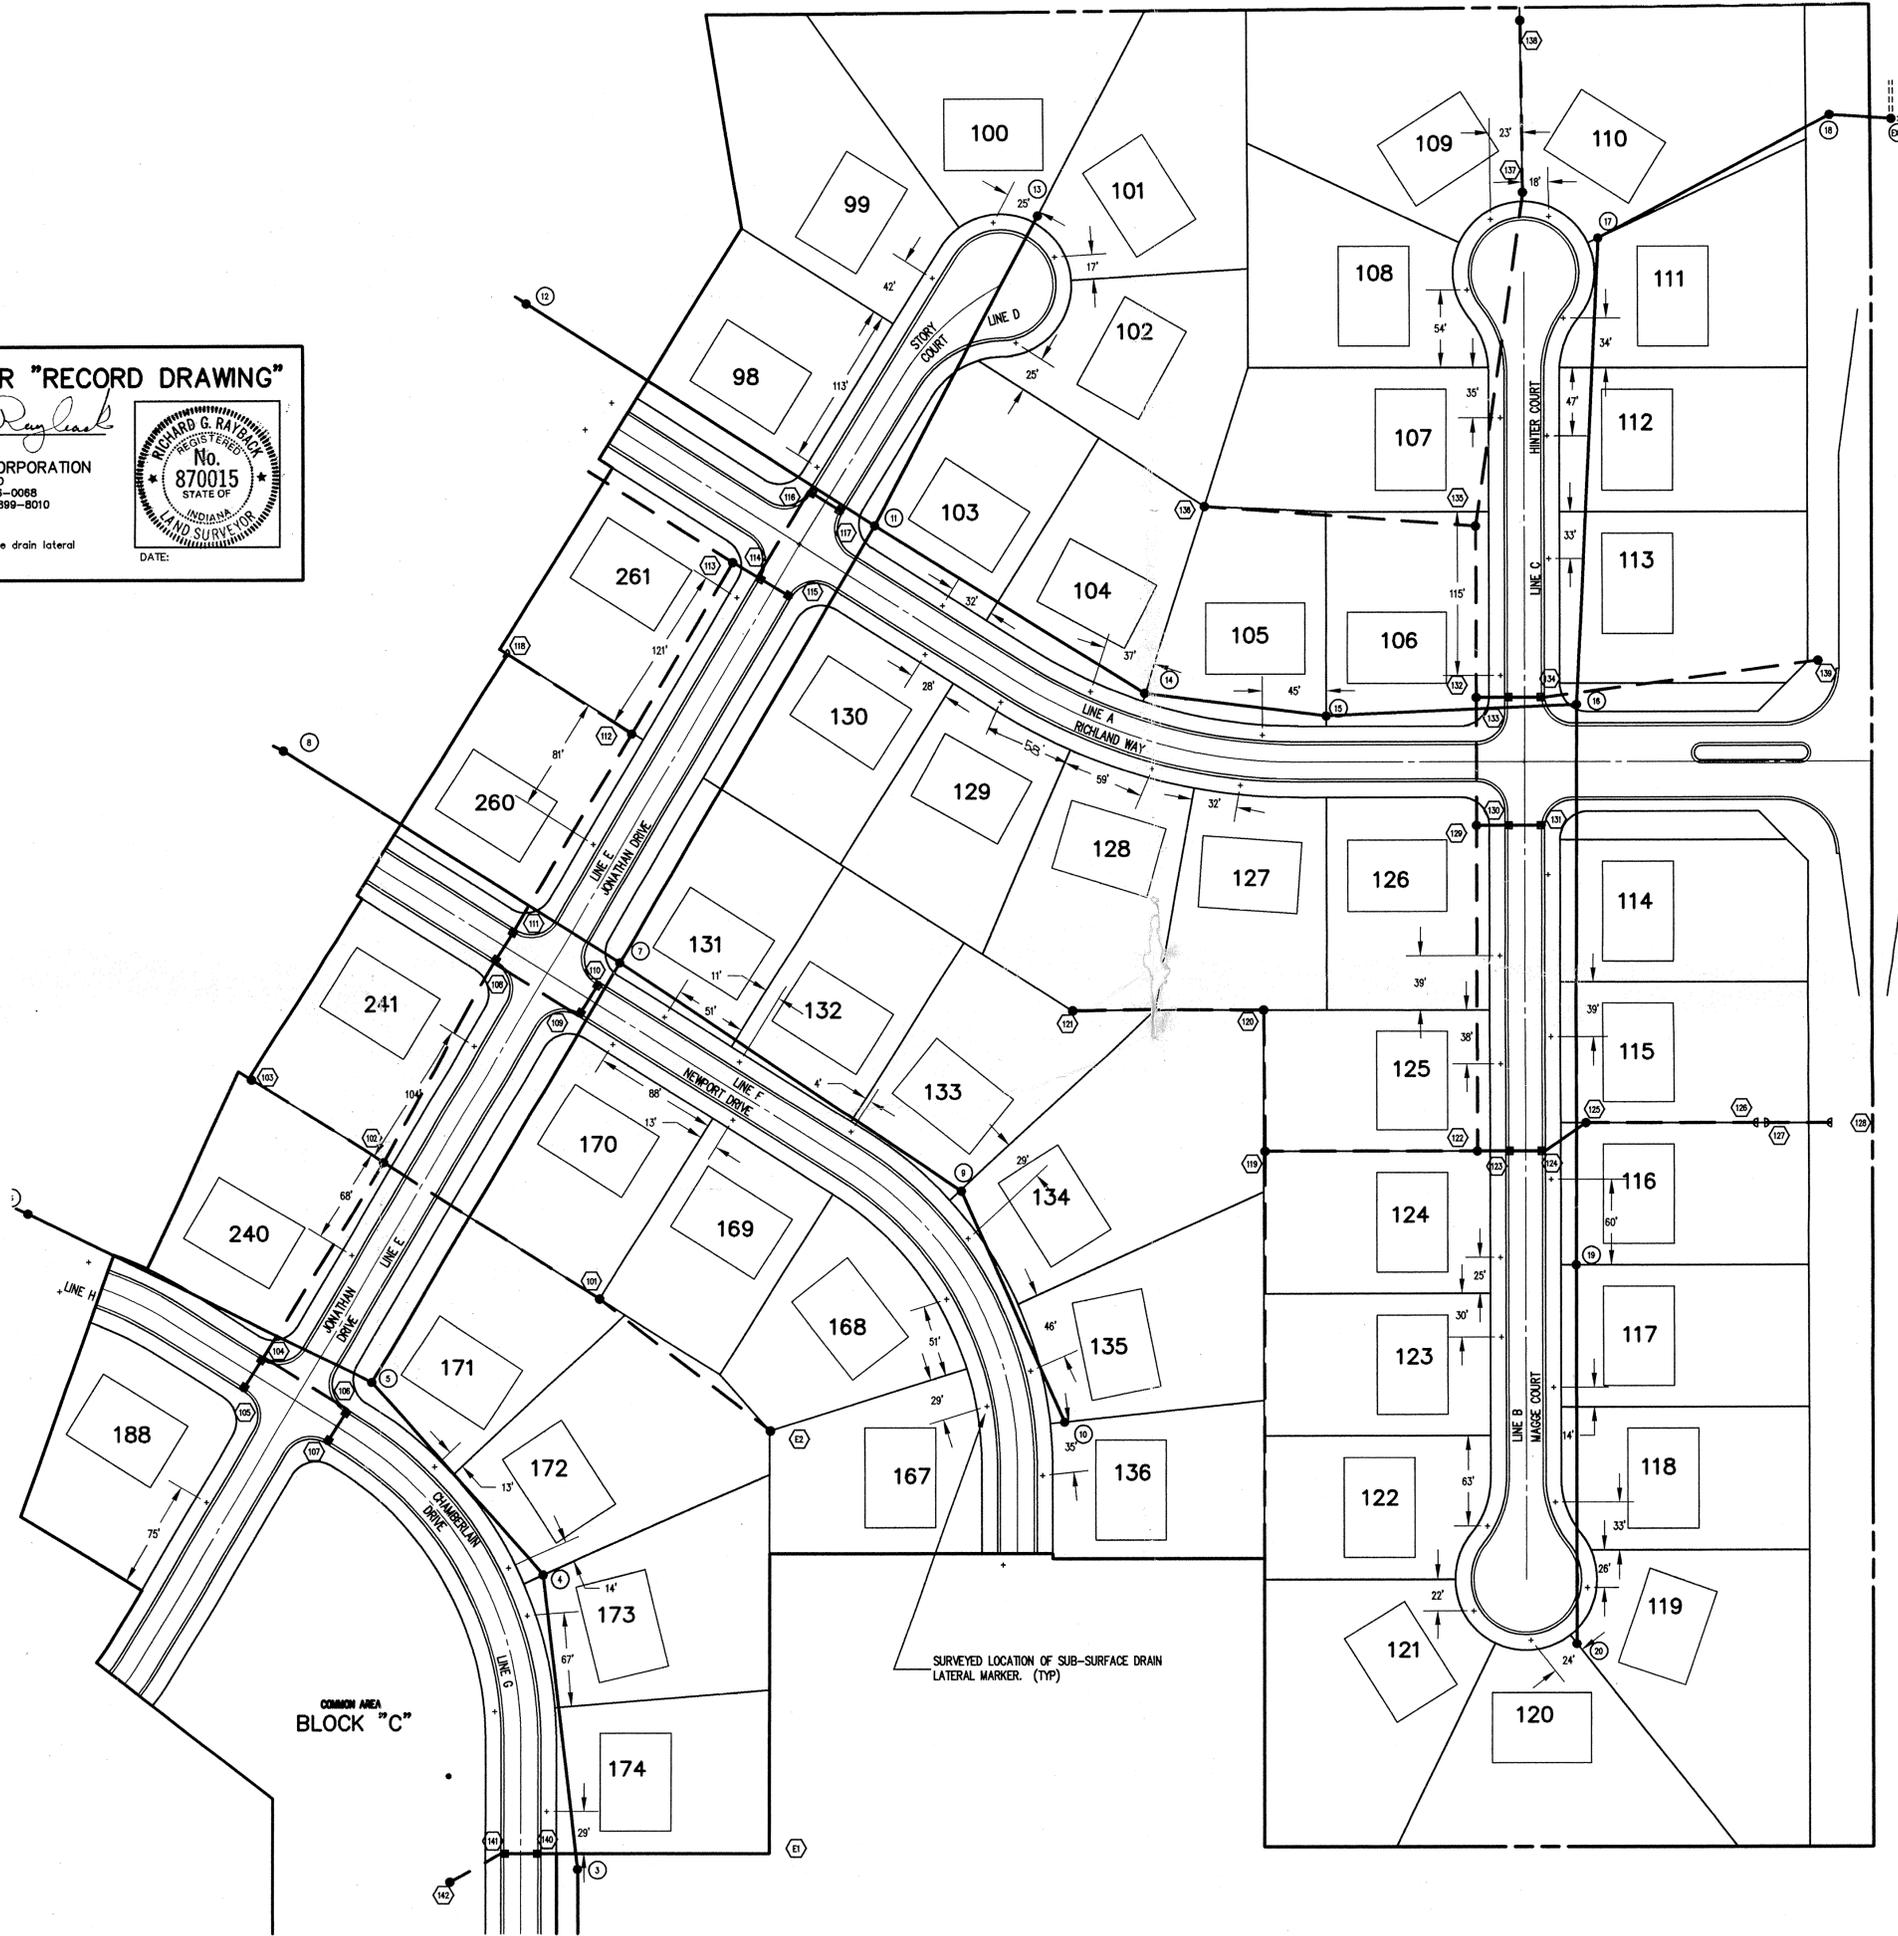

This information was gathered for input into the Hamilton County Geographic Information System. This document is considered an official record of the County.
 Entry Date: 2/20/96
 Entered by: JLDH



ASSUMED NORTH
 SCALE 1" = 60'

SUB-SURFACE DRAIN RECORD DRAWING

FILED

OCT 04 1996

OFFICE OF HAMILTON COUNTY SURVEYOR

Revisions

CERTIFIED BY _____
 THIS DRAWING AND THE IDEAS, DESIGNS AND CONCEPTS CONTAINED HEREIN ARE THE EXCLUSIVE INTELLECTUAL PROPERTY OF SCHNEIDER ENGINEERING CORPORATION AND ARE NOT TO BE USED OR REPRODUCED IN WHOLE OR IN PART, WITHOUT THE WRITTEN CONSENT OF SCHNEIDER ENGINEERING CORPORATION.
 © 1996, Schneider Engineering Corporation

Schneider Engineering Corporation
 3020 North Post Road
 Indianapolis, Indiana 46226-0088
 317-898-8282
 317-899-8010 Fax
 Engineering
 Surveying
 Landscape Architecture
 GIS • LIS
 Geology

A Partnered Entity with Bohlen, Meyer, Gibson & Associates, Incorporated

MERRIMAC CORP.
 MERRIMAC SECTION 2
 WESTFIELD, INDIANA

RECORD DRAWING SUB-SURFACE DRAIN LOCATIONS

| | | | |
|--|-------------|-------|----------|
| Date | Project No. | Drawn | Approved |
| 29 MAY 96 | 1045.02 | TJ | |
| Computer Files | Sheet No. | | |
| J:\1045\DWG\02\10452ASB.DWG XREF J:\1045\DWG\02\10452PL.DWG | 1 | | |