

Kenton C. Ward, CFM
Surveyor of Hamilton County
Phone (317) 776-8495
Fax (317) 776-9628

Suite 188
One Hamilton County Square
Noblesville, Indiana 46060-2230

Map Correction-Field Verification

Drain Number: 315

Drain Length: 3654

Drain Name: Centennial South Phase 2

Change + / - : -223

Date: 7-15-2013


New Length: 3431

Verified By: SLM

Notes & Sketch:

The SSD was improperly mapped under the curbs. The SSD under the curbs were not outlined as part of the regulated drain. The SSD outlined in the report were those in the common area and in the rear of lots 152-151 and 166-167. Therefore, the length of SSD was shortened from 1898 feet to 1675 feet.

Suzanne L. Mills
GIS Specialist

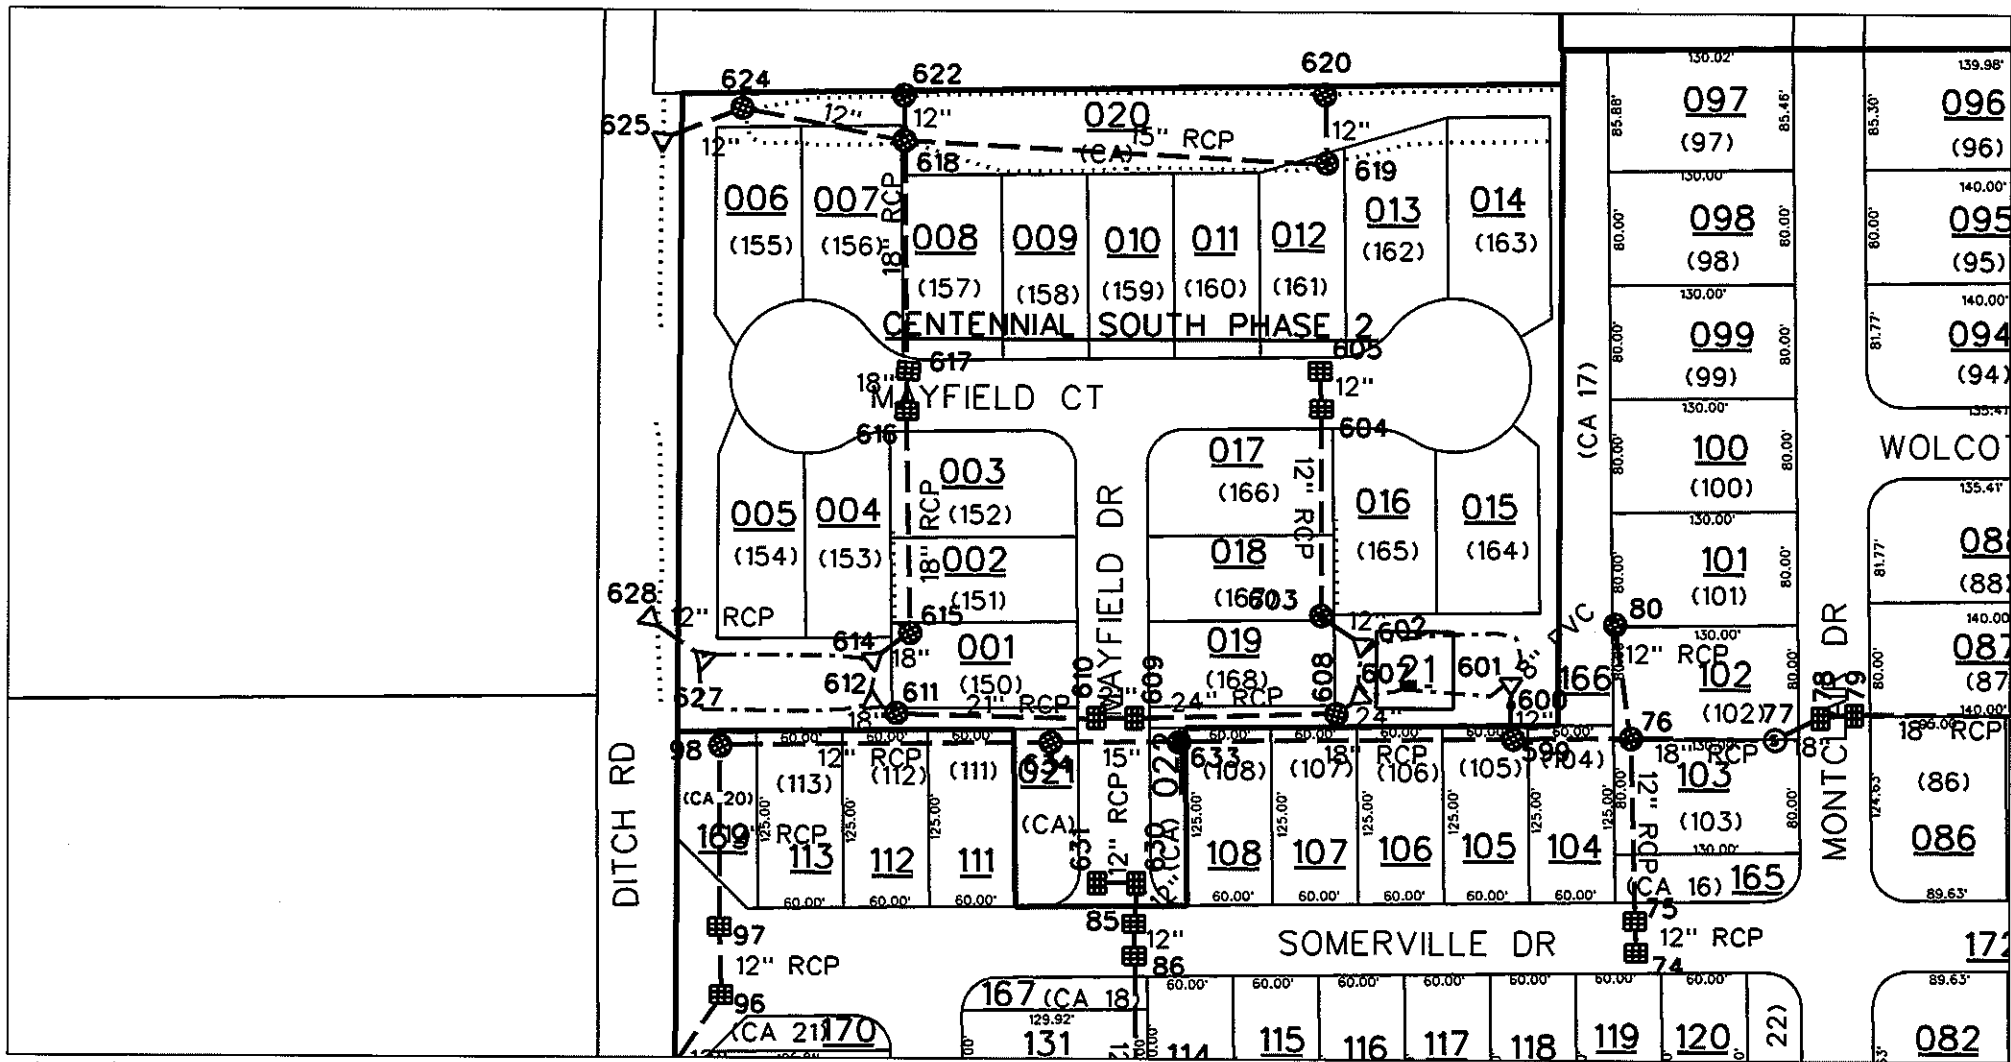

sub_rg_drn.dgn 7/15/2013 11:27:54 AM