


Drain: CENTENNIAL DRAIN -315
Improvement: CENTENNIAL SEC 7 ARM
Operator: JDH
Date: 10-6-03
YR OF CONST. 2002

GIS Drain Input Checklist

- Digitize & Attribute Tile Drains N/A
- Digitize & Attribute Storm Drains JRB 10-6
- Digitize & Attribute SSD N/A
- Digitize & Attribute Open Ditch N/A
- Sum drain lengths & Validate JRB 10-6
- Enter Improvements into Posse JRB 10-6
- Enter Drain Age into Posse July 11-17
- Sum drain length for Watershed in Posse July 11-17
- Stamp Plans JRB 10-6
- Pull Source Documents for Scanning JRB 10-6

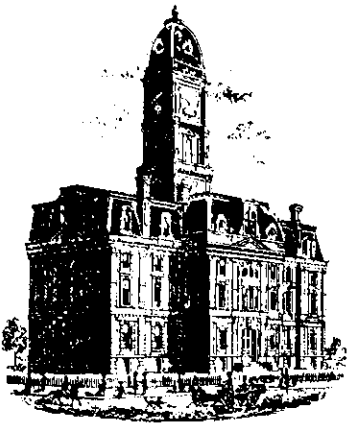

SURVEYOR'S OFFICE
Hamilton County

Kenton C. Ward, Surveyor

Phone (317) 776-8495

Fax (317) 776-9628

Suite 188

One Hamilton County Square
Noblesville, Indiana 46060-2230

August 12, 2002

To: Hamilton County Drainage Board

Re: Centennial Drain, Section 7 Arm

Attached is a petition, non-enforcement request, plans, calculations, quantity summary and assessment roll for the Section 7 Arm, Centennial Drain. I have reviewed the submittals and petition and have found each to be in proper form.

I have made a personal inspection of the land described in the petition. Upon doing so, I believe that the drain is practicable; will improve the public health; benefit a public highway and be of public utility; and that the costs, damages, and expenses of the proposed drain will probably be less than the benefits accruing to the owners of land likely to be benefited. The drain will consist of the following:

42" RCP 582 feet

The total length of the drain will be 582 feet.

There are no subsurface drains (SSD) to be part of the regulated drain within this section.


I have reviewed the plans and believe the drain will benefit each lot equally. Therefore, I recommend each lot be assessed equally. I also believe that no damages will result to landowners by the construction of this drain. I recommend a maintenance assessment of \$50.00 per lot, \$5.00 per acre for roadways, with a \$50.00 minimum. With this assessment the total annual assessment for this drain/this section will be \$469.50.

Parcels assessed for this drain may be assessed for the Collins-Osborn or Williams Creek Drain at sometime in the future.

I believe this proposed drain meets the requirements for Urban Drain Classification as set out in IC 36-9-27-67 to 69. Therefore, this drain shall be designated as an Urban Drain.

I recommend that upon approval of the above-proposed drain that the Board also approve the attached non-enforcement request. This request is for the reduction of the regulated drain easement to those easement widths as shown on the secondary plat for Centennial, Section 7 as recorded in the office of the Hamilton County Recorder.

I recommend the Board set a hearing for this proposed drain for September 23, 2002.

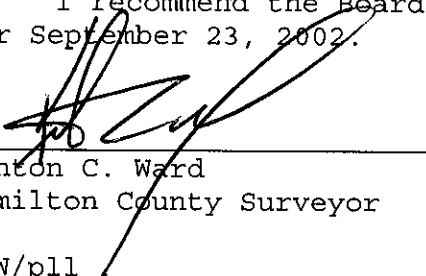

Kenton C. Ward
Hamilton County Surveyor

KCW/pl1

State of Indiana)
)
County of Hamilton)

FILED

MAY 08 2002

TO: HAMILTON COUNTY DRAINAGE BOARD
c/o Hamilton County Surveyor
Courthouse
Noblesville, IN 46060

OFFICE OF HAMILTON COUNTY SURVEYOR

In the matter of Centennial subdivision, Section
7 Drain petition.

Petitioner is the owner of all lots in the land affected by the proposed new regulated drain. The drainage will affect various lots in Centennial, Section 7, a subdivision in Hamilton County, Indiana. The general route of such drainage shall be in existing easements and along public roads as shown in the plans on file in the Surveyor's Office.

Petitioner believes that the cost, damages, and expenses of the proposed improvement will be less than the benefits which will result to the owners of the land likely to be benefitted thereby. Petitioner believes the proposed improvements will:

- (a) improve public health
- (b) benefit a public street
- (c) be of public utility


Petitioner agrees to pay the cost of construction of the drainage system and requests periodic maintenance assessments by the Board thereafter.

The Petitioner also agrees to the following:


1. To provide the Drainage Board a Performance Bond for the portion of the drainage system which will be made a regulated drain. The bond will be in the amount of 100% of the Engineers estimate. The bond will be in effect until construction of 100% of the system is completed and so certified by the Engineer.
2. The Petitioner shall retain an Engineer throughout the construction phase. At completion of the project the Petitioner's Engineer shall certify that the drainage system which is to be maintained as a regulated drain has been constructed as per construction plans.
3. The Petitioner agrees to request in writing to the County Surveyor any changes from the approved plan and must receive written authorization from the County Surveyor prior to implementation of the change. All changes shall be documented and given to the Surveyor to be placed in the Drain File.

4. The Petitioner shall instruct his Engineer to provide a reproducible print on a 24" x 36" mylar of the final design of the Drainage System. This shall be submitted to the County Surveyor prior to the release of the Performance Bond.
5. The Petitioner shall comply with the Erosion Control Plan as specified on the construction plans. Failure to comply with the Erosion Control Plan shall be determined by the Board as being an obstruction to the drainage system. The County Surveyor shall immediately install or repair the needed measures at Petitioners cost as per IC 36-9-27-46.

The Petitioner further requests that the Drain be classified as an Urban Drain.

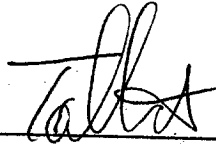

Signed

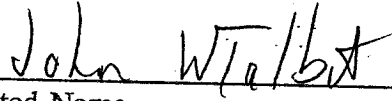

Printed Name


Signed

Printed Name

Recorded Owner(s) of Land Involved

Date

4/29/02

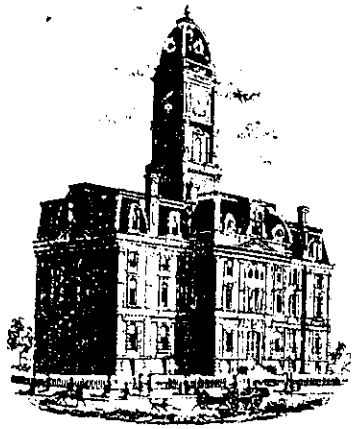

SURVEYOR'S OFFICE
Hamilton County

Kenton C. Ward, Surveyor

Phone (317) 776-8495

Fax (317) 776-9628

Suite 188

One Hamilton County Square

Noblesville, Indiana 46060-2230

January 22, 2003

Mr. John Talbot
Estridge Development
1041 West Main Street
Carmel, IN 46032

Re: Centennial Drain

The Hamilton County Surveyor's Office is returning the enclosed sureties that was released by the Hamilton County Board of Commissioners during their meeting of January 13, 2003.

Accompanying this letter you will find the released sureties for Centennial Sec. 7 and Centennial Townhomes Sec. 2.

Sincerely,

Jerry L. Liston

Inspector, Hamilton County Surveyor's Office

SUBDIVISION IMPROVEMENTS PERFORMANCE BOND

Bond No. 8873625

KNOW ALL MEN BY THESE PRESENTS:

That we, ESTRIDGE DEVELOPMENT COMPANY, INC., as Principal, and Developers Surety and Indemnity Company, a Corporation organized and doing business under and by virtue of the laws of the State of Iowa and duly licensed to conduct a general surety business in the State of INDIANA, as Surety, are held and firmly bound unto Hamilton County Board of Commissioners as Obligee in the sum of Six Thousand Five Hundred Twenty-Eight & No/100 (\$ --6,528.00--) Dollars for which payment, well and truly to be made, we bind ourselves, our heirs, executors and successors, jointly and severally firmly by these presents.

Whereas, Principal is the owner and developer of real property described as Centennial, Section 7

Whereas, Principal, has, as a condition to approval of the plat for the real property, agreed to construct certain land improvements, consisting of Erosion Control, as specified in the plans and specifications prepared by; and

Whereas, Principal is required to provide security for the faithful performance of such improvements.

NOW THEREFORE, the condition of this obligation is such that so long as Principal shall well and truly perform the conditions for plat approval, and delivers them, in good and workmanlike condition, within the time specified in such conditions, or any extension thereof, granted by Obligee, with or without notice to Surety, then this obligation shall be void, otherwise to remain in full force and effect, subject further to the following terms and conditions:

- 1. The obligation of surety shall, in no event, exceed the penal sum hereof.
2. In the event of litigation between Obligee, Surety and Principal, arising out of any breach, or to enforce any right or obligation hereby created, the prevailing party shall be entitled to the recovery of costs and reasonable attorneys fees.
3. This bond shall remain in full force and effect until release by the Obligee, provided further that the penal sum hereof may be reduced upon resolution of Obligee.
4. Neither this bond, nor any right or obligation hereunder may be assigned, conveyed or hypothecated except upon the express, written, consent of Surety and Principal.

WITNESSETH my hand and seal this 5th day of June, 2002

ESTRIDGE DEVELOPMENT COMPANY, INC.

Principal

BY: [Signature]

Title: Director of Land Development

Developers Surety and Indemnity Company
Surety

BY: [Signature]
Ginger J. Krahn

Attorney-in-Fact

BOARD OF COMMISSIONERS OF THE COUNTY OF HAMILTON

[Signature]

ATTEST: [Signature]
HAMILTON COUNTY AUDITOR

SIP0300

JUN 05 2002

DATE: 7-22-02

SUBDIVISION IMPROVEMENTS PERFORMANCE BOND

HCDB 2002-00322

Bond No. 887359S

KNOW ALL MEN BY THESE PRESENTS:

That we, ESTRIDGE DEVELOPMENT COMPANY, INC., as Principal, and Developers Surety and Indemnity Company, a Corporation organized and doing business under and by virtue of the laws of the State of Iowa and duly licensed to conduct a general surety business in the State of INDIANA, as Surety, are held and firmly bound unto Hamilton County Board of Commissioners as Obligee in the sum of Fifty Five Thousand & No/100 Dollars for which payment, well and truly to be made, we bind ourselves, our heirs, executors and successors, jointly and severally firmly by these presents.

Whereas, Principal is the owner and developer of real property described as Centennial, Section 7

Whereas, Principal, has, as a condition to approval of the plat for the real property, agreed to construct certain land improvements, consisting of Storm Sewers, as specified in the plans and specifications prepared by _____; and

Whereas, Principal is required to provide security for the faithful performance of such improvements.

NOW THEREFORE, the condition of this obligation is such that so long as Principal shall well and truly perform the conditions for plat approval, and delivers them, in good and workmanlike condition, within the time specified in such conditions, or any extension thereof, granted by Obligee, with or without notice to Surety, then this obligation shall be void, otherwise to remain in full force and effect, subject further to the following terms and conditions:

1. The obligation of surety shall, in no event, exceed the penal sum hereof.
2. In the event of litigation between Obligee, Surety and Principal, arising out of any breach, or to enforce any right or obligation hereby created, the prevailing party shall be entitled to the recovery of costs and reasonable attorneys fees.
3. This bond shall remain in full force and effect until release by the Obligee, provided further that the penal sum hereof may be reduced upon resolution of Obligee.
4. Neither this bond, nor any right or obligation hereunder may be assigned, conveyed or hypothecated except upon the express, written, consent of Surety and Principal.

WITNESSETH my hand and seal this 5th day of June, 20 02

ESTRIDGE DEVELOPMENT COMPANY, INC.

Principal

BY: [Signature]

Title: Director of Land Development

Developers Surety and Indemnity Company

Surety

BY: [Signature]

Ginger J. Krahn

Attorney-in-Fact

BOARD OF COMMISSIONERS OF THE COUNTY OF HAMILTON

[Signature]
[Signature]

SIP0300

DATE: 7/22/02

FILED

JUN 05 2002

OFFICE OF HAMILTON COUNTY SURVEYOR

ATTEST: [Signature]


HAMILTON COUNTY AUDITOR

FINDINGS AND ORDER
CONCERNING THE MAINTENANCE OF THE
Centennial Drain, Section 7 Arm


On this *23rd day of September 2002*, the Hamilton County Drainage Board has held a hearing on the Maintenance Report and Schedule of Assessments of the *Centennial Drain, Section 7 Arm*.

Evidence has been heard. Objections were presented and considered. The Board then adopted the original/amended Schedule of Assessments. The Board now finds that the annual maintenance assessment will be less than the benefits to the landowners and issues this order declaring that this Maintenance Fund be established.

HAMILTON COUNTY DRAINAGE BOARD

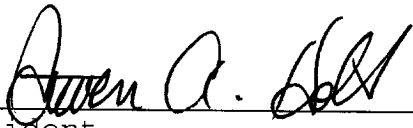


President

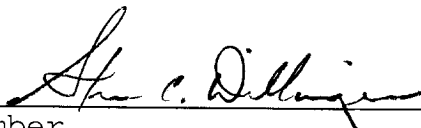

Member



Member

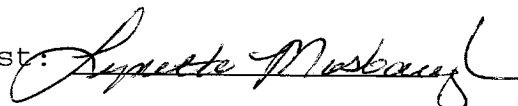Attest: 

CERTIFICATE OF COMPLETION AND COMPLIANCE

To: Hamilton County Surveyor

Re: CENTENNIAL , SECTION 7

I hereby certify that:

1. I am a Registered Land Surveyor or Engineer in the State of Indiana .
2. I am familiar with the plans and specifications for the above referenced subdivision .
3. I have personally observed and supervised the completion of the drainage facilities for the above referenced subdivision .
4. The drainage facilities within the above referenced subdivision to the best of my knowledge , information and belief have been installed and completed in comformity with all plans and specifications .

Signature: J. Cort Crosby Date: 12/9/02

Type or Print Name: J. CORT CROSBY P.E.

Business Address: 8901 OTIS AVE

INDIANAPOLIS , IN 46216

Telephone Number: (317) 826-7306


SEAL



INDIANA REGISTRATION NUMBER

920350

Revised 10/95

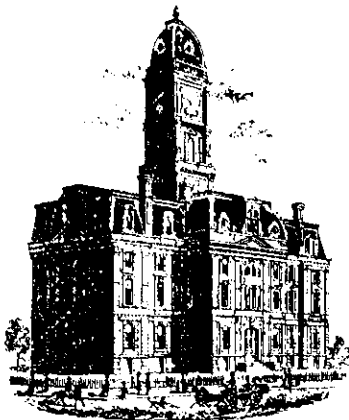

SURVEYOR'S OFFICE

Hamilton County

Kenton C. Ward, Surveyor

Phone (317) 776-8495

Fax (317) 776-9628

Suite 188

One Hamilton County Square

Noblesville, Indiana 46060-2230

To: Hamilton County Drainage Board

August 12, 2003

Re: Centennial Drain: Centennial Sec. 7 Arm

Attached are as-builts, certificate of completion & compliance, and other information for Centennial Sec. 7. An inspection of the drainage facilities for this section has been made and the facilities were found to be complete and acceptable.

During construction, changes were made to the drain, which will alter the plans submitted with my report for this drain-dated Centennial Sec. 7. The report was approved by the Board at the hearing held September 23, 2002 . (See Drainage Board Minutes Book 6, Pages 442-443) The changes are as follows:

Structure:	T.C.:	I.E.:	Pipe:	Length:	Original Plans:	Difference:
551	908.04	902.49				
546	907.53	902.21	42	408	413	-5
546	907.53	902.21				
545		902.1	42	171	169	2

The length of the drain due to the changes described above is now **579 feet**.

The non-enforcement was approved by the Board at its meeting on September 23, 2002 and recorded under instrument #200300011398.

The bond or letter of credit from Developers Surety and Indemnity Co, numbers 887359s and 887362s; dated June 5, 2002; in the amounts of \$55,000 and \$6528; was released January 13, 2003.

I recommend the Board approve the drain's construction as complete and acceptable.

Sincerely,

A handwritten signature in black ink, appearing to read 'K. Ward', written over a horizontal line.

Kenton C. Ward,
Hamilton County Surveyor

KCW/slm

CENTENNIAL SECTION 7


(CONSTRUCTION PLANS)

HAMILTON COUNTY WESTFIELD, INDIANA


DEVELOPER:

ESTRIDGE DEVELOPMENT CO., INC.


1041 WEST MAIN STREET
CARMEL, INDIANA 46032
(317) 582-2456

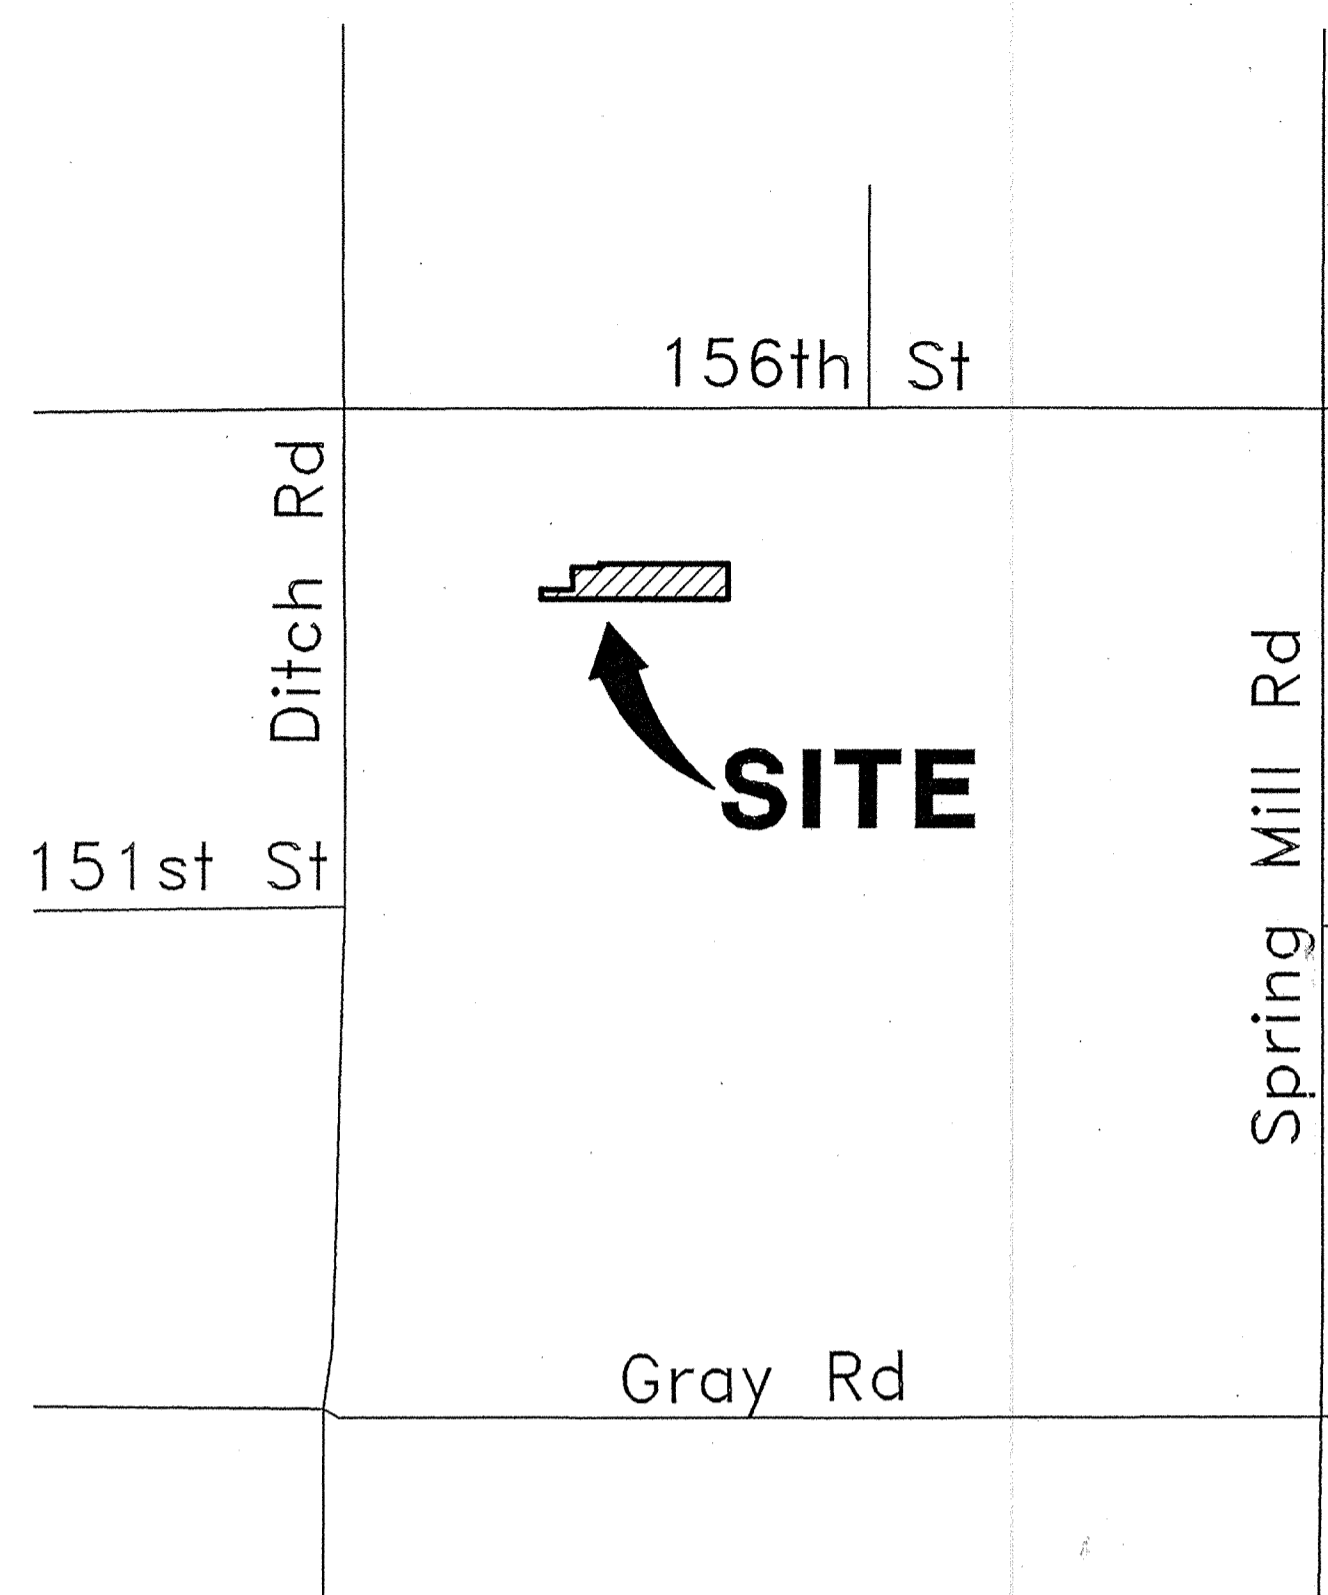


AREA MAP
SCALE: 1"=1000'

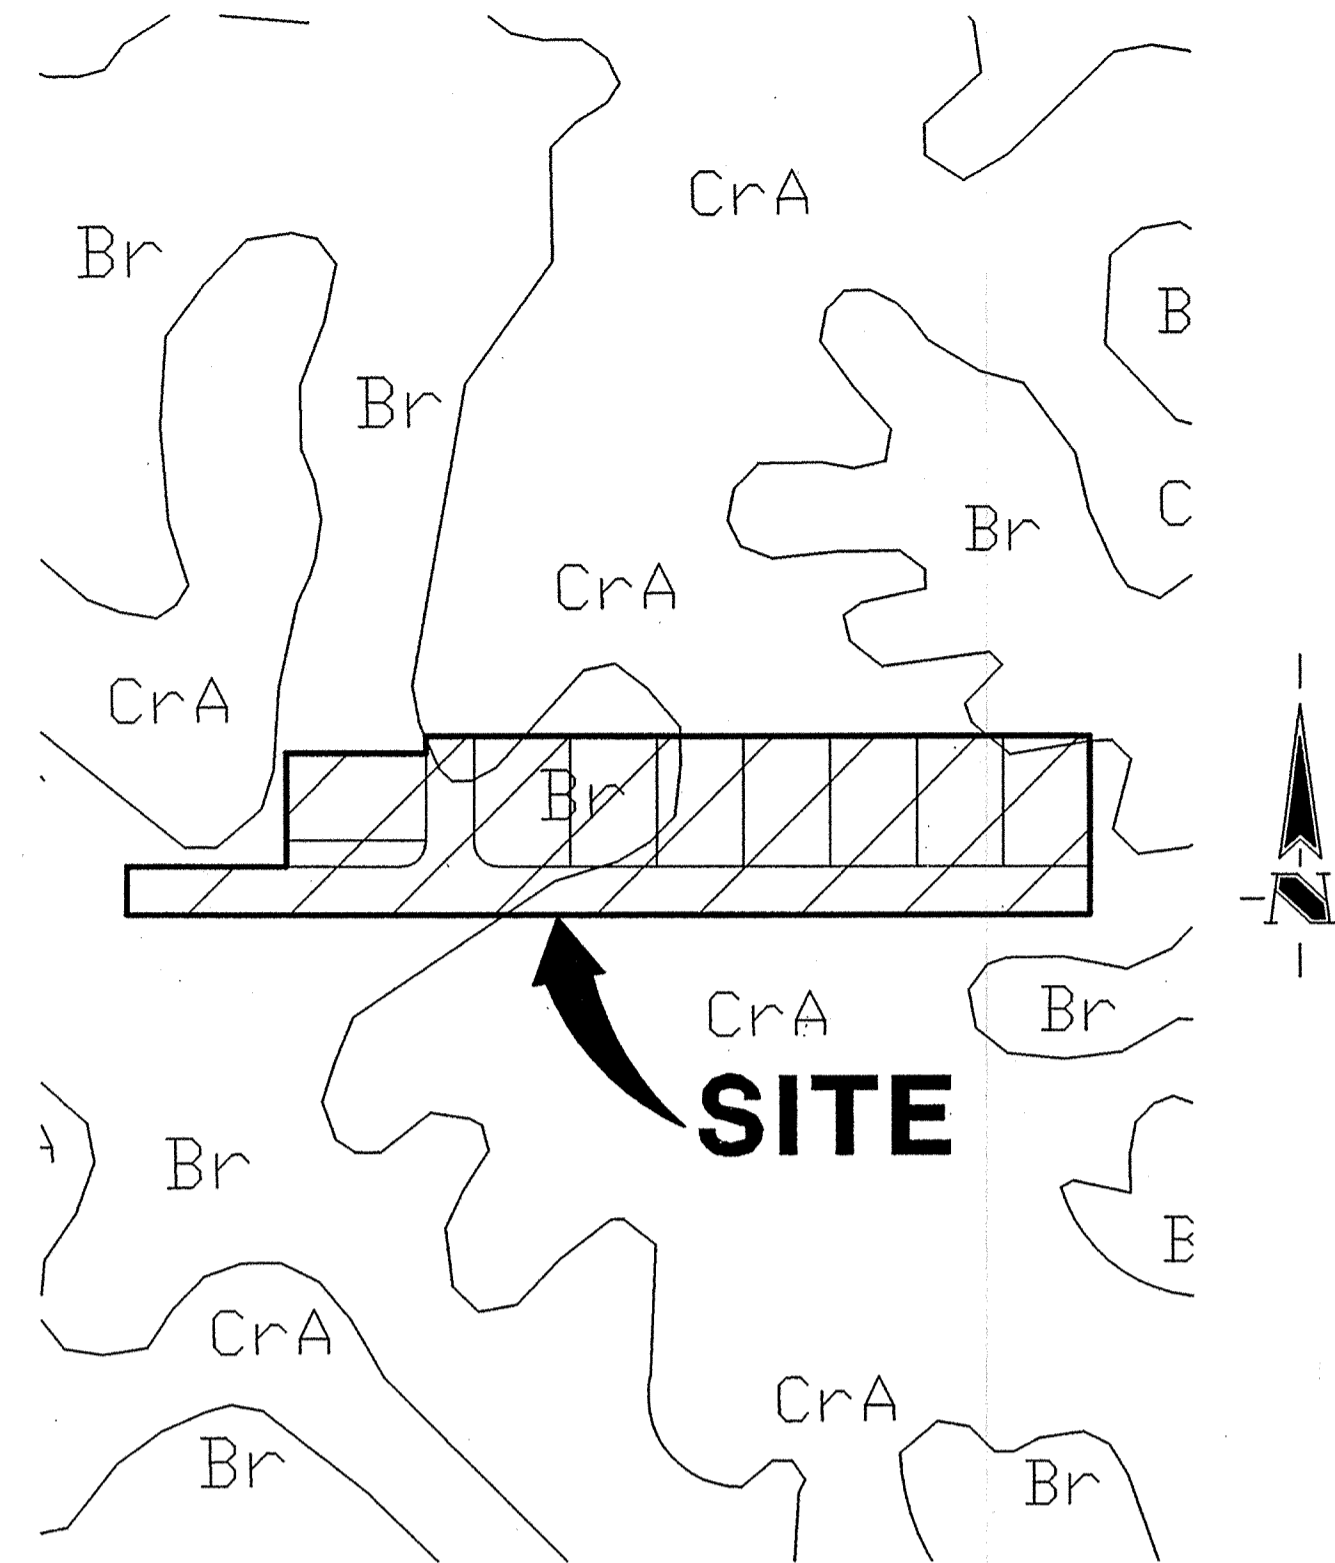

SOILS MAP
SCALE: 1"=200'

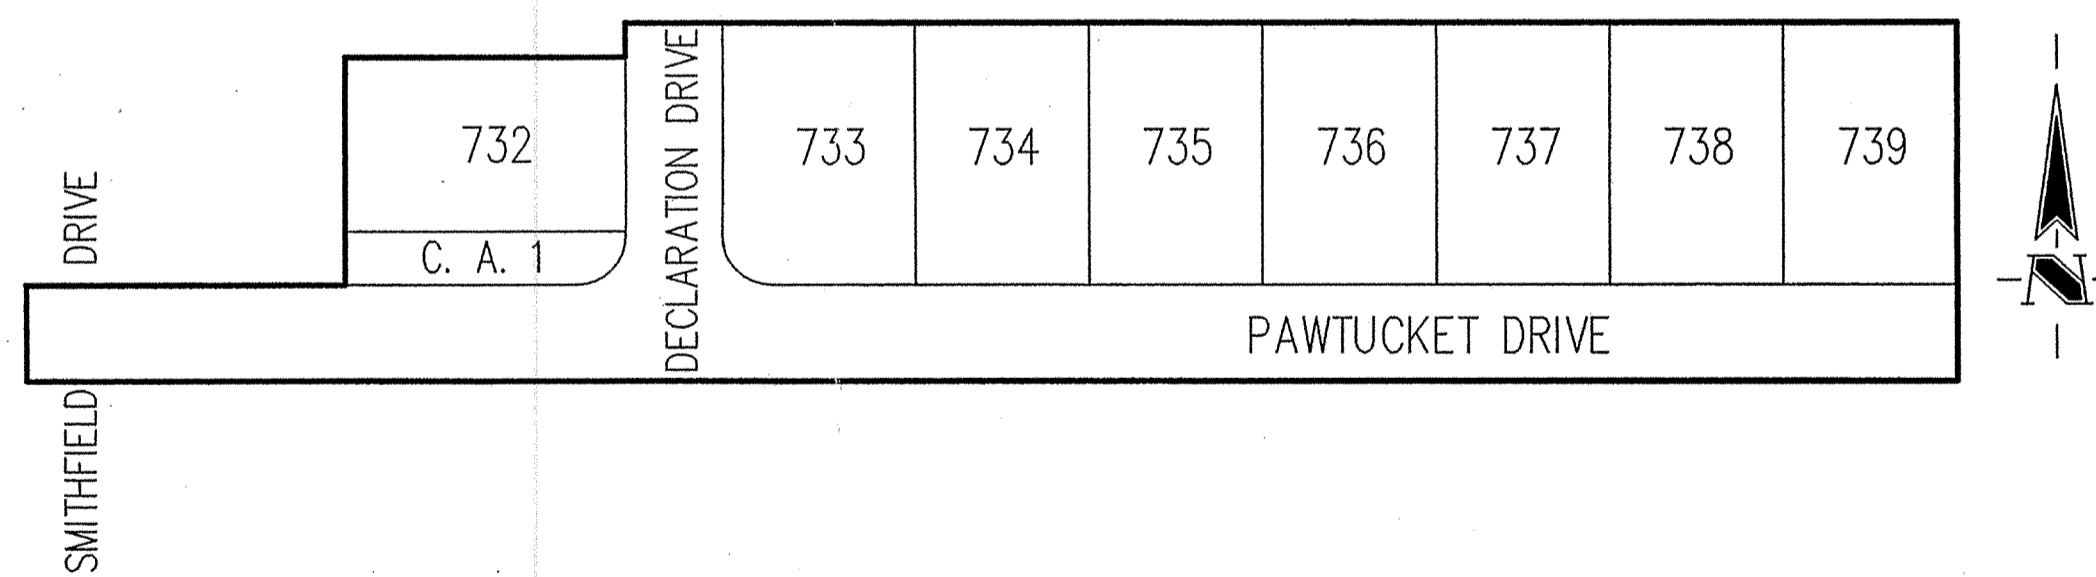

SITE MAP
SCALE: 1"=100'

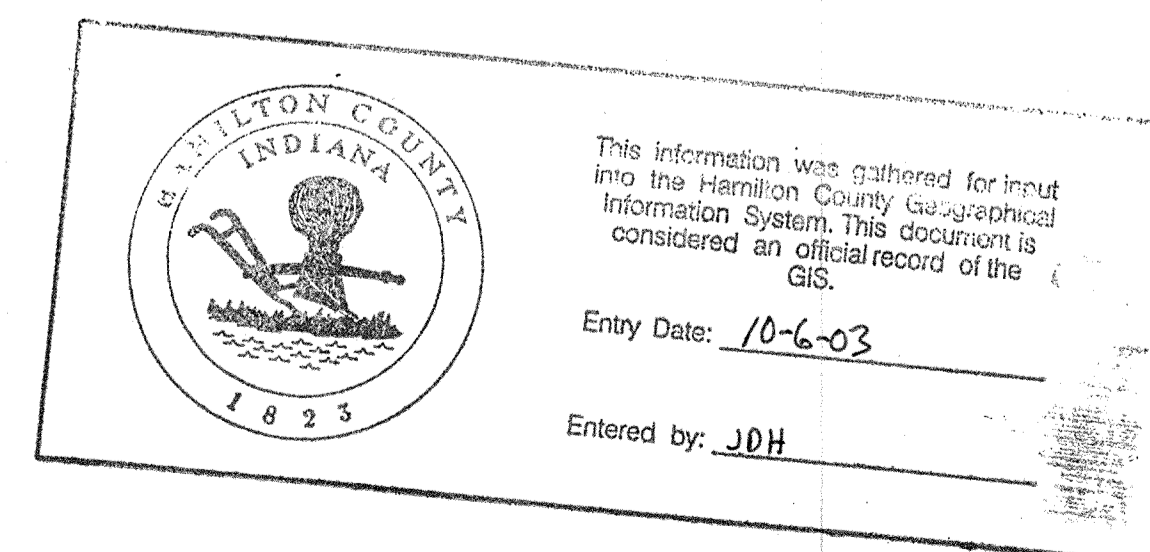

INDEX	
SHEET No.	DESCRIPTION
C100	COVER SHEET
C101	DEVELOPMENT PLAN
C102	EROSION CONTROL PLAN
C103	EROSION CONTROL DETAILS
C201	STREET PLAN
C301	TRAFFIC CONTROL PLAN
C401	SANITARY SEWER PLAN
C601	STORM SEWER PLAN
C701	WATER DISTRIBUTION PLAN
C702	WATER DISTRIBUTION DETAILS
C801-C804	GENERAL DETAILS
C901, C902	SPECIFICATIONS




Historic Fort Harrison Architecture
8901 Otis Avenue Civil Engineering
Indianapolis, Indiana Environmental Engineering
46216-1037 Geotechnical Services
317-826-7100 GIS * LIS
317-826-7200 Fax Home Builder Services
www.schneidercorp.com Interior Design
Land Surveying
Landscape Architecture
Transportation Engineering

J. Cort Crosby
CERTIFIED BY: J. CORT CROSBY, P.E.


E-MAIL ADDRESS: ccrosby@schneidercorp.com

REVISIONS:		
DATE	BY	DESCRIPTION
05/03/02	PRC	C100, C101, C102, C201, C301, C401, C601 & C701.

PROJECT ENGINEER: JCC
CHECKED BY: JCC DATE CHECKED: 4/15/02

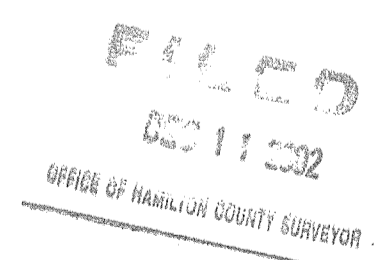

THESE DOCUMENTS ARE SUBJECT TO PERIODIC REVISIONS BY THE SCHNEIDER CORPORATION. THE HOLDER IS RESPONSIBLE FOR VERIFYING THAT THESE DOCUMENTS ARE THE MOST CURRENT PRIOR TO USE.

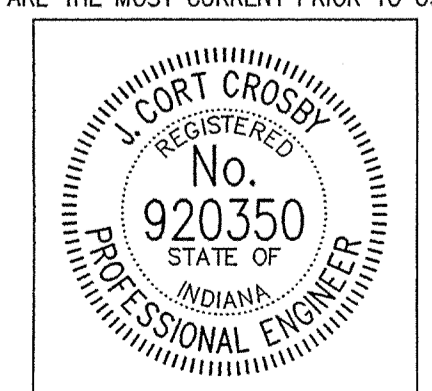

DATE: 12/6/02

RECORD DRAWING

NOT APPLICABLE
SEE PROFILE SHEETS

① SANITARY SEWER

STR #	STA BASELINE	OFFSET	LT/RT	TYPE	TC	INVERTS
E124				MANHOLE	900.00	898.72 (E), 898.63 (N), EX-898.63 (S)
177	23+14.80 "H"	28.00'	RT	MANHOLE	900.00	900.33 (E), 900.23 (W)
178	20+44.80 "H"	28.00'	RT	MANHOLE	900.00	901.54 (W)
179	26+47.79 "H"	292.00'	RT	MANHOLE	900.00	900.02 (E), 899.92 (N), 899.82 (S)

② STORM SEWER TABLE

STR #	STA BASELINE	OFFSET	LT/RT	TYPE	TC	INVERTS
E559				EX. BEEHIVE INLET	907.59	EX-903.24 (S), EX-903.24 (E), EX-903.24 (N)
545	19+09.00 "H"	160.00'	RT	END SECTION		902.12
546	20+78.79 "H"	160.00'	RT	BEEHIVE INLET	907.60	902.29 (WAE)
551	24+91.84 "H"	160.24'	RT	BEEHIVE INLET	908.20	902.70 (E), EX-902.70 (W), EX-903.43 (S)

UTILITIES - WESTFIELD

GAS

Indiana Gas Company
505 West Dr. 125 S.
Lebanon, Indiana 46052
(317) 482-6456
Attn: Jeff Aubry

TELEPHONE

Phone, Cable TV, Internet
E.COM
750 Liberty Drive
Westfield, Indiana 46074

SANITARY SEWERS AND WATER
TOWN OF WESTFIELD - WESTFIELD UTILITIES

2706 East 171st Street
Westfield, Indiana 46074
(317) 896-5452

ELECTRIC

P. S. I. Energy
P.O. Box 876
Carmel, Indiana 46032
(317) 581-3041
Attn: Mark La Barr

Utility Hotline: within Indiana 1-800-382-5544
outside Indiana 1-800-428-5200

NOTE

The size and location of utilities are per plans and locations provided by the respective utility companies. All utility companies shall be notified prior to any excavation for field location of services.

LEGEND

- Sub-surface Drain Marker
- Existing Storm Sewer
- New Storm Sewer
- Existing Sanitary Sewer
- New Sanitary Sewer
- Existing Contour
- New Pavement Grade
- All Other Finish Grades
- Storm Structure Number
- Sanitary Structure Number
- Flow Arrow
- Denotes Elevation and Approximate Pad Size



"IT'S THE LAW"
CALL 2 WORKING DAYS BEFORE YOU DIG
1-800-382-5544
CALL TOLL FREE
PER INDIANA STATE LAW IS-69-1991.
IT IS AGAINST THE LAW TO EXCAVATE
WITHOUT NOTIFYING THE UNDERGROUND
LOCATION SERVICE TWO (2) WORKING
DAYS BEFORE COMMENCING WORK.

ASSUMED NORTH
SCALE: 1"=50'

BENCHMARK

BM - U.S.G.S. 93 RHP (1951)
BRASS DISK IN CONCRETE POST S.W. CORNER OF 146TH AND
DITCH ROAD.
ELEV. = 903.373


TEM #9
R.R. SPIKE 1.3' UP NORTH SIDE OF MAPLE± S.E. CORNER SITE.
ELEV. = 908.39

GENERAL NOTES

- ALL GRADES AT BOUNDARY SHALL MEET EXISTING GRADES.
- IT SHALL BE THE RESPONSIBILITY OF EACH SUBCONTRACTOR TO VERIFY ALL EXISTING UTILITIES AND CONDITIONS PERTAINING TO HIS PHASE OF WORK. IT SHALL ALSO BE THE SUBCONTRACTOR'S RESPONSIBILITY TO CONTACT THE OWNERS OF THE VARIOUS UTILITIES FOR PROPER STAKE LOCATION OF EACH UTILITY BEFORE WORK IS STARTED. THE SUBCONTRACTOR SHALL NOTIFY IN WRITING THE OWNER AND THE ENGINEER OF ANY CHANGES, OMISSIONS, OR ERRORS FOUND ON THESE PLANS OR IN FIELD BEFORE WORK IS STARTED OR RESUMED.
- STANDARD SPECIFICATIONS FOR THE TOWN OF WESTFIELD - WESTFIELD UTILITIES, SHALL APPLY FOR ALL SANITARY SEWERS.
- ANY PART OF THE SANITARY OR STORM SEWER TRENCHES RUNNING UNDER PAVED AREAS TO BE BACKFILLED WITH GRANULAR MATERIAL.
- THE SIZE AND LOCATION OF EXISTING UTILITIES SHOWN ARE PER INFORMATION PROVIDED BY THE RESPECTIVE UTILITY COMPANIES. ALL UTILITY COMPANIES SHOULD BE NOTIFIED PRIOR TO ANY EXCAVATION FOR FIELD LOCATION OF SERVICES.
- SERVICE WALKS SHALL BE NON-REINFORCED CONCRETE 4" THICK AND 4' IN WIDTH.
- CONCRETE SERVICE WALK ACROSS FRONTAGE OF EACH LOT TO BE CONSTRUCTED BY OTHERS.
- EXPANSION JOINTS ARE TO BE PLACED AT ALL WALK INTERSECTION AND BETWEEN WALKS AND PLATFORMS. SIDEWALK SCORES ARE TO BE EQUALLY SPACED BETWEEN EXPANSION JOINTS. CONTRACTION JOINTS AND PERPENDICULAR SIDEWALKS AT 5' INTERVALS OR LESS WITH A CONTRACTION JOINT EVERY 20' OR LESS.
- TEMPORARY TRAFFIC CONTROL DURING CONSTRUCTION TO CONFORM TO APPLICABLE LOCAL AND STATE STANDARDS.
- ALL CONSTRUCTION ACTIVITY ON THIS SITE TO BE PERFORMED IN COMPLIANCE WITH APPLICABLE O.S.H.A. STANDARDS FOR WORKER SAFETY.
- CONTRACTOR SHALL MINIMIZE DAMAGE TO EXISTING TREES.


CERTIFICATION FOR "RECORD DRAWING"

NOTE:
Record drawing certification for sub-surface drain marker location only.

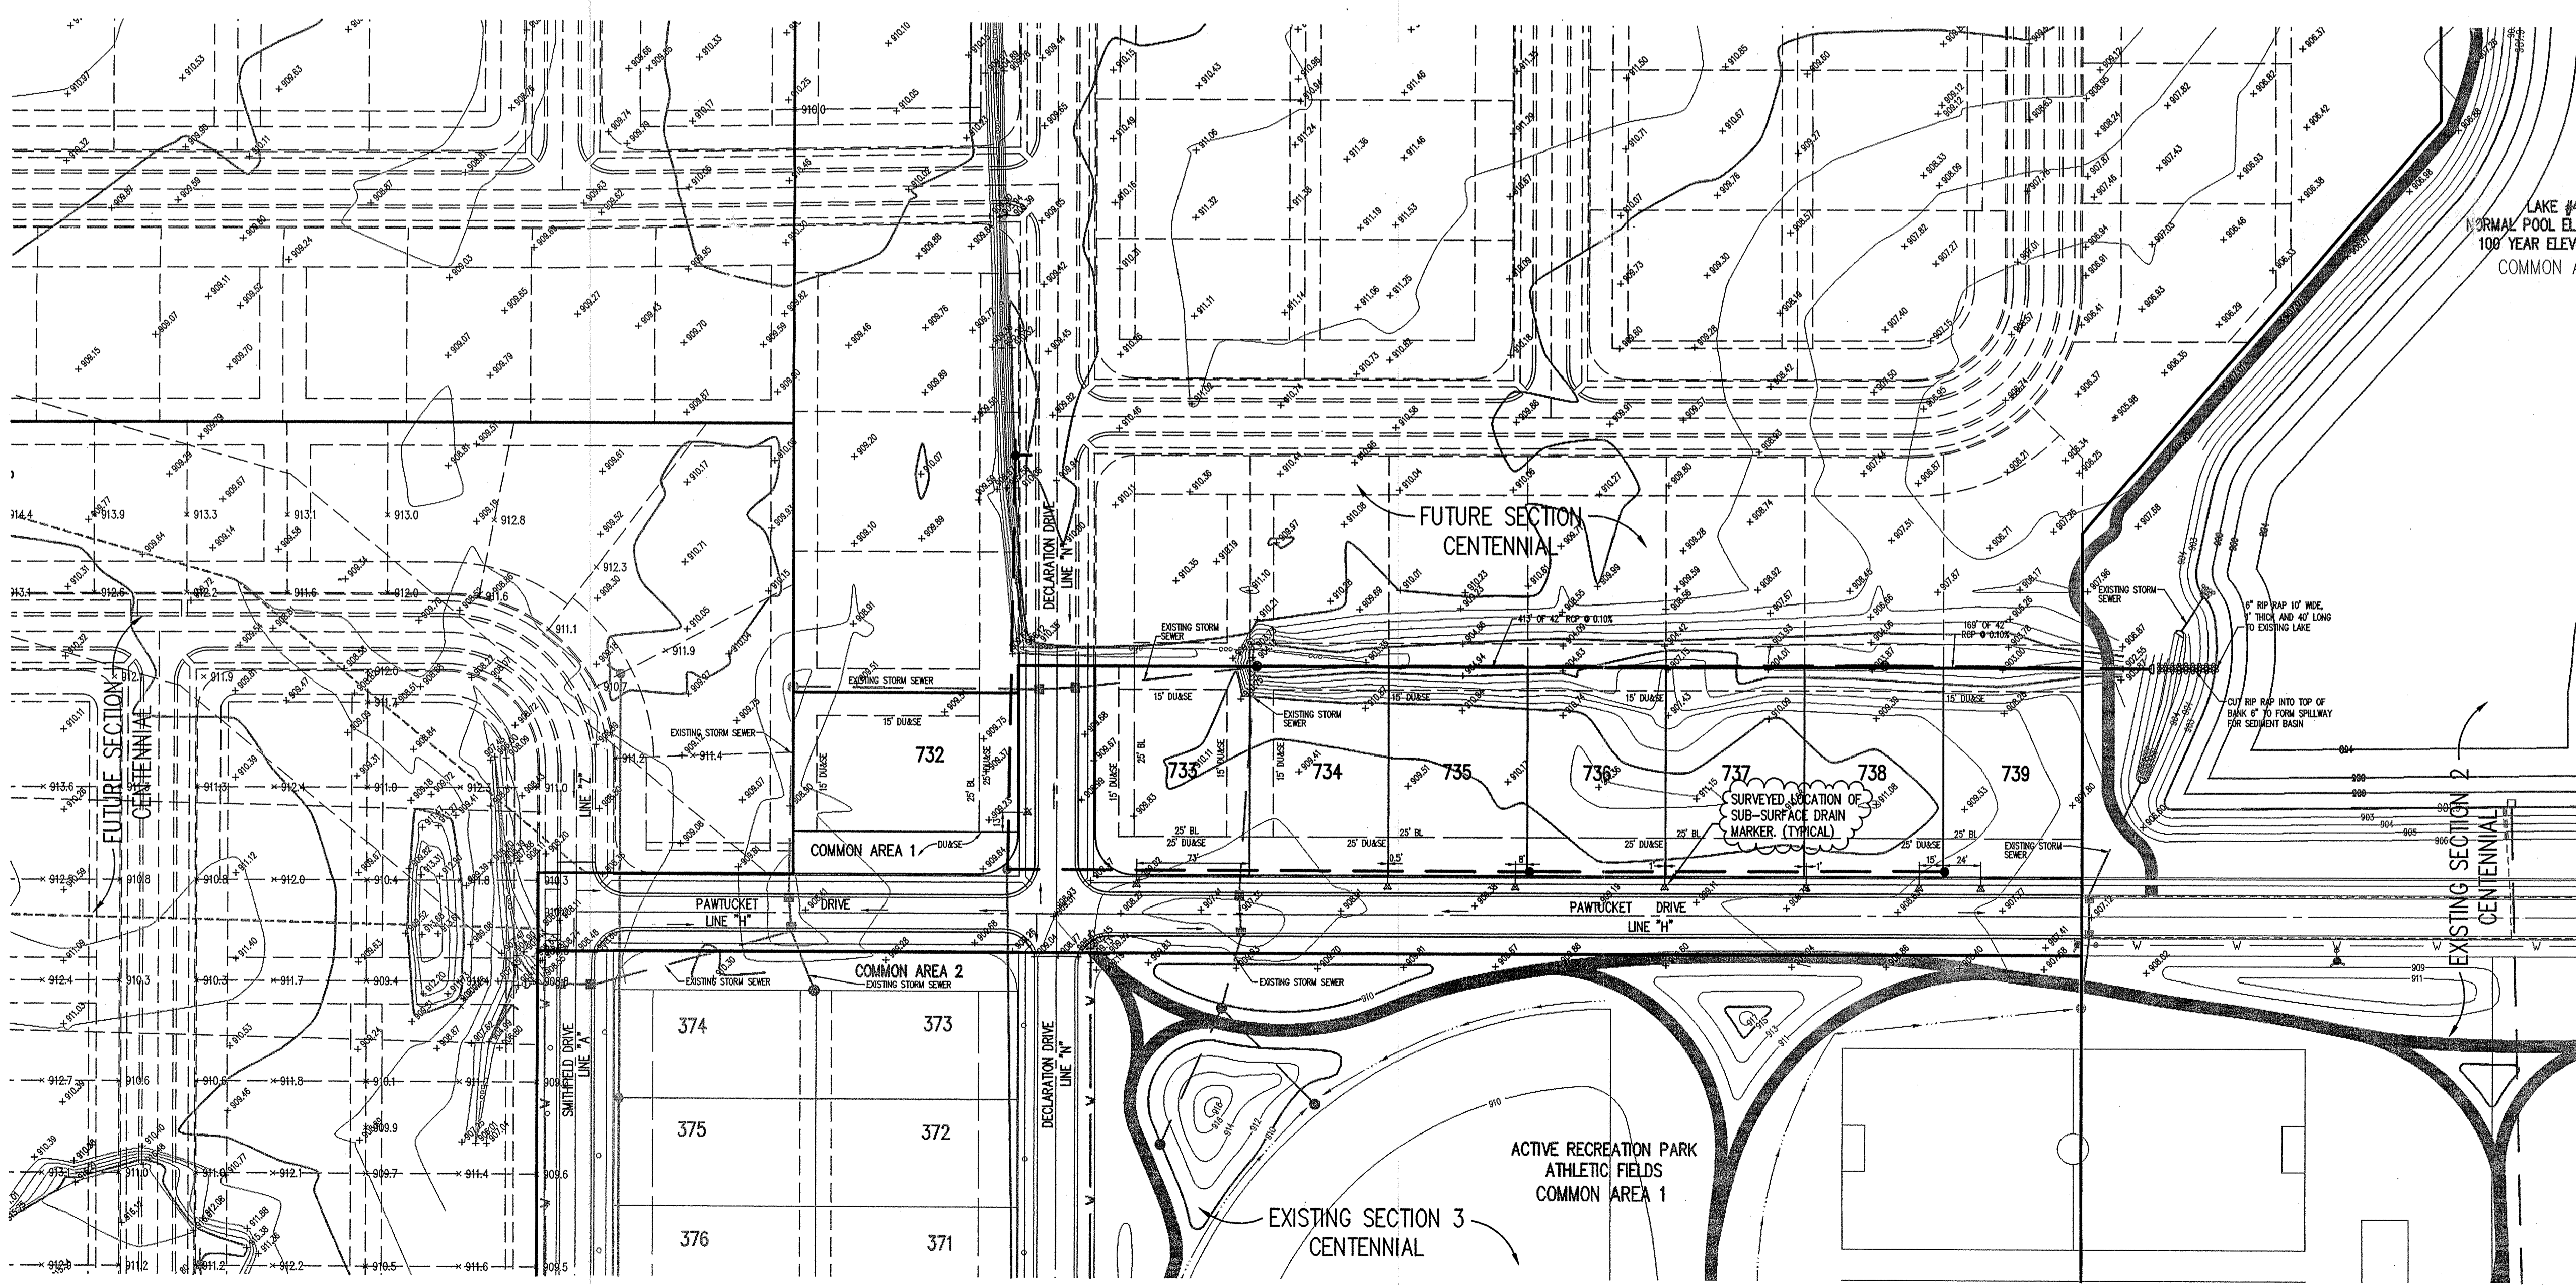

LAKE #4
NORMAL POOL ELE
100 YEAR ELEV=

SUB-SURFACE DRAIN
RECORD DRAWING

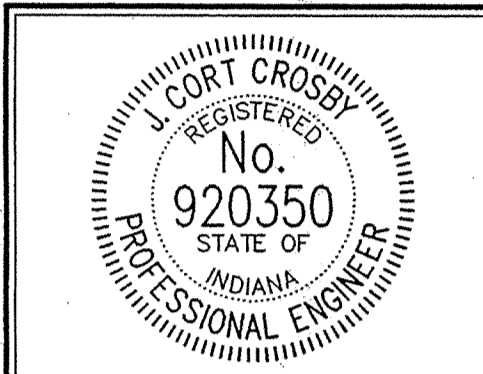

DATE: 12/16/02
THIS DRAWING AND THE IDEAS, DESIGNS AND CONCEPTS CONTAINED HEREIN ARE THE EXCLUSIVE INTELLECTUAL PROPERTY OF THE SCHNEIDER CORPORATION, AND ARE NOT TO BE USED OR REPRODUCED, IN WHOLE OR IN PART, WITHOUT THE WRITTEN CONSENT OF THE SCHNEIDER CORPORATION.
© COPYRIGHTED BY THE SCHNEIDER CORP. (2002)

THE SCHNEIDER CORPORATION
Historic Fort Harrison
8901 Otis Avenue
Indianapolis, IN 46216-1037
Telephone: 317.828.7100
Fax: 317.826.7200
www.schneidercorp.com


Architecture
Civil Engineering
Environmental Engineering
Geotechnical Services
GIS + LIS
Home + LIS
Interior Design
Land Surveying
Landscape Architecture
Transportation Engineering

CENTENNIAL SECTION 7

WESTFIELD, INDIANA

ESTRIDGE DEVELOPMENT CO., INC.
CARMEL, INDIANA

DATE: 04/16/02	PROJECT NO: 753.027
DRAWN BY: DRP	CHECKED BY: JCC
SHEET TITLE: SUBSURFACE DRAIN ASBUILT	
DRAWING FILES: R:\753\027\DWGS\C101 XREF: 027BS XREF: 027-TABS XREF: R:\753\028\DWGS\028BS XREF: R:\753\029\DWGS\029BS XREF: R:\753\030\DWGS\030BS XREF: R:\753\031\DWGS\031BS XREF: R:\753\032\DWGS\032BS XREF: R:\753\033\DWGS\033BS XREF: R:\753\034\DWGS\034BS XREF: R:\753\035\DWGS\035BS XREF: R:\753\036\DWGS\036BS XREF: R:\753\037\DWGS\037BS XREF: R:\753\038\DWGS\038BS XREF: R:\753\039\DWGS\039BS XREF: R:\753\040\DWGS\040BS XREF: R:\753\041\DWGS\041BS XREF: R:\753\042\DWGS\042BS XREF: R:\753\043\DWGS\043BS XREF: R:\753\044\DWGS\044BS XREF: R:\753\045\DWGS\045BS XREF: R:\753\046\DWGS\046BS XREF: R:\753\047\DWGS\047BS XREF: R:\753\048\DWGS\048BS XREF: R:\753\049\DWGS\049BS XREF: R:\753\050\DWGS\050BS XREF: R:\753\051\DWGS\051BS XREF: R:\753\052\DWGS\052BS XREF: R:\753\053\DWGS\053BS XREF: R:\753\054\DWGS\054BS XREF: R:\753\055\DWGS\055BS XREF: R:\753\056\DWGS\056BS XREF: R:\753\057\DWGS\057BS XREF: R:\753\058\DWGS\058BS XREF: R:\753\059\DWGS\059BS XREF: R:\753\060\DWGS\060BS XREF: R:\753\061\DWGS\061BS XREF: R:\753\062\DWGS\062BS XREF: R:\753\063\DWGS\063BS XREF: R:\753\064\DWGS\064BS XREF: R:\753\065\DWGS\065BS XREF: R:\753\066\DWGS\066BS XREF: R:\753\067\DWGS\067BS XREF: R:\753\068\DWGS\068BS XREF: R:\753\069\DWGS\069BS XREF: R:\753\070\DWGS\070BS XREF: R:\753\071\DWGS\071BS XREF: R:\753\072\DWGS\072BS XREF: R:\753\073\DWGS\073BS XREF: R:\753\074\DWGS\074BS XREF: R:\753\075\DWGS\075BS XREF: R:\753\076\DWGS\076BS XREF: R:\753\077\DWGS\077BS XREF: R:\753\078\DWGS\078BS XREF: R:\753\079\DWGS\079BS XREF: R:\753\080\DWGS\080BS XREF: R:\753\081\DWGS\081BS XREF: R:\753\082\DWGS\082BS XREF: R:\753\083\DWGS\083BS XREF: R:\753\084\DWGS\084BS XREF: R:\753\085\DWGS\085BS XREF: R:\753\086\DWGS\086BS XREF: R:\753\087\DWGS\087BS XREF: R:\753\088\DWGS\088BS XREF: R:\753\089\DWGS\089BS XREF: R:\753\090\DWGS\090BS XREF: R:\753\091\DWGS\091BS XREF: R:\753\092\DWGS\092BS XREF: R:\753\093\DWGS\093BS XREF: R:\753\094\DWGS\094BS XREF: R:\753\095\DWGS\095BS XREF: R:\753\096\DWGS\096BS XREF: R:\753\097\DWGS\097BS XREF: R:\753\098\DWGS\098BS XREF: R:\753\099\DWGS\099BS XREF: R:\753\100\DWGS\100BS	
SHEET NO: C101	

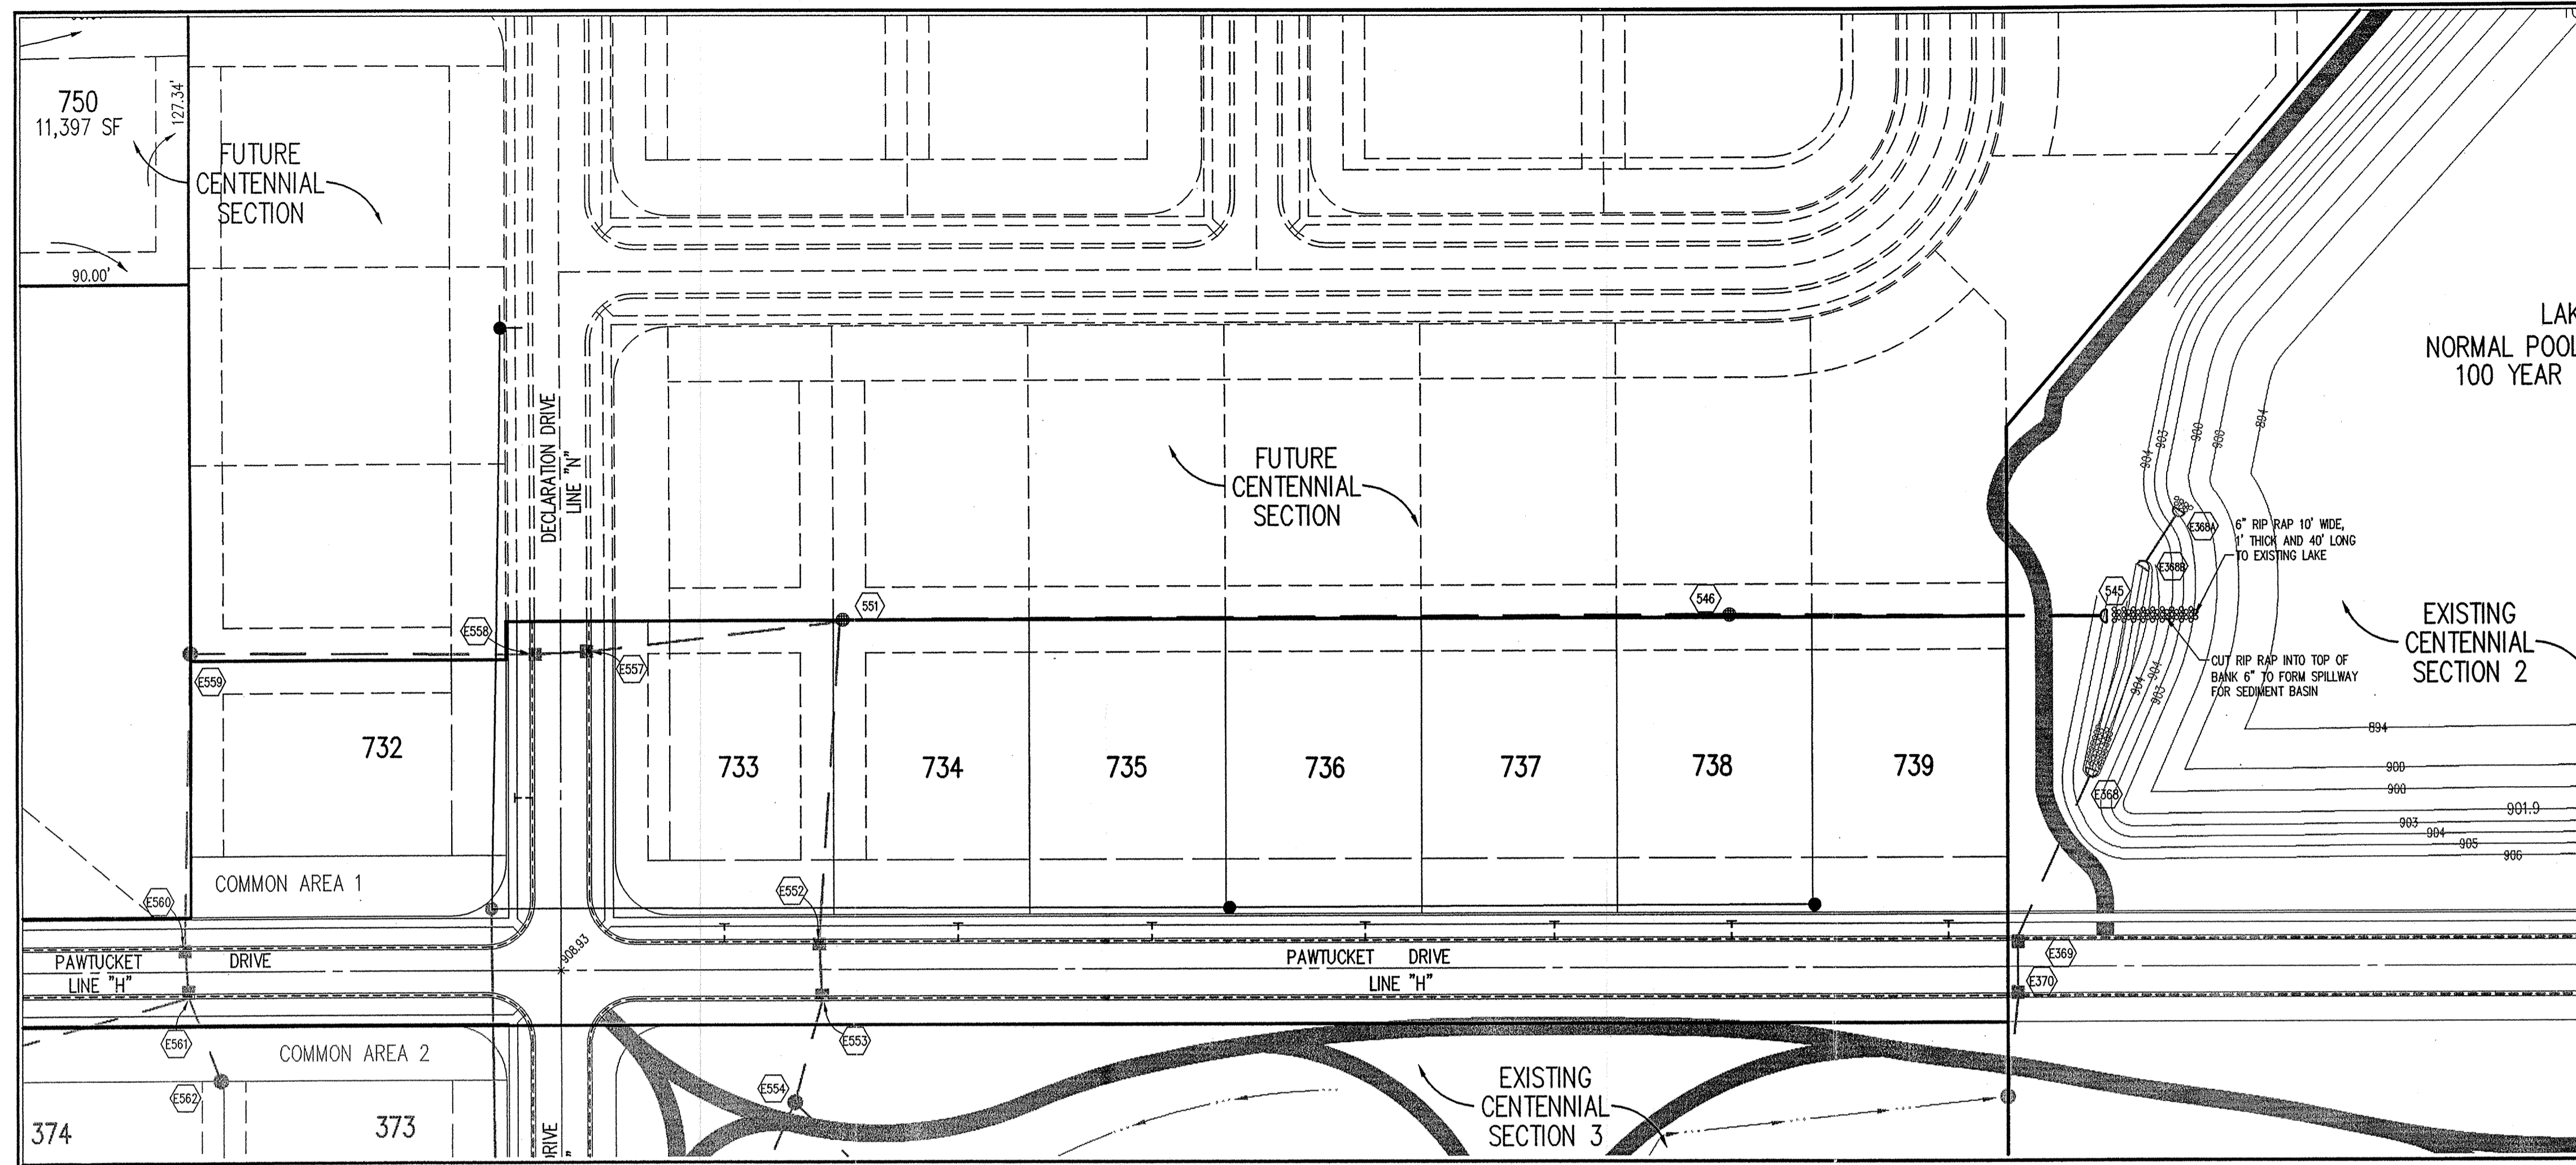

LAKE #4
NORMAL POOL ELEV. 901.90
100 YEAR ELEV. 906.33

GENERAL NOTES

1. TEMPORARY TRAFFIC CONTROL DURING CONSTRUCTION TO CONFORM TO APPLICABLE LOCAL AND STATE STANDARDS.
2. ALL CONSTRUCTION ACTIVITY ON THIS SITE TO BE PERFORMED IN COMPLIANCE WITH APPLICABLE O.S.H.A. STANDARDS FOR WORKER SAFETY.
3. IT SHALL BE THE CONTRACTORS RESPONSIBILITY TO FIELD VERIFY ALL UTILITY LOCATIONS BEFORE CONSTRUCTION BEGINS.
4. CONTRACTORS SHALL MINIMIZE DAMAGE TO EXISTING TREES.

HOLEY MOLEY SAYS
"DON'T DIG BLIND"



"IT'S THE LAW"
CALL 2 WORKING DAYS BEFORE YOU DIG
1-800-382-5544
CALL TOLL FREE

PER INDIANA STATE LAW IS-69-1991,
IT IS AGAINST THE LAW TO EXCAVATE
WITHOUT NOTIFYING THE UNDERGROUND
LOCATION SERVICE TWO (2) WORKING
DAYS BEFORE COMMENCING WORK.




CERTIFICATION FOR "RECORD DRAWING"

NOTE:
Record drawing certification for top of casting, invert elevations, and lengths of pipe only. Slope percentage represents a calculated figure and is for general information only.

Sheet	Sheet Number	Description
CB02	4	Bedding Detail - Reinforced Concrete Pipe (RCP)
CB02	1	Roll Curb Inlet Detail
CB02	2	Beehive Inlet Detail
CB02	3	Storm Manhole Detail
CB02	6	Precast Concrete End Section
CI03		RipRap Detail @ End Section

STORM SEWER PLAN

SCALE: 1"=50'

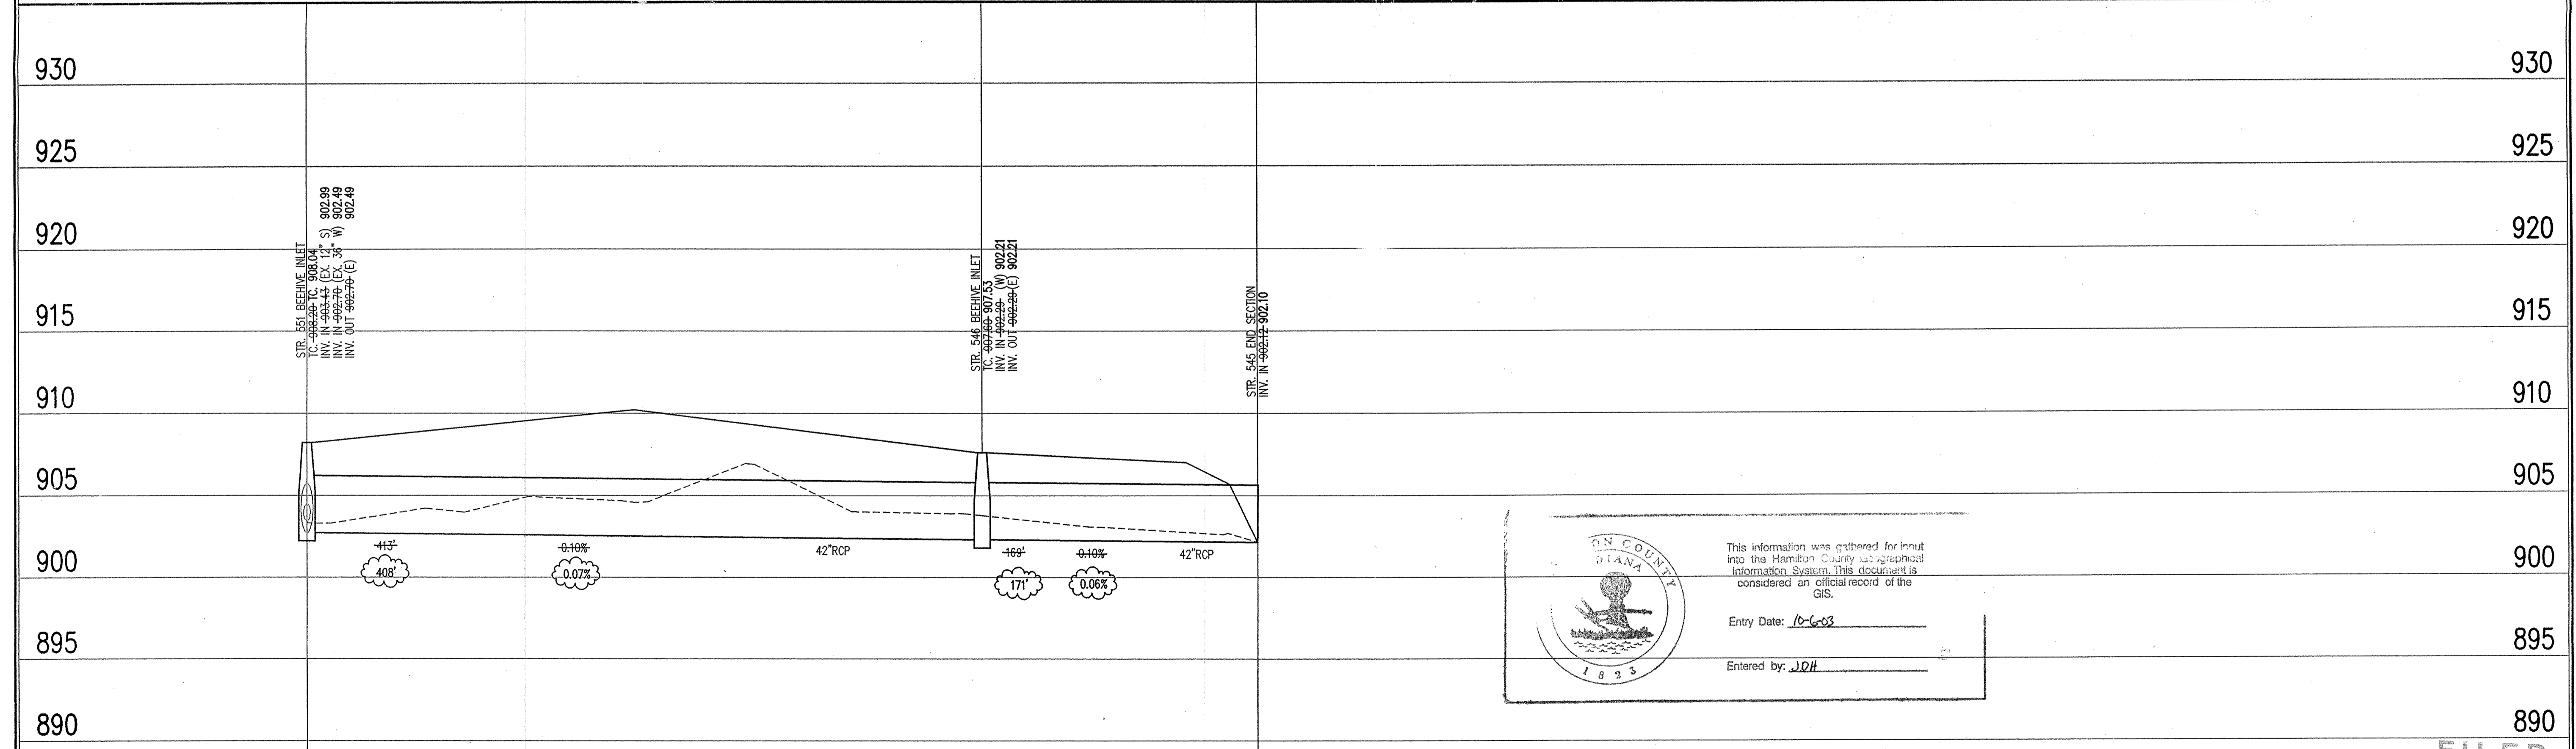

Hamilton County, Indiana
This information was gathered for input into the Hamilton County Geographical Information System. This document is considered an official record of the GIS.

Entry Date: 10-6-03
Entered by: JPH

REVISIONS:
1. L.P.C. 05/05/02 UPDATED PLAN VIEW.
2. DRP 12/05/02 STORM SEWER RECORD DRAWING.

COURT CROSS REGISTERED
No. 920350
STATE OF INDIANA
PROFESSIONAL ENGINEER

DATE: 12/14/02

THIS DRAWING AND THE IDEAS, DESIGNS AND CONCEPTS CONTAINED HEREIN ARE THE EXCLUSIVE INTELLECTUAL PROPERTY OF THE SCHNEIDER CORPORATION, AND ARE NOT TO BE USED OR REPRODUCED, IN WHOLE OR IN PART, WITHOUT THE WRITTEN CONSENT OF THE SCHNEIDER CORPORATION.

© COPYRIGHTED BY THE SCHNEIDER CORP. (2002)

Schneider

THE SCHNEIDER CORPORATION
Historic Fort Harrison
8901 Otis Avenue
Indianapolis, IN 46216-1037
Telephone: 317.826.7100
Fax: 317.826.7300
www.schneidercorp.com

Architecture
Civil Engineering
Environmental Engineering
Geotechnical Services
GIS * LIS
Home Builder Services
Interior Design
Land Surveying
Landscape Architecture
Transportation Engineering

CENTENNIAL SECTION 7

WESTFIELD, INDIANA

ESTRIDGE DEVELOPMENT CO., INC.
CARMEL, INDIANA

DATE: 04/16/02	PROJECT NO.: 753.027
DRAWN BY: DRP	CHECKED BY: JCC
SHEET TITLE: STORM SEWER PLAN	
DRAWING FILES: R:\753\027\DWG\001 R:\753\027\DWG\STORM R:\753\027\DWG\027B5 R:\753\028\DWG\028B5 R:\753\029\DWG\029B5 R:\753\030\DWG\030B5	
SHEET NO.: C601	

STORM SEWER RECORD DRAWING

FILED
DEC 11 2002
OFFICE OF HAMILTON COUNTY SURVEYOR

STORM SEWER PROFILE

LEGEND

	Existing Grade
	New Grade
	Granular Backfill

SCALE: HORZ.: 1"=50'
VERT.: 1"=5'

This copy is from the Digital Archive of the Hamilton County Surveyor's Office, Noblesville, IN 46060