

Drain: JOHN OSBORN DRAIN **Drain #:** 162
Improvement/Arm: KINGSMILL - SECTION 2
Operator: JOH **Date:** 6-2-04
Drain Classification: Urban/Rural **Year Installed:** 1994

GIS Drain Input Checklist

- Pull Source Documents for Scanning JA
- Digitize & Attribute Tile Drains N/A
- Digitize & Attribute Storm Drains JA
- Digitize & Attribute SSD JA
- Digitize & Attribute Open Ditch N/A
- Stamp Plans JA
- Sum drain lengths & Validate JA
- Enter Improvements into Posse JA
- Enter Drain Age into Posse JA
- Sum drain length for Watershed in Posse JA
- Check Database entries for errors JA

**Gasb 34 Footages for Historical Cost
Drain Length Log**


Drain-Improvement: JOHN OSBORN DRAIN - KINGSMILL - SECTION 4

Drain Type:	Size:	Length SURVEYORS REPORT	Length (DB Query)	Length Reconcile	If Applicable	
					Price:	Cost:
SSO	6"	7,748'	5,748'	-2,000'		
RCP	12"	557'	557'	∅		
	15"	164'	164'	∅		
	18"	971'	988'	+17'		
	21"	190'	190'	∅		
	24"	392'	392'	∅		
	27"	87'	87'	∅		

Sum: 10,009' 8,126' -1,983'

Final Report: _____

Comments:
SR AND AD DISAGREE ON 6" SSO AND 18" RCP LENGTHS

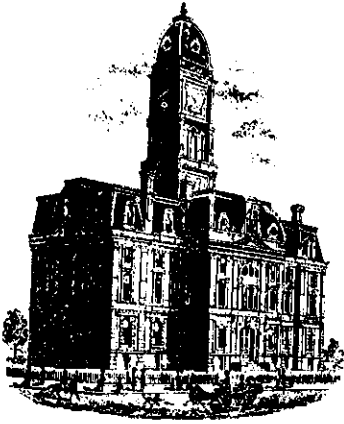

SURVEYOR'S OFFICE

Hamilton County

Kenton C. Ward, Surveyor

Suite 146

776-8495

One Hamilton County Square

Noblesville, Indiana 46060-2230

December 20, 1994

TO: Hamilton County Drainage Board

RE: John Osborn Drain-Kingsmill Section 1 Arm

Attached is a petition, non-enforcement request, plans, calculations, quantity summary and assessment roll for the Kingsmill, Section 1 Arm of the John Osborn Drain. I have reviewed the submittals and petition and have found each to be in proper form.

I have made a personal inspection of the land described in the petition. Upon doing so, I believe that the drain is practicable; will improve the public health; benefit a public highway and be of public utility; and that the costs, damages and expenses of the proposed drain will probably be less than the benefits accruing to the owners of land likely to be benefited. The drain will consist of the following:

6" SSD	7748 feet	21" RCP	190 feet
12" RCP	560 feet	24" RCP	392 feet
15" RCP	164 feet	27" RCP	87 feet
18" RCP	911 feet		

The total length of the drain will be 10,052 feet.

The retention pond (lake) located in Block C is not to be considered part of the regulated drain. Only the inlet and outlet will be maintained as part of the regulated drain. The maintenance of the pond (lake) will be the responsibility of the Homeowners Association. The Board will however, retain jurisdiction for ensuring the storage volume for which the lake was designed will be retained. Thereby, allowing no fill or easement encroachments.

The subsurface drains (SSD) to be part of the regulated drain are those located under the curbs and those main lines between lots or in rear yards. Only the main SSD lines which are located within the easement/right of way are to be maintained as regulated drain. Laterals for individual lots will not be considered part of the regulated drain.


I have reviewed the plans and believe the drain will benefit each lot equally. Therefore, I recommend each lot be assessed equally. I also believe that no damages will result to landowners by the construction of this drain. I recommend a maintenance assessment of \$25.00 per lot, \$2.00 per acre for roadways, with a \$25.00 minimum. With this assessment the total annual assessment for this section will be \$ 828, 44

Parcels assessed for this drain may be assessed for the Williams Creek, Osborn-Collins or Springmill Run Drains at sometime in the future. Lots 41, 42, 43 1, 3 and 4, assessed for this drain will also be assessed for the Fitch and Jessup Drain.

I believe this proposed drain meets the requirements for Urban Drain Classification as set out in IC 36-9-27-67 to 69. Therefore, this drain shall be designated as an Urban Drain.

I recommend that upon approval of the above proposed drain that the Board also approve the attached non-enforcement request. This request is for the reduction of the regulated drain easement to those easement widths as shown on the secondary plat for Kingsmill Section 1 as recorded in the office of the Hamilton County Recorder.

I recommend the Board set a hearing for this proposed drain for February 1995.

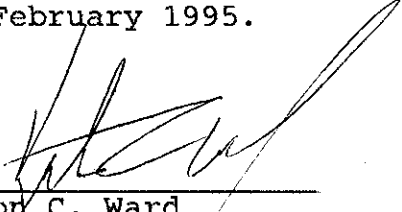

Kenton C. Ward
Hamilton County Surveyor
KCW/no

TO: HAMILTON COUNTY DRAINAGE BOARD
Hamilton County Surveyor, Courthouse, Noblesville, IN 46060

In the matter of Kingsmill Subdivision,
Section One Drain Petition.

Petitioner is the owner of all lots in the land affected by the proposed new regulated drain. The drainage will affect various lots in Kingsmill, a subdivision in Hamilton County, Indiana. The general route of such drainage shall be in existing easements and along public roads as shown in the plans on file in the Surveyor's Office.

Petitioner believes that the cost, damages and expenses of the proposed improvement will be less than the benefits which will result to the owners of the land likely to be benefited thereby. Petitioner believes the proposed improvements will:

- (a) improve public health
- (b) benefit a public street
- (c) be of public utility

Petitioner agrees to pay the cost of construction of the drainage system and requests periodic maintenance assessments by the Board thereafter.

The Petitioner also agrees to the following:

1. To provide the Drainage Board a Performance Bond for the portion of the drainage system which will be made a regulated drain. The bond will be in the amount of 100% of the Engineers estimate. The bond will be in effect until construction of 100% of the system is completed and so certified by the Engineer.
2. The Petitioner shall retain an Engineer throughout the construction phase. At completion of the project the Petitioner's Engineer shall certify that the drainage system which is to be maintained as a regulated drain has been constructed as per construction plans.

3. The Petitioner agrees to request in writing to the County Surveyor any changes from the approved plan and must receive written authorization from the County Surveyor prior to implementation of the change. All changes shall be documented and given to the Surveyor to be placed in the Drain File.

4. The Petitioner shall instruct his Engineer to provide a reproducible print on a 24" x 36" mylar of the final design of the Drainage System. This shall be submitted to the County Surveyor prior to the release of the Performance Bond.

5. The Petitioner shall comply with the Erosion Control Plan as as specified on the construction plans. Failure to comply with the Erosion Control Plan shall be determined by the Board as being an obstruction to the drainage system. The County Surveyor shall immediately install or repair the needed measures at Petitioners cost as per IC 36-9-27-46.

The Petitioner further requests that the Drain be classified as an Urban Drain.

Steven A. Wilson *Secretary*
 Signed _____

STEVEN A. WILSON
 Printed Name _____

Signed _____

Printed Name _____

RECORDED OWNER(S) OF LAND INVOLVED

DATE _____

BEFORE THE HAMILTON COUNTY DRAINAGE BOARD


IN THE MATTER OF THE John Osborn Drain-Kingsmill Arm

NOTICE

TO WHOM IT MAY CONCERN AND _____

Notice is hereby given of the Hearing of the Hamilton County Drainage Board on the John Osborn Drain-Kingsmill Arm ~~Drain~~, on February 27, 1995, at 9:30 A.M. in the Commissioners's Court, Hamilton County Judicial Center, One Hamilton County Square Noblesville, Indiana and which the Maintenance Report of the Board have been filed and are available for public inspection in the Office of the Hamilton County Surveyor.

Hamilton County Drainage Board

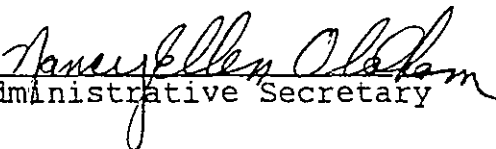ATTEST 
Administrative Secretary

ONE TIME ONLY

BEFORE THE HAMILTON
COUNTY DRAINAGE BOARD
IN THE MATTER OF THE


John Osborn Drain-Kingsmill Arm

NOTICE

Notice is hereby given pursuant to Section 405 of the 1965 Indiana Drainage Code that this Board, prior to final adjournment has issued an order adopting the Schedule of Assessments, filed the same and made public announcement thereof at the hearing and ordered publication. If judicial review of the findings and order of the Board is not requested pursuant to Article Eight of this code within twenty (20) days from the date of this publication, the order shall be conclusive.

HAMILTON COUNTY DRAINAGE BOARD

ATTEST:


Administrative Secretary

ONE TIME ONLY

STANDBY LETTER OF CREDIT

Letter of Credit No: 44333

Date: September 7, 1994

BENEFICIARY

HAMILTON COUNTY COMMISSIONER
Hamilton County Judicial Center
1 Hamilton County Square, Suite 157
Noblesville, IN 46060

FOR ACCOUNT OF

KINGSMILL CORPORATION
P.O. Box 649
Carmel, IN 46032

We hereby establish our Irrevocable Letter of Credit in your favor, for the account indicated above, for the sum or sums not exceeding an aggregate amount of USD12,900.00 (Twelve Thousand Nine Hundred U.S.Dollars.)

Funds are available by your draft(s) at sight drawn on National City Bank, Indiana Indianapolis, Indiana.

Drafts are to be accompanied by:


1. The original of this Letter of Credit No. 44333.
2. Signed Beneficiary's certificate stating that "Kingsmill Corporation has failed to complete the erosion control measures required in Kingsmill, Section 1.

All drafts drawn under this Letter of Credit are to be endorsed hereon and shall bear the clause: "Drawn under National City Bank, Indiana Indianapolis, Indiana Letter of Credit No. 44333", and must be drawn and presented at this office on or before June 1, 1995.


We hereby agree with you that all drafts drawn under and in compliance with the terms of this Letter of Credit will be duly honored upon proper presentation.

Except as otherwise expressly stated herein, this credit is subject to the Uniform Customs and Practice for Documentary Credits (1993 Revision), International Chamber of Commerce, Publication No.500.


Very truly yours,

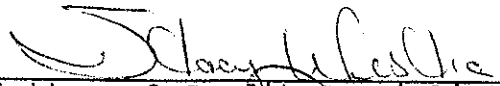

Letter of Credit Specialist I
BOARD OF COMMISSIONERS
OF THE COUNTY OF HAMILTON

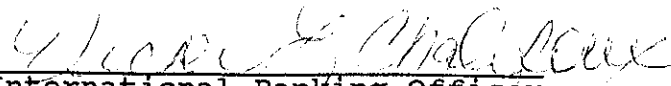

International Banking Officer
& Operations Manager

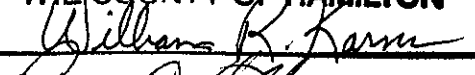

DATE 9.12.94

ATTEST: _____
HAMILTON COUNTY AUDITOR

STANDBY LETTER OF CREDIT

Letter of Credit No: 44306

Date: July 25, 1994

BENEFICIARY

HAMILTON COUNTY COMMISSIONER
HAMILTON COUNTY JUDICIAL CENTER
1 Hamilton County Square
Suite 157
Noblesville, IN 46060

FOR ACCOUNT OF

KINGSMILL CORPORATION
P.O. Box 649
Carmel, IN 46032

We hereby establish our Irrevocable Letter of Credit in your favor, for the account indicated above, for the sum or sums not exceeding an aggregate amount of USD114,400.00 (One Hundred Fourteen Thousand Four Hundred U.S.Dollars).

Funds are available by your draft(s) at sight drawn on National City Bank, Indiana Indianapolis, Indiana.

Drafts are to be accompanied by:


1. The original of this Letter of Credit No. 44306.
2. A signed beneficiary certificate stating that "Kingsmill Corporation has failed to complete the storm sewer or has failed to complete the sub-surface drain in Kings Mill, Section 1. More specifically storm sewer \$83,200.00 and sub-surface drain \$31,200.00".


All drafts drawn under this Letter of Credit are to be endorsed hereon and shall bear the clause: "Drawn under National City Bank, Indiana Indianapolis, Indiana Letter of Credit No. 44306", and must be drawn and presented at this office on or before July 31, 1995.


We hereby agree with you that all drafts drawn under and in compliance with the terms of this Letter of Credit will be duly honored upon proper presentation.

Except as otherwise expressly stated herein, this credit is subject to the Uniform Customs and Practice for Documentary Credits (1993 Revision), International Chamber of Commerce, Publication No.500.

Very truly yours,

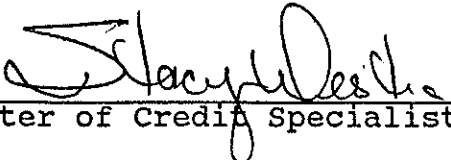
Letter of Credit Specialist I

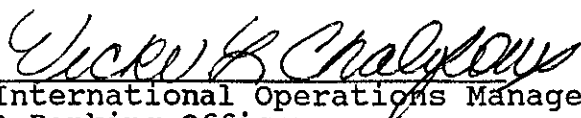
International Operations Manager
& Banking Officer

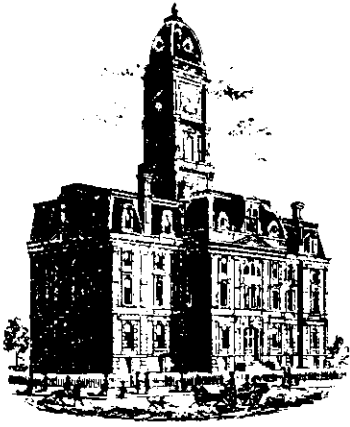

Kenton C. Ward, Surveyor

Phone (317) 776-8495

Fax (317) 776-9628

Suite 188

One Hamilton County Square

Noblesville, Indiana 46060-2230

Map Correction-Field Verification

Drain Number: #162

Drain Length: 8126

Drain Name: John Osborn: Kingsmill Sec. 1

Change +/-: -287

Date: 8-15-05

New Length: 7839


Verified By: SIM

Notes & Sketch:

SSD: Curb inlets at the entrance were incorrectly mapped. This portion was never taken in as regulated drain. It will be picked up in the future as part of the TOWNE lakes drain.

Suzanne L. Mills

GIS Specialist

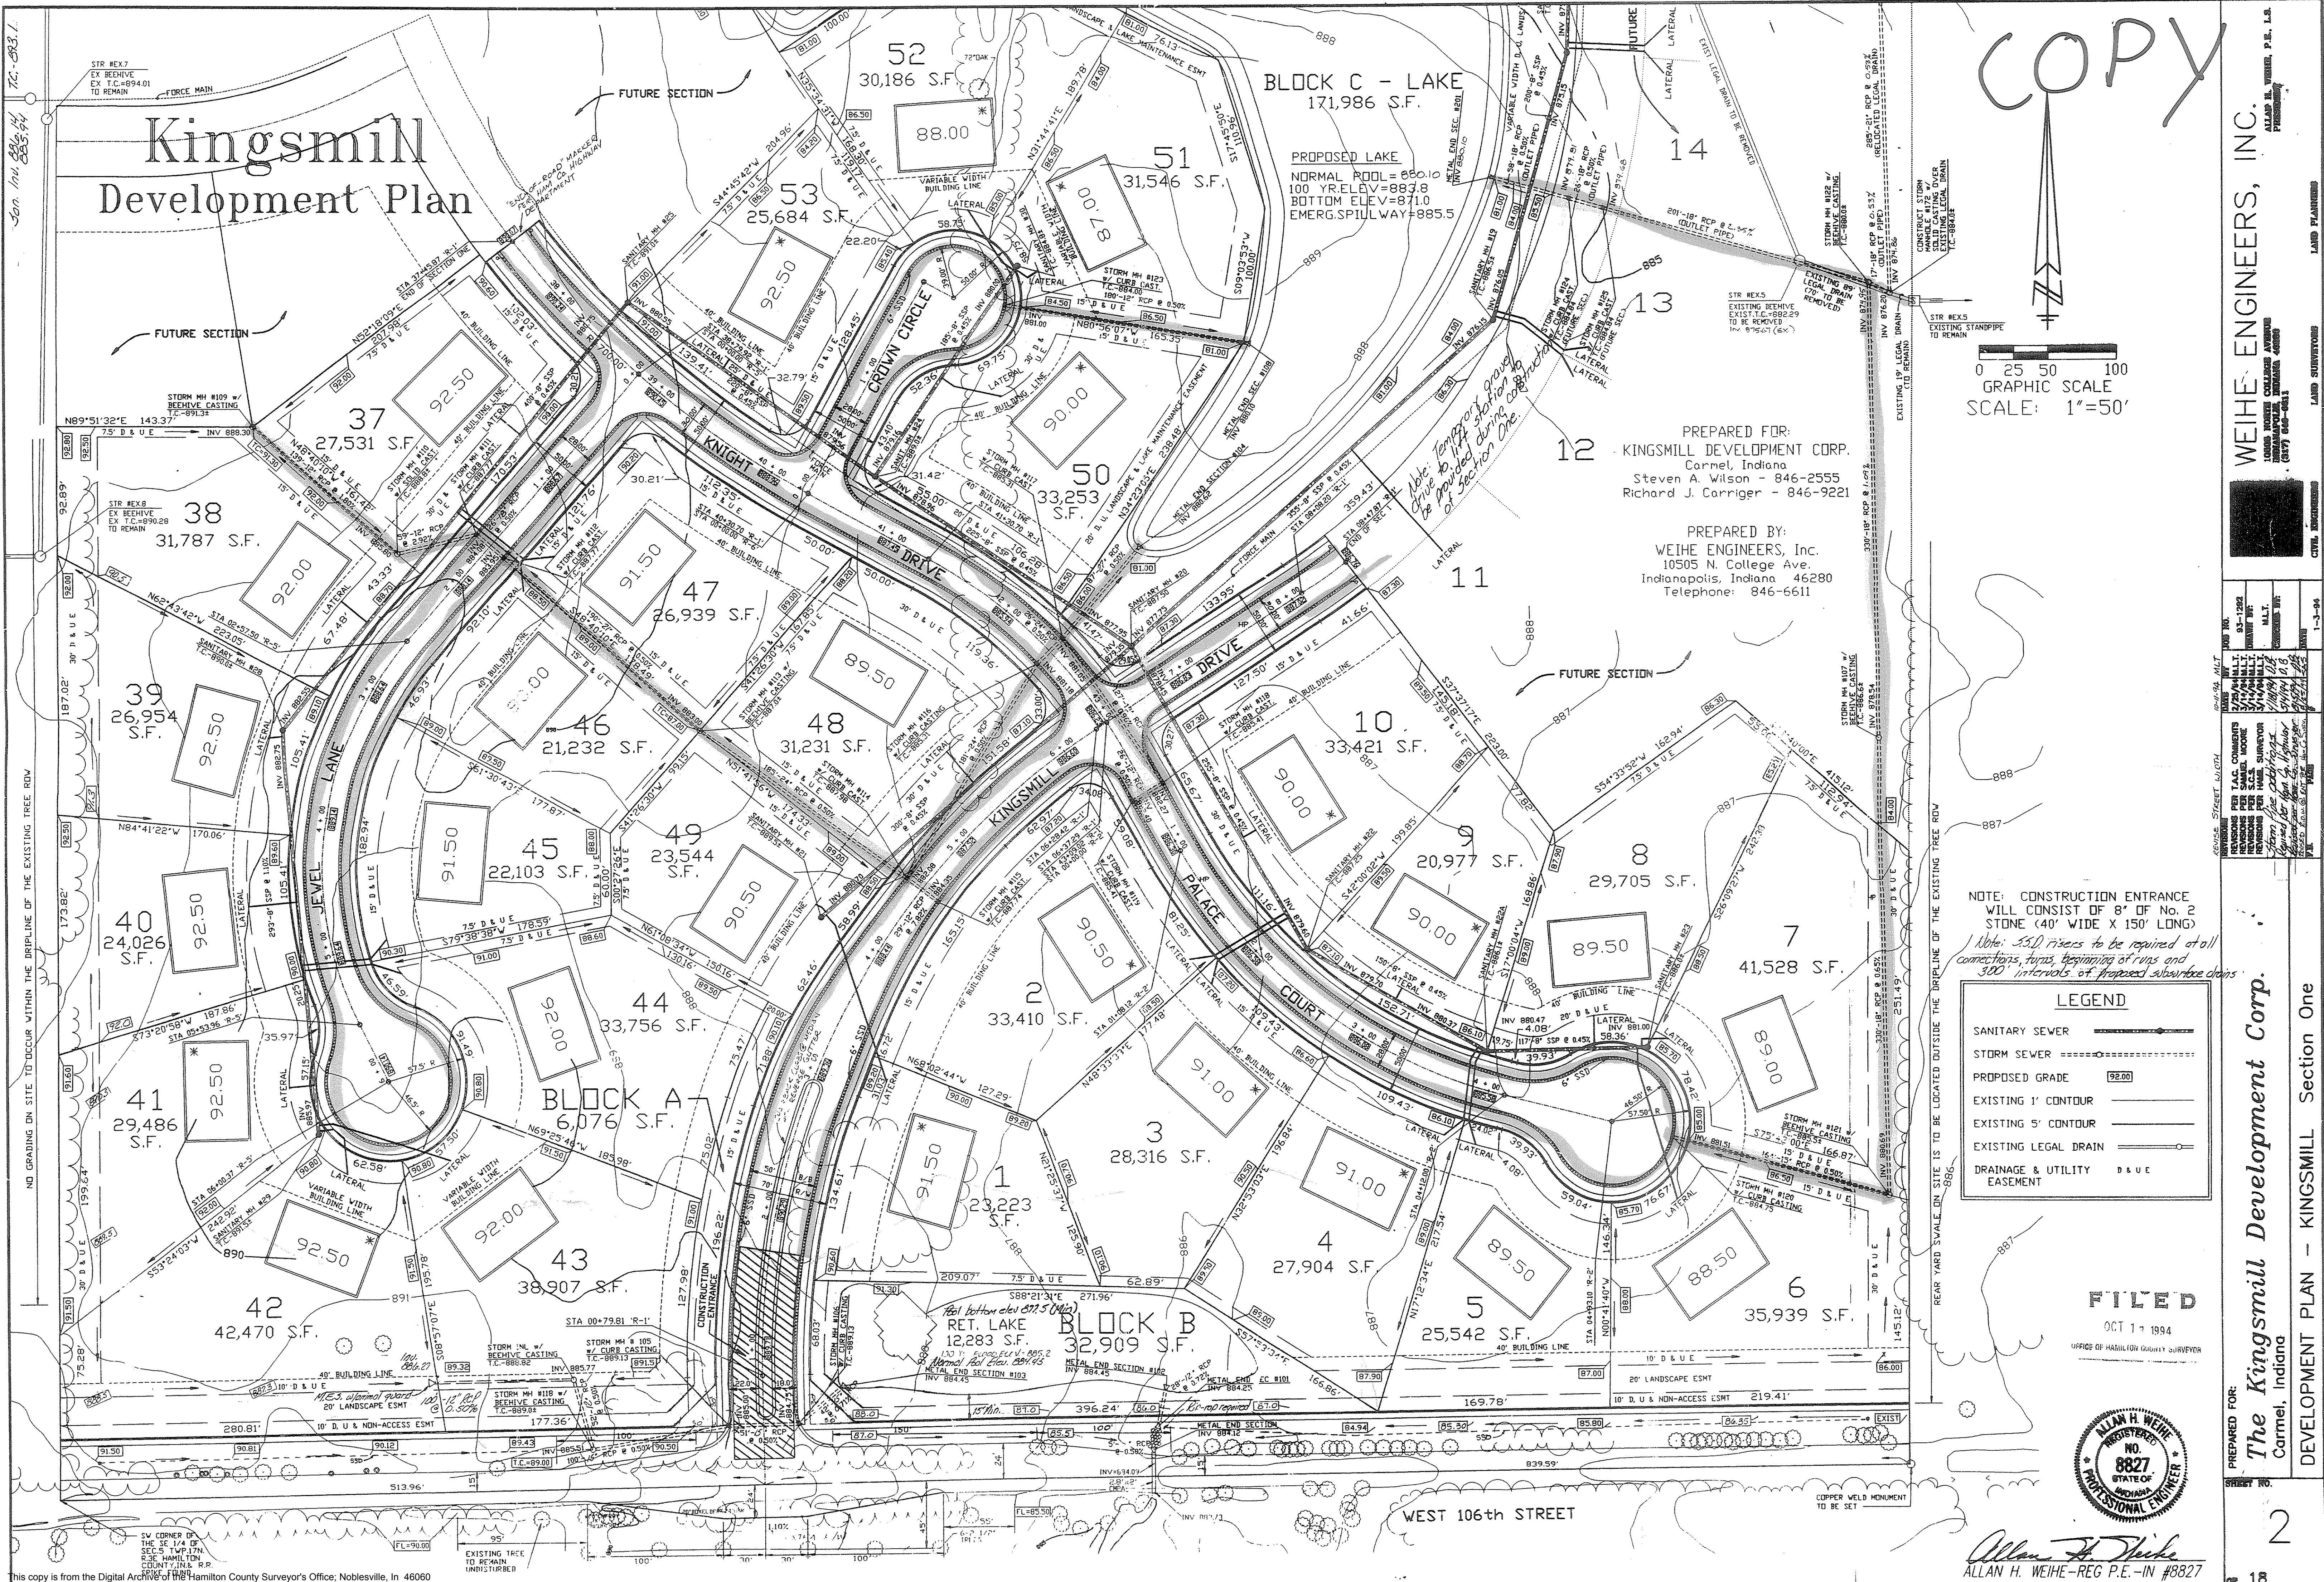

Kingsmill Development Plan

BLOCK C - LAKE
171,986 S.F.


BLOCK A
6,076 S.F.

BLOCK B
32,909 S.F.

PREPARED FOR:
KINGSMILL DEVELOPMENT CORP.
Carmel, Indiana
Steven A. Wilson - 846-2555
Richard J. Carriger - 846-9221

PREPARED BY:
WEIHE ENGINEERS, Inc.
10505 N. College Ave.
Indianapolis, Indiana 46280
Telephone: 846-6611

COPY

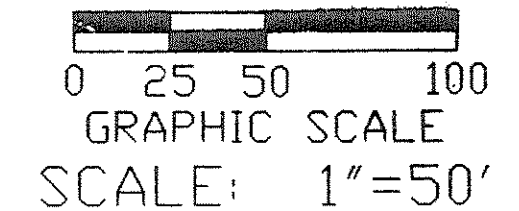

NOTE: CONSTRUCTION ENTRANCE WILL CONSIST OF 8' OF NO. 2 STONE (40' WIDE X 150' LONG)
Note: 35.0 risers to be repaired at all connections, turns, beginning of runs and 300' intervals of proposed subsurface drains

LEGEND	
SANITARY SEWER	—
STORM SEWER	----
PROPOSED GRADE	92.00
EXISTING 1' CONTOUR	—
EXISTING 5' CONTOUR	—
EXISTING LEGAL DRAIN	—
DRAINAGE & UTILITY EASEMENT	D & U

FILED
OCT 11 1994
OFFICE OF HAMILTON COUNTY SURVEYOR



Allan H. Weihe
ALLAN H. WEIHE-REG P.E.-IN #8827

WEIHE ENGINEERS, INC.
10505 N. COLLEGE AVE.
INDIANAPOLIS, INDIANA 46280
(317) 606-6611

LAND SURVEYORS
CIVIL ENGINEERS

PREPARED FOR:
The Kingsmill Development Corp.
Carmel, Indiana

DEVELOPMENT PLAN - KINGSMILL Section One

NO. 100-1222
DATE: 03-12-94
DRAWN BY: M.L.T.
CHECKED BY: M.L.T.
REVISIONS PER I.A.C. COMMENTS: 1/27/94 M.L.T. 1-3-94
REVISIONS PER S.C.S. WORK: 2/27/94 M.L.T.
REVISIONS PER H.A.M. SURVEYOR: 3/17/94 M.L.T.
Signed for legal purposes: 3/17/94 M.L.T.
I hereby certify that the above is a true and correct copy of the original as shown to me on 3/17/94.

2

18

This copy is from the Digital Archive of the Hamilton County Surveyor's Office; Noblesville, IN 46060



SURVEYOR'S OFFICE
Hamilton County

Kenton C. Ward, Surveyor

Suite 146

776-8495

One Hamilton County Square

Noblesville, Indiana 46060-2230

May 8, 1996

To: Hamilton County Drainage Board

Re: John Osborn Drain, Kingsmill Arm Section 1

Attached are as-builts, certificate of completion & compliance, and other information for Kingsmill Section 1. An inspection of the drainage facilities for this section has been made and the facilities were found to be complete and acceptable.

During construction, changes were made to the drain which will alter the plans submitted with my report for this drain dated December 20, 1994. The changes are as follows:

STR 115-114 consists of 12" RCP which was shortened from 29' feet to 26' feet.

STR 121-107 consists of 18" RCP which was lengthened from 300' feet to 330' feet.

STR 107-122 consists of 18" RCP which was lengthened from 300' feet to 330' feet.


The length of the drain due to the changes described above is now 10,109 feet.

The non-enforcement was approved by the Board at its meeting on February 29, 1995.





The bond or letter of credit from National City Bank, number #44333 for erosion control and #44306 for storm sewer, dated September 7, 1994 and July 25, 1994, in the amounts of \$12,900.00 and \$114,400 have been released.

I recommend the Board approve the drains construction as complete and acceptable.

Sincerely,

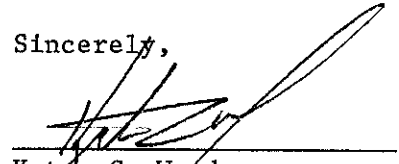
Kenton C. Ward
Hamilton County Surveyor





KCW/ndw

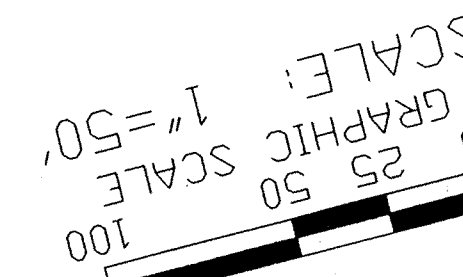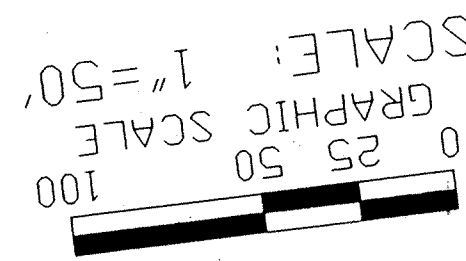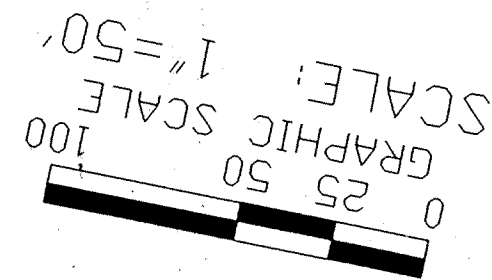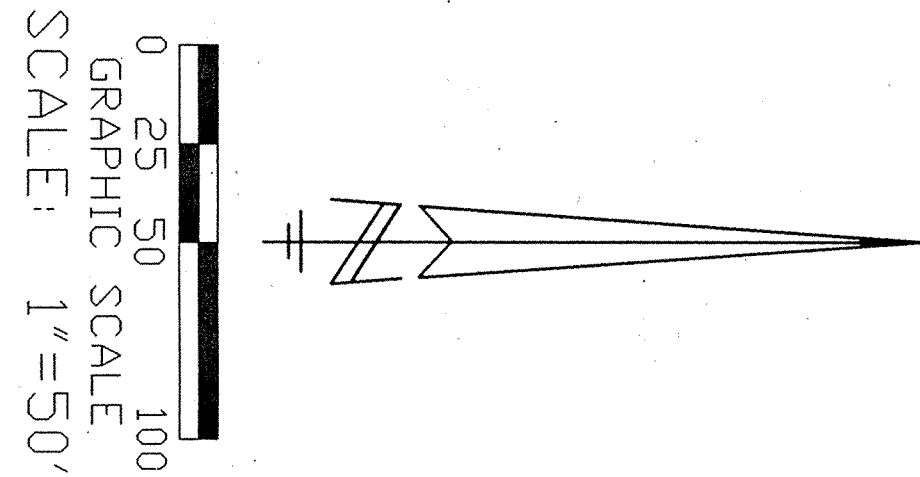

PREPARED FOR:
KINGSMILL DEVELOPMENT CORP.
Carmel, Indiana
Steven A. Wilson - 846-2555
Richard J. Carriger - 846-9221

PREPARED BY:
WEIHE ENGINEERS, Inc.
10505 N. College Ave.
Indianapolis, Indiana 46280
Telephone: 846-6611

BENCHMARK BM
1) P.K. NAIL SET IN C/L OF 106TH STREET 12.2' SOUTH OF P.V.P.M. 131-A AT THE SOUTHEAST CORNER OF PROPERTY. ELEVATION=887.99
2) P.K. NAIL SET IN C/L OF 106TH STREET 14.9' SOUTH OF P.V.P.M. 1130-A AT THE SOUTHWEST CORNER OF PROPERTY. ELEVATION=893.32

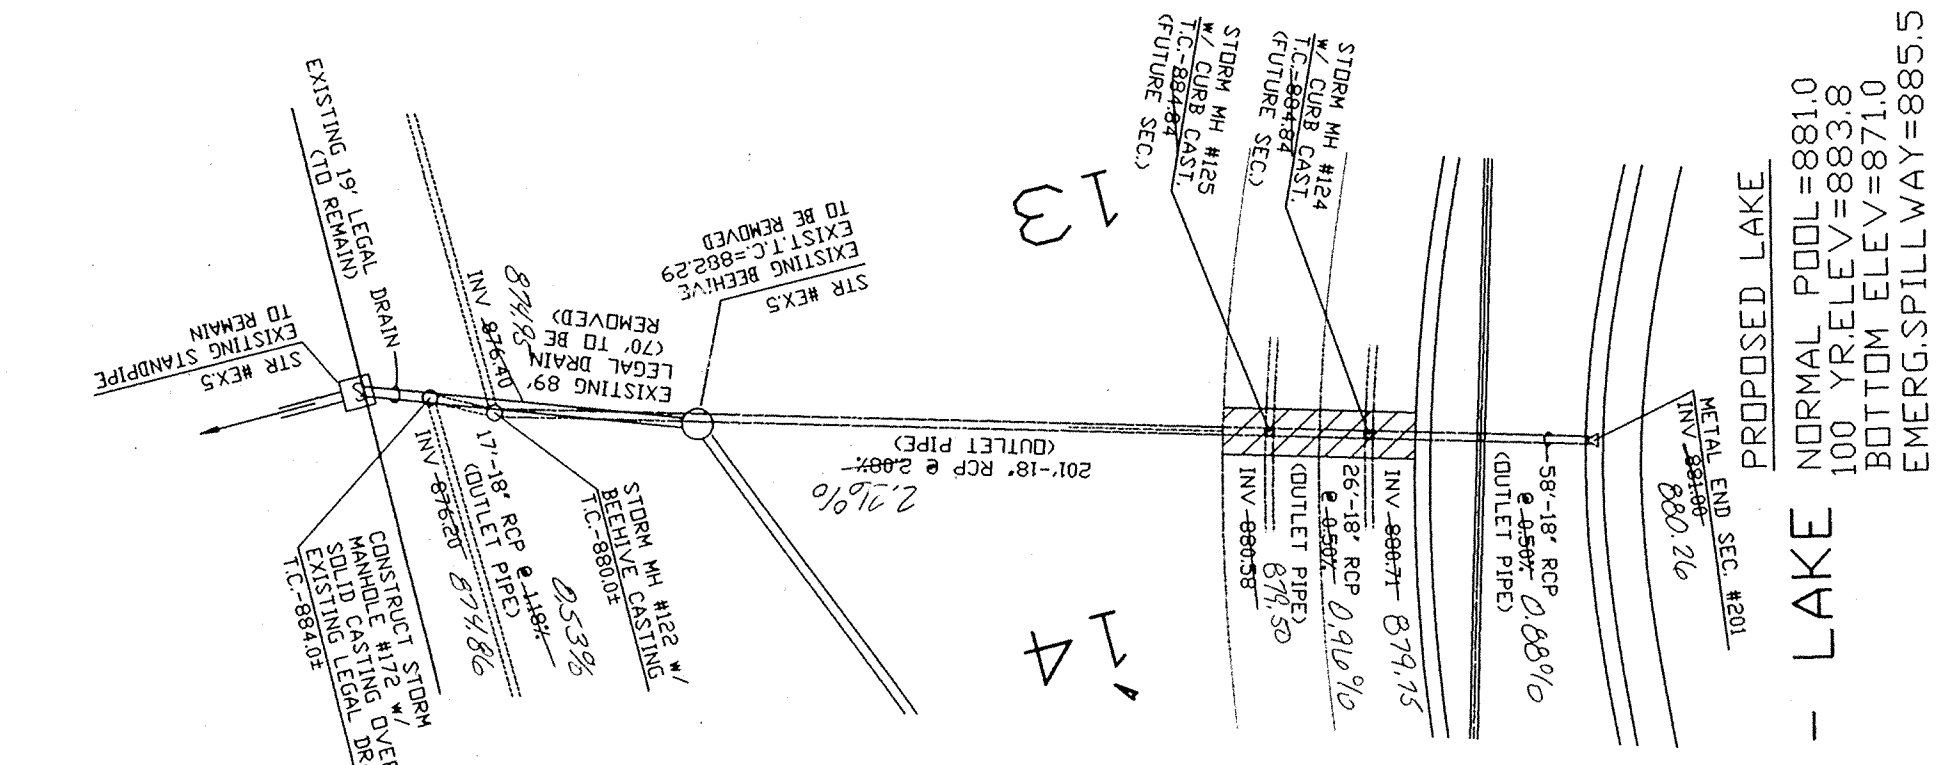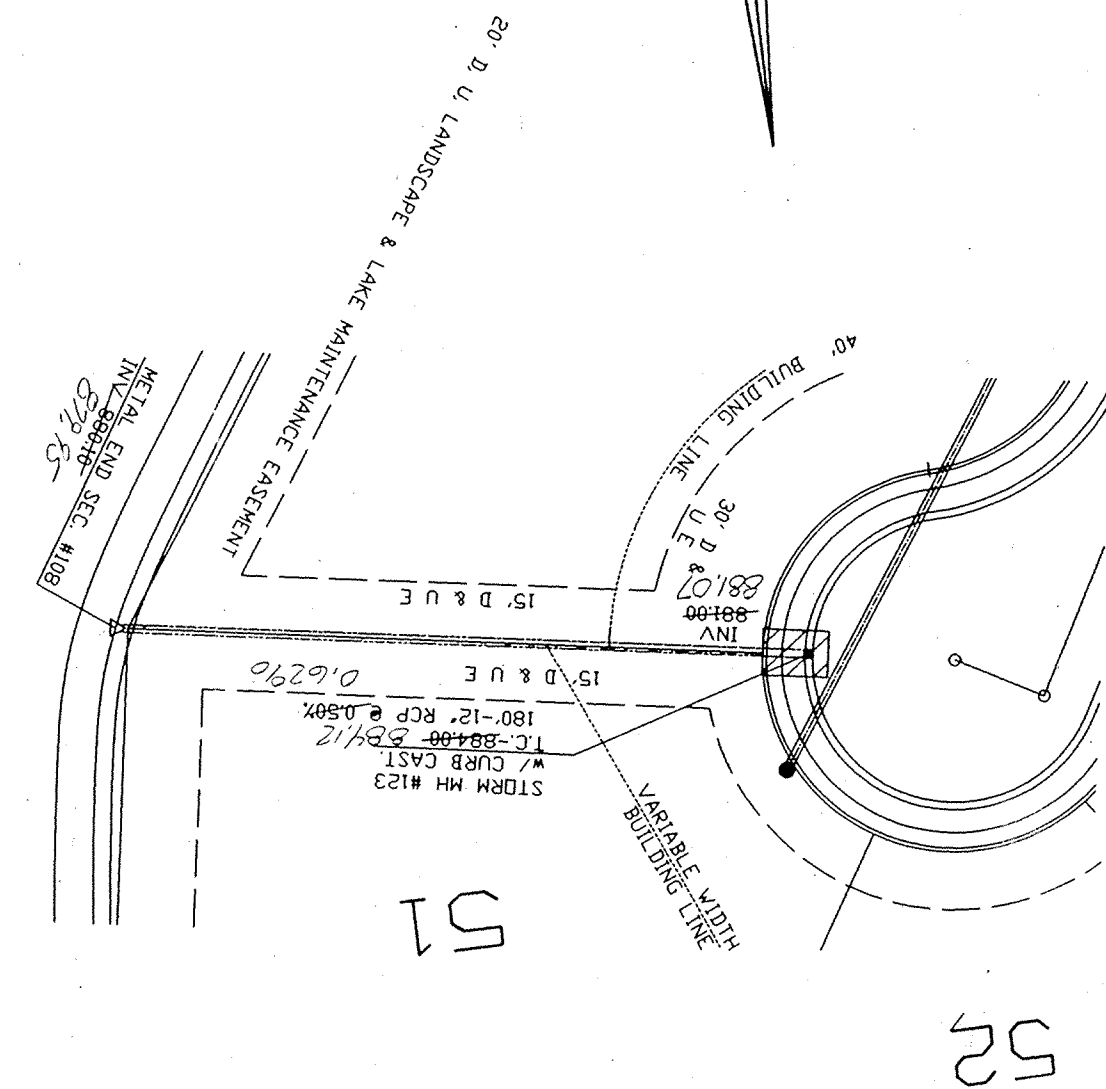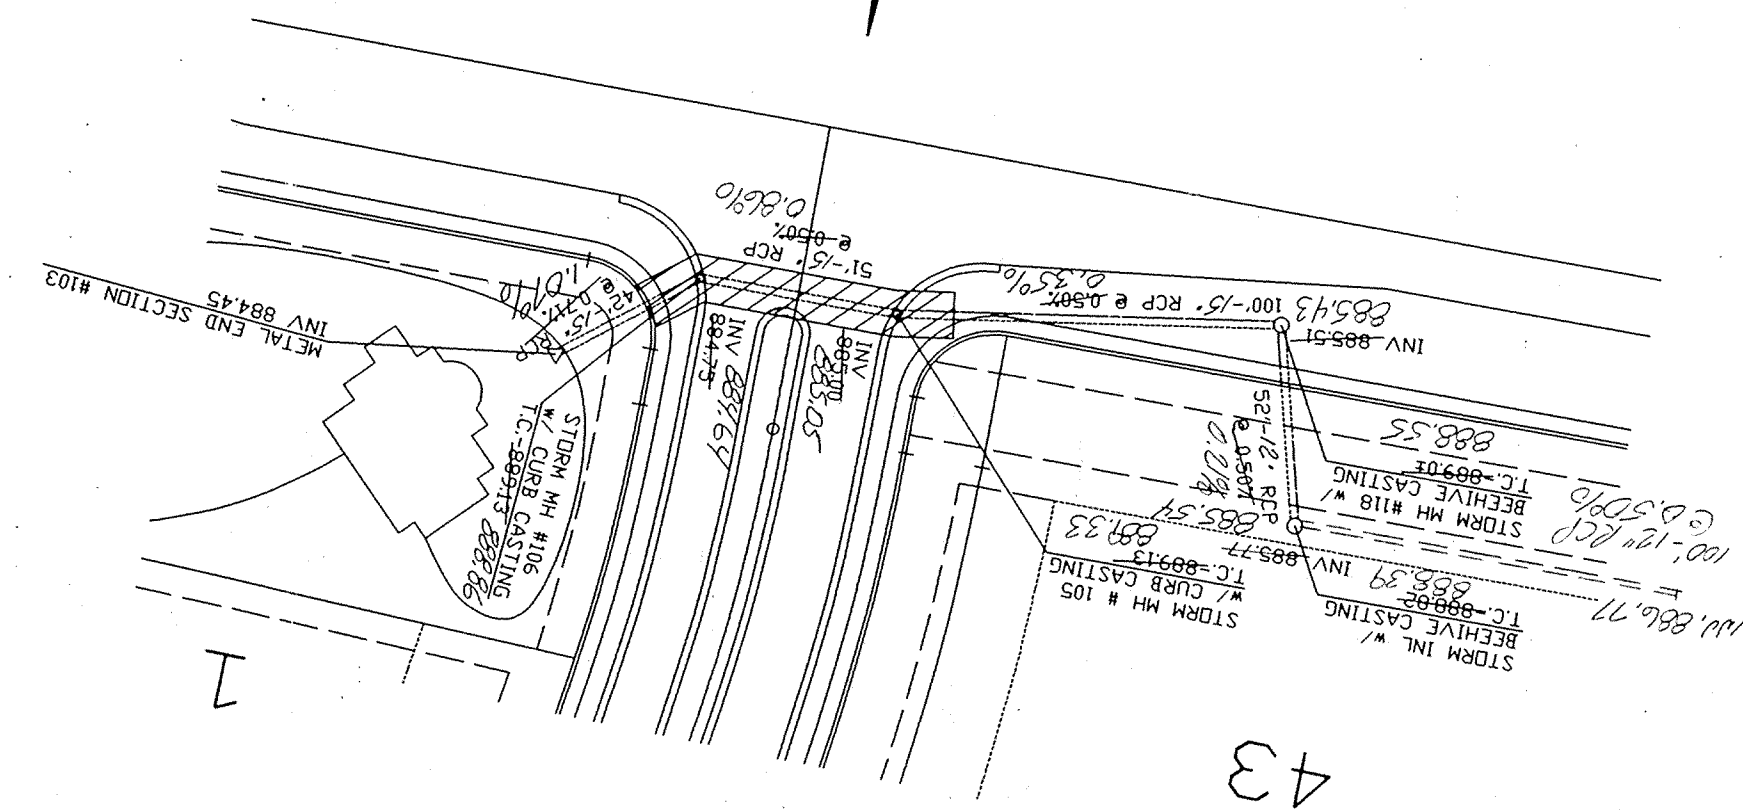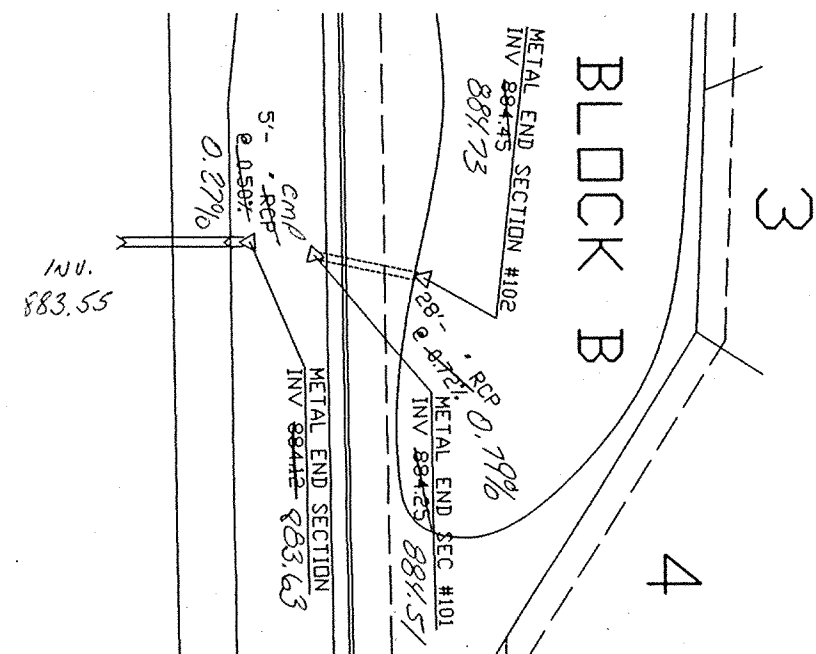






PROPOSED LAKE
NORMAL POOL=881.0
100 YR.ELEV.=883.8
BOTTOM ELEV.=871.0
EMERG.SPILLWAY=885.5

STORM SEWER PLANS

SCALE: 1" = 50' Horiz.
SCALE: 1" = 5' Vert.

RECORD DRAWING* STORM SEWERS
T.C.'S, INVERTS, PERCENTAGES
FEBRUARY 28, 1995

Allan H. Weihe
ALLAN H. WEIHE, REG. P.E. - INDIANA #8827

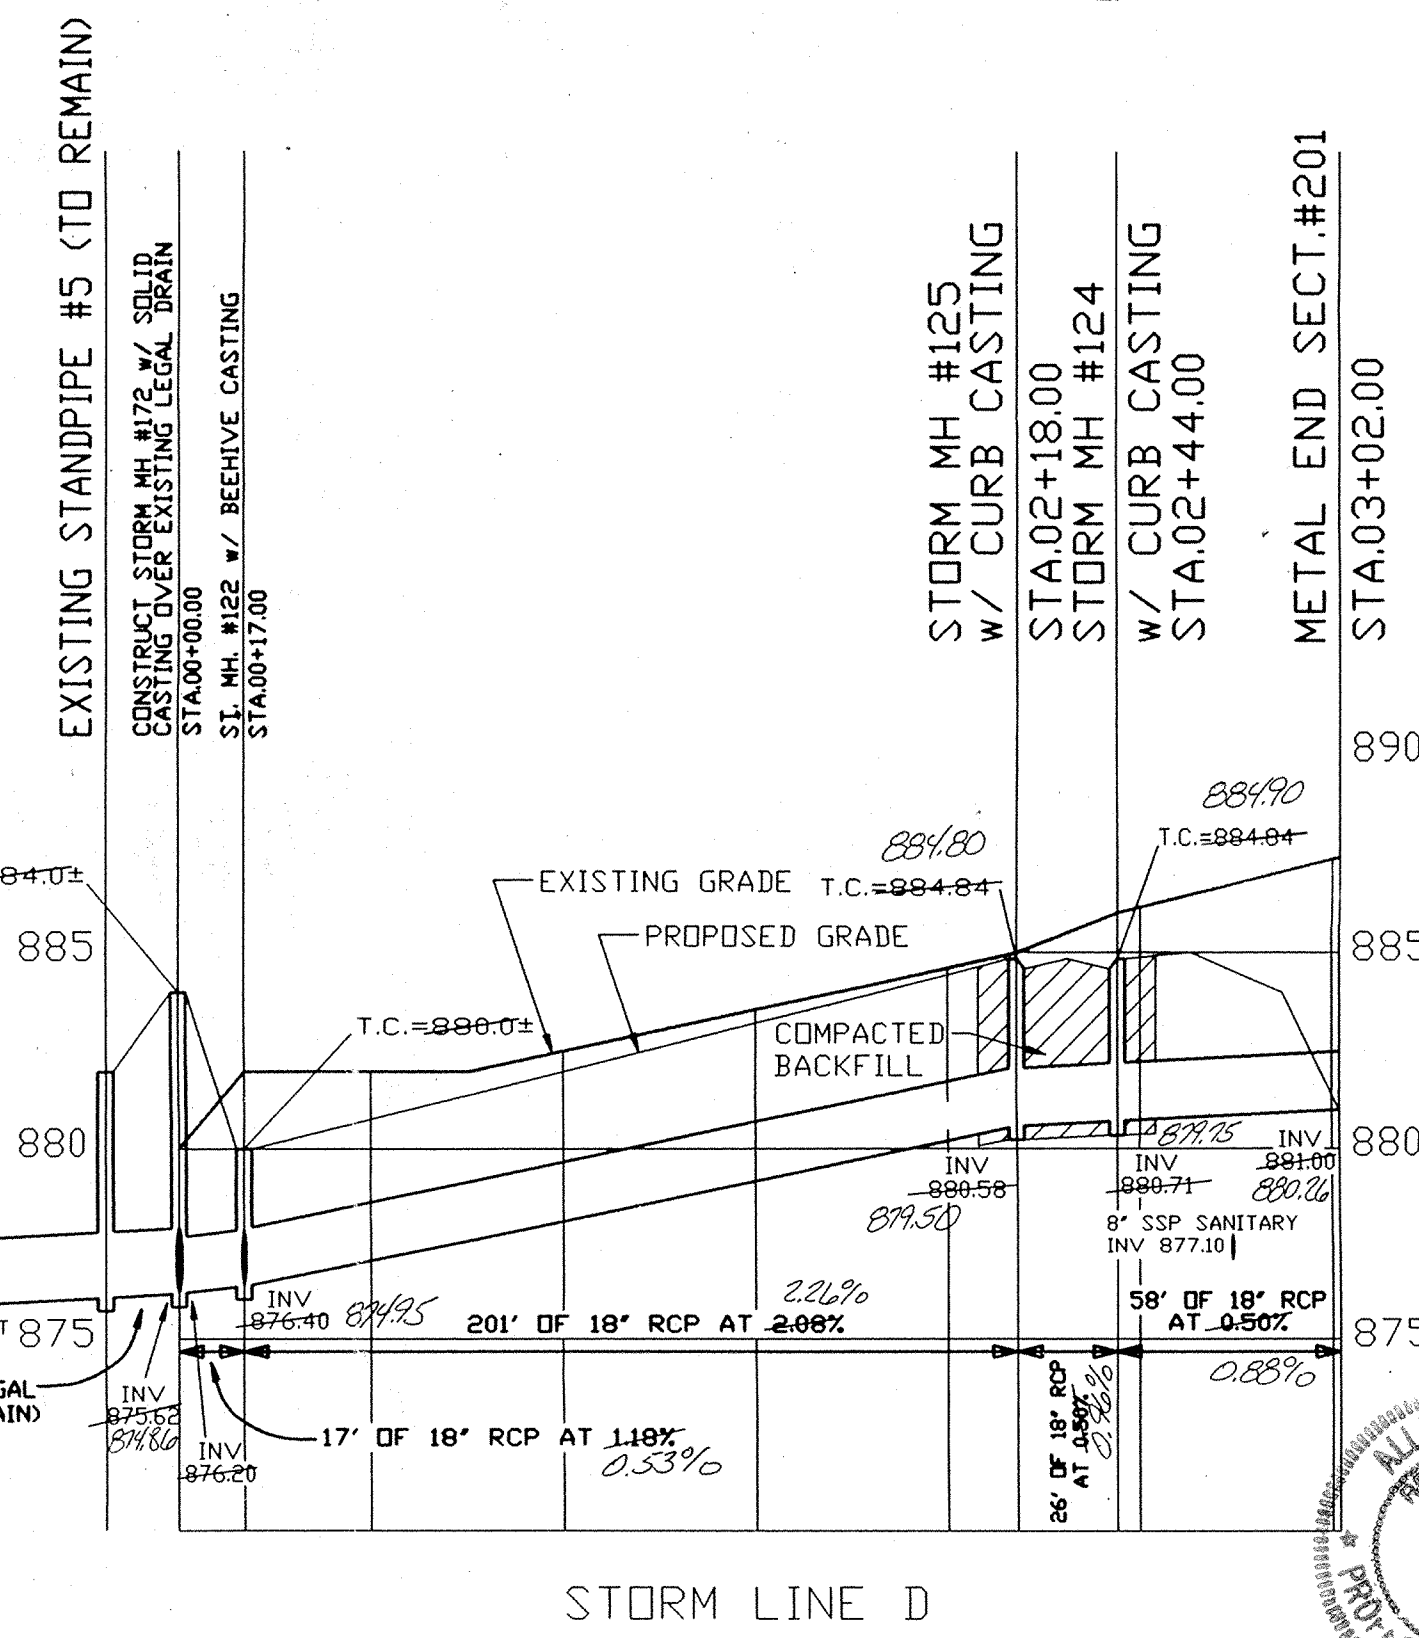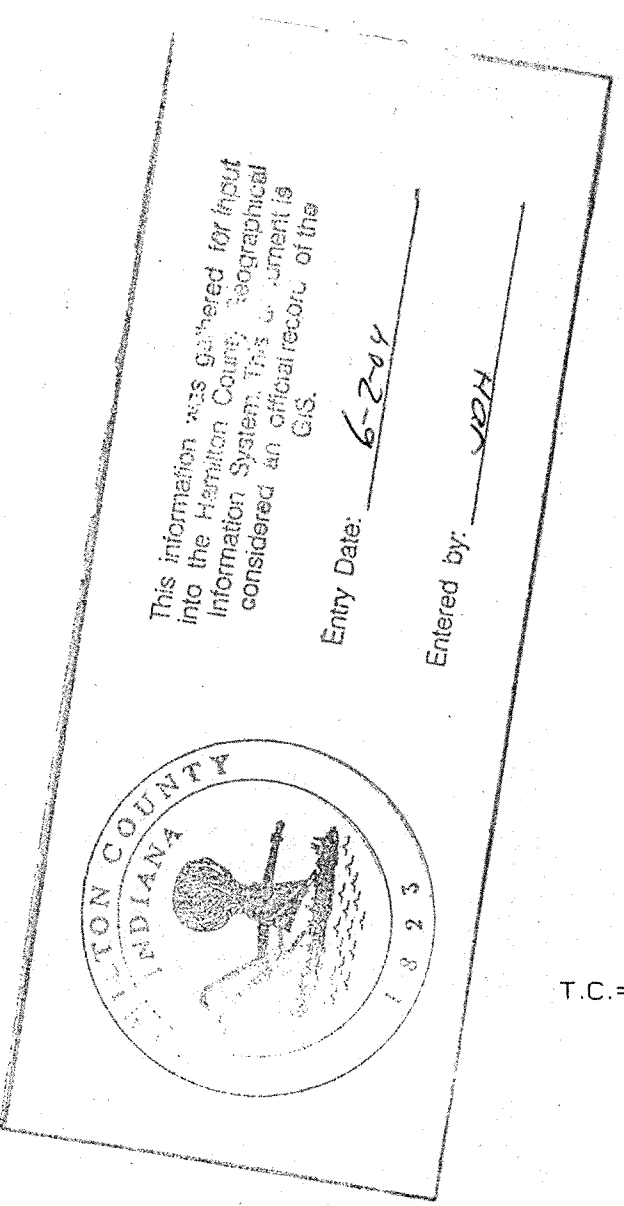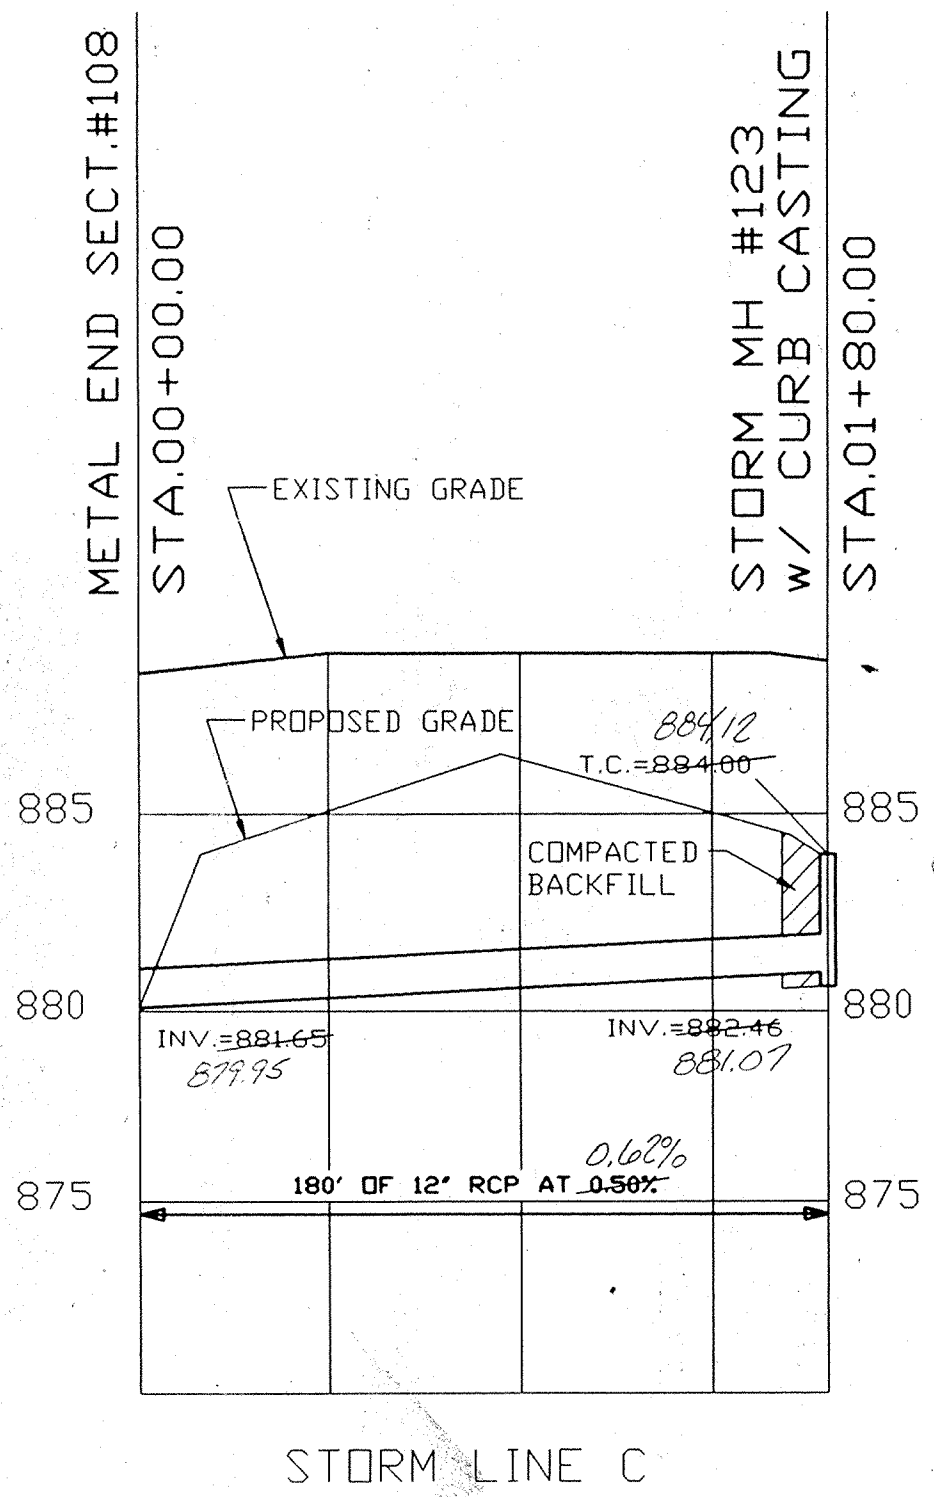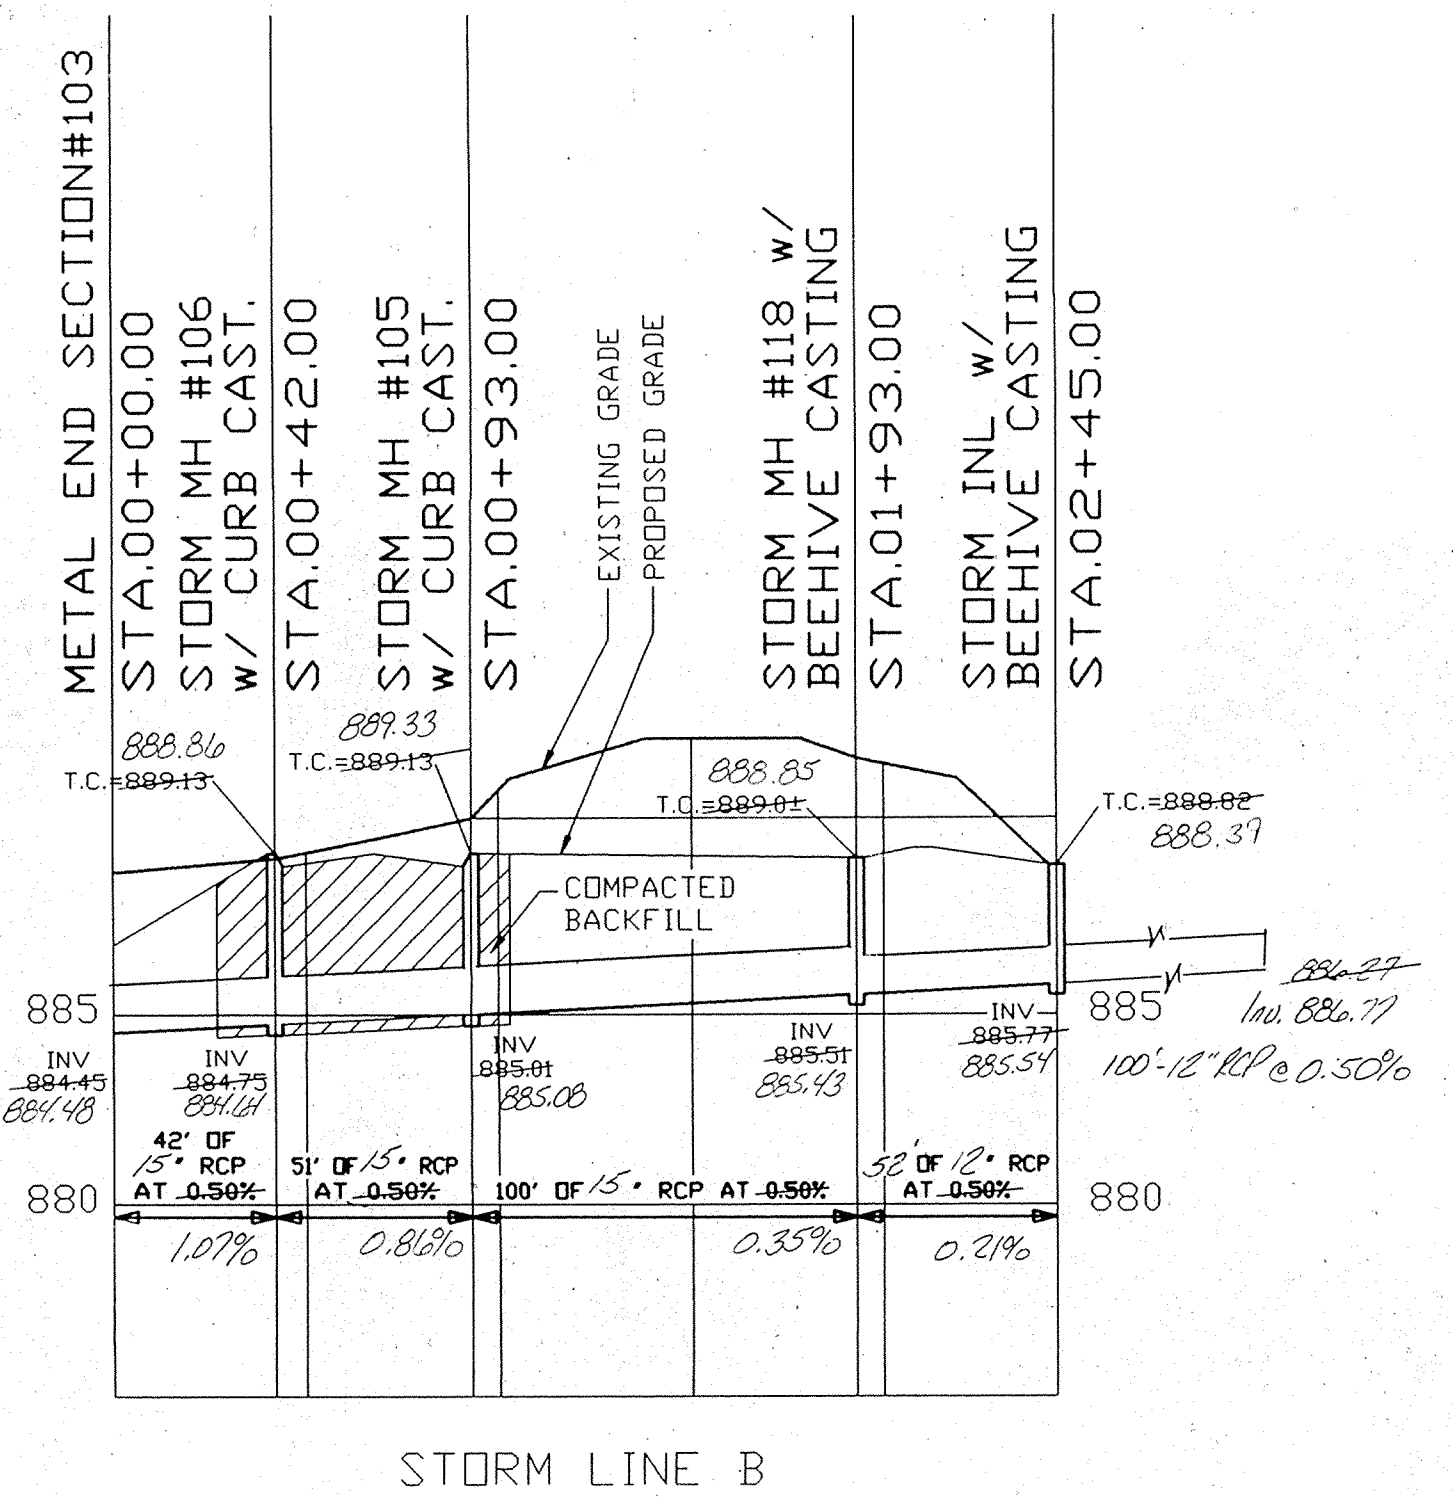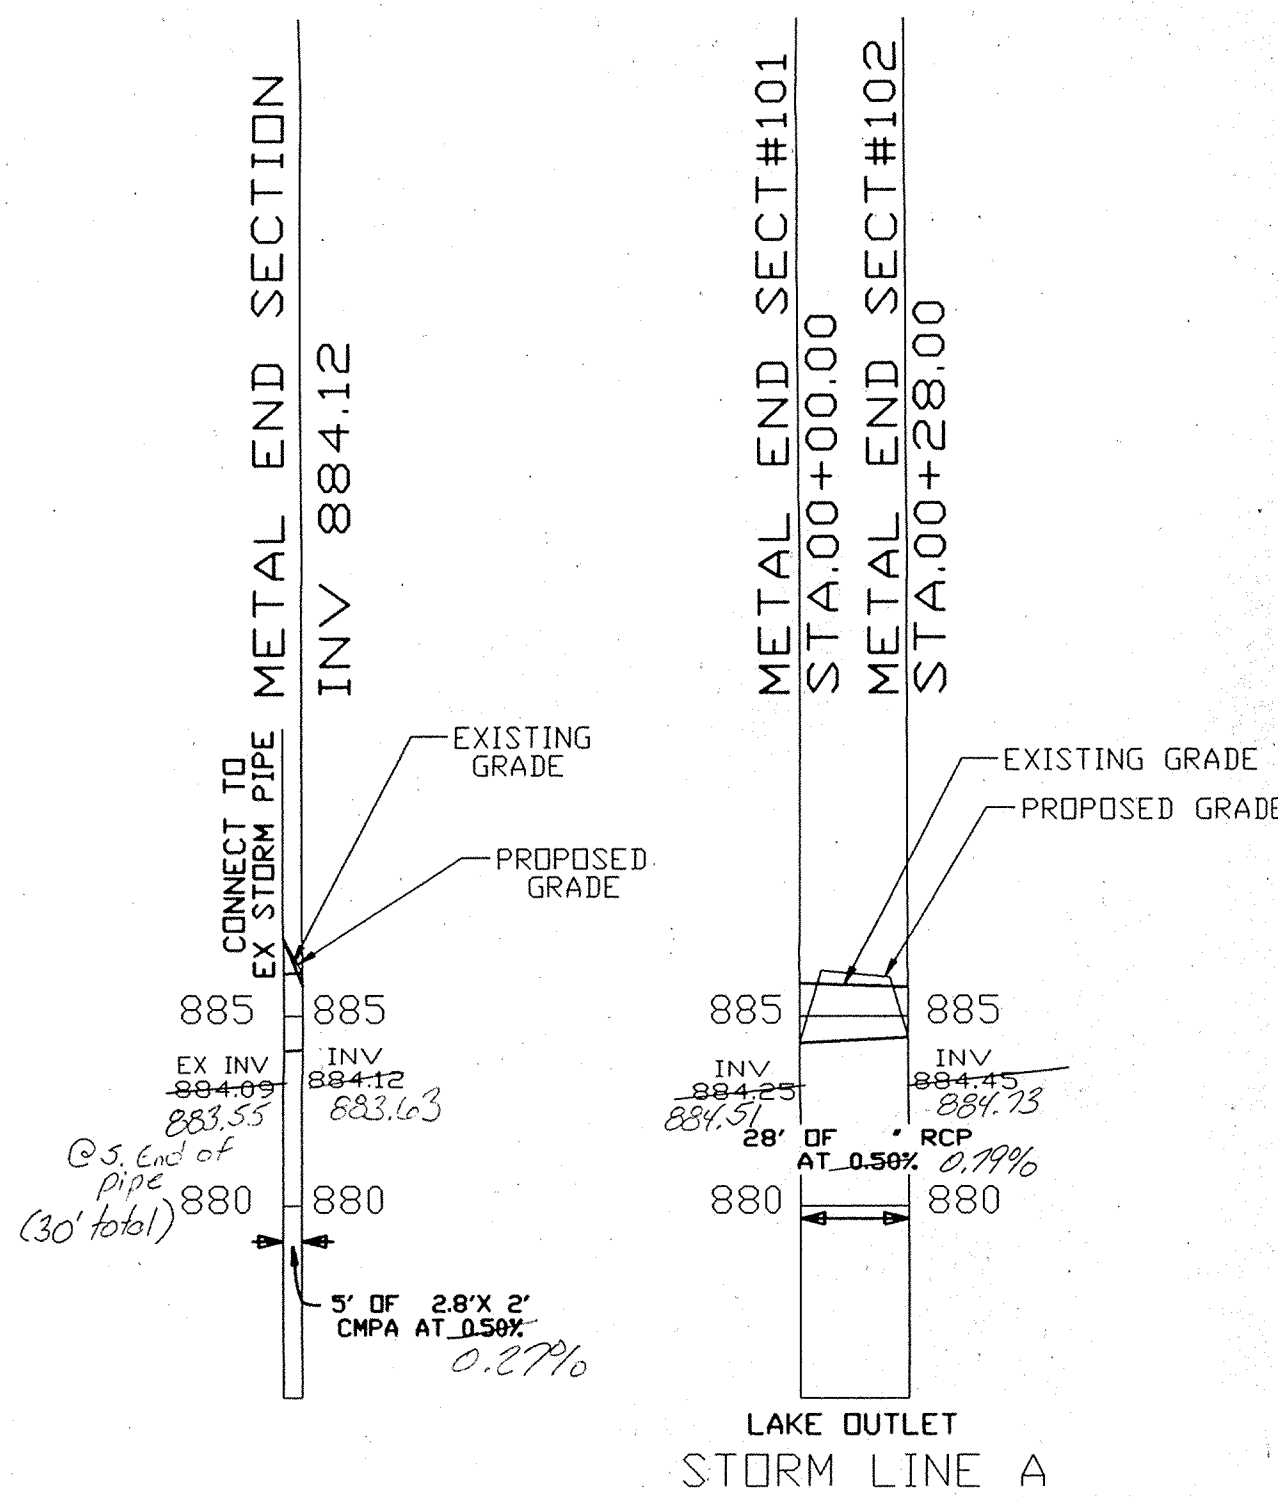


STORM SEWER PROFILES

Allan H. Weihe
ALLAN H. WEIHE-REG P.E.-IN #8827

ALLAN H. WEIHE, P.E., L.S.
PRESIDENT



10505 NORTH COLLEGE AVENUE
INDIANAPOLIS, INDIANA 46280
(317) 846-6611

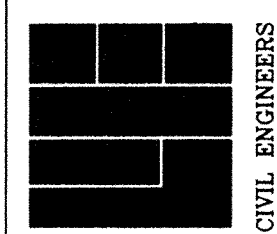

PROJECT NO.	93-1292
DATE	1/18/95
DESIGNED BY	J. D. BARNETT
CHECKED BY	A. H. WEIHE
DATE	01-07-94
PAGE	11

PREPARED FOR:
The Kingsmill Development Corp.
Carmel, Indiana

BENCHMARK
 1) P.K. NAIL SET IN C/L OF 106TH STREET 12' SOUTH OF P.V.P. #131-A AT THE SOUTHEAST CORNER OF PROPERTY. ELEVATION=887.99
 2) P.K. NAIL SET IN C/L OF 106TH STREET 14' SOUTH OF P.V.P. #130-A AT THE SOUTHWEST CORNER OF PROPERTY. ELEVATION=893.32

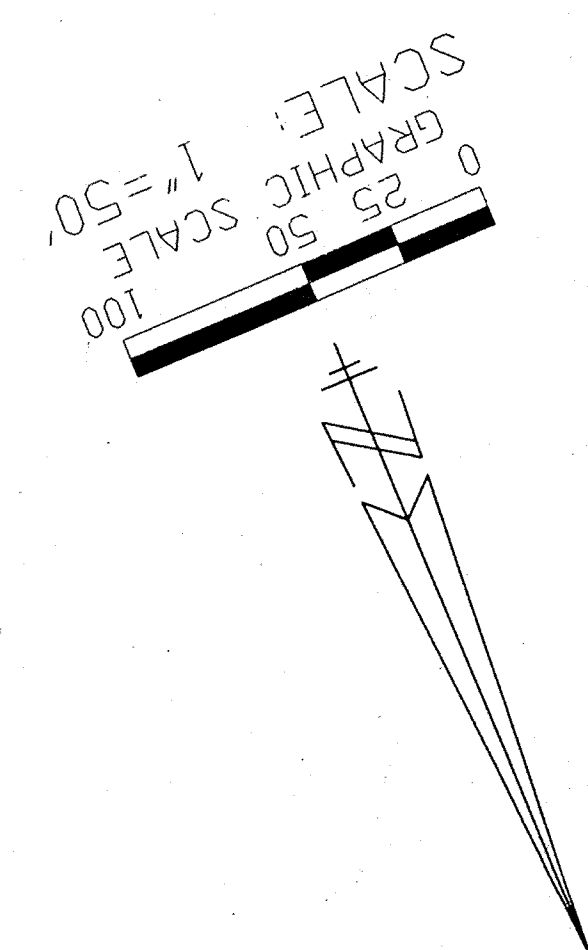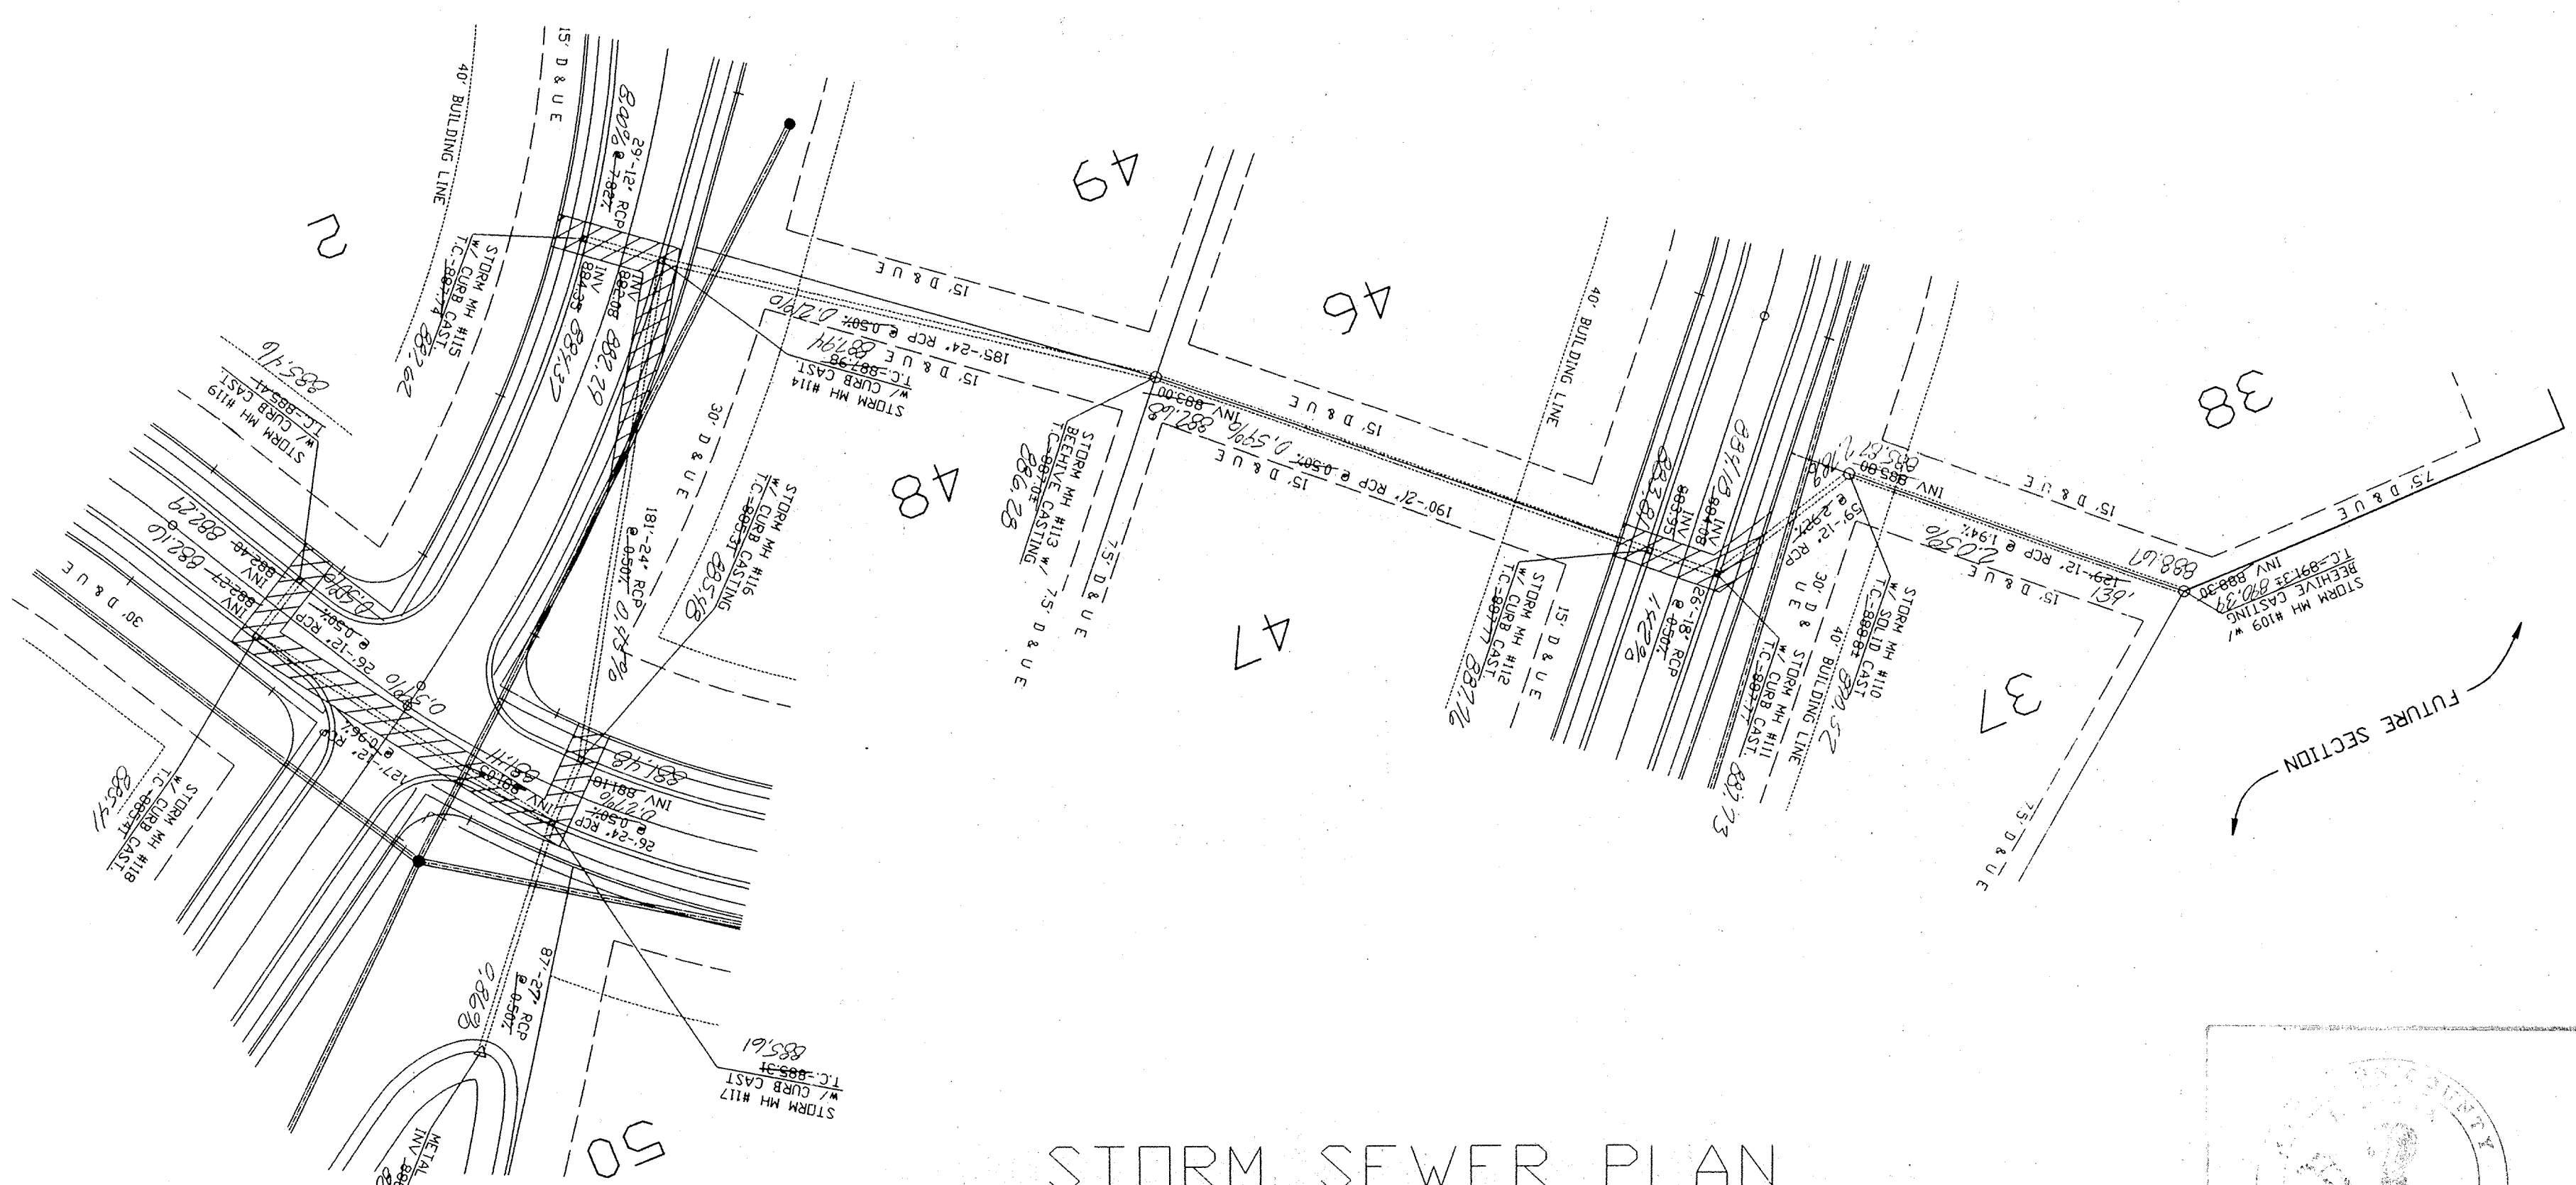

PREPARED FOR:
 KINGSMILL DEVELOPMENT CORP.
 Carmel, Indiana
 Steven A. Wilson - 846-2555
 Richard J. Carriger - 846-9221

PREPARED BY:
 WEIHE ENGINEERS, Inc.
 10505 N. College Ave.
 Indianapolis, Indiana 46280
 Telephone: 846-6611

This information was gathered for input into the Hamilton County Geographical Information System. This document is considered an official record of the GIS.





Entered by: JMH

Entered Date: 6-2-04


SCALE: 1" = 50' Horiz.
 SCALE: 1" = 5' Vert.

"RECORD DRAWING" STORM SEWERS
 T.C.'S, INVERTS, PERCENTAGES
 FEBRUARY 28, 1995

Allan H. Weihe
 ALLAN H. WEIHE, REG. P.E. - INDIANA #8827

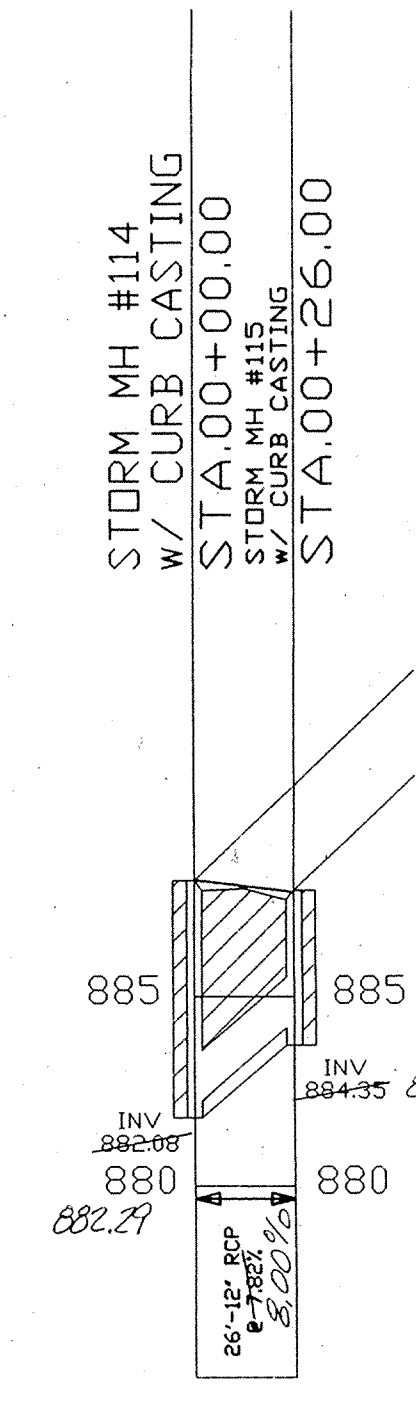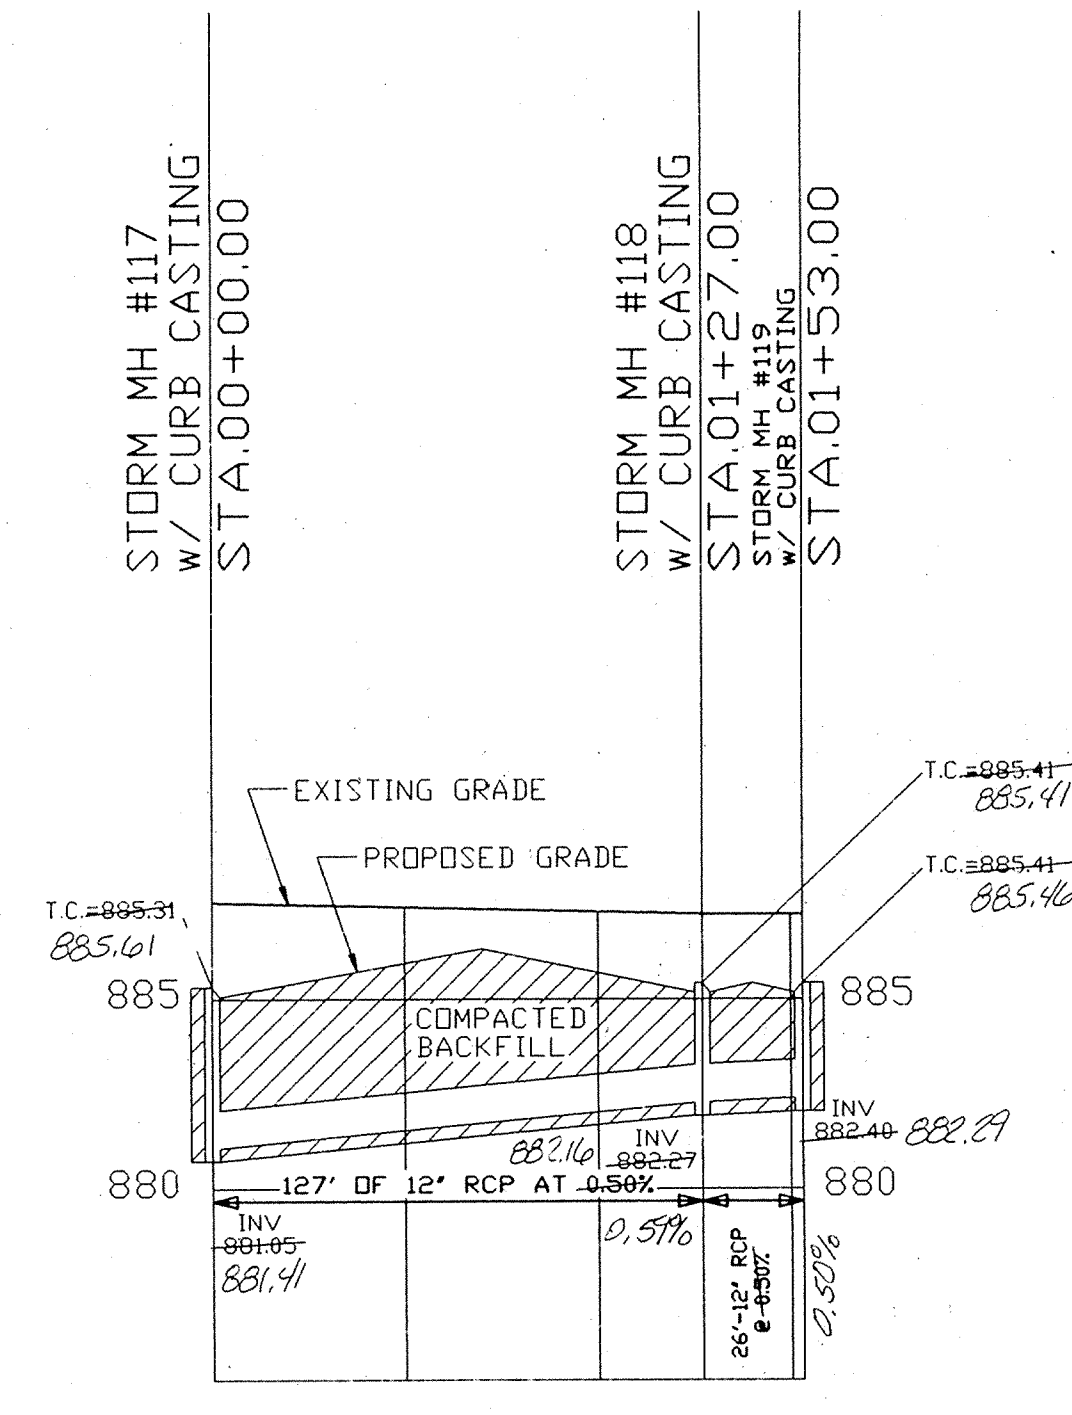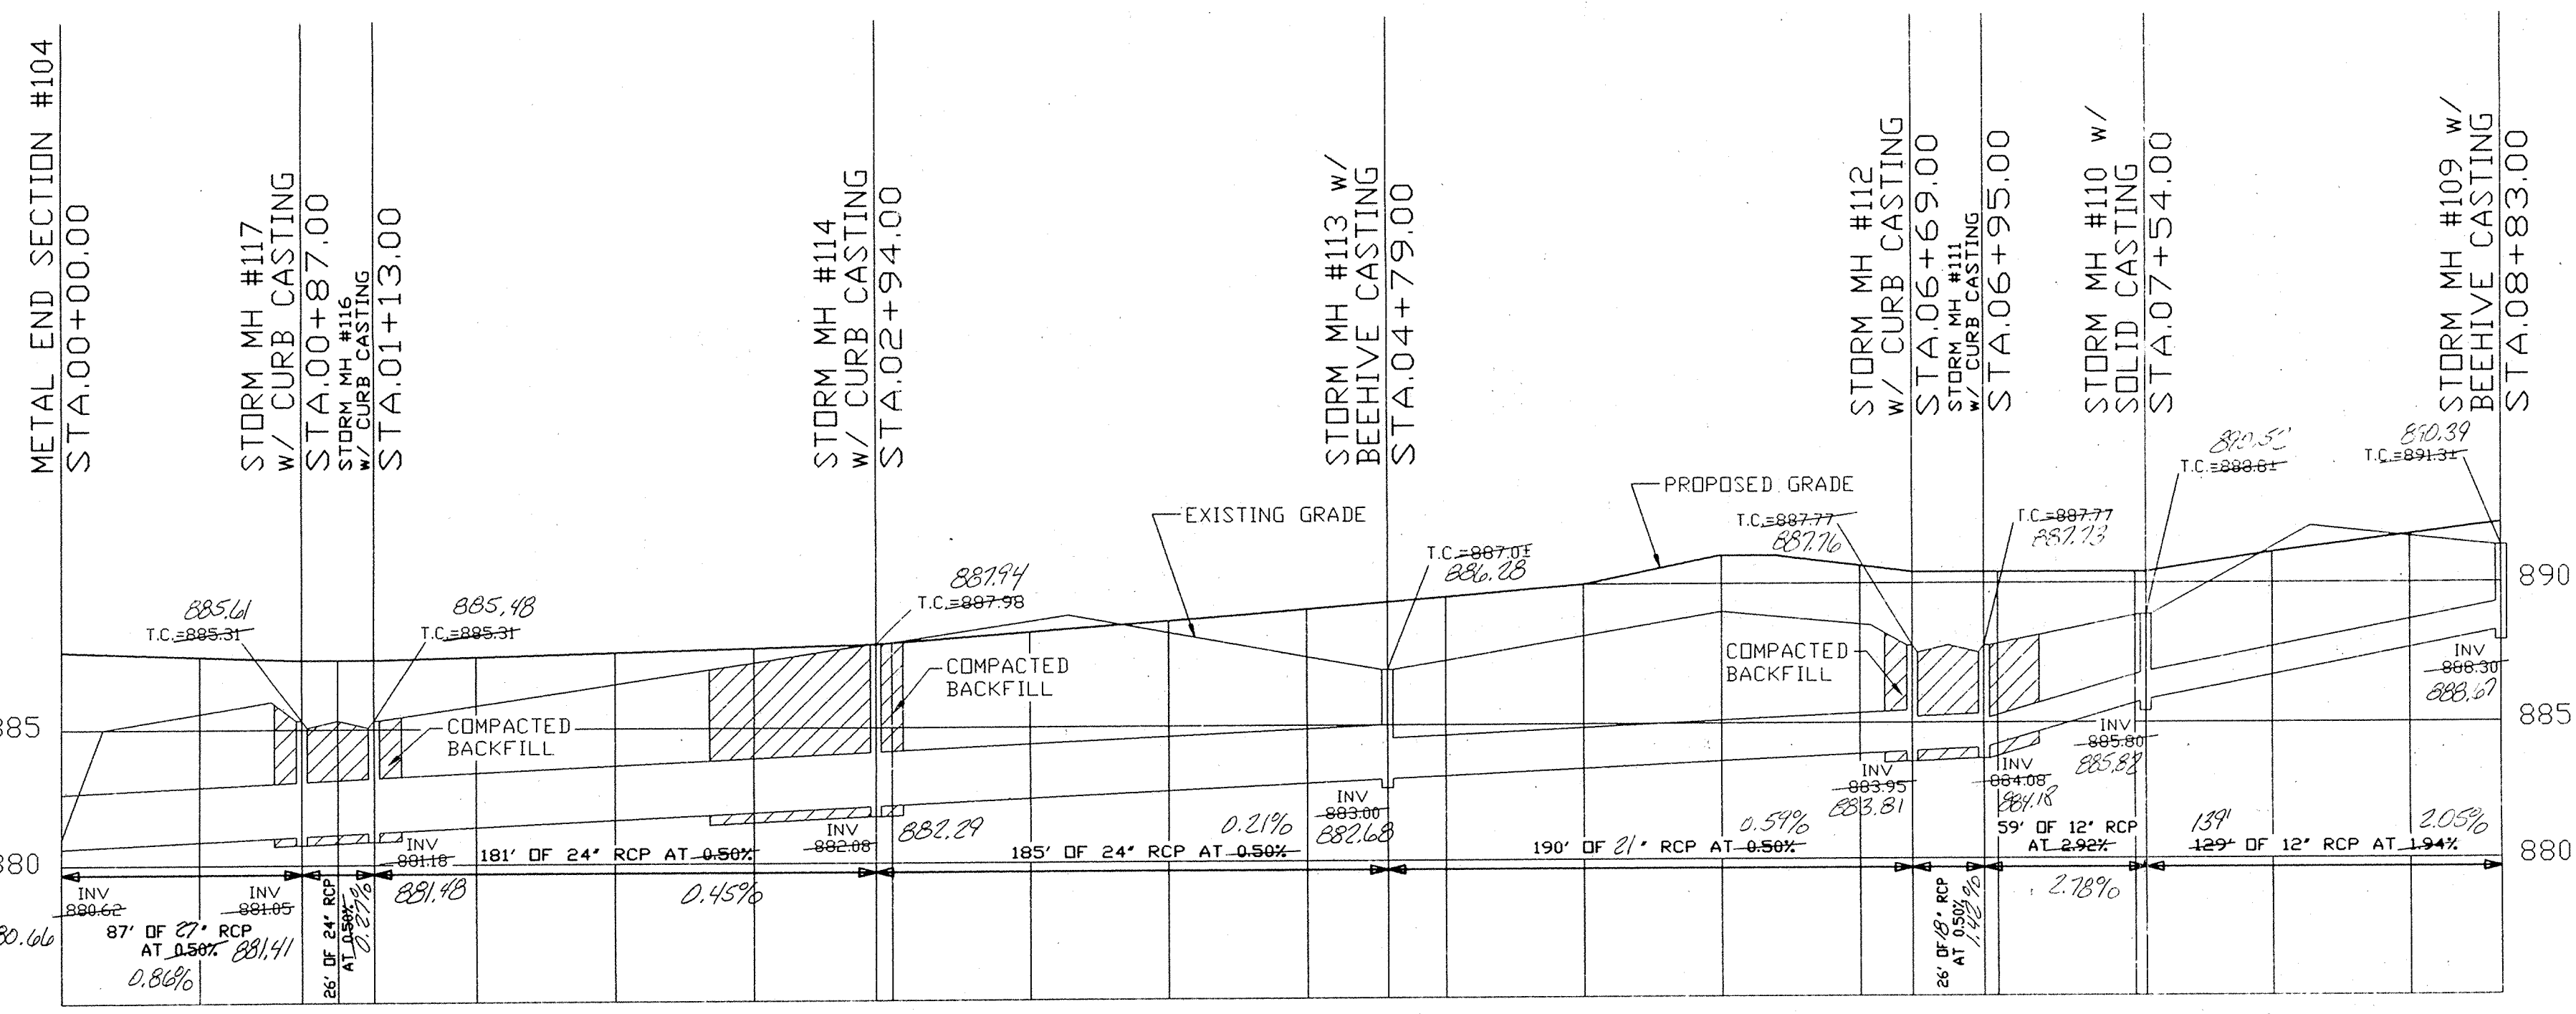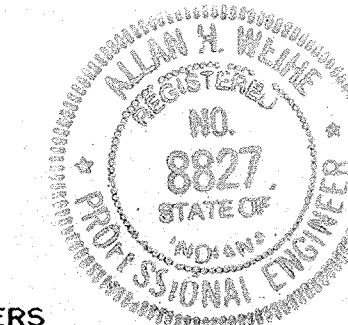

STORM SEWER PROFILES

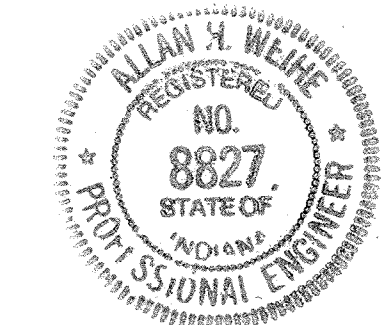

Allan H. Weihe
 ALLAN H. WEIHE-REG P.E.-IN #8827

WEIHE ENGINEERS, INC.
 10505 N. COLLEGE AVENUE
 INDIANAPOLIS, INDIANA 46280
 (317) 846-6611
 LAND PLANNERS
 CIVIL ENGINEERS

DATE: 4/18/95 BY: JMH DRAWN BY: MLT CHECKED BY: MLT DATE: 01-13-94

REVISIONS:
 Storm Pipe Revision

NO. 8827
 STATE OF INDIANA
 PROFESSIONAL ENGINEER


PREPARED FOR:
 The Kingsmill Development Corp.
 Carmel, Indiana

SHEET NO. 12 OF 18

STORM SEWER PLAN & PROFILE SHEET - Kingsmill

PROPOSED LAKE
 NORMAL POOL=881.0
 100 YR.ELEV=883.8
 BOTTOM ELEV=871.0
 EMERG.SPILLWAY=885.5


BLOCK C - LAKE

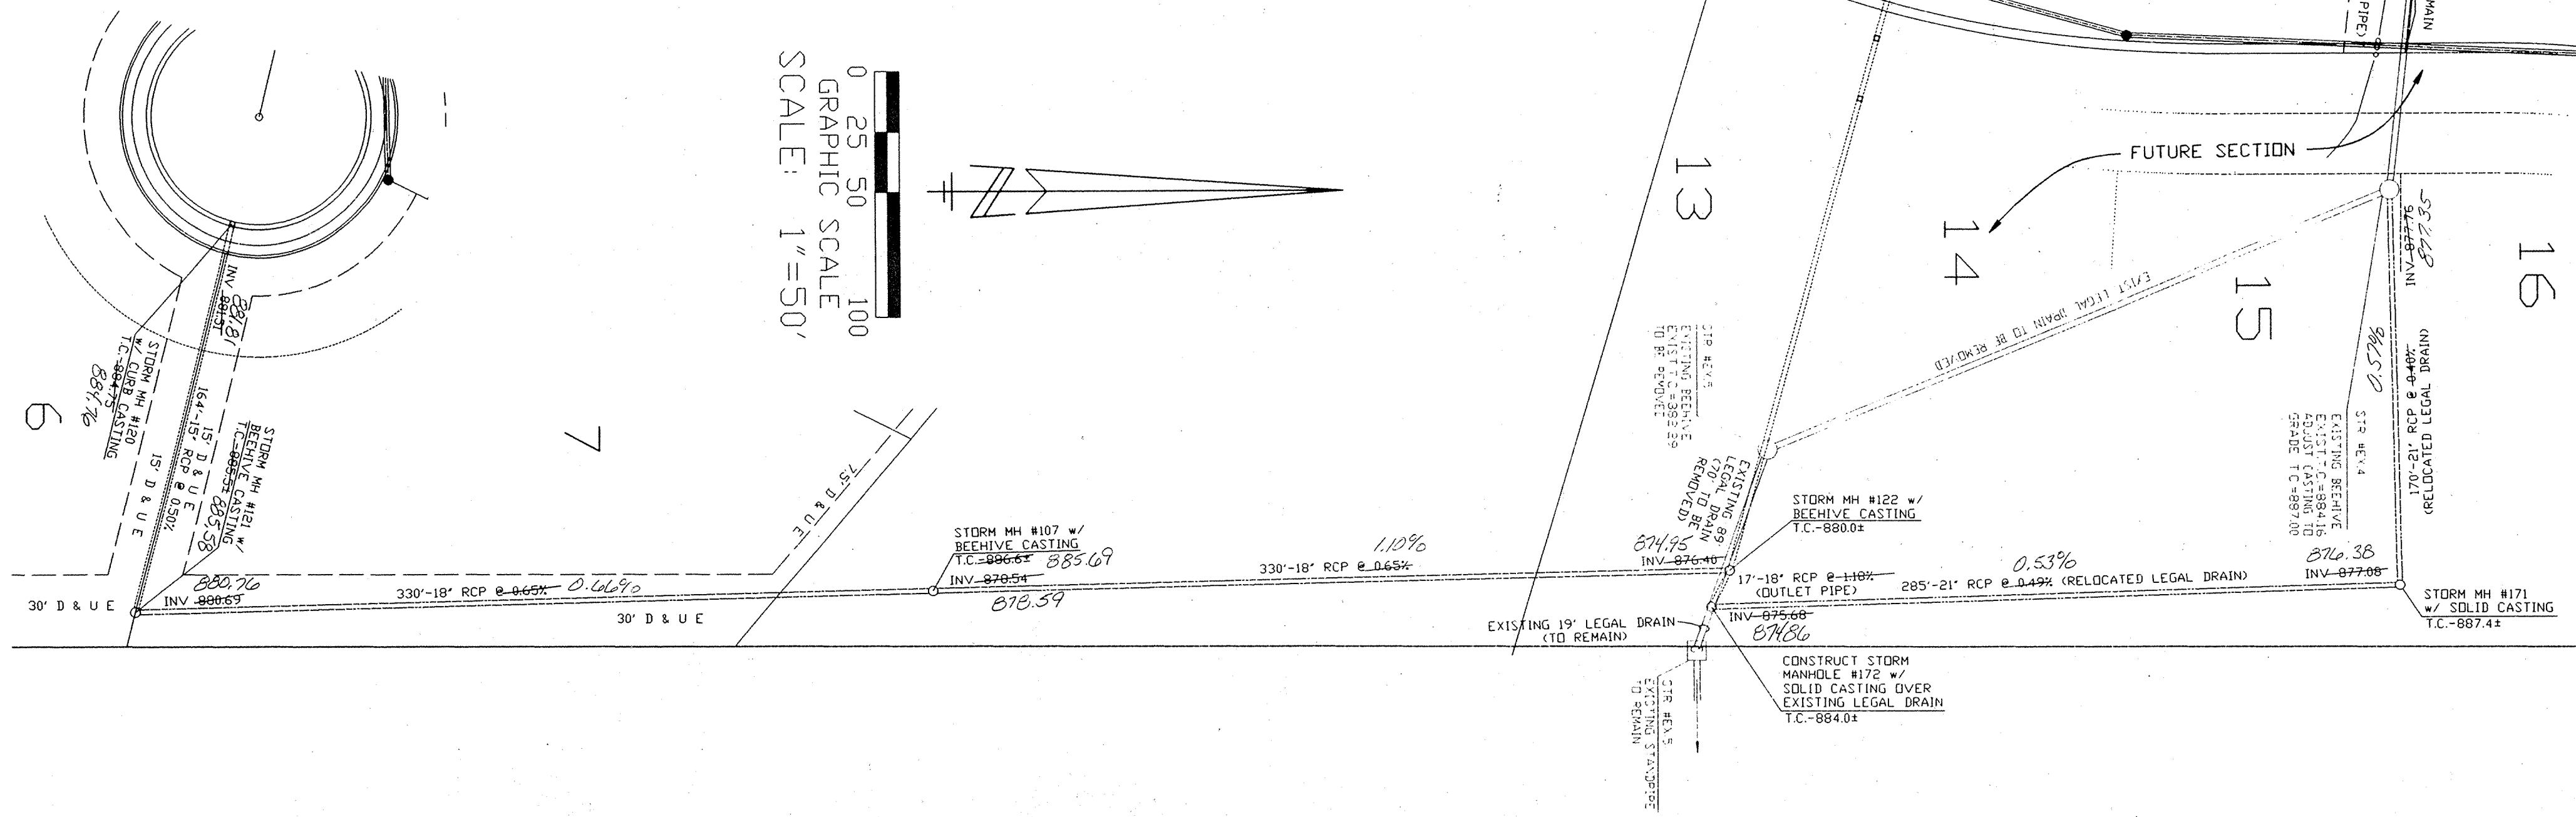

1) BENCHMARK BM
 P.K. NAIL SET IN C/L OF 106TH STREET 12.8' SOUTH OF P.W.P. 131-A AT THE SOUTHEAST CORNER OF PROPERTY. ELEVATION=887.99
 2) P.K. NAIL SET IN C/L OF 106TH STREET 14.8' SOUTH OF P.W.P. 1130-A AT THE SOUTHWEST CORNER OF PROPERTY. ELEVATION=893.32

PREPARED FOR:
 KINGSMILL DEVELOPMENT CORP.
 Carmel, Indiana
 Steven A. Wilson - 846-2555
 Richard J. Carriger - 846-9221

PREPARED BY:
 WEIHE ENGINEERS, Inc.
 10505 N. College Ave.
 Indianapolis, Indiana 46280
 Telephone: 846-6611

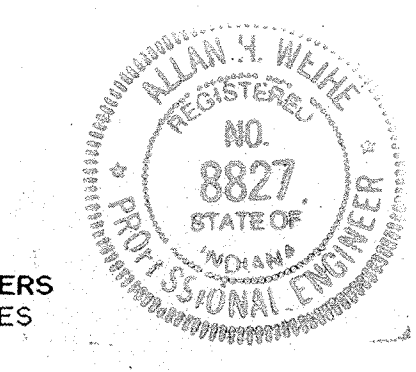


"RECORD DRAWING" STORM SEWERS
 T.C.'S, INVERTS, PERCENTAGES
 FEBRUARY 28, 1995


Allan H. Weihe
 ALLAN H. WEIHE, REG. P.E. - INDIANA #8827

SCALE: 1" = 50' Horiz.
 SCALE: 1" = 5' Vert.

STORM SEWER PLAN

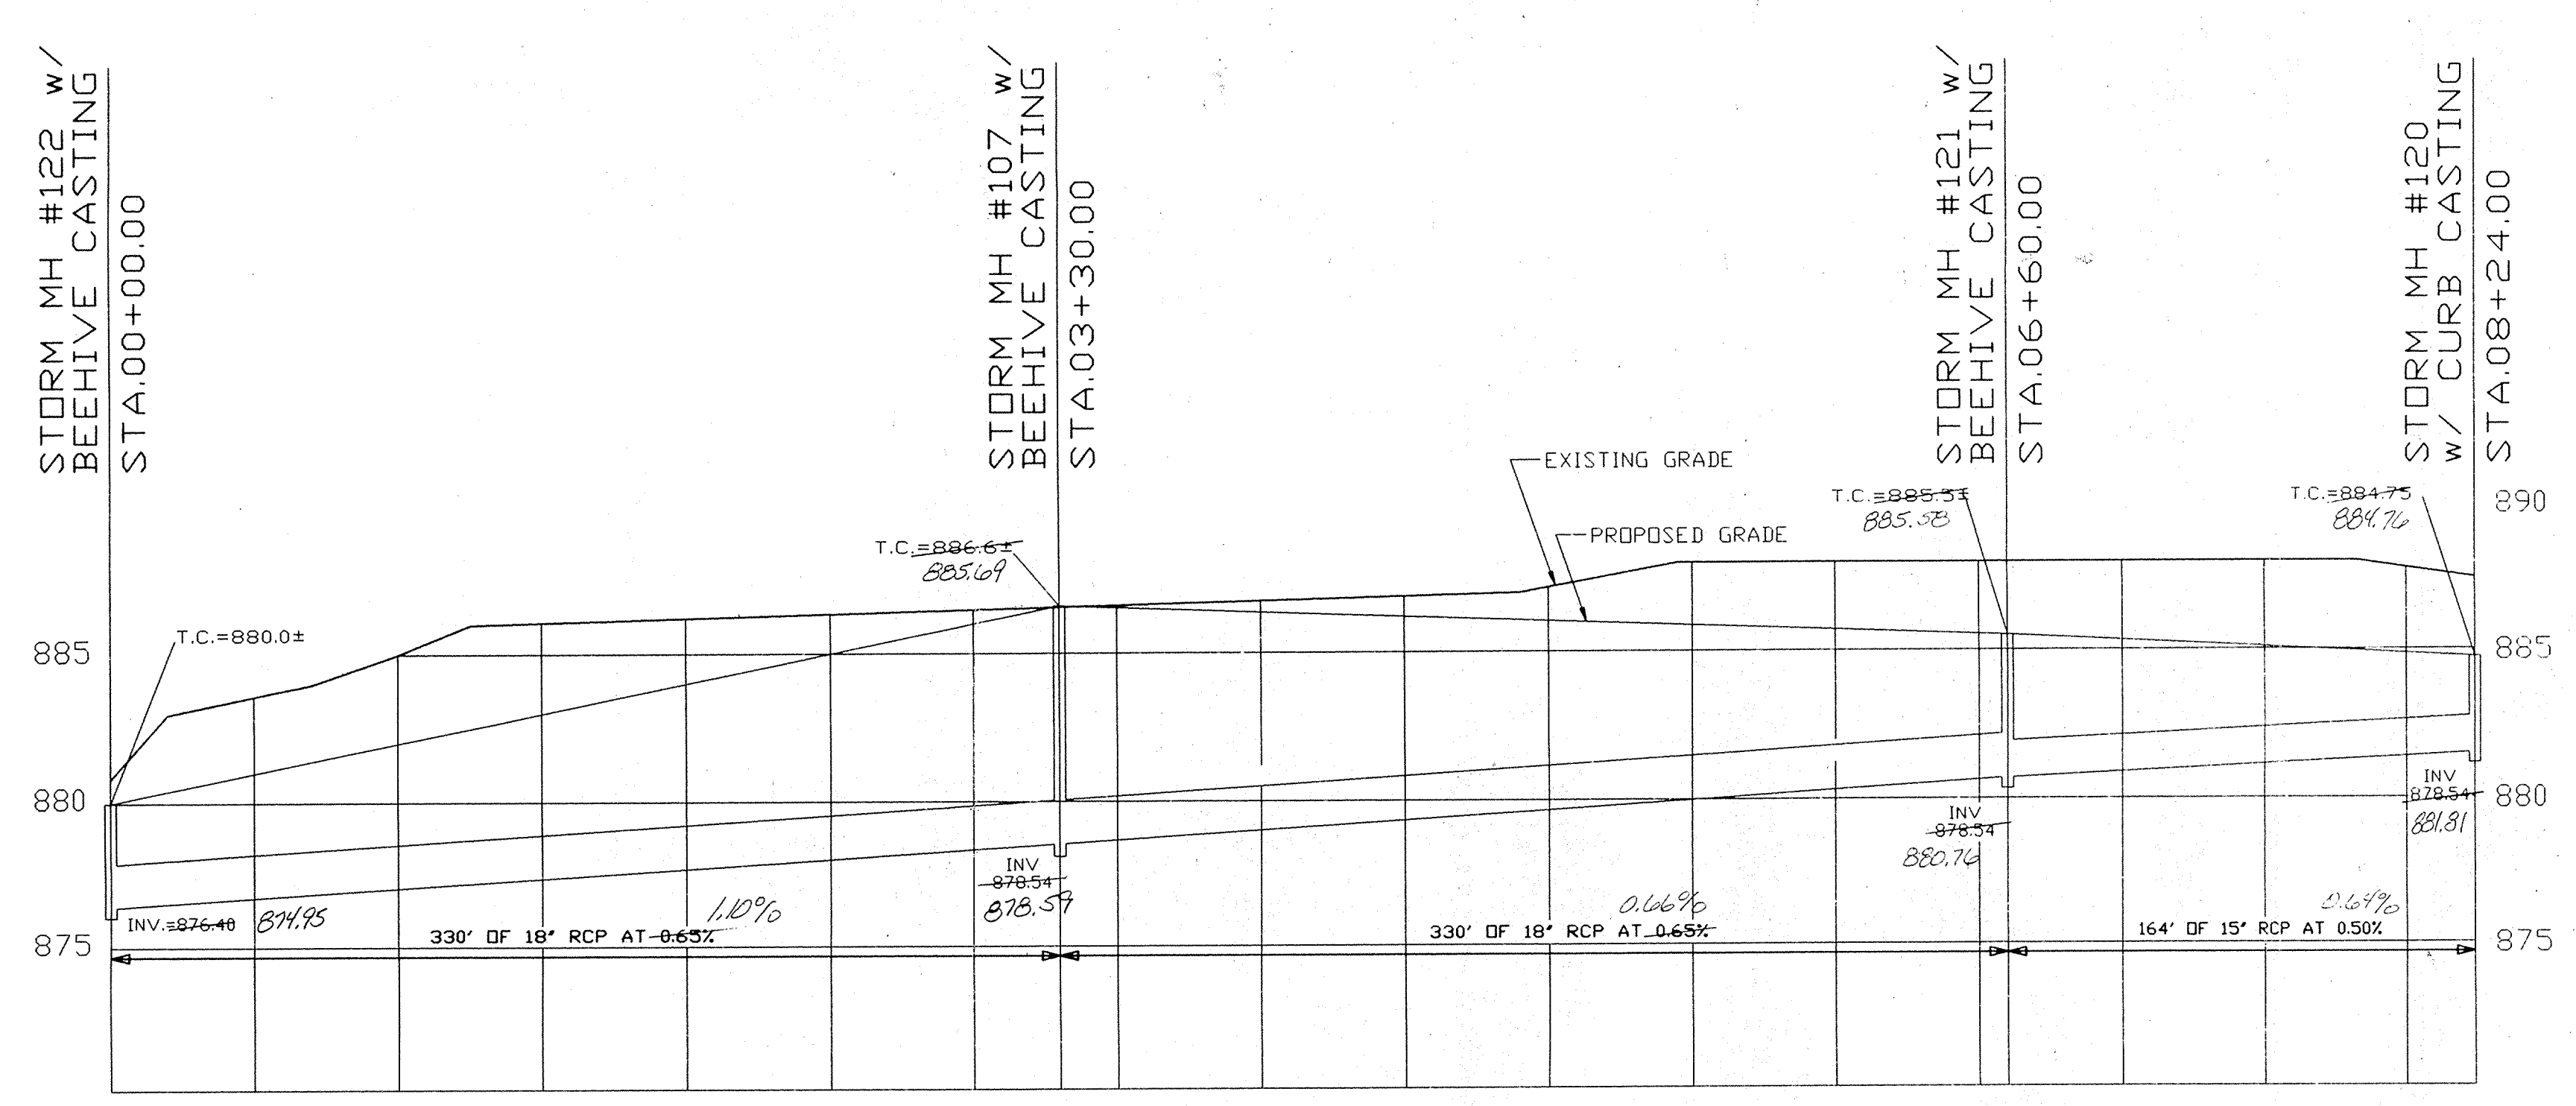

LINE S-3

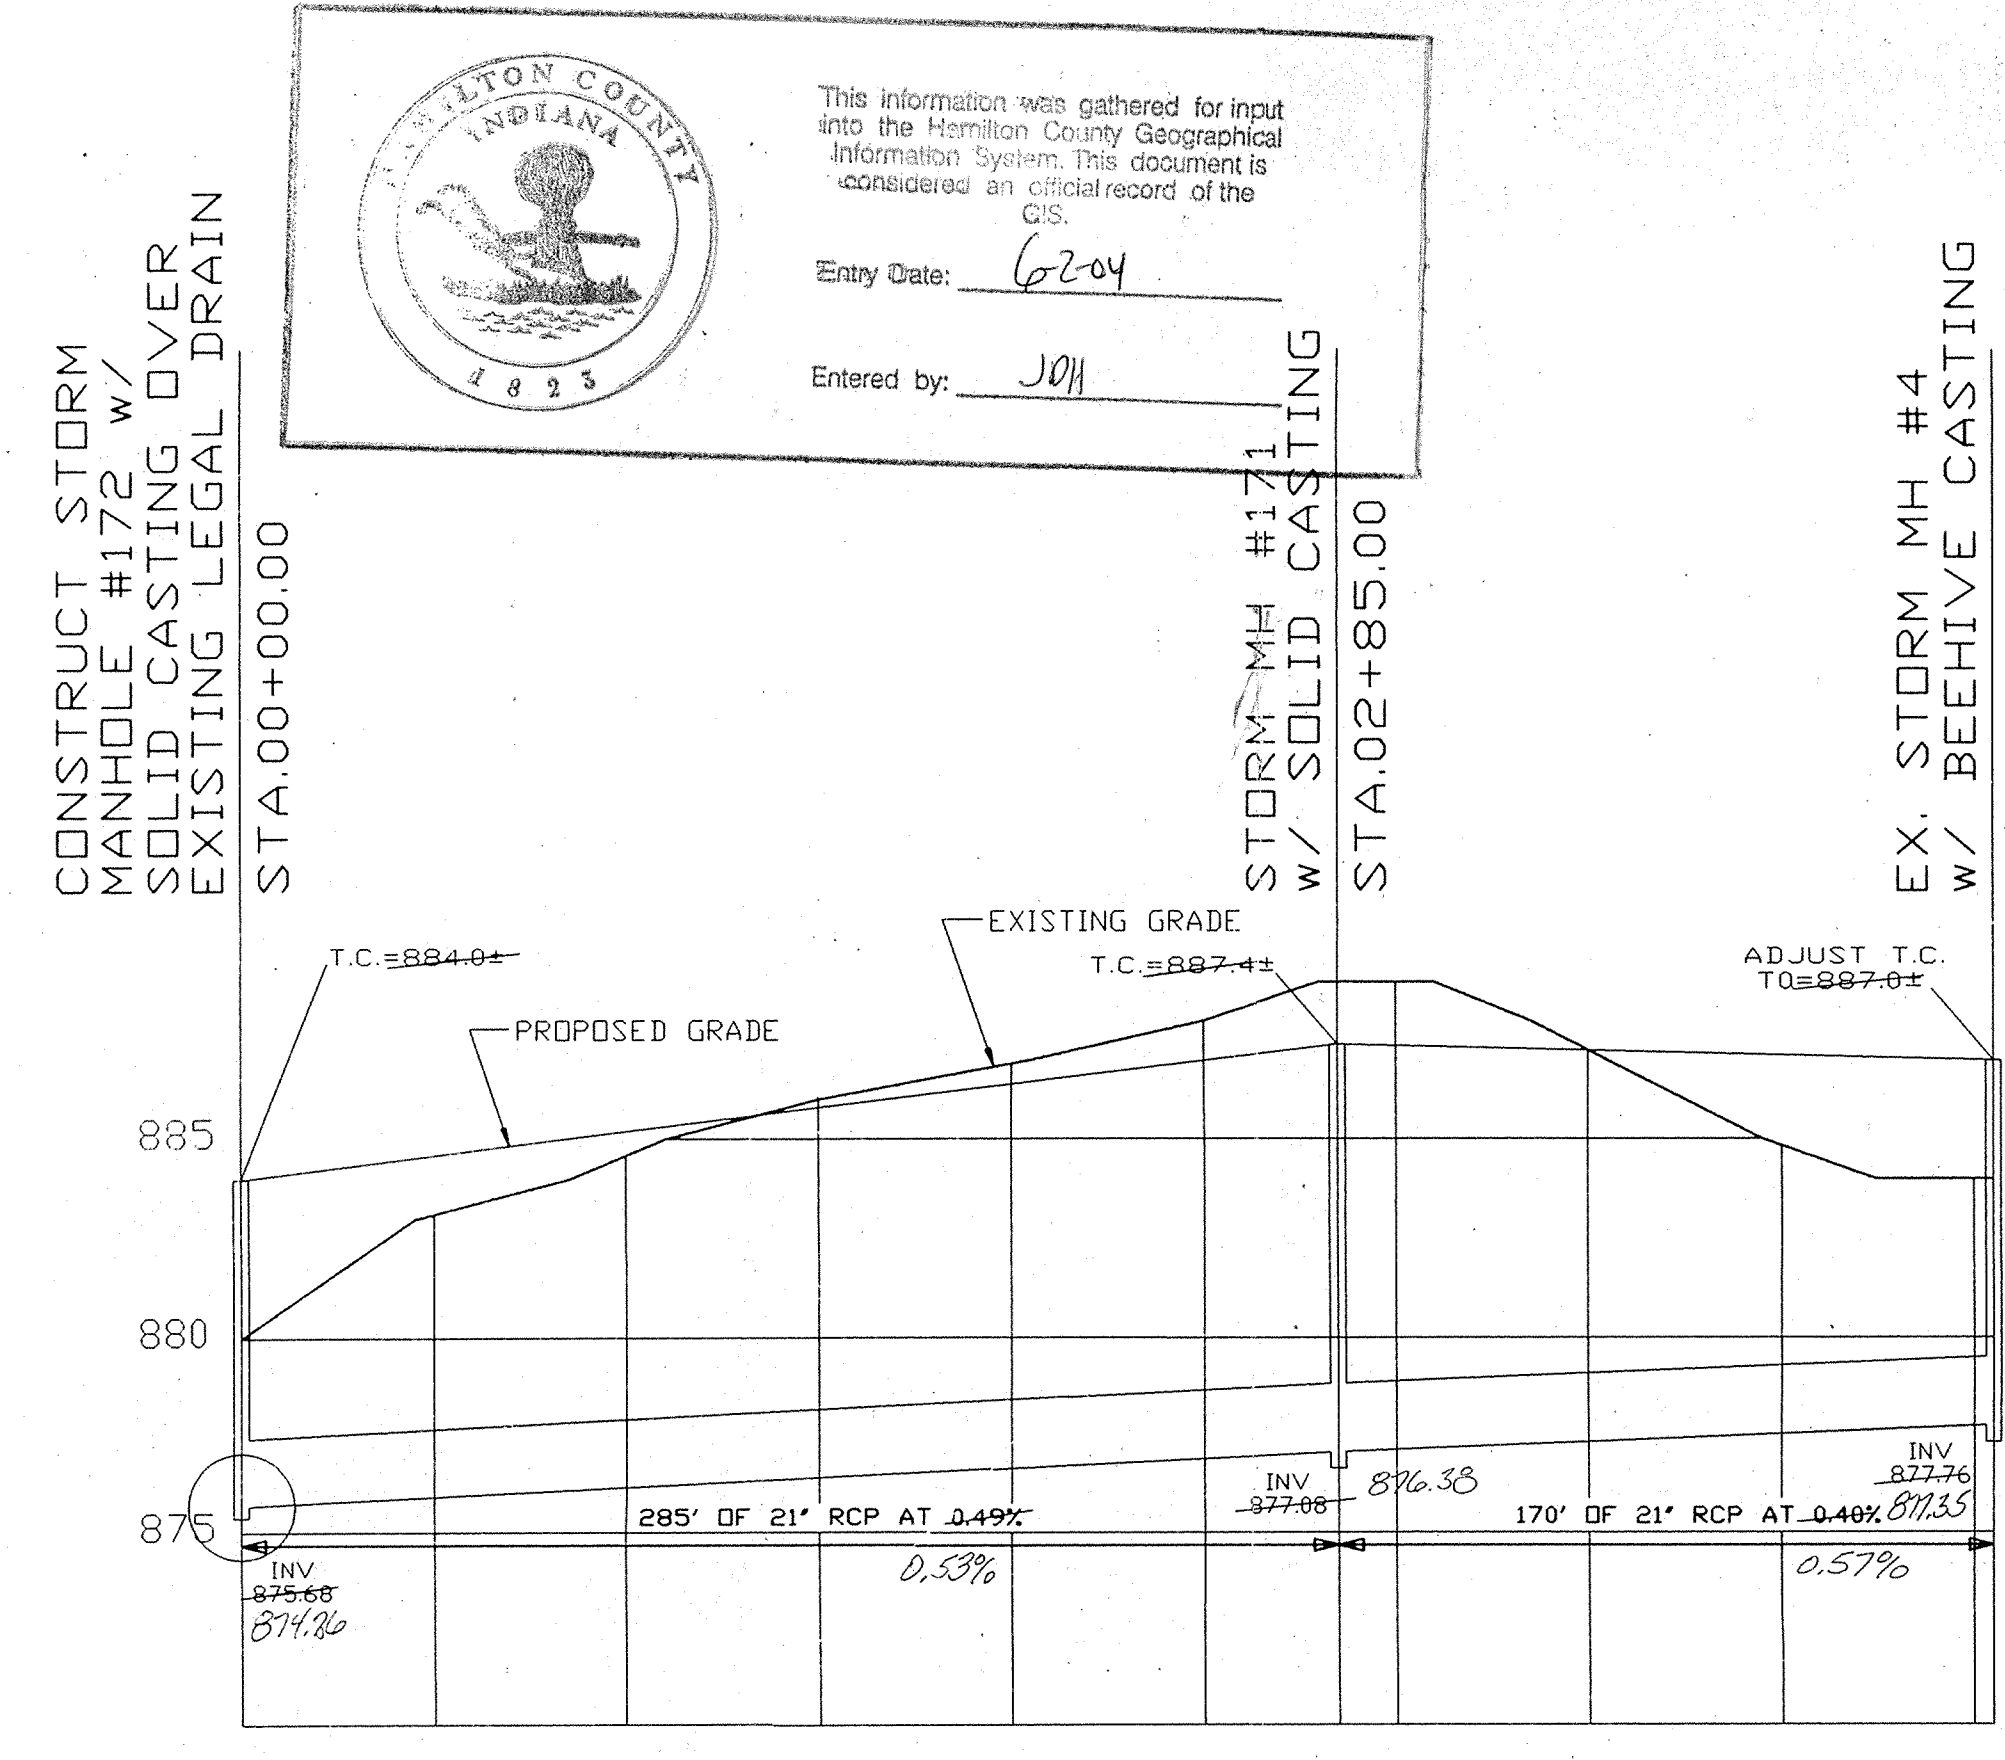

LINE S-3

STORM SEWER PROFILES


Hamilton County, Indiana seal and GIS information box. Entry Date: 6-2-04. Entered by: J011.



Allan H. Weihe
 ALLAN H. WEIHE-REG P.E.-IN #8827

WEIHE ENGINEERS, INC. LAND PLANNERS
 10505 NORTH COLLEGE AVENUE INDIANAPOLIS, INDIANA 46280 (317) 846-6611
 CIVIL ENGINEERS
 PREPARED FOR: The Kingsmill Development Corp. Carmel, Indiana
 SHEET NO. 13 OF 18
 STORM SEWER PLAN & PROFILE SHEET - Kingsmill

Kingsmill Development Plan

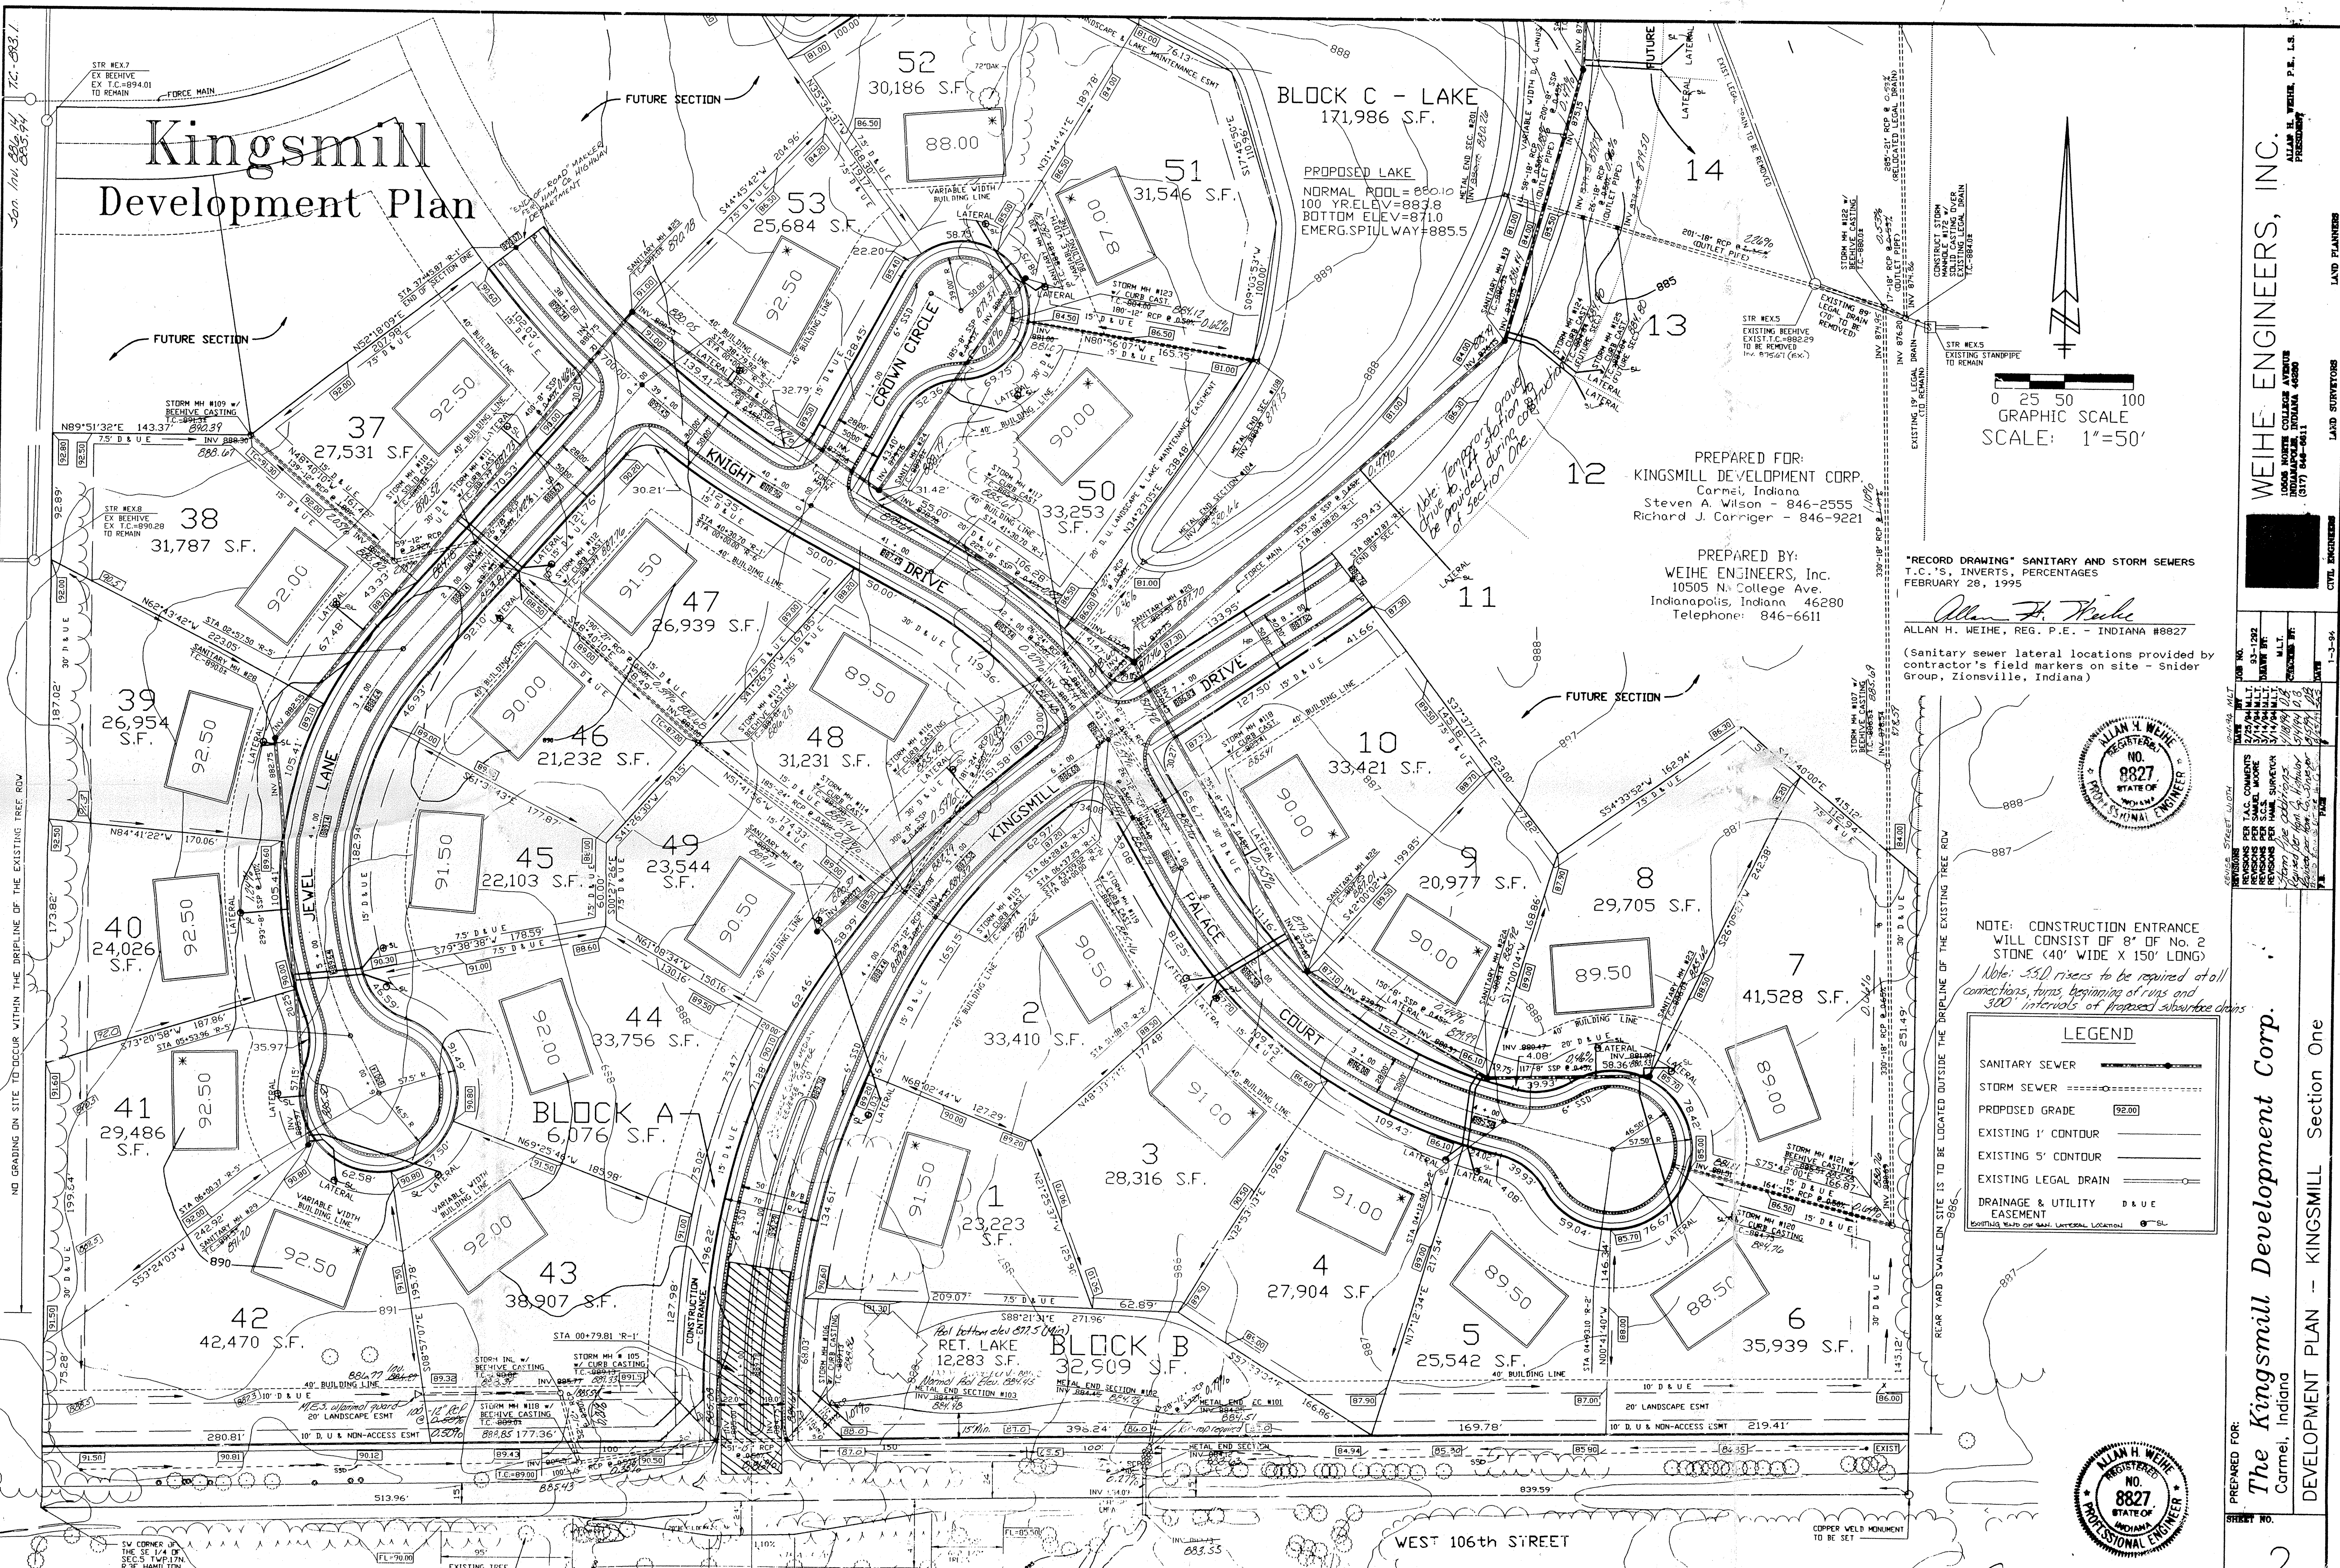

BLOCK C - LAKE
171,986 S.F.

PROPOSED LAKE
NORMAL POOL=880.10
100 YR.ELEV.=883.8
BOTTOM ELEV.=871.0
EMERG.SPILLWAY=885.5

PREPARED FOR:
KINGSMILL DEVELOPMENT CORP.
Carmel, Indiana
Steven A. Wilson - 846-2555
Richard J. Carriger - 846-9221


PREPARED BY:
WEIHE ENGINEERS, Inc.
10505 N. College Ave.
Indianapolis, Indiana 46280
Telephone: 846-6611

0 25 50 100
GRAPHIC SCALE
SCALE: 1"=50'

"RECORD DRAWING" SANITARY AND STORM SEWERS
T.C.'s, INVERTS, PERCENTAGES
FEBRUARY 28, 1995

Allan H. Weihe
ALLAN H. WEIHE, REG. P.E. - INDIANA #8827

(Sanitary sewer lateral locations provided by contractor's field markers on site - Snider Group, Zionsville, Indiana)

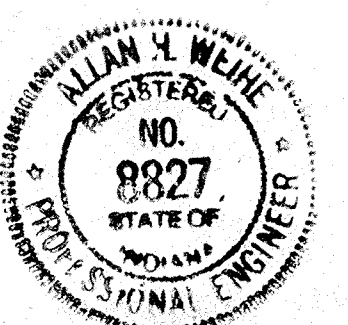

NOTE: CONSTRUCTION ENTRANCE WILL CONSIST OF 8" OF NO. 2 STONE (40' WIDE X 150' LONG)
Note: S&D risers to be required at all connections, turns, beginning of runs and 300' intervals of proposed sewer lines

LEGEND	
SANITARY SEWER	—●—●—●—
STORM SEWER	-----
PROPOSED GRADE	(92.00)
EXISTING 1' CONTOUR	—
EXISTING 5' CONTOUR	- - - - -
EXISTING LEGAL DRAIN	—○—
DRAINAGE & UTILITY EASEMENT	D & U



Allan H. Weihe
ALLAN H. WEIHE-REG P.E.-IN #8827

PREPARED FOR:
The Kingsmill Development Corp.
 Carmel, Indiana
 DEVELOPMENT PLAN - KINGSMILL Section One
 SHEET NO. 2

WEIHE ENGINEERS, INC.
 10505 N. COLLEGE AVE.
 INDIANAPOLIS, INDIANA 46280
 (317) 846-6611
 LAND PLANNERS
 CIVIL ENGINEERS
 LAND SURVEYORS

NO GRADING ON SITE TO OCCUR WITHIN THE DRIFLINE OF THE EXISTING TREE ROW




This copy printed from the Digital Archive of the Hamilton County Surveyor's Office, One Hamilton Co. Square, Ste. 188, Noblesville, IN 46060

Kingsmill Development Plan

PREPARED FOR:
KINGSMILL DEVELOPMENT CORP.
Carmel, Indiana
Steven A. Wilson - 846-2555
Richard J. Carriger - 846-9221

PREPARED BY:
WEIHE ENGINEERS, Inc.
10505 N. College Ave.
Indianapolis, Indiana 46280
Telephone: 846-6611

LEGEND	
SANITARY SEWER	
STORM SEWER	
PROPOSED GRADE	
EXISTING 1' CONTOUR	
EXISTING 5' CONTOUR	
EXISTING LEGAL DRAIN	
DRAINAGE & UTILITY EASEMENT	

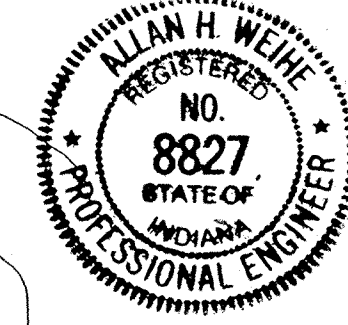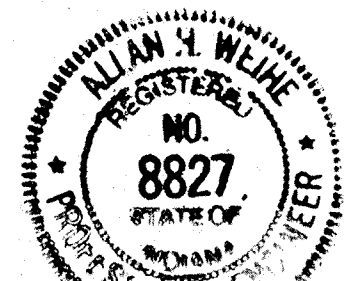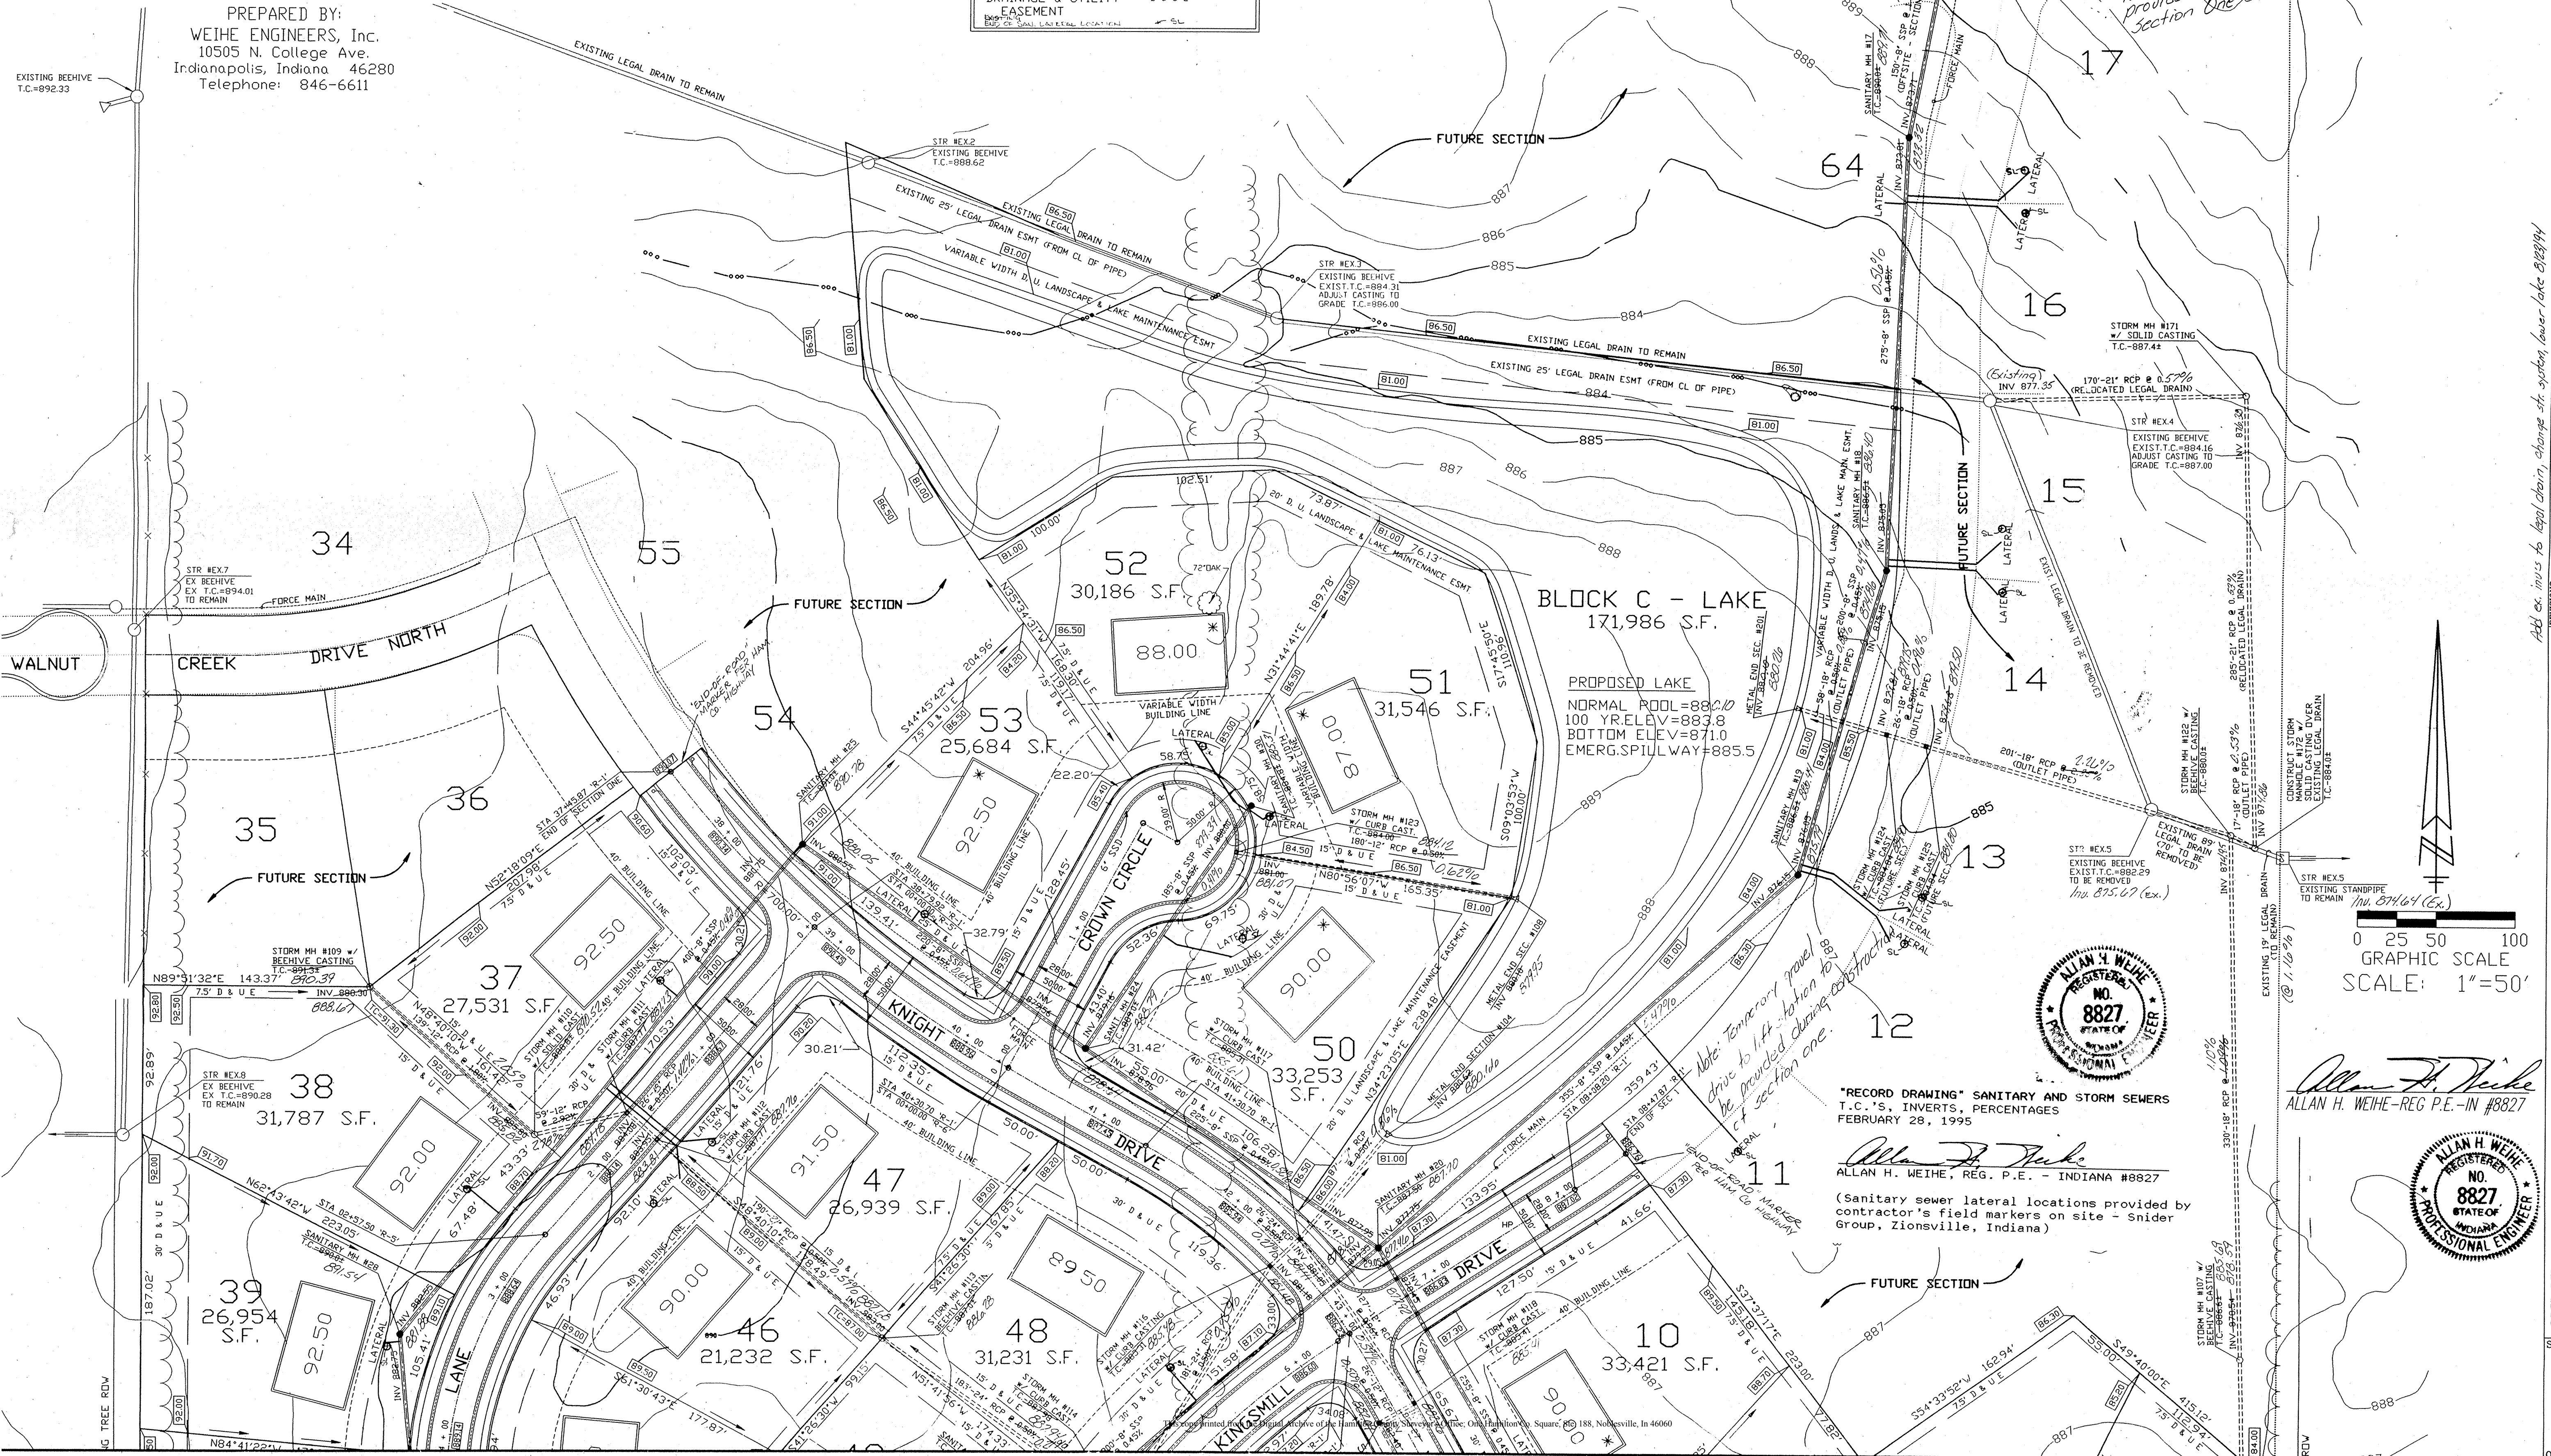

"RECORD DRAWING" SANITARY AND STORM SEWERS
T.C.'S, INVERTS, PERCENTAGES
FEBRUARY 28, 1995

Allan H. Weihe
ALLAN H. WEIHE, REG. P.E. - INDIANA #8827

(Sanitary sewer lateral locations provided by contractor's field markers on site - Snider Group, Zionsville, Indiana)

Construction of gravel access to lift station shall be provided during Section One development.

Record drawing TC 8827B

Add ex. in. to legal drain, storm sewer, sewer, base, lake, 8827B

<p>WEIHE ENGINEERS, INC. 10505 NORTH COLLEGE AVENUE INDIANAPOLIS, INDIANA 46260 (317) 846-6611</p>	
<p>PREPARED FOR: The Kingsmill Development Corp. Carmel, Indiana</p>	<p>DEVELOPMENT PLAN - KINGSMILL Section One</p>
<p>SHEET NO. 3</p>	<p>DATE 1-3-94</p>
<p>DATE 1-3-94</p>	<p>DATE 1-3-94</p>
<p>REVISIONS PER T.C. COMMENTS 93-1292 REVISIONS PER SAMUEL MOORE 5/14/94 M.L.T. 5/14/94 M.L.T. 5/14/94 M.L.T. 5/14/94 M.L.T.</p>	<p>CHECKED BY: M.L.T. M.L.T. M.L.T. M.L.T.</p>
<p>DRAWN BY: M.L.T. M.L.T. M.L.T. M.L.T.</p>	<p>DATE 1-3-94</p>