

Kenton C. Ward, CFM
Surveyor of Hamilton County
Phone (317) 776-8495
Fax (317) 776-9628

Suite 188
One Hamilton County Square
Noblesville, Indiana 46060-2230

Map Correction-Field Verification

Drain Number: 315

Drain Length: 4,687 ft.

Drain Name: J. Osborn-Walnut Creek Woods

Change + / - : 20

Date: 04-12-2016


New Length: 4,707 ft.

Verified By: SLM

Notes & Sketch: See attached Map.

The outlet structure for Walnut Creek Woods (OS-101) was removed and the 15" RCP extended to manhole Structure 108A of the John Osborn Drain. This change was missed because it was not reflected on the as-builts for Walnut Creek Woods. It is not clear as to when this extension was done. However, it was probably done with the Kingsmill Development as it directly followed the instillation of the Walnut Creek Woods arm.

Suzanne L. Mills
GIS Specialist

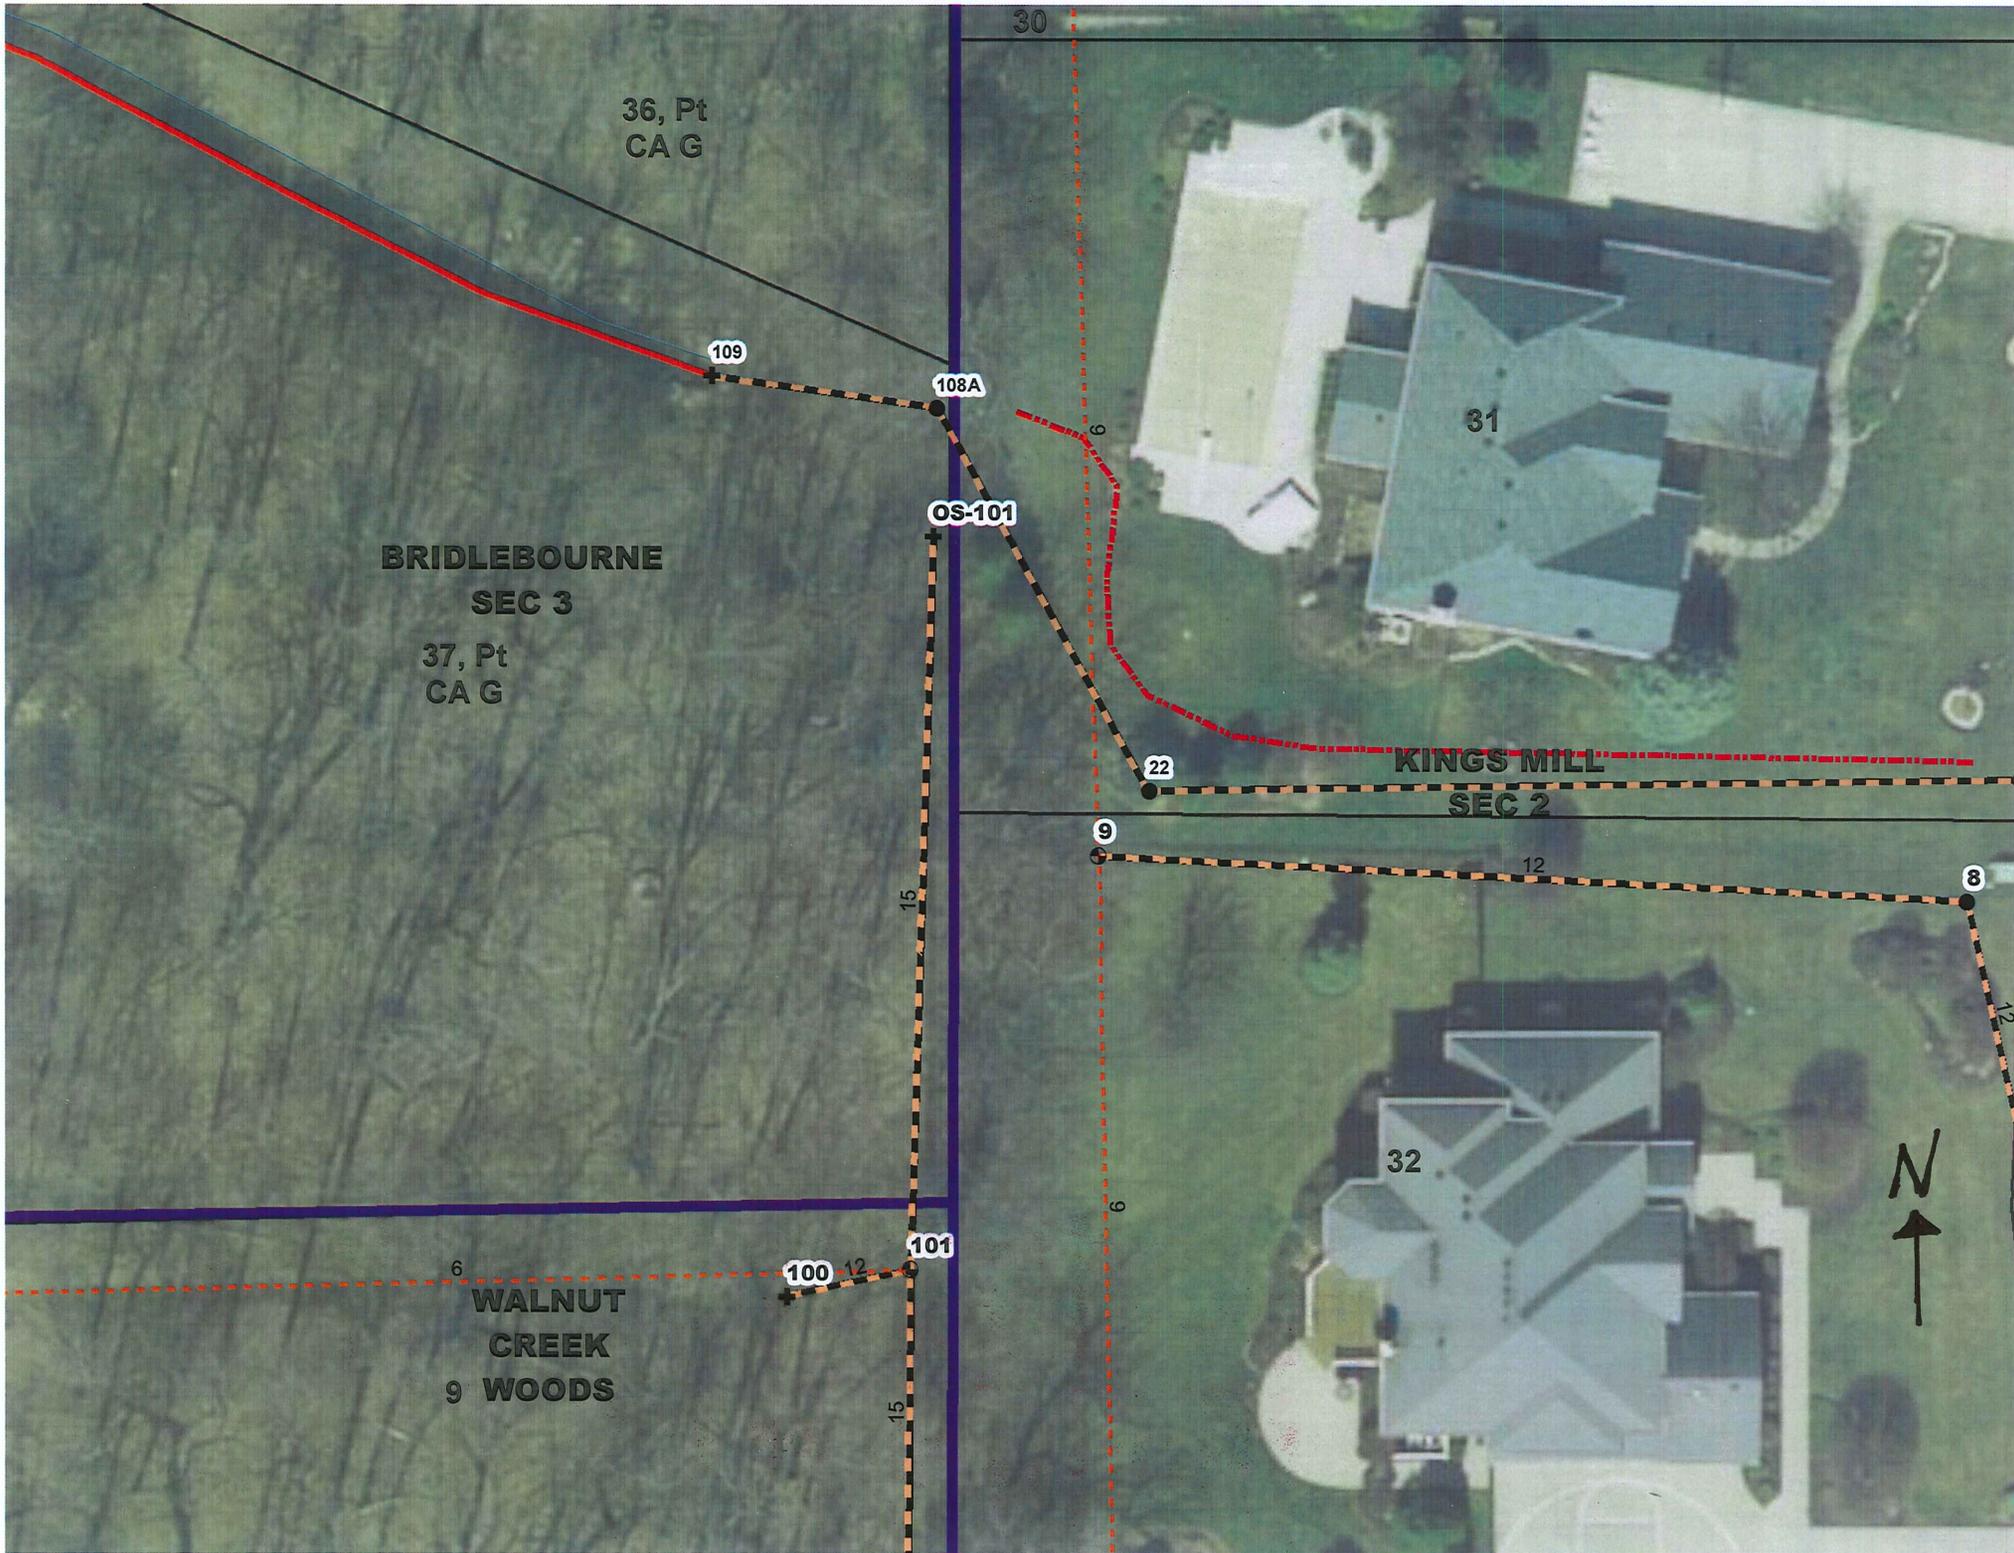

BRIDLEBOURNE
SEC. 3

WALNUT
CREEK
WOODS

